




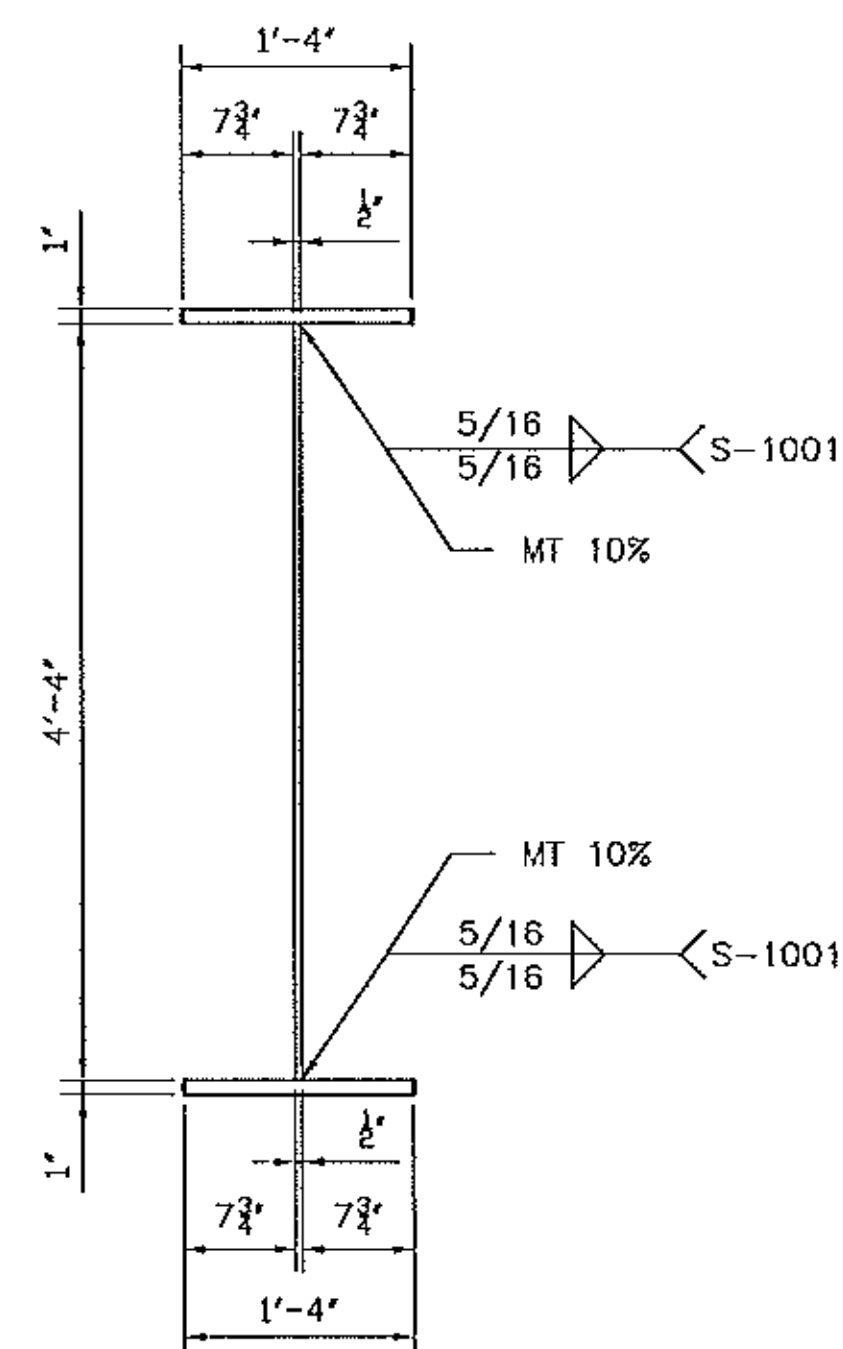


TYPICAL SECTION

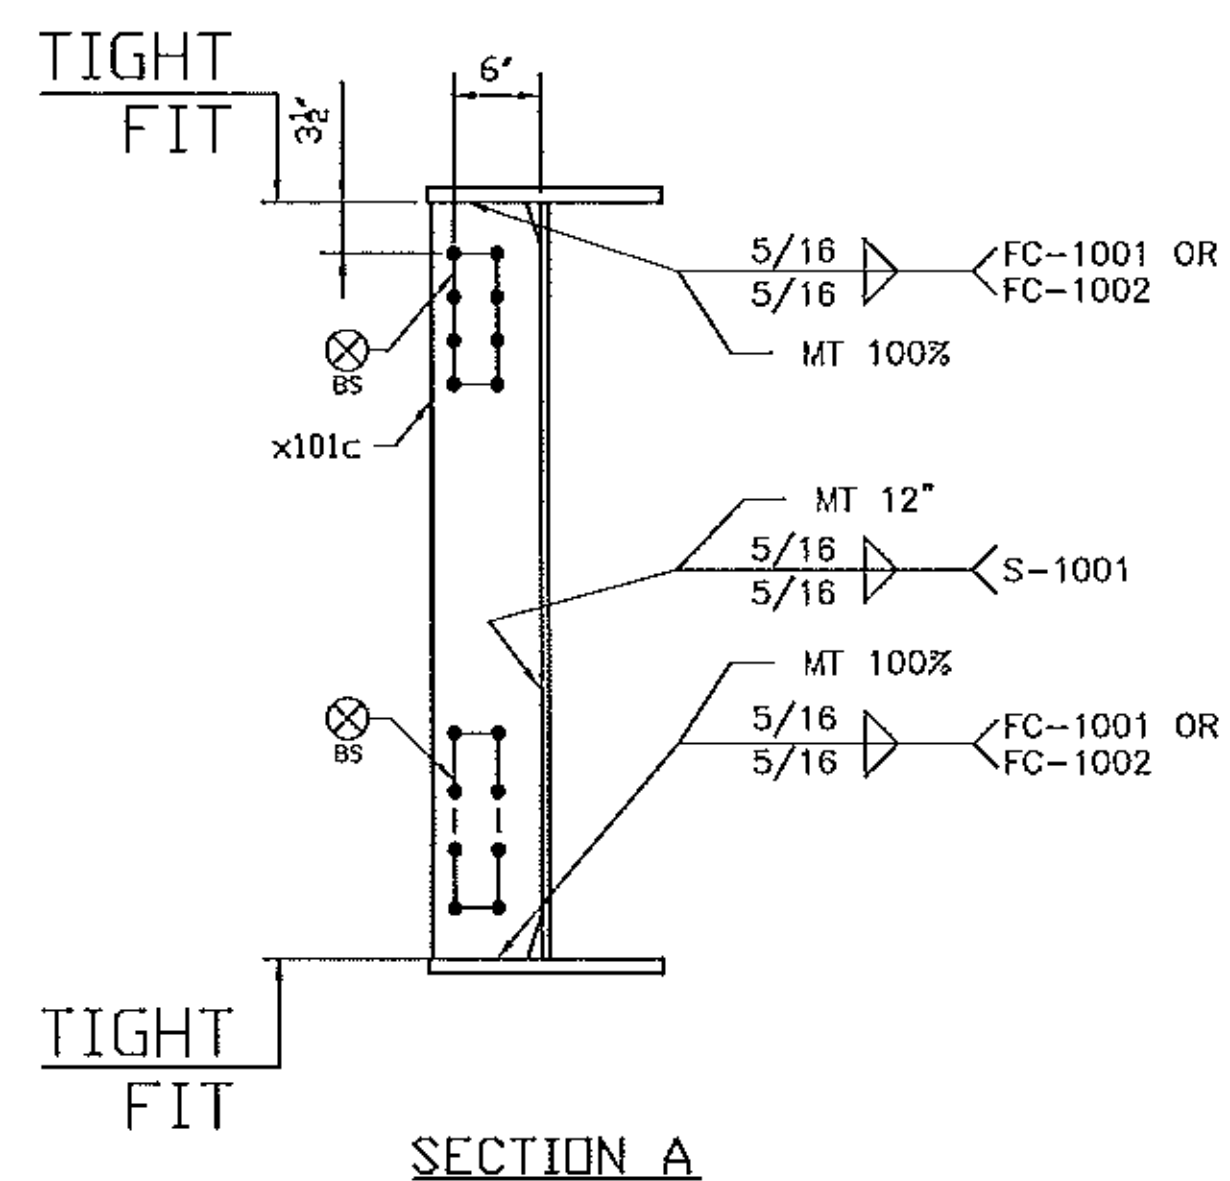


SECTION A

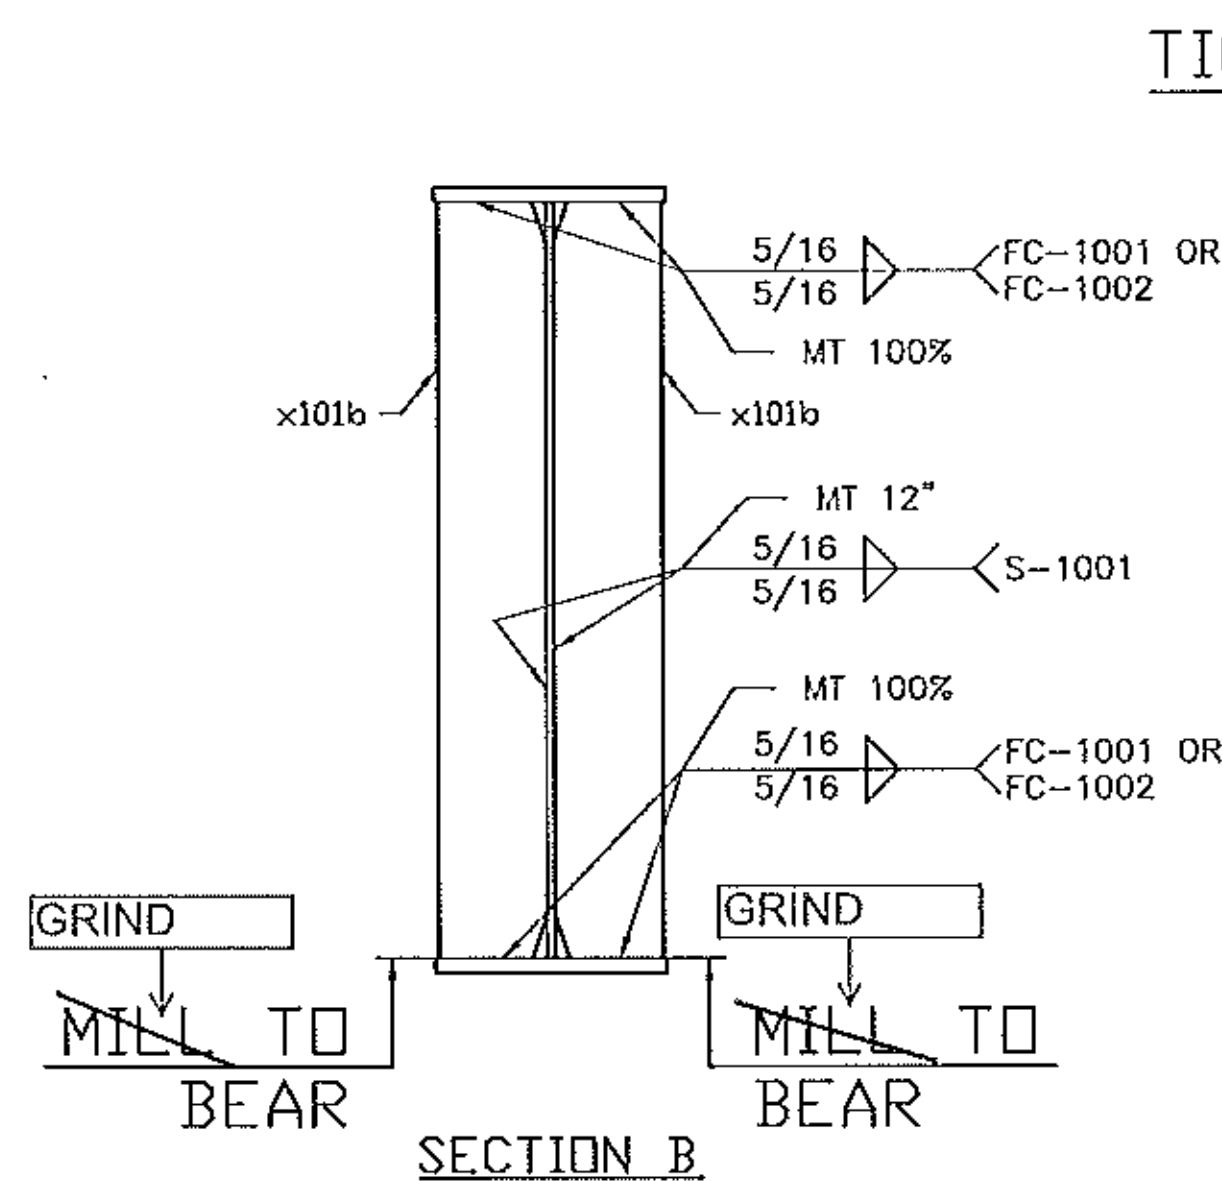


SECTION B

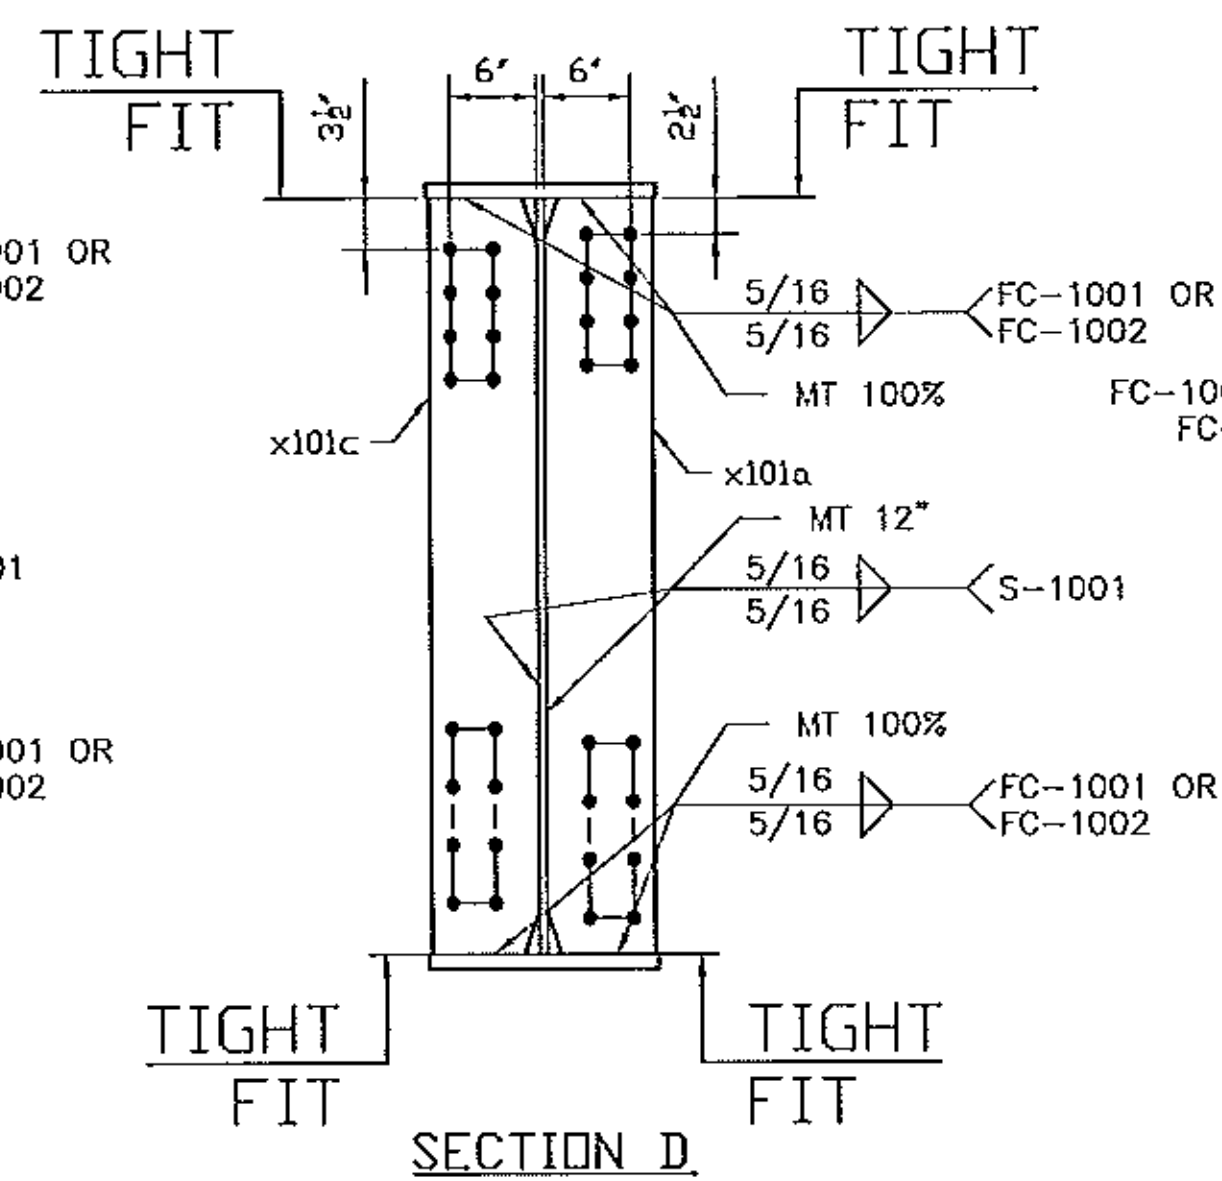

SECTION D

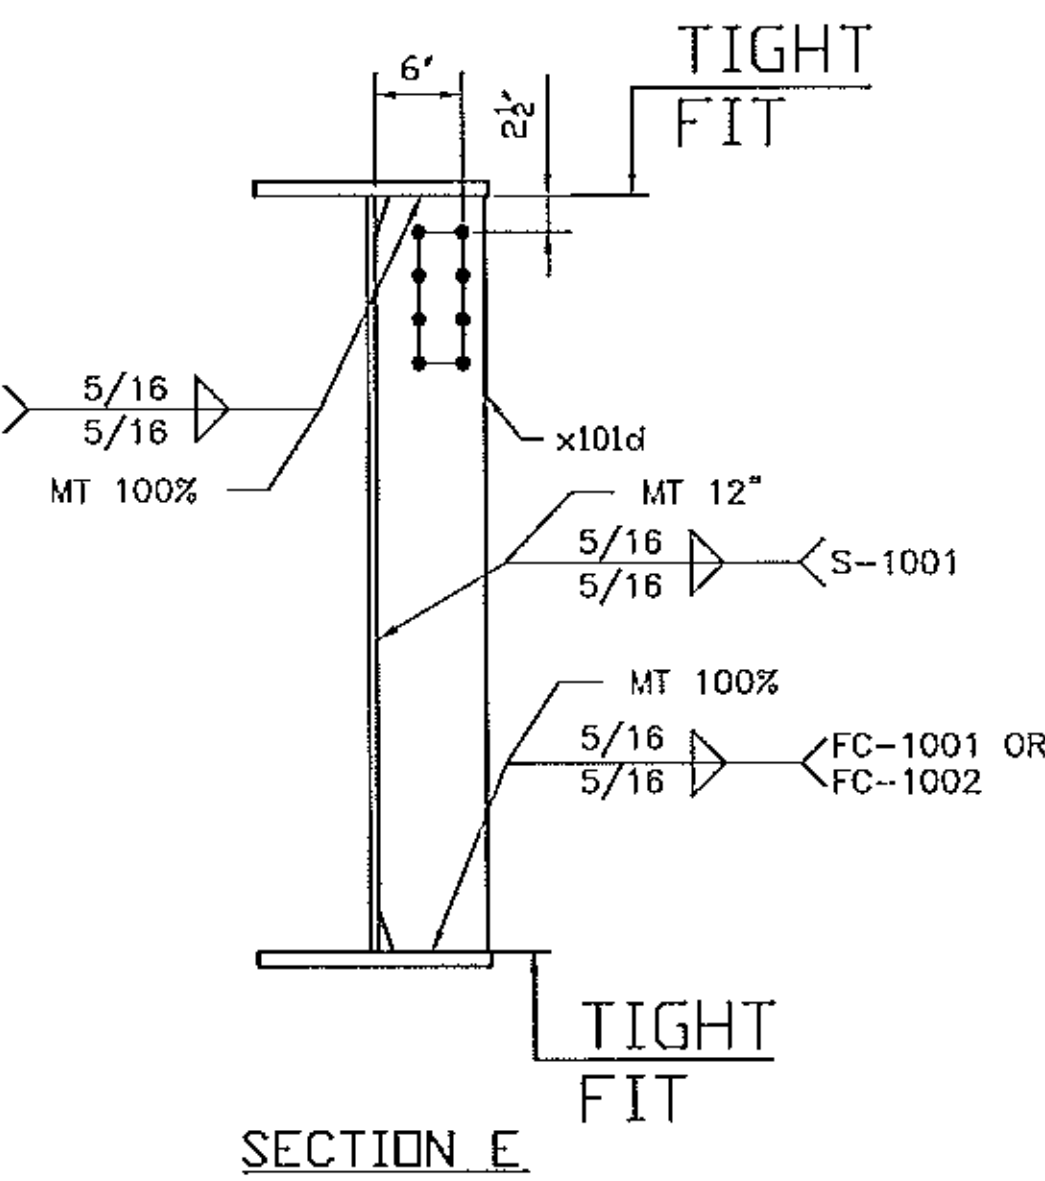


SECTION E

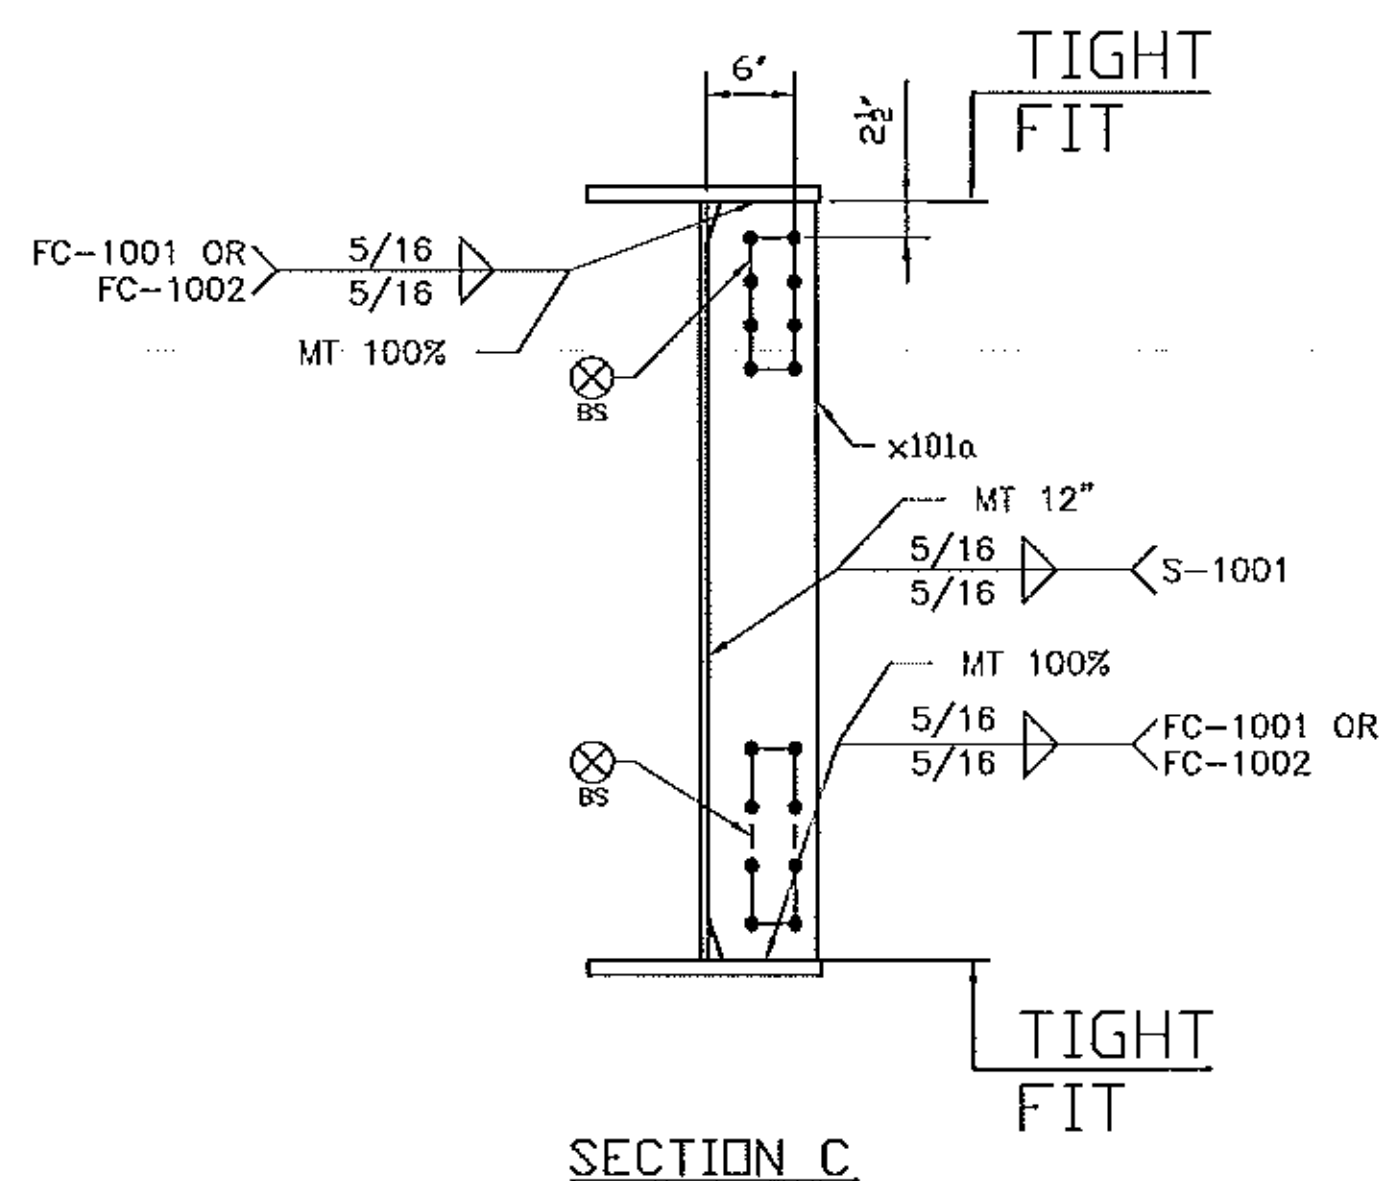

SECTION C

PRIMER ONLY, NO PAINT
BOTH SIDES 75 mm DIA AROUND HOLE
WHERE NOTED WITH THIS SYMBOL

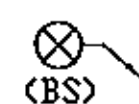

GENERAL NOTES: SEE GN100
HOLES: 15/16 (U.N.)
CLEANING
AND PAINTING: SEE SHEET P100 AND P101

FOR APPROVAL	07/06/12	BR	EG
REVISION	DATE	PAR	VER.

Vermont Agency of Transportation
RECEIVED
CK'D BY M.E.M. OK'D BY C.W.M.
July 09, 2012
RESUBMIT APPROVED AS NOTED
BY C. CARLSON DATE 07-27-2012

NOTE: BOLT 1 WASHER: 1 WASHER UNDER NUT U.N.
BOLT 2 WASHER: 1 WASHER UNDER HEAD U.N.
1 WASHER UNDER HEAD U.N.



PROJECT: VT RT 9, BRIDGE NO. 11
TOWN OF WOODFORD, VT
OVER WALDOOMSAC RIVER

TITLE				GIRDER 102G1	
REFERENCE					
PROJECT NO. ER BHF 010-1 (44)					
DESIGN BY	BR	DATE	JULY 2012	CHECKED BY	UN04260
DESIGN BY	GG	DATE	JULY 2012	CHECKED BY	102-3 A