



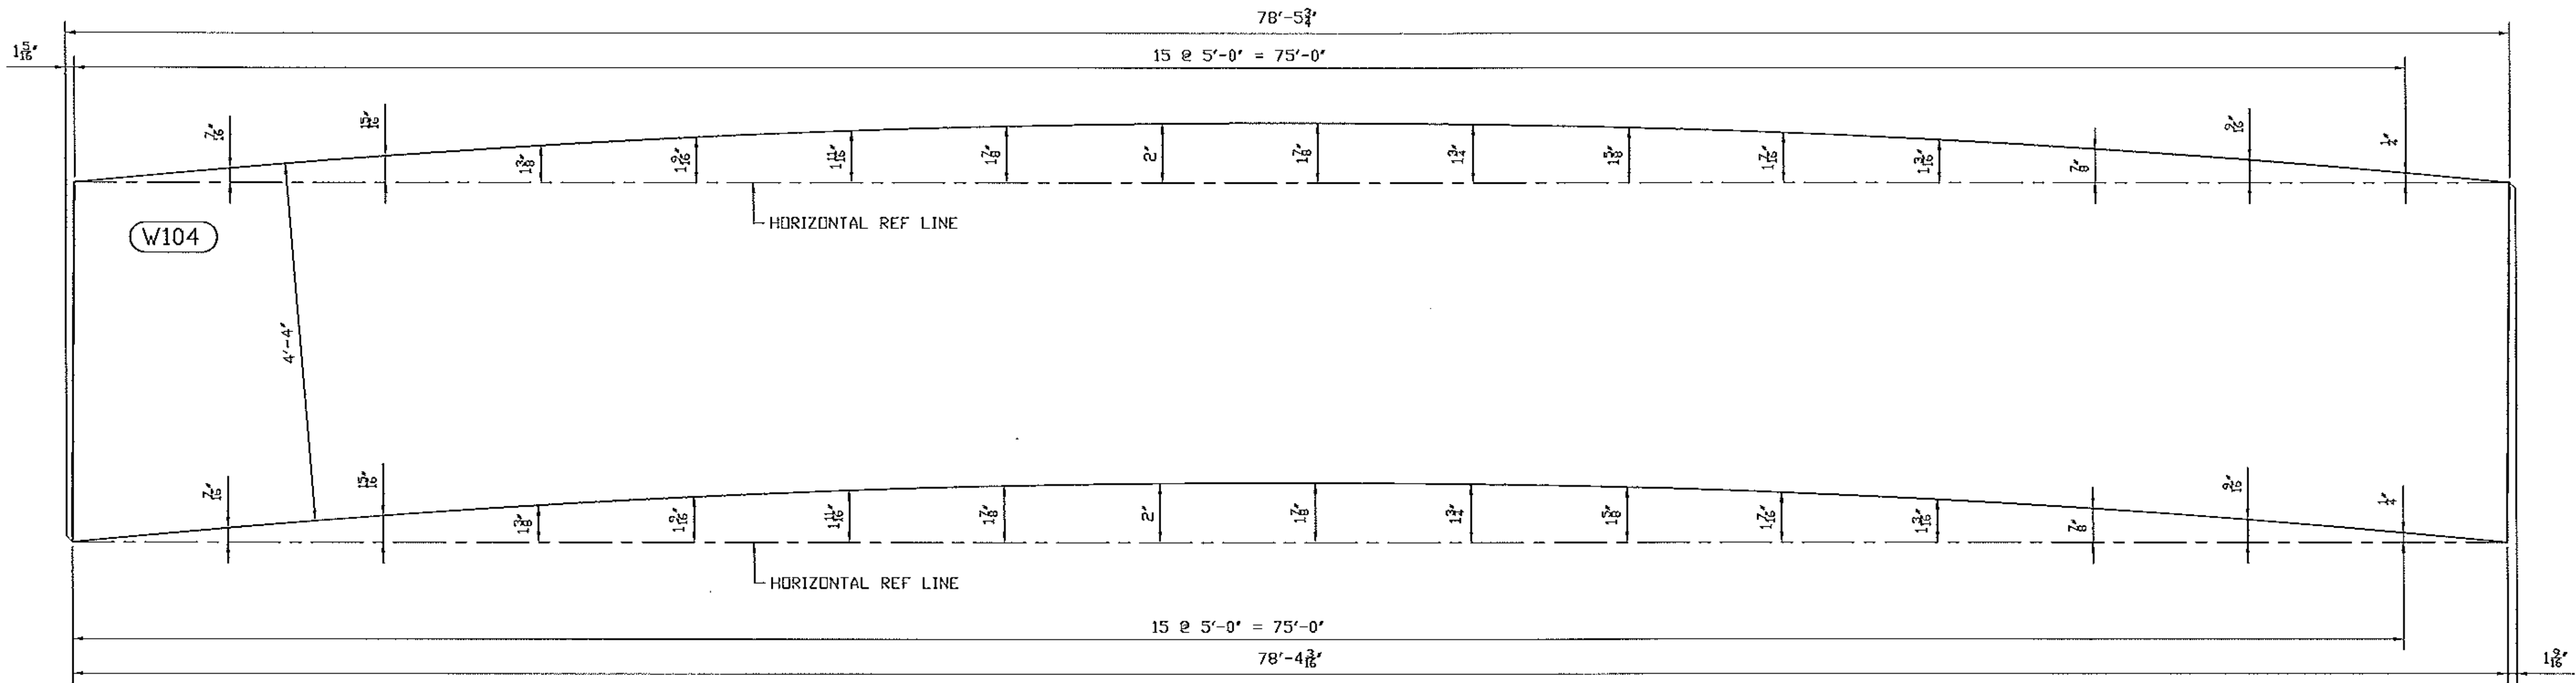

ONE WEB PLATE W104
W104 = PL 1/2"

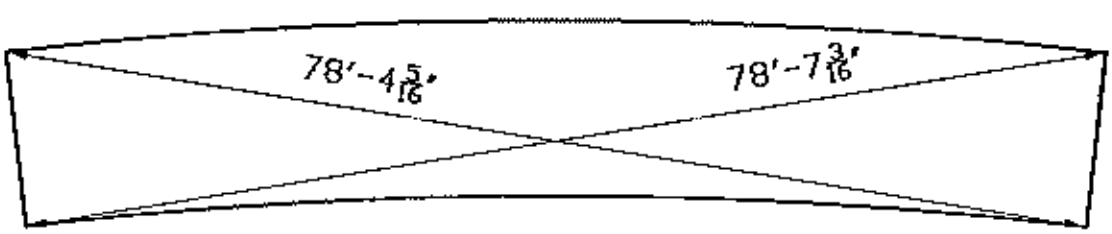

GENERAL NOTES: SEE GN100

	FOR APPROVAL	07/06/12	BR	EG
No	REVISION	DATE	PAR	VER.

Vermont Agency of Transportation
RECEIVED
CK'D BY M.E.M. OK'D BY C.W.M.
July 09, 2012
RESUBMIT APPROVED ✓
BY C. CARLSON DATE 07-27-2012

NOTE: BOLT 1 WASHER: 1 WASHER UNDER NUT U.N.
BOLT 2 WASHER: 1 WASHER UNDER HEAD U.N.
1 WASHER UNDER HEAD U.N.



386 River Road, Claremont,
NH 03743
Tel: (603) 542-5202 Fax: (603) 542-5312

a division of
CANAM
GROUP INC.

PROJECT: VT RT 9, BRIDGE NO. 11
TOWN OF WOODFORD, VT
OVER WALDOMSAC RIVER

TITLE: GIRDER 104G1

REFERENCED: PROJECT NO. ER BHF 010-1 (44)

REVISED BY	BR	DATE	JULY 2012	CONTRACT NO.	UN04260
DRAWN BY	GG	DATE	JULY 2012	REVISION NO.	104-1 A