
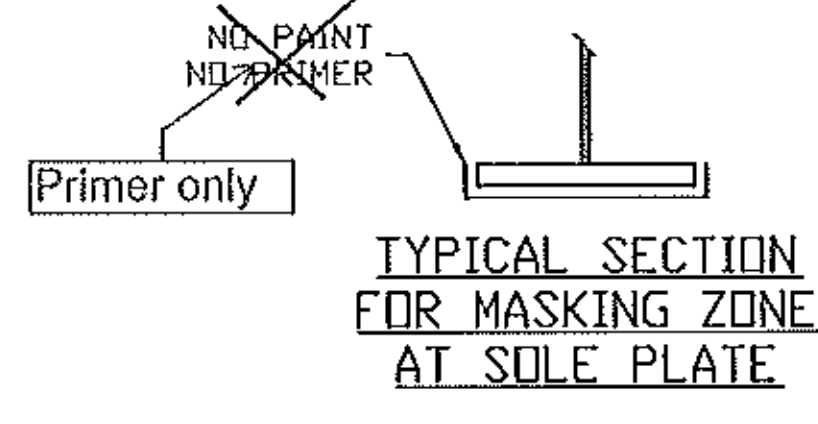
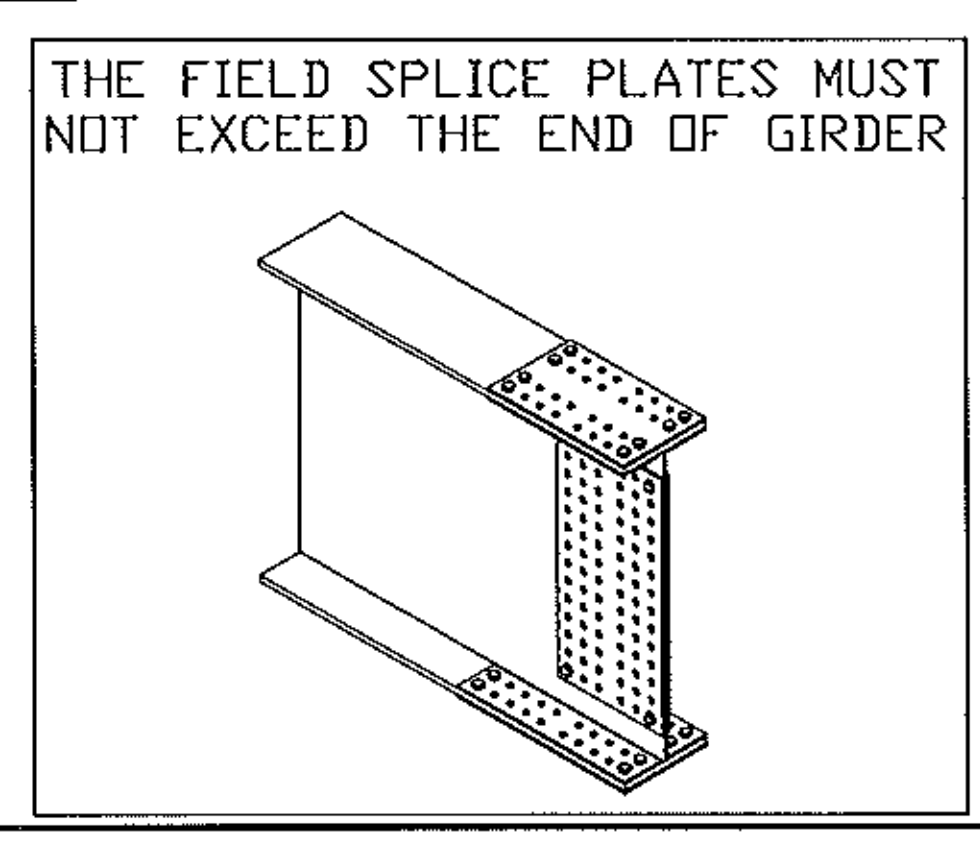
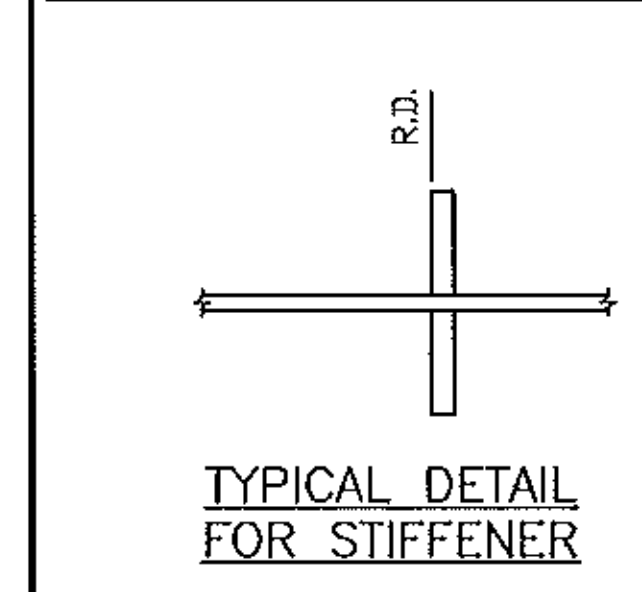
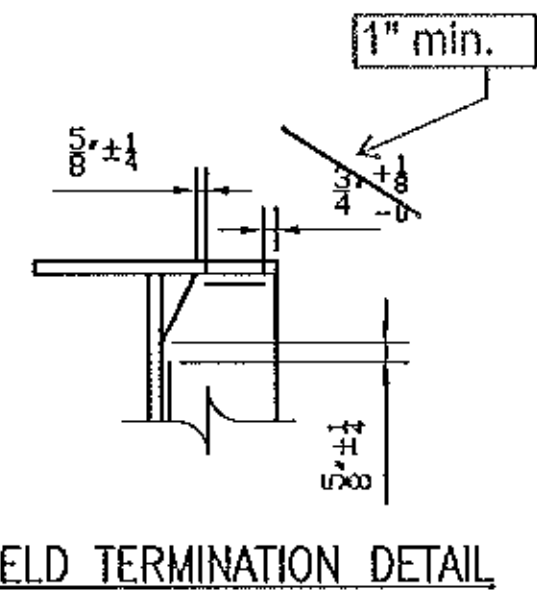
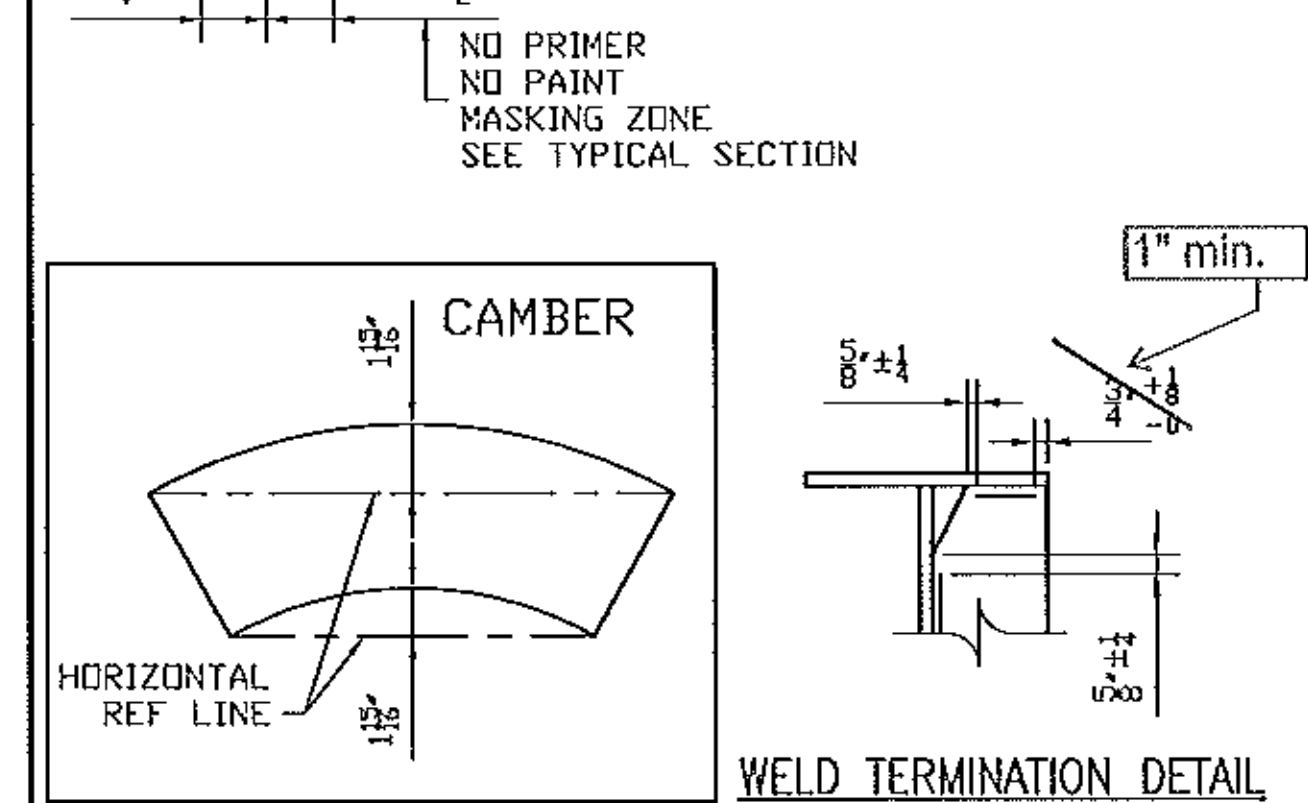


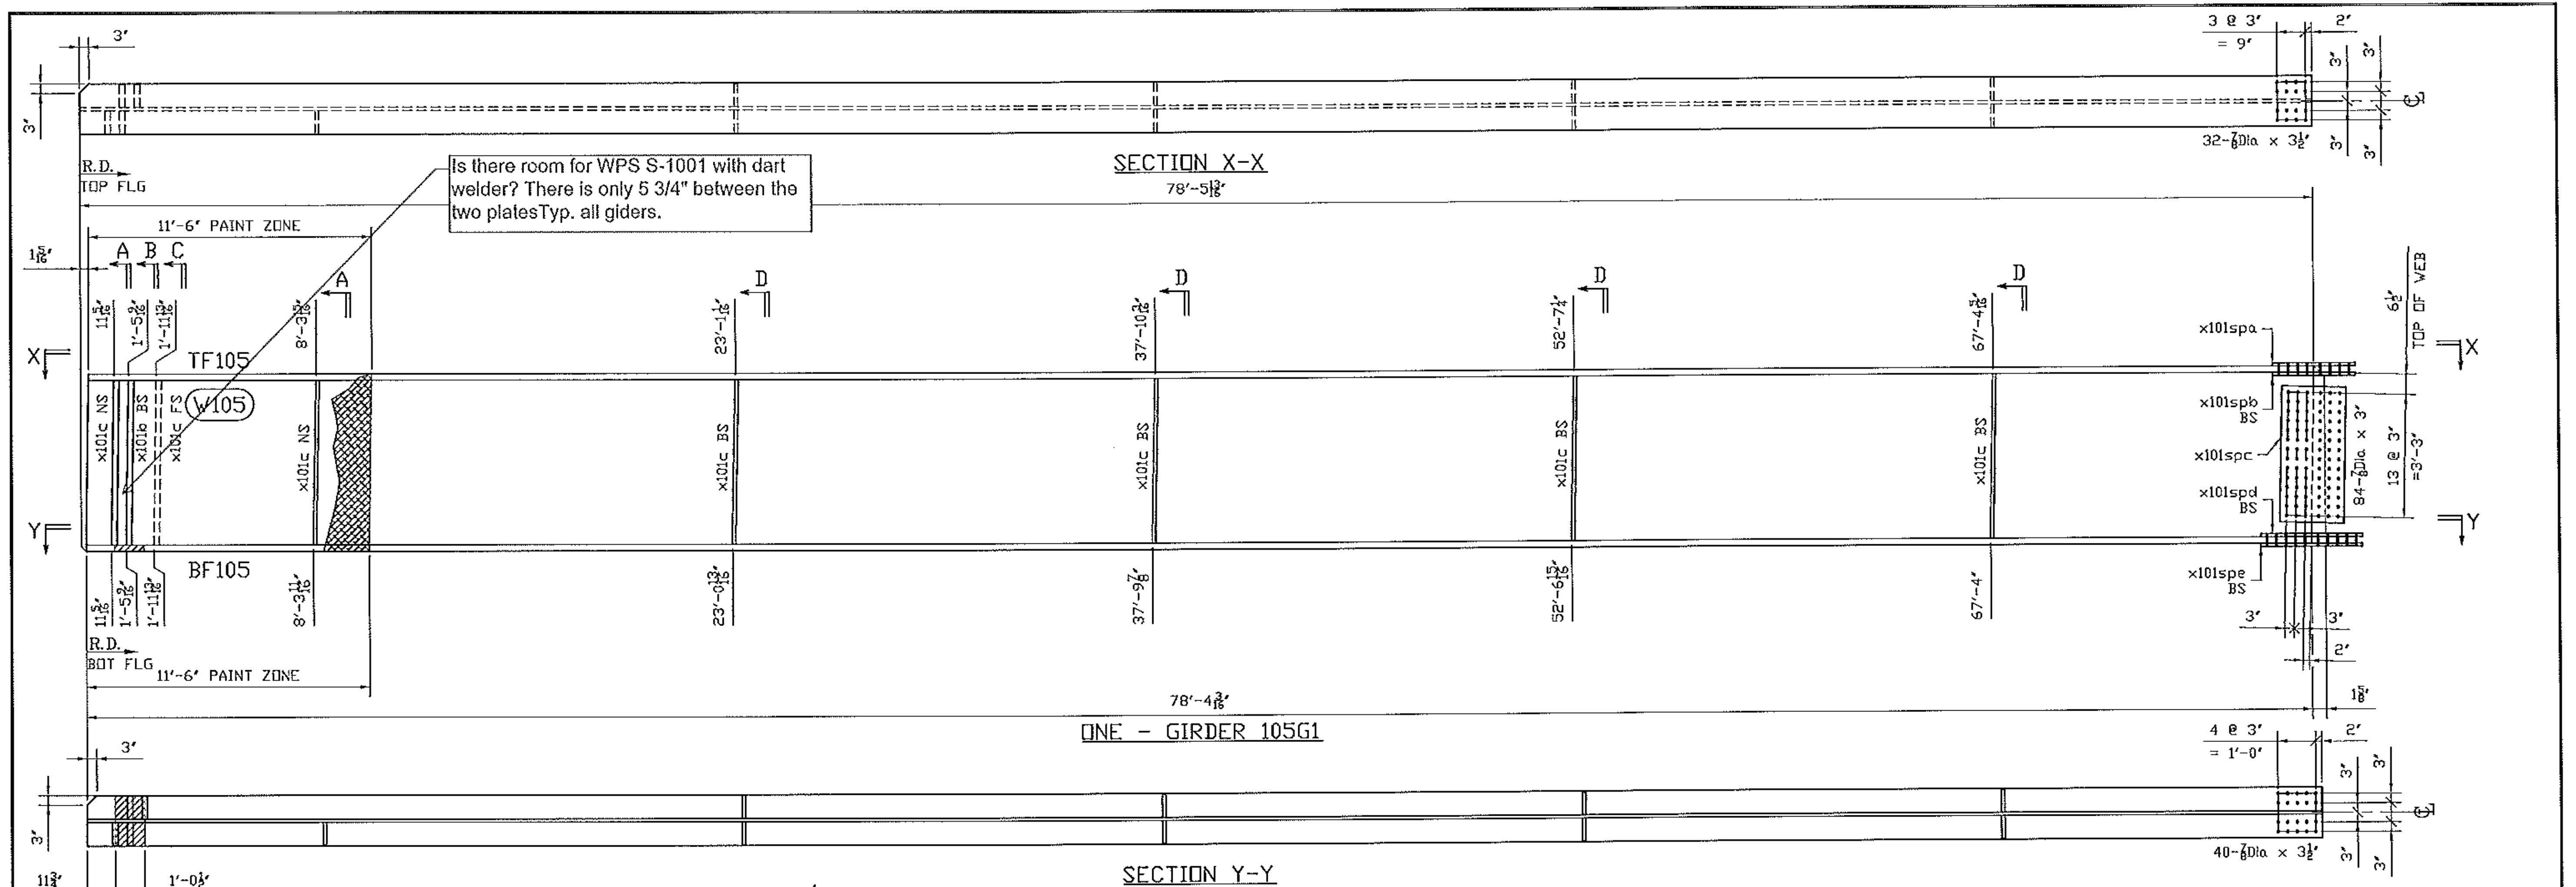

BILL OF MATERIAL									
Mark	Qty.	Description	Std	Length	Remark	ABM	Total	Seq	Qty
			Grd				Weight		/Seq
105G1	ONE	GIRDER				16629	16699	1	1
105G1	1	.GIRDER		78-5 13/16					
TF105	1	PL1x16	A70950WT2	78-4 1/2		100-1	4267		
W105	1	PL1/2x52	A70950WT2	78-5 13/16		100-2	6944		
BF105	1	PL1x16	A70950WT2	78-4 3/16		100-1	4266		
x101b	2	PL7/8x7 1/2	A70950WT2	4-4 WB		101-1	194		
x101c	10	PL1/2x7 1/2	A70950WT2	4-4		101-2/3	553		
x101spa	1	PL1/2x16	A70950WT2	2-2 1/4		102-1	60		
x101spb	2	PL1/2x7	A70950WT2	2-2 1/4		102-2	52		
x101spc	2	PL1/2x43	A70950WT2	8 1/4		102-3	101		
x101spd	2	PL1/2x7	A70950WT2	2-8 1/4		102-4	64		
x101spe	1	PL1/2x16	A70950WT2	2-8 1/4		102-5	73		
FB		FIELD BOLTS							
78F3	84	.7/8 Dia A325 TYP3		3 1/2	1FL WASH				
78F312	72	.7/8 Dia A325 TYP3		3 1/2	1FL WASH				

GENERAL NOTES: SEE GN100
 HOLES: 15/16 (UN.)
 CLEANING AND PAINTING: SEE SHEET P100 AND P101

See standard specification 506.24(a)(9), no payment will be made for bolts, nuts, washers, they are considered to be incidental

608
 Vermont Agency of Transportation
RECEIVED
 CK'D BY M.E.M. OK'D BY C.W.M.
 July 09, 2012
 RESUBMIT APPROVED AS NOTED
 BY C. CARLSON DATE 07-27-2012

FOR APPROVAL	07/06/12	BR	EG
REVISION	DATE	PAR	VER.
NOTE: BOLT 1 WASHER: 1 WASHER UNDER NUT U.N. BOLT 2 WASHER: 1 WASHER UNDER HEAD U.N. 1 WASHER UNDER HEAD U.N.			
PROJECT: VT RT 9, BRIDGE NO. 11 TOWN OF WOODFORD, VT OVER WALDOOMSAC RIVER			
TITLE: GIRDER 105G1			
REFERENCE: PROJECT NO. ER BHF 010-1 (44)			
DATE: BR	DATE: JULY 2012	CONTRACT NO: UN04260	
DATE: GG	DATE: JULY 2012	DATE: 105-2	