




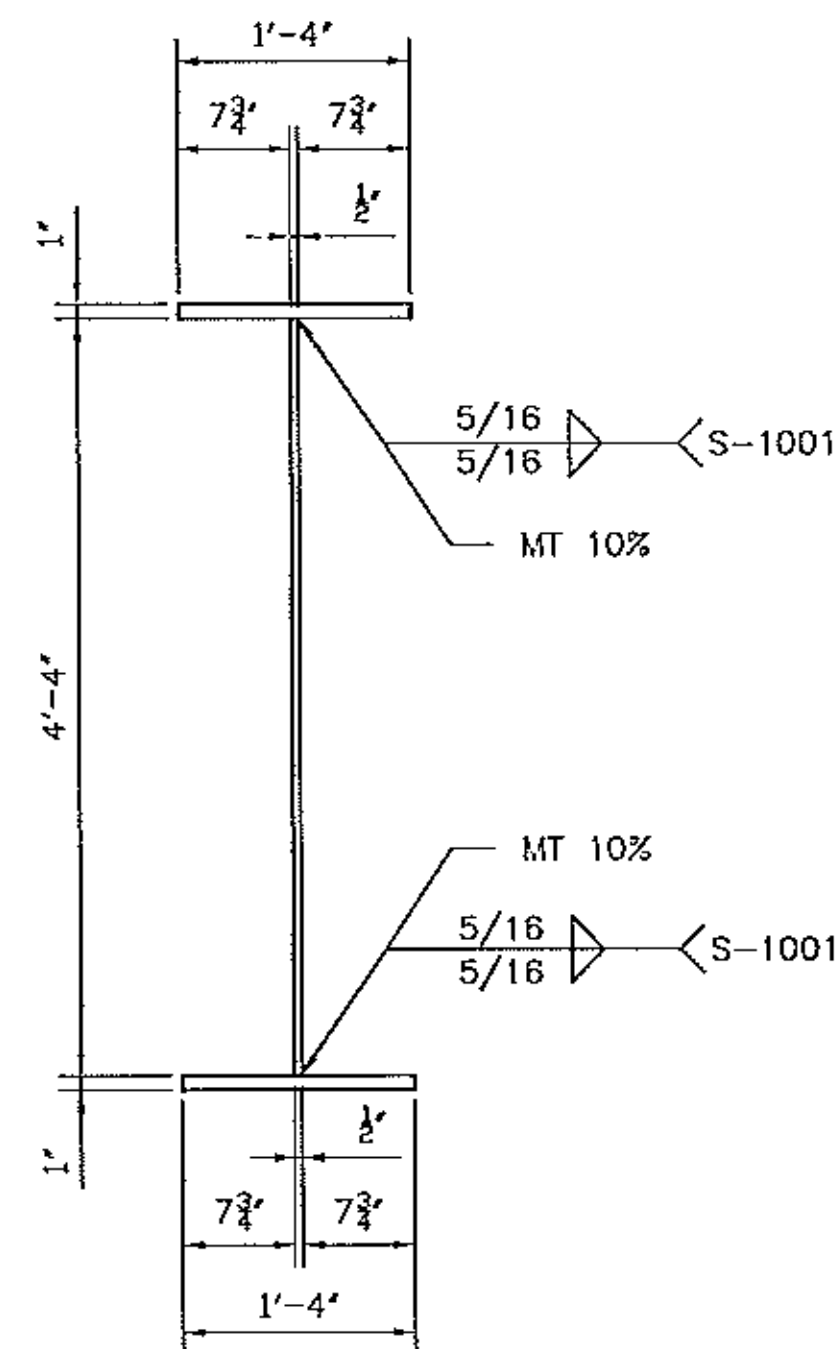


TYPICAL SECTION

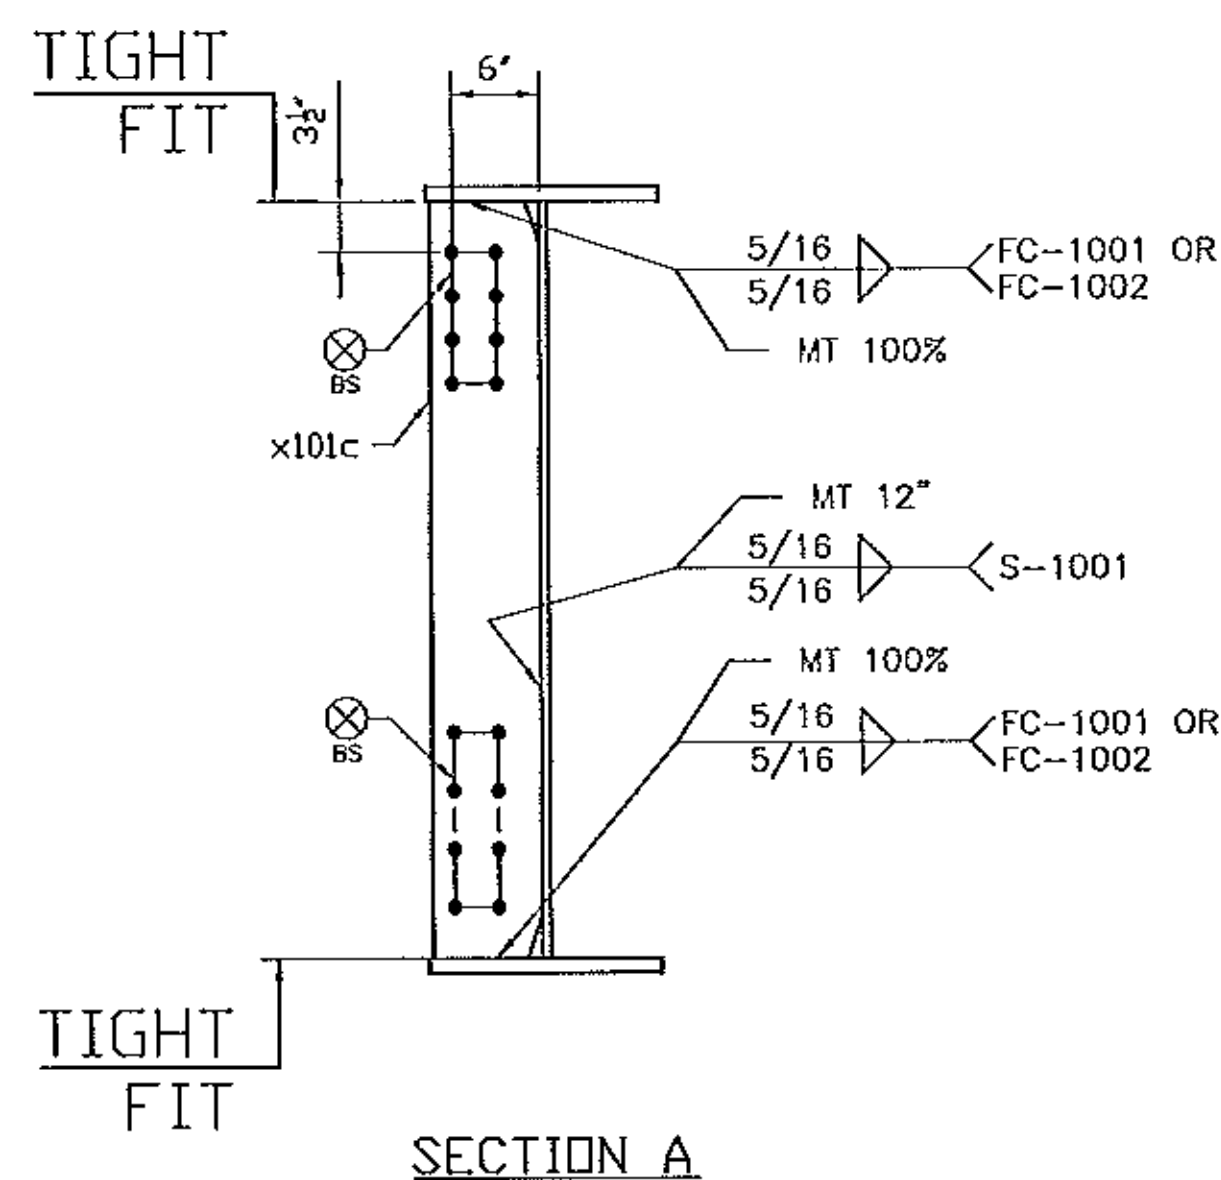


SECTION A

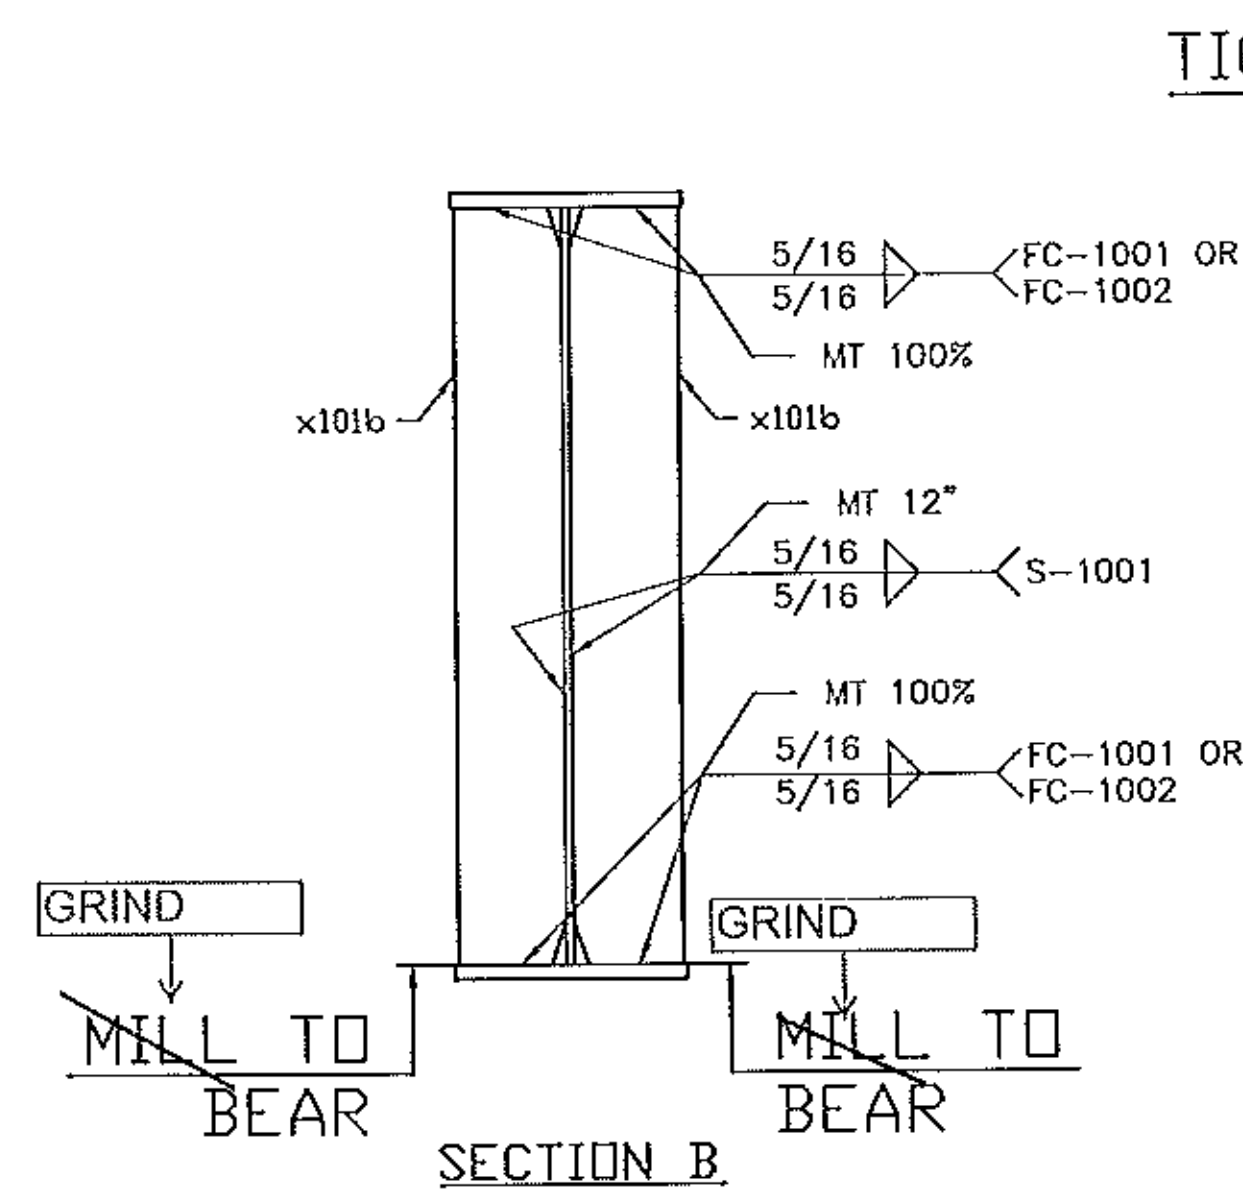

SECTION B

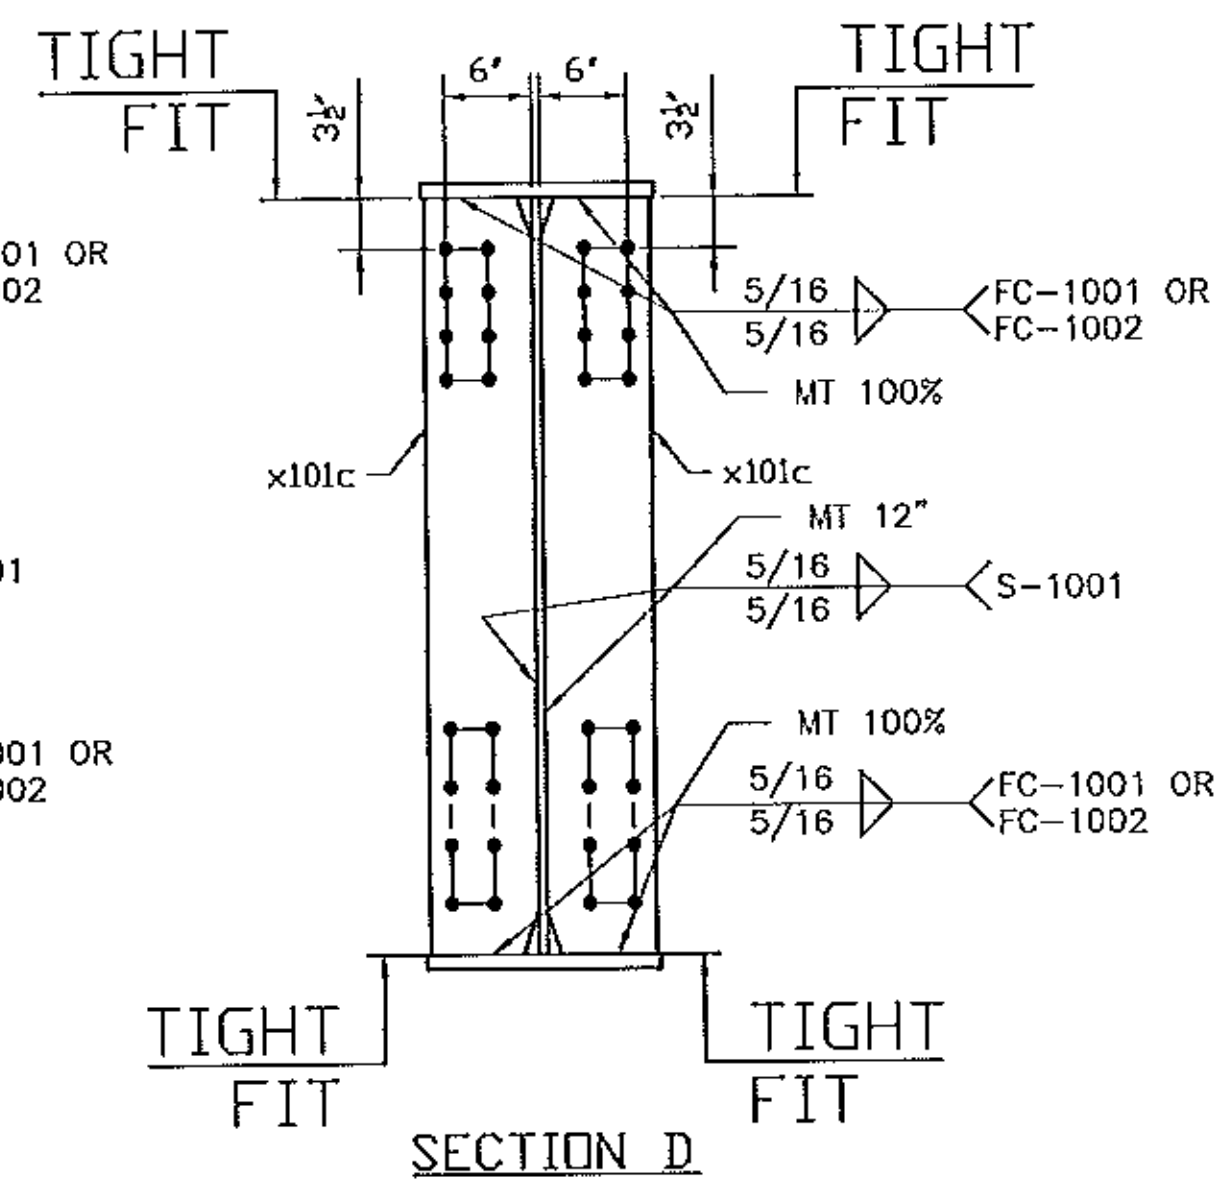

SECTION D

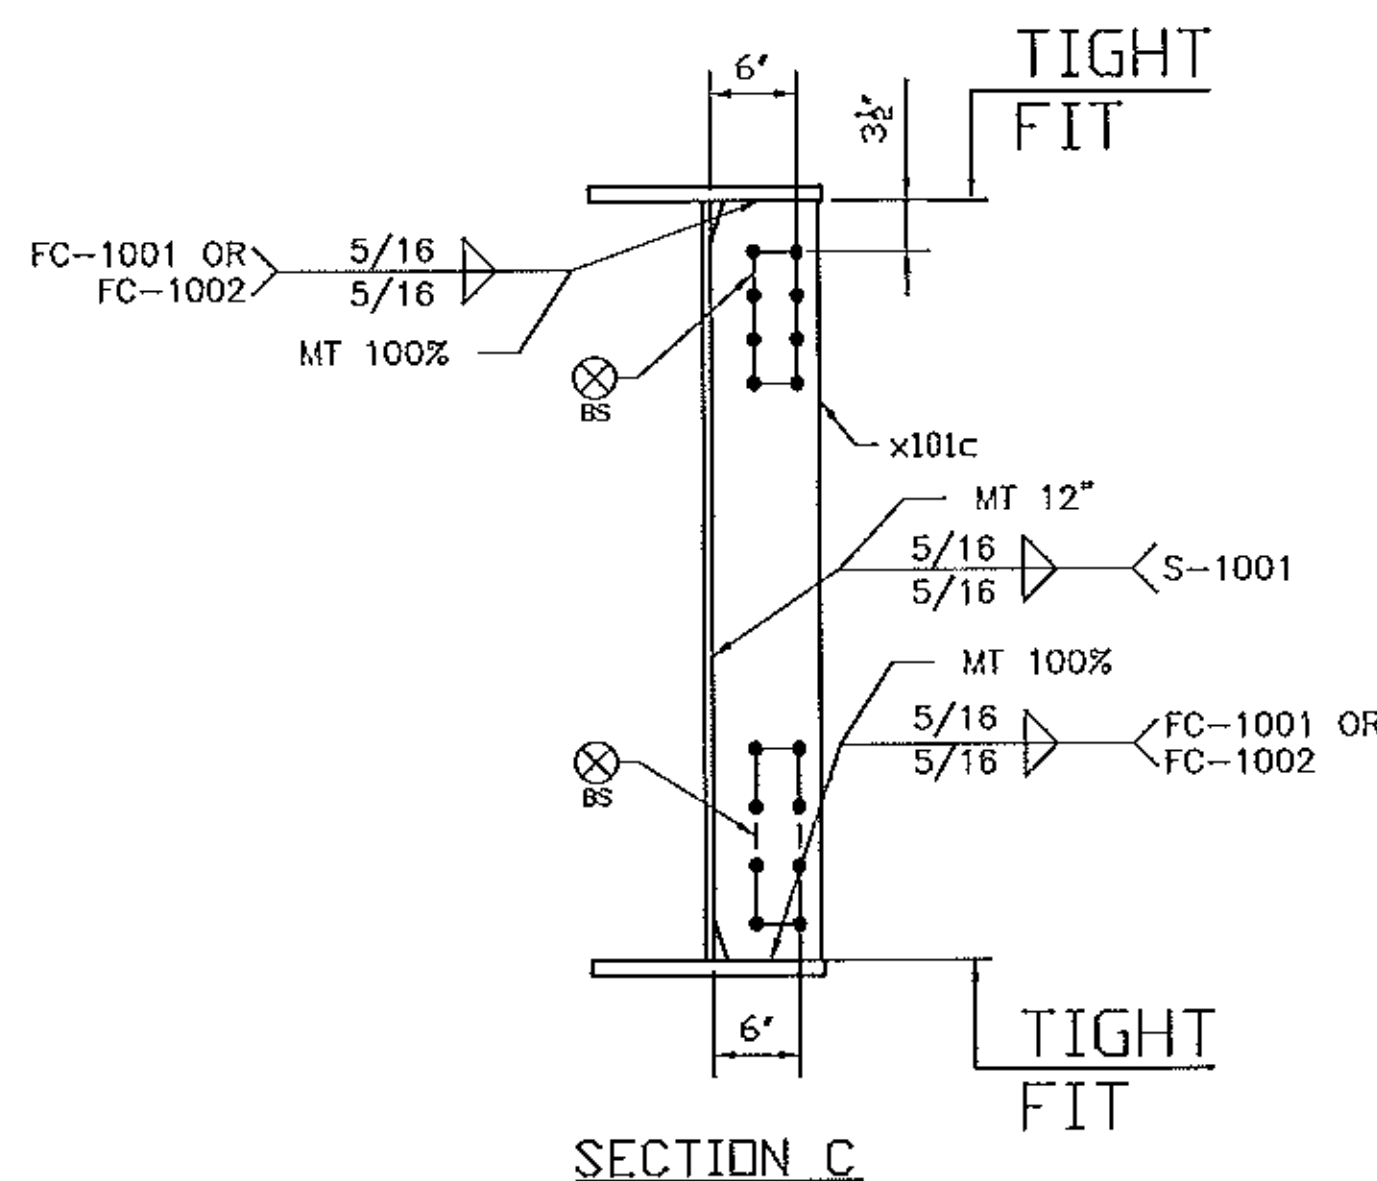


SECTION C

GENERAL NOTES: SEE GN100
HOLES: 15/16 (UN.)
CLEANING AND PAINTING: SEE SHEET P100 AND P101

FOR APPROVAL	07/06/12	BR	EG
REVISION	DATE	PAR	VER.

PRIMER ONLY, NO PAINT
BOTH SIDES 75 mm DIA AROUND HOLE
WHERE NOTED WITH THIS SYMBOL

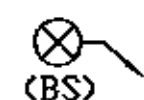

Vermont Agency of Transportation

RECEIVED

CK'D BY M.E.M. OK'D BY C.W.M.

July 09, 2012

RESUBMIT BY C. CARLSON APPROVED AS NOTED DATE 07-27-2012

NOTE: BOLT 1 WASHER: 1 WASHER UNDER NUT U.N.
BOLT 2 WASHER: 1 WASHER UNDER HEAD U.N.
1 WASHER UNDER HEAD U.N.



PROJECT: VT RT 9, BRIDGE NO. 11
TOWN OF WOODFORD, VT
OVER WALDOMSAC RIVER

TITLE: GIRDER 105G1

REFERENCE: PROJECT NO. ER BHF 010-1 (44)

BR	JULY 2012	UN04260
GG	JULY 2012	105-3 A