

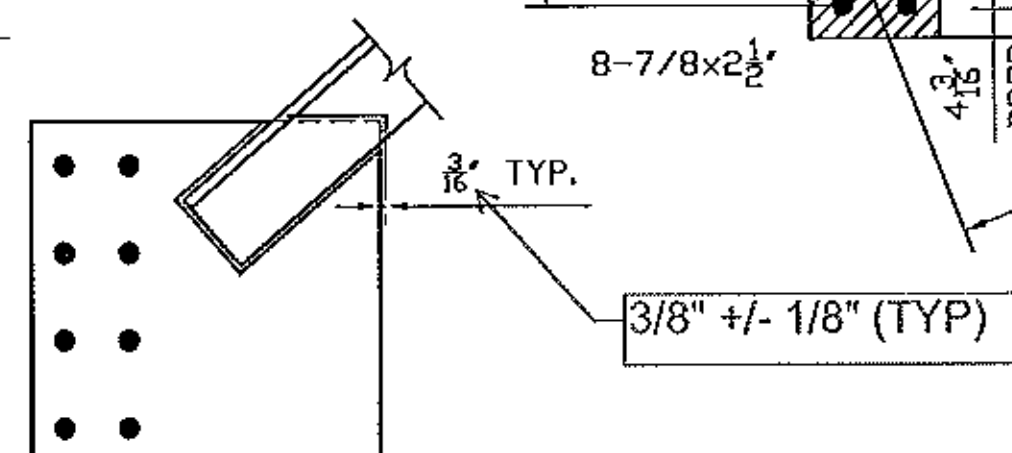


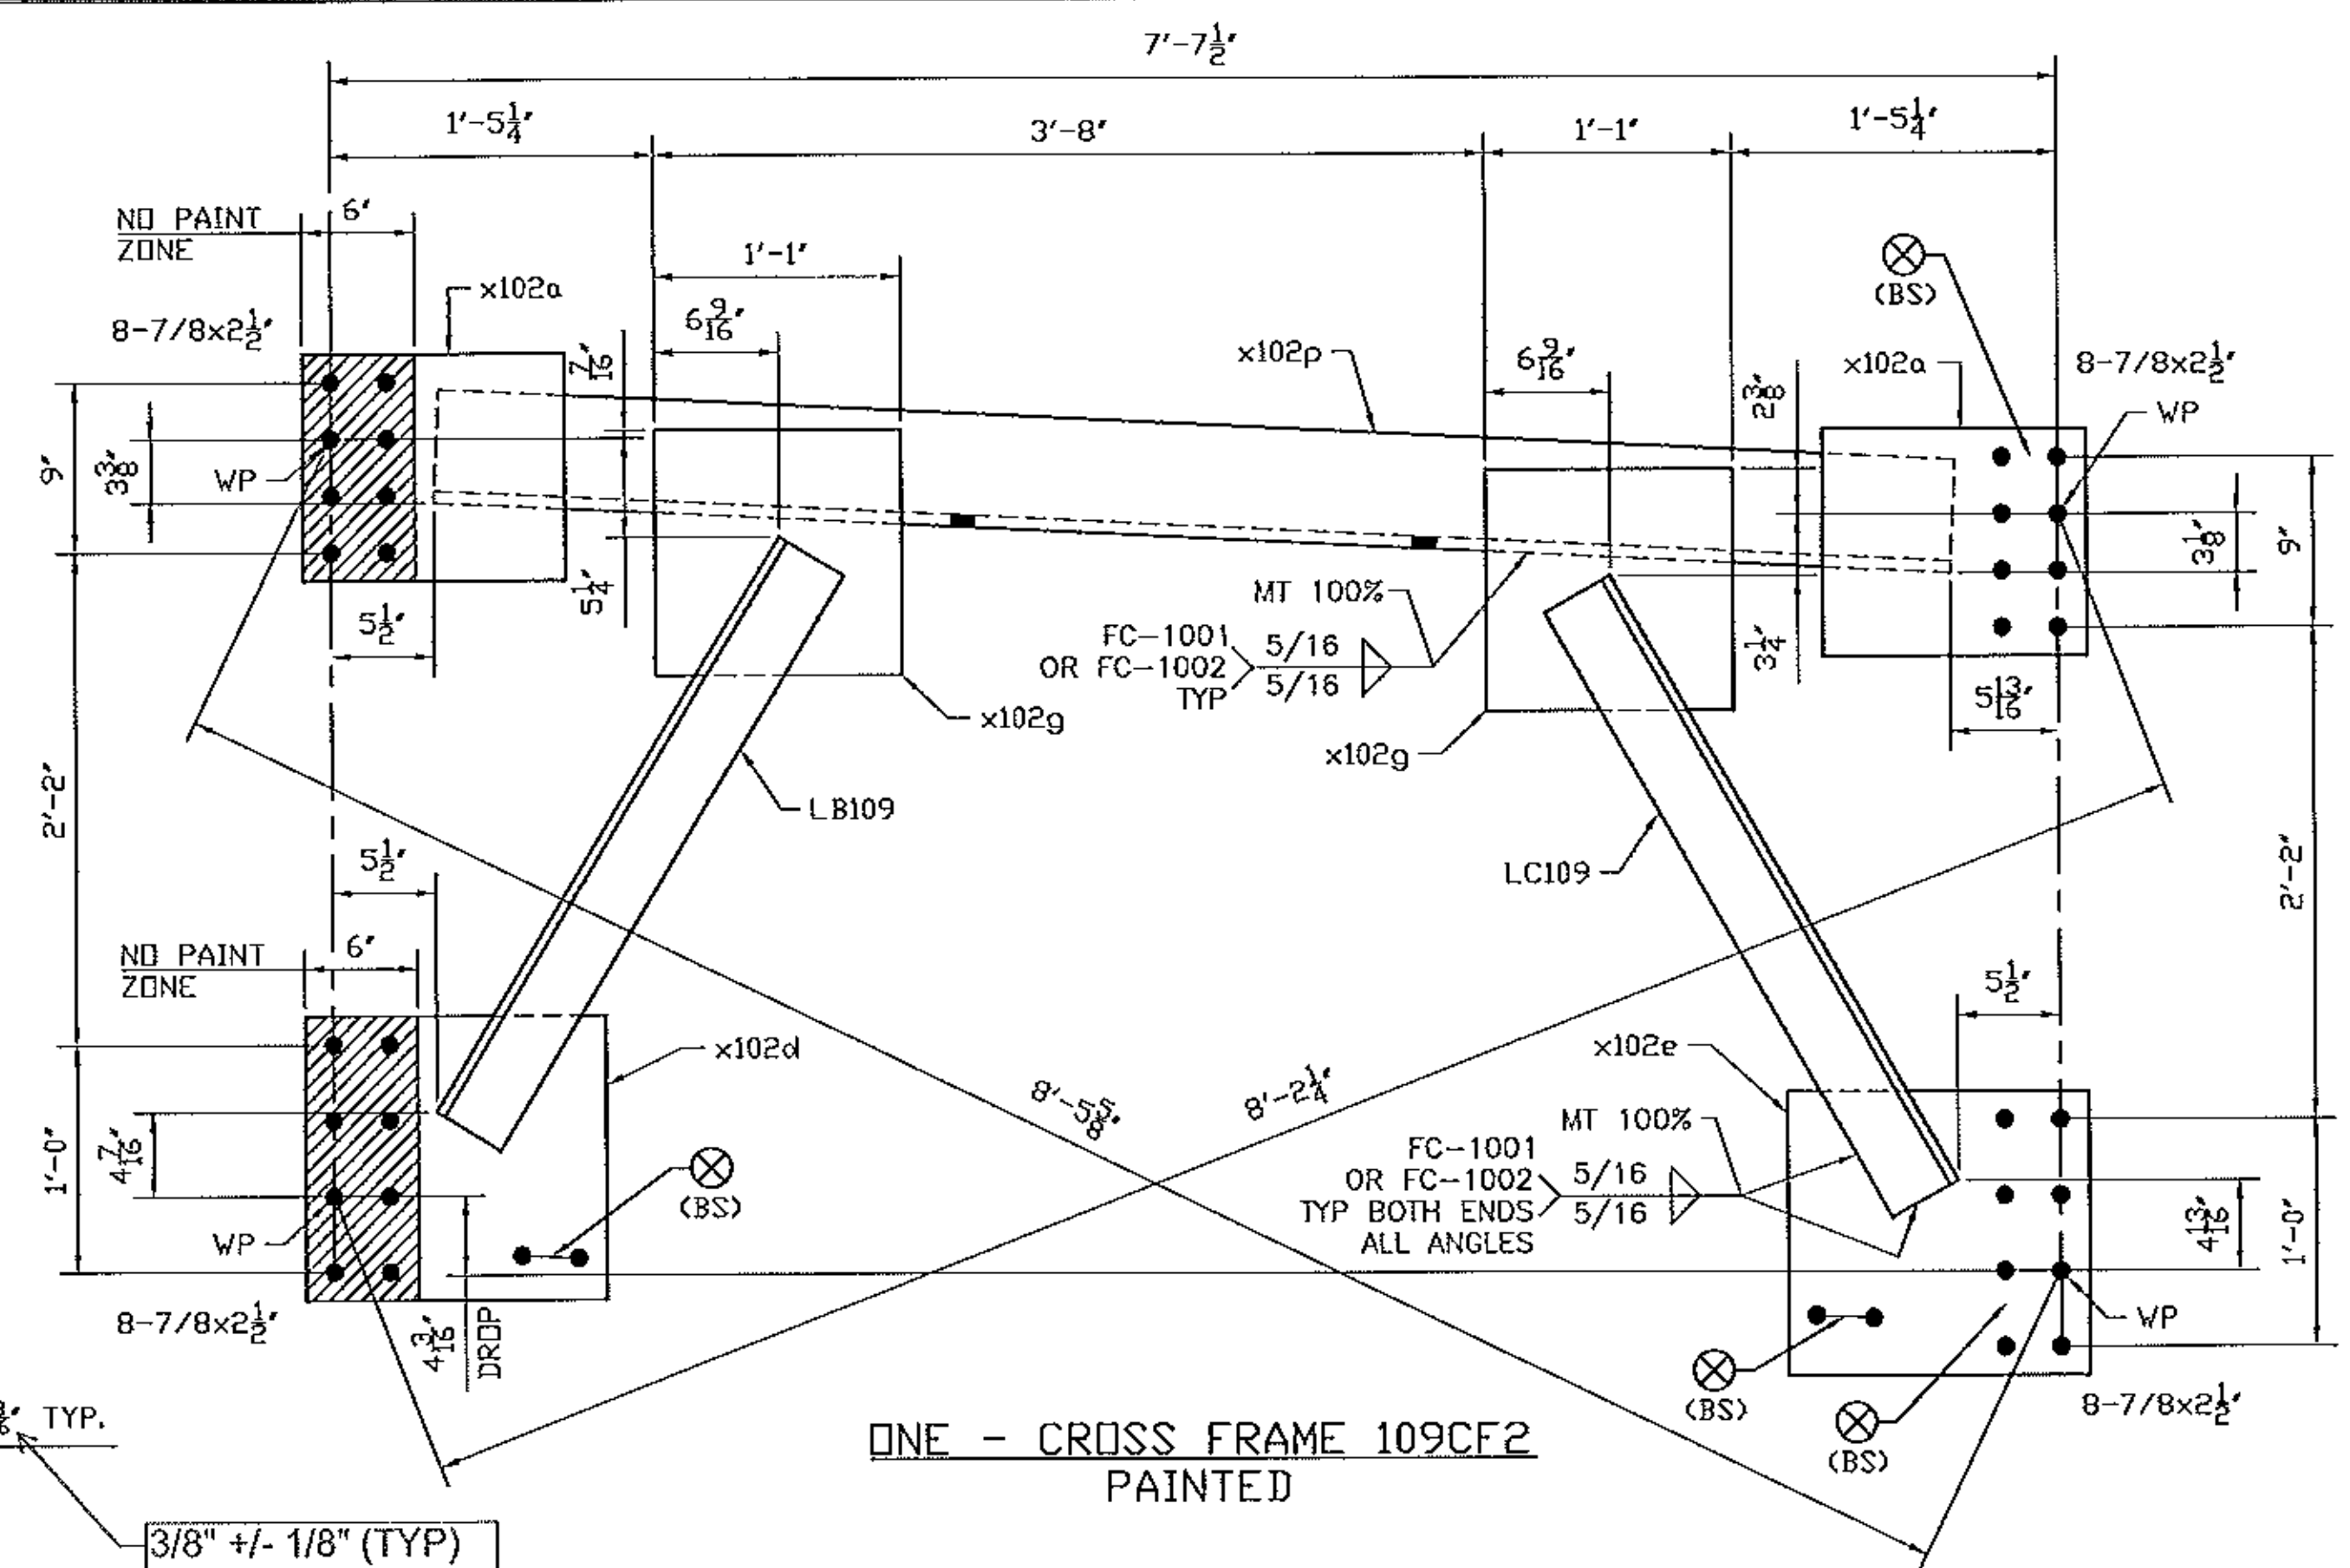

ONE - CROSS FRAME 109CF2
PAINTED

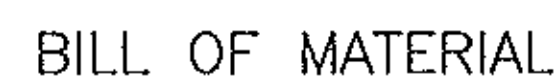

BILL OF MATERIAL

BILL OF MATERIAL									
Mark	Qty.	Description	Std	Length	Remark	ABM	Total	Seq	Qty
			Grd				Weight		/Sec
109CF1	4	CROSS FRAME				1611	1713	1	4
109CF1	4	CROSS FRAME		7-10 1/2					
LB109	4	L4x4x1/2	A70950W	2-11 3/8		105-6	151		
LC109	4	L4x4x1/2	A70950W	5-0 13/16		105-6	157		
x102a	8	PL1/2x12	A70950W	1-2		105-8	191		
x102d	4	PL1/2x15	A70950W	1-4		105-8	136		
x102e	4	PL1/2x15	A70950W	1-4		105-8	136		
x102g	8	PL1/2x13	A70950W	1-1		105-10	192		
x102p	4	L6x6x5/8	A70950W	6-8 5/16		105-2	648		
FB		FIELD BOLTS							
78F212	128	.7/8 Dia A325 TYP3		2 1/2	1FL WASH				
109CF1	ONE	CROSS FRAME				403	429		1
109CF1	1	CROSS FRAME		7-10 1/2	PAINT				
LB109	1	L4x4x1/2	A70950W	2-11 3/8		105-5	38		
LC109	1	L4x4x1/2	A70950W	5-0 13/16		105-5	39		
x102a	2	PL1/2x12	A70950W	1-2		105-7	48		
x102d	1	PL1/2x15	A70950W	1-4		105-7	34		
x102e	1	PL1/2x15	A70950W	1-4		105-7	34		
x102g	2	PL1/2x13	A70950W	1-1		105-9	48		
x102p	4	L6x6x5/8	A70950W	6-8 5/16		162	648		
FB		FIELD BOLTS							
78F212	32	.7/8 Dia A325 TYP3		2 1/2	1FL WASH				

RECEIVED

July 09, 2012

RESUBMIT APPROVED AS NOTED
BY C. CARLSON DATE 07-27-2012

△			
△			
△	FOR APPROVAL	07/06/12	BR EG
No	REVISION	DATE	PAR VER.

NOTE:	BOLT 1 WASHER:	1 WASHER UNDER NUT U.N.
	BOLT 2 WASHER:	1 WASHER UNDER HEAD U.N.
		1 WASHER UNDER HEAD U.N.



PROJECT: VT RT 9, BRIDGE NO. 11
TOWN OF WOODFORD, VT
OVER WALDOOMSAC RIVER

TITLE	CROSS FRAME AT WATERLINE
-------	--------------------------

REFERENCE: PROJECT NO. ER BHF 010-1 (44)

BUYING IN	BR	DATE	JULY 2012	CONTRACT NO	UN04260
ORDER IN	GG	DATE	JULY 2012	BUYING NO	109 