

SEE SHEET 2 FOR INDEX OF SHEETS  
AND LIST OF STANDARDS

# STATE OF VERMONT AGENCY OF TRANSPORTATION



## PROPOSED IMPROVEMENT BRIDGE PROJECT


TOWN OF WOODFORD  
COUNTY OF BENNINGTON

ROUTE NO : VT RT 9, PRINCIPAL ARTERIAL    BRIDGE NO : 11


PROJECT LOCATION : BEGINNING AT A POINT 1.206 MILES EAST OF THE BENNINGTON - WOODFORD TOWN LINE AND EXTENDING EASTERLY 0.038 MILES.

PROJECT DESCRIPTION : WORK TO BE PERFORMED UNDER THIS PROJECT INCLUDES REPAIR OF FLOOD DAMAGED BRIDGE NO. 11 WHICH IS OVER THE ROARING BRANCH OF THE WALLOOMSAC RIVER. REPLACEMENT OF STRUCTURAL STEEL, CONCRETE DECK, MUNICIPAL WATERLINE, ALONG WITH ASSOCIATED CHANNEL WORK AND NECESSARY APPROACH WORK, SUBBASE AND PAVEMENT, ALONG EXISTING ALIGNMENT.

LENGTH OF ROADWAY = 90.93 FEET    = 0.017 MI  
LENGTH OF BRIDGE    = 109.57 FEET    = 0.021 MI  
LENGTH OF PROJECT = 200.50 FEET    = 0.038 MI

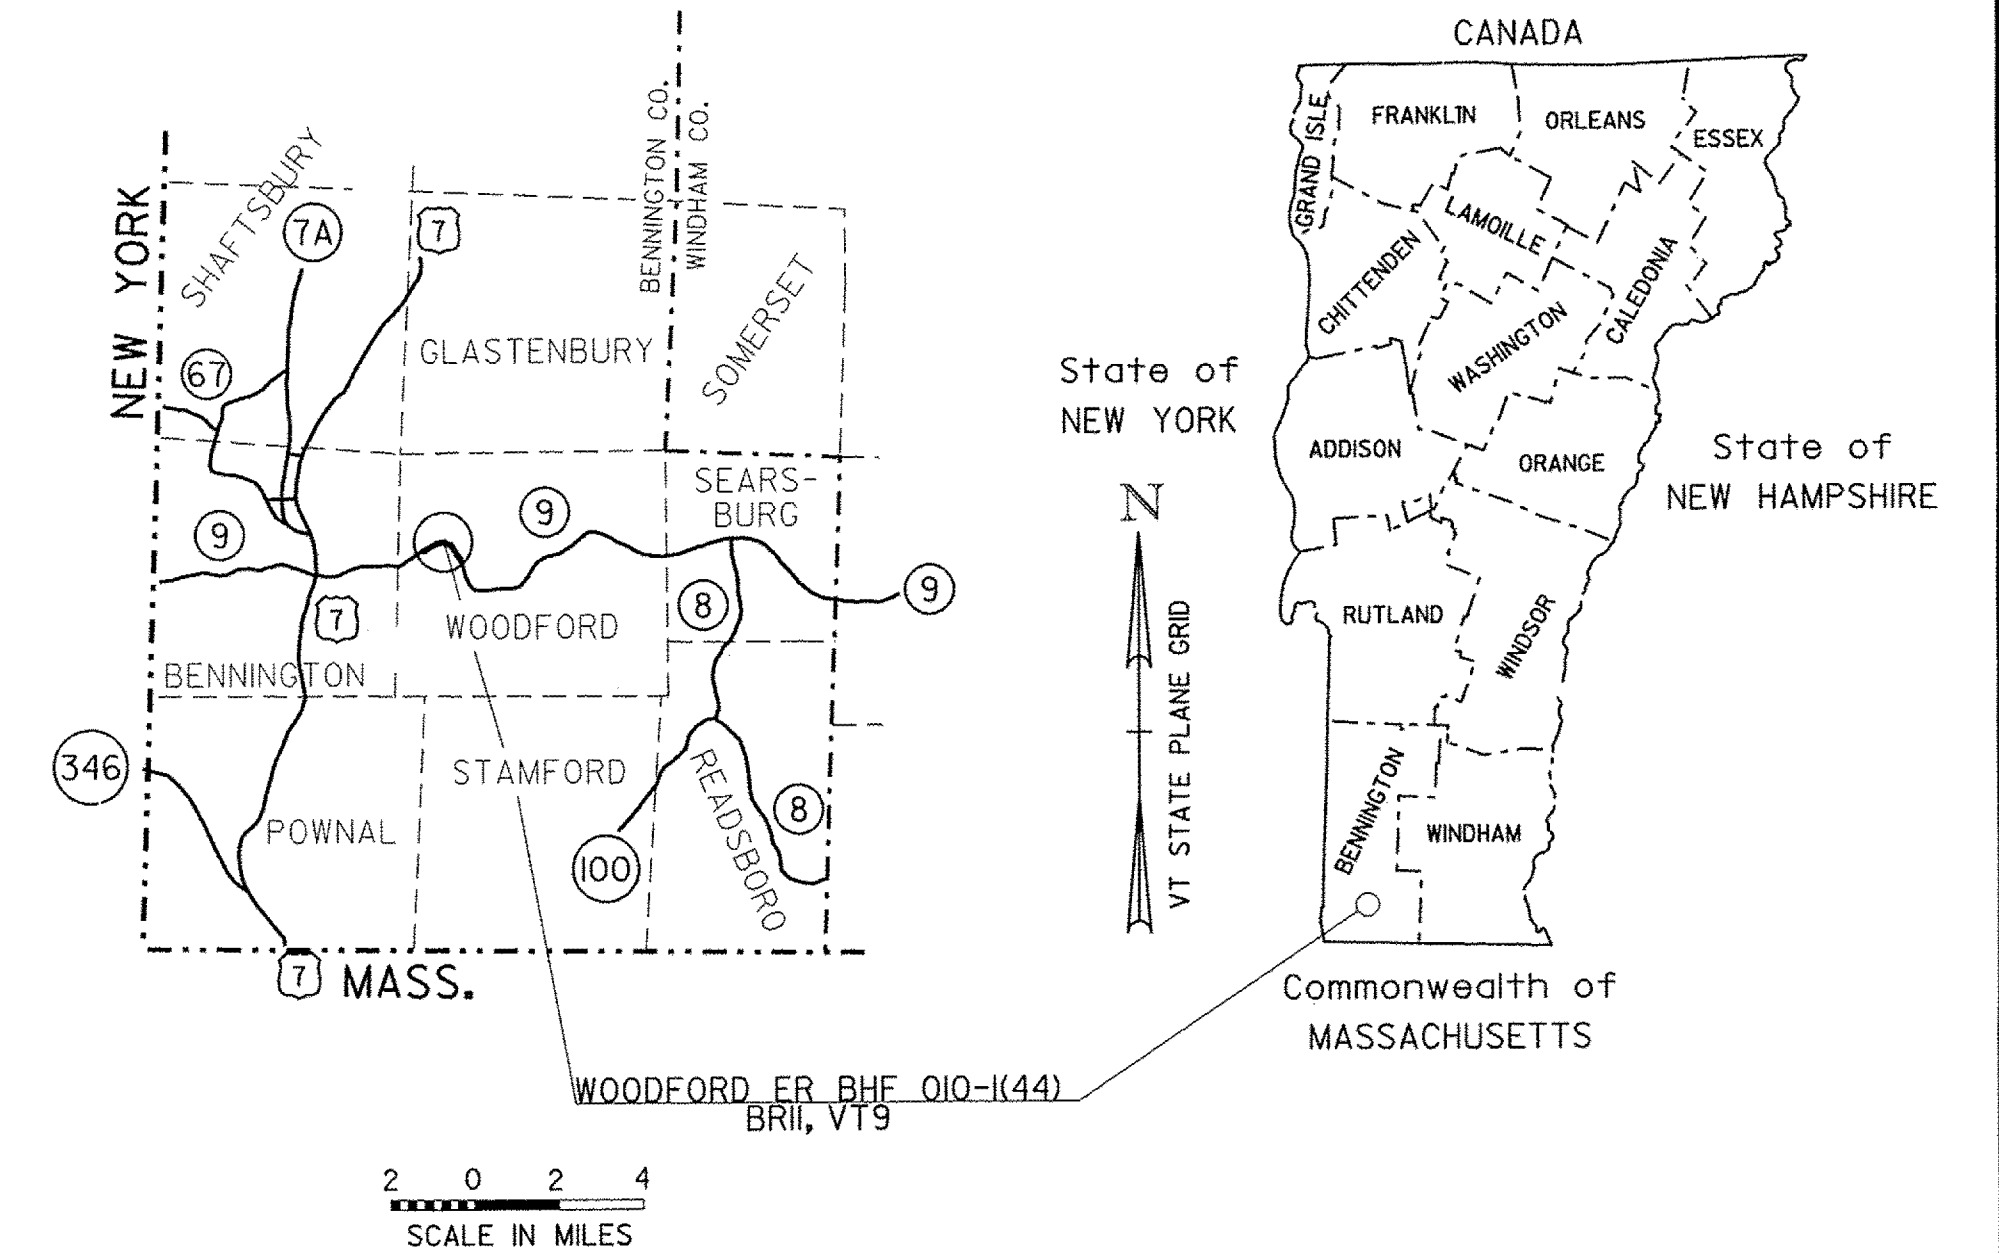

RECORD PLANS	
CONTRACTOR:	T. BUCK CONSTRUCTION, INC. - AUBURN, ME
RESIDENT ENGINEER:	RON LEMAIRE
CONSTRUCTION BEGAN:	JUNE 4, 2012
CONSTRUCTION COMPLETE:	JULY 18, 2013
RECORD PLANS BY:	RON LEMAIRE & JENNA HYDE
I HEREBY CERTIFY THAT ALL THE CONSTRUCTION REQUIRED BY THIS SET OF DRAWINGS HAS BEEN ACCOMPLISHED AS INDICATED HEREIN.	
BY:	RESIDENT ENGINEER
DATE: 01/14/15	
NOTE: Any further information concerning final quantities, amounts or other details relative to this project may be found at Central Files in the electronic archives.	

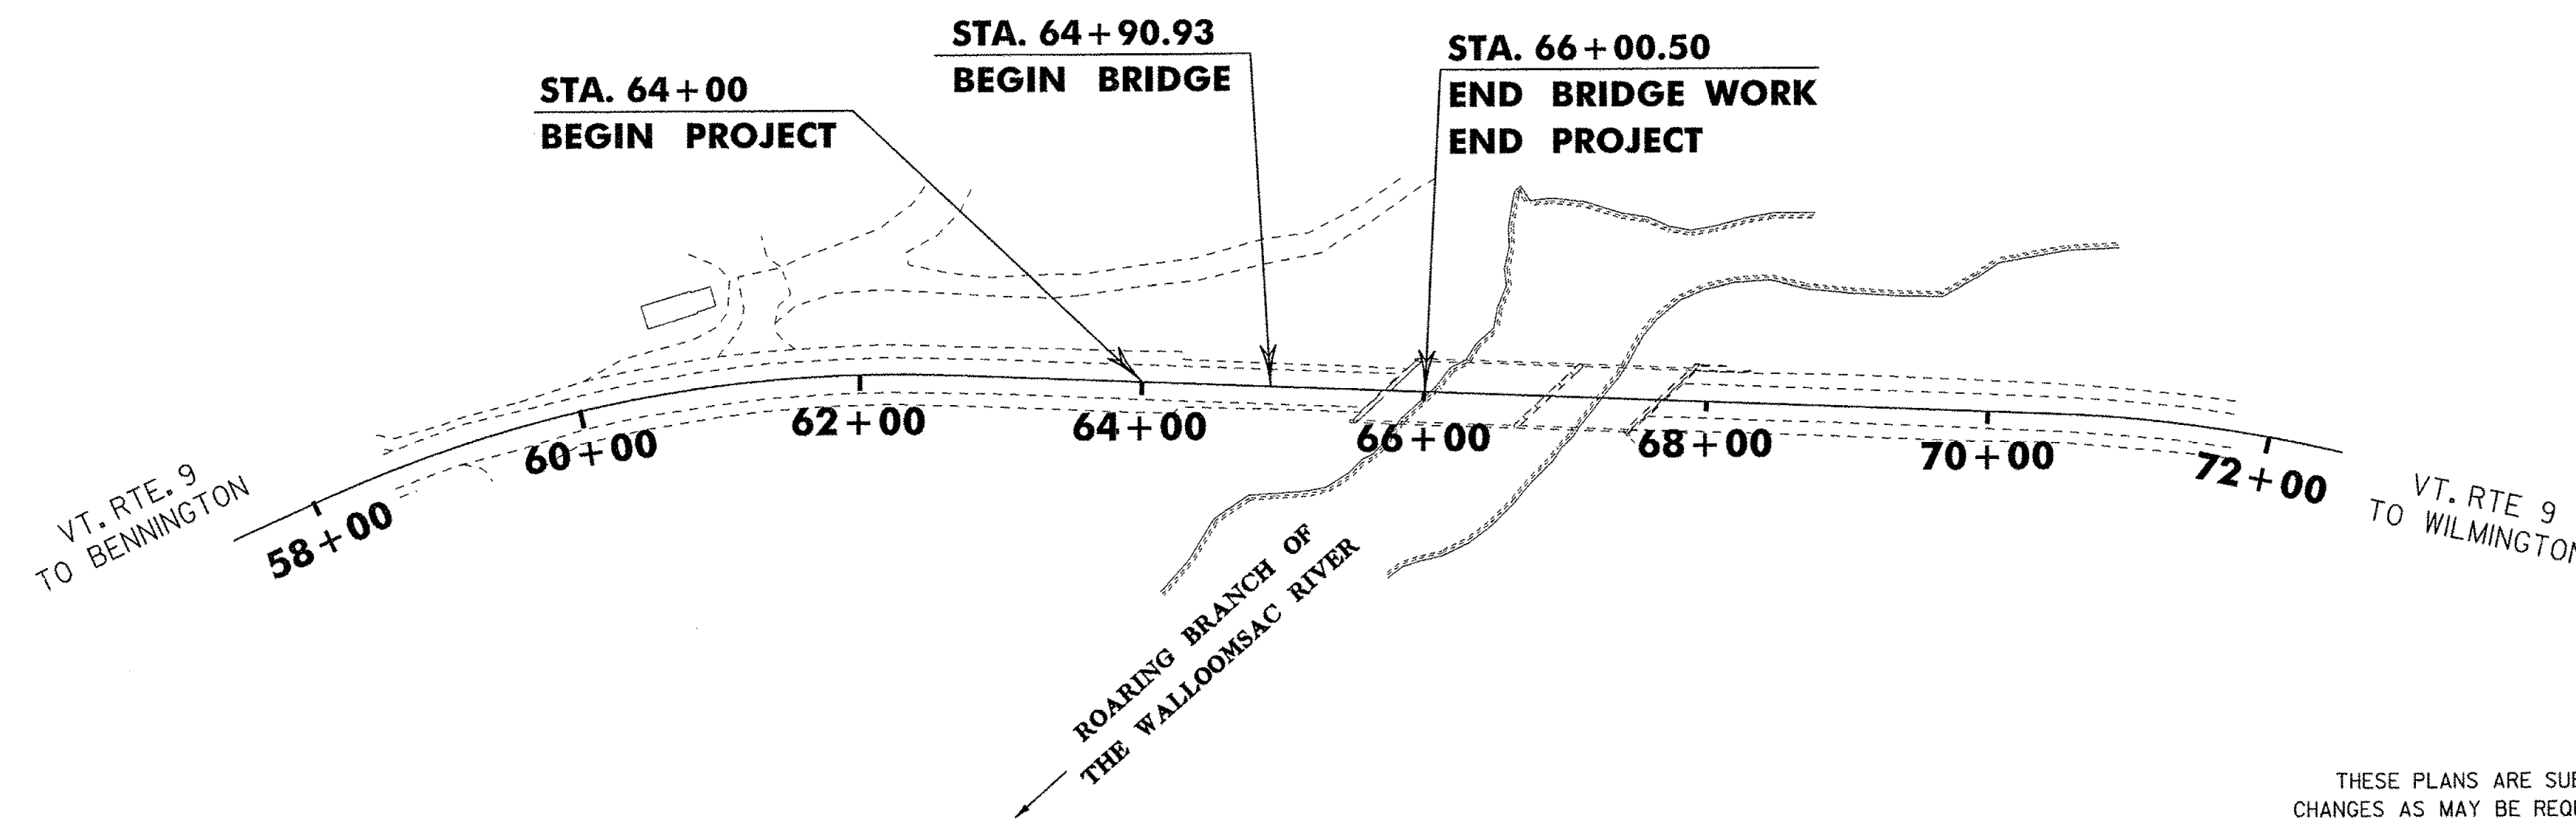


QUALITY ASSURANCE PROGRAM: LEVEL 1

CONVENTIONAL SYMBOLS	
COUNTY LINE	
TOWN LINE	
LIMITS OF ACCESS	
POINT OF ACCESS	
FENCE LINE	
STONE WALL	
TRAVELED WAY	
GUARD RAIL	
RAILROAD	
SURVEY LINE	
CULVERT	
POWER POLE	
TELEPHONE POLE	
TREES	
CONTROL OF ACCESS	
PROPERTY LINE	
R.O.W. TAKING LINE	
SLOPE RIGHTS	
TOP OF CUT	
TOE OF SLOPE	

SURVEYED BY : L. ORVIS  
SURVEYED DATE : 11/6/2011

DATUM  
VERTICAL    NAVD88  
HORIZONTAL    NAD83 (2007)

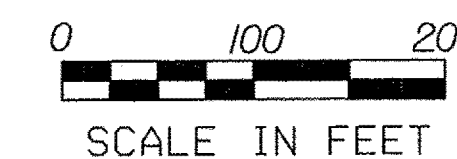

THESE PLANS ARE SUBJECT TO SUCH ENGINEERING CHANGES AS MAY BE REQUIRED BY THE FEDERAL HIGHWAY ADMINISTRATION OR THE DIRECTOR OF PROGRAM DEVELOPMENT.

CONSTRUCTION IS TO BE CARRIED ON IN ACCORDANCE WITH THESE PLANS AND THE STANDARD SPECIFICATIONS FOR CONSTRUCTION DATED 2011, AS APPROVED BY THE FEDERAL HIGHWAY ADMINISTRATION ON JULY 20, 2011 FOR USE ON THIS PROJECT, INCLUDING ALL SUBSEQUENT REVISIONS AND SUCH REVISED SPECIFICATIONS AND SPECIAL PROVISIONS AS ARE INCORPORATED IN THESE PLANS.

23-MAR-2012

DIRECTOR OF PROGRAM DEVELOPMENT	
APPROVED:	DATE: 3/22/12
PROJECT MANAGER : CAROLYN CARLSON	
PROJECT NAME :	<b>WOODFORD</b>
PROJECT NUMBER :	<b>ER BHF 010-1(44)</b>
SHEET 1 OF 58 SHEETS	

# PRELIMINARY INFORMATION SHEET (BRIDGE)

## INDEX OF SHEETS

## FINAL HYDRAULIC REPORT

### PLAN SHEETS

1	TITLE SHEET
2	PRELIMINARY INFORMATION SHEET
3	PROJECT NOTES
4 - 5	QUANTITY SHEETS
6	BRIDGE QUANTITY SHEET
7	PROJECT TYPICAL SECTIONS
8	EARTH/WORK SECTIONS
9	TIE SHEET
10 - 12	PLAN SHEETS
13 - 15	PROFILE SHEETS
16	BANKING DIAGRAM & MATERIAL TRANSITION
17	BORING INFORMATION SHEET
18	BORING LOGS
19	DECK TYPICAL SECTION
20	DECK PLAN
21	DECK FRAMING PLAN
22	GIRDER DETAILS
23	GIRDER SPLICE DETAILS
24	BAY ONE CROSSFRAME DETAILS
25	TYPICAL CROSSFRAME DETAILS
26	ABUTMENT 1 BEARING DETAILS
27	BRIDGE EXPANSION JOINT DETAILS
28	BRIDGE EXPANSION JOINT PLAN
29	DOWNSPOUT DETAILS
30	APPROACH SLAB DETAILS
31	ABUTMENT 1 PLAN
32	ABUTMENT 1 ELEVATION
33	ABUTMENT 1 FOOTING REINFORCING
34	WINGWALL DETAILS
35	REINFORCING STEEL SCHEDULE
36 - 39	ROADWAY CROSS SECTIONS SHEETS
40 - 43	CHANNEL CROSS SECTIONS SHEETS
44 - 46	R.O.W. PLAN SHEETS
47	EPSC NARRATIVE
48 - 50	EPSC EXISTING CONDITION SHEETS
51 - 53	EPSC CONSTRUCTION CONDITION SHEETS
54 - 56	EPSC FINAL CONDITION SHEETS
57 - 58	EPSC DETAILS

### STANDARDS LIST

C-10	CURBING	02-11-2008
E-100	CONSTRUCTION APPROACH SIGNS	01-02-2004
E-101	CONSTRUCTION SIGN DETAILS	05-30-2003
E-102	CONSTRUCTION SIGN DETAILS	06-30-2003
E-102a	CONSTRUCTION SIGN DETAILS	05-01-2004
E-106	TRAFFIC CONTROL - MISCELLANEOUS DETAILS	03-01-2004
E-107	DELINEATION, BARRICADES AND DETOURS FOR CONSTRUCTION AREAS	06-30-2003
E-107A	BREAKAWAY BARRICADE DETAILS	06-08-2009
E-108	CONSTRUCTION ZONE LONGITUDINAL DROP OFFS	06-08-2009
E-121	STANDARD SIGN PLACEMENT - CONVENTIONAL ROAD	08-08-1995
E-193	PAVEMENT MARKING DETAILS	08-18-1995
G-1	STEEL BEAM GUARDRAIL DETAILS (POST, DELINEATOR, TYPICALS)	01-03-2000
G-17A	MODIFIED ECCENTRIC LOADER TERMINAL (MELT)	09-27-2002
G-17B	MODIFIED ECCENTRIC LOADER TERMINAL (MELT)	09-27-2002
G-19	GENERIC GRADING PLANS FOR GUARDRAIL END TERMINALS	11-15-2002
S-360a	BRIDGE RAILING, GALVANIZED NETC 2 RAIL	12-14-2009
S-360b	GUARDRAIL APPROACH SECTION, GALVANIZED NETC 2 RAIL	12-14-2009
S-363	GUARDRAIL APPROACH SECTION, GALVANIZED NETC 2 & 4 RAIL	12-14-2009

### WATERLINE UTILITY SHEETS

C-101	WATER MAIN ON BRIDGE
C-501	WATERLINE DETAILS

### STRUCTURES DETAIL SHEETS

SD-501.000	CONCRETE DETAILS AND NOTES	05-07-2010
SD-502.00	CONCRETE DETAILS AND NOTES	06-04-2010
SD-601.00	STRUCTURAL STEEL DETAILS & NOTES	06-04-2010
SD-602.00	STRUCTURAL STEEL PLATE GIRDER DETAILS AND NOTES	05-02-2011

### HYDROLOGIC DATA

Date: Dec 2011

DRAINAGE AREA : 37.7 SQ MI  
 CHARACTER OF TERRAIN : HILLY TO MOUNTAINOUS, MOSTLY FORESTED  
 STREAM CHARACTERISTICS :  
 NATURE OF STREAMBED : WELL ARMORED - MEDIUM TO LARGE COBBLES & BOULDER

### PEAK FLOW DATA

Q 2.33 =	2400 CFS	Q 50 =	6000 CFS
Q 10 =	4000 CFS	Q 100 =	7000 CFS
Q 25 =	5000 CFS	Q 500 =	

DATE OF FLOOD OF RECORD : N/A  
 ESTIMATED DISCHARGE : N/A  
 WATER SURFACE ELEV. : N/A  
 NATURAL STREAM VELOCITY : @ Q50 = 12.9 fps  
 ICE CONDITIONS : LIGHT  
 DEBRIS : MODERATE  
 DOES THE STREAM REACH MAXIMUM HIGHWATER ELEV. RAPIDLY? YES  
 IS ORDINARY RISE RAPID? YES  
 IS STAGE AFFECTED BY UPSTREAM OR DOWNSTREAM CONDITIONS? NO  
 IF YES, DESCRIBE:

WATERSHED STORAGE : <1% HEADWATERS :  
 UNIFORM : X  
 IMMEDIATELY ABOVE SITE :

### EXISTING STRUCTURE INFORMATION

STRUCTURE TYPE : THREE SPAN CONTINUOUS PLATE GIRDER BRIDGE  
 YEAR BUILT : 2005  
 CLEAR SPAN(NORMAL TO STREAM) : 183 FT  
 VERTICAL CLEARANCE ABOVE STREAMBED : 10 FT  
 WATERWAY OF FULL OPENING : 2200 SQ FT  
 DISPOSITION OF STRUCTURE : REPAIR  
 TYPE OF MATERIAL UNDER SUBSTRUCTURE :

### WATER SURFACE ELEVATIONS AT:

Q2.33 =	1132.4 FT	VELOCITY =	10.4 FPS
Q10 =	1133.7 FT	"	10.6 FPS
Q25 =	1134.1 FT	"	11.4 FPS
Q50 =	1134.5 FT	"	12.1 FPS
Q100 =	1134.9 FT	"	12.7 FPS

LONG TERM STREAMBED CHANGES : Channel is highly unstable and subject to lateral shifting

IS THE ROADWAY OVERTOPPED BELOW Q100 : NO  
 FREQUENCY : N/A  
 RELIEF ELEVATION : N/A  
 DISCHARGE OVER ROAD @Q100 : N/A

### UPSTREAM STRUCTURE

TOWN : N/A DISTANCE :  
 HIGHWAY # : STRUCTURE # :  
 CLEAR SPAN : CLEAR HEIGHT :  
 YEAR BUILT : FULL WATERWAY :  
 STRUCTURE TYPE :

### DOWNSTREAM STRUCTURE

TOWN : Bennington DISTANCE : 1.7 MI  
 HIGHWAY # : VT 9 STRUCTURE # : 9  
 CLEAR SPAN : 209 FT CLEAR HEIGHT : 17'  
 YEAR BUILT : FULL WATERWAY :  
 STRUCTURE TYPE :

### LFD LOAD RATING (TONS)

STRESS LEVELS	TRUCK						
	H	HS	3S2	6AXLE	3A STR	4A STR	5A SEMI
INVENTORY	46	52					
POSTING	52	73	85		67	69	79
OPERATING		87	101	116			
COMMENTS:							

### PROPOSED STRUCTURE

STRUCTURE TYPE : THREE SPAN PLATE GIRDER BRIDGE  
 CLEAR SPAN(NORMAL TO STREAM) : 53' + 77' + 53' = 183 FT TOTAL  
 VERTICAL CLEARANCE ABOVE STREAMBED : 10 FT  
 WATERWAY OF FULL OPENING : 2200 SQ FT

### WATER SURFACE ELEVATIONS AT:

Q2.33 =	1132.4 FT	VELOCITY =	10.4 FPS
Q10 =	1133.7 FT	"	10.6 FPS
Q25 =	1134.1 FT	"	11.4 FPS
Q50 =	1134.5 FT	"	12.1 FPS
Q100 =	1134.9 FT	"	12.7 FPS

IS THE ROADWAY OVERTOPPED BELOW Q100 : NO  
 FREQUENCY : N/A  
 RELIEF ELEVATION : N/A  
 DISCHARGE OVER ROAD @Q100 : N/A

AVERAGE LOW ELEVATION OF SUPERSTRUCTURE : 1139.1 FT  
 VERTICAL CLEARANCE : @ Q100 = 4.2 FT

SCOUR : 1 FT

REQUIRED CHANNEL PROTECTION : STONE FILL, TYPE IV

### PERMIT INFORMATION

AVERAGE DAILY FLOW : 80 CFS DEPTH OR ELEVATION :  
 ORDINARY LOW WATER : 40 CFS DEPTH = 0.5 FT  
 ORDINARY HIGH WATER : 1150 CFS DEPTH = 3.0 FT

### TEMPORARY BRIDGE REQUIREMENTS

STRUCTURE TYPE : Single span structure  
 CLEAR SPAN (NORMAL TO STREAM) : 131' minimum clear span (normal to channel)  
 VERTICAL CLEARANCE ABOVE STREAMBED : Minimum low beam elev. 1140'  
 WATERWAY AREA OF FULL OPENING : 1315 SQ FT

### ADDITIONAL INFORMATION

HYDROLOGIC AND HYDRAULIC INFORMATION TAKEN FROM 2005 PLANS.  
 2011 SURVEY SHOWED SOME CHANGES IN CHANNEL, BUT LITTLE EFFECT ON NET CROSS SECTIONAL AREA.  
 2011 SURVEY DOES NOT REPRESENT A LONG TERM CONDITION OF THE CHANNEL.  
 1. MAINTAIN TWO-WAY TRAFFIC ON A TEMPORARY BRIDGE.  
 2. TRAFFIC SIGNALS ARE NOT NECESSARY.  
 3. SIDEWALKS ARE NOT NECESSARY  
 4. THE APPROACHES FOR THE TEMPORARY BRIDGE SHALL BE PAVED.

### DESIGN VALUES

1. DESIGN LIVE LOAD	HS-25
2. FUTURE PAVEMENT	d <sub>p</sub> : 0.0 INCH
3. ABUTMENT BEARING TO BEARING LENGTH (THREE SPANS)	L: 272.00 FT (79.00 - 114.00 - 79.00) FT
4. MIN. MID-SPAN POS. CAMBER @ RELEASE (PRESTRESSED UNITS)	Δ: ---
5. PRESTRESSING STRAND	f <sub>y</sub> : ---
6. PRESTRESSED CONCRETE STRENGTH	f' <sub>c</sub> : ---
7. PRESTRESSED CONCRETE RELEASE STRENGTH	f' <sub>cr</sub> : ---
8. CONCRETE, HIGH PERFORMANCE CLASS AA	f' <sub>c</sub> : ---
9. CONCRETE, HIGH PERFORMANCE CLASS A	f' <sub>c</sub> : 4.0 KSI
10. CONCRETE, HIGH PERFORMANCE CLASS B	f' <sub>c</sub> : 3.5 KSI
11. CONCRETE, CLASS C	f' <sub>c</sub> : ---
12. REINFORCING STEEL	f <sub>y</sub> : 60 KSI
13. STRUCTURAL STEEL AASHTO M270 (WEATHERING)	f <sub>y</sub> : 50 KSI
14. SOIL UNIT WEIGHT	γ: 0.140 KCF
15. NOMINAL BEARING RESISTANCE OF SOIL	q <sub>n</sub> : 4.0 KSF
16. SOIL BEARING RESISTANCE FACTOR (REFER TO AASHTO LRFD)	φ: ---
17. NOMINAL BEARING RESISTANCE OF ROCK	q <sub>n</sub> : ---
18. ROCK BEARING RESISTANCE FACTOR (REFER TO AASHTO LRFD)	φ: ---
19. NOMINAL AXIAL PILE RESISTANCE	q <sub>p</sub> : ---
20. PILE YIELD STRENGTH ASTM A572	f <sub>y</sub> : ---
21. PILE SIZE	---
22. EST. PILE LENGTH	L <sub>p</sub> : ---
23. PILE RESISTANCE FACTOR	φ: ---
24. LATERAL PILE DEFLECTION	Δ: ---
25. BASIC WIND SPEED	V <sub>30</sub> : ---
26. MINIMUM GROUND SNOW LOAD	p <sub>g</sub> : ---
27. SEISMIC DATA	PgA: --- S: --- S <sub>1</sub> : ---

PROJECT NAME : WOODFORD


PROJECT NUMBER : ER BHF 010-1(44)

FILE NAME : s11b214pi.dgn PLOT DATE : 3/23/2012  
 PROJECT LEADER : C. CARLSON DRAWN BY : G. ROY  
 DESIGNED BY : M. EVANS-MONGEON CHECKED BY : M. EVANS-MONGEON  
 PRELIMINARY INFORMATION SHEET SHEET 2 OF 58

### TRAFFIC DATA

YEAR	ADT	DHV	% D	% T	ADTT
2012	4000	620	56	10.7	500
2032	4300	660	56	13.1	660

### TEMPORARY BRIDGE PROFILE ALONG TEMP CL

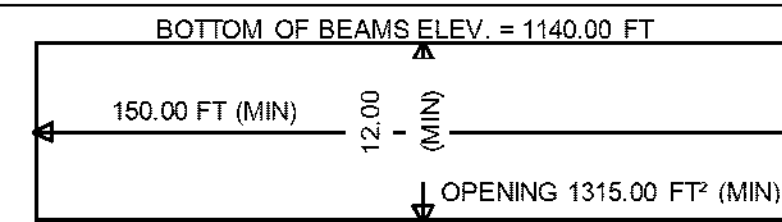

20 year ESAL for flexible pavement from 2012 to 2032 : 4789000

40 year ESAL for flexible pavement from 2012 to 2052 : 10386000

Design Speed : 50 mph

**GENERAL**

1. ALL MATERIALS AND CONSTRUCTION SHALL CONFORM TO THE STATE OF VERMONT AGENCY OF TRANSPORTATION STANDARD SPECIFICATIONS FOR CONSTRUCTION DATED 2011, AND ITS LATEST REVISIONS, AND THE AASHTO STANDARD SPECIFICATIONS FOR HIGHWAY BRIDGES, SIXTEENTH EDITION, AND ITS LATEST REVISIONS.
2. THE BRIDGE IS DESIGNED FOR HS 25 LIVE LOAD WITH NO ALLOWANCE FOR ADDITIONAL FUTURE PAVEMENT.
3. ALL DIMENSIONS ARE HORIZONTAL OR VERTICAL AND ARE GIVEN AT 68 DEGREES FAHRENHEIT UNLESS NOTED OTHERWISE.
4. THE CONTRACTOR SHALL USE EXTREME CARE WHILE WORKING AROUND THE EXISTING WATER LINE WHICH IS BURIED AT THE WEST END OF THE BRIDGE AND IN THE AREA UPSTREAM OF THE PORTION OF THE BRIDGE THAT IS TO BE REHABILITATED. ANY DAMAGE THAT IS INCURRED WILL BE REPAIRED OR REPLACED AT THE CONTRACTOR'S EXPENSE.
5. THE DETAILS AND DIMENSIONS ON THE PROJECT SPECIFIC PLAN AND DETAIL SHEETS SHALL TAKE PRECEDENCE OVER THE MORE GENERAL "STRUCTURES DETAIL SHEETS" PROVIDED IN THE PLAN SET.
6. TACK COAT: EMULSIFIED ASPHALT SHALL BE APPLIED AT A RATE OF 0.04 GAL/SY ON ALL COLD PLANED SURFACES AND BETWEEN SUCCESSIVE COURSES OF PAVEMENT, BOTH ON THE BRIDGE AND IN THE ROADWAY SECTION.
7. THE BRIDGE PLAQUE SHALL BE FURNISHED BY THE AGENCY OF TRANSPORTATION AND INSTALLED BY THE CONTRACTOR AS SHOWN ON SHEET SD-502.00. THE COST FOR THIS WORK SHALL BE INCLUDED IN THE UNIT PRICE BID FOR ITEM 501.34, CONCRETE, HIGH PERFORMANCE CLASS B.
8. ITEM 529.20 PARTIAL REMOVAL OF STRUCTURE IS FOR THE REMOVAL AND DISPOSAL OF A PORTION OF THE DECK AS SHOWN ON THE DECK PLAN SHEET AND ON THE FRAMING PLAN. THE PRICE BID SHALL INCLUDE THE COST FOR SALVAGING 3'-0" OF THE DECK REINFORCING, ALONG WITH CLEANING AND REPAIRING OF THAT STEEL AS NEEDED, IN ORDER TO SPLICE THAT REINFORCING STEEL TO THE NEW DECK REINFORCING STEEL.
9. THE REMOVAL OF THE BITUMINOUS CONCRETE PAVEMENT ON THE BRIDGE, IN THE AREA WHERE THE DECK IS TO BE REMOVED, SHALL BE PAID FOR UNDER ITEM 529.10, REMOVAL OF BRIDGE PAVEMENT.
10. HEIGHT OF FILL BEHIND THE ABUTMENT WILL BE LIMITED TO THE BRIDGE SEAT ELEVATION UNTIL THE DECK HAS BEEN PLACED AND THE CURING PERIOD IS COMPLETE.

**TRAFFIC MAINTENANCE DURING CONSTRUCTION**

11. TRAFFIC WILL BE MAINTAINED ON A TWO-WAY TEMPORARY BRIDGE TO BE PLACED UPSTREAM IF THE EXISTING BRIDGE.
12. THE DETOUR ALIGNMENT SHALL BE DESIGNED FOR A MINIMUM DESIGN SPEED OF 25 MPH. THE TEMPORARY DETOUR SHALL BE PAVED. ALL WORK ASSOCIATED WITH THE INSTALLATION AND REMOVAL OF THE TEMPORARY BRIDGE AND ITS APPROACHES, INCLUDING TEMPORARY TRAFFIC BARRIER, PAVEMENT, PAVEMENT MARKINGS, AND REMOVING AND RESETTING THE EXISTING GUARDRAIL (SEE PLAN SHEET (2) AND PLAN SHEET (3)) WILL BE INCLUDED IN THE UNIT PRICE BID FOR CONTRACT ITEM 528.11, "TWO-WAY TEMPORARY BRIDGE".
13. SIX TREES NEED TO BE REMOVED IN ORDER TO INSTALL THE TEMPORARY DETOUR (SEE PLAN SHEET (1)). PAYMENT FOR THE REMOVAL OF THESE TREES SHALL BE INCLUDED IN THE UNIT PRICE BID FOR ITEM 201.10, CLEARING AND GRUBBING INCLUDING INDIVIDUAL TREES AND STUMPS.
14. ADVISORY SIGNS SHALL BE POSTED IN ACCORDANCE WITH VAOT STANDARD E-107. PAYMENT FOR ALL AND OFF PROJECT SIGNING AND TRAFFIC CONTROL DEVICES, INCLUDING DRUMS AND BARRICADES, WILL BE PAID FOR UNDER CONTRACT ITEM 900.645 SPECIAL PROVISION (TRAFFIC CONTROL, ALL-INCLUSIVE).
15. LIMITS OF THE TEMPORARY DETOUR MUST BE WITHIN THE RIGHT-OF-WAY. SEE ROW SHEETS.
16. THE AREA DISTURBED BY THE TEMPORARY DETOUR SHALL BE SEEDED AND MULCHED AFTER ALL THE FILL IS REMOVED TO THE FINAL GROUND ELEVATION. THE COST OF THE SEED, FERTILIZER AND MULCH WILL BE PAID FOR UNDER THEIR RESPECTIVE ITEMS. ANY DAMAGE TO THE EXISTING PAVEMENT AS A RESULT OF THE TEMPORARY DETOUR SHALL BE REPAIRED TO THE ORIGINAL CONDITION AT THE CONTRACTOR'S EXPENSE.

**CONCRETE**

17. DEWATERING OF THE EXCAVATED AREA FOR THE SUBSTRUCTURE IS ANTICIPATED. PAYMENT FOR DESIGNING, CONSTRUCTING AND MAINTAINING A DEWATERING AREA SHALL BE CONSIDERED INCIDENTAL TO CONTRACT ITEM 204.25, STRUCTURE EXCAVATION.
18. ALL EXPOSED EDGES OF CONCRETE SHALL BE CHAMFERED 1 INCH BY 1 INCH.
19. JOINTS AND SCORE MARKS IN CONCRETE SHALL BE CONSTRUCTED AS INDICATED ON THE PLANS OR AS DIRECTED BY THE ENGINEER.
20. REINFORCING PLACEMENT TOLERANCES SHALL BE:
 

SPACING	± 1 INCH
CLEARANCE	± ¼ INCH
21. THE DECK, CURBS ON THE BRIDGE, AND THE PORTIONS OF ABUTMENT # 1 ABOVE THE CONSTRUCTION JOINT IN THE BACKWALL (SEE EXPANSION JOINT DETAILS), SHALL BE CONCRETE, HIGH PERFORMANCE CLASS A. ALL OTHER CONCRETE SHALL BE CONCRETE, HIGH PERFORMANCE CLASS B.
22. FOR BRIDGE DECK PLACEMENT, THE MAXIMUM TIME LIMIT FOR ANY COMBINATION OF PLACEMENTS DONE IN ANY ONE DAY SHALL BE EIGHT HOURS. THERE SHALL BE A MINIMUM OF 96 HOURS BETWEEN THE COMPLETION OF ONE DAY'S PLACEMENT AND THE BEGINNING OF OTHER ADJACENT PLACEMENT. ALL INDIVIDUAL DECK PLACEMENTS SHALL START FROM THE LOW END OF THE SECTION BEING PLACED.
23. NO CONCRETE IN THE ABUTMENTS OR WINGWALLS SHALL BE PLACED ABOVE THE BRIDGE SEAT CONSTRUCTION JOINT UNTIL THE GIRDERS HAVE BEEN PROFILED AND THE FINISHED GRADE OF THE DECK HAS BEEN DETERMINED.
24. SURFACES OF BRIDGE SEATS UNDER BEARING DEVICES SHALL BE LEVEL. ALL OTHER AREAS OF THE BRIDGE SEATS SHALL BE SLOPED AWAY FROM THE BEARING DEVICES AT A RATE OF 0.04 FT/FT. THE ENTIRE BRIDGE SEAT SURFACE SHALL BE GIVEN A MAGNESIUM FLOAT FINISH.
25. WATER REPELLENT, SILANE SHALL BE APPLIED TO ALL EXPOSED CONCRETE SURFACES EXCEPT THE UNDERSIDE OF THE DECK BETWEEN THE DRIP NOTCHES.
26. FLEMING BRACKETS OR SIMILAR FALSE WORK SHALL BE PLACED AT A MAXIMUM SPACING OF 4'-0" ALONG THE FASCIA GIRDERS. THE BRACKETS SHALL BEAR NEAR THE BOTTOM FLANGE AND IN NO CASE SHALL THEY BEAR ABOVE THE BOTTOM QUARTER OF THE WEB DEPTH.
27. ALL REINFORCING IN THE DECK, BRIDGE CURBS AND IN THE BACKWALL SHALL BE EPOXY COATED. EPOXY COATED REINFORCING STEEL IS DENOTED IN THE REINFORCING STEEL SCHEDULE WITH A PREFIX OF "E". ALL OTHER REINFORCING SHALL BE PLAIN REINFORCING.
28. ALL REINFORCING STEEL SHALL BE DETAILED AND FABRICATED IN ACCORDANCE WITH THE PROCEDURES AND TOLERANCES IN APPLICABLE PUBLICATIONS OF THE "CONCRETE REINFORCING STEEL INSTITUTE".
29. ALL EPOXY REINFORCING STEEL TO BE CUT IN THE FIELD SHALL BE SAW CUT AND THE EXPOSED ENDS TREATED WITH AN APPROVED TWO-PART EPOXY REPAIR MATERIAL.
30. MINIMUM CLEAR COVER FOR REINFORCING STEEL SHALL BE AS FOLLOWS:
 

ALONG BACK FACES OF WALLS AGAINST EARTH:	2 INCHES
ALONG TOP SURFACE OF DECK SLAB:	2.5 INCHES
ALONG BOTTOM SURFACE OF DECK SLAB:	1.5 INCHES
ELSEWHERE UNLESS OTHERWISE INDICATED:	3 INCHES

**STRUCTURAL STEEL**

31. THE COST FOR CUTTING THE EXISTING STEEL AND FIELD DRILLING THE HOLES IN THE EXISTING STEEL, FOR THE NEW FIELD SPLICE WILL BE CONSIDERED INCIDENTAL TO THE UNIT PRICE BID FOR CONTRACT ITEM 506.55, STRUCTURAL STEEL PLATE GIRDER. THE COST FOR FIELD DRILLING THE HOLES NEEDED TO ATTACH THE WATER MAIN SUPPORTS TO INTERMEDIATE CROSS FRAMES AND TO THE INTERMEDIATE WATER LINE SUPPORTS SHALL BE CONSIDERED INCIDENTAL TO THE UNIT PRICE BID FOR ITEM 900.645 SPECIAL PROVISION (WATER MAIN ON BRIDGE) (16") (CL 52).
32. UNLESS OTHERWISE NOTED, ALL NEW STRUCTURAL STEEL SHALL CONFORM TO AASHTO M270M/M270 GRADE 50W AND SHALL BE PAID FOR UNDER ITEM 506.55, STRUCTURAL STEEL, PLATE GIRDER. THE STRUCTURAL STEEL FOR THE DOWNSPOUT AND HARDWARE SHALL BE AS SPECIFIED ON DOWNSPOUT DETAILS SHEET AND SHALL ALSO BE PAID FOR UNDER ITEM 506.55, STRUCTURAL STEEL, PLATE GIRDER.
33. CHARPY V-NOTCH TEST: TEST STRUCTURAL STEEL MEMBERS DESIGNATED "CVN" IN THE PLANS IN ACCORDANCE WITH SUBSECTION 714.01.

34. THE WESTERN ENDS OF ALL SIX GIRDERS SHALL BE PAINTED FOR A DISTANCE OF 10 FEET FROM THE CENTERLINE OF BEARING AT ABUTMENT 1. ALL CROSS-FRAMES, DIAPHRAGMS AND CONNECTION OR STIFFENER PLATES IN THIS AREA SHALL ALSO BE PAINTED. THE FINAL COLOR SHALL BE BROWN IN CONFORMANCE WITH SUBSECTION 708.03 OF THE STANDARD SPECIFICATIONS. BROWN GREASE, CONFORMING TO SUBSECTION 708.04 SHALL BE APPLIED TO ALL PAINTED AREAS. PAYMENT WILL BE MADE UNDER ITEM 900.645 SPECIAL PROVISION (QC/QA CLEANING AND PAINTING STRUCTURAL COMPONENTS).
35. THE ENDS OF THE GIRDERS SHALL BE VERTICAL UNDER FULL DEAD LOAD.
36. ANY CONNECTIONS THAT ARE NOT DETAILED ON THE PLANS SHALL BE DETAILED BY THE FABRICATOR AND SUBMITTED TO THE ENGINEER FOR APPROVAL.
37. ANY HOLES IN THE WEBS OF THE FASCIA GIRDERS THAT ARE NOT OTHERWISE FILLED WILL BE FILLED WITH EITHER BUTTON HEAD OR HEX HEAD BOLTS, WHICH SHALL BE TIGHTENED AS PER SUBSECTION 506.19.
38. ALL FIELD CONNECTIONS SHALL BE MADE USING 7/8" DIAMETER, AASHTO M164M/M164 BOLTS IN 15/16" HOLES UNLESS OTHERWISE NOTED.
39. AFTER THE GIRDERS HAVE BEEN ERECTED, ELEVATIONS SHALL BE TAKEN ALONG THE TOPS OF THE GIRDERS, AS DIRECTED BY THE ENGINEER, FOR USE IN DETERMINING THE FINAL GRADE.

**STONE FILL**

40. THE STONE FILL, TYPE IV SHALL BE PLACED IN FRONT OF THE ABUTMENT AND AROUND PIER 1 BEFORE THE STRUCTURAL STEEL HAS BEEN SET.

**WATER LINE**

41. ANY DAMAGE TO THE EXISTING ROADWAY INCURRED DURING THE RELOCATION OF THE EXISTING WATER MAIN SHALL BE REPAIRED TO THE ORIGINAL CONDITION. THIS WORK SHALL BE INCIDENTAL TO ITEM 900.645 SPECIAL PROVISION (WATER MAIN ON BRIDGE)(16") (CL52).
42. THE DESIGN AND INSTALLATION OF A TEMPORARY WATER MAIN SYSTEM WILL BE THE RESPONSIBILITY OF THE CONTRACTOR AND SHALL BE DONE IN ACCORDANCE TO THE PLANS AND TO SECTION 629. THE SYSTEM SHALL MAINTAIN THE SAME DESIGN FLOWS AS THE EXISTING SYSTEM. PAYMENT FOR THE TEMPORARY WATER MAIN AND ANY PIPES, FITTINGS, ATTACHMENTS, TESTING AND EXCAVATION REQUIRED TO BUILD A COMPLETE, FUNCTIONAL SYSTEM TO THE SATISFACTION OF THE ENGINEER SHALL BE INCLUDED IN THE COST FOR CONTRACT ITEM 900.645 SPECIAL PROVISION (MAINTENANCE OF EXISTING FLOWS).
43. THE WATER MAIN THAT IS CURRENTLY IN USE, WHICH CONNECTS TO THE WATER MAIN ON THE BRIDGE AT APPROXIMATELY STA. 66+24 AND IS BURIED BETWEEN STA. 64+65 AND 66+10, SHALL REMAIN IN PLACE UNTIL SOME OTHER METHOD OF MAINTAINING THE WATER FLOW HAS BEEN ESTABLISHED. WHEN THIS MAIN IS NO LONGER NECESSARY, IT SHALL BE REMOVED. THE REMOVED MATERIAL SHALL BECOME THE PROPERTY OF THE CONTRACTOR. PAYMENT FOR THIS WORK WILL BE CONSIDERED INCIDENTAL TO ITEM 900.645 SPECIAL PROVISION (WATER MAIN ON BRIDGE) (16") (CL 52).

PROJECT NAME: WOODFORD	
PROJECT NUMBER: ER BHF 010-1(44)	
FILE NAME: slb214gennote.dgn	PLOT DATE: 23-MAR-2012
PROJECT LEADER: C. CARLSON	DRAWN BY: M.EVANS-MONGE
DESIGNED BY: M.EVANS-MONGEON	CHECKED BY: C.CARLSON
PROJECT NOTES	SHEET 3 OF 58

# QUANTITY SHEET 1

SUMMARY OF ESTIMATED QUANTITIES										TOTALS		DESCRIPTIONS				DETAILED SUMMARY OF QUANTITIES		
					ROADWAY	EROSION CONTROL	UTIL. (NON-PARTIC.)	BRIDGE	FULL C.E. ITEMS	GRAND TOTAL	FINAL	UNIT	ITEMS	ITEM NUMBER	ROUND	QUANTITIES	UNIT	ITEMS
					1					1		LS	CLEARING AND GRUBBING, INCLUDING INDIVIDUAL TREES AND STUMPS	201.10				
					1170					1170		CY	COMMON EXCAVATION	203.15	6.26			
					830			7730		8560		CY	UNCLASSIFIED CHANNEL EXCAVATION	203.27	9.95			
					1					1		CY	TRENCH EXCAVATION OF EARTH, EXPLORATORY (N.A.B.I.)	204.22				
								2020		2020		CY	STRUCTURE EXCAVATION	204.25	1.4			
								1300		1300		CY	GRANULAR BACKFILL FOR STRUCTURES	204.30	2.96			
					476			121		597		SY	COLD PLANING, BITUMINOUS PAVEMENT	210.10	1.4			
					830					830		CY	SUBBASE OF CRUSHED GRAVEL, COARSE GRADED	301.25	7.28			
					2.3			1.7		4		CWT	EMULSIFIED ASPHALT	404.65	0.14			
					1					1		LU	PRICE ADJUSTMENT, ASPHALT CEMENT (N.A.B.I.)	406.50				
								159		159		CY	CONCRETE, HIGH PERFORMANCE CLASS A	501.33	1.08			
								553		553		CY	CONCRETE, HIGH PERFORMANCE CLASS B	501.34	1.61			
								114010		114010		LB	STRUCTURAL STEEL, PLATE GIRDER	506.55	8.16			
								82170		82170		LB	REINFORCING STEEL, LEVEL I	507.11	1.64			
								1		1		LS	SHEAR CONNECTORS (1400 - 7/8" X 7")	508.15				
								20		20		GAL	WATER REPELLENT, SILANE	514.10	2.79			
								67		67		LF	BRIDGE EXPANSION JOINT, VERMONT	516.11				
								528		528		SY	SHEET MEMBRANE WATERPROOFING, TORCH APPLIED	519.20	0.34			
								240		240		LF	BRIDGE RAILING, GALVANIZED 2 RAIL BOX BEAM	525.33				
					1					1		LS	TWO-WAY TEMPORARY BRIDGE (3600 SF - EST.)	528.11				
								150		150		SY	REMOVAL OF BRIDGE PAVEMENT	529.10	7.34			
								1		1		EACH	PARTIAL REMOVAL OF STRUCTURE	529.20				
								6		6		EACH	BEARING DEVICE ASSEMBLY, STEEL REINFORCED ELASTOMERIC PAD	531.17				
					590			2660		3250		CY	STONE FILL, TYPE IV	613.13	0.23			
					80					80		LF	CAST-IN-PLACE CONCRETE CURB, TYPE B	616.28				
					75					75		LF	STEEL BEAM GUARDRAIL, GALVANIZED	621.20	1.8			
					1					1		EACH	MANUFACTURED TERMINAL SECTION, FLARED	621.50				
					2					2		EACH	GUARDRAIL APPROACH SECTION, GALVANIZED 2 RAIL BOX BEAM	621.72				
					1600					1600		HR	FLAGGERS	630.15				
									1	1		LS	FIELD OFFICE, ENGINEERS	631.10				
									1	1		LS	TESTING EQUIPMENT, CONCRETE	631.16				
									1	1		LS	TESTING EQUIPMENT, BITUMINOUS	631.17				
									800	800		DL	FIELD OFFICE TELEPHONE (N.A.B.I.)	631.26				
					1					1		LS	MOBILIZATION/DEMobilIZATION	635.11				
					811					811		LF	4 INCH WHITE LINE	646.20				
					811					811		LF	4 INCH YELLOW LINE	646.21				
					530			2070		2600		SY	GEOTEXTILE UNDER STONE FILL	649.31	2.69			
						100				100		SY	GEOTEXTILE FOR SILT FENCE	649.51	9.9			
						210				210		SY	GEOTEXTILE FOR SILT FENCE, WOVEN WIRE REINFORCED	649.515	5.8			
						220				220		SY	GEOTEXTILE FOR FILTER CURTAIN	649.61	1			


PROJECT NAME: **WOODFORD**  
PROJECT NUMBER: **ER BHF 010 -1 (44)**  
FILE NAME: s11b214\_qs.xls PLOT DATE: 03/23/2012  
PROJECT LEADER: C. CARLSON DRAWN BY: G. ROY  
DESIGNED BY: EVANS-MONGEON CHECKED BY: EVANS-MONGEON  
QUANTITY SHEET #1 SHEET 4 OF 58

# QUANTITY SHEET 2

SUMMARY OF ESTIMATED QUANTITIES										TOTALS		DESCRIPTIONS				DETAILED SUMMARY OF QUANTITIES		
					ROADWAY	EROSION CONTROL	UTIL. (NON-PARTIC.)	BRIDGE	FULL C.E. ITEMS	GRAND TOTAL	FINAL	UNIT	ITEMS	ITEM NUMBER	ROUND	QUANTITIES	UNIT	ITEMS
						50				50		LB	SEED	651.15	8			
						350				350		LB	FERTILIZER	651.18				
						1.4				1.4		TON	AGRICULTURAL LIMESTONE	651.20				
						1.4				1.4		TON	HAY MULCH	651.25				
						130				130		CY	TOPSOIL	651.35	2.3			
						1210				1210		SY	GRUBBING MATERIAL	651.40	9.31			
						1				1		LS	EPSC PLAN	652.10				
						70				70		HR	MONITORING EPSC PLAN	652.20				
						1				1		LU	MAINTENANCE OF EPSC PLAN (N.A.B.I.)	652.30				
						1190				1190		SY	TEMPORARY EROSION MATTING	653.20	6.11			
						30				30		CY	VEHICLE TRACKING PAD	653.35				
						400				400		LF	BARRIER FENCE	653.50	1.2			
						1130				1130		LF	PROJECT DEMARCATION FENCE	653.55	2.6			
					1					1		LU	PRICE ADJUSTMENT, FUEL (N.A.B.I.)	690.50				
							1			1		LS	SPECIAL PROVISION (MAINTENANCE OF EXISTING FLOWS)	900.645				
								1		1		LS	SPECIAL PROVISION (QC/QA CLEANING AND PAINTING STRUCTURAL COMPONENTS)	900.645				
					1					1		LS	SPECIAL PROVISION (TRAFFIC CONTROL, ALL-INCLUSIVE)	900.645				
							1			1		LS	SPECIAL PROVISION (WATER MAIN ON BRIDGE)(16"XCL 52)	900.645				
					1					1		LU	SPECIAL PROVISION (MAT DENSITY PAY ADJUSTMENT SMALL QUANTITY) (N.A.B.I.)	900.650				
					1					1		LU	SPECIAL PROVISION (MIXTURE PAY ADJUSTMENT) (N.A.B.I.)	900.650				
					349			110		459		TON	SPECIAL PROVISION (BITUMINOUS CONCRETE PAVEMENT, SMALL QUANTITY)	900.680	1.15			

# BRIDGE QUANTITY SHEET 1

SUMMARY OF BRIDGE QUANTITIES										TOTALS		DESCRIPTIONS			DETAILED SUMMARY OF QUANTITIES		
							CHANNEL	SUPER-STRUCTURE	APPROACH SLAB	ABUTMENT 1	BRIDGE TOTAL	UNIT	ITEMS	ITEM NUMBER	QUANTITIES	UNIT	ITEMS
							7730				7730	CY	UNCLASSIFIED CHANNEL EXCAVATION	203.27			
										2020	2020	CY	STRUCTURE EXCAVATION	204.25			
										1300	1300	CY	GRANULAR BACKFILL FOR STRUCTURES	204.30			
								121			121	SY	COLD PLANING, BITUMINOUS PAVEMENT	210.10			
							1.4		0.3		1.7	CWT	EMULSIFIED ASPHALT	404.65			
							155			4	159	CY	CONCRETE, HIGH PERFORMANCE CLASS A	501.33			
									54	499	553	CY	CONCRETE, HIGH PERFORMANCE CLASS B	501.34			
							114010				114010	LB	STRUCTURAL STEEL, PLATE GIRDER	506.55			
							37810		7010	37350	82170	LB	REINFORCING STEEL, LEVEL I	507.11			
							1				1	LS	SHEAR CONNECTORS (1400 - 7/8" X 7")	508.15			
							10			10	20	GAL	WATER REPELLENT, SILANE	514.10			
							67				67	LF	BRIDGE EXPANSION JOINT, VERMONT	516.11			
							528				528	SY	SHEET MEMBRANE WATERPROOFING, TORCH APPLIED	519.20			
							240				240	LF	BRIDGE RAILING, GALVANIZED 2 RAIL BOX BEAM	525.33			
							150				150	SY	REMOVAL OF BRIDGE PAVEMENT	529.10			
							1				1	EACH	PARTIAL REMOVAL OF STRUCTURE	529.20			
										6	6	EACH	BEARING DEVICE ASSEMBLY, STEEL REINFORCED ELASTOMERIC PAD	531.17			
							2660				2660	CY	STONE FILL, TYPE IV	613.13			
							2070				2070	SY	GEOTEXTILE UNDER STONE FILL	649.31			
							1				1	LS	SPECIAL PROVISION (QC/QA CLEANING AND PAINTING STRUCTURAL COMPONENTS)	900.645			
							91		19		110	TON	SPECIAL PROVISION (BITUMINOUS CONCRETE PAVEMENT, SMALL QUANTITY)	900.680			

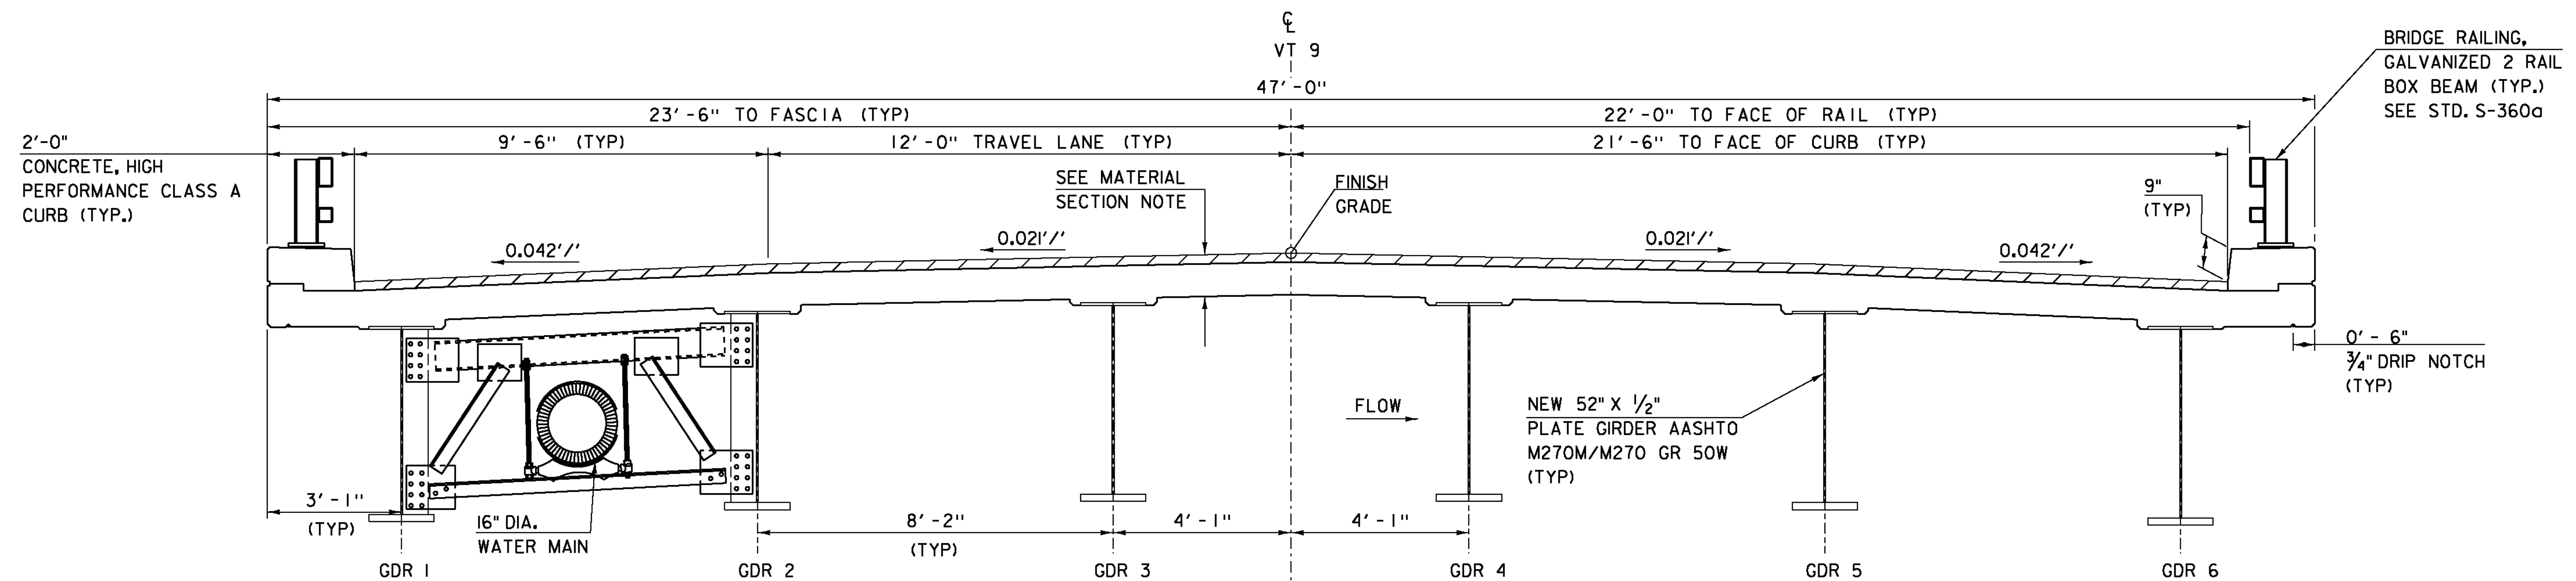


NEW BRIDGE TYPICAL SECTION

SCALE 1/2" = 1'-0"

**MATERIAL SECTION**

- 1 1/2" TYPE IVS SPECIAL PROVISION, (BITUMINOUS CONCRETE PAVEMENT, SMALL QUANTITY)
- 1 1/4" TYPE IVS SPECIAL PROVISION, (BITUMINOUS CONCRETE PAVEMENT, SMALL QUANTITY)
- SHEET MEMBRANE WATERPROOFING, TORCH APPLIED
- 8 1/2" DECK CONCRETE, HIGH PERFORMANCE CLASS A

TACK COAT: EMULSIFIED ASPHALT SHALL BE APPLIED AT THE RATE OF 0.040 GAL / SY BETWEEN SUCCESSIVE COARSE OF PAVEMENT AS DIRECTED BY THE ENGINEER.

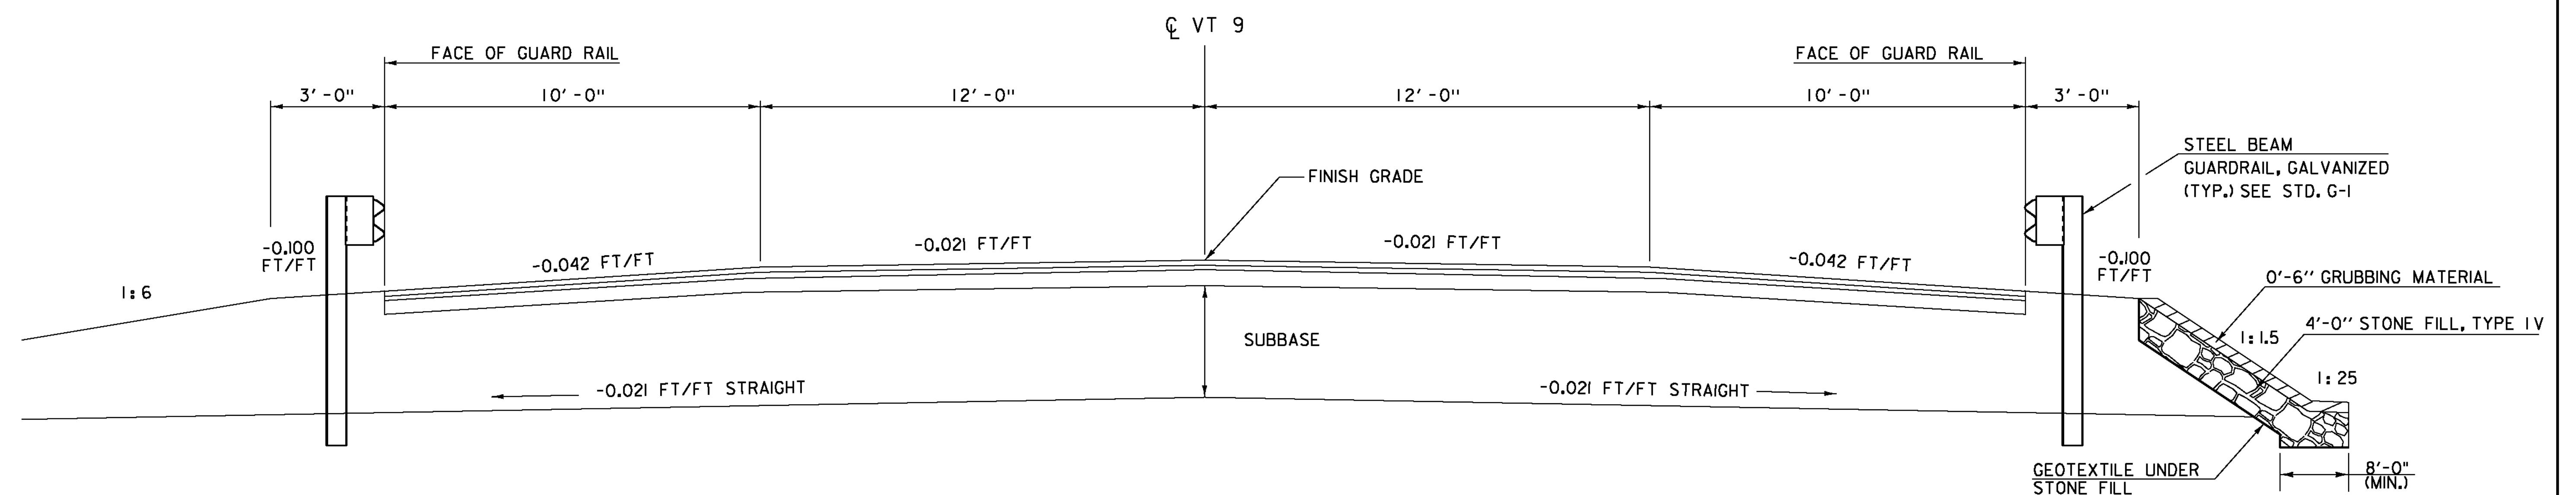


ROADWAY NORMAL SECTION WITH GUARD RAIL

NTS

- 1 1/2" SPECIAL PROVISION, (BITUMINOUS CONCRETE PAVEMENT, SMALL QUANTITY), TYPE IVS
- 1 1/4" SPECIAL PROVISION, (BITUMINOUS CONCRETE PAVEMENT, SMALL QUANTITY), TYPE IVS
- 5" SPECIAL PROVISION, (BITUMINOUS CONCRETE PAVEMENT, SMALL QUANTITY), TYPE IIS (TWO LIFTS OF 2 1/2")
- 36" SUBBASE OF CRUSHED GRAVEL, COARSE GRADED

TACK COAT: EMULSIFIED ASPHALT SHALL BE APPLIED AT THE RATE OF 0.040 GAL / SY BETWEEN SUCCESSIVE COARSE OF PAVEMENT AS DIRECTED BY THE ENGINEER.

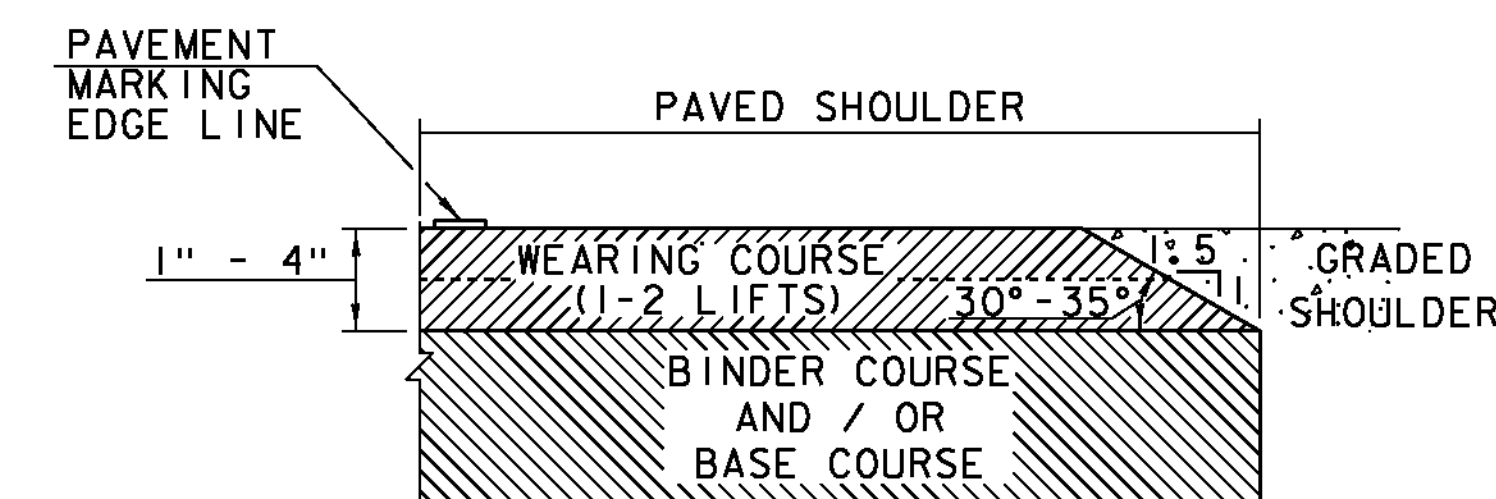


SAFETY EDGE DETAIL

NOT TO SCALE

NOTE: LEVELING COURSE MAY INCLUDE THE "SAFETY EDGE" AT THE CONTRACTOR'S CHOICE.

MATERIAL ITEM	THICKNESS TOLERANCE
PAVEMENT (TOTAL DEPTH)	±1/4"
SUBBASE	±1"


PROJECT NAME:	WOODFORD
PROJECT NUMBER:	ER BHF 010-1(44)
FILE NAME:	slb214typ.dgn
PROJECT LEADER:	C. CARLSON
DESIGNED BY:	M. EVANS-MONGEON
PROJECT TYPICAL SECTIONS	
PLOT DATE:	23-MAR-2012
DRAWN BY:	C. MOONEY
CHECKED BY:	EVANS-MONGEON
SHEET	7 OF 58

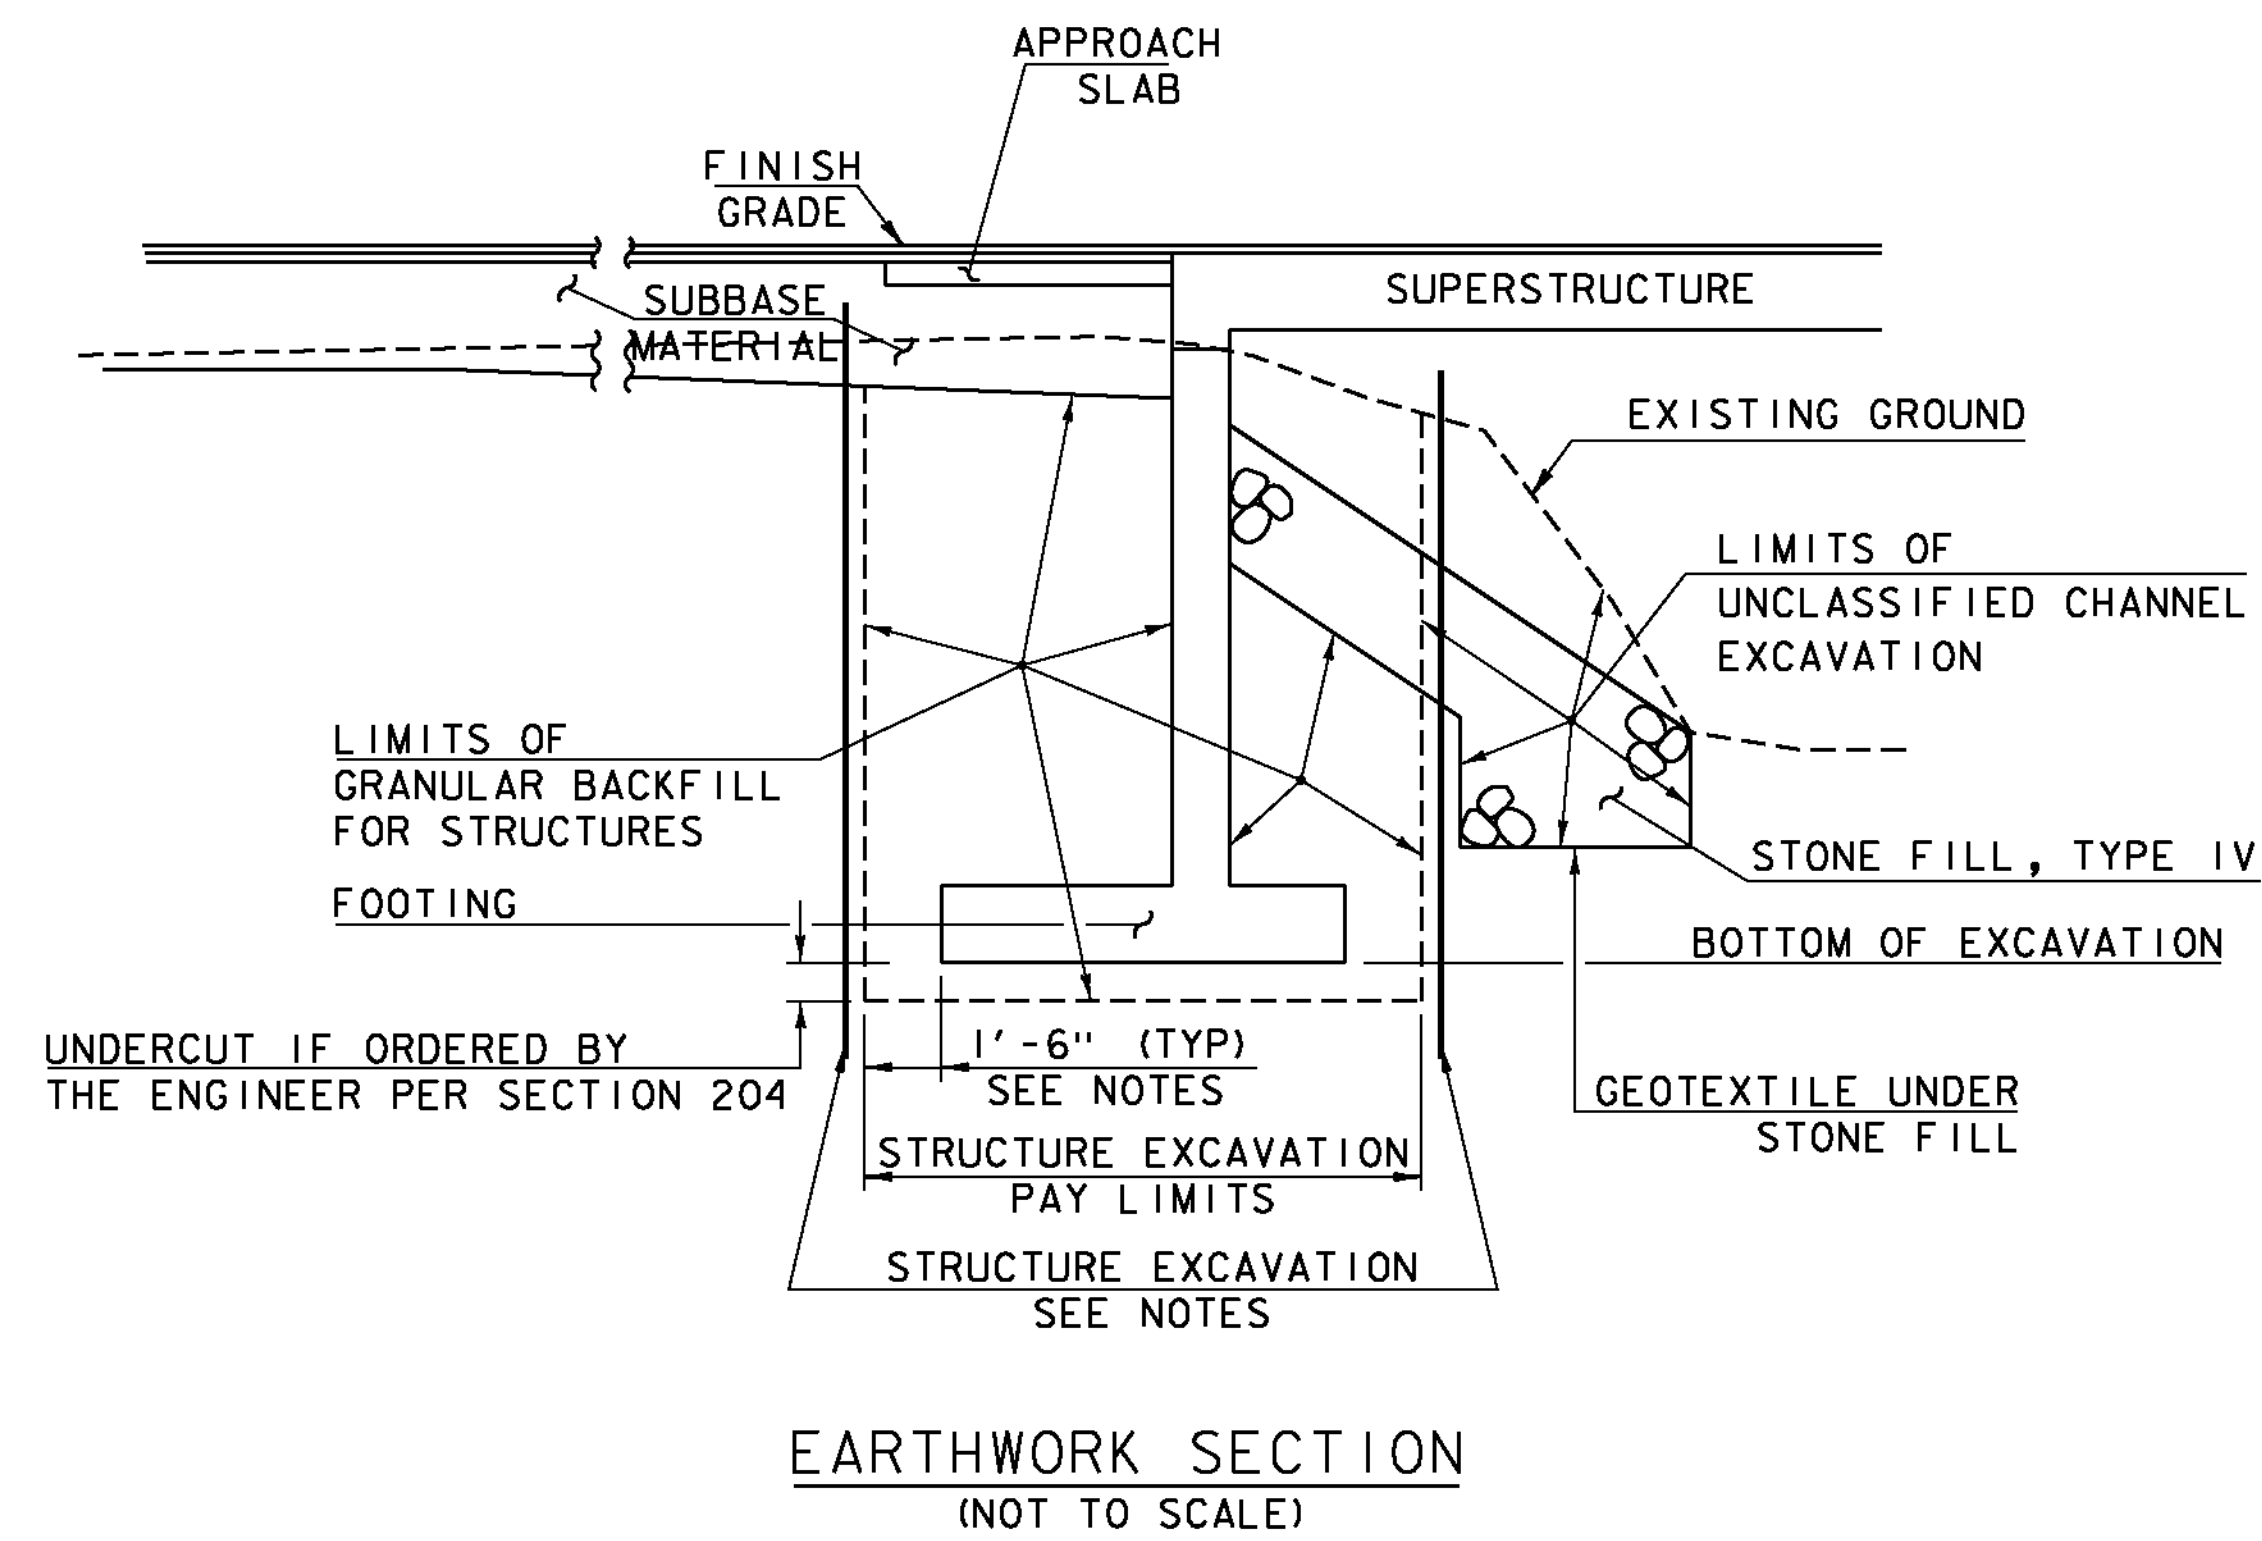

**EARTHWORK SECTION**  
(NOT TO SCALE)

**STRUCTURE EXCAVATION NOTES**

1. THE PAY LIMITS OF "STRUCTURE EXCAVATION" SHALL BE 1'-6" OUTSIDE THE PERIMETER OF THE FOOTING AND FROM BOTTOM OF EXCAVATION UP TO THE EXISTING GROUND OR BOTTOM OF SUBBASE, WHICHEVER IS LOWER.
2. IF AN EXCAVATION IS CONSTRUCTED WHICH IS LARGER THAN THE INDICATED STRUCTURE EXCAVATION PAY LIMITS, PAYMENT FOR ALL UNCLASSIFIED CHANNEL EXCAVATION, INCLUDING THAT PORTION WHICH IS INSIDE THE EXCAVATION BUT OUTSIDE THE STRUCTURE EXCAVATION PAY LIMITS, WILL BE MADE AT THE CONTRACT UNIT PRICE FOR UNCLASSIFIED CHANNEL EXCAVATION. NO MEASUREMENT AND PAYMENT WILL BE MADE FOR STRUCTURE EXCAVATION AND GRANULAR BACKFILL FOR STRUCTURES OUTSIDE THE PAY LIMITS DEFINED IN NOTE 1.

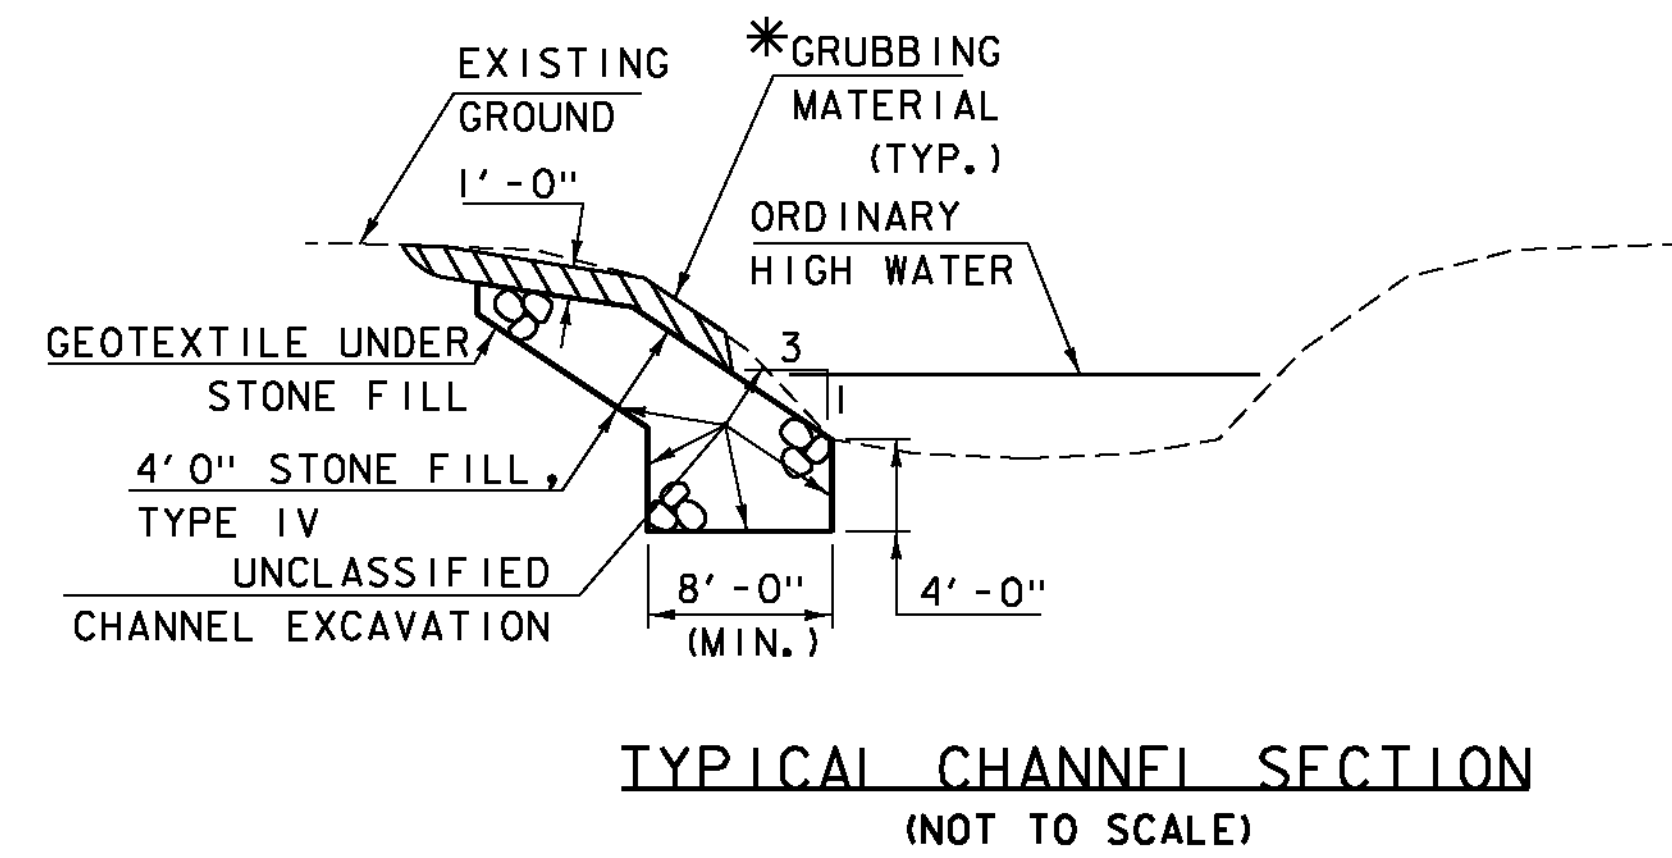

\*GRUBBING MATERIAL SHALL NOT BE PLACED ON THE STONE FILL IN THE AREA UNDER THE BRIDGE. WHENEVER CHANNEL SLOPE INTERSECTS ROADWAY SUBBASE, GRUBBING MATERIAL SHALL BEGIN AT THE BOTTOM OF SUBBASE.

PROJECT NAME: WOODFORD	
PROJECT NUMBER: ER BHF 010-1(44)	
FILE NAME: s1lb214typ.dgn	PLOT DATE: 23-MAR-2012
PROJECT LEADER: C. CARLSON	DRAWN BY: C. MOONEY
DESIGNED BY: M. EVANS-MONGEON	CHECKED BY: EVANS-MONGEON
EARTHWORK SECTIONS	SHEET 8 OF 58

GPS CONTROL POINTS

HVCTRL #1

B95011  
 NORTH = 141197.186  
 EAST = 1467159.125  
 ELEV. = 1020.450

 
 
 


GENERAL LOCATION, WOODFORD, VT., ABOUT 2.5 MI (4.0 KM) EAST OF BENNINGTON, VT. TO REACH FROM THE INTERSECTION OF U.S. ROUTE 7 AND VT ROUTE 9 IN BENNINGTON GO EAST ALONG VT ROUTE 9 FOR 2.7 MI (4.3 KM) TO THE MOST NORTHEASTERLY GRAVEL DRIVE LEFT TO THE AVALON MOTEL AND MINI MART AND THE MARK ON THE LEFT. THE MARK IS SET 10 CM BELOW GROUND SURFACE IN THE TOP OF A 30 CM DIAMETER CONCRETE MONUMENT POURED TO A DEPTH OF 1.4 M (4.6 FT). IT IS 9.3 M (30.5 FT) NORTHWEST OF AND ABOUT 0.3 M (1.0 FT) LOWER THAN THE CENTERLINE OF VT ROUTE 9, 4.9 M (16.1 FT) SOUTHWEST OF THE CENTERLINE OF THE GRAVEL DRIVE TO THE MOTEL, 7.3 M (24.0 FT) EAST OF THE SOUTHWEST END OF A METAL CULVERT, 18.4 M (60.4 FT) SOUTH OF A 20 CM PINE, AND 1.1 M (3.6 FT) SOUTHEAST OF A FIBERGLASS WITNESS POST. NOTE, THIS MARK IS INTERVISIBLE WITH B95012.

HVCTRL #2

B95012  
 NORTH = 142071.296  
 EAST = 1468110.302  
 ELEV. = 1047.270






GENERAL LOCATION, WOODFORD, VT., ABOUT 3 MI (4.8 KM) EAST OF BENNINGTON, VT. TO REACH FROM THE INTERSECTION OF U.S. ROUTE 7 AND VT ROUTE 9 IN BENNINGTON GO EAST ALONG VT ROUTE 9 FOR 3.0 MI (4.8 KM) TO A POWERLINE CROSSING AND THE MARK ON THE RIGHT. THE MARK IS SET FLUSH WITH GROUND SURFACE IN THE TOP OF A 30 CM DIAMETER CONCRETE MONUMENT POURED TO A DEPTH OF 1.4 M (4.6 FT). IT IS 10.6 M (34.8 FT) SOUTH OF AND ABOUT 0.5 M (1.6 FT) LOWER THAN THE CENTERLINE OF VT ROUTE 9, 8.4 M (27.6 FT) NORTHEAST OF POWER POLE NO. 18, 25.3 M (83.0 FT) SOUTH OF POLE NO. 52/864, 23.7 M (77.8 FT) WEST OF THE SOUTHWEST END OF A 70-CM DIAMETER METAL CULVERT, AND 0.7 M (2.3 FT) NORTH OF A FIBERGLASS WITNESS POST. NOTE, THIS MARK IS INTERVISIBLE WITH B95011.

TRAVERSE TIES

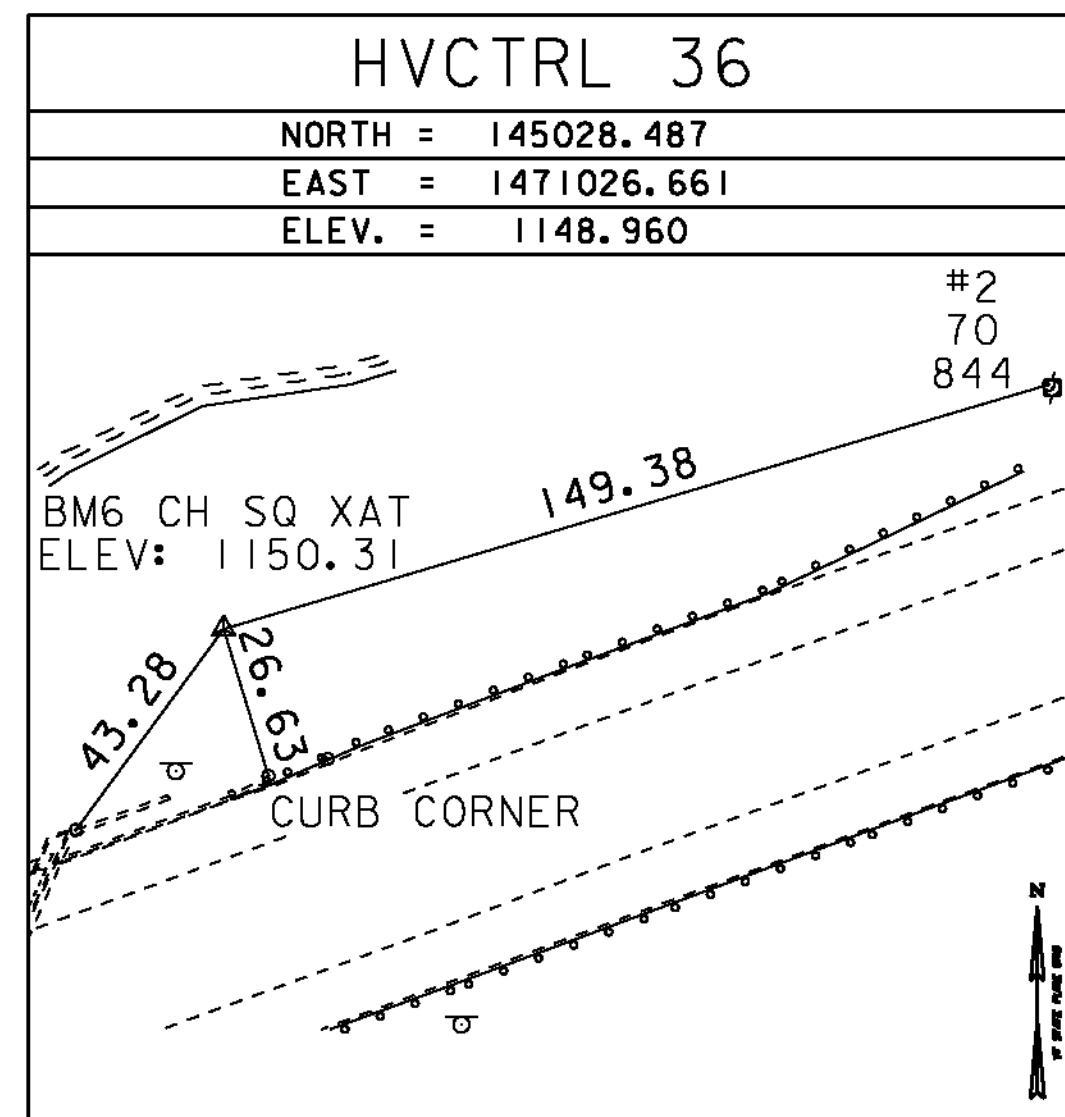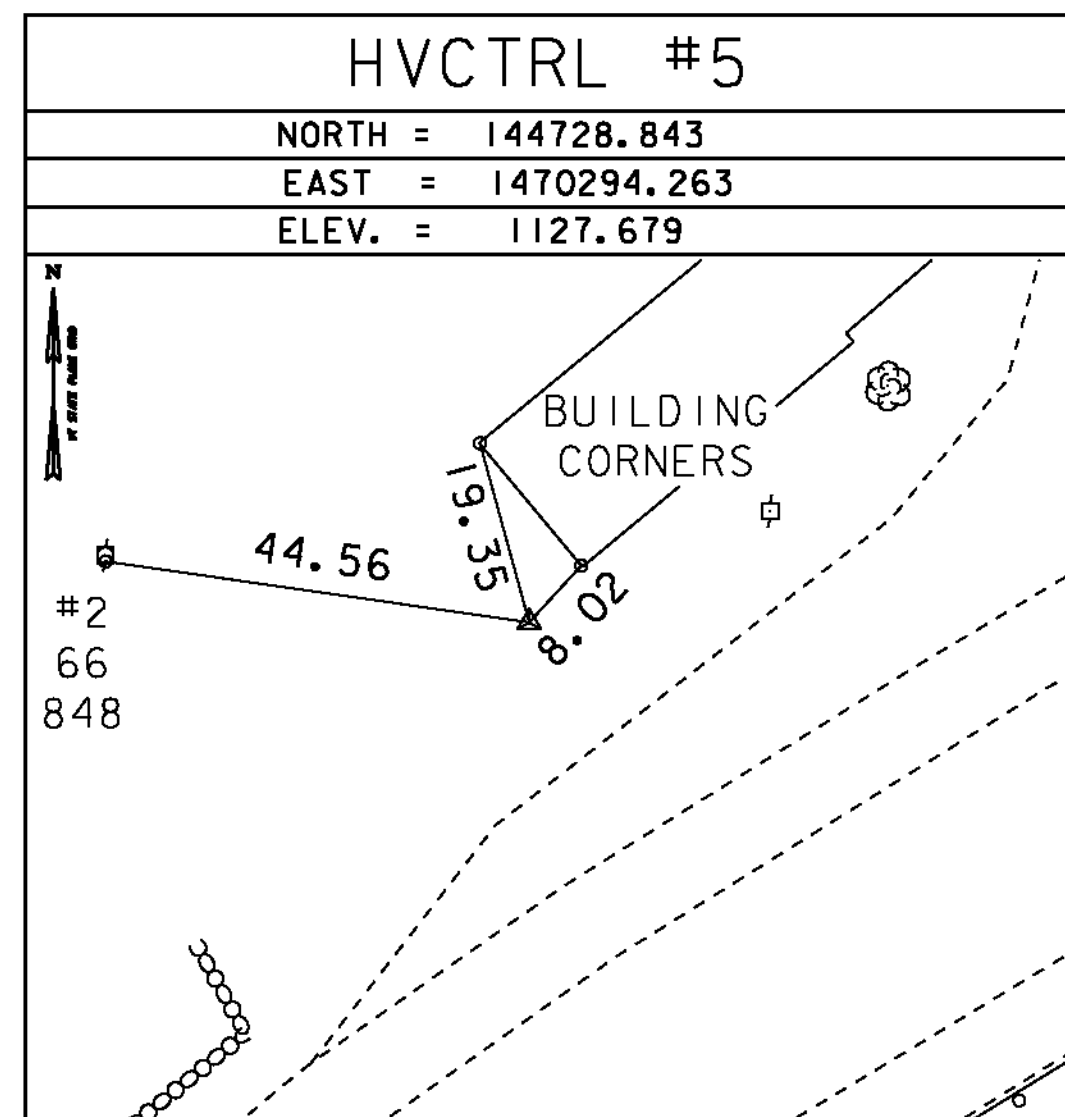



\* MAIN TRAVERSE COMPLETED 11/06/2011 BY L. ORVIS P.C. & G. HITCHCOCK

     ALIGNMENT TIES



DATUM	
VERTICAL	NAVD 88
HORIZONTAL	NAD 83 (07)
ADJUSTMENT	COMPASS

PROJECT NAME:	WOODFORD
PROJECT NUMBER:	ER-BHF 010-1(44)
FILE NAME:	survey\11b2141.dgn
PROJECT LEADER:	C. CARLSON
DESIGNED BY:	
TIE SHEET	
PLOT DATE:	23-MAR-2012
DRAWN BY:	R. BULLOCK
CHECKED BY:	
SHEET	9 OF 58

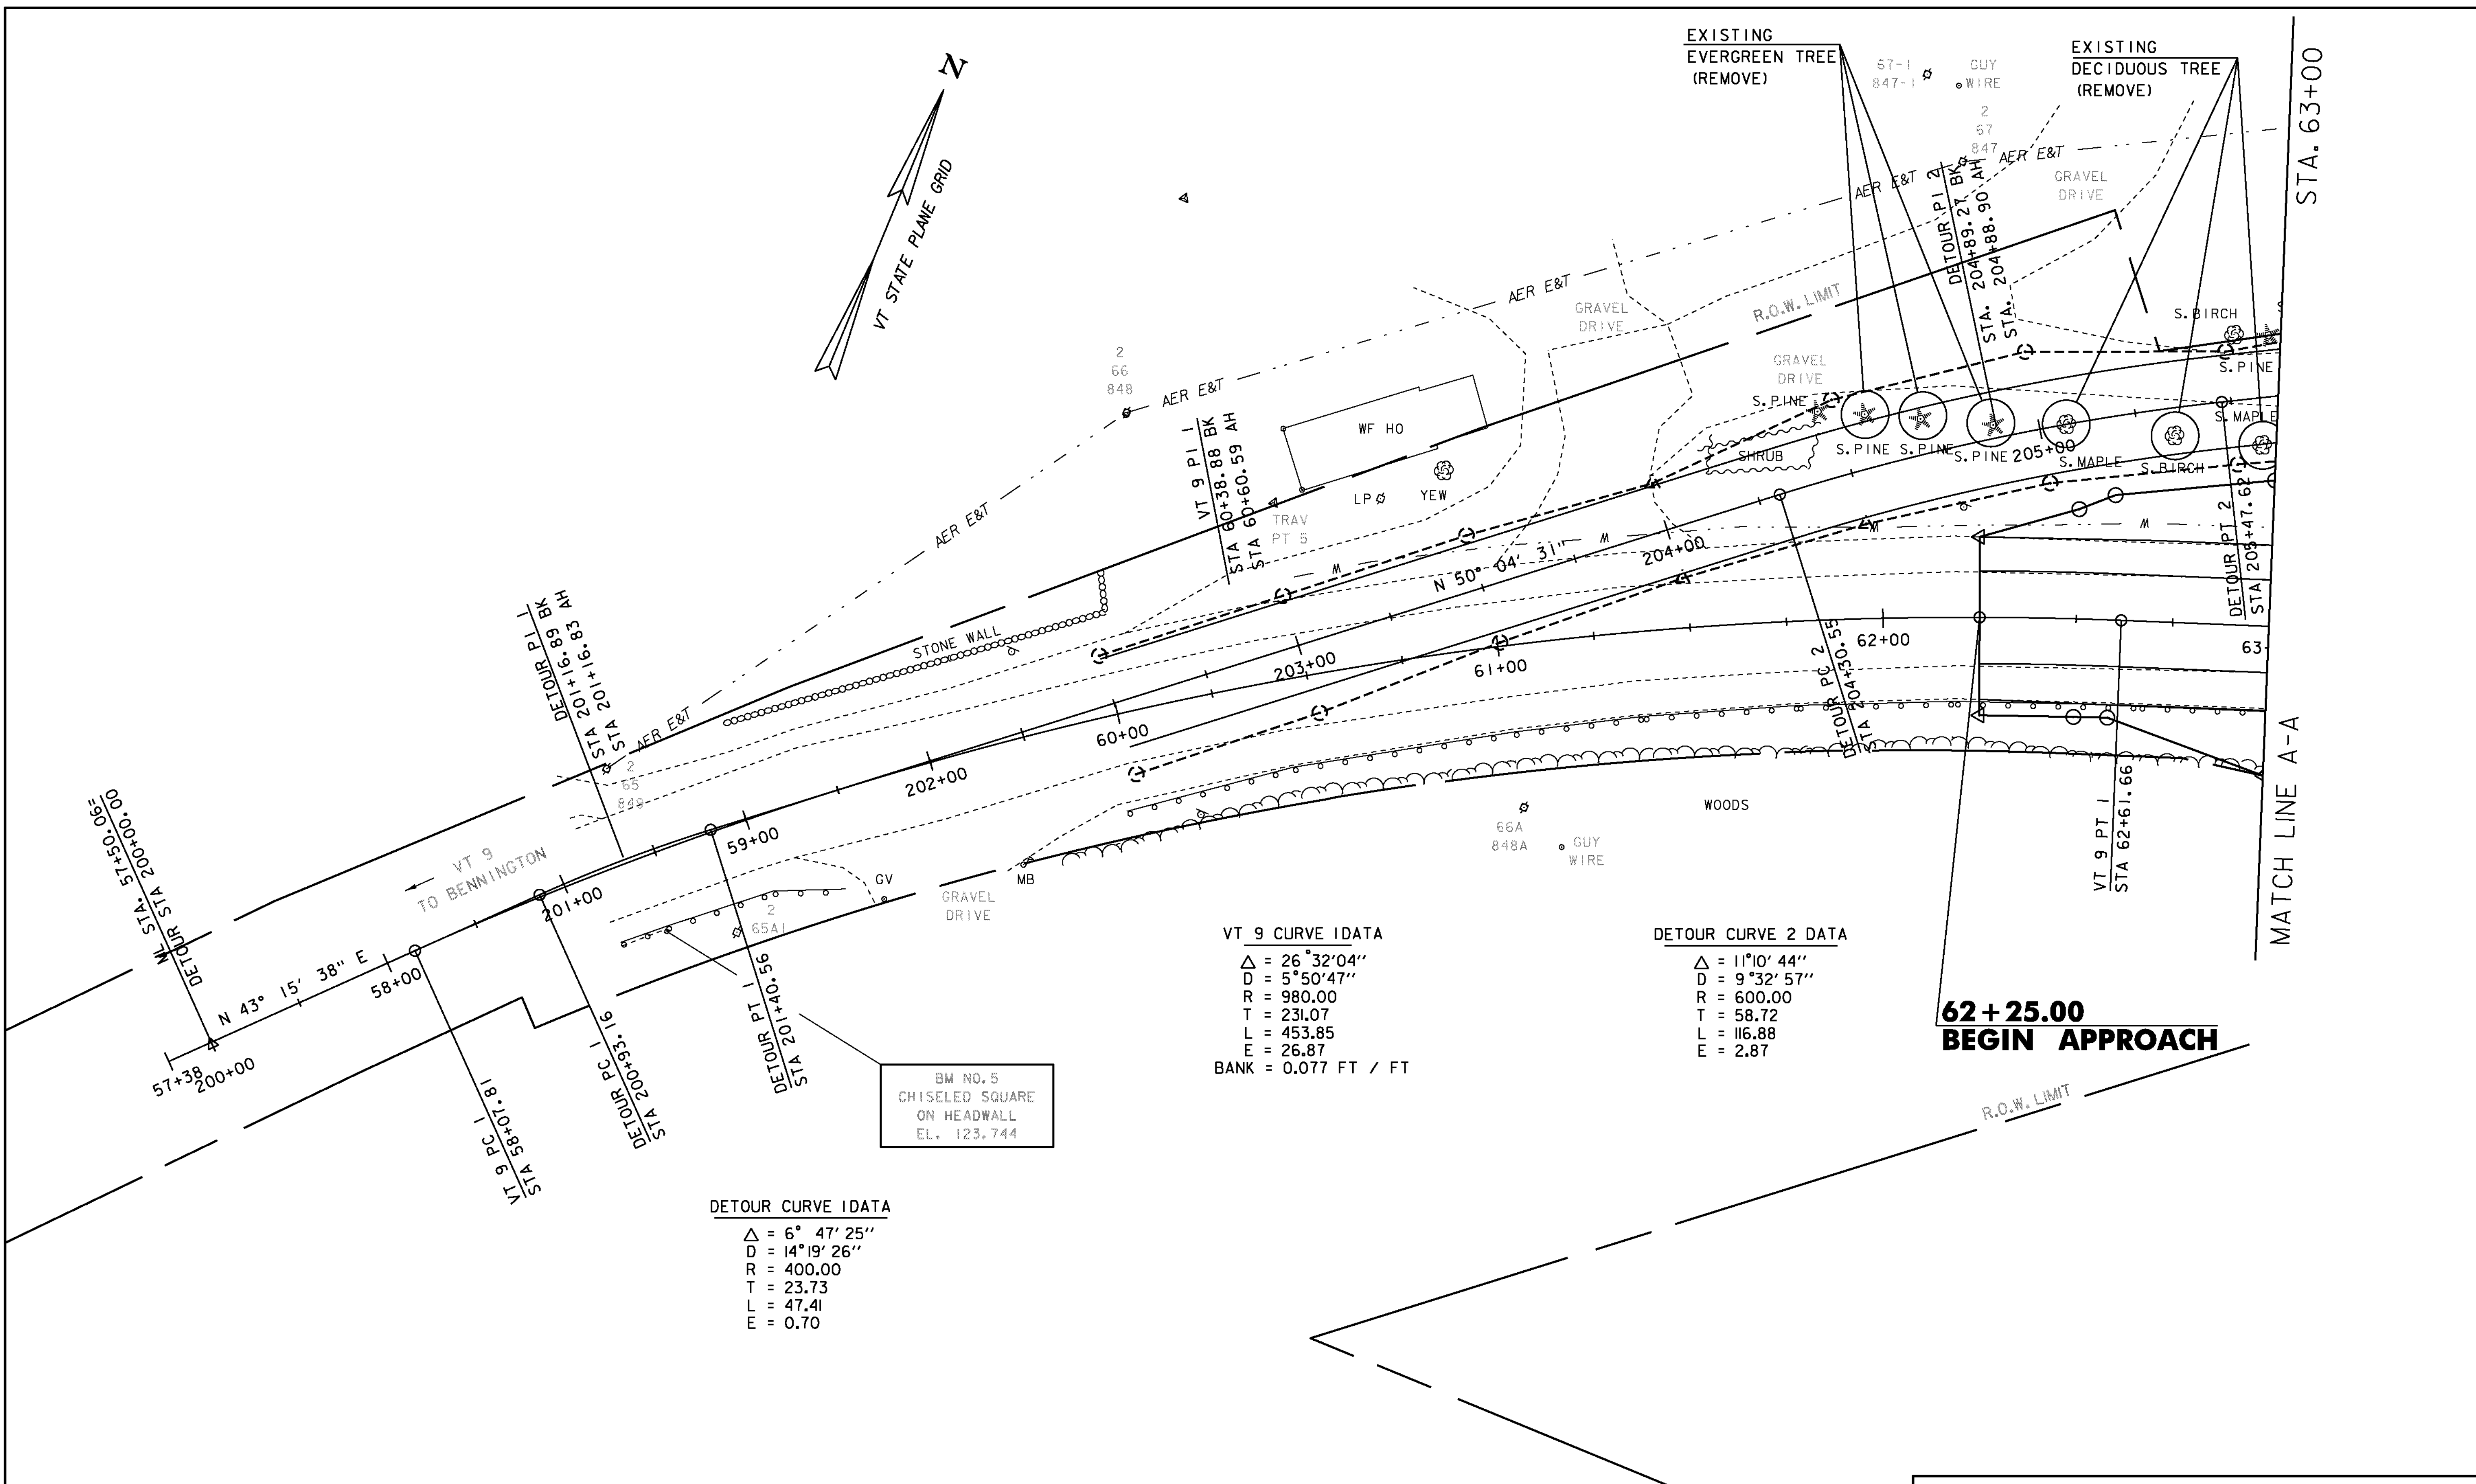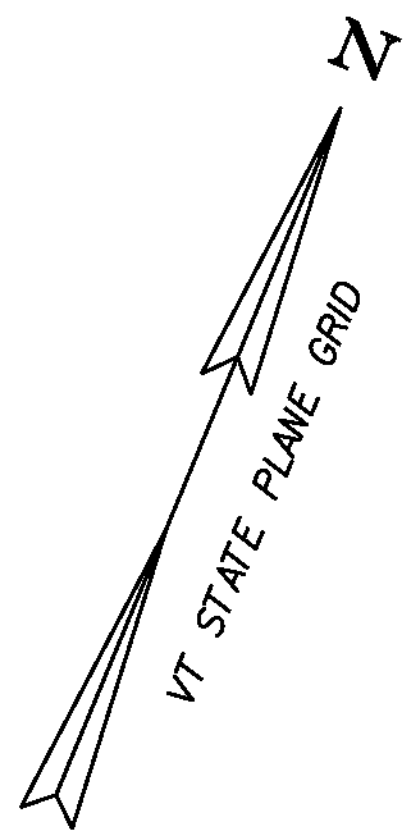


**VT 9 CURVE 1 DATA**  
 $\Delta = 26^\circ 32' 04''$   
 $D = 5^\circ 50' 47''$   
 $R = 980.00$   
 $T = 231.07$   
 $L = 453.85$   
 $E = 26.87$   
 BANK = 0.077 FT / FT

**DETOUR CURVE 2 DATA**  
 $\Delta = 11^\circ 10' 44''$   
 $D = 9^\circ 32' 57''$   
 $R = 600.00$   
 $T = 58.72$   
 $L = 116.88$   
 $E = 2.87$

**DETOUR CURVE 1 DATA**  
 $\Delta = 6^\circ 47' 25''$   
 $D = 14^\circ 19' 26''$   
 $R = 400.00$   
 $T = 23.73$   
 $L = 47.41$   
 $E = 0.70$

BM NO. 5  
 CHISELED SQUARE  
 ON HEADWALL  
 EL. 123.744

**62+25.00  
 BEGIN APPROACH**

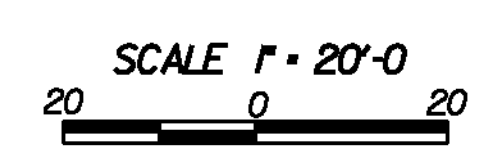

PROJECT NAME: WOODFORD	PLOT DATE: 23-MAR-2012
PROJECT NUMBER: ER BHF 010-1(44)	DRAWN BY: EVANS-MONGEON
FILE NAME: s11b214bdr.dgn	CHECKED BY: G. ROY
PROJECT LEADER: C. CARLSON	SHEET 10 OF 58
DESIGNED BY: M.EVANS-MONGEON	
PLAN SHEET (1)	

**64+00.00**  
**END APPROACH**  
**BEGIN PROJECT**  
**F.G. 1140.96**

**64+90.93**  
**BEGIN BRIDGE**  
**F.G. 1144.26**

**66+00.50**  
**END BRIDGE WORK**  
**BEGIN APPROACH**  
**F.G. 1147.44**

**CAST-IN-PLACE CONCRETE CURB, TYPE B**  
 64+29.6 - 64+69.4 RT  
 64+72.5 - 65+12.9 LT

**STEEL BEAM GUARDRAIL, GALVANIZED**  
 64+36.8 - 64+85.0 RT  
 64+14.8 - 64+39.8 RT

**GUARDRAIL APPROACH SECTION, GALVANIZED 2 RAIL BOX BEAM**  
 64+85.0 - 65+15.2 LT  
 64+39.8 - 64+70.0 RT

**MANUFACTURED TERMINAL SECTION, FLARED**  
 63+99.0 - 64+36.8 LT

**BRIDGE RAILING, GALVANIZED 2 RAIL BOX BEAM**  
 64+70.0 - 66+00.50 RT  
 65+15.2 - 66+00.50 LT

**4" YELLOW LINE**  
 62+25.0 - 66+30.5 DBL SOLID

**4" WHITE LINE**  
 62+25.0 - 66+30.5 LT  
 62+25.0 - 66+30.5 RT

**DETOUR CURVE 3 DATA**

$\Delta = 19^\circ 24' 14''$   
 $D = 14^\circ 19' 26''$   
 $R = 400.00$   
 $T = 68.39$   
 $L = 134.82$   
 $E = 5.80$

EXISTING (BURIED) WATER MAIN TO BE REMOVED  
 SEE PROJECT NOTES

TEMPORARY DETOUR CONSTRUCTION LIMITS

TEMPORARY DETOUR CONSTRUCTION LIMITS

APPROXIMATE LOCATION OF TEMPORARY STRUCTURE  
 N 80° 39' 29" E  
 210+00


EXISTING 12" WATER LINE


BM NO. 6  
 CHISELED SQUARE ON ABUTMENT  
 EL. 1150.309

**66+30.50**  
**END APPROACH**

SCALE 1" = 20'-0"

PROJECT NAME:	WOODFORD	PLOT DATE:	23-MAR-2012
PROJECT NUMBER:	ER BHF 010-1(44)	DRAWN BY:	EVANS-MONGEON
FILE NAME:	slb214bdr.dgn	CHECKED BY:	G. ROY
DESIGNED BY:	M.EVANS-MONGEON	PLAN SHEET (2)	SHEET II OF 58

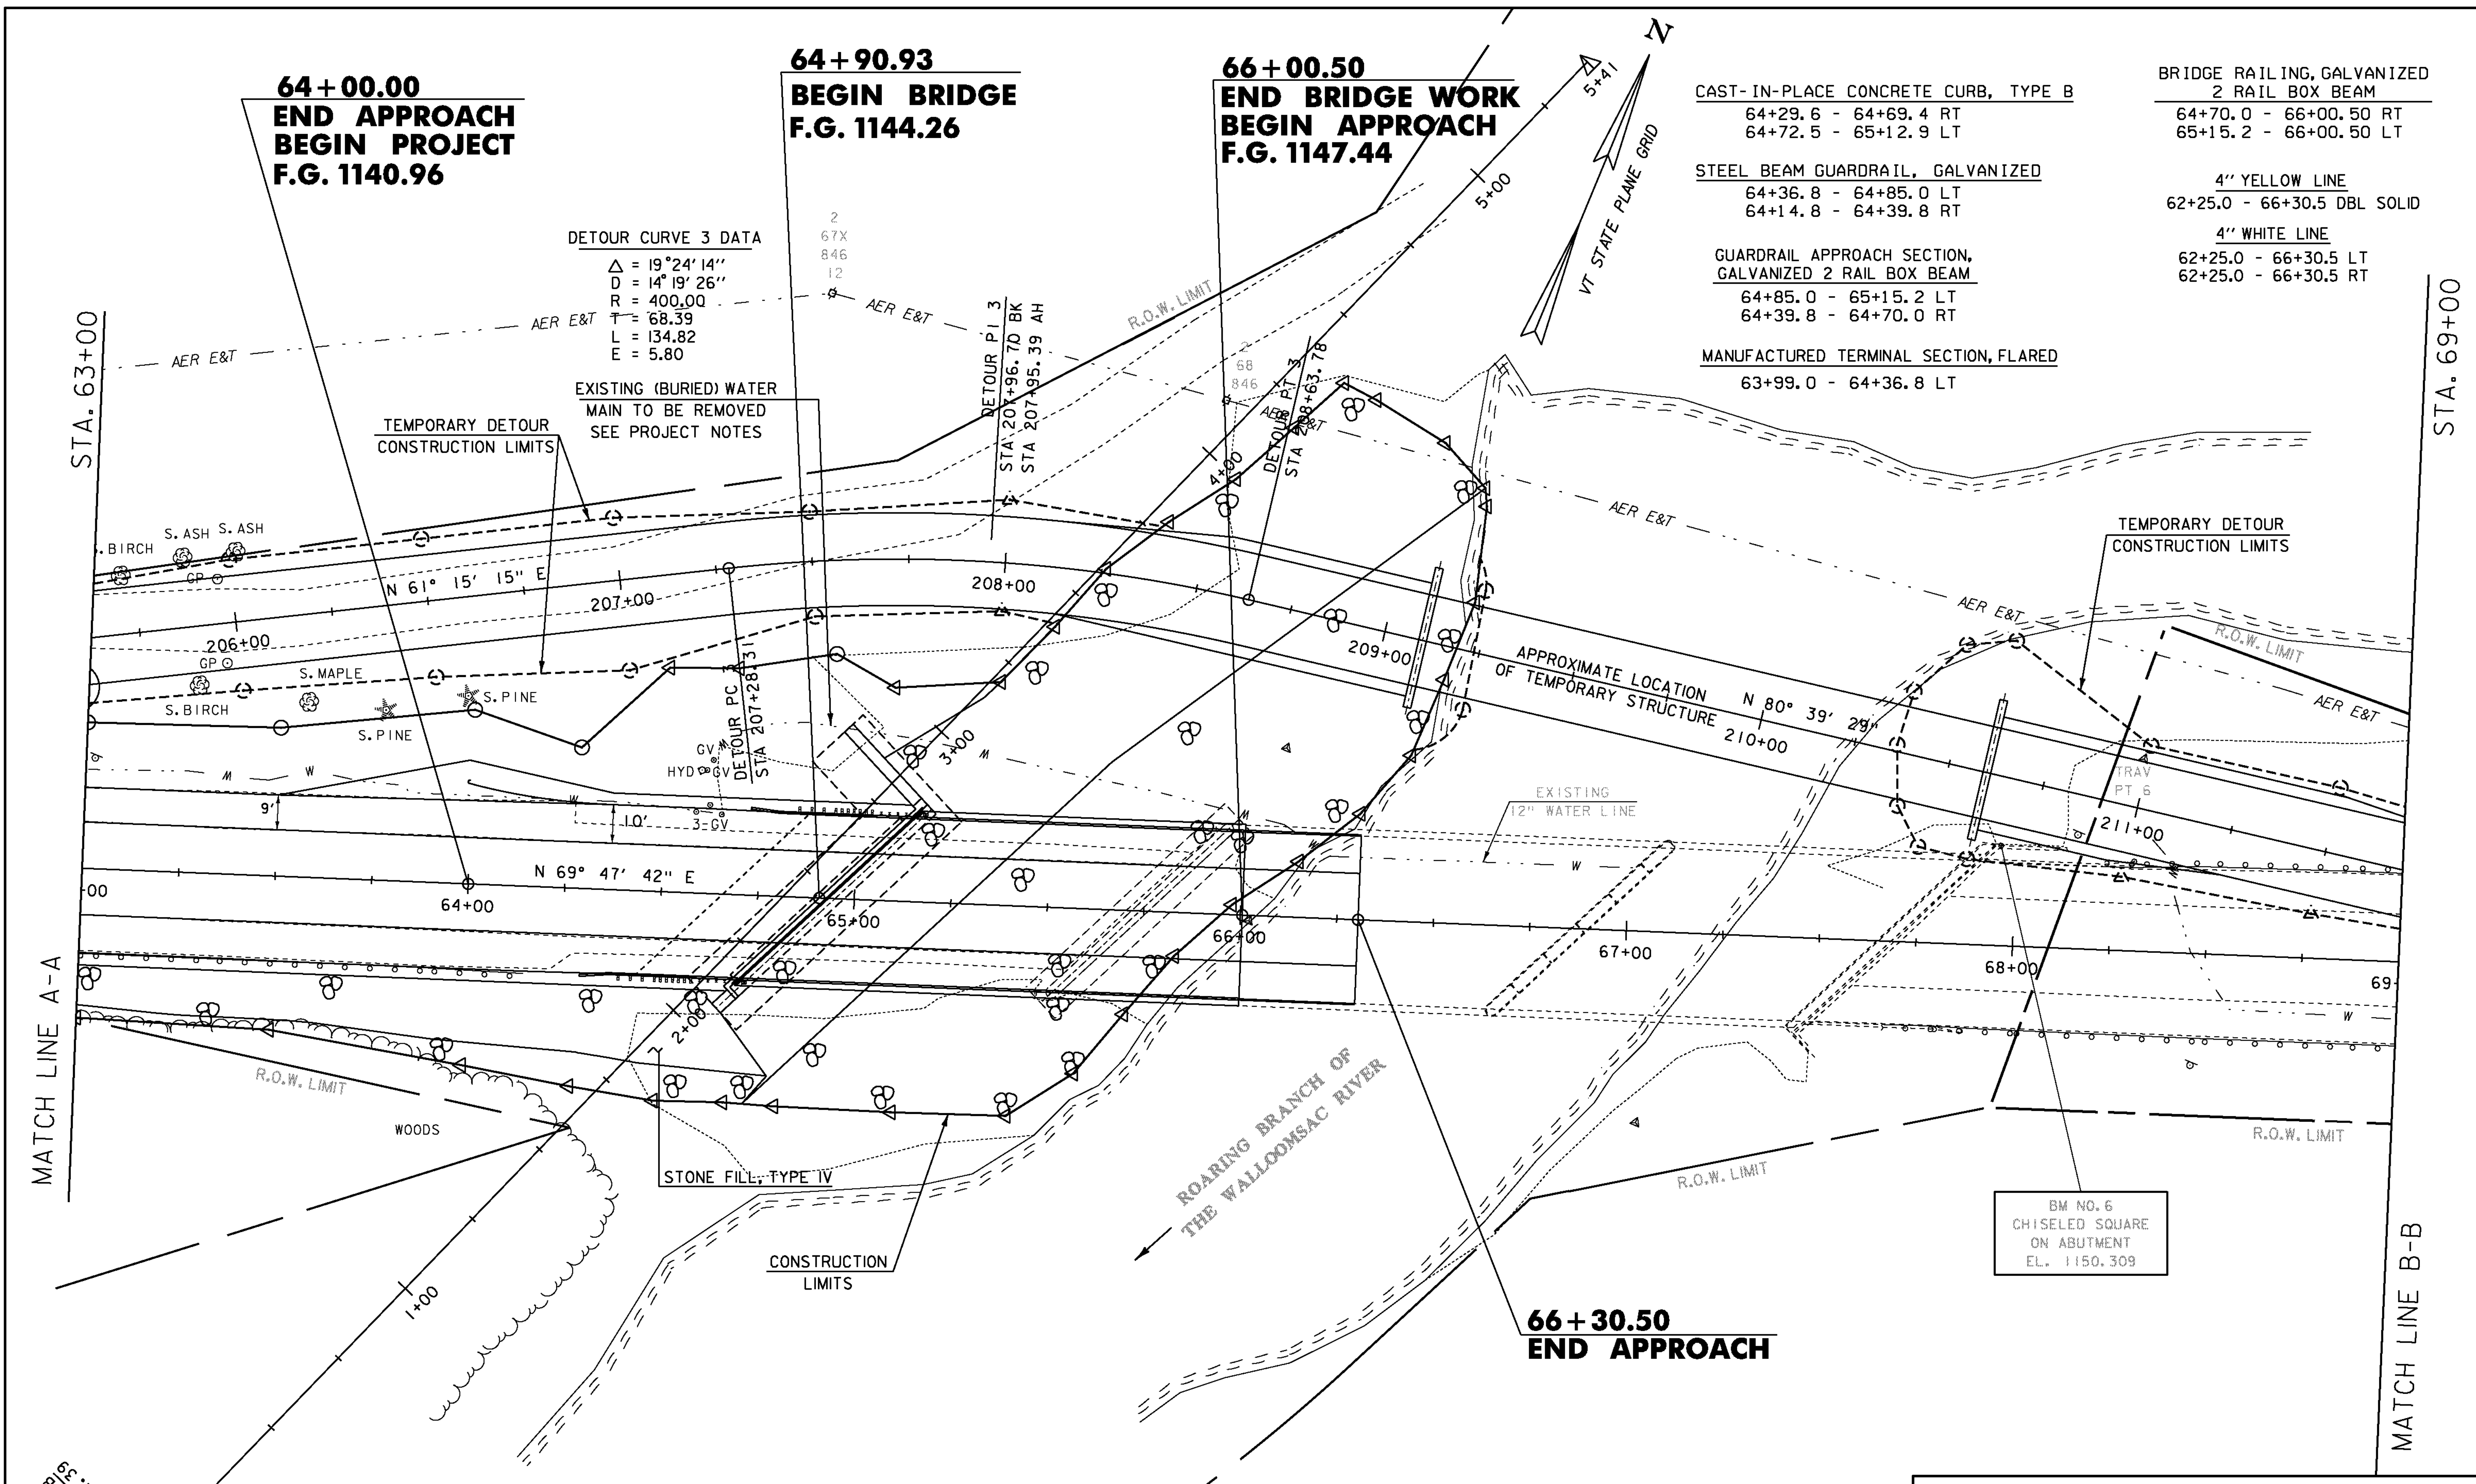

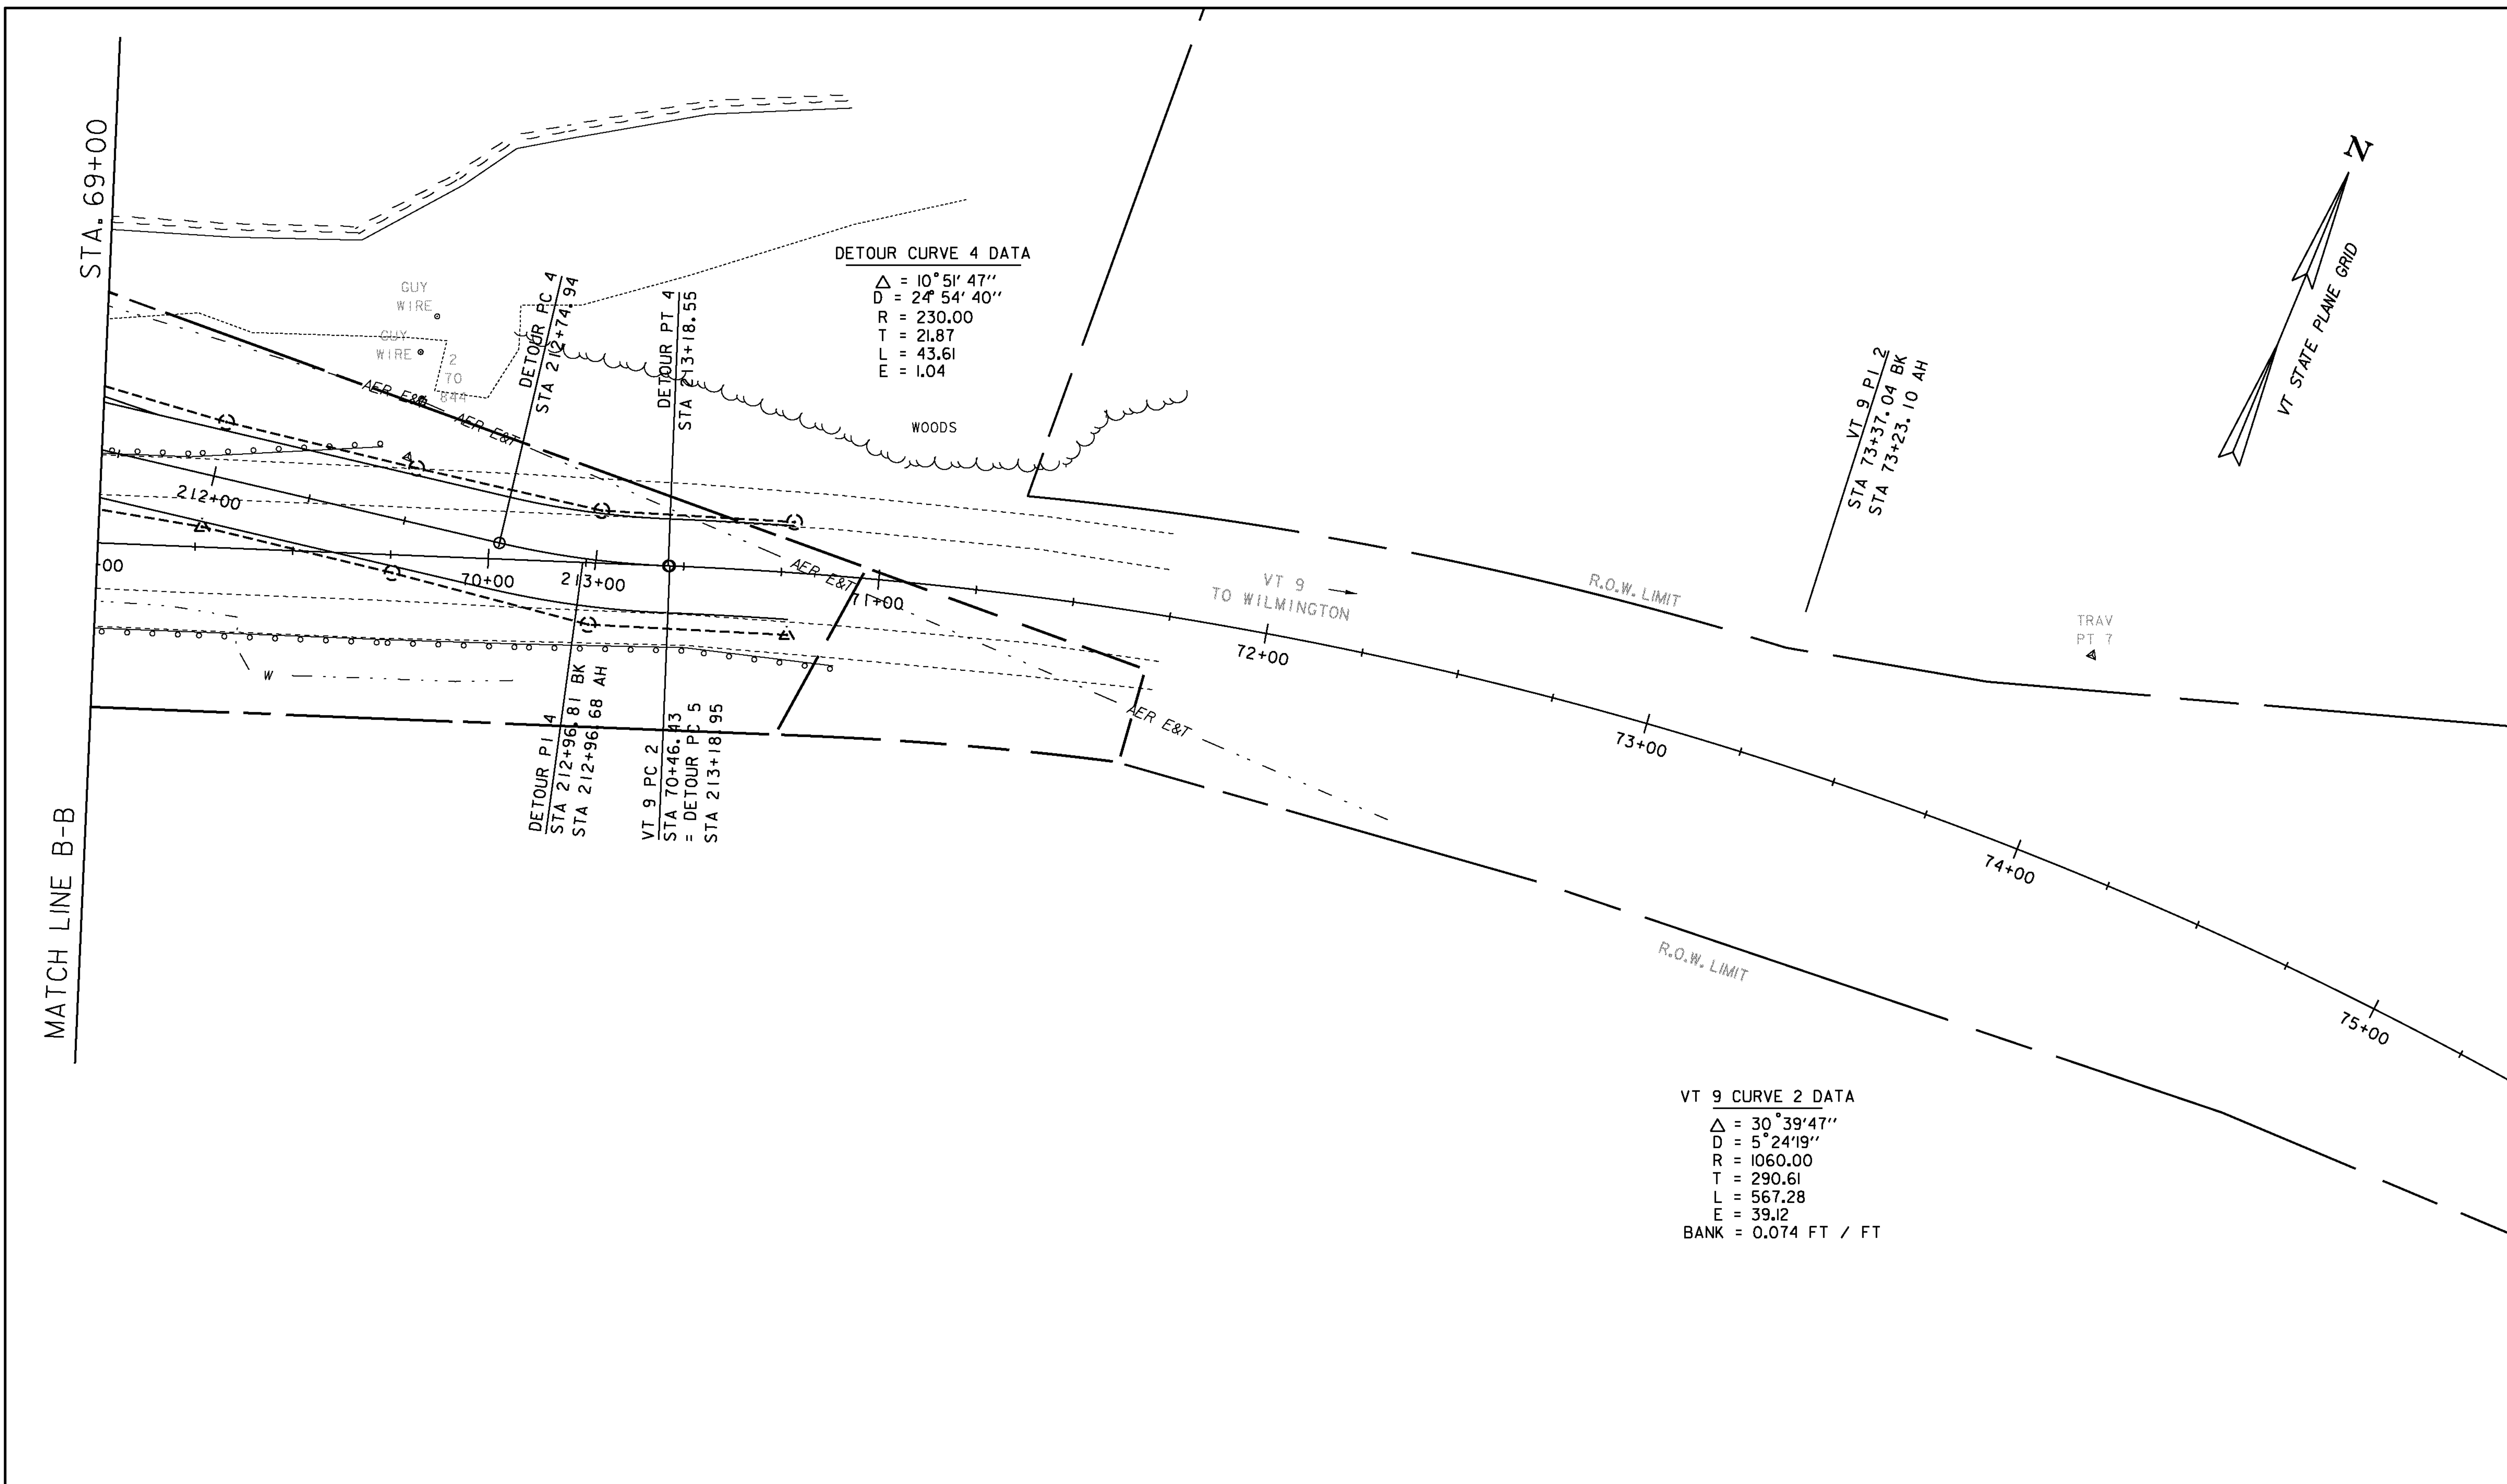


DETOUR CURVE 4 DATA  
 $\Delta = 10^\circ 51' 47''$   
 $D = 24^\circ 54' 40''$   
 $R = 230.00$   
 $T = 21.87$   
 $L = 43.61$   
 $E = 1.04$


VT 9 CURVE 2 DATA  
 $\Delta = 30^\circ 39' 47''$   
 $D = 5^\circ 24' 19''$   
 $R = 1060.00$   
 $T = 290.61$   
 $L = 567.28$   
 $E = 39.12$   
 $BANK = 0.074 \text{ FT} / \text{ FT}$

MATCH LINE B-B

STA. 69+00

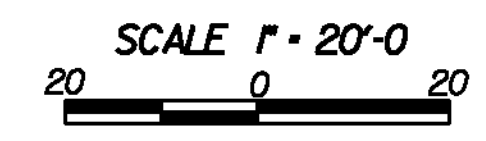

PROJECT NAME: WOODFORD	PLOT DATE: 23-MAR-2012
PROJECT NUMBER: ER BHF 010-1(44)	DRAWN BY: EVANS-MONGEON
FILE NAME: s11b214bdr.dgn	CHECKED BY: G. ROY
PROJECT LEADER: C. CARLSON	SHEET 12 OF 58
DESIGNED BY: M. EVANS-MONGEON	
PLAN SHEET (3)	

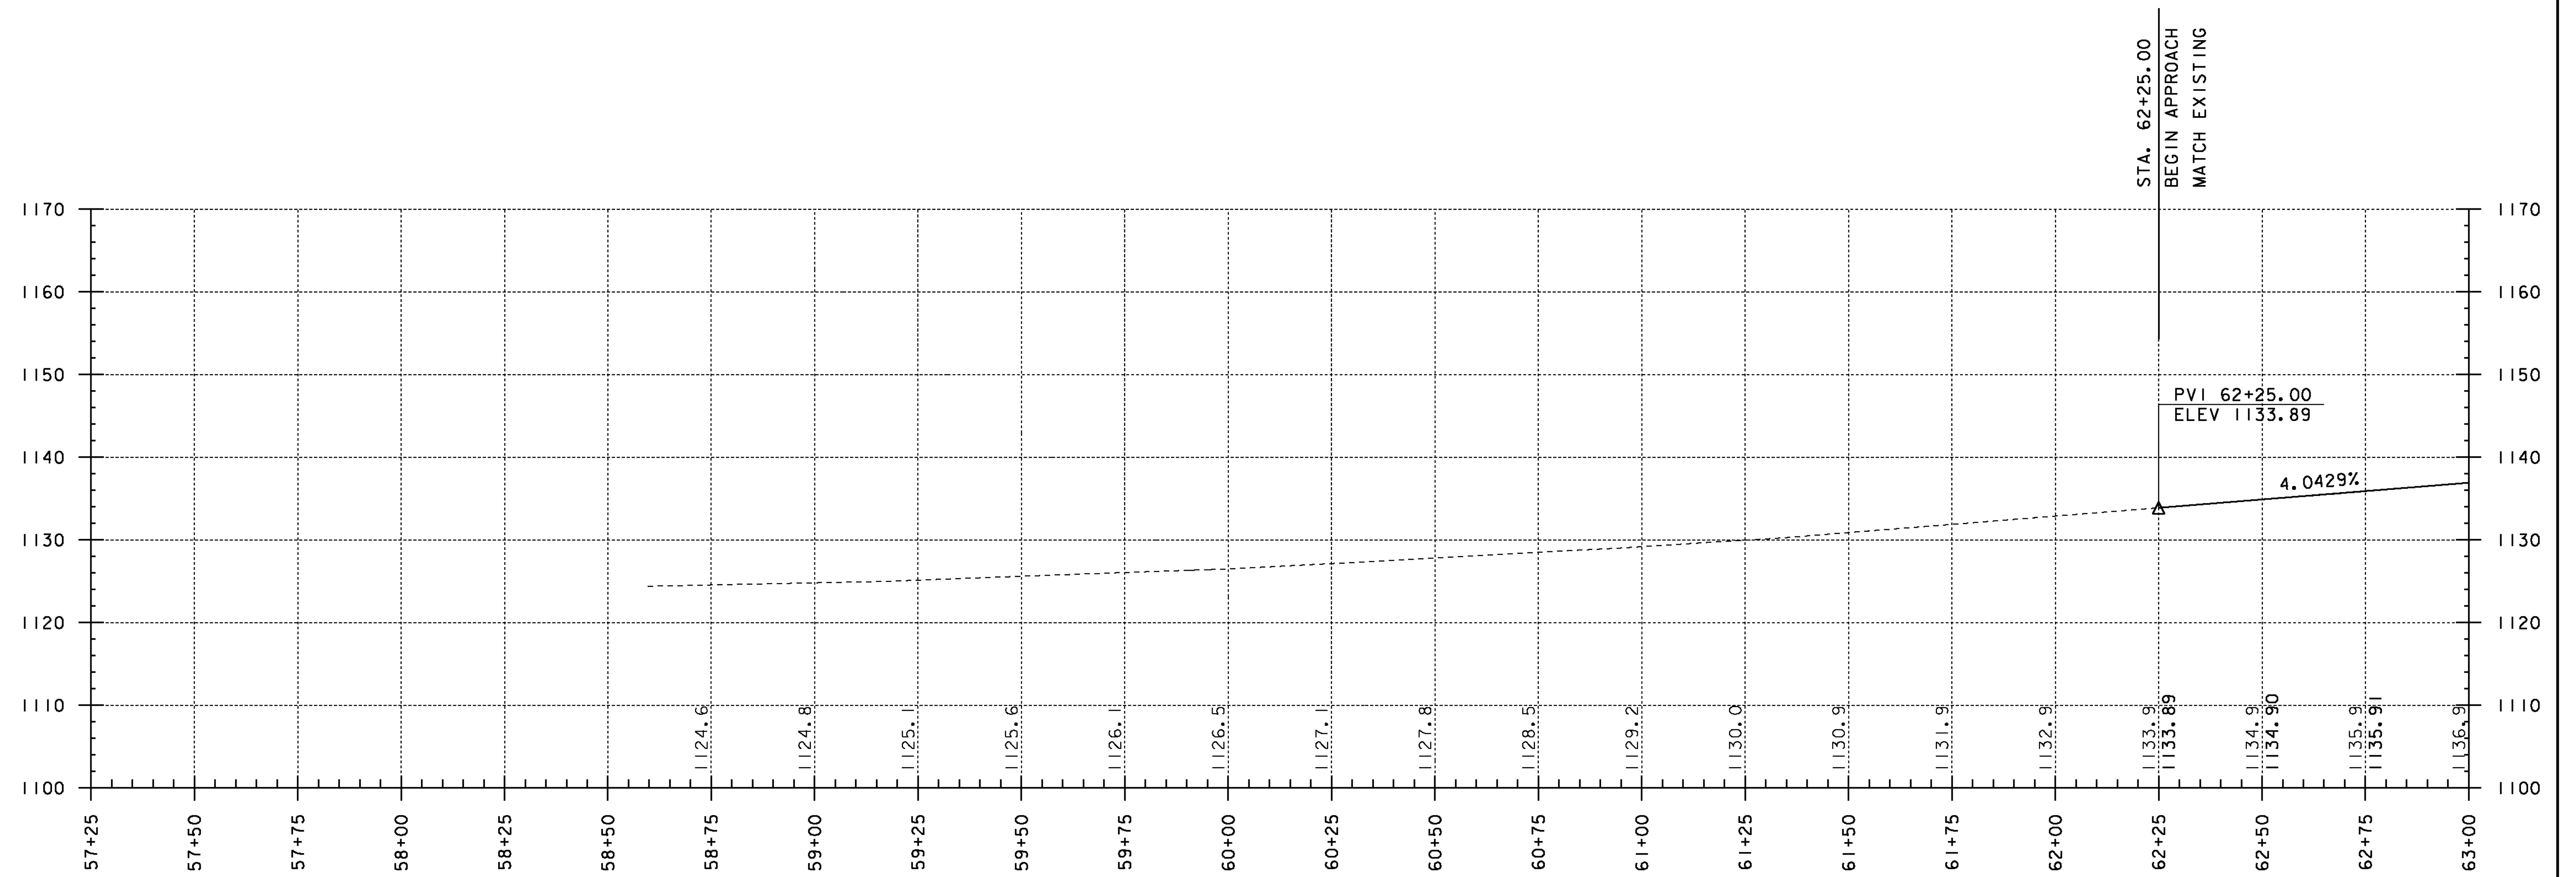

NOTE:


ELEVATIONS SHOWN TO THE NEAREST TENTH ARE EXISTING GROUND ALONG PROPOSED CENTERLINE.

ELEVATIONS SHOWN TO THE NEAREST HUNDREDTH ARE FINISH GRADES ALONG PROPOSED CENTERLINE.

PROFILE ALONG VT 9

HORIZONTAL SCALE: 1" = 20'-0"  
 VERTICAL SCALE: 1" = 10'-0"


PROJECT NAME: WOODFORD	
PROJECT NUMBER: ER BHF 010-1(44)	
FILE NAME: s11b214xs.dgn	PLOT DATE: 23-MAR-2012
PROJECT LEADER: C. CARLSON	DRAWN BY: EVANS-MONGEON
DESIGNED BY: M.EVANS-MONGEON	CHECKED BY:
PROFILE SHEET (1)	SHEET 13 OF 58

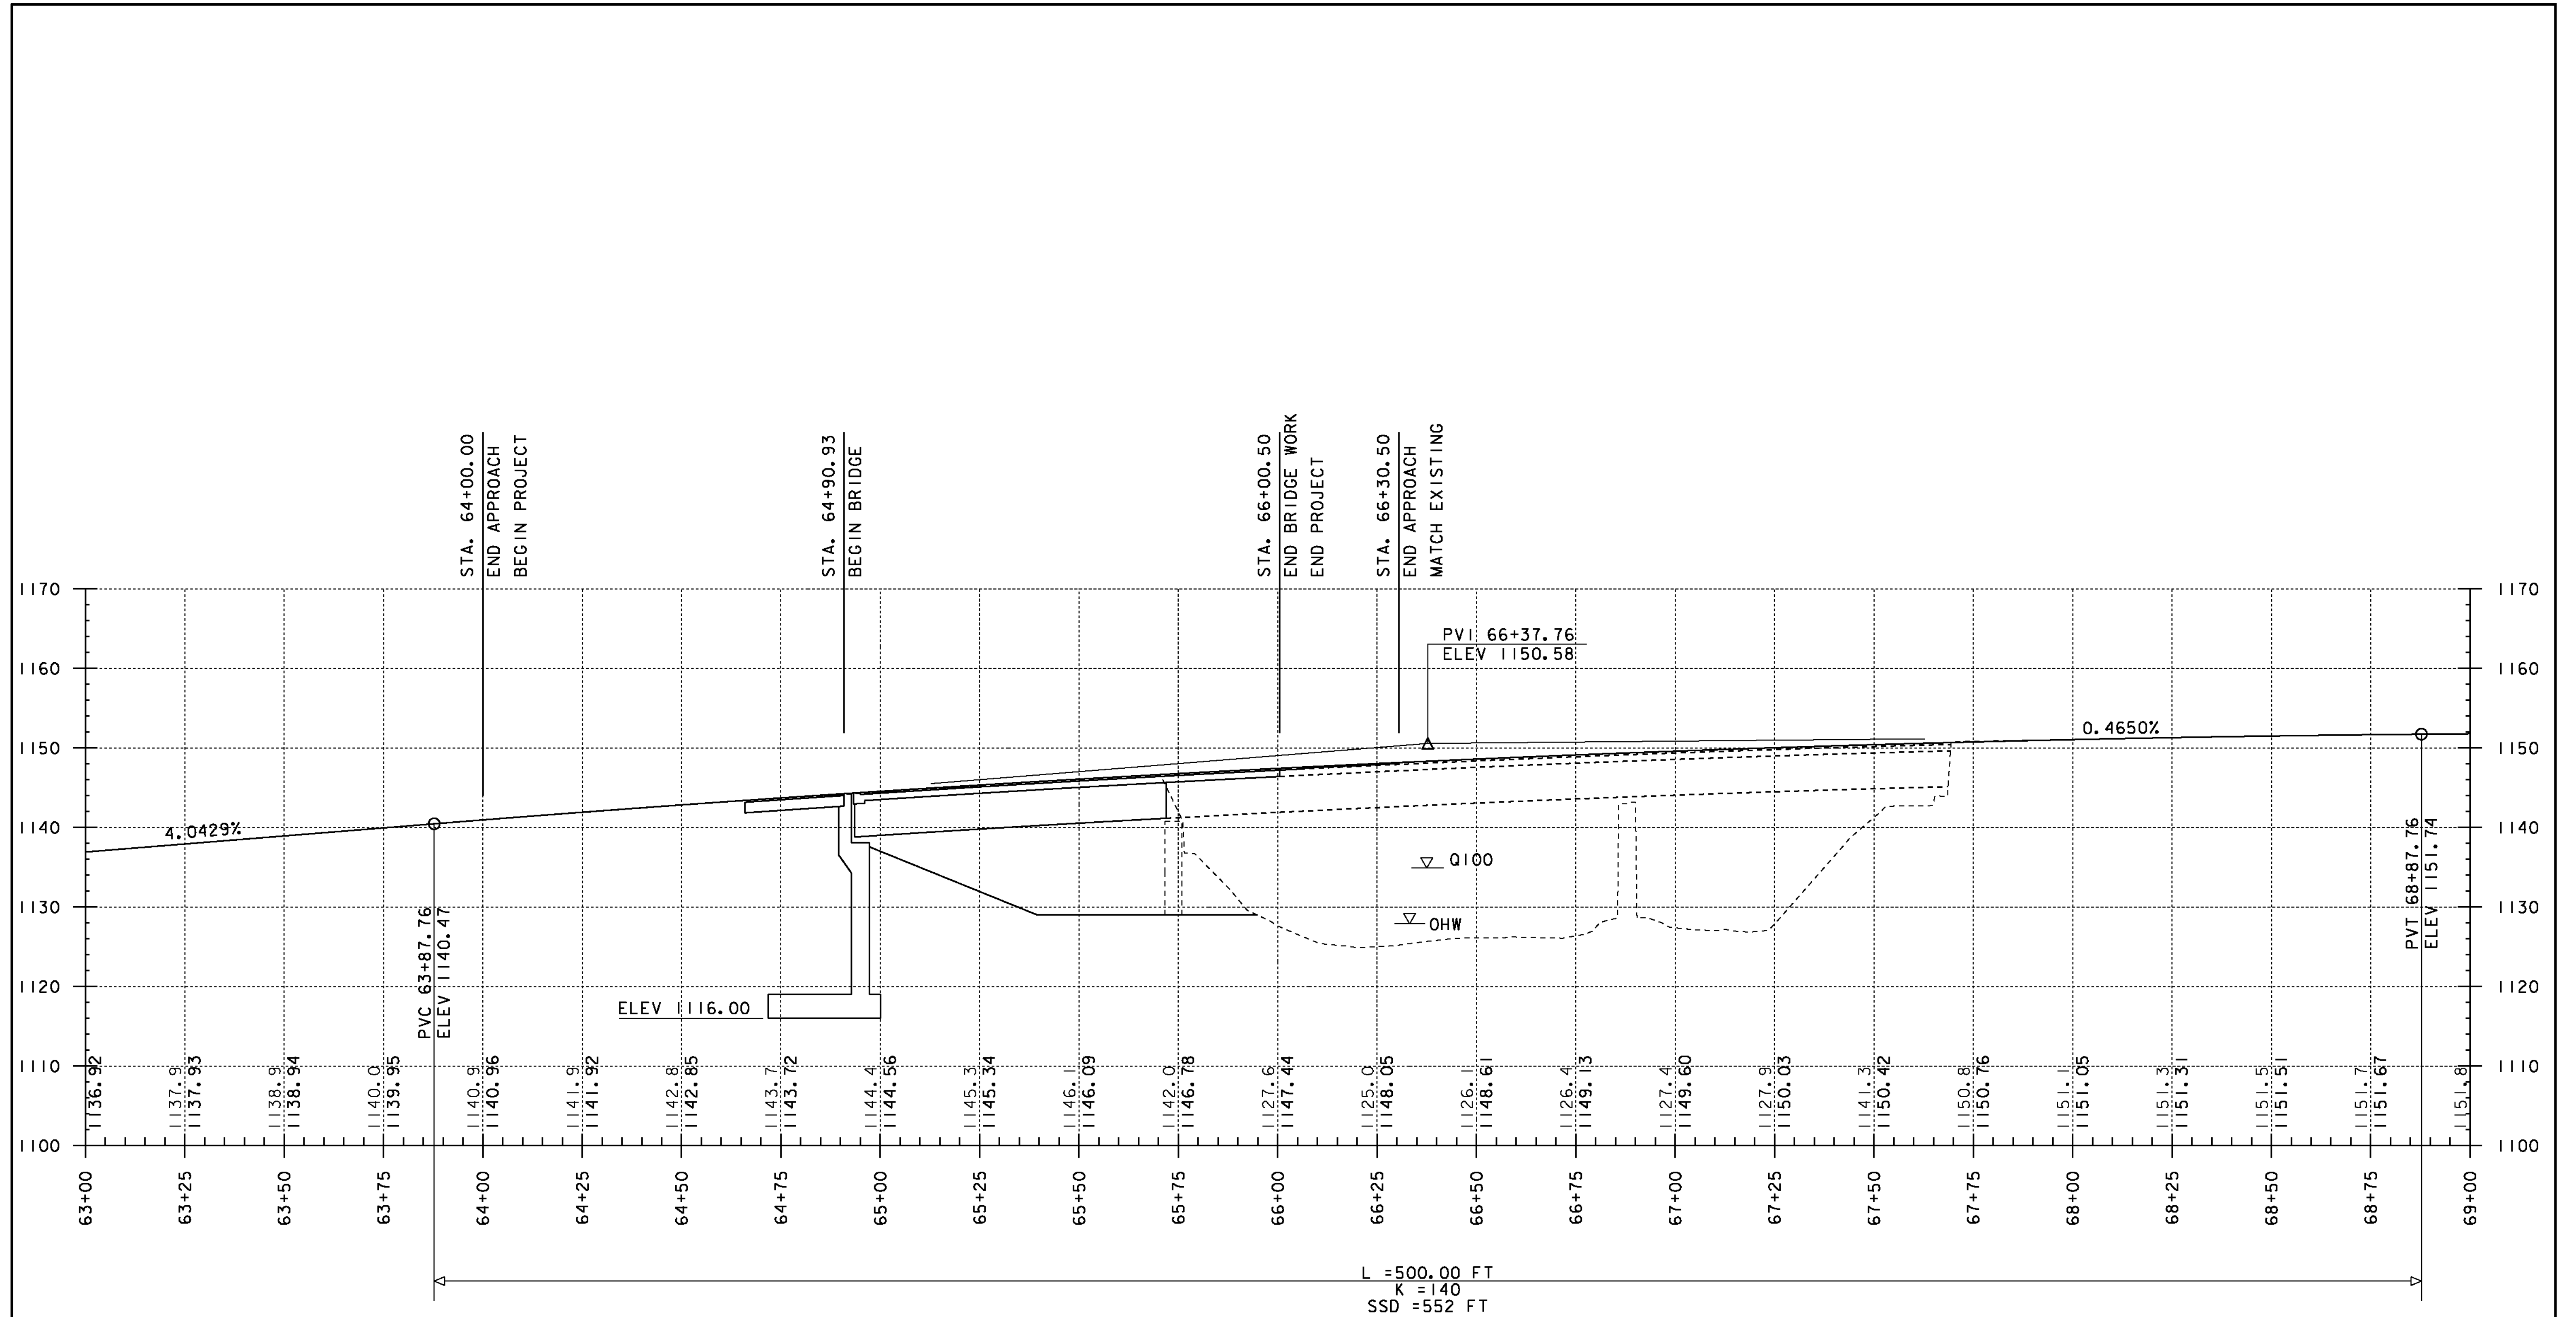

**PROFILE ALONG VT 9**  
 HORIZONTAL SCALE: 1" = 20'-0"  
 VERTICAL SCALE: 1" = 10'-0"

NOTE:  
 ELEVATIONS SHOWN TO THE NEAREST TENTH ARE  
 EXISTING GROUND ALONG PROPOSED CENTERLINE.  
 ELEVATIONS SHOWN TO THE NEAREST HUNDREDTH ARE  
 FINISH GRADES ALONG PROPOSED CENTERLINE.

PROJECT NAME: WOODFORD	
PROJECT NUMBER: ER BHF 010-1(44)	
FILE NAME: s11b214xs.dgn	PLOT DATE: 23-MAR-2012
PROJECT LEADER: C. CARLSON	DRAWN BY: EVANS-MONGEON
DESIGNED BY: M.EVANS-MONGEON	CHECKED BY:
PROFILE SHEET (2)	SHEET 14 OF 58

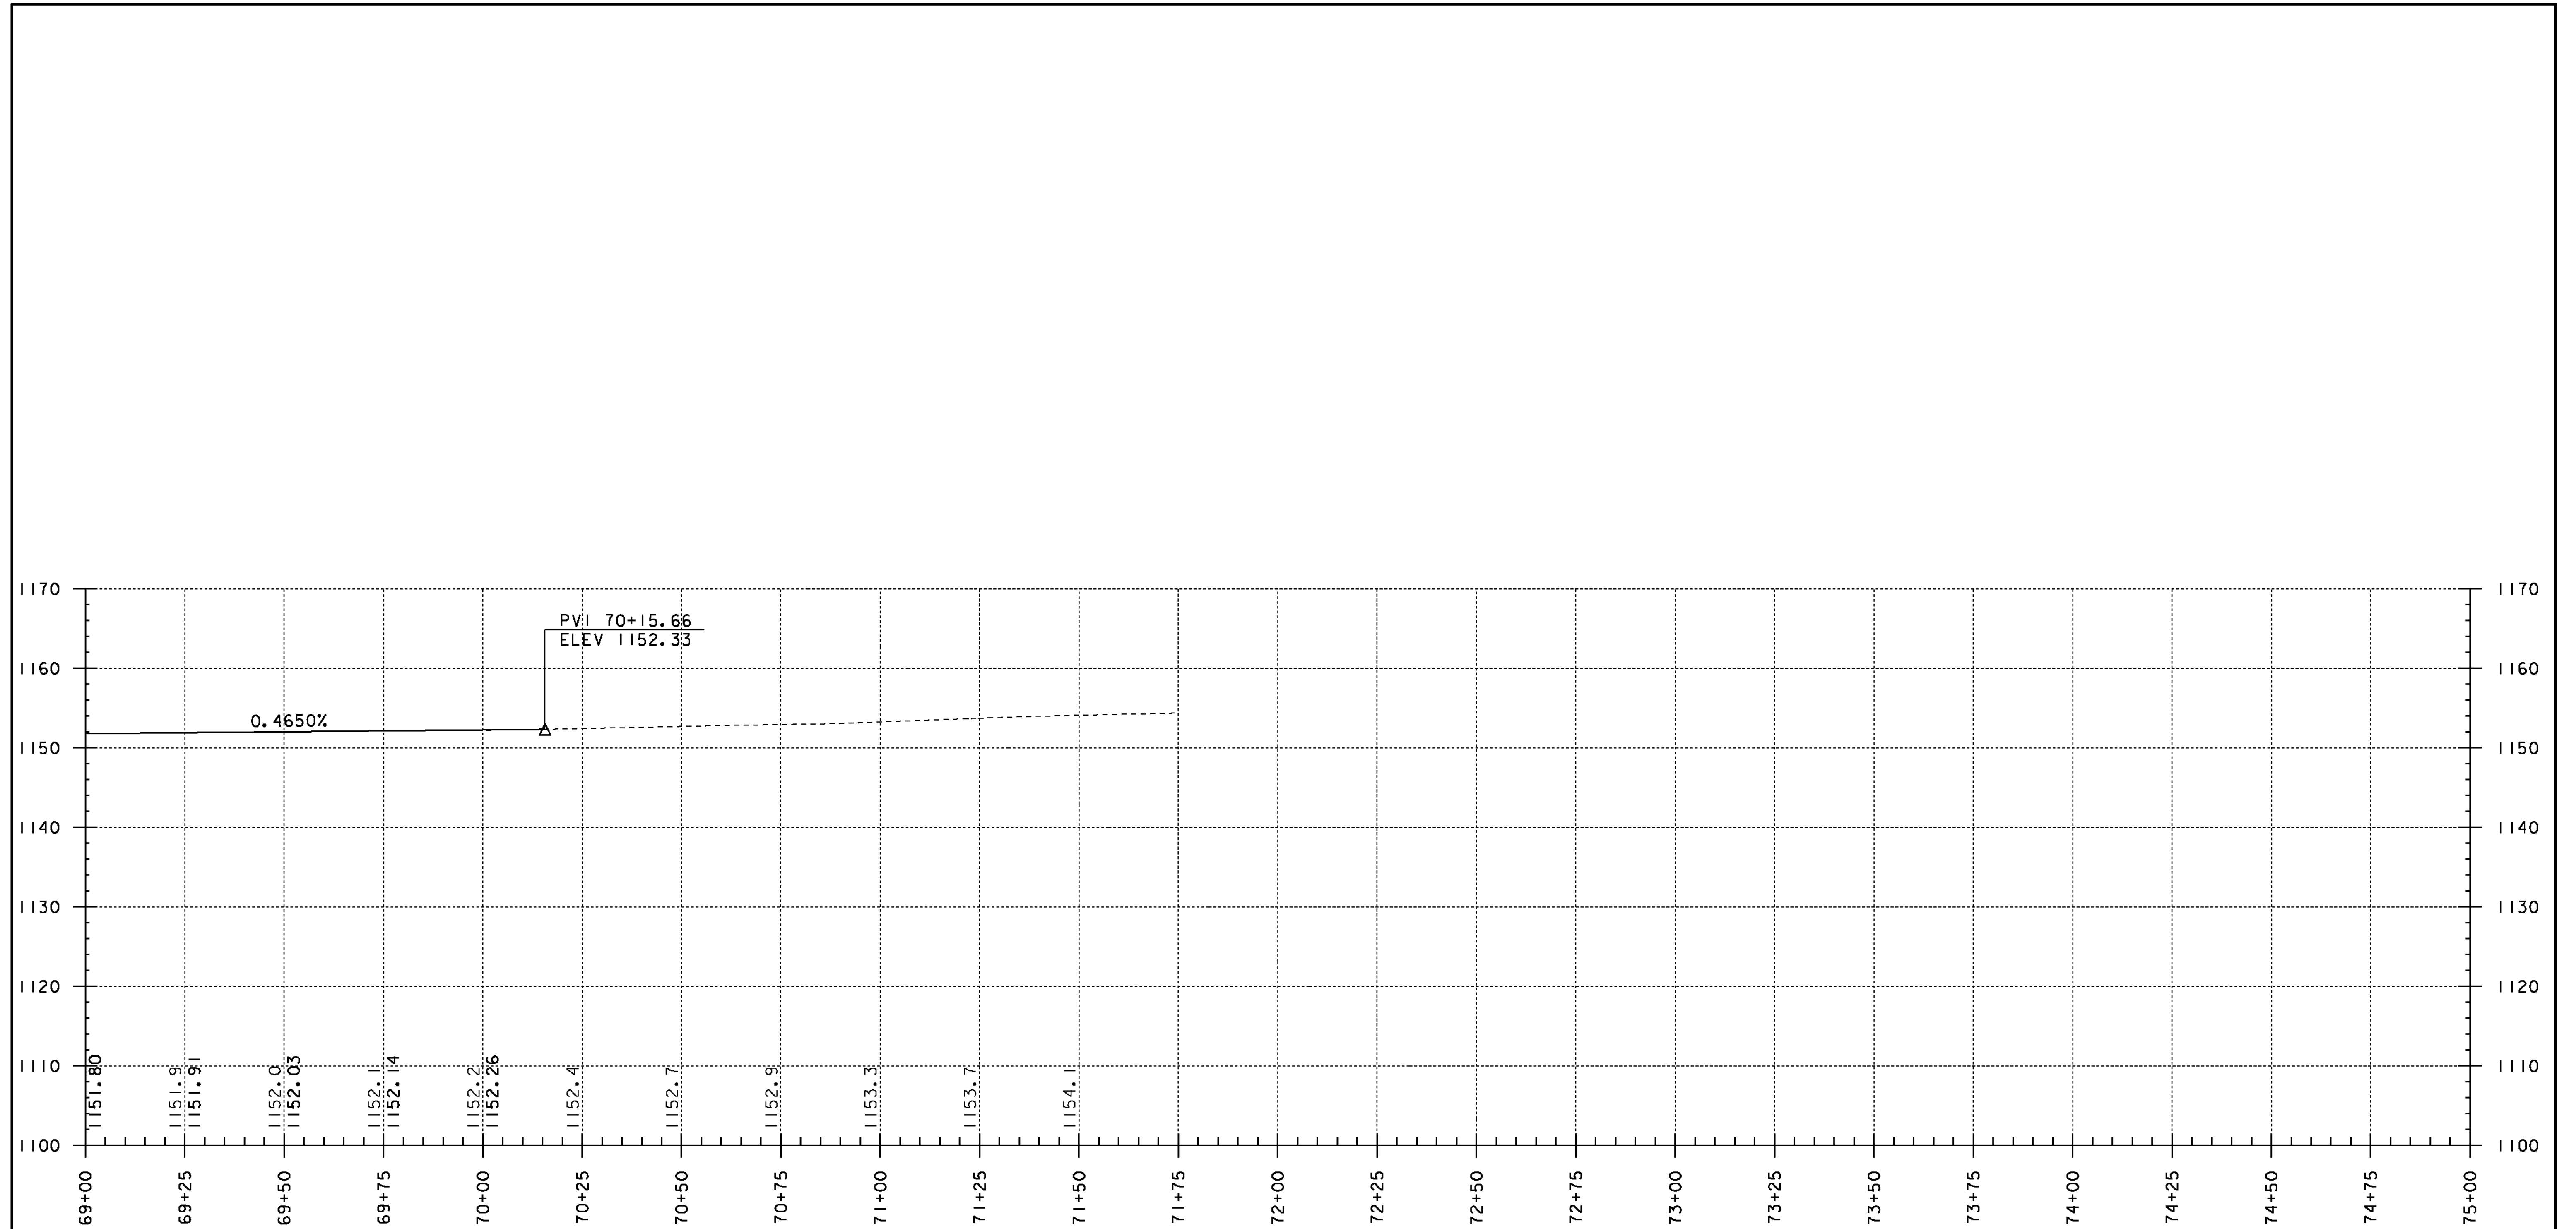

NOTE:


ELEVATIONS SHOWN TO THE NEAREST TENTH ARE  
EXISTING GROUND ALONG PROPOSED CENTERLINE.

ELEVATIONS SHOWN TO THE NEAREST HUNDREDTH ARE  
FINISH GRADES ALONG PROPOSED CENTERLINE.



PROFILE ALONG VT 9

HORIZONTAL SCALE: 1" = 20'-0"  
VERTICAL SCALE: 1" = 10'-0"

PROJECT NAME: WOODFORD	
PROJECT NUMBER: ER BHF 010-1(44)	
FILE NAME: s11b214xs.dgn	PLOT DATE: 23-MAR-2012
PROJECT LEADER: C. CARLSON	DRAWN BY: EVANS-MONGEON
DESIGNED BY: M.EVANS-MONGEON	CHECKED BY:
PROFILE SHEET (3)	SHEET 15 OF 58

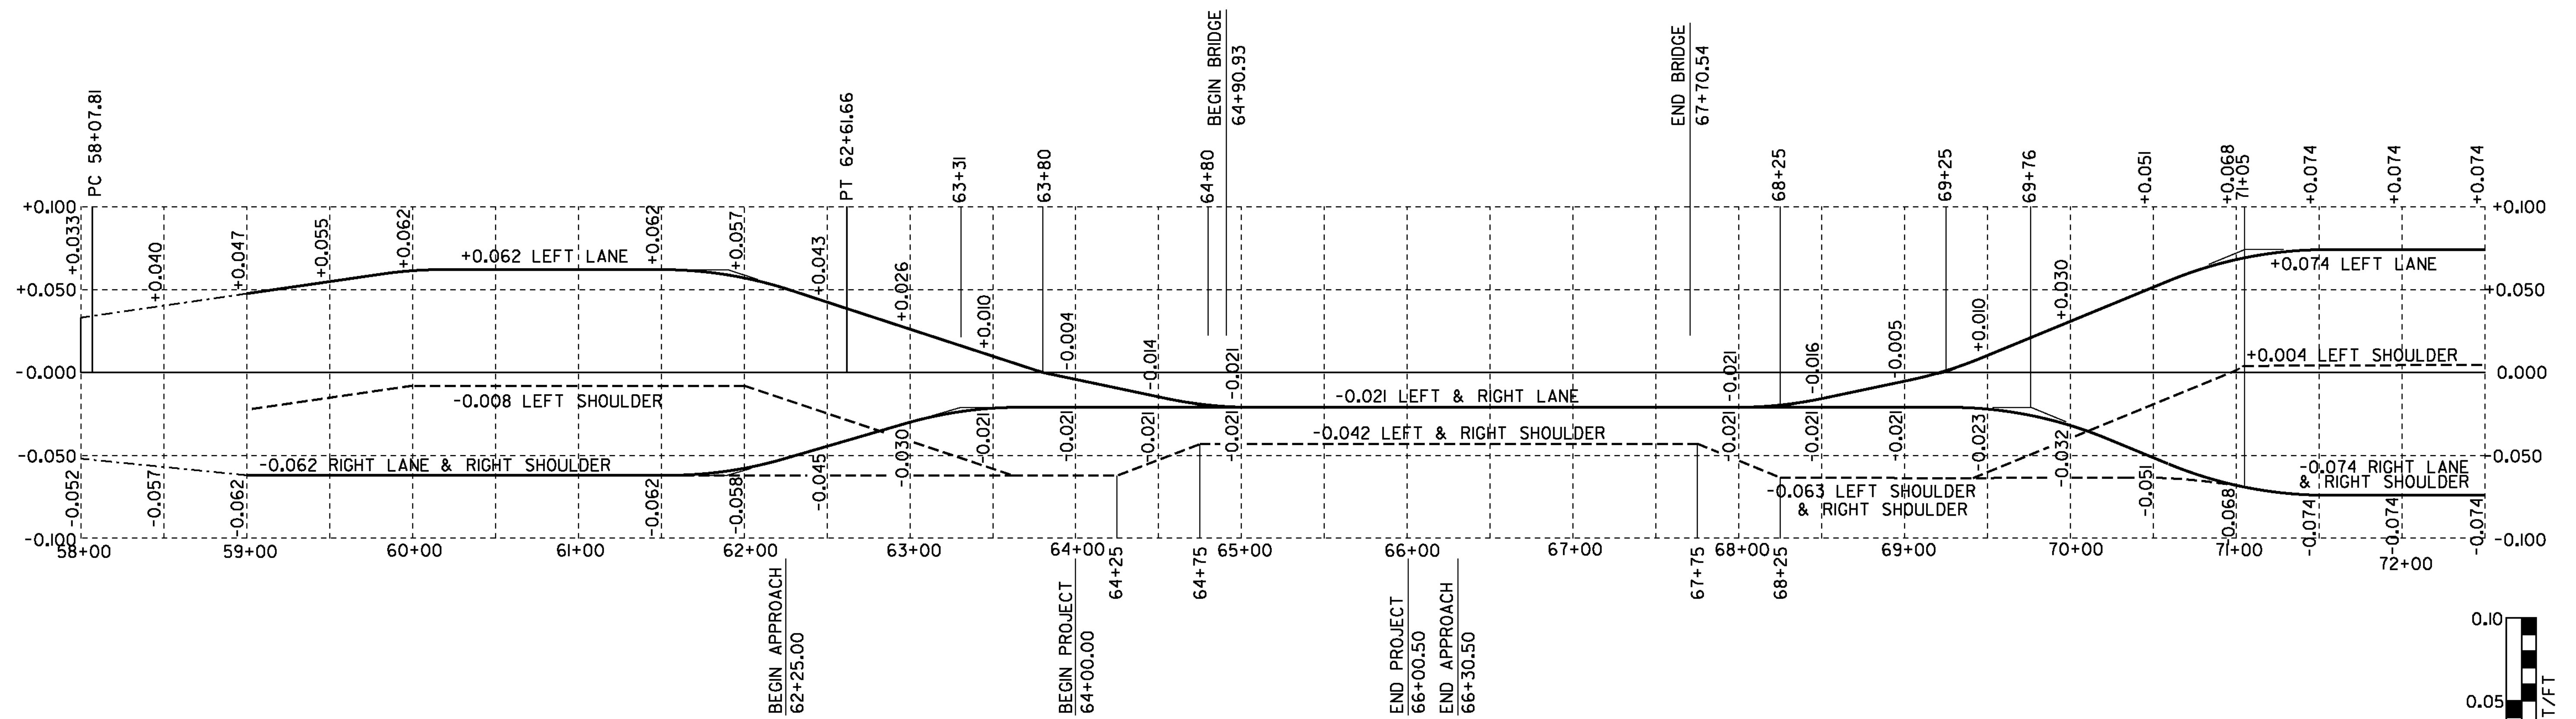

BANKING DIAGRAM

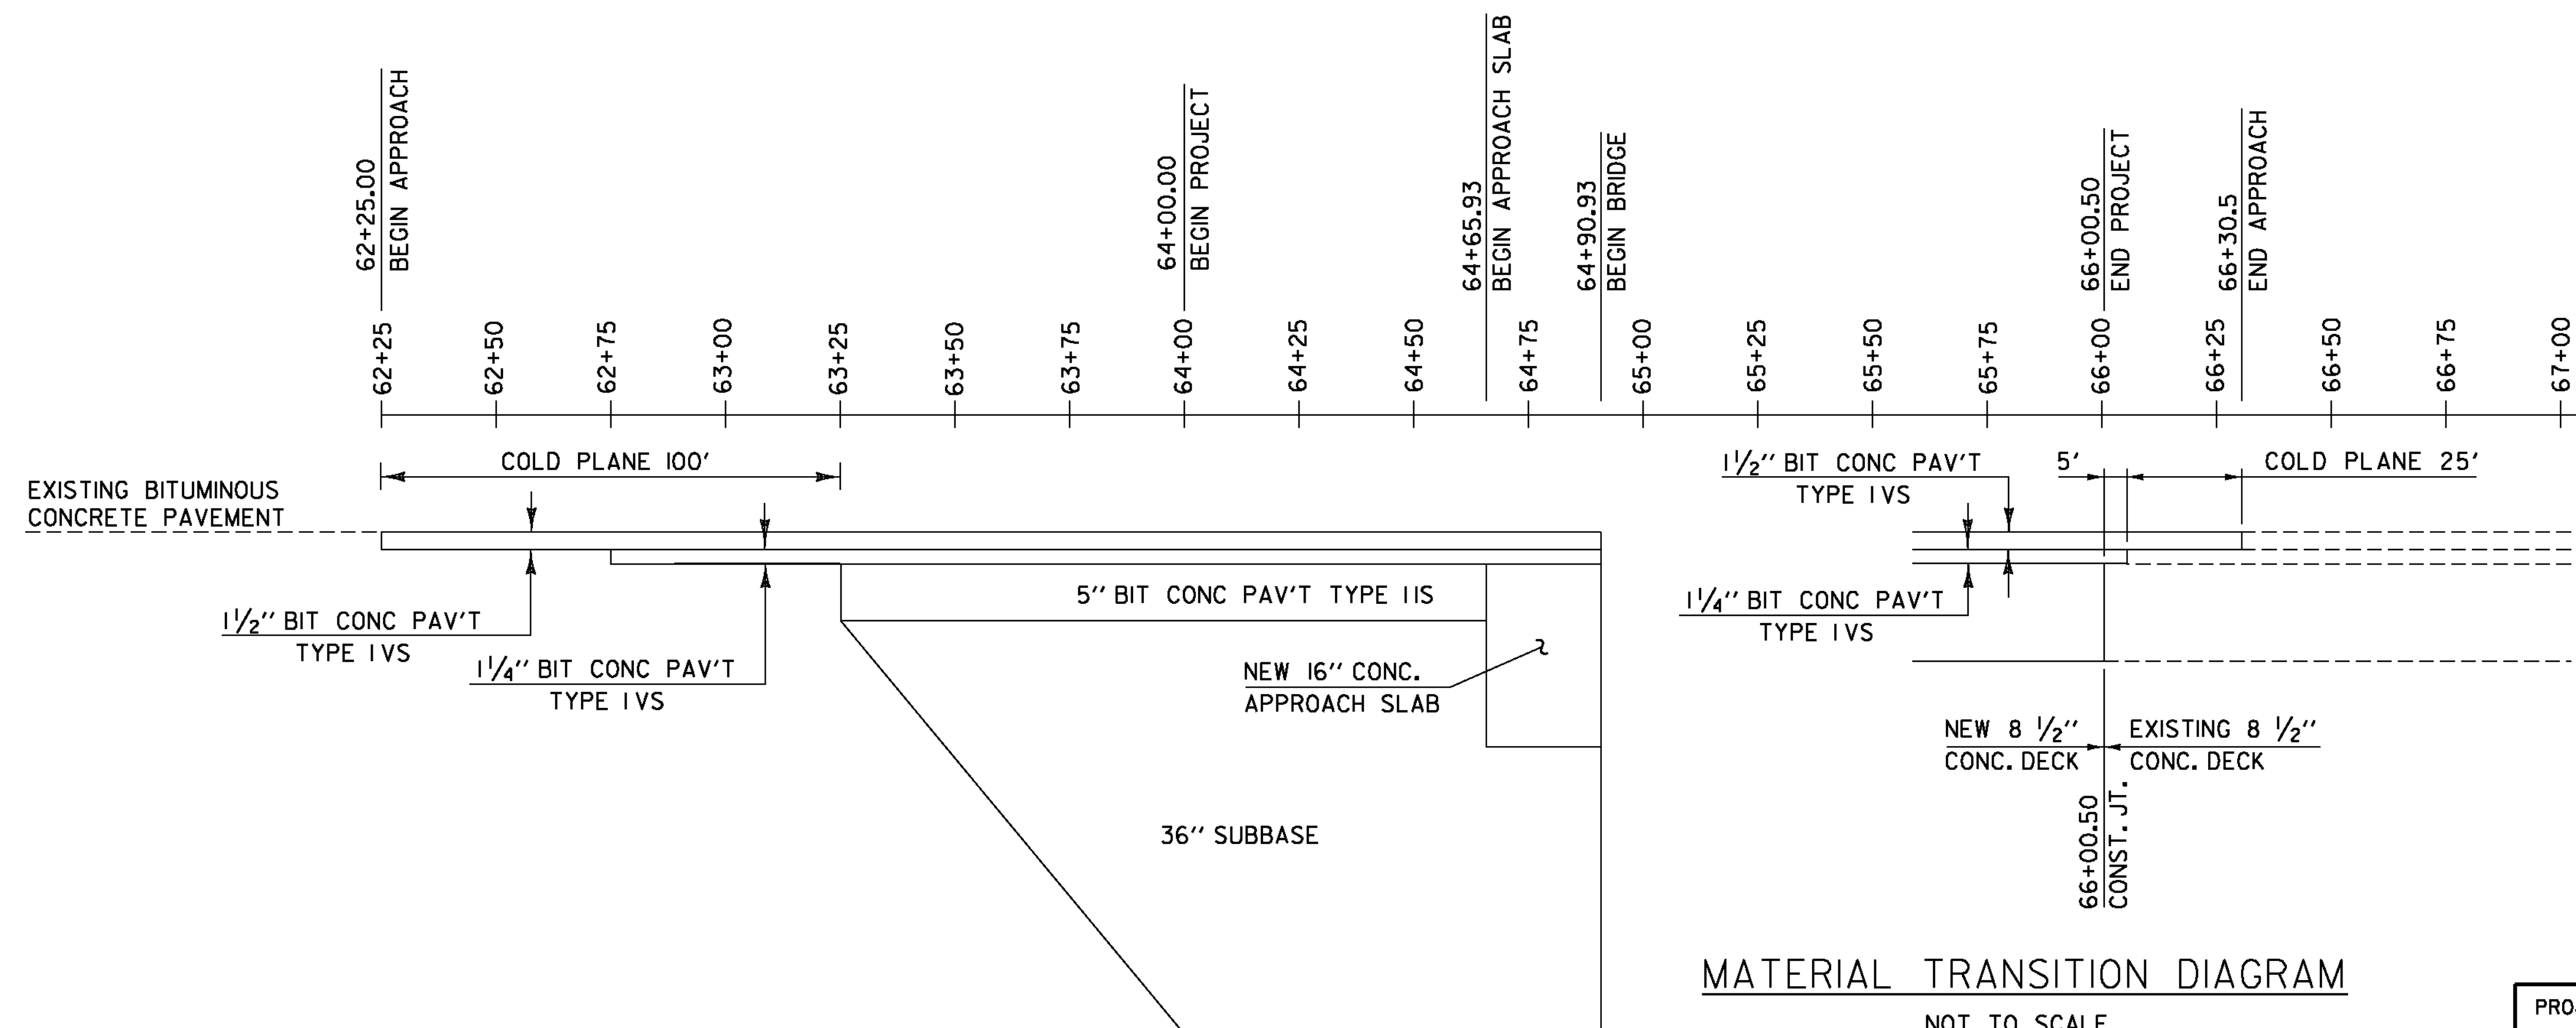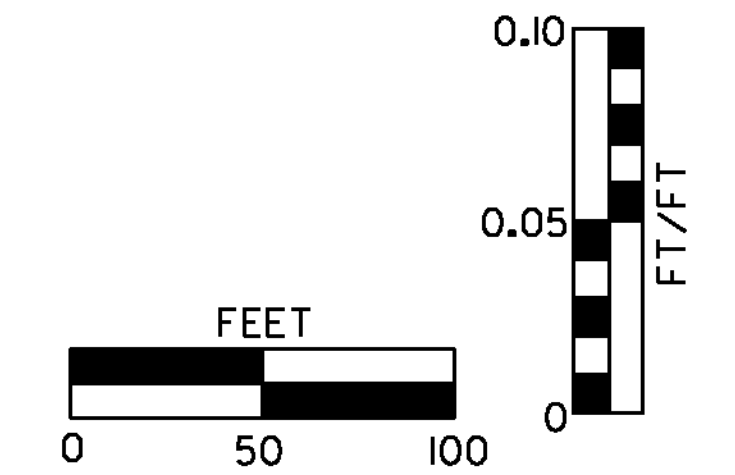

MATERIAL TRANSITION DIAGRAM

NOT TO SCALE

PROJECT NAME:	WOODFORD
PROJECT NUMBER:	ER BHF OIO-I(44)
FILE NAME:	slb214banking.dgn
PROJECT LEADER:	C. CARLSON
DESIGNED BY:	M. EVANS-MONGEON
BANKING DIAGRAM & MATERIAL TRANSITION	
PLOT DATE:	23-MAR-2012
DRAWN BY:	C. MOONEY
CHECKED BY:	EVANS-MONGEON
SHEET	16 OF 58

**SOIL CLASSIFICATION**

AASHTO

A1	Gravel and Sand
A3	Fine Sand
A2	Silty or Clayey Gravel and Sand
A4	Silty Soil - Low Compressibility
A5	Silty Soil - Highly Compressible
A6	Clayey Soil - Low Compressibility
A7	Clayey Soil - Highly Compressible

**ROCK QUALITY DESIGNATION**

R.Q.D. (%)	ROCK DESCRIPTION
<25	Very Poor
25 to 50	Poor
51 to 75	Fair
76 to 90	Good
>90	Excellent

**SHEAR STRENGTH**

UNDRAINED SHEAR STRENGTH IN P.S.F.	CONSISTENCY
<250	Very Soft
250-500	Soft
500-1000	Med. Stiff
1000-2000	Stiff
2000-4000	Very Stiff
>4000	Hard

**CORRELATION GUIDE OF "N" TO DENSITY/CONSISTENCY**


DENSITY (GRANULAR SOILS)		CONSISTENCY (COHESIVE SOILS)	
N	DESCRIPTIVE TERM	N	DESCRIPTIVE TERM
<5	Very Loose	<2	Very Soft
5-10	Loose	2-4	Soft
11-24	Med. Dense	5-8	Med. Stiff
25-50	Dense	9-15	Stiff
>50	Very Dense	16-30	Very Stiff
		31-60	Hard
		>60	Very Hard

**COMMONLY USED SYMBOLS**

- ▼ Water Elevation
- ⊙ Standard Penetration Boring
- ⊕ Auger Boring
- ⊖ Rod Sounding
- ⊙ Sample
- N Standard Penetration Test
- Blow Count Per Foot For:  
2" O.D. Sampler  
1 1/2" I.D. Sampler  
Hammer Weight Of 140 Lbs.  
Hammer Fall Of 30"
- YS Field Vane Shear Test
- US Undisturbed Soil Sample
- B Blast
- DC Diamond Core
- MD Mud Drill
- WA Wash Ahead
- HSA Hollow Stem Auger
- AX Core Size 1 1/8"
- BX Core Size 1 3/8"
- NX Core Size 2 1/8"
- M Double Tube Core Barrel Used
- LL Liquid Limit
- PL Plastic Limit
- PI Plasticity Index
- NP Non Plastic
- w Moisture Content (Dry Wgt. Basis)
- D Dry
- M Moist
- MTW Moist To Wet
- W Wet
- Sat Saturated
- Bo Boulder
- Gr Gravel
- Sa Sand
- Sl Silt
- Cl Clay
- HP Hardpan
- Le Ledge
- NLTD No Ledge To Depth
- CNPF Can Not Penetrate Further
- TLOB Top of Ledge Or Boulder
- NR No Recovery
- Rec. Recovery
- %Rec. Percent Recovery
- ROD Rock Quality Designation
- CBR California Bearing Ratio
- < Less Than
- > Greater Than
- R Refusal (N > 100)
- VTSPG NAD83 - See Note 7

**COLOR**

- |     |        |      |              |
|-----|--------|------|--------------|
| blk | Black  | pnk  | Pink         |
| bl  | Blue   | pu   | Purple       |
| brn | Brown  | rd   | Red          |
| dk  | Dark   | tn   | Tan          |
| gry | Gray   | wh   | White        |
| gn  | Green  | yel  | Yellow       |
| lt  | Light  | mltc | Multicolored |
| or  | Orange |      |              |

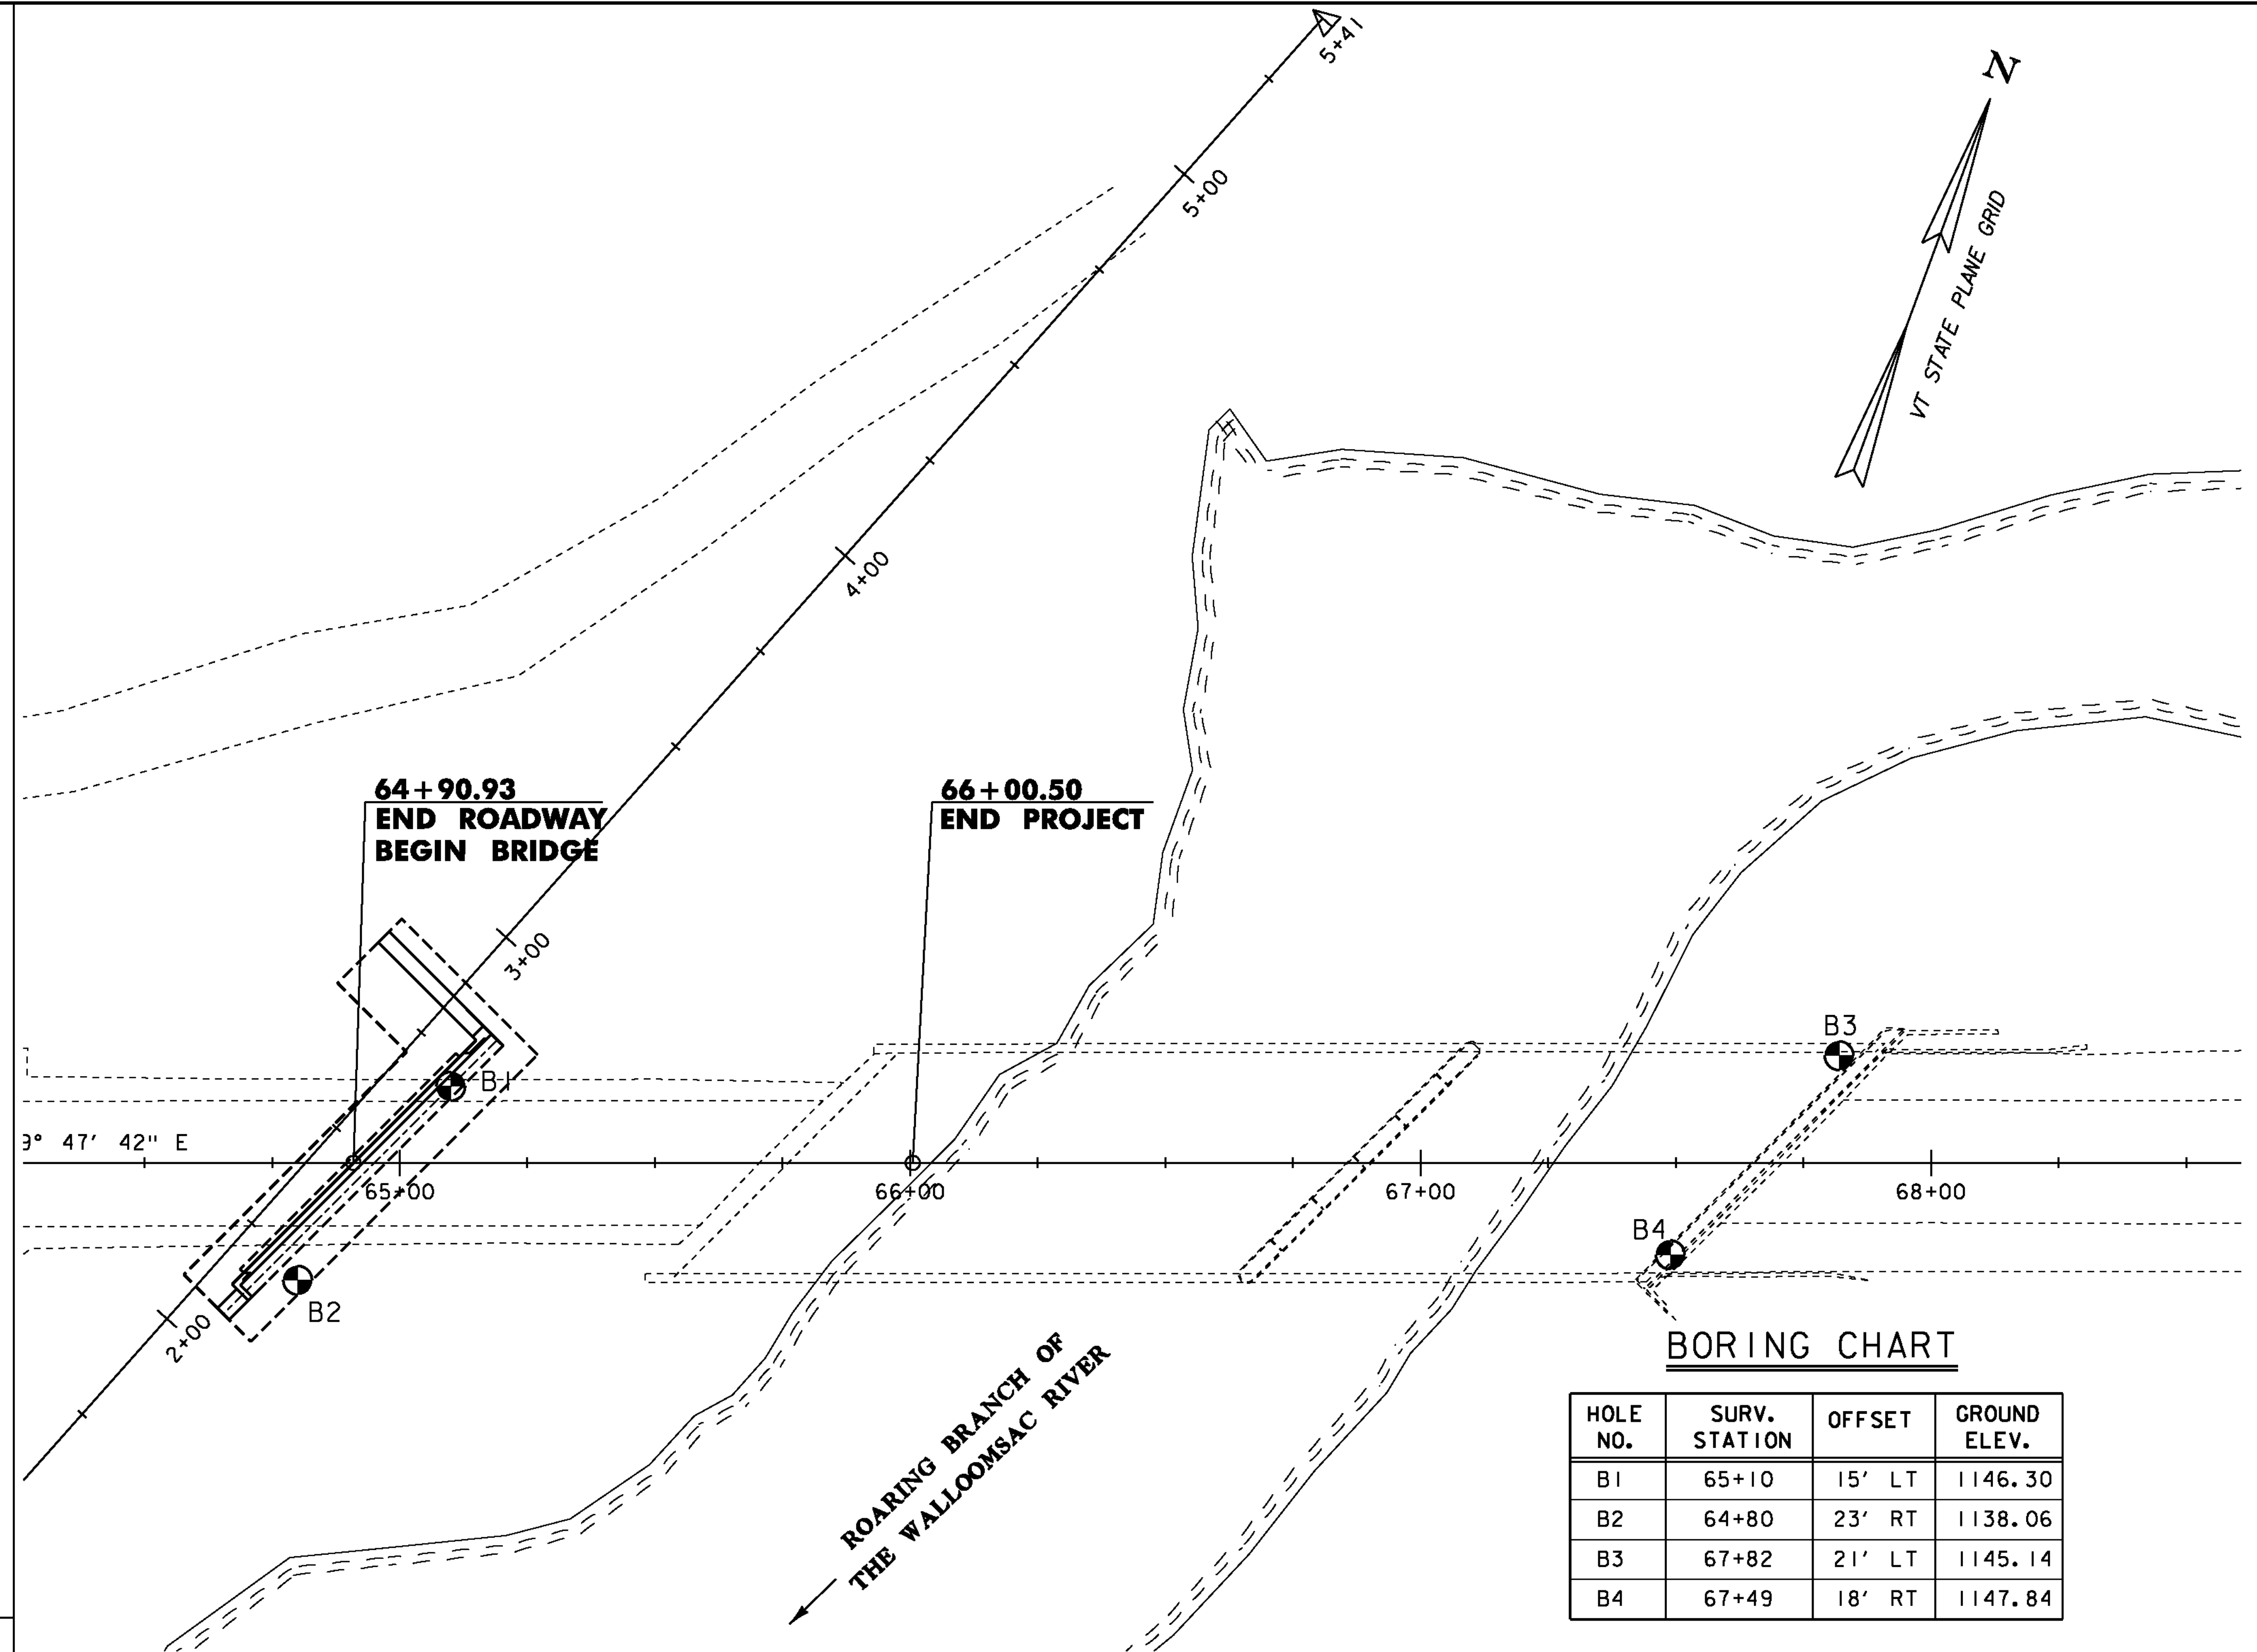

**DEFINITIONS (AASHTO)**

- BEDROCK (LEDGE)** - Rock in its native location of indefinite thickness.
- BOULDER** - A rock fragment with an average dimension > 12 inches.
- COBBLE** - Rock fragments with an average dimension between 3 and 12 inches.
- GRAVEL** - Rounded particles of rock < 3" and > 0.075" (#10 sieve).
- SAND** - Particles of rock < 0.075" (#10 sieve) and > 0.0025" (#200 sieve).
- SILT** - Soil < 0.0025" (#200 sieve), non or slightly plastic and exhibits no strength when air-dried.
- CLAY** - Fine grained soil, exhibits plasticity when moist and considerable strength when air-dried.
- VARVED** - Alternate layers of silt and clay.
- HARDPAN** - Extremely dense soil, cemented layer, not softened when wet.
- MUCK** - Soft organic soil (containing > 10% organic material).
- MOISTURE CONTENT** - Weight of water divided by dry weight of soil.
- FLOWING SAND** - Granular soil so saturated (loose) that it flows into drill casing during extraction of wash rod.
- STRIKE** - Angle from magnetic north to line of intersection of bed with a horizontal plane.
- DIP** - Inclination of bed with a horizontal plane.

**GENERAL NOTES**

- The subsurface explorations shown herein were made between 10/23/1996 and 12/02/1996 by the Agency.
- Soil and rock classifications, properties and descriptions are based on engineering interpretation from available subsurface information by the Agency and may not necessarily reflect actual variations in subsurface conditions that may be encountered between individual boring or sample locations.
- Observed water levels and/or conditions indicated are as recorded at the time of exploration and may vary according to the prevailing rainfall, methods of exploration and other factors.
- Engineering judgment was exercised in preparing the subsurface information presented herein. Analysis and interpretation of subsurface data was performed and interpreted for Agency design and estimating purposes. Presentation of the information in the Contract is intended to provide the Contractor access to the same data available to the Agency. The subsurface information is presented in good faith and is not intended as a substitute for personal investigation, independent interpretation, independent analysis or judgment by the Contractor.
- Pictorial structure details shown on the boring plan layout or soils profile are for illustrative purposes only and may not accurately portray final contract details.
- Terminology used on boring logs to describe the hardness, degree of weathering, and spacing of fractures, joints and other discontinuities in the bedrock is defined in the AASHTO Manual on Subsurface Investigations, 1988.
- Northing and Easting coordinates are shown in Vermont State Plane Grid North American Datum 1983 in meters and survey feet.



PROJECT NAME: WOODFORD  
PROJECT NUMBER: ER BHF 010-1(44)

FILE NAME: s1b214boring.dgn PLOT DATE: 23-MAR-2012  
PROJECT LEADER: C.CARLSON DRAWN BY: EVANS-MONGEO  
DESIGNED BY: M.EVANS-MONGEON CHECKED BY: G.ROY  
BORING INFORMATION SHEET SHEET 17 OF 58

STATE OF VERMONT  
AGENCY OF TRANSPORTATION  
MATERIALS & RESEARCH DIVISION  
SUBSURFACE INFORMATION

HOLE NO.: B-1  
SHEET 1 OF 1  
DATE STARTED: 12/2/96  
DATE COMPLETED: 0/0/0

PROJECT NAME: WOODFORD  
SITE NAME: BRIDGE #11  
STATION: 65+10.00  
GROUND EL.: 1146.30

PROJECT NUMBER: BHF 010-K29  
SITE NO.: ROUTE 9  
OFFSET: -15.00  
G.W. DEPTH:

BORING CREW  
CREW CHIEF: MCGLYNN  
DRILLER: CHABOT E J  
LOGGER:

BORING RIG: TRUCK  
BORING TYPE: WASH BORE  
SAMPLE TYPE: SPLIT BARREL

DEPTH	SYMBOL	CLASSIFICATION OF MATERIALS (Description)	BLOWS PER FOOT	M.C. %	GRAVEL %	SAND %	FINES %	LL	PI
5		No Rec., Boulders							
		BXDC, 7.0'-10.0', Rec. = 2.1'							
10		No Rec.	46						
		BXDC, 12.0'-15.0', Rec. = 1.6'							
15		No Rec.	46						
		BXDC, 17.0'-20.0', Rec. = 3.0', Boulders							
20		A-1-b, GrSa, br, MTW, Rec. = 0.4'	R	13.2	40.6	50	9.4		
		BXDC, 21.0'-25.0', Rec. = 1.5'							
25		A-1-b, GrSa, br, MTW, Rec. = 1.0'	R	11.3	35.8	56.8	7.4		
		BXDC, 26.5'-30.0', Rec. = 1.5'							
30		A-1-b, GrSa, br, MTW, Rec. = 0.9'	R	12.2	35.7	56.2	8.1		
		BXDC, 31.5'-35.0', Rec. = 1.6'							
35		A-1-b, GrSa, br, MTW, Rec. = 1.7'	R	12.4	45.8	46.6	7.6		
40									
45									
			Hole stopped @ 37.0' in SaGr + Bo						

STATE OF VERMONT  
AGENCY OF TRANSPORTATION  
MATERIALS & RESEARCH DIVISION  
SUBSURFACE INFORMATION

HOLE NO.: B-2  
SHEET 1 OF 1  
DATE STARTED: 11/14/96  
DATE COMPLETED: 11/21/96

PROJECT NAME: WOODFORD  
SITE NAME: BRIDGE #11  
STATION: 64+80.00  
GROUND EL.: 1138.06

PROJECT NUMBER: BHF 010-K29  
SITE NO.: ROUTE 9  
OFFSET: 23.00  
G.W. DEPTH:

BORING CREW  
CREW CHIEF: MCGLYNN  
DRILLER: CHABOT E J  
LOGGER:

BORING RIG: TRUCK  
BORING TYPE: WASH BORE  
SAMPLE TYPE: SPLIT BARREL

DEPTH	SYMBOL	CLASSIFICATION OF MATERIALS (Description)	BLOWS PER FOOT	M.C. %	GRAVEL %	SAND %	FINES %	LL	PI
5		BXDC, 0.0'-5.0', Rec. = 4.1'							
		BXDC, 5.0'-10.0', Rec. = 3.2'							
10		No Rec., Boulders	R						
		BXDC, 11.5'-14.0', Rec. = 2.1'							
15		No Rec., Boulders	R						
		BXDC, 16.0'-20.0', Rec. = 1.6'							
20		A-1-a, SaGr, br, MTW, Rec. = 0.4'	R	11.6	51.7	39.8	8.5		
		BXDC, 21.5'-25.0', Rec. = 1.5'							
25		A-1-a, SaGr, br, MTW, Rec. = 0.5'	R	16.3	67.5	24.4	8.1		
		BXDC, 27.0'-30.0', Rec. = 3.0'							
30		A-1-a, SaGr, br, MTW, Rec. = 0.5'	R	12.5	60.8	29.8	9.4		
		BXDC, 31.0'-35.0', Rec. = 1.7'							
35		A-1-b, SaGr, br, MTW, Rec. = 0.5'	R	9.3	49.4	34.9	15.7		
40									
45									
			Hole stopped @ 37.0' in Gr, HP + Bo						

STATE OF VERMONT  
AGENCY OF TRANSPORTATION  
MATERIALS & RESEARCH DIVISION  
SUBSURFACE INFORMATION

HOLE NO.: B-3  
SHEET 1 OF 1  
DATE STARTED: 0/0/0  
DATE COMPLETED: 0/0/0

PROJECT NAME: WOODFORD  
SITE NAME: BRIDGE #11  
STATION: 67+82.00  
GROUND EL.: 1145.14

PROJECT NUMBER: BHF 010-K29  
SITE NO.: ROUTE 9  
OFFSET: -21.00  
G.W. DEPTH:

BORING CREW  
CREW CHIEF: MCGLYNN  
DRILLER: CHABOT E J  
LOGGER:

BORING RIG: TRUCK  
BORING TYPE: WASH BORE  
SAMPLE TYPE: SPLIT BARREL

DEPTH	SYMBOL	CLASSIFICATION OF MATERIALS (Description)	BLOWS PER FOOT	M.C. %	GRAVEL %	SAND %	FINES %	LL	PI
5		BXDC, 3.0'-6.0', No Rec., Boulders							
10		No Rec., Gravelly Material with Boulders	41						
		BXDC, 12.0'-14.0', Boulders							
15		A-1-a, SaGr, br, Wet, Rec. = 0.4'	39	15.9	71.7	23.7	4.6		
		BXDC, 18.0'-20.0', Rec. = 1.4', Boulders							
20		A-1-a, SaGr, br, MTW, Rec. = 1.1'	29	11.7	56.6	33.3	10.1		
		BXDC, 22.0'-24.0', Rec. = 1.5', Boulders							
25		A-1-a, SaGr, br, MTW, Rec. = 0.5'	R	10.8	55	37.1	7.9		
		BXDC, 27.0'-29.0', Rec. = 1.6', Boulders							
30		A-1-a, SaGr, br, MTW, Rec. = 0.5'	R	12.6	53.3	38.3	8.4		
		BXDC, 32.0'-33.5', Rec. = 1.1', Boulders							
35		A-1-a, SaGr, br, MTW, Rec. = 0.4'	R	14.7	59.3	33.3	7.4		
40									
45									
			Hole stopped @ 37.0' in Sa, Gr + Bo						

STATE OF VERMONT  
AGENCY OF TRANSPORTATION  
MATERIALS & RESEARCH DIVISION  
SUBSURFACE INFORMATION

HOLE NO.: B-4  
SHEET 1 OF 1  
DATE STARTED: 10/29/96  
DATE COMPLETED: 11/1/96

PROJECT NAME: WOODFORD  
SITE NAME: BRIDGE #11  
STATION: 67+49.00  
GROUND EL.: 1147.84


PROJECT NUMBER: BHF 010-K29  
SITE NO.: ROUTE 9  
OFFSET: 18.00  
G.W. DEPTH:

BORING CREW  
CREW CHIEF: MCGLYNN  
DRILLER: CHABOT E J  
LOGGER:

BORING RIG: TRUCK  
BORING TYPE: WASH BORE  
SAMPLE TYPE: SPLIT BARREL

DEPTH	SYMBOL	CLASSIFICATION OF MATERIALS (Description)	BLOWS PER FOOT	M.C. %	GRAVEL %	SAND %	FINES %	LL	PI
5		No Rec., On Boulder							
		BXDC, 5.2'-7.4', Boulders							
10		A-1-a, SaGr, br, Moist, Rec. = 0.5'	22	16.7	73.1	20.4	6.5		
15		A-1-a, Gr, br, Moist, Rec. = 0.2'	R	N/A	87.2	10.2	2.6		
		No Rec., Boulders							
20		A-1-b, SaGr, br, Wet, Rec. = 0.8'	49	12.8	46.9	37.2	15.9		
25		A-1-a, SaGr, br, MTW, Rec. = 1.2'	39	11.6	52	33.5	14.5		
30		A-1-a, SaGr, br, Moist, Rec. = 1.4'	72	10.4	53.9	31.6	14.5		
35		A-1-a, SaGr, br, Moist, Rec. = 0.6'	R	9.6	51.2	38	10.8		
40		No Rec., Boulders							
		BXDC, 40.4'-43.0', Boulders							
45									
			Hole stopped @ 43.0'						

SURVEYED BY: J. TOUCHETTE DATE: 04/97  
DRAWN BY: C.C. BENDA  
SQUAD LEADER: /matres/84e039/me039bor.dgn  
DESIGN FILE NO.: /matres/84e039/me039bor.dgn  
IPARM FILE: BORING LOGS DATE PLOTTED: 23-MAR-2012  
PROJ. NAME: WOODFORD  
PROJ. NO.: ER BHF 010-I(44)  
SHEET 18 OF 58 SHEETS

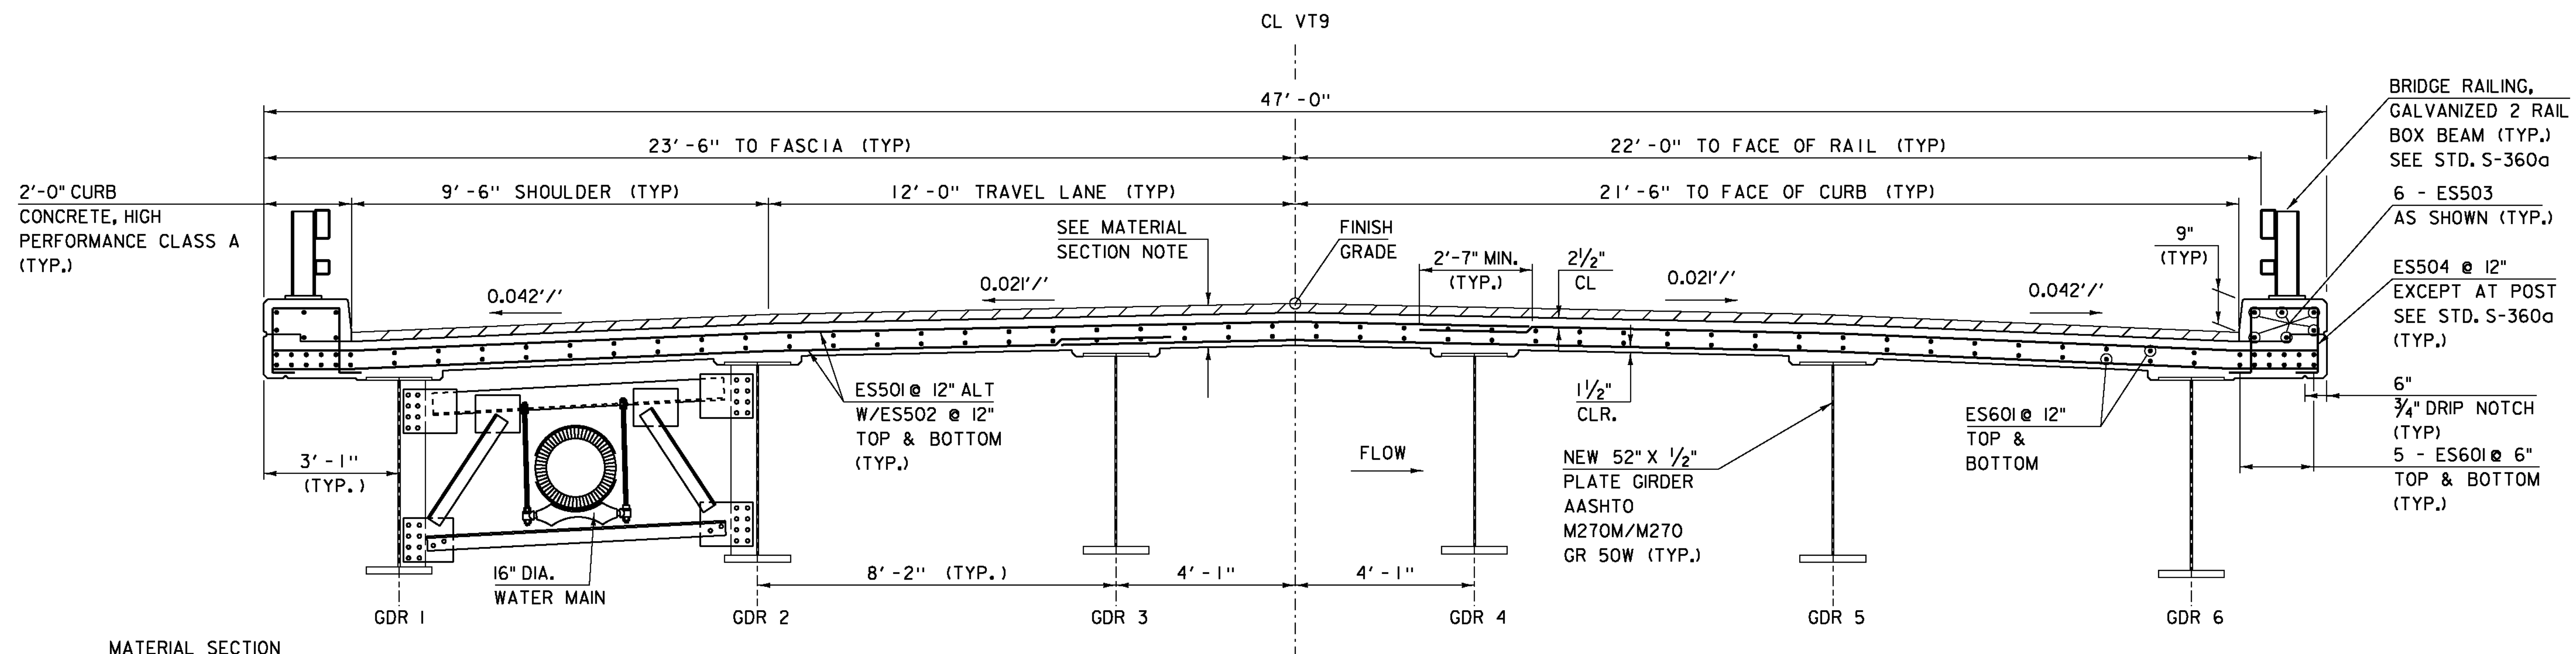


**MATERIAL SECTION**  
 1 1/2" BITUMINOUS CONCRETE PAVEMENT TYPE IVS  
 1 1/4" BITUMINOUS CONCRETE PAVEMENT TYPE IVS  
 SHEET MEMBRANE WATERPROOFING, TORCH APPLIED  
 8 1/2" DECK CONCRETE, HIGH PERFORMANCE CLASS A

BITUMINOUS CONCRETE PAVEMENT SHALL BE PAID FOR UNDER  
 ITEM 900.680 SPECIAL PROVISION (BITUMINOUS CONCRETE  
 PAVEMENT, SMALL QUANTITY).




EMULSIFIED ASPHALT SHALL BE APPLIED AT A RATE OF  
 0.040 GAL / SY BETWEEN SUCCESSIVE COURSES OF PAVEMENT  
 AS DIRECTED BY THE ENGINEER.

**NEW BRIDGE TYPICAL SECTION**  
 SCALE 1/2" = 1'-0"

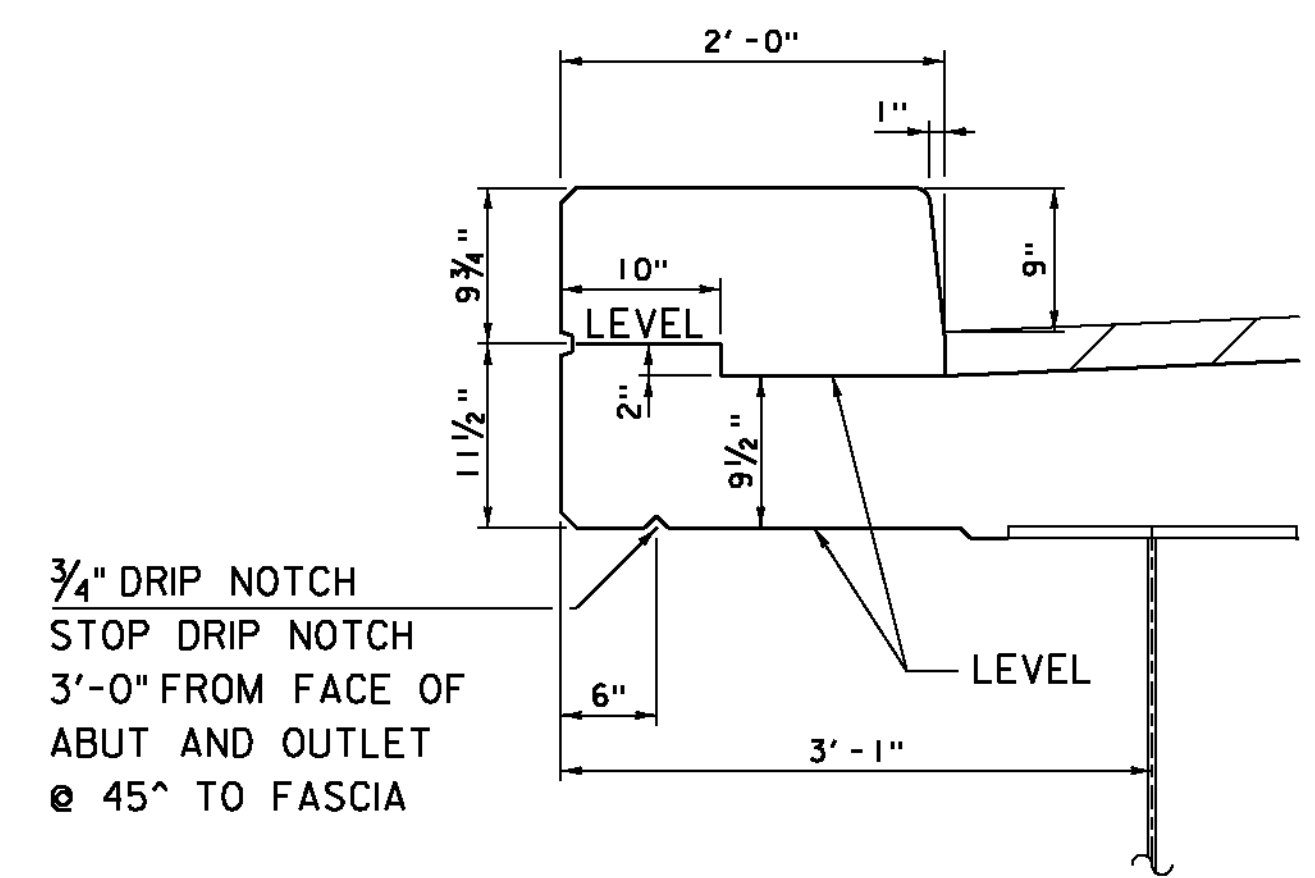


**CURB TYPICAL SECTION**  
 SCALE 1" = 1'-0"

PROJECT NAME: WOODFORD	PLOT DATE: 23-MAR-2012
PROJECT NUMBER: ER BHF 010-1(44)	DRAWN BY: C. MOONEY
FILE NAME: slb214sup.dgn	CHECKED BY: M. EVANS-MONGEON
PROJECT LEADER: C. CARLSON	SHEET 19 OF 58
DESIGNED BY: M. EVANS-MONGEON	
DECK TYPICAL SECTION	

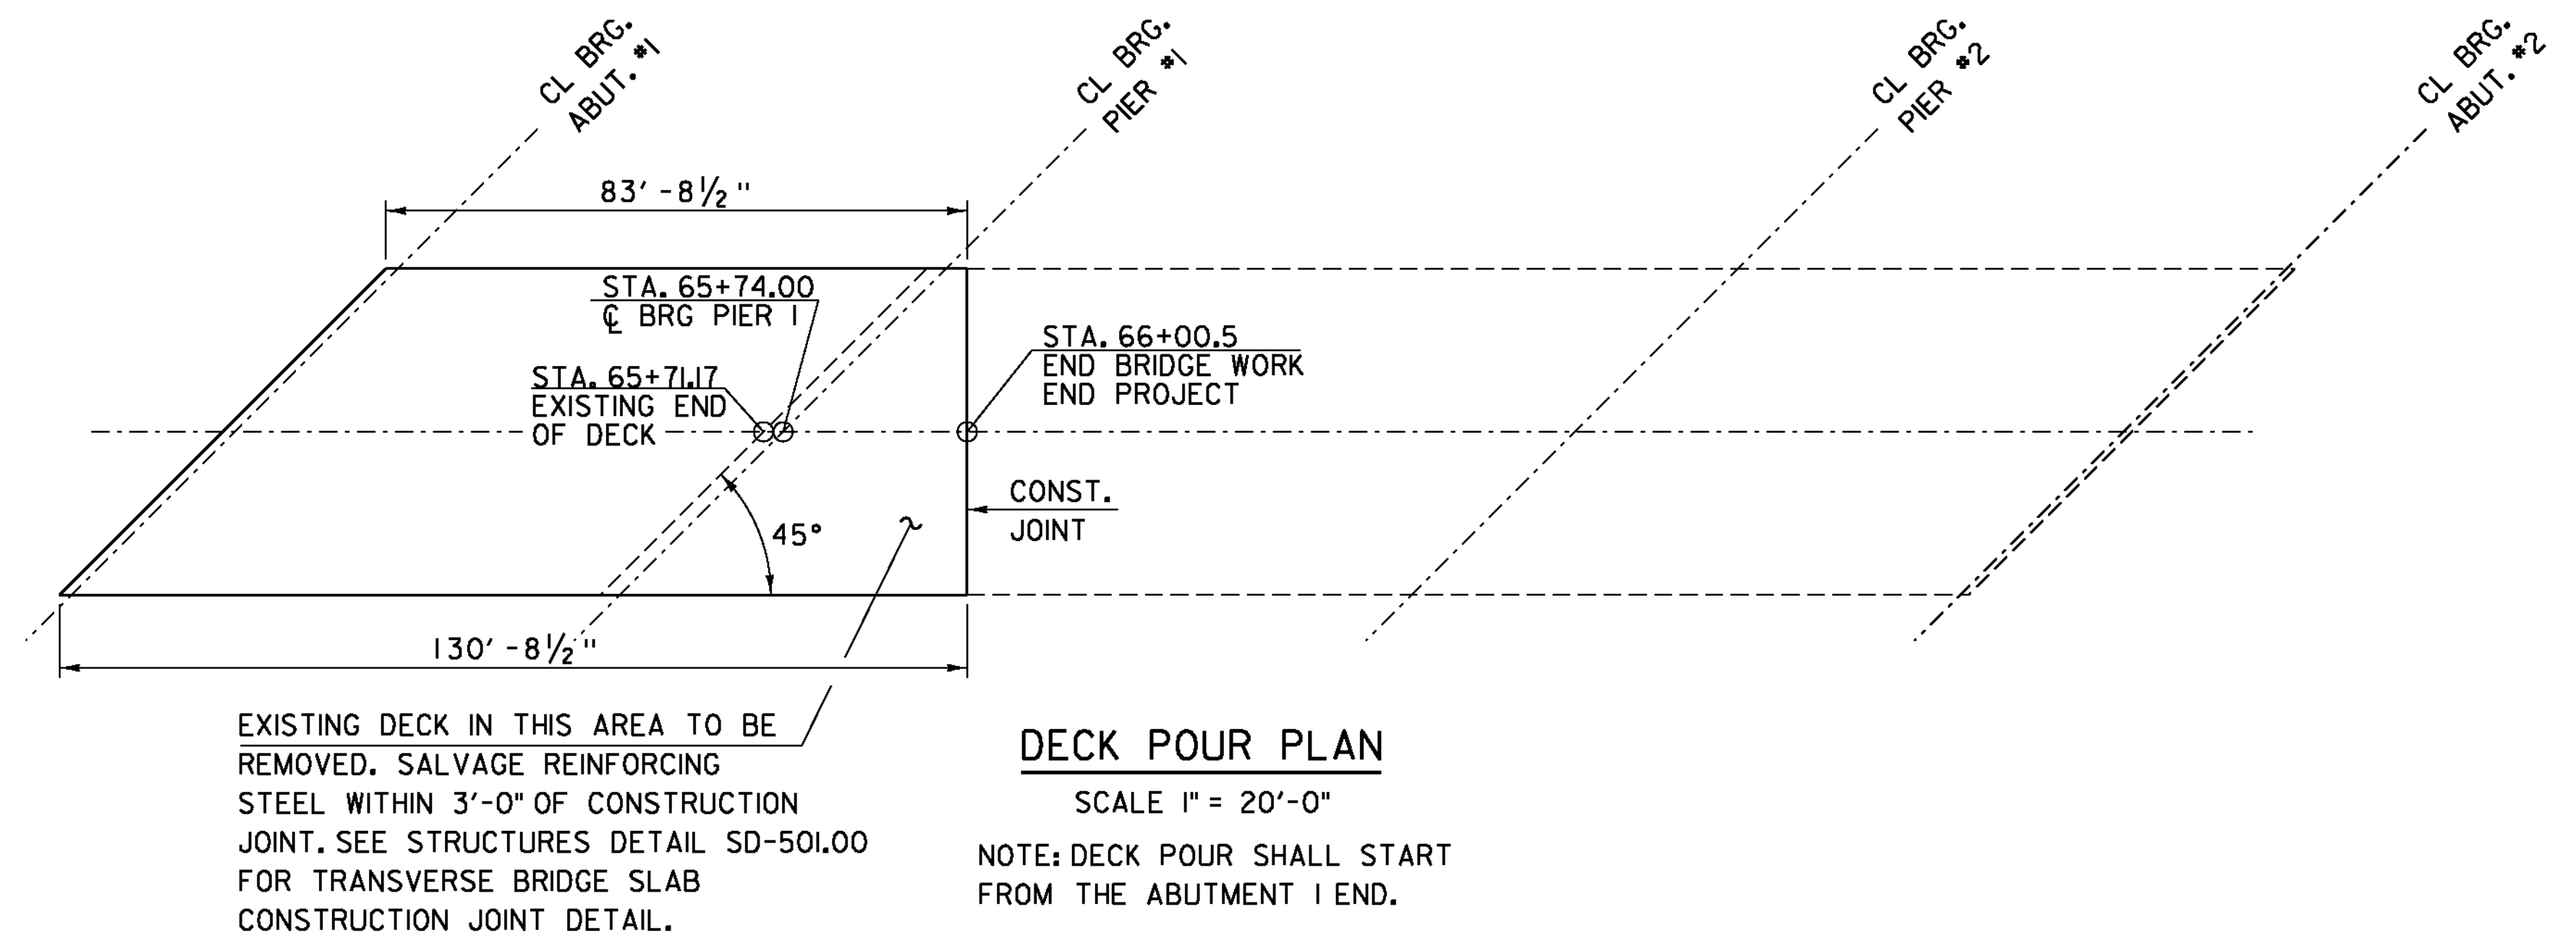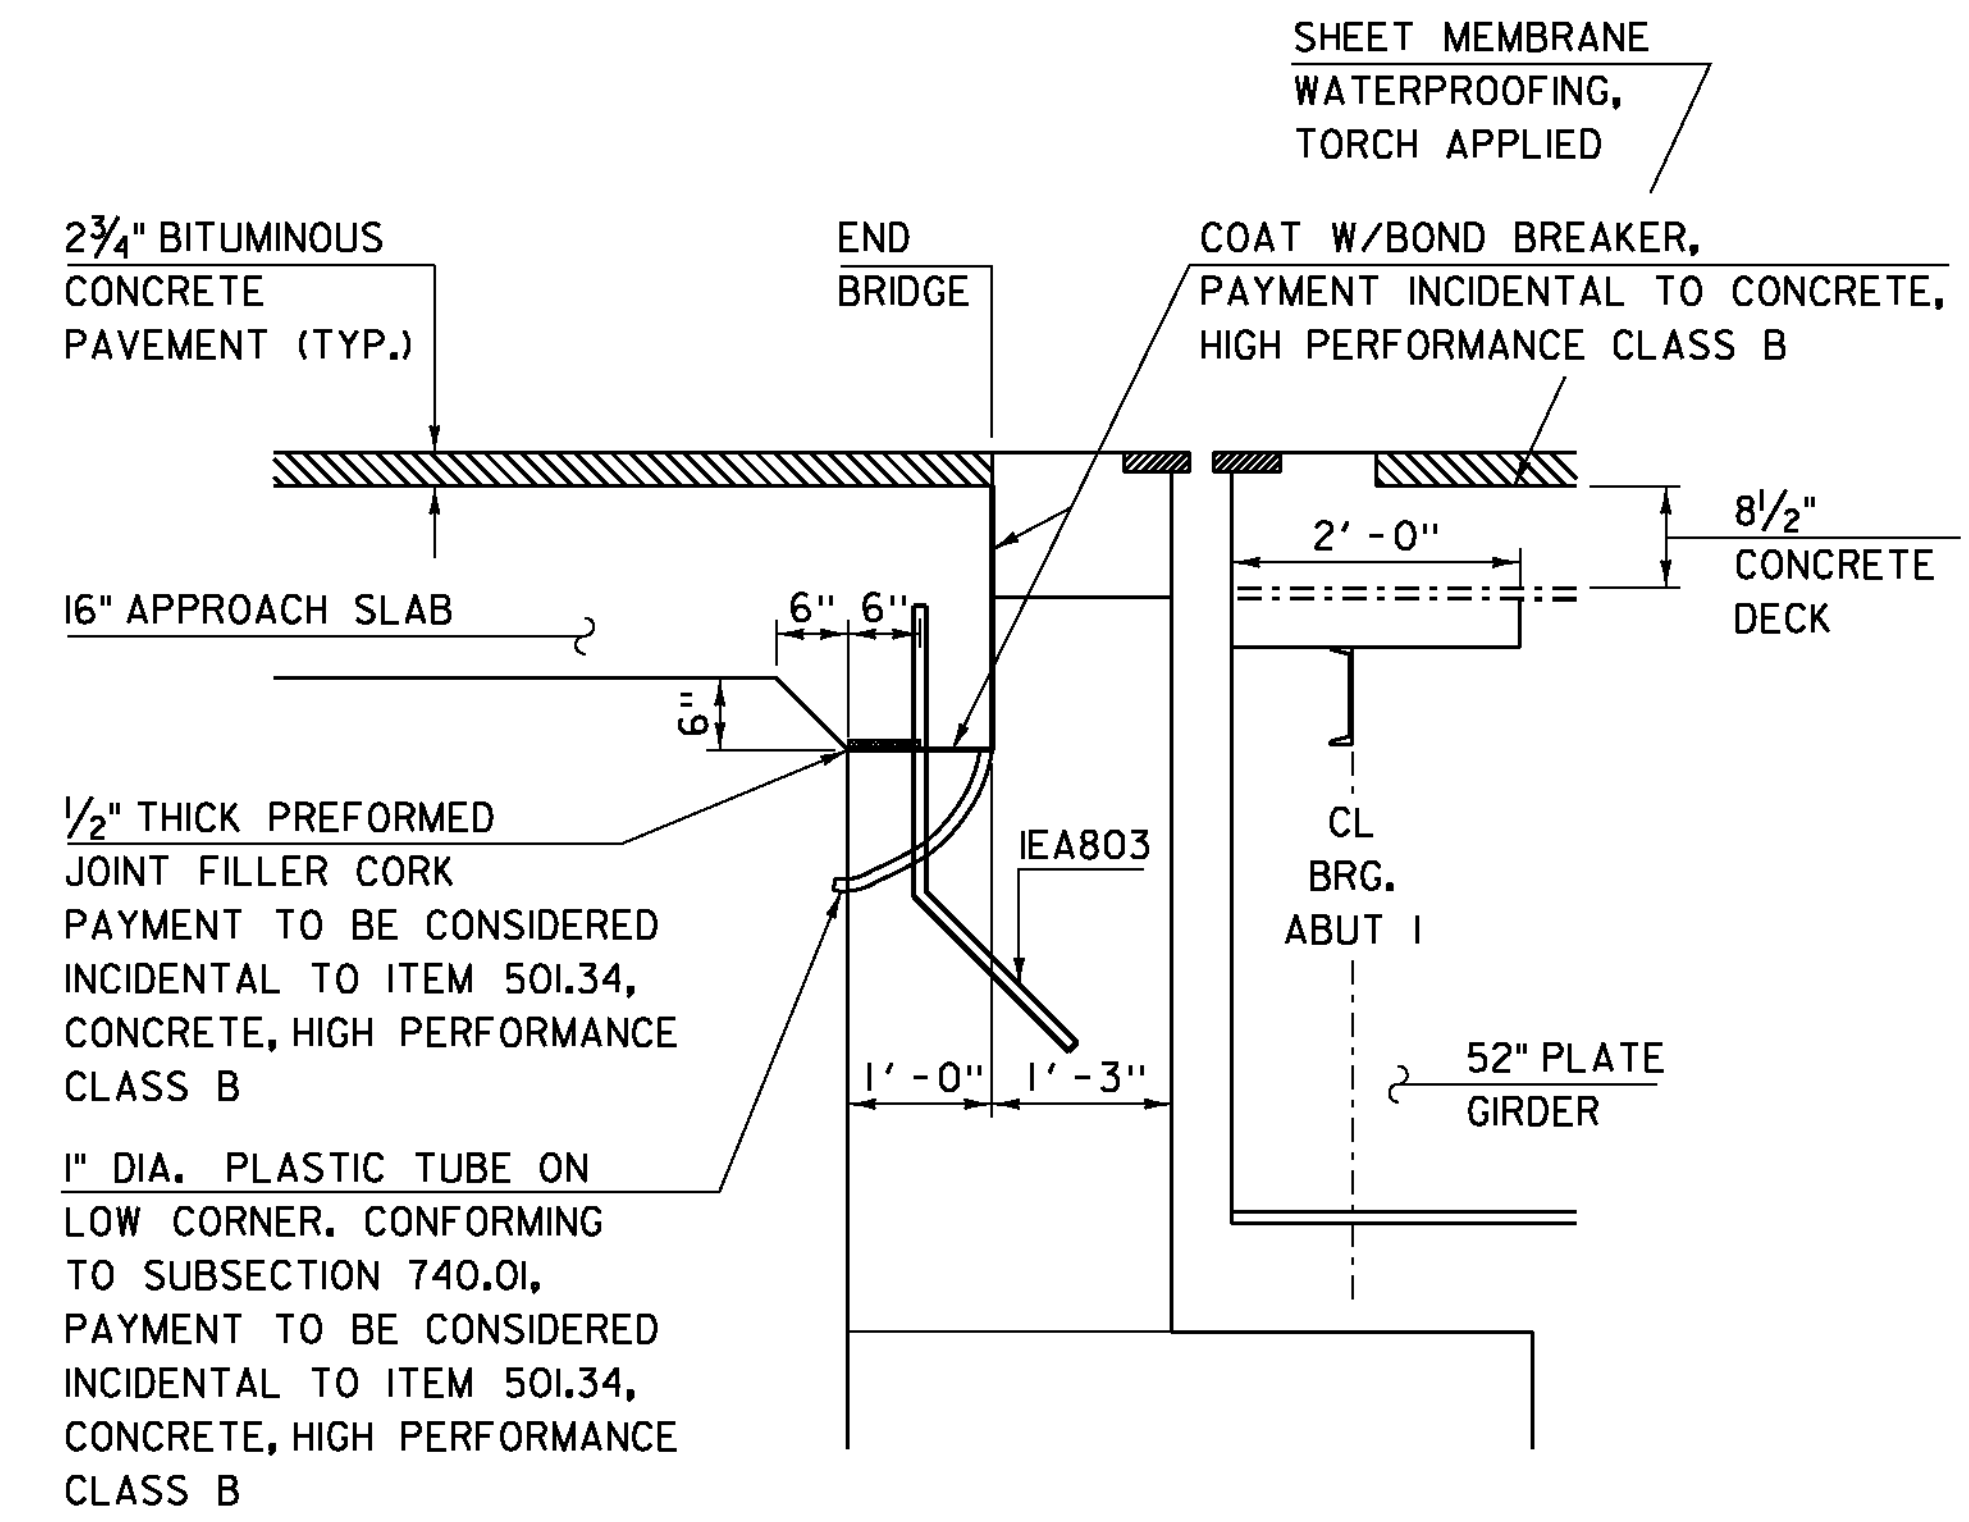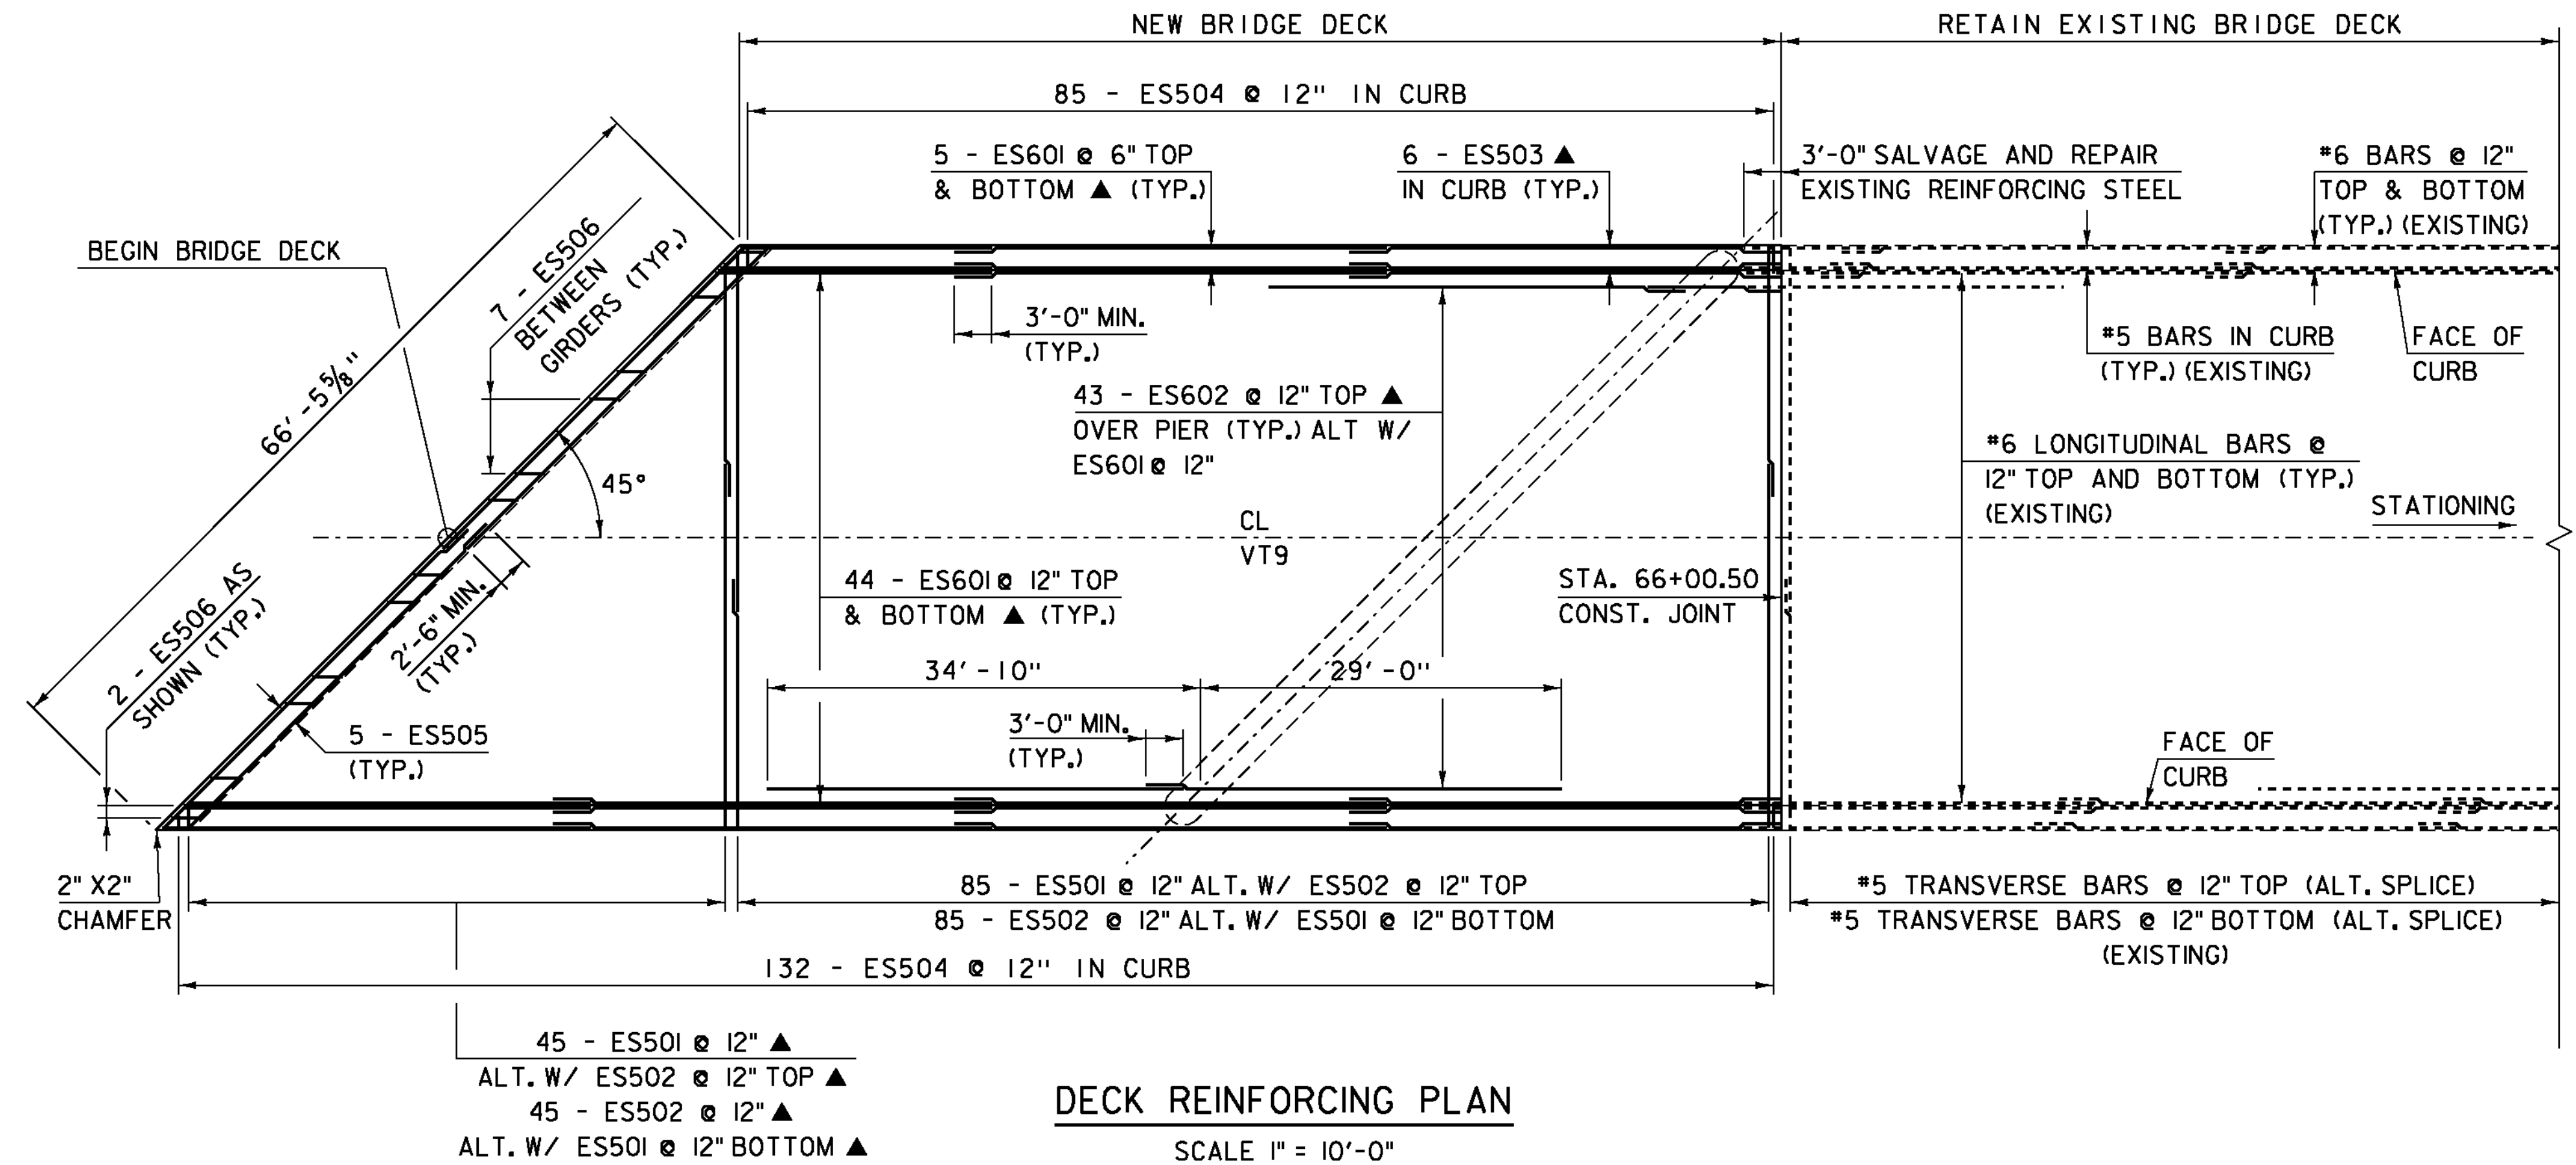


PROJECT NAME:	WOODFORD
PROJECT NUMBER:	ER BHF 010-1(44)
FILE NAME:	slb214sup.dgn
PROJECT LEADER:	C. CARLSON
DESIGNED BY:	M. EVANS-MONGEON
DECK PLAN	
PLOT DATE:	23-MAR-2012
DRAWN BY:	C. MOONEY
CHECKED BY:	M. EVANS-MONGEON
SHEET	20 OF 58

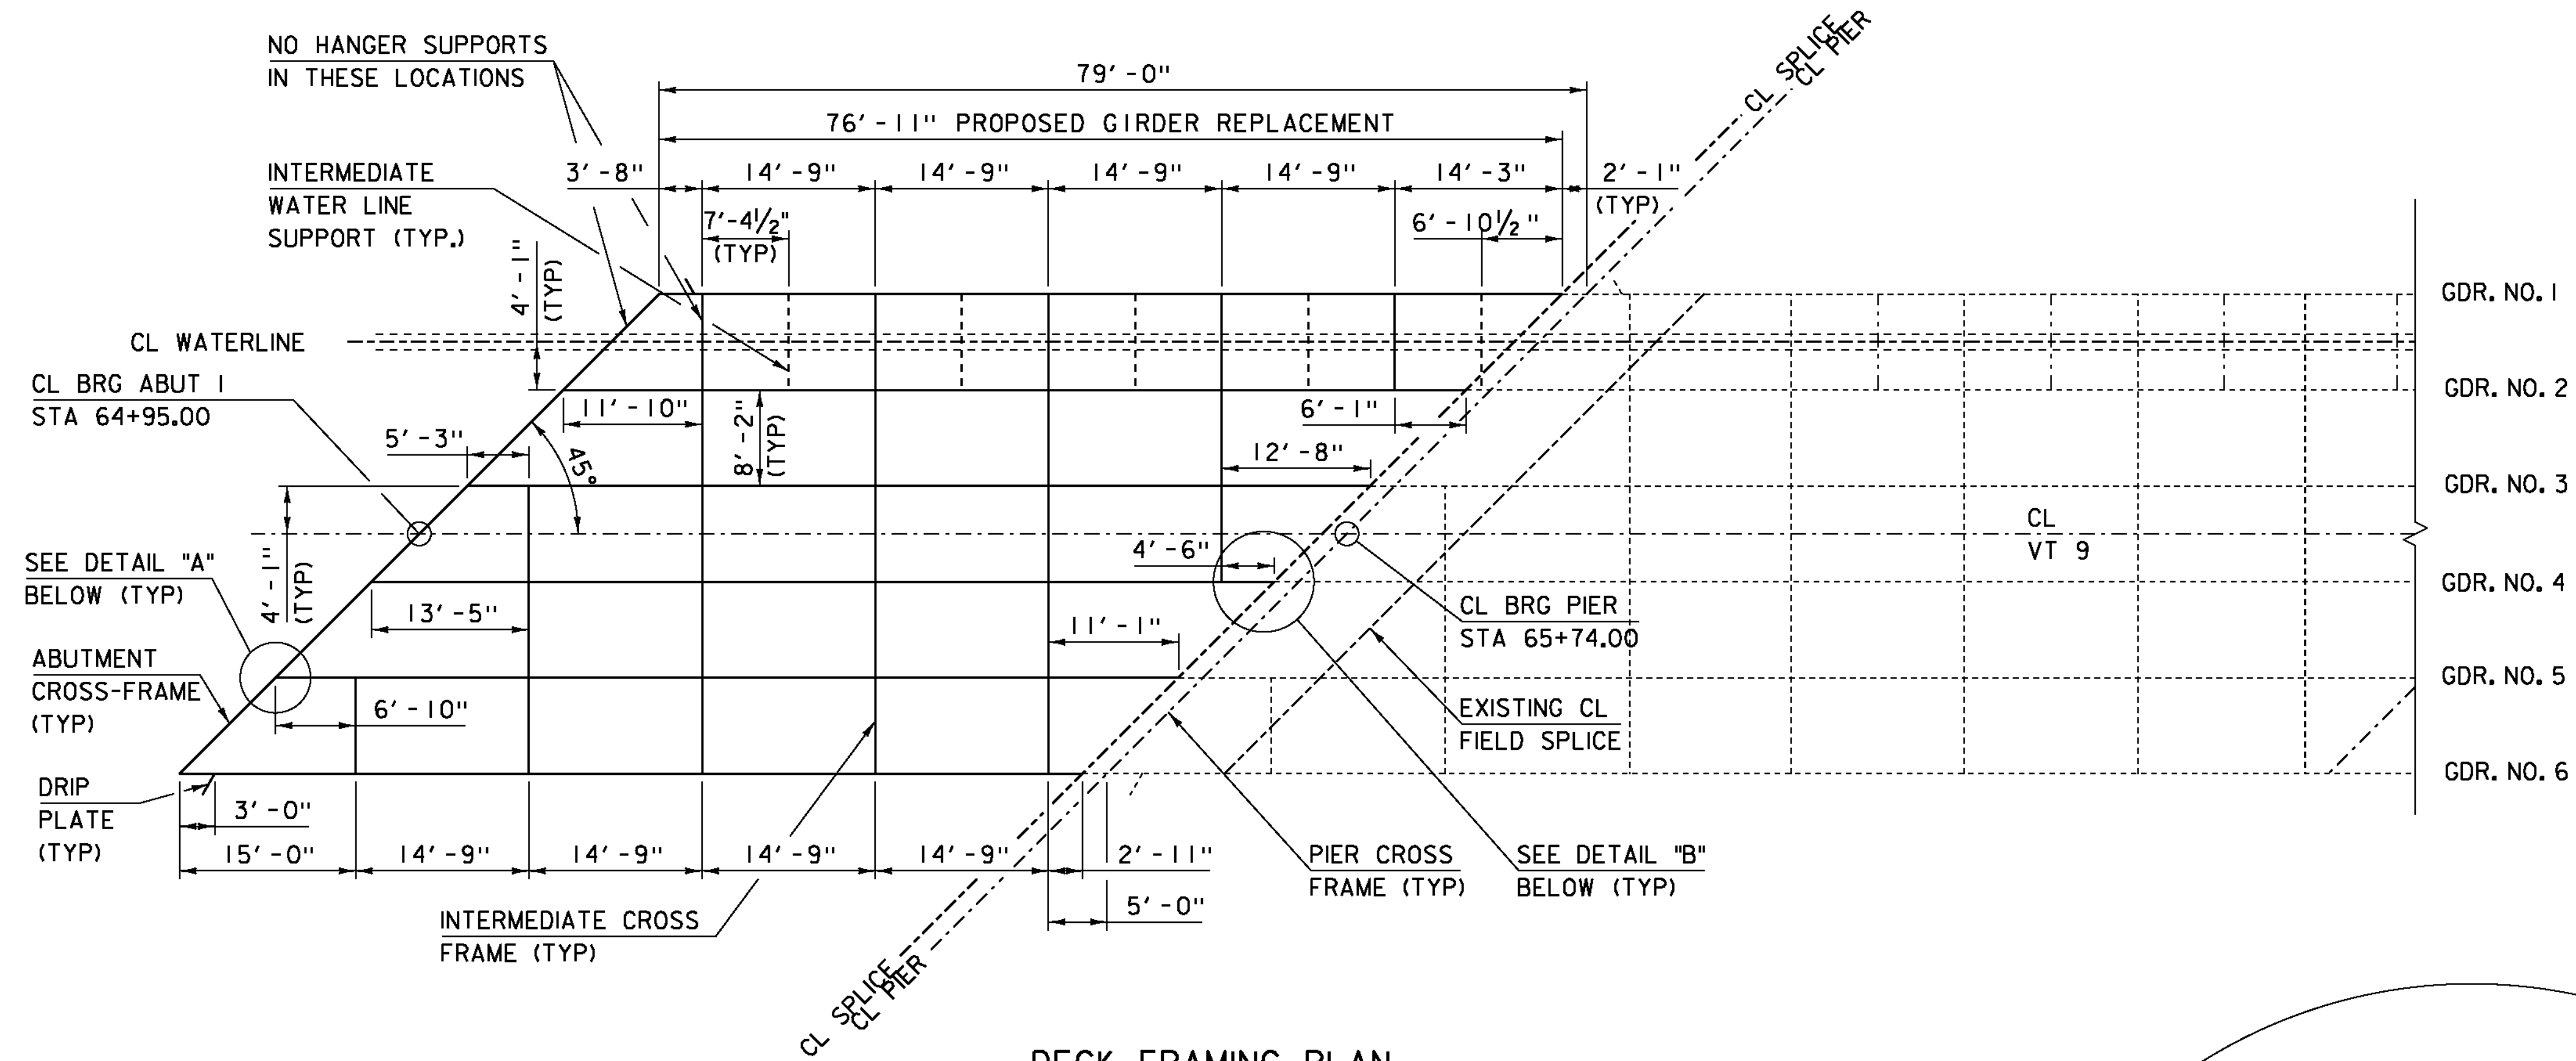


**DECK FRAMING PLAN**

SCALE 1" = 10'-0"

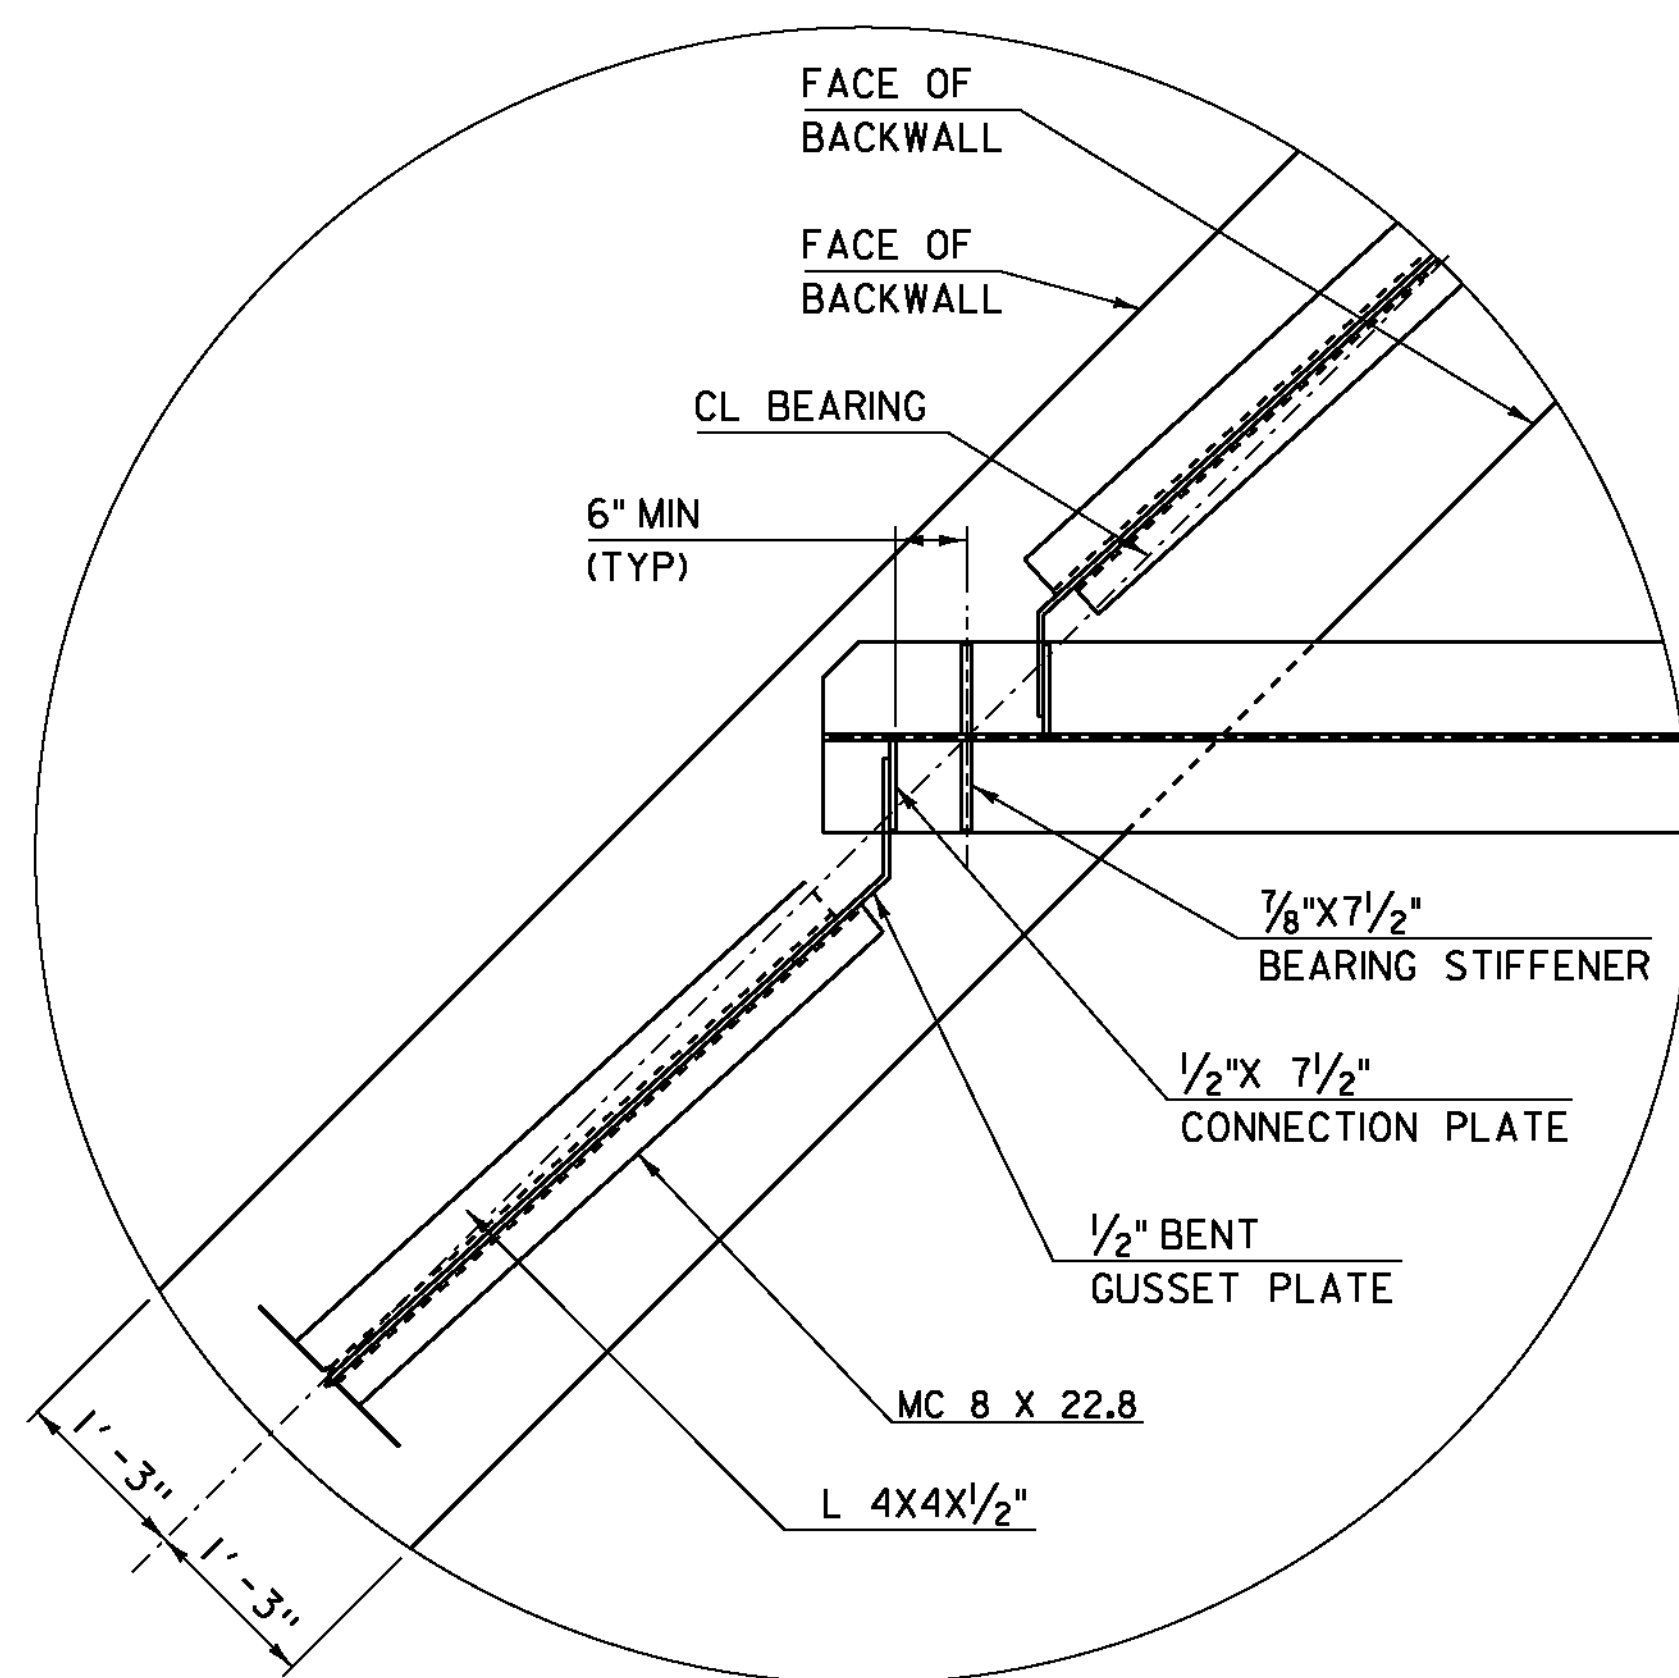


**DETAIL "A"**

SCALE 3/4" = 1'-0"

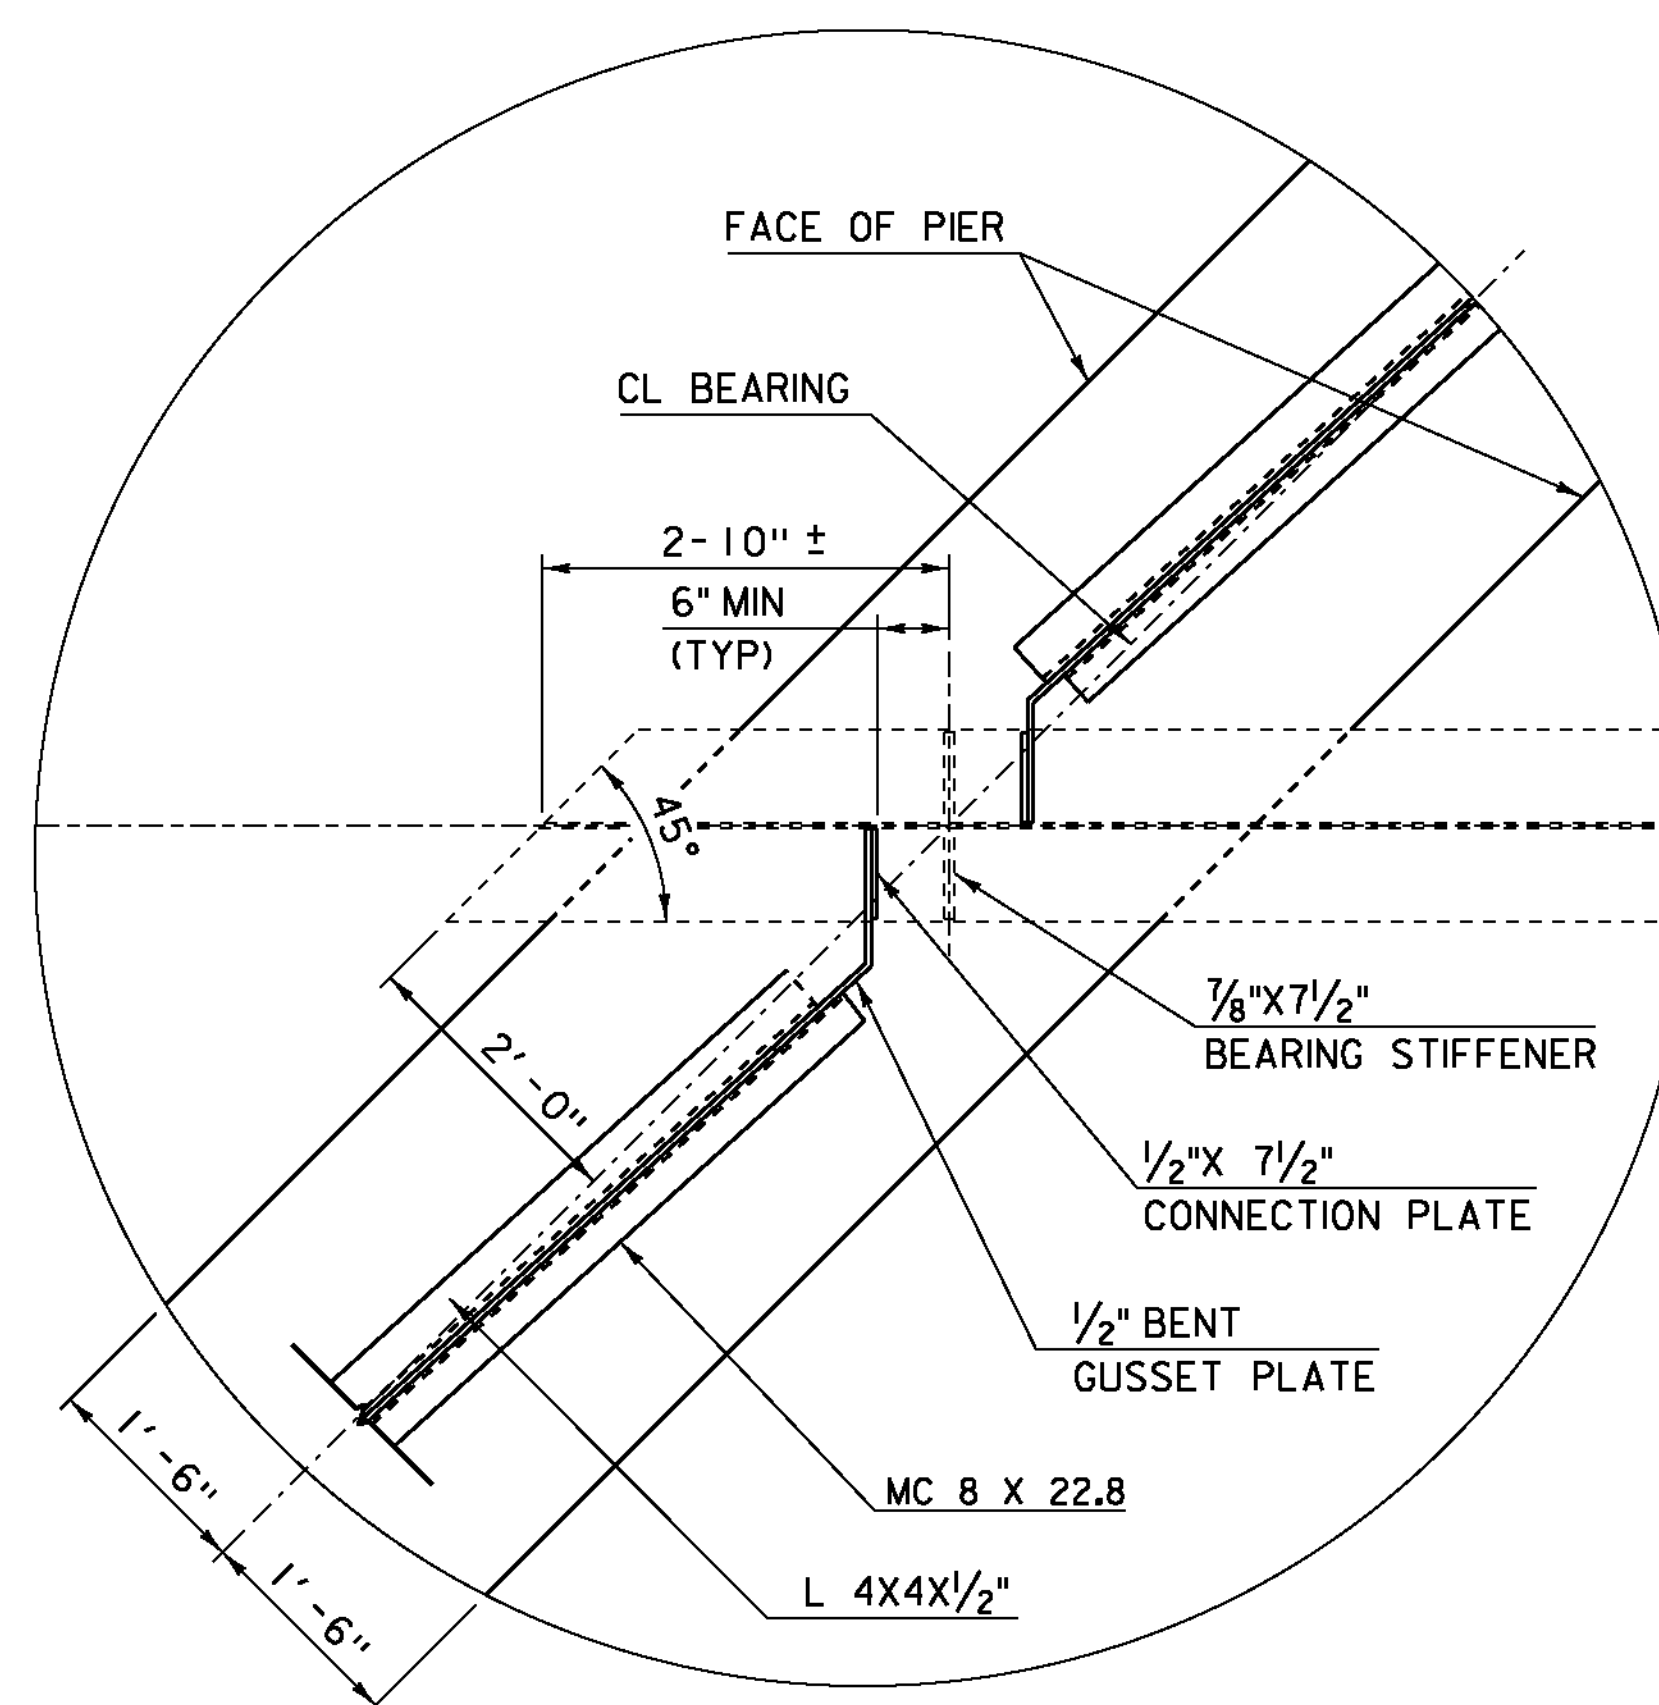

**DETAIL "B" EXISTING CONDITION**

SCALE 3/4" = 1'-0"

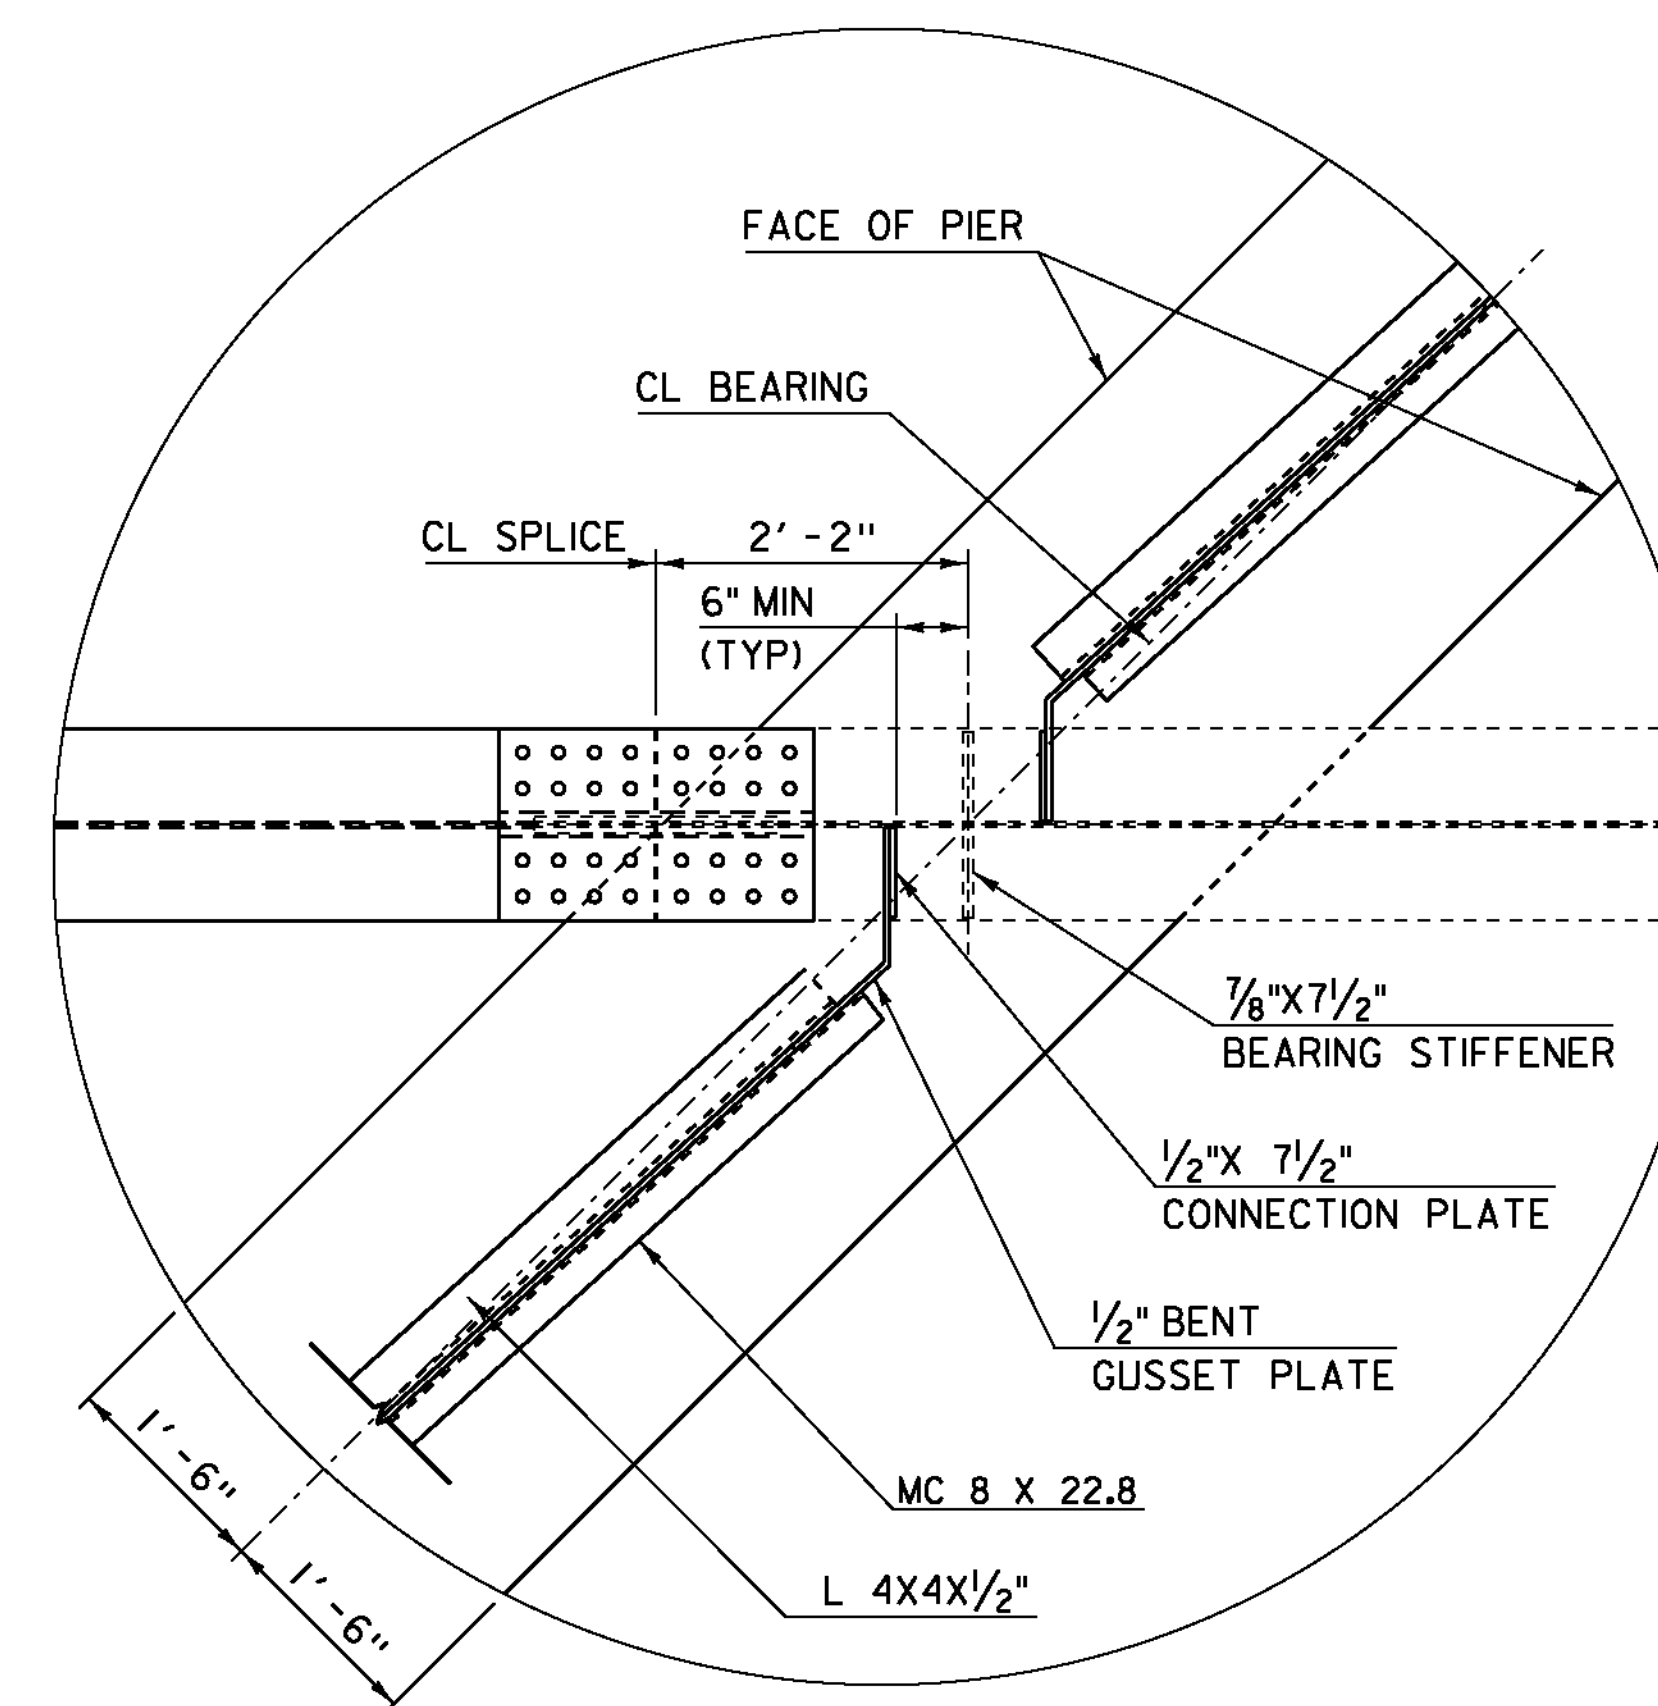


**DETAIL "B" FINAL CONDITION**

SCALE 3/4" = 1'-0"

PROJECT NAME: WOODFORD  
PROJECT NUMBER: ER BHF 010-1(44)

FILE NAME: s11b214sup.dgn  
PROJECT LEADER: C. CARLSON  
DESIGNED BY: M. EVANS-MONGEON  
DECK FRAMING PLAN


PLOT DATE: 23-MAR-2012  
DRAWN BY: C. MOONEY  
CHECKED BY: M. EVANS-MONGEON  
SHEET 21 OF 58

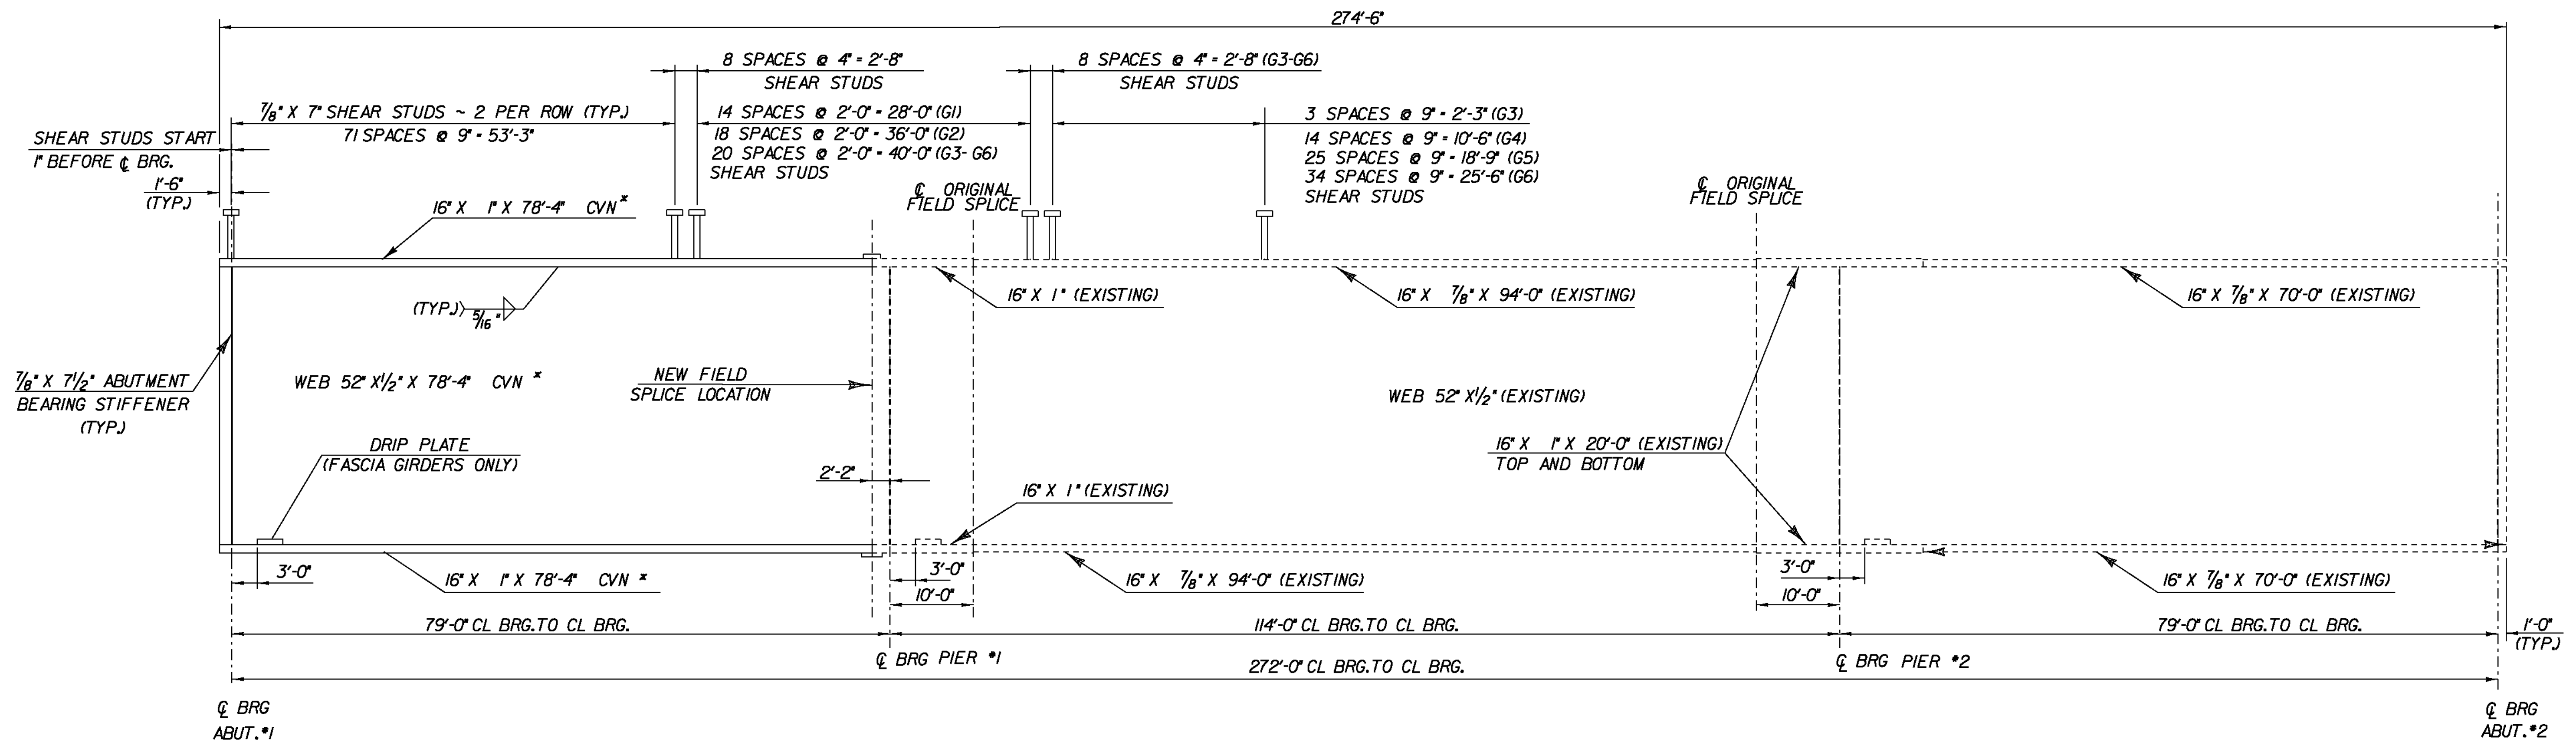

\* DENOTES THAT CHARPY V-NOTCH (CVN) TEST IS REQUIRED

**GIRDER ELEVATION**


HORIZ. SCALE: SCALE 1" = 10'-0"  
 VERT. SCALE: SCALE 1" = 1'-0"

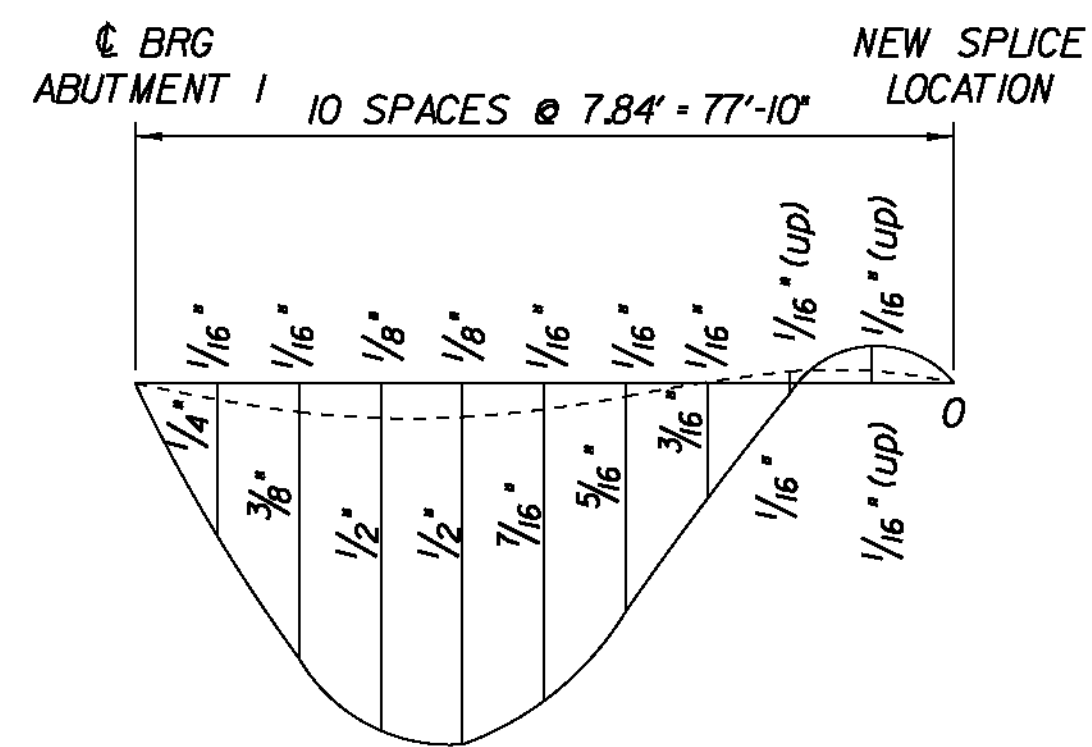

**DEAD LOAD DEFLECTION**

NTS


Numbers Above Line - Dead Load Deflection (Steel Only)  
 Numbers Below Line - Total Dead Load Deflection

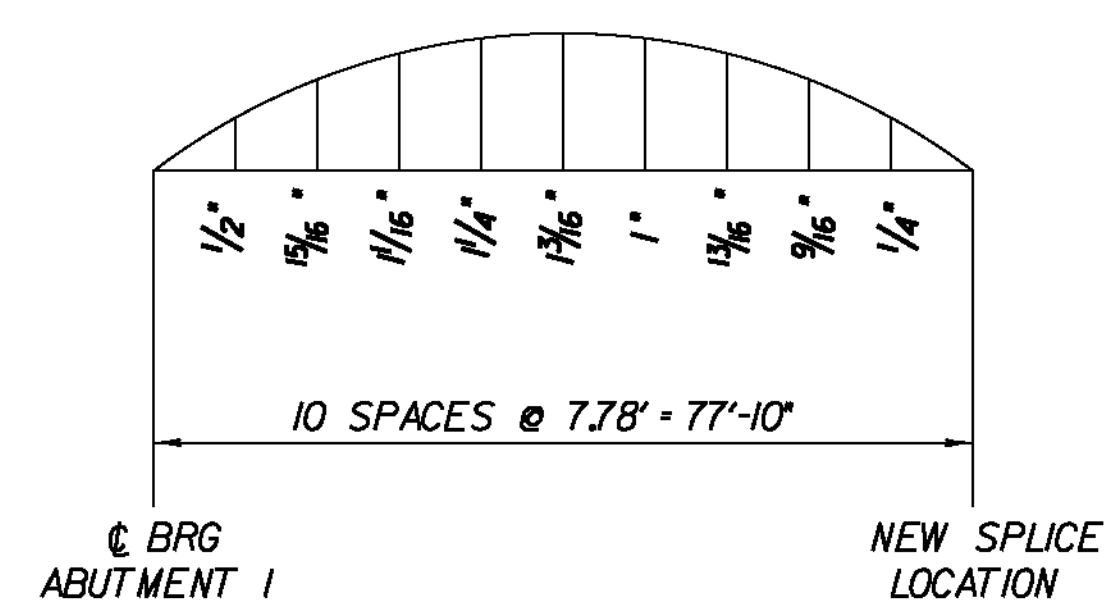


**CAMBER**

NTS


PROJECT NAME: WOODFORD	PLOT DATE: 23-MAR-2012
PROJECT NUMBER: ER BHF OIO -1(44)	DRAWN BY: M.EVANS-MONGE
FILE NAME: s11B214girder.dgn	CHECKED BY: H.SALLS
PROJECT LEADER: C. CARLSON	SHEET 22 OF 58
DESIGNED BY: M.EVANS-MONGEON	
GIRDER DETAILS	

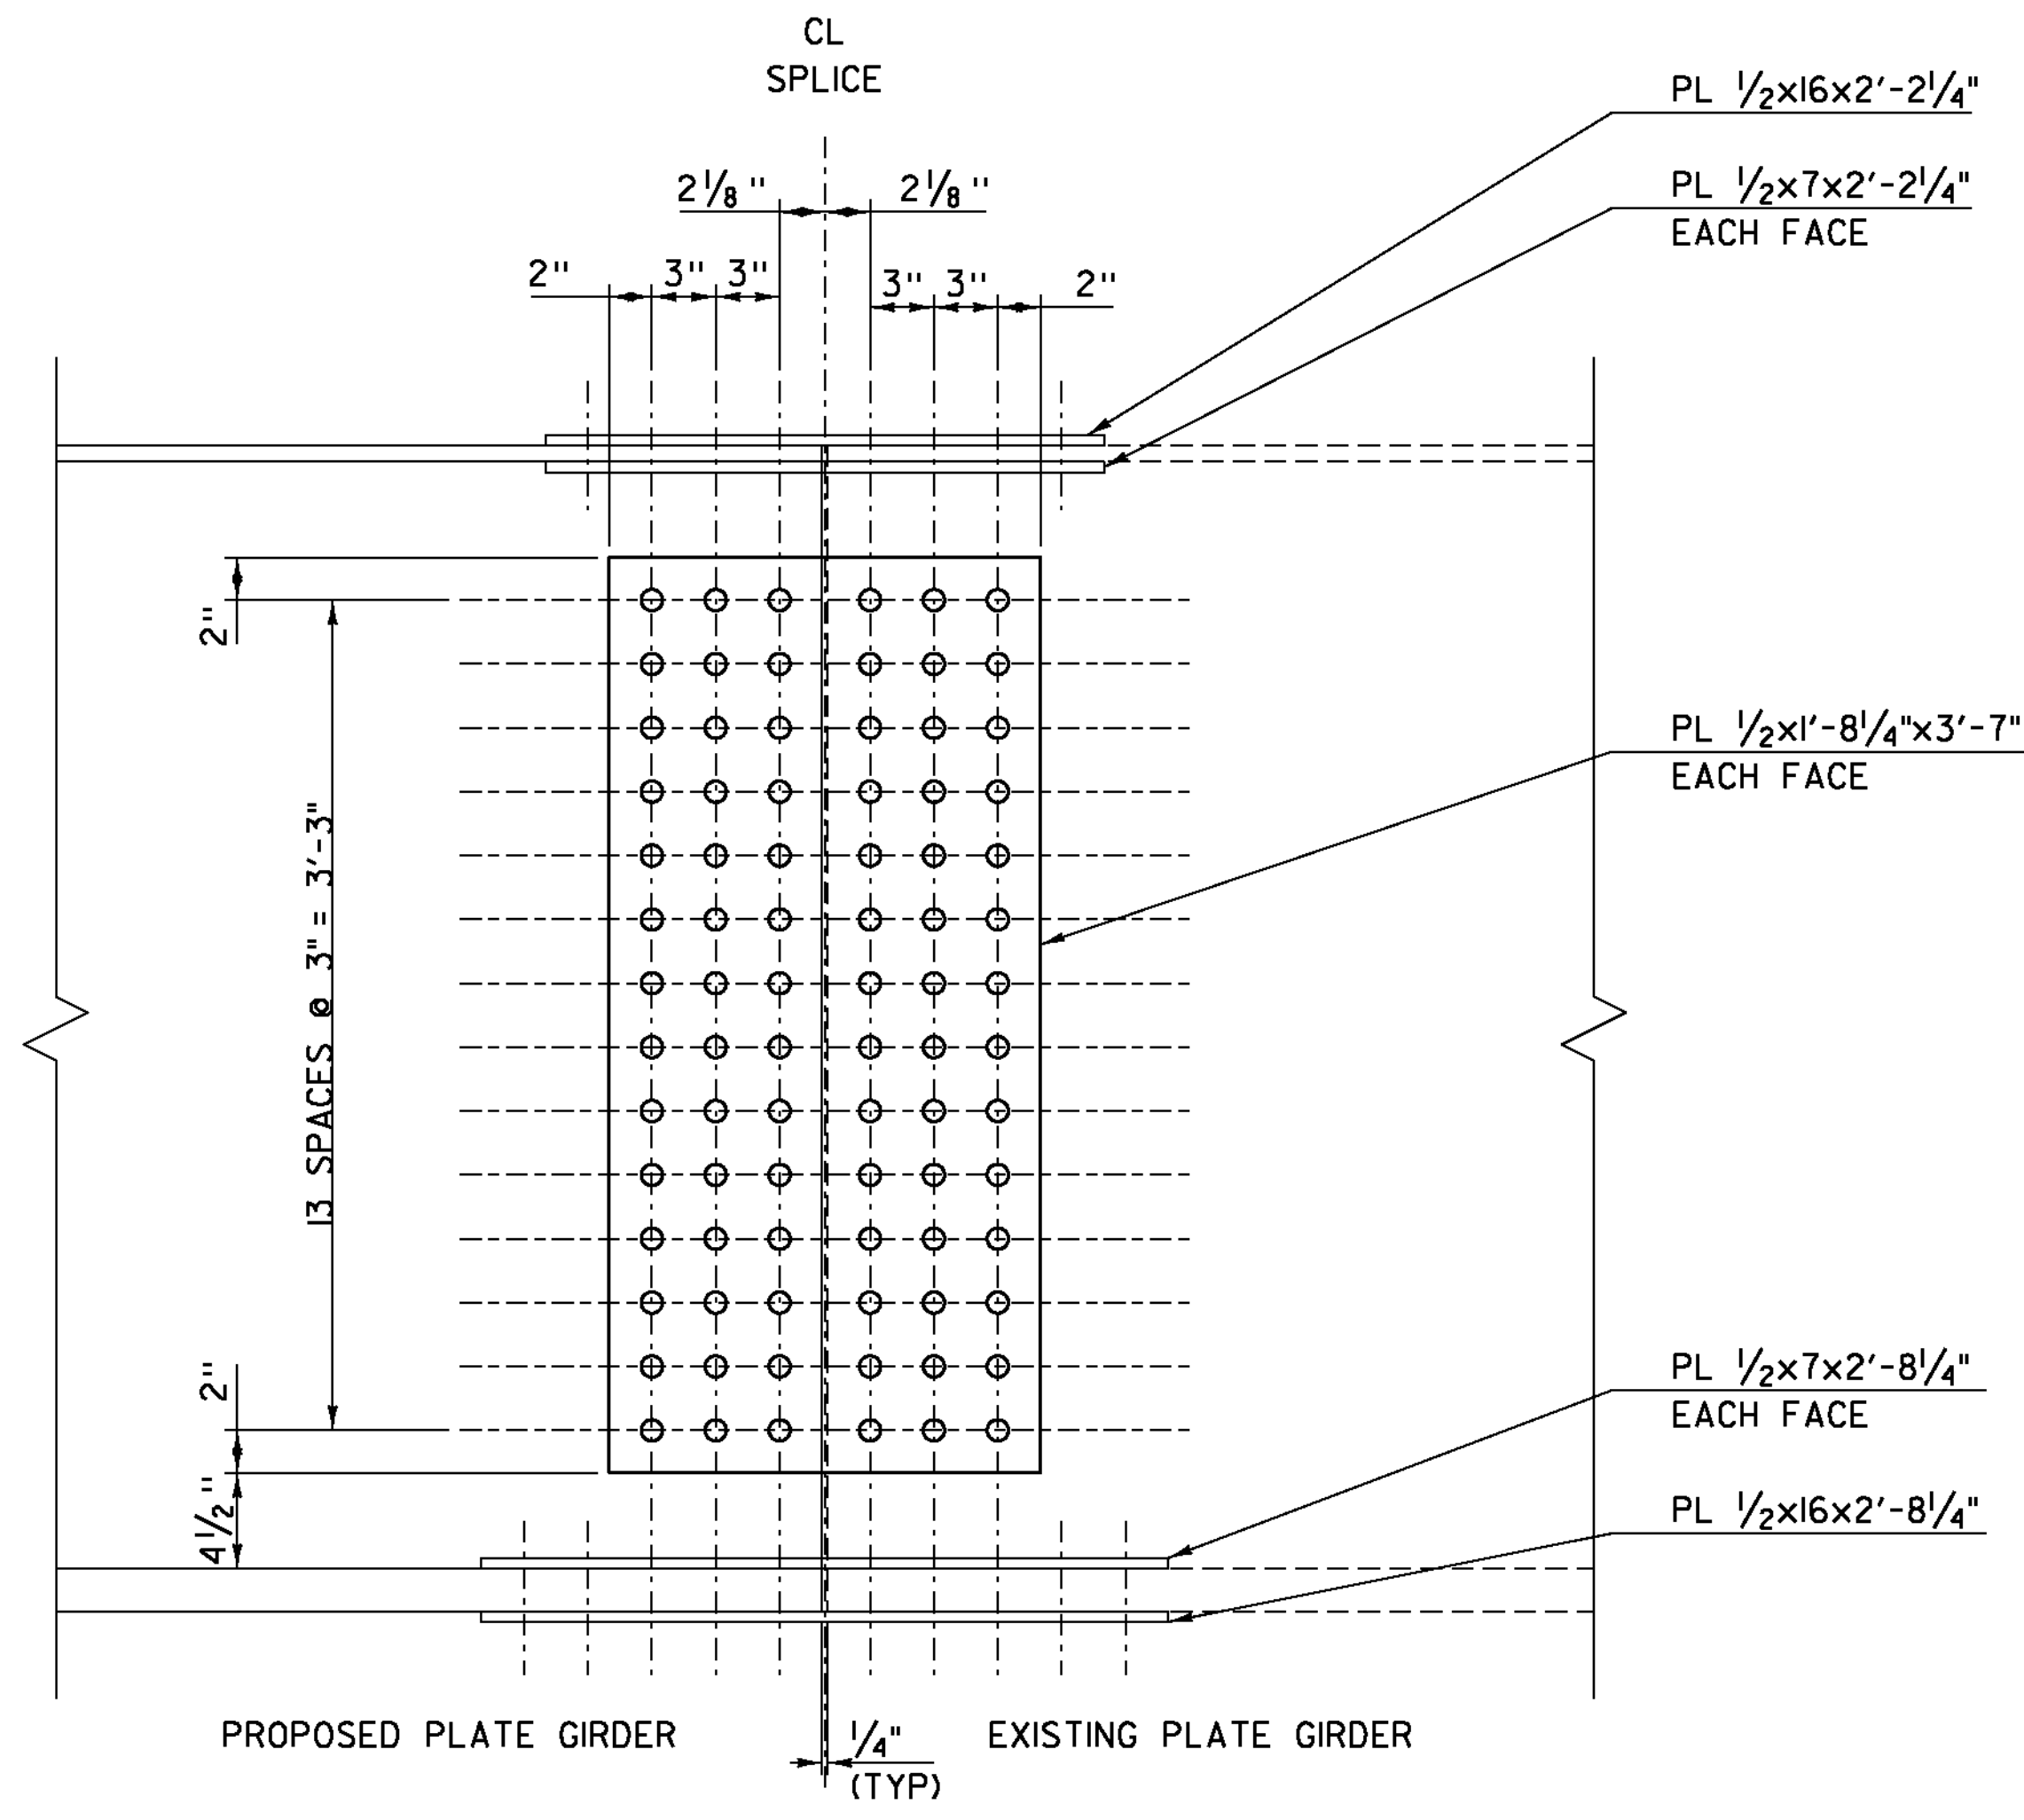

**ELEVATION VIEW SPLICE PLATE**  
SCALE 1/2" = 1'-0"

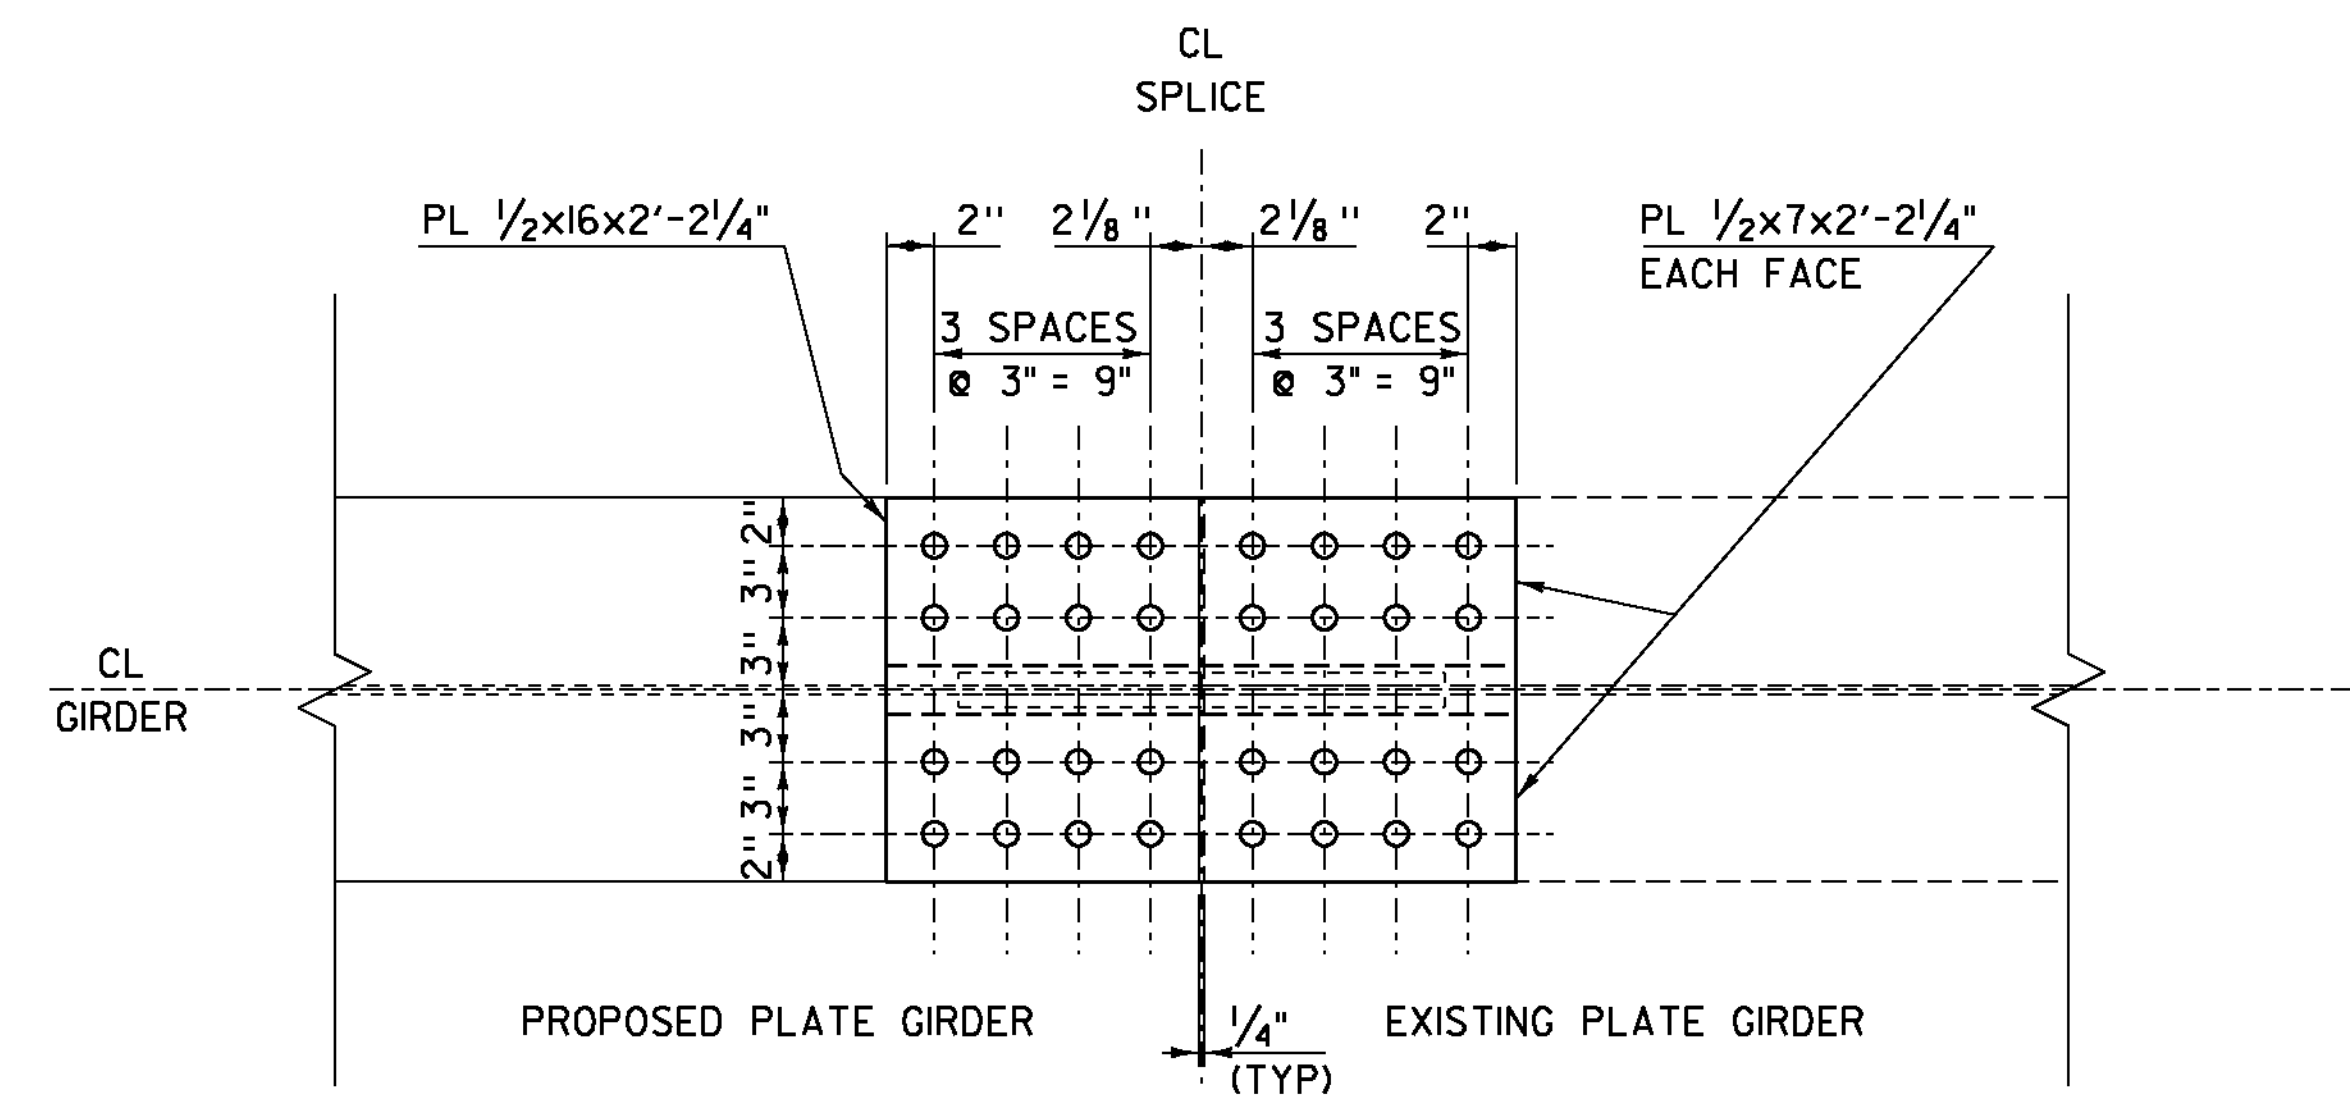


**PLAN VIEW TOP SPLICE PLATE**  
SCALE 1/2" = 1'-0"


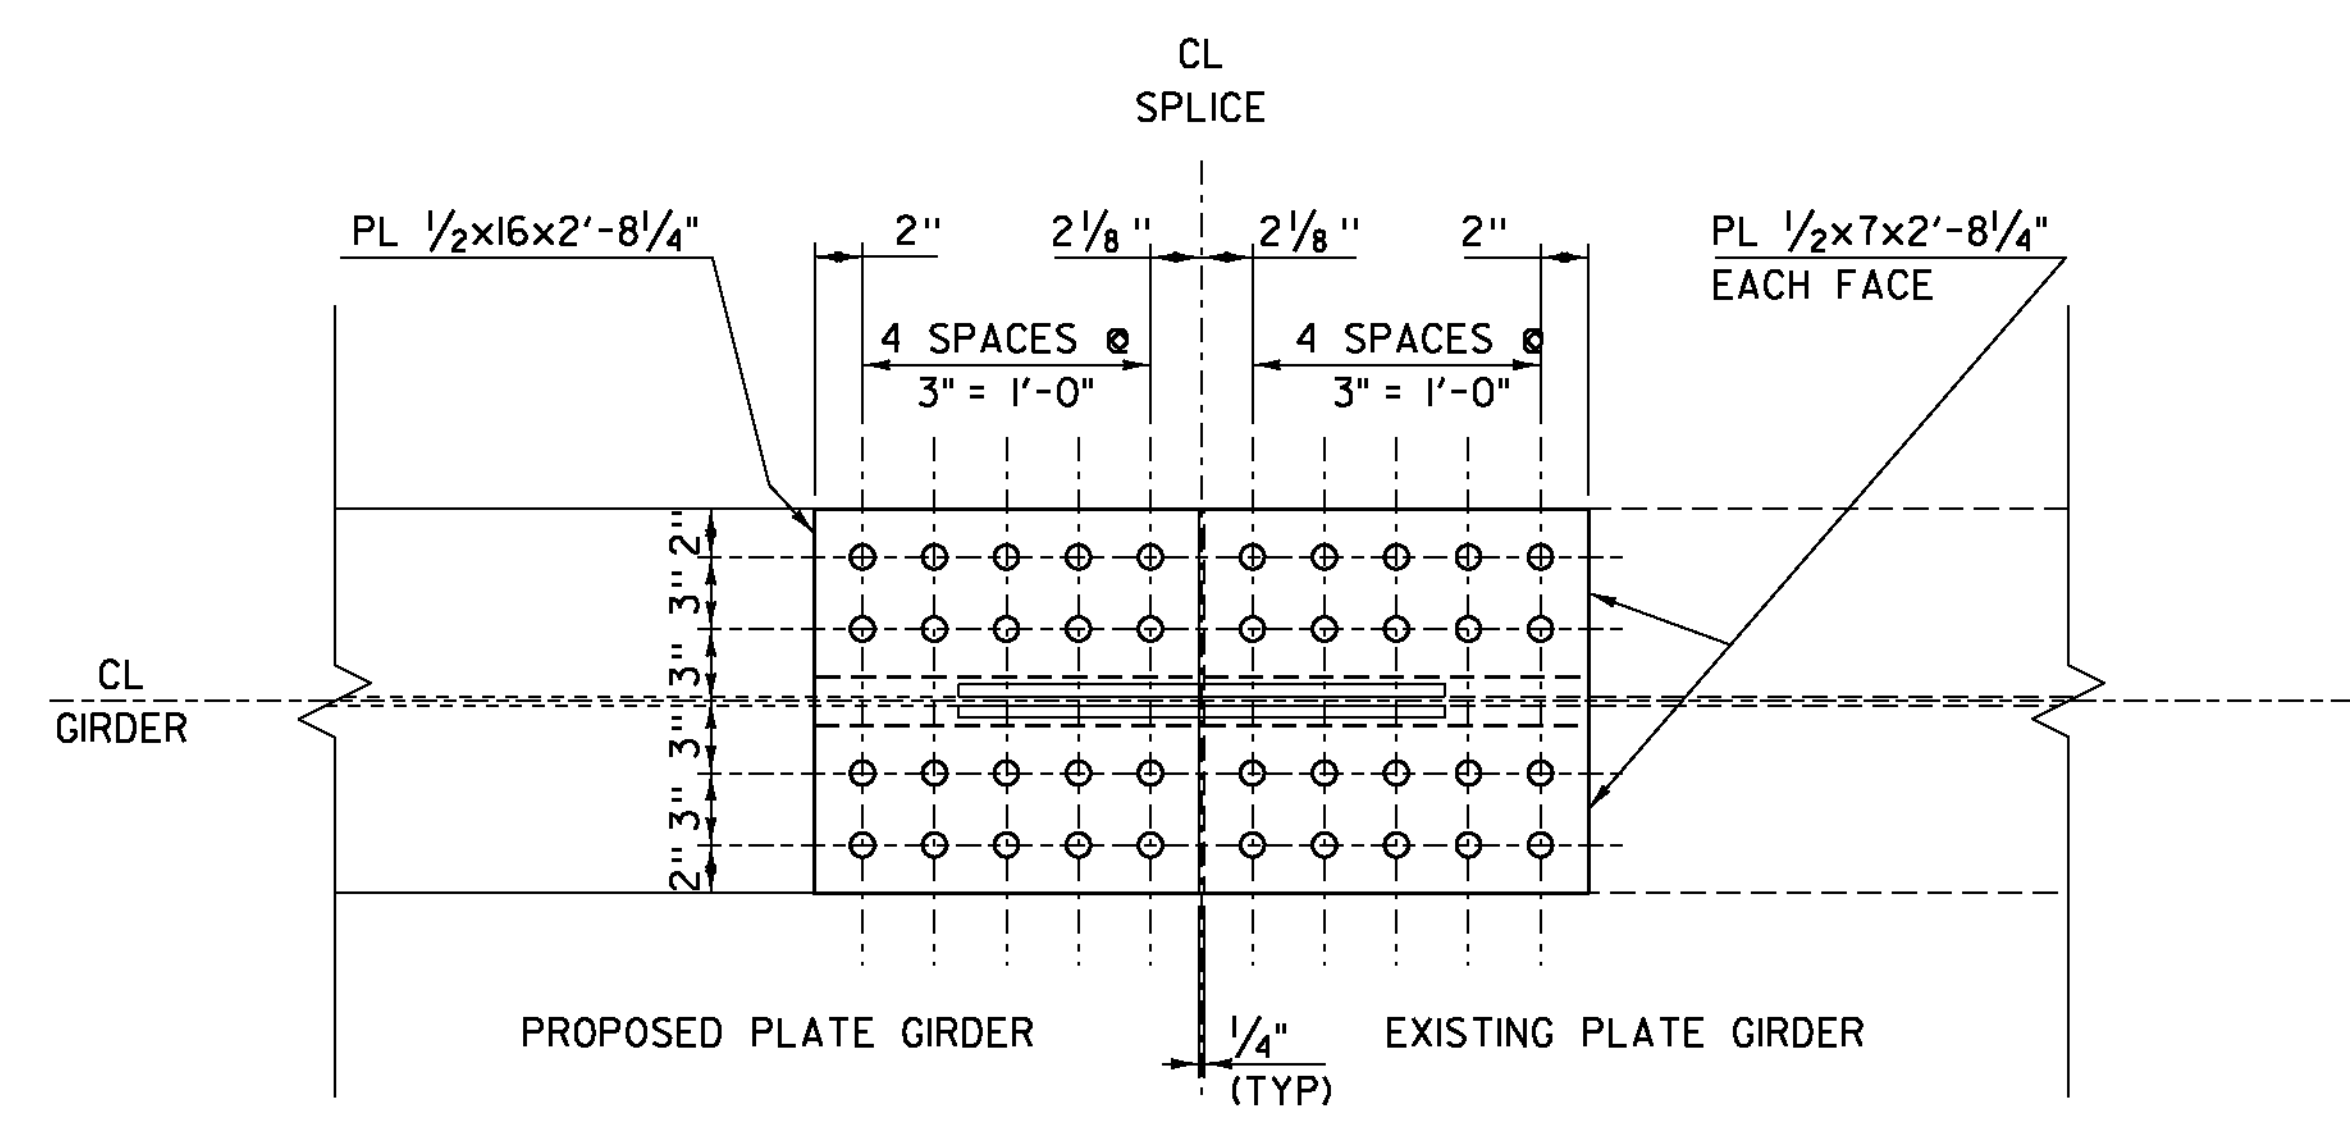


**PLAN VIEW BOTTOM SPLICE PLATE**  
SCALE 1/2" = 1'-0"


PROJECT NAME:	WOODFORD
PROJECT NUMBER:	ER BHF 010-1(44)
FILE NAME:	slb214sup.dgn
PROJECT LEADER:	C. CARLSON
DESIGNED BY:	M. EVANS-MONGEON
GIRDER SPLICE DETAILS	
PLOT DATE:	23-MAR-2012
DRAWN BY:	C. MOONEY
CHECKED BY:	M. EVANS-MONGEON
SHEET	23 OF 58

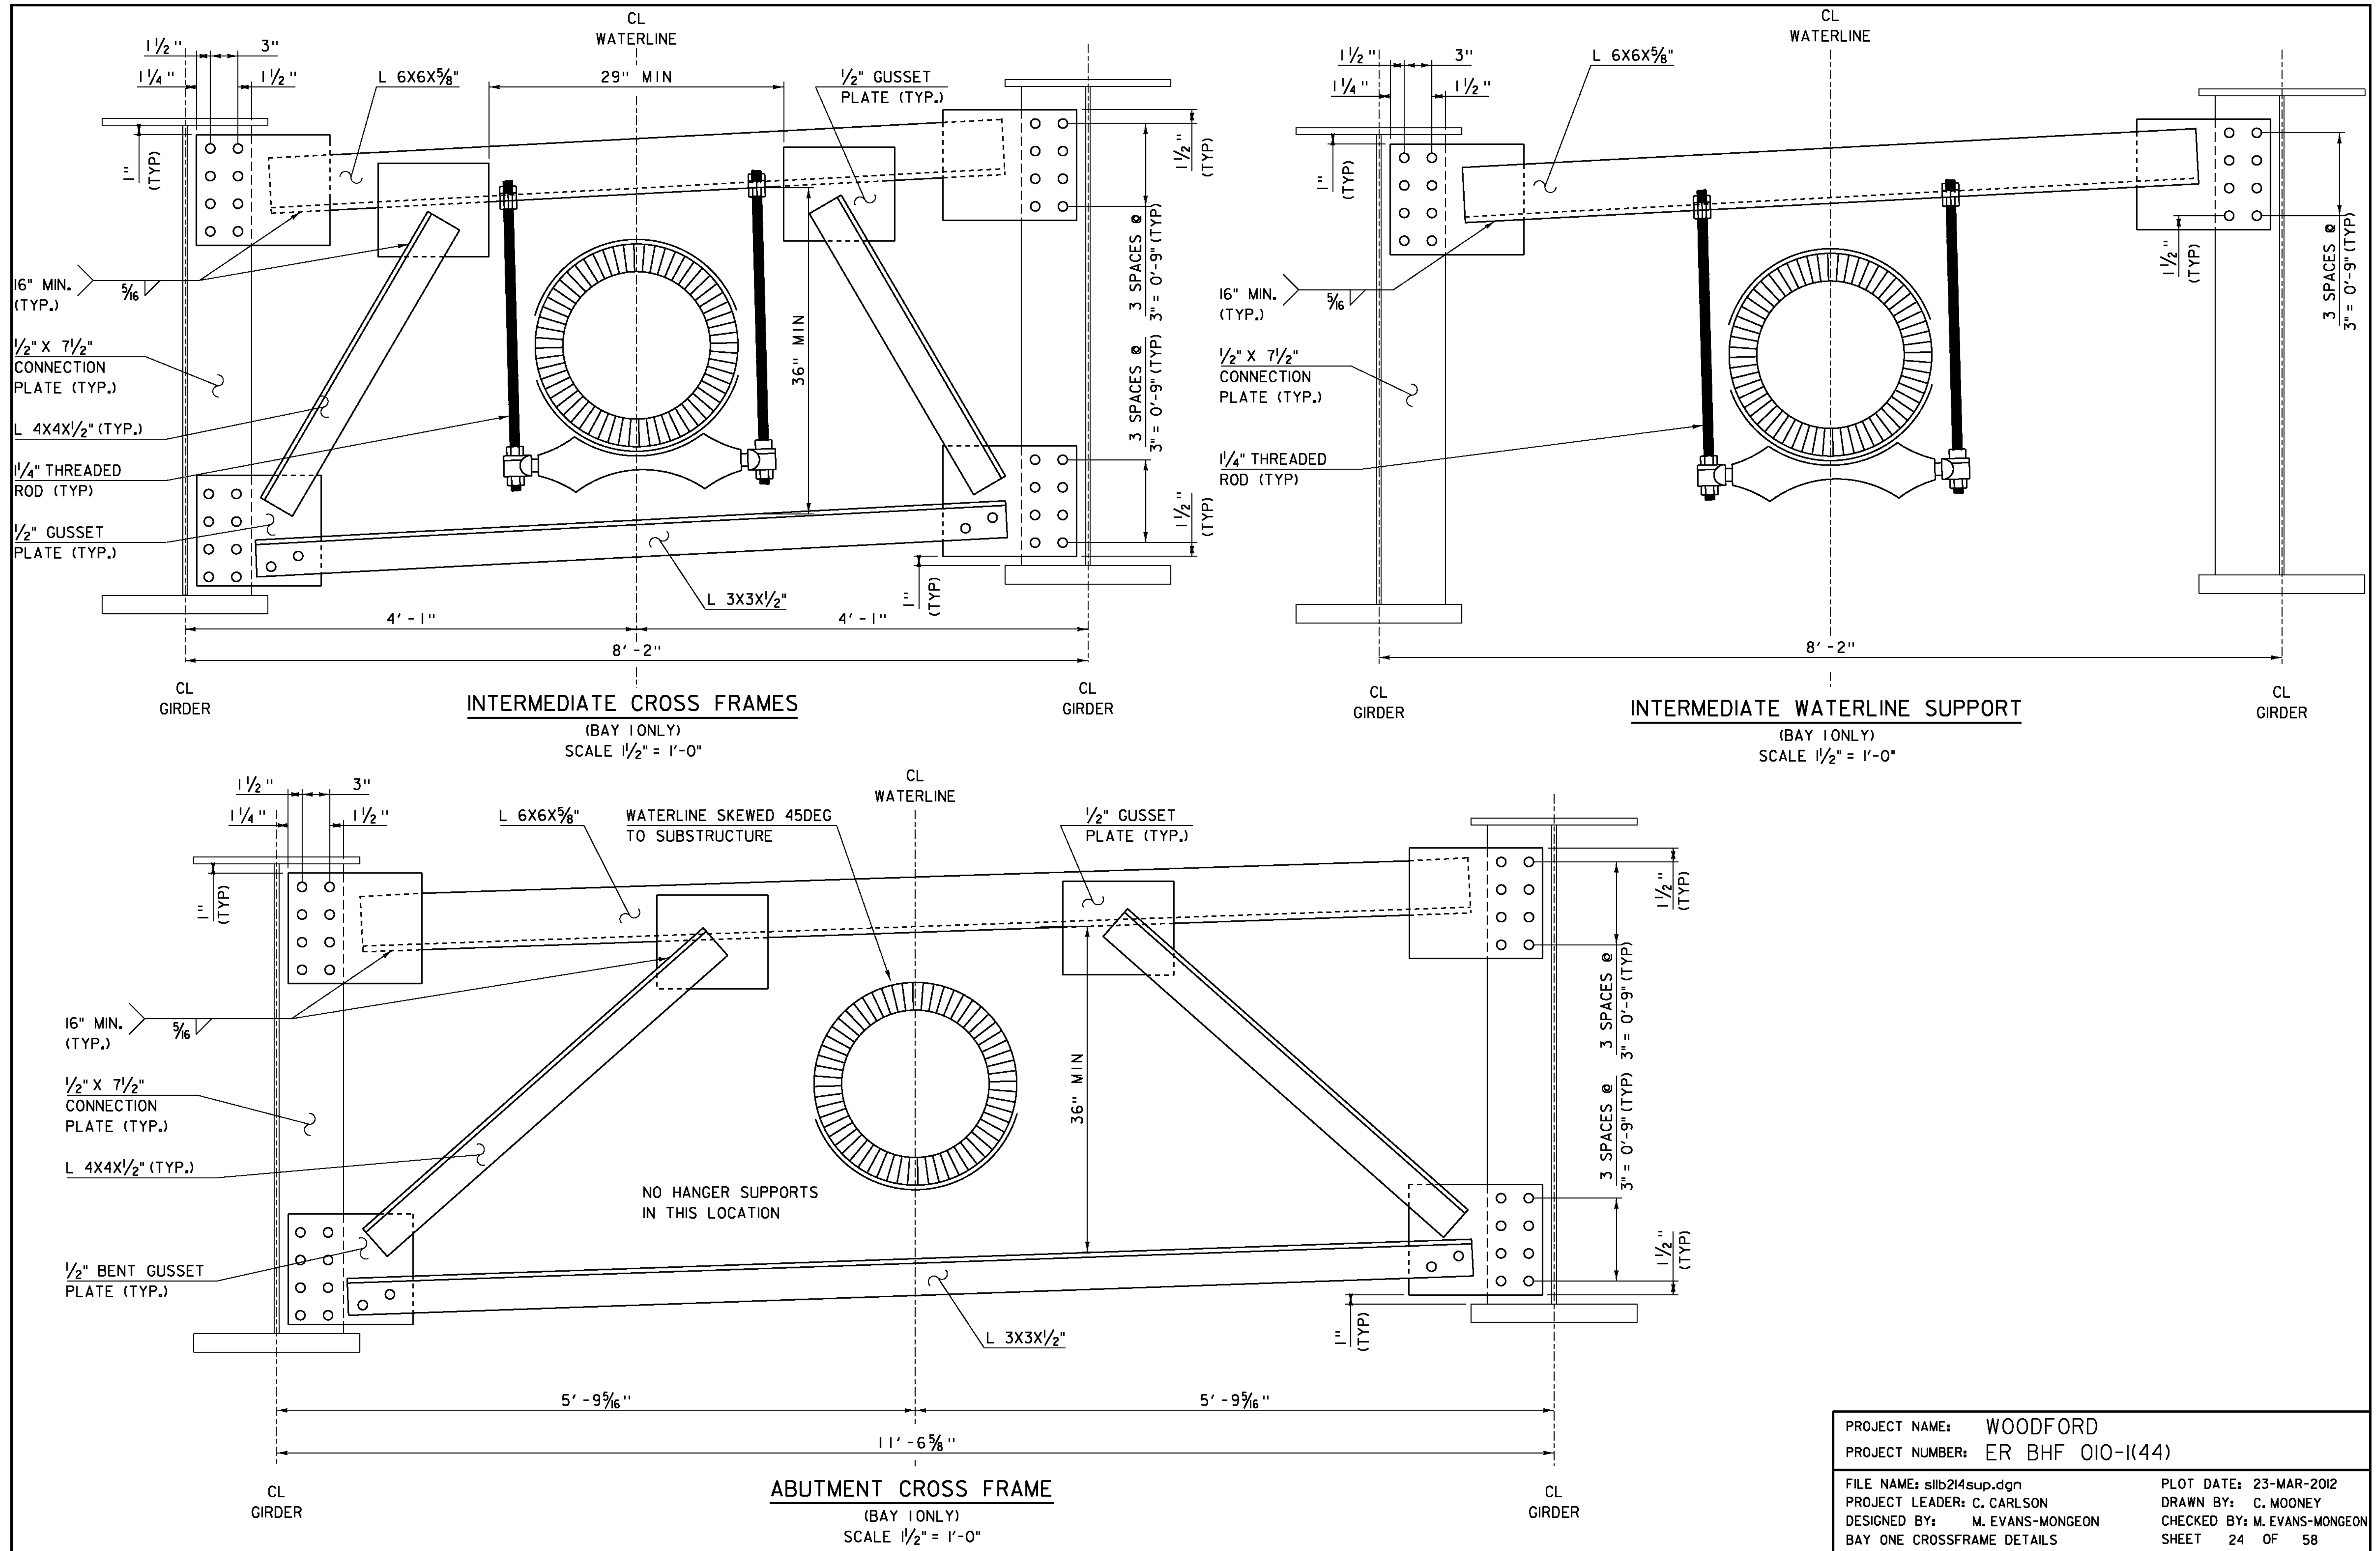

PROJECT NAME:	WOODFORD	PLOT DATE:	23-MAR-2012
PROJECT NUMBER:	ER BHF 010-1(44)	DRAWN BY:	C. MOONEY
FILE NAME:	slb214sup.dgn	DESIGNED BY:	M. EVANS-MONGEON
PROJECT LEADER:	C. CARLSON	CHECKED BY:	M. EVANS-MONGEON
BAY ONE CROSSFRAME DETAILS		SHEET 24 OF 58	

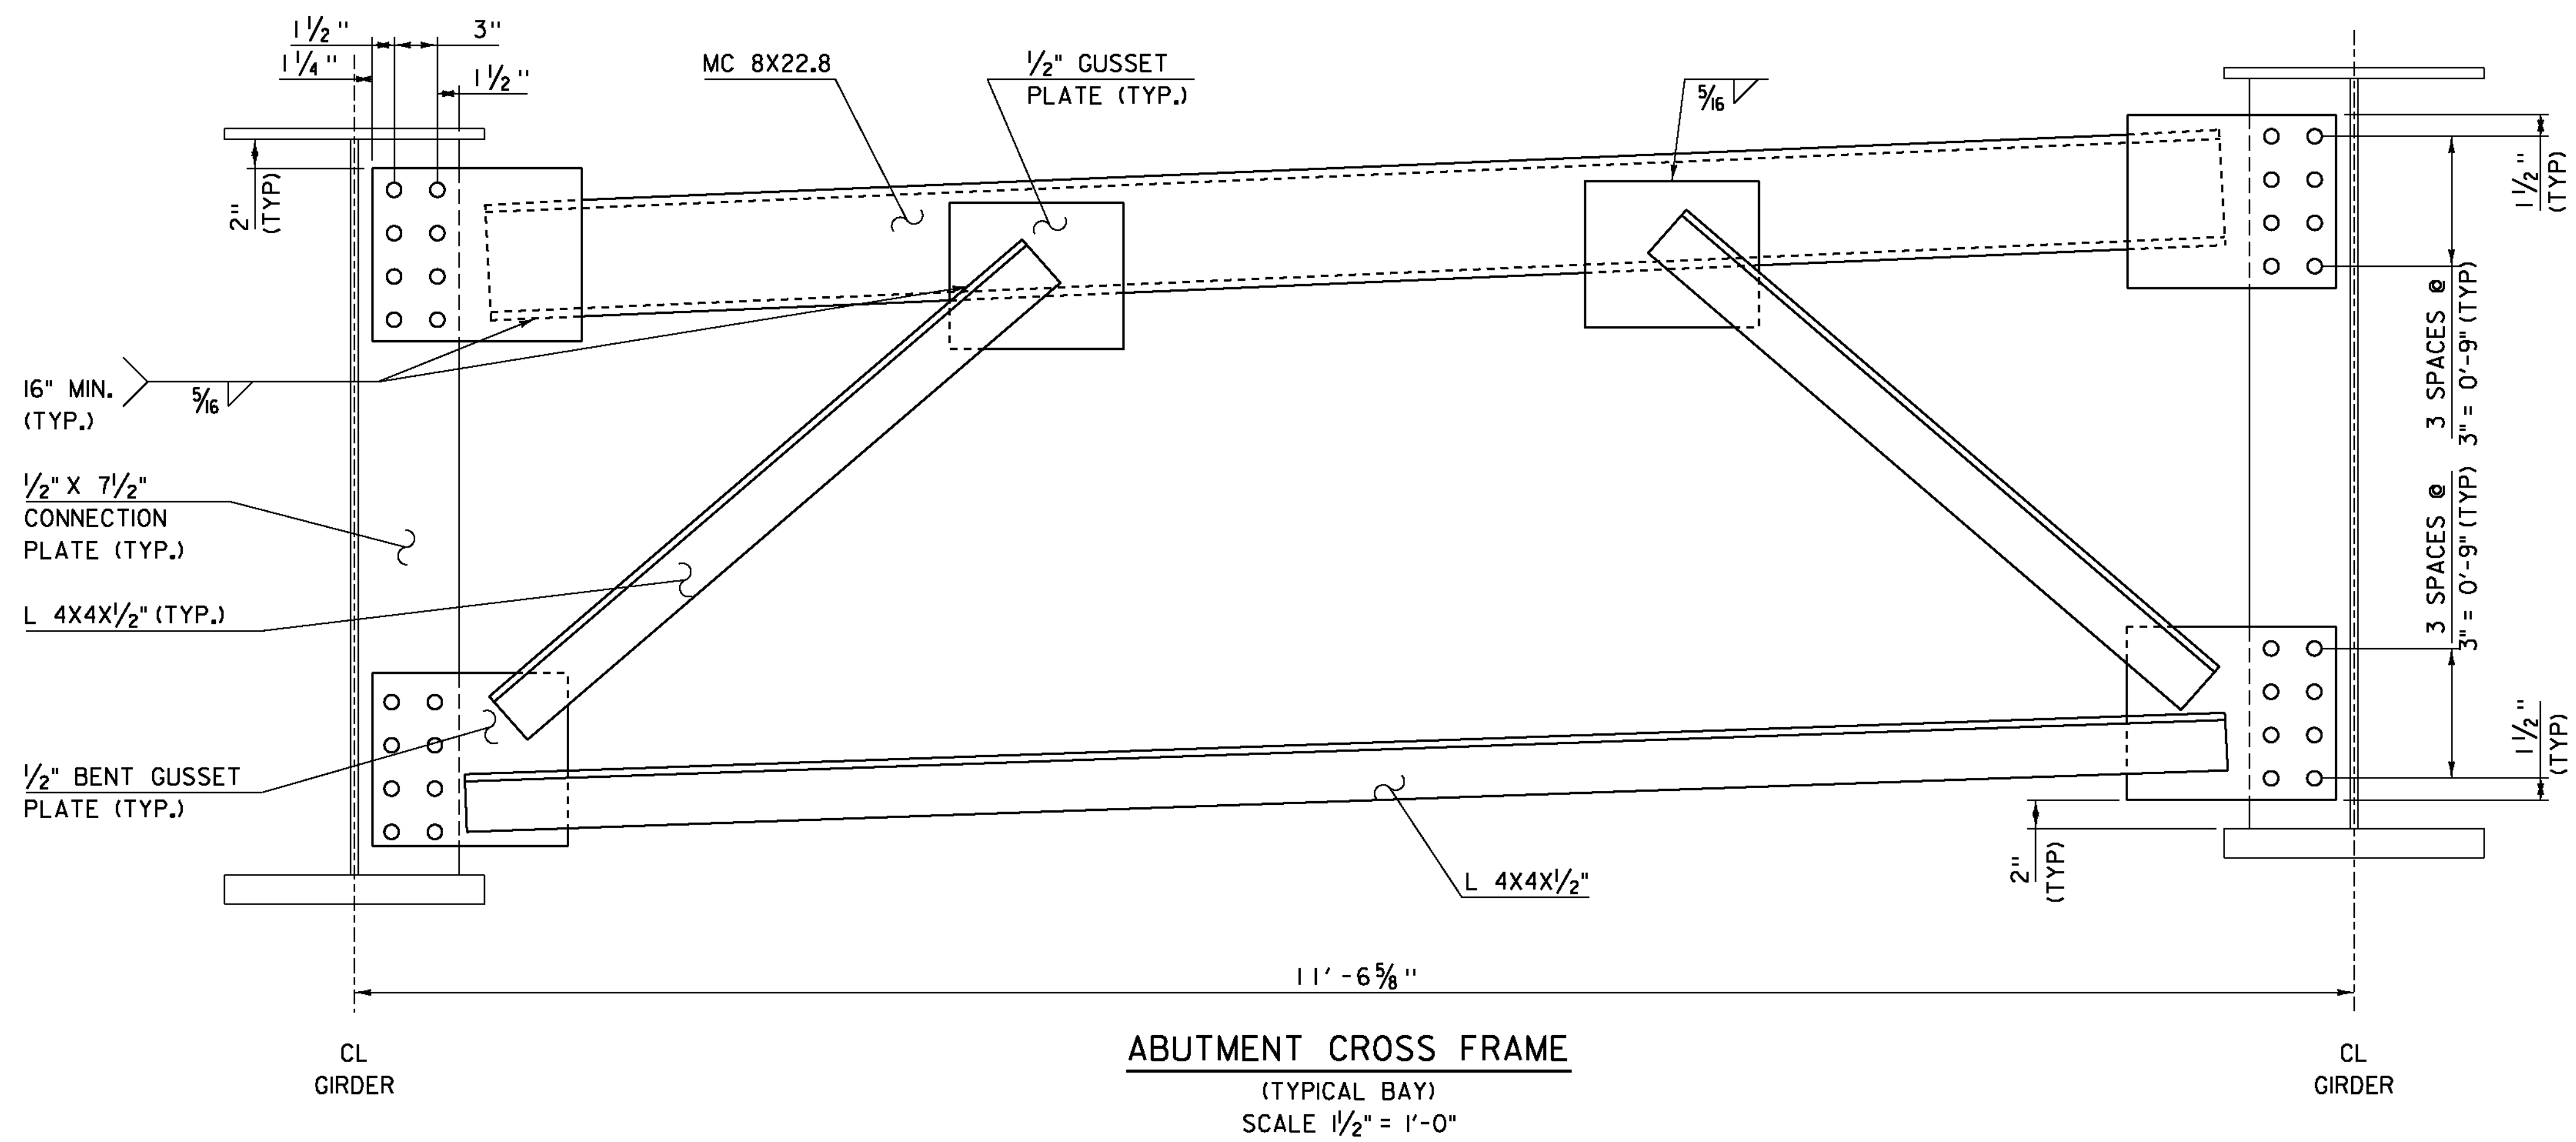
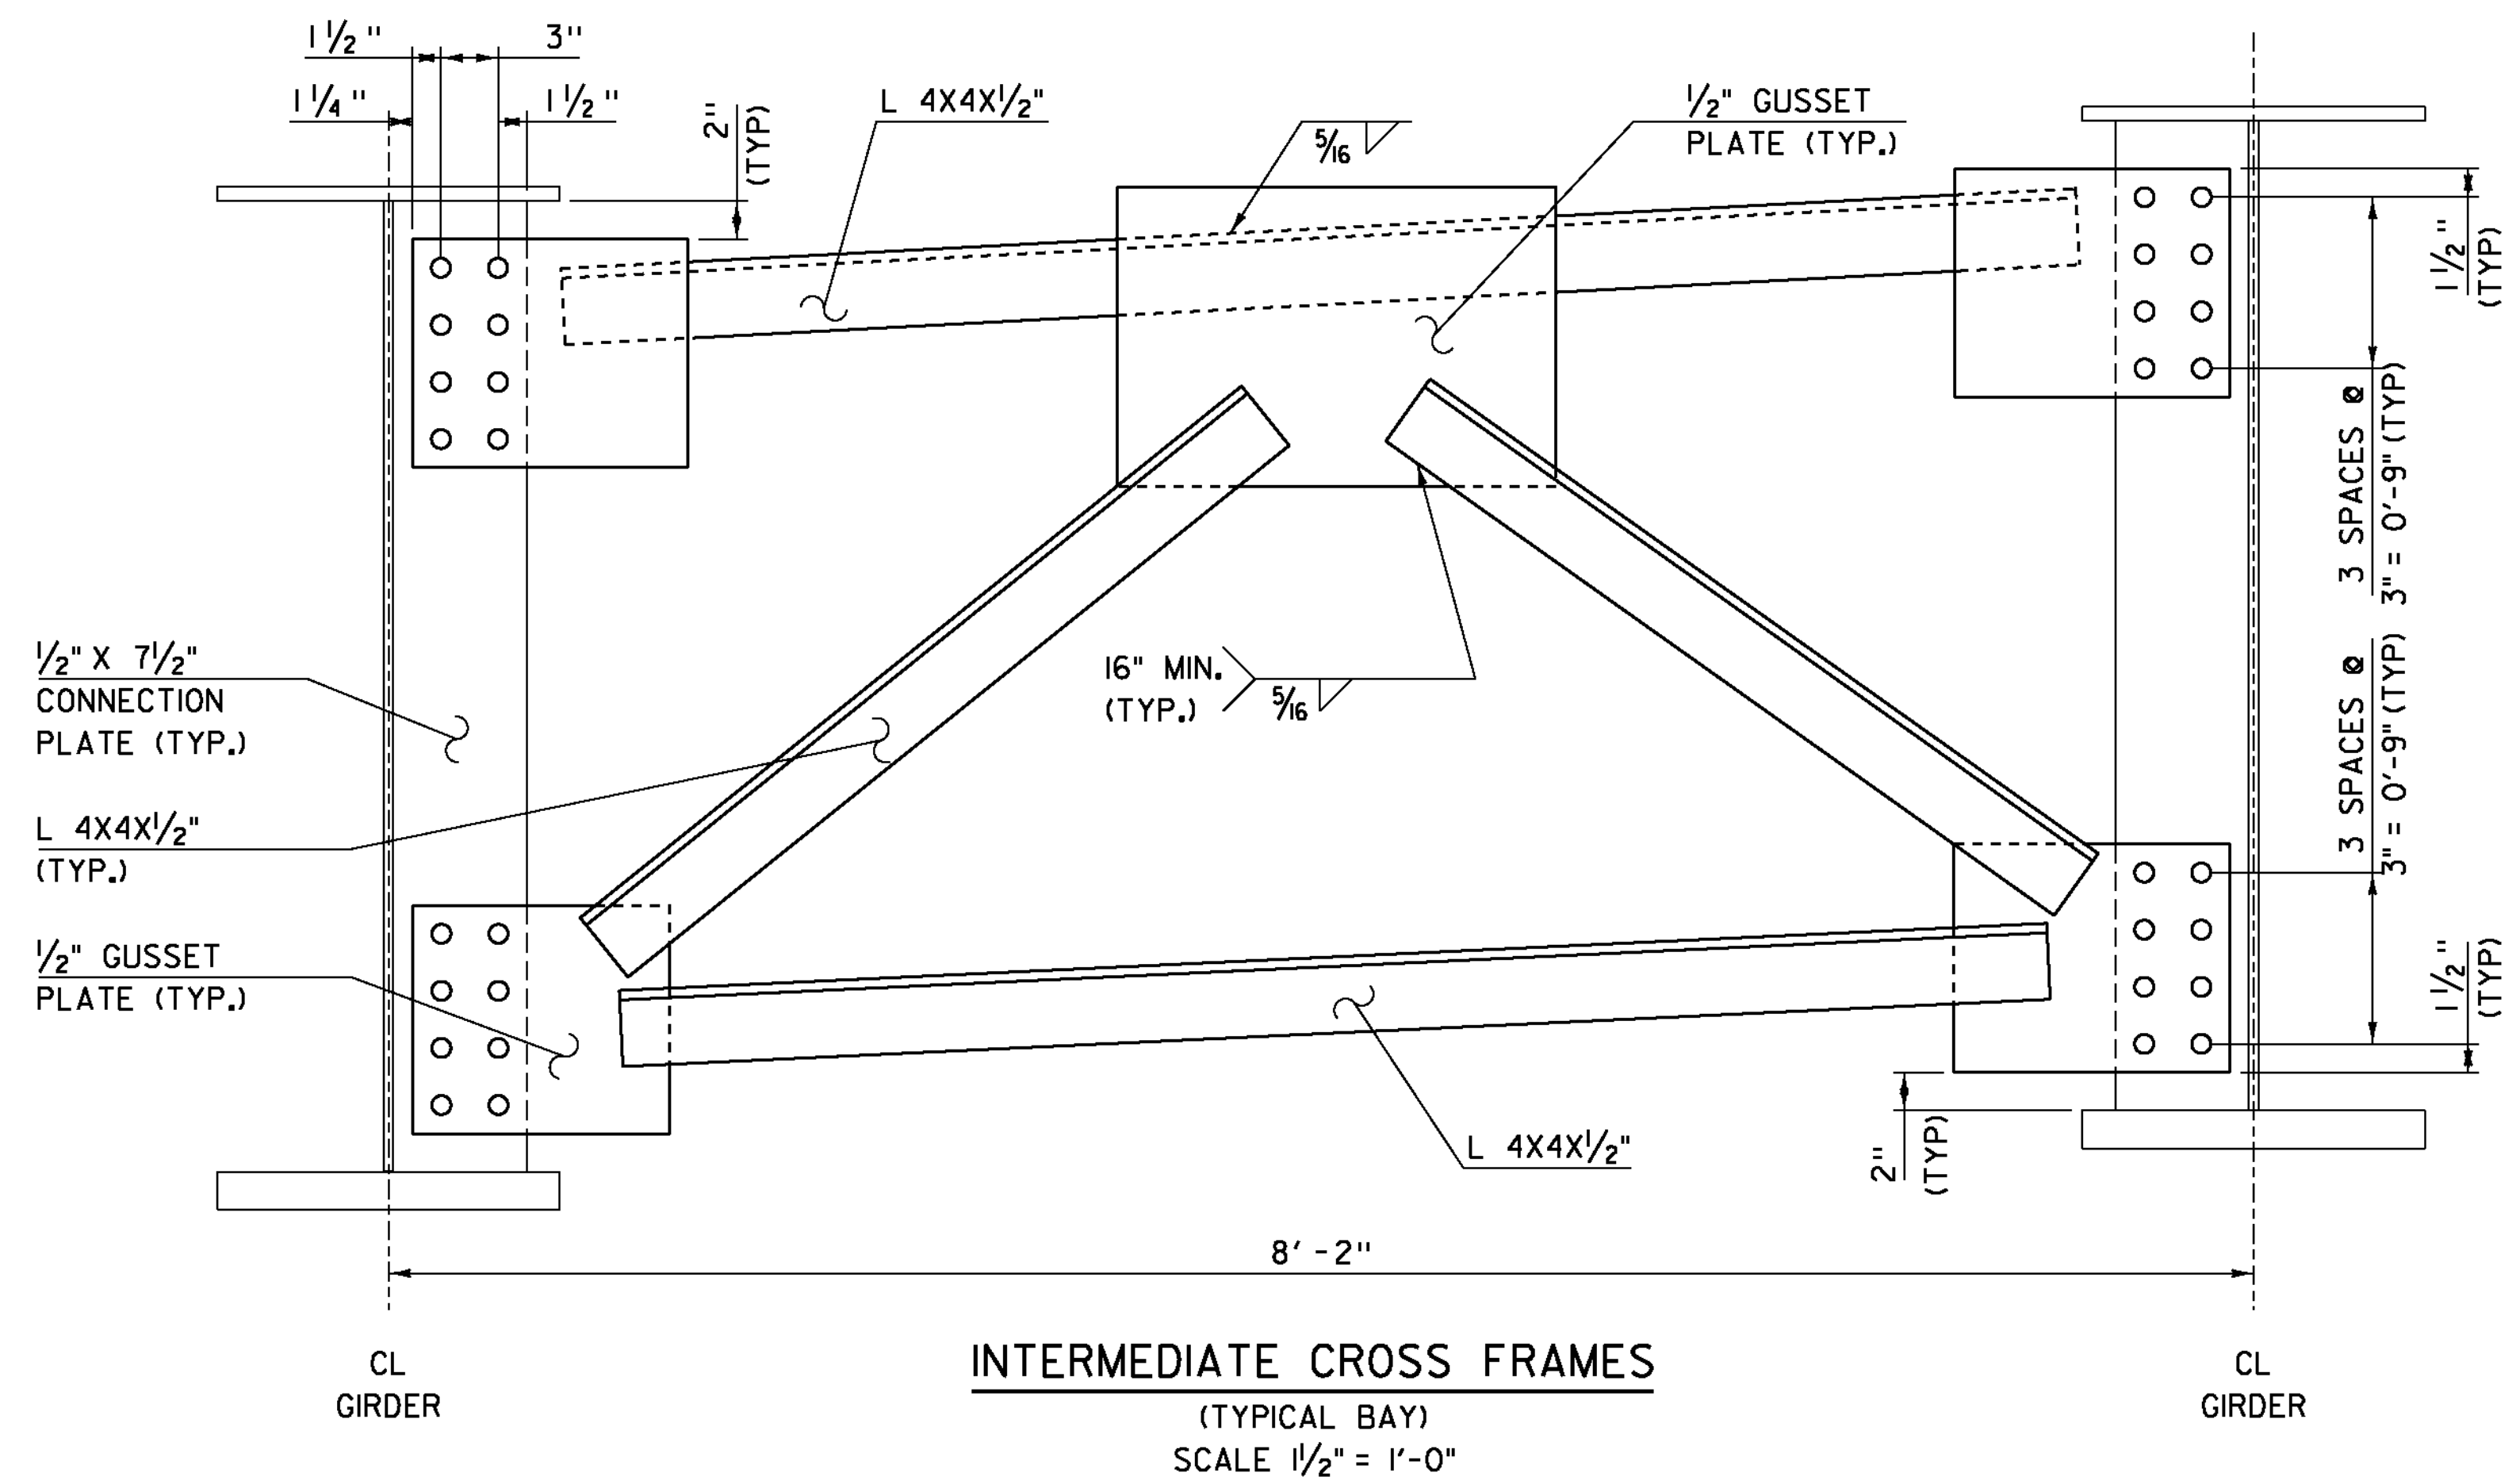


PROJECT NAME: WOODFORD	
PROJECT NUMBER: ER BHF 010-1(44)	
FILE NAME: slb214sup.dgn	PLOT DATE: 23-MAR-2012
PROJECT LEADER: C. CARLSON	DRAWN BY: C. MOONEY
DESIGNED BY: M. EVANS-MONGEON	CHECKED BY: M. EVANS-MONGEON
TYPICAL CROSSFRAME DETAILS	
SHEET 25 OF 58	

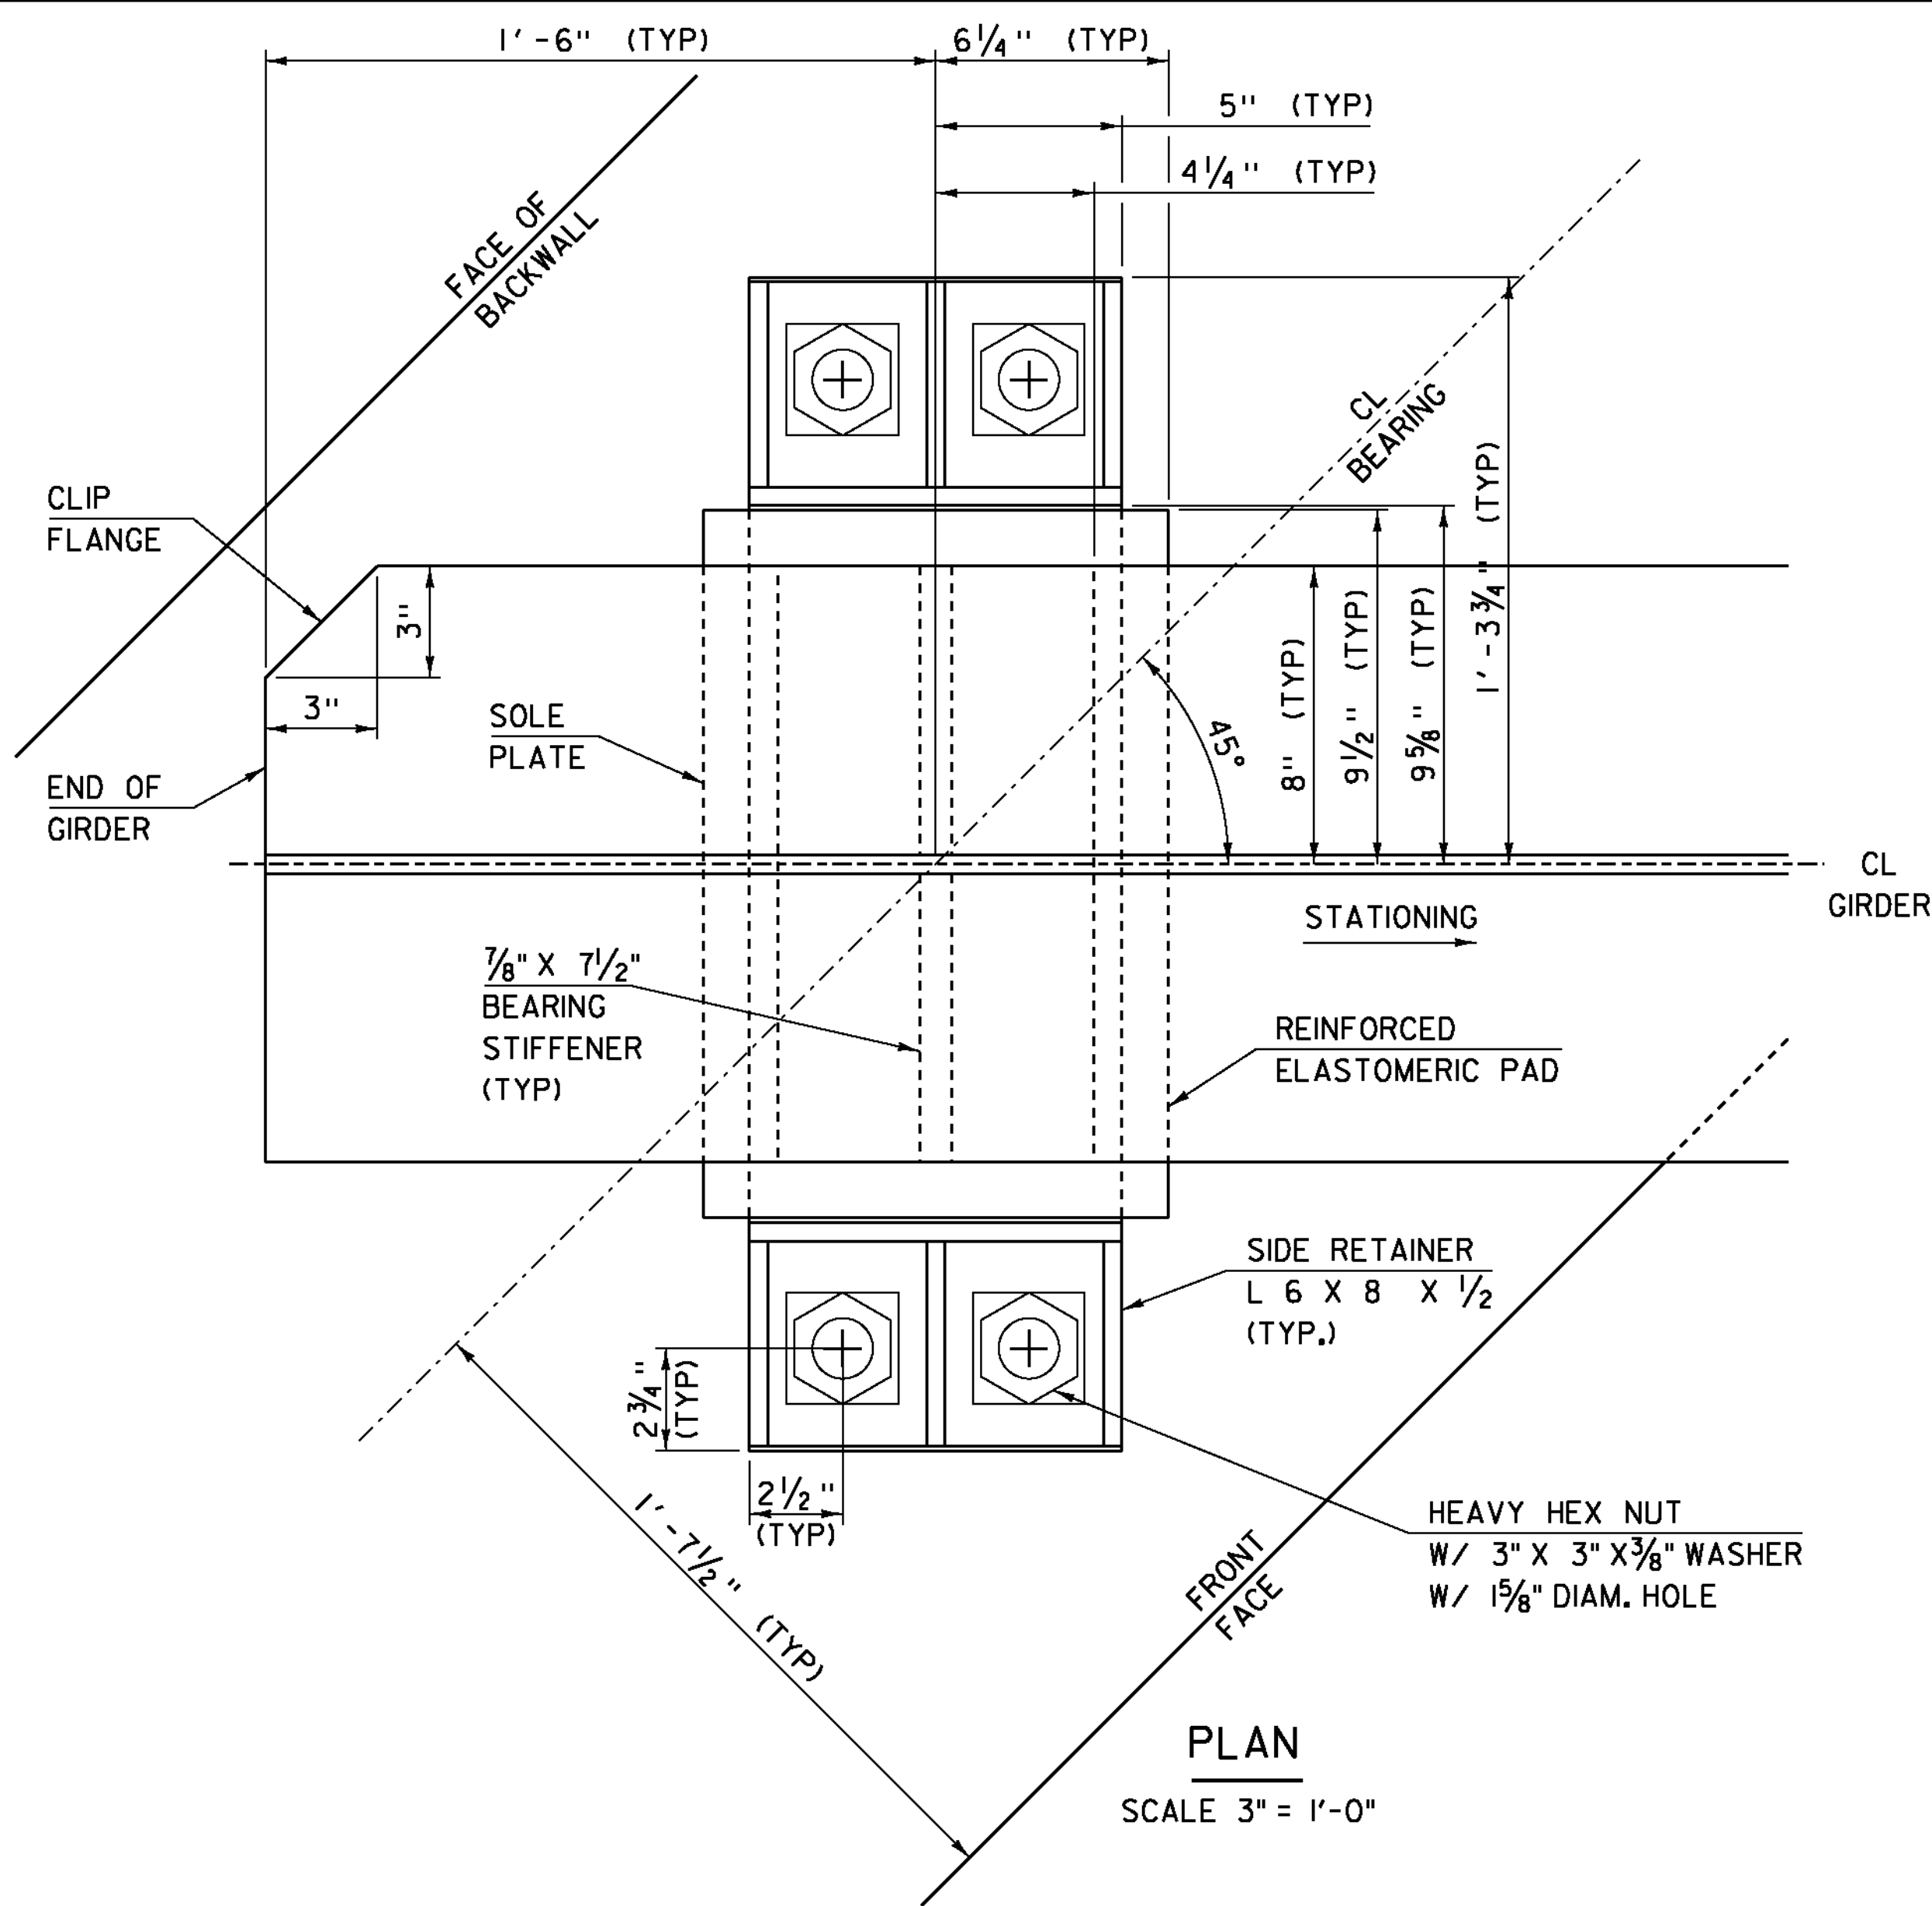


**BEARING DEVICE NOTES**

1. BEARINGS SHALL BE PAID FOR UNDER THE ITEM 531.17 "BEARING DEVICE ASSEMBLY, STEEL REINFORCED ELASTOMERIC PAD" AND SHALL CONFORM TO APPLICABLE SUBSECTIONS OF SECTION 531 AND 731.
2. THE FIELD WELD CONNECTING THE BOTTOM FLANGE WITH THE BEARING DEVICE SHALL BE MADE WITH E7018 RODS. AREAS OF METALIZING DAMAGED BY WELDING AND/OR HANDLING SHALL BE REPAIRED BY METALIZING IN ACCORDANCE WITH ASTM A 760/760M.
3. FABRICATION DRAWINGS CONFORMING TO SUBSECTION 531.03 SHALL BE SUBMITTED AND INCLUDE ANY NECESSARY WELDING OR BONDING PROCEDURES. THE FABRICATION DRAWINGS SUBMITTAL SHALL ALSO INCLUDE A TYPE D CERTIFICATION PER SUBSECTION 700.02 (C).
4. ALL STEEL COMPONENTS SHALL BE METALIZED AS PER SUBSECTION 531.04(b) AND 506.14. AFTER THE BEARINGS ARE METALIZED, THEY SHALL BE SEALED WITH AN APPROVED SEALANT AS SPECIFIED IN SUBSECTION 726.09(c). ALL WASHERS SHALL BE 3/8" PLATE MINIMUM. PAYMENT FOR ANCHOR BOLTS, NUTS, AND WASHERS SHALL BE INCLUDED IN THE UNIT BID PRICE FOR "BEARING DEVICE ASSEMBLY, STEEL REINFORCED ELASTOMERIC PAD". ANCHOR BOLTS, NUTS AND WASHERS SHALL BE GALVANIZED PER AASHTO M 232/M 232M.
5. ALL STEEL IN BEARING DEVICES SHALL BE AASHTO M270M/M270 GRADE 36.
6. ALL REINFORCEMENT BETWEEN LAYERS OF ELASTOMERIC SHALL BE STEEL ASTM A36. ALL INTERNAL STEEL PLATES SHALL BE SAND BLASTED AND FREE OF COATINGS, RUST, AND MILL SCALE. THE PLATES SHALL BE FREE OF SHARP EDGES AND BURRS.
7. STEEL REINFORCED ELASTOMERIC PAD BEARINGS SHALL HAVE A MINIMUM OF 1/8" EDGE SEAL OF ELASTOMER INTEGRAL WITH THE BEARING OVER ALL INTERNAL PLATES.
8. FOR ELASTOMERIC BEARINGS, ALL MATERIALS SHALL CONFORM TO AASHTO M251M/M251.
9. ALTERNATE CONFIGURATIONS FOR BEARINGS MAY BE SUBMITTED FOR APPROVAL. ANY ALTERNATE SUBMITTED SHALL BE DESIGNED AND CERTIFIED TO MEET THE DESIGN LOADS AND CRITERIA SHOWN ON THIS SHEET. THE ALTERNATE SHALL MAINTAIN THE ANCHORAGE SYSTEM SHOWN AND SHALL BE DESIGNED PER AASHTO STANDARD SPECIFICATIONS FOR HIGHWAY BRIDGES LATEST REVISIONS.
10. BRIDGE SEAT ELEVATIONS MAY BE REVISED TO ACCOMMODATE AN ALTERNATIVE CONFIGURATION.
11. DESIGN CRITERIA:
  - A. DESIGN ROTATION = 0.01 RADIAN
  - B. HORIZONTAL CAPACITY SHALL BE MINIMUM OF 20% VERTICAL LOAD IN ANY RESTRAINED DIRECTION.
  - C. VERTICAL DESIGN LOAD PER BEARING :
    - ABUTMENT BEARINGS  
RDL = 45.0 Kips  
RLL = 79.0 Kips
  - D. TEMPERATURE RANGE = -30°F TO 120°F
  - E. ELASTOMER SHALL HAVE NOMINAL HARDNESS OF 60 ON SHORE 'A' SCALE. ELASTOMER SHALL HAVE A SHEAR MODULUS BETWEEN 130 AND 175 psi. THE RAW ELASTOMER SHALL BE VIRGIN NEOPRENE CLASSIFIED AS LOW TEMPERATURE GRADE 4 AS DEFINED IN TABLE 18.4.5.1- 1A OF AASHTO, DIVISION II, SECTION 18.
  - F. NO FABRIC REINFORCEMENT WILL BE ALLOWED IN ELASTOMERIC PADS
12. THE BEARING TOLERANCES SHALL MEET THOSE GIVEN IN AASHTO STANDARD SPECIFICATIONS FOR HIGHWAY CONSTRUCTION AND ITS LATEST REVISIONS, DIVISION II SECTION 18.
13. THE STEEL SOLE PLATES AND MASONRY PLATES SHALL BE HOT BONDED TO THE REINFORCED ELASTOMERIC PAD DURING THE VULCANIZATION PROCESS. THE STEEL SURFACES TO BE BONDED TO THE PAD SHALL NOT BE METALIZED.
14. THE ANCHOR BOLTS SHALL MEET THE REQUIREMENTS OF A 307 GR. C.

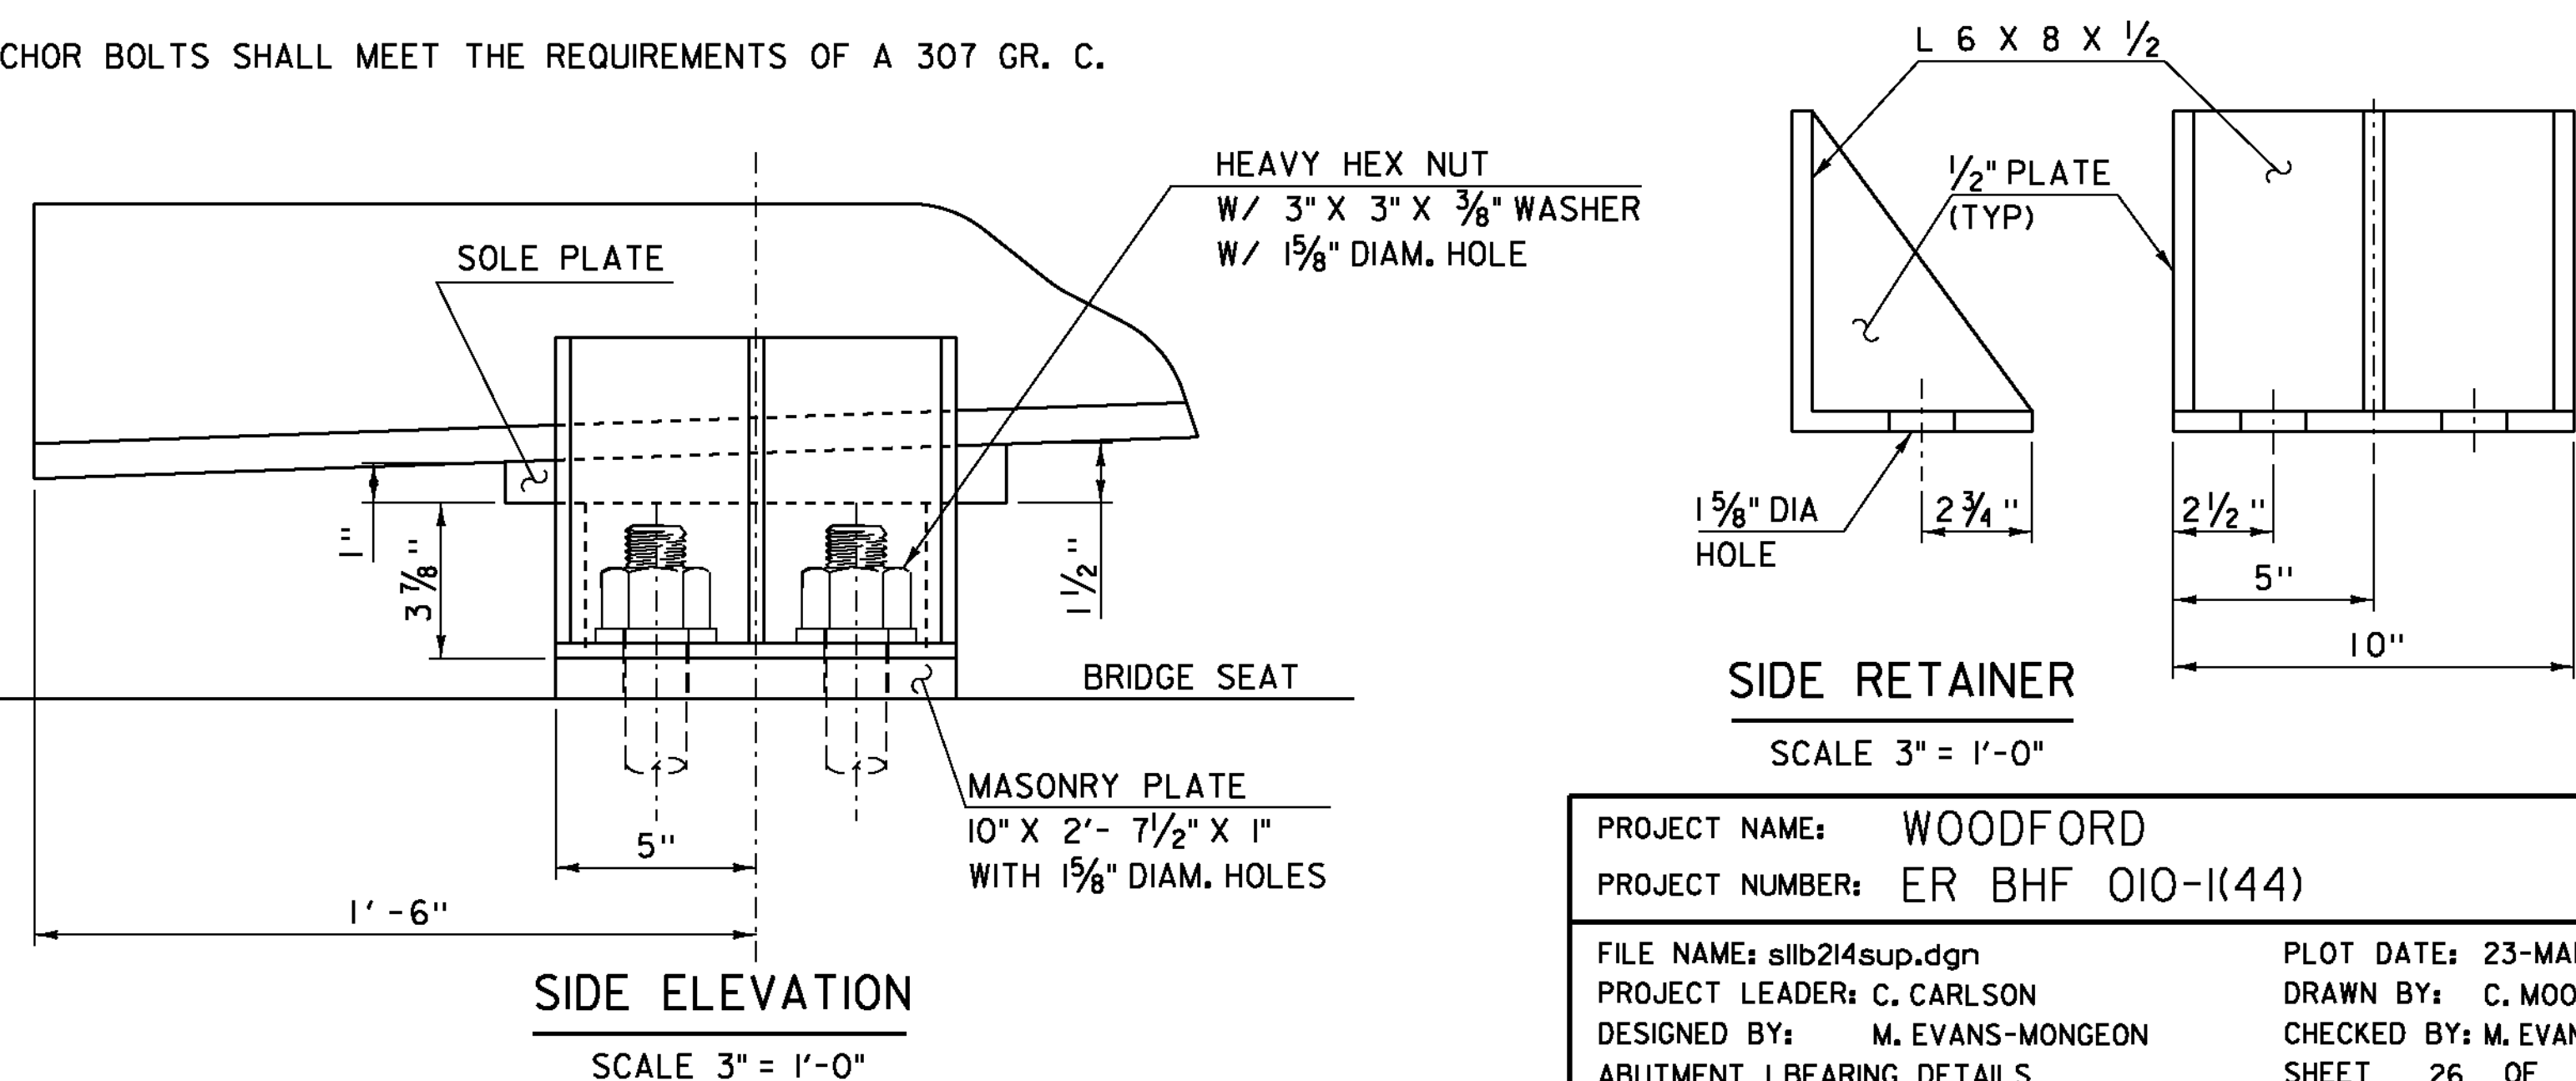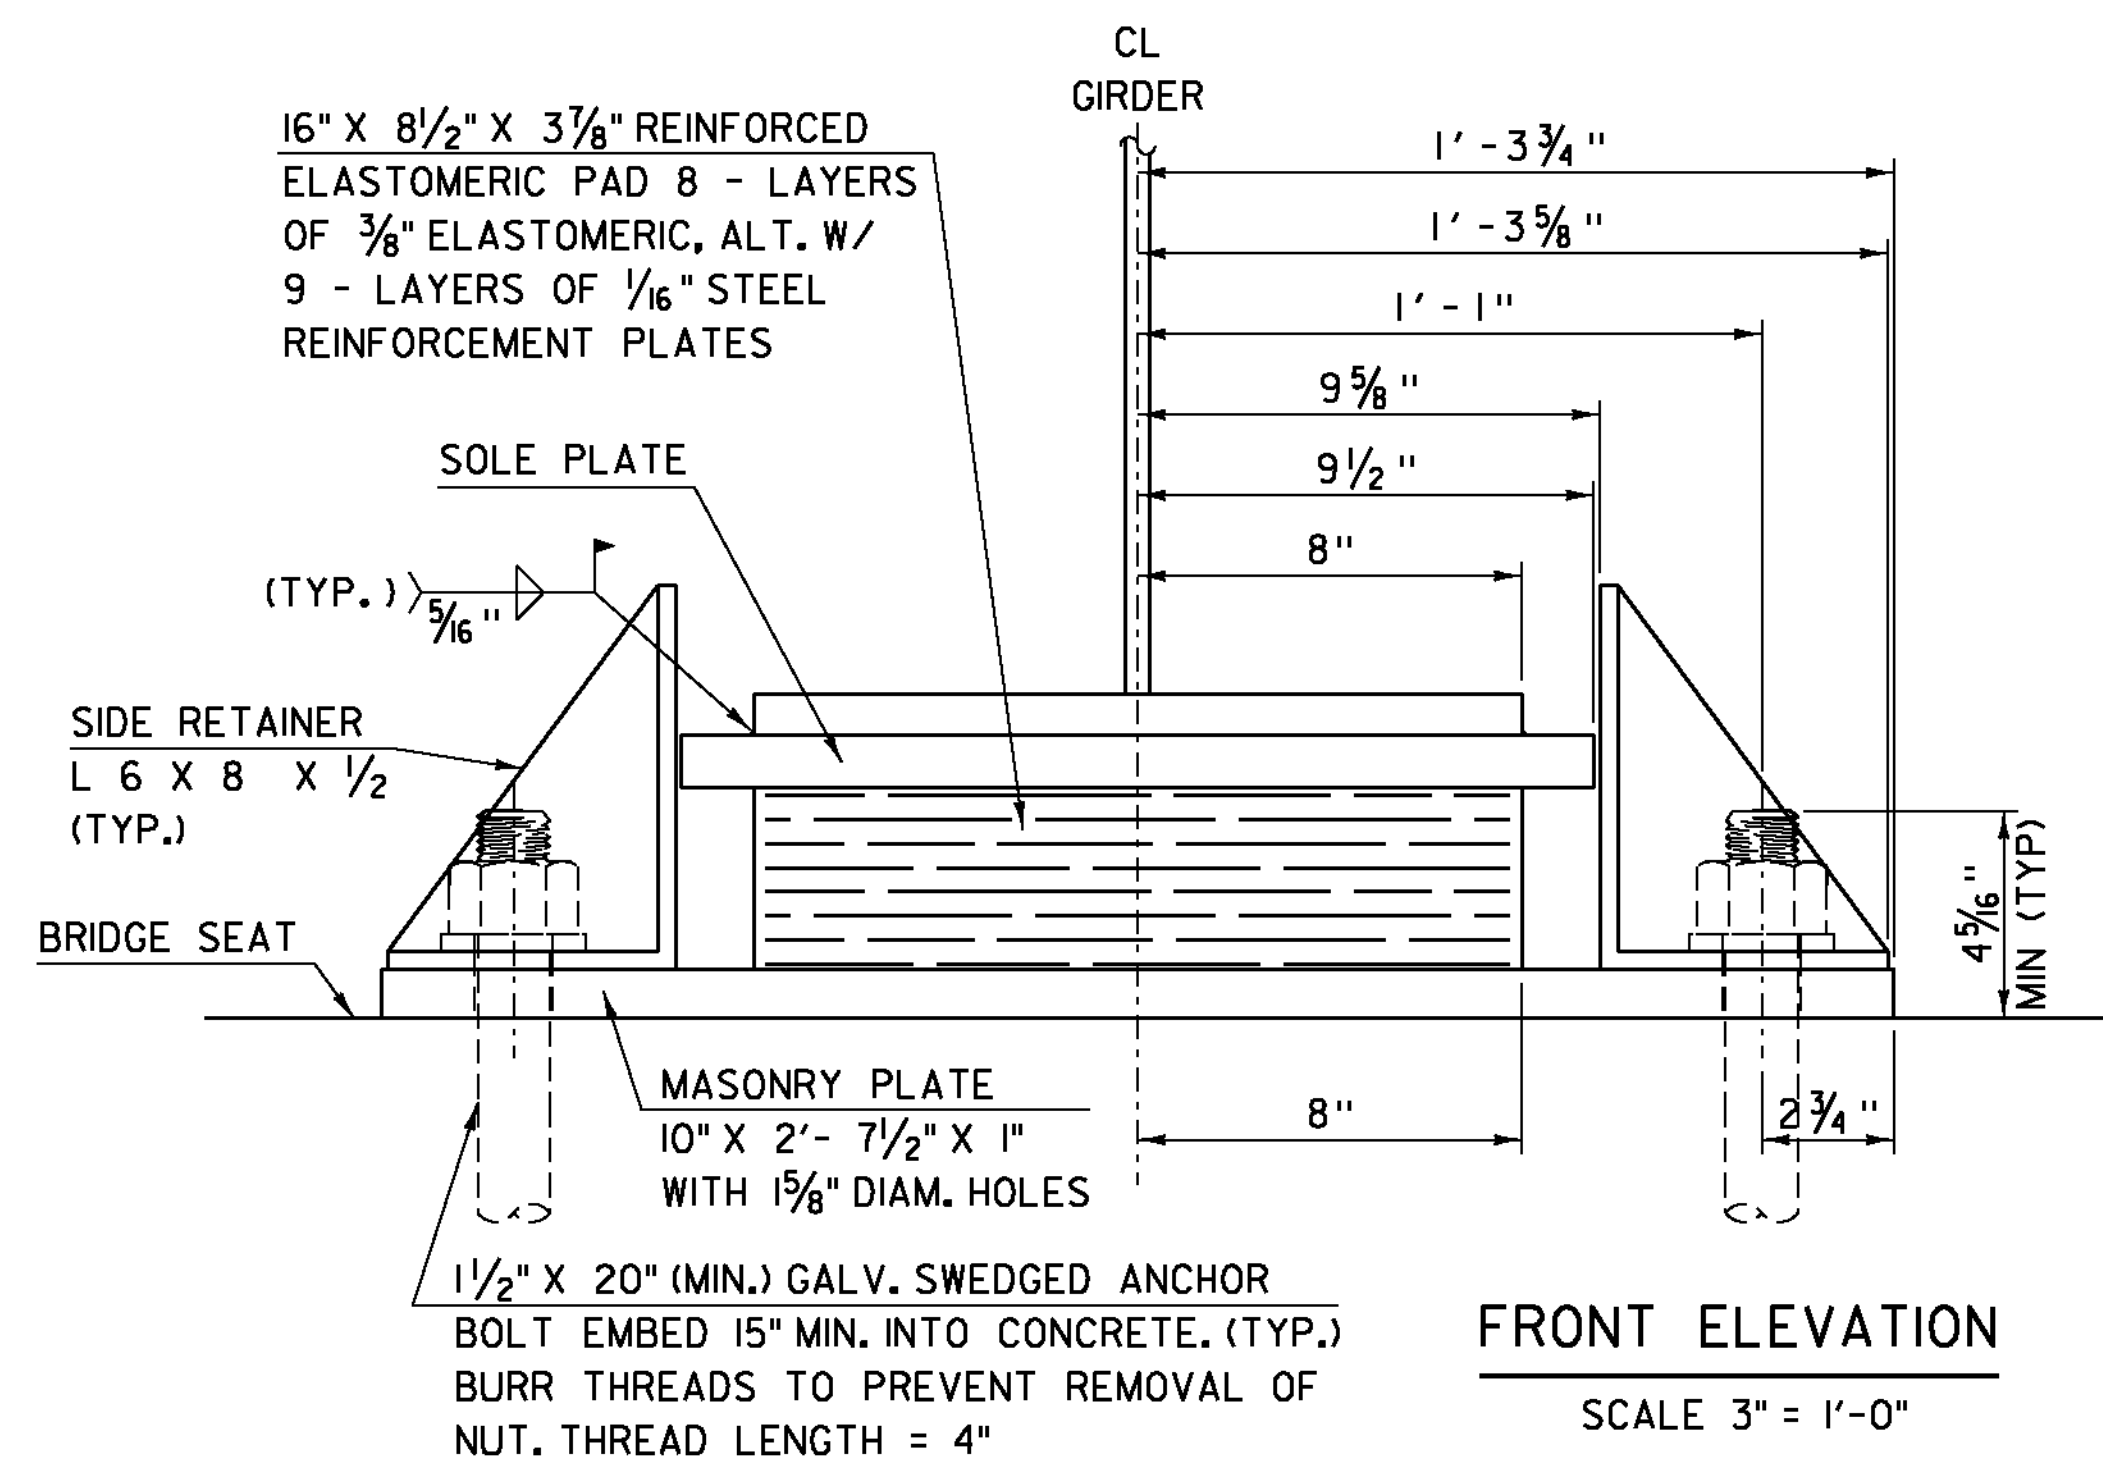


PROJECT NAME: WOODFORD	
PROJECT NUMBER: ER BHF 010-1(44)	
FILE NAME: silb214sup.dgn	PLOT DATE: 23-MAR-2012
PROJECT LEADER: C. CARLSON	DRAWN BY: C. MOONEY
DESIGNED BY: M. EVANS-MONGEON	CHECKED BY: M. EVANS-MONGEON
ABUTMENT I BEARING DETAILS	SHEET 26 OF 58

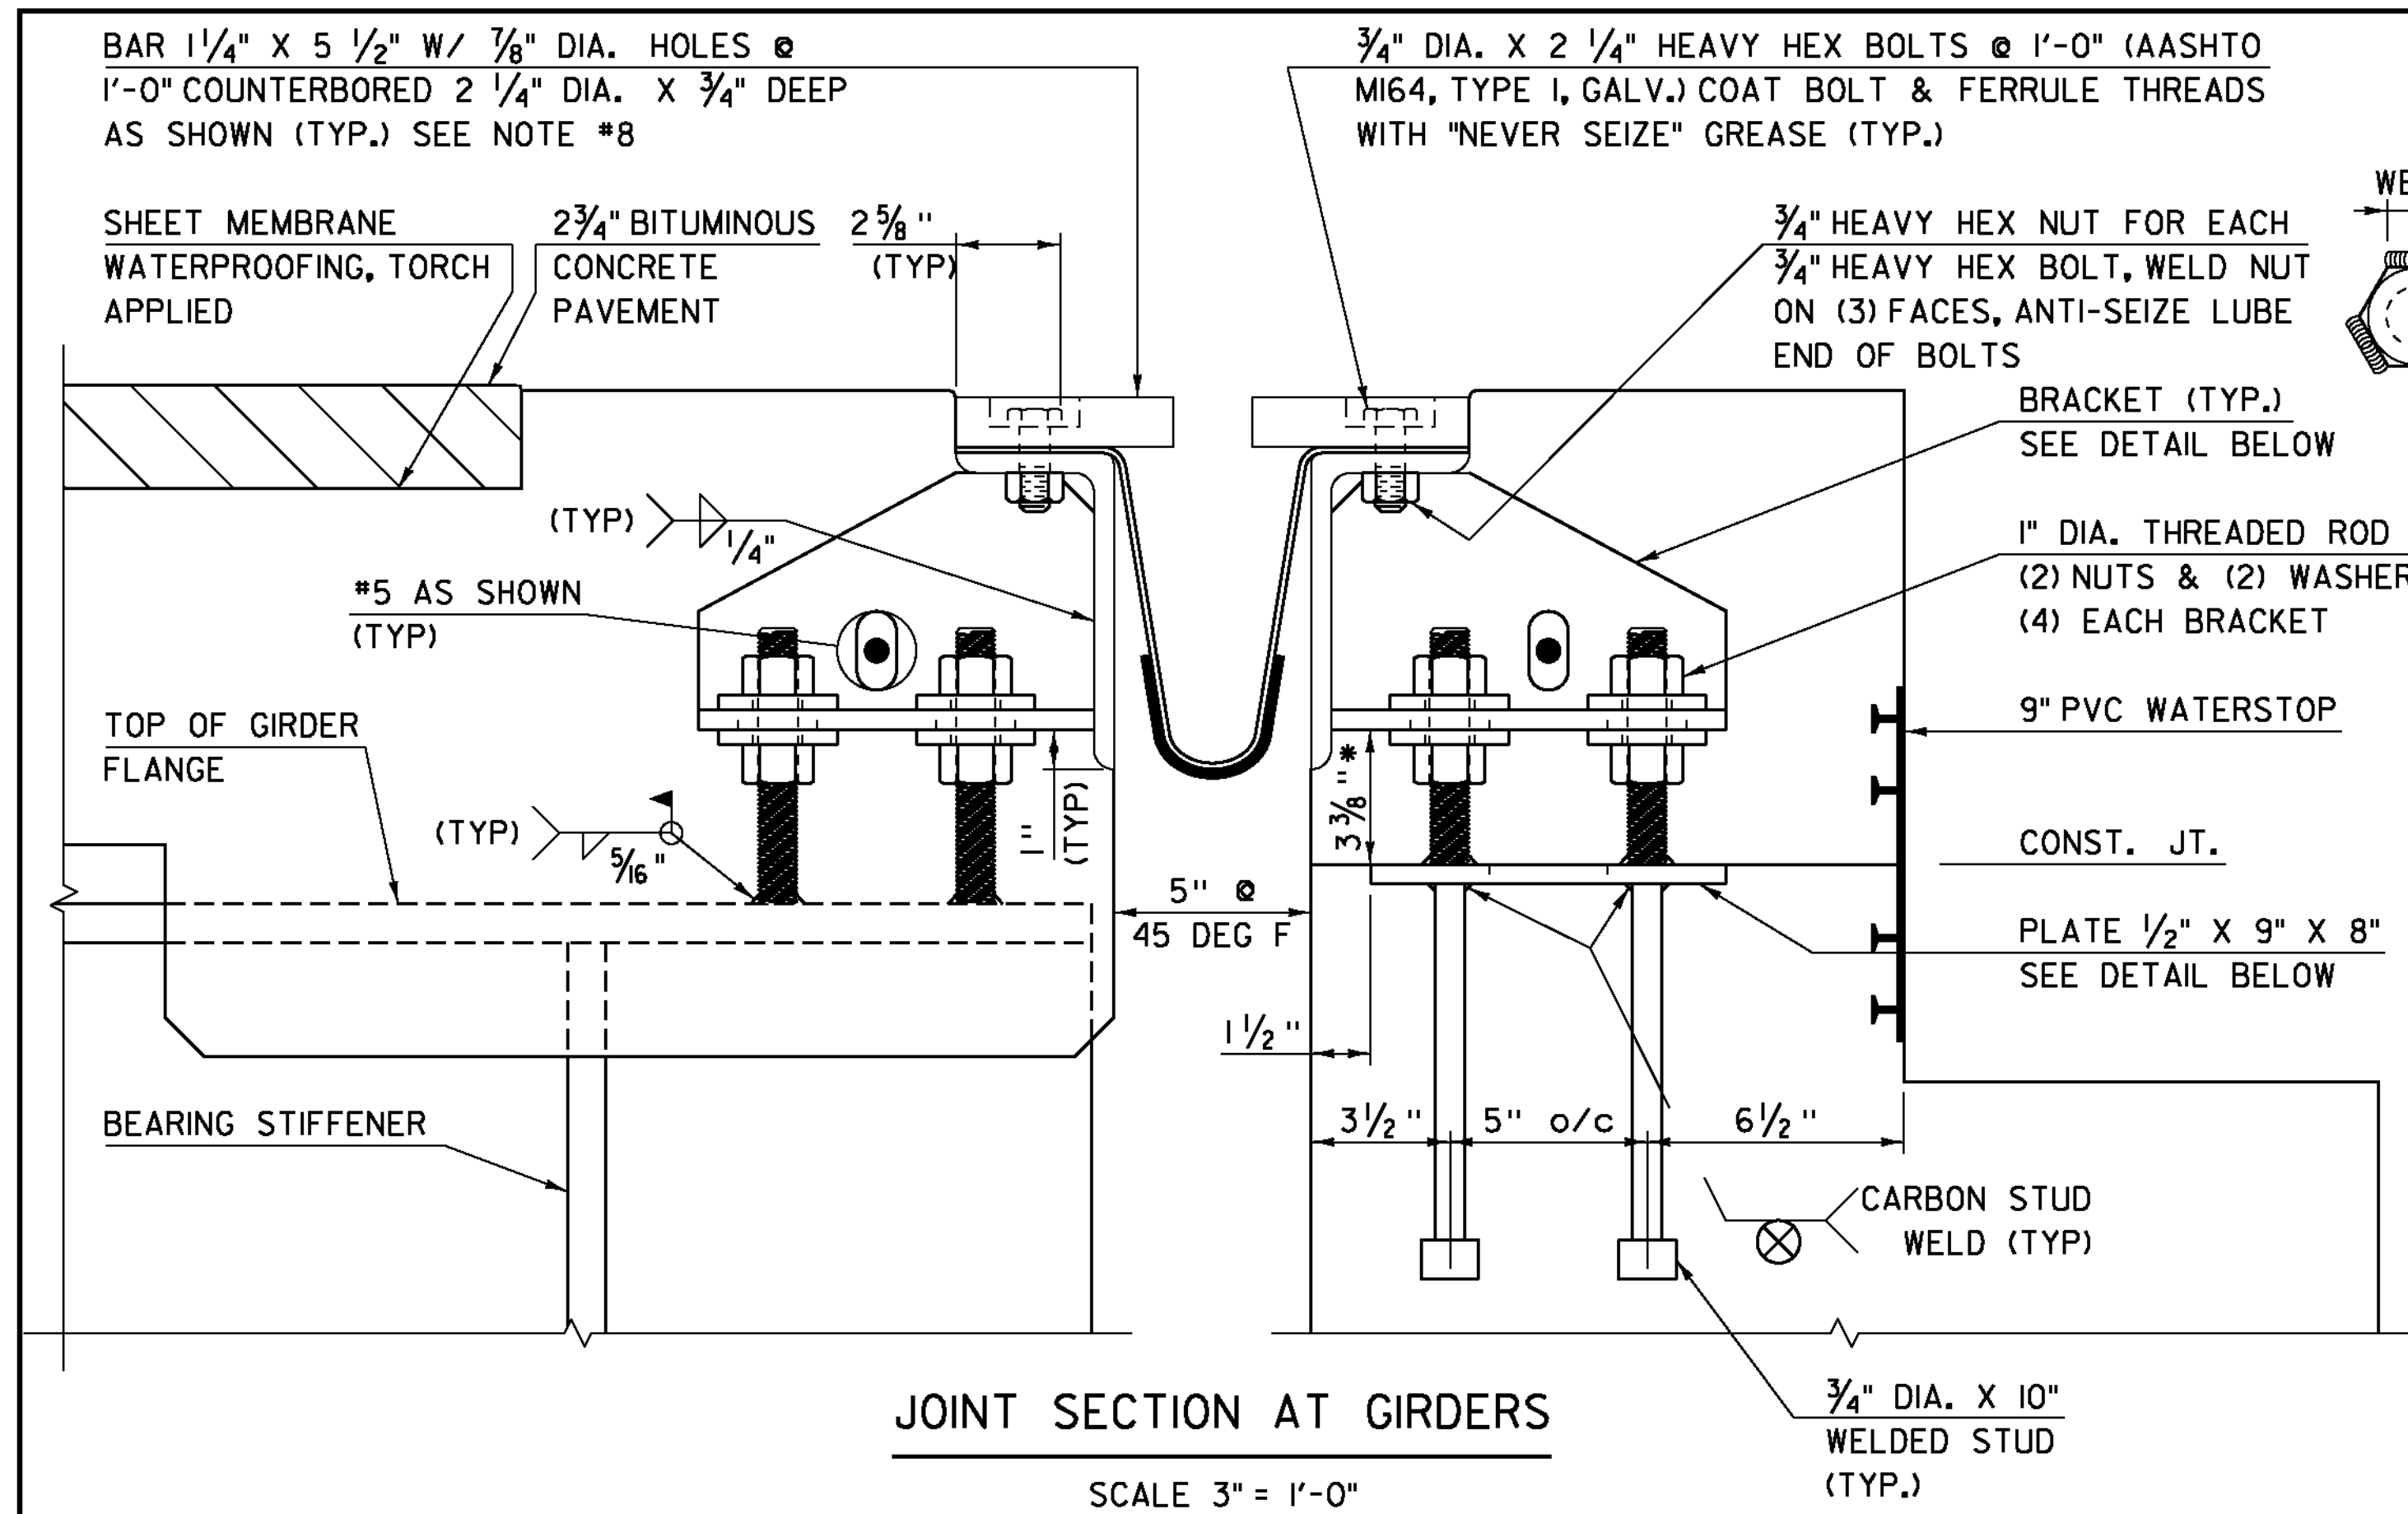

**JOINT SECTION AT GIRDERS**

SCALE 3" = 1'-0"

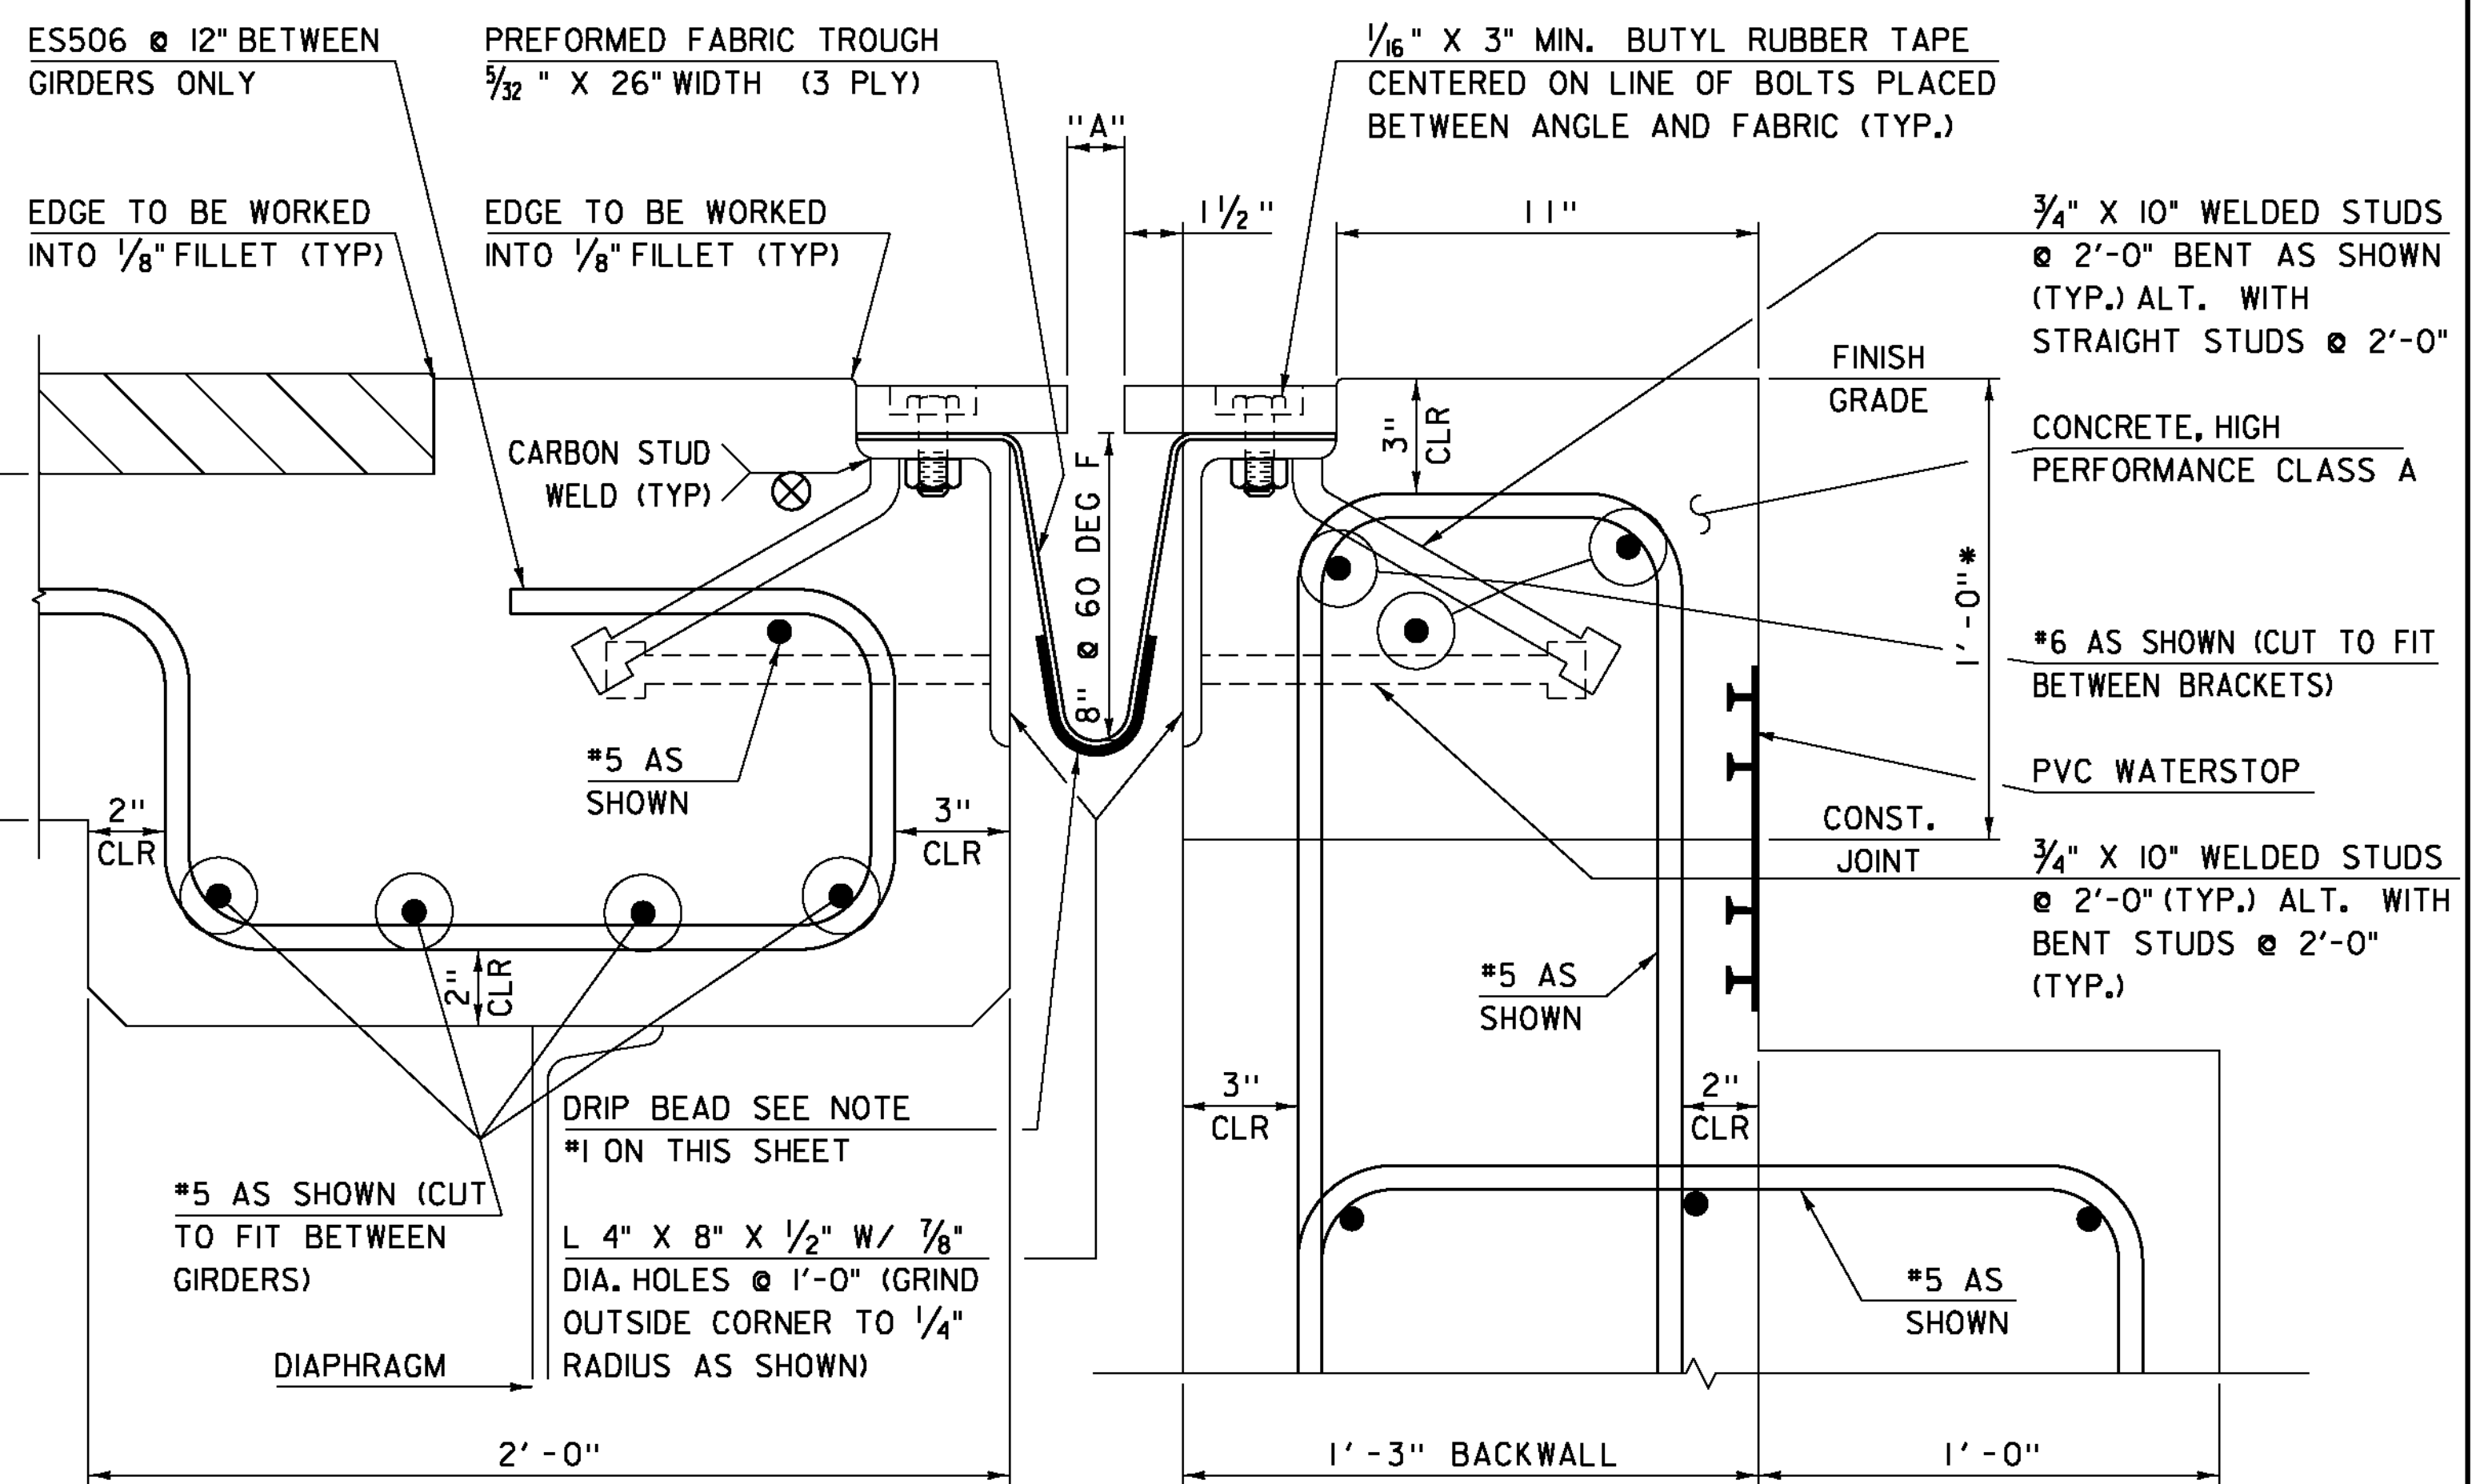


**JOINT SECTION BETWEEN GIRDERS**

SCALE 3" = 1'-0"


**NOTES FOR ITEM 516.11 "BRIDGE EXPANSION JOINT, VERMONT"**

- FABRIC TROUGH SHALL BE THOROUGHLY CLEANED AND FLUSHED AFTER PAVING OPERATION. A DRIP BEAD OF 1/4"x7" STRIP OF PREFORMED FABRIC MATERIAL SHALL BE CEMENTED TO THE BOTTOM OF THE FABRIC TROUGH USING AN ADHESIVE APPROVED BY THE MANUFACTURER. THE DRIP BEAD SHALL BE APPLIED 1" FROM THE DOWNSPOUT END OF THE TROUGH. PREFORMED FABRIC MATERIAL SHALL BE CONTINUOUS FOR THE FULL LENGTH OF THE JOINT.
- THE EXPANSION DEVICE SHALL BE COVERED TO PROTECT THE FINISH DURING PLACING OF BRIDGE DECK CONCRETE.
- SEE "JOINT GAP DIMENSION TABLE" FOR DISTANCE "A" VALUES IN TEMPERATURE RANGE PROVIDED.
- JOINT BRACKET LENGTH VARIES DEPENDENT ON THE BRIDGE SKEW ANGLE. THE BRACKET MUST BE LOCATED SUCH THAT THE THREADED RODS ARE NOT LESS THAN 1/2" FROM GIRDERS END OR FLANGE SIDES.
- ALL STEEL COMPONENTS SHALL BE GALVANIZED OR METALIZED AND MEET THE REQUIREMENTS OF SUBSECTION 726.08 OR 726.09. PRIOR TO GALVANIZING OR METALIZING, ALL CORNERS AND EDGES OF STEEL PLATES, SHAPES, ETC., SHALL BE GROUND TO A 1/16" INCH RADIUS. THREADED RODS SHALL CONFORM TO THE REQUIREMENTS OF 714.04. THE "WELDED STUD ANCHOR PLATE" AND WELDED STUDS MAY BE SUPPLIED WITHOUT GALVANIZING OR METALIZING.
- THE 4"x8"x 1/2" ANGLES MAY BE FURNISHED AS ONE CONTINUOUS PIECE OR SPLICED AS SHOWN IN THE FIELD SPLICE DETAIL. THE 1 1/4"x5 1/2" BARS EACH SIDE OF THE JOINT SHALL BE PROVIDED IN TWO EQUAL LENGTHS.
- PROJECTING THREADS OF THE 3/4" DIA. BOLTS IN THE JOINT SHALL BE GREASED BY THE CONTRACTOR PRIOR TO PLACING ADJACENT CONCRETE. THIS WILL FACILITATE BOLT REMOVAL IF REQUIRED IN THE FUTURE.
- FILL COUNTERBORED HOLES WITH HOT POURED JOINT SEALER IN ACCORDANCE WITH SUBSECTION 707.04 AFTER BOLT INSTALLATION. PAYMENT FOR THE WORK SHALL BE INCIDENTAL TO ITEM 516.11 "BRIDGE EXPANSION JOINT, VERMONT".
- THE FABRIC TROUGH SHALL BE ONE CONTINUOUS FABRIC PIECE. THE EXPANSION JOINT MAY BE SHOP ASSEMBLED AND SHIPPED AS ONE CONTINUOUS PIECE, OR IT MAY HAVE ONE FIELD SPLICE AS DETAILED ON THIS SHEET. IF THE EXPANSION JOINT HAS A FIELD SPLICE, THE FABRIC TROUGH SHALL BE SHIPPED WITH ONE UNIT AND ASSEMBLED WITH THE SECOND UNIT PRIOR TO CONCRETE PLACEMENT.
- TEMPORARY SHIPPING ATTACHMENTS SHALL BE ATTACHED BY BOLTING; WELDING WILL NOT BE PERMITTED.

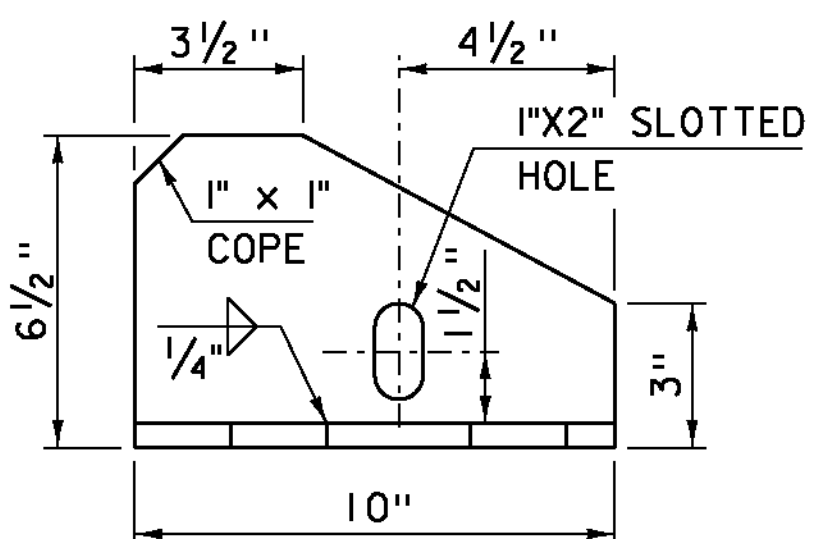


**BRACKET ELEVATION**

SCALE 3" = 1'-0"

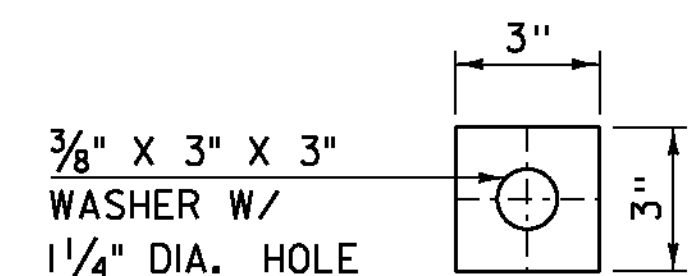


**WASHER FOR BRACKET**

SCALE 3" = 1'-0"

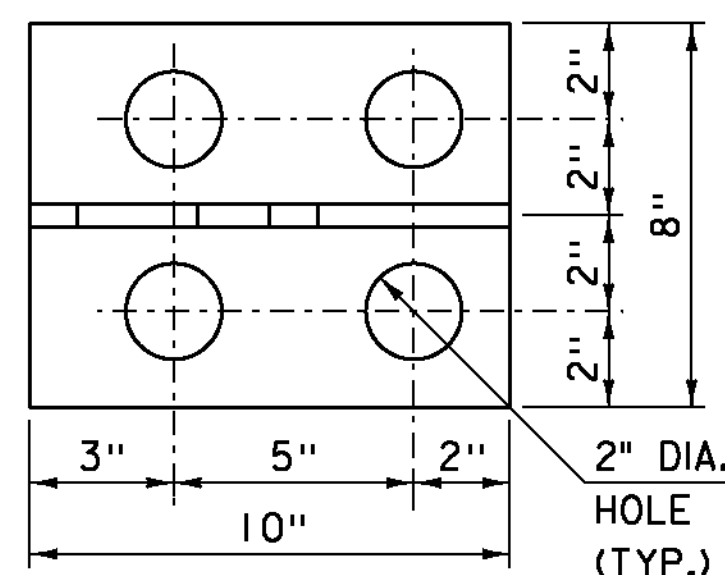

**BRACKET PLAN**

SCALE 3" = 1'-0"

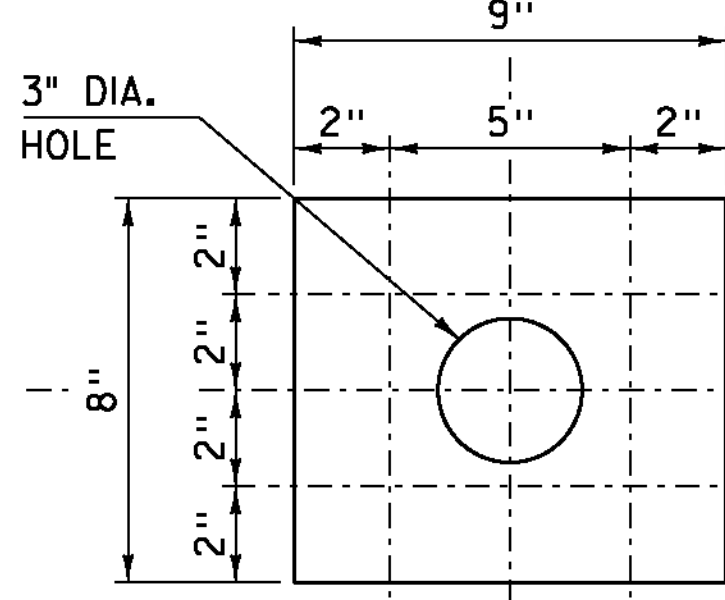


**PLATE PLAN**

SCALE 3" = 1'-0"

NOTE:

ALL PLATES 1/2"

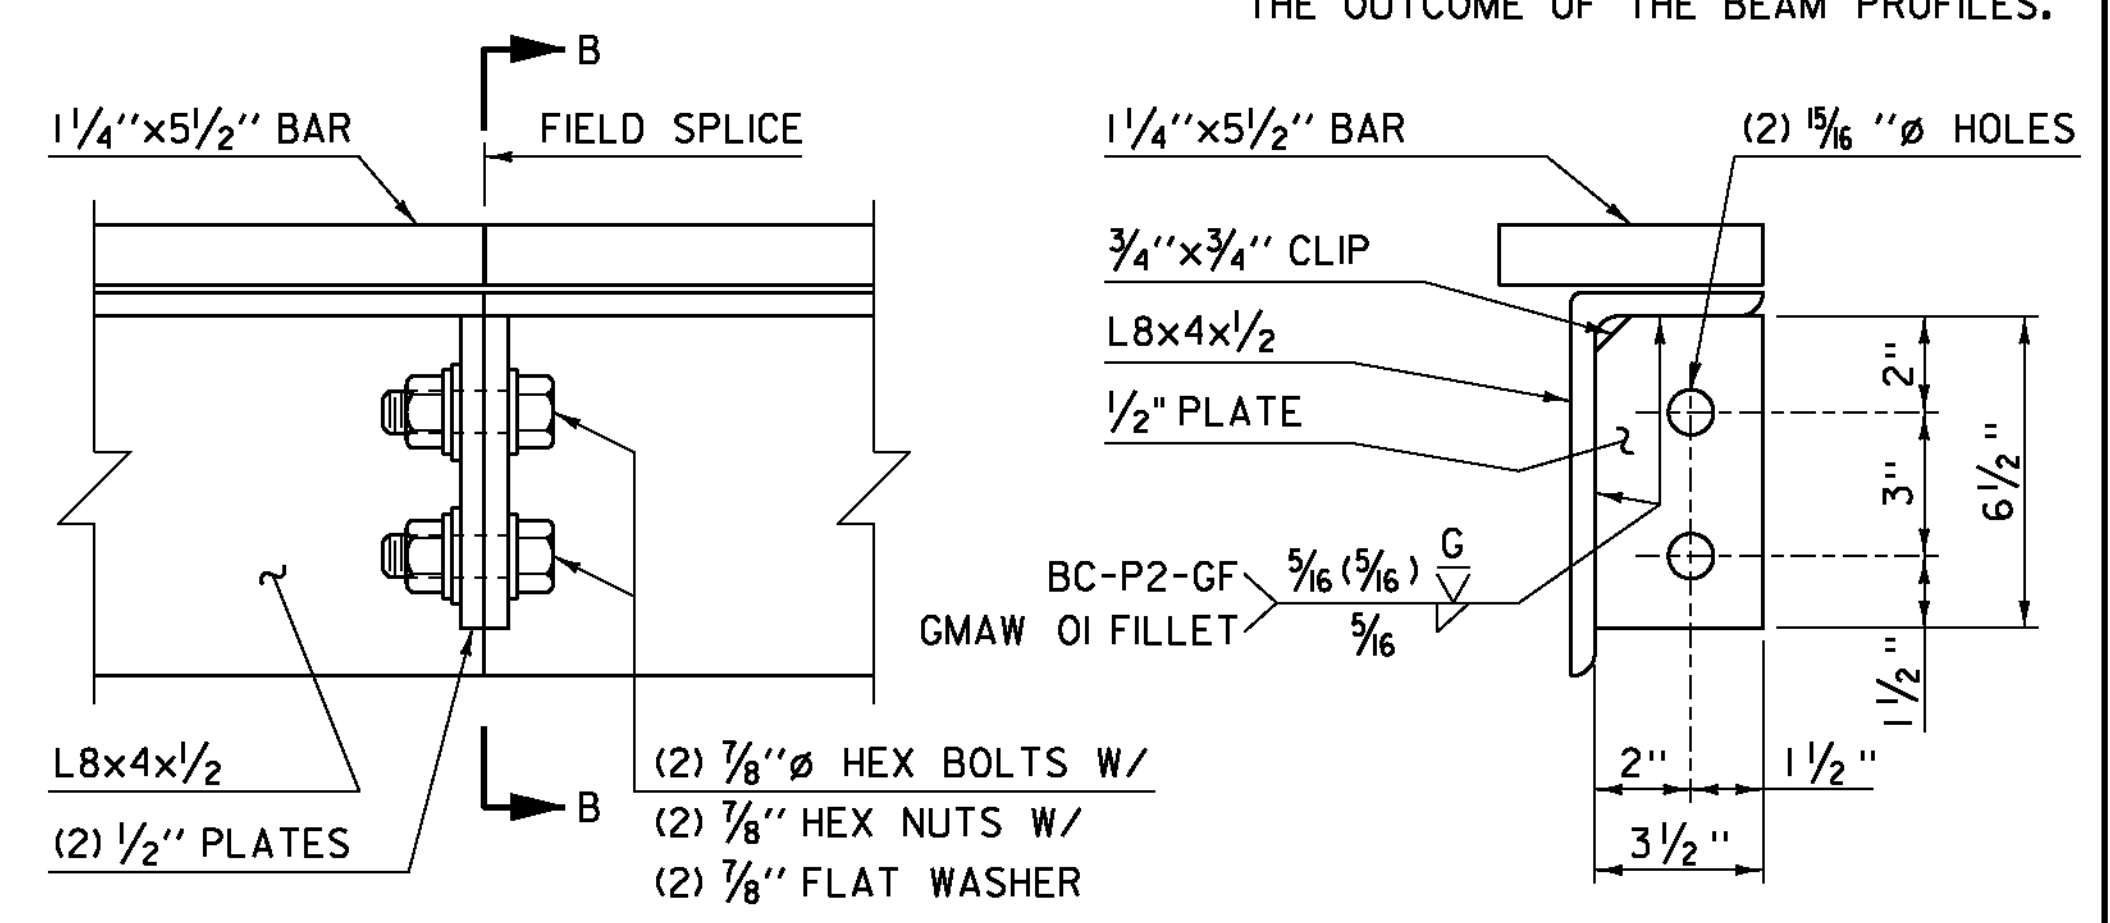

**OPTIONAL FIELD SPLICE DETAIL**

**SECTION "B-B"**

**JOINT GAP DIMENSION TABLE**




TEMP	"A" DIST
0 DEG F	2 3/8"
15 DEG F	2 1/4"
30 DEG F	2 1/8"
45 DEG F	2"
60 DEG F	1 7/8"
75 DEG F	1 3/4"
90 DEG F	1 5/8"
105 DEG F	1 1/2"

PROJECT NAME: WOODFORD  
 PROJECT NUMBER: ER BHF 010-1(44)


FILE NAME: sl1b214sup.dgn  
 PROJECT LEADER: C. CARLSON  
 DESIGNED BY: M. EVANS-MONGEON  
 BRIDGE EXPANSION JOINT DETAILS

PLOT DATE: 23-MAR-2012  
 DRAWN BY: C. MOONEY  
 CHECKED BY: M. EVANS-MONGEON  
 SHEET 27 OF 58

• THESE DIMENSIONS ARE THEORETICAL AND MAY CHANGE DEPENDING UPON THE OUTCOME OF THE BEAM PROFILES.




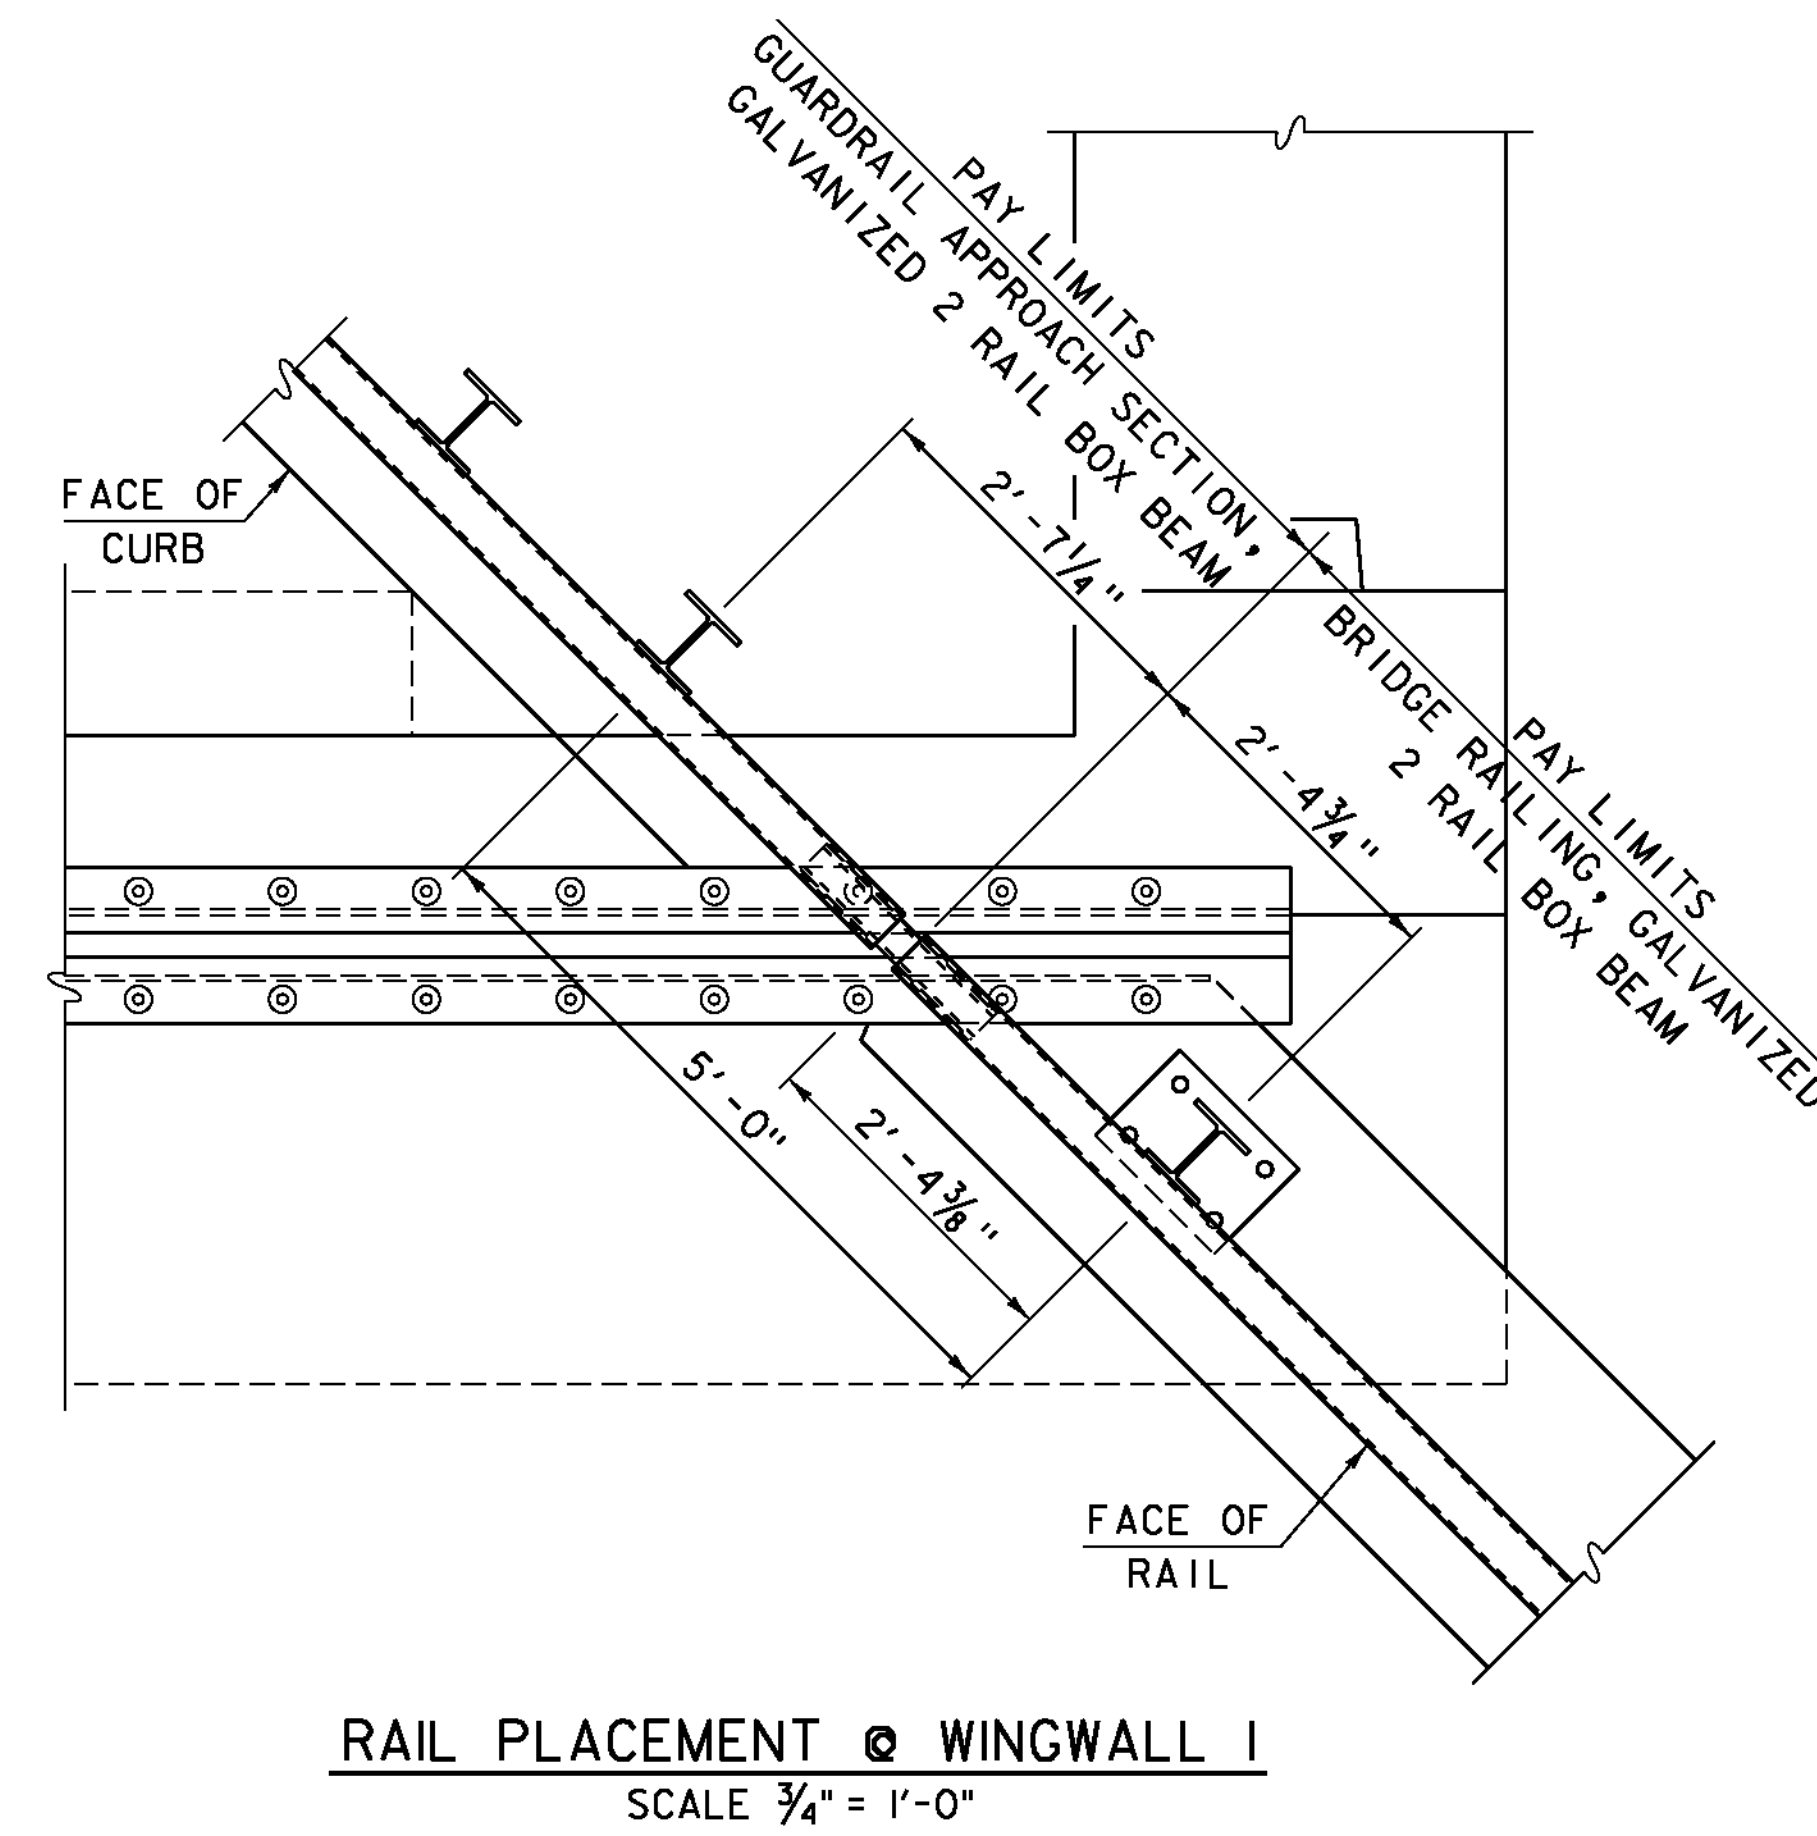
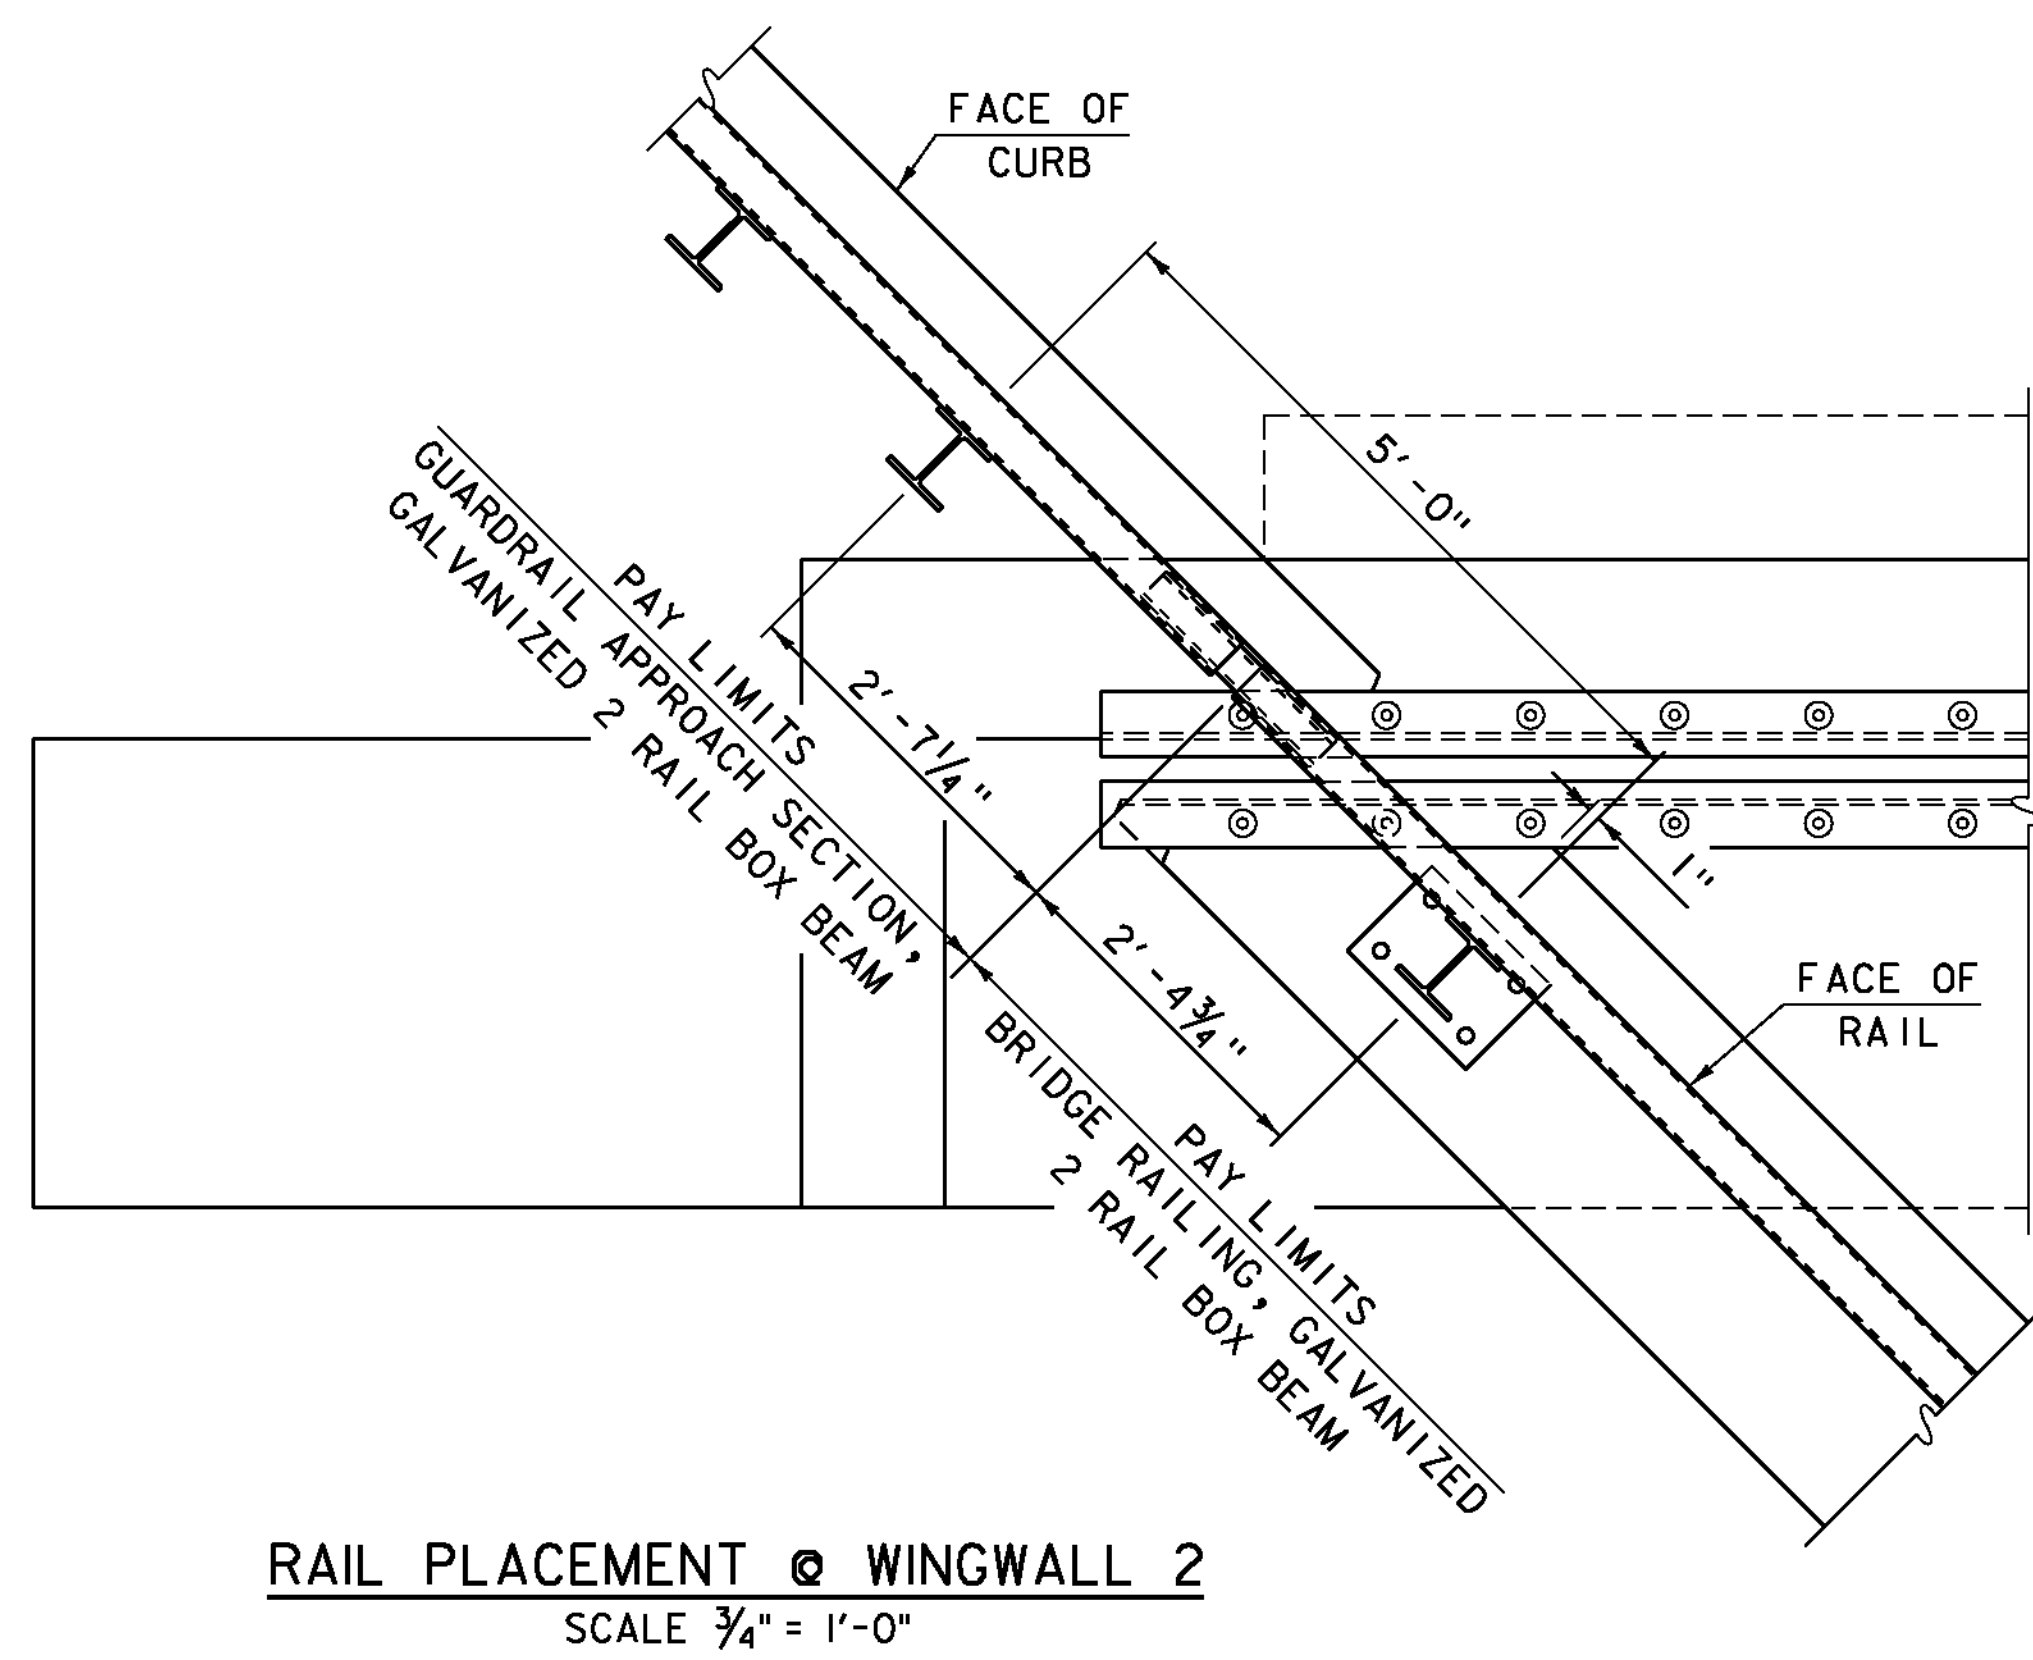
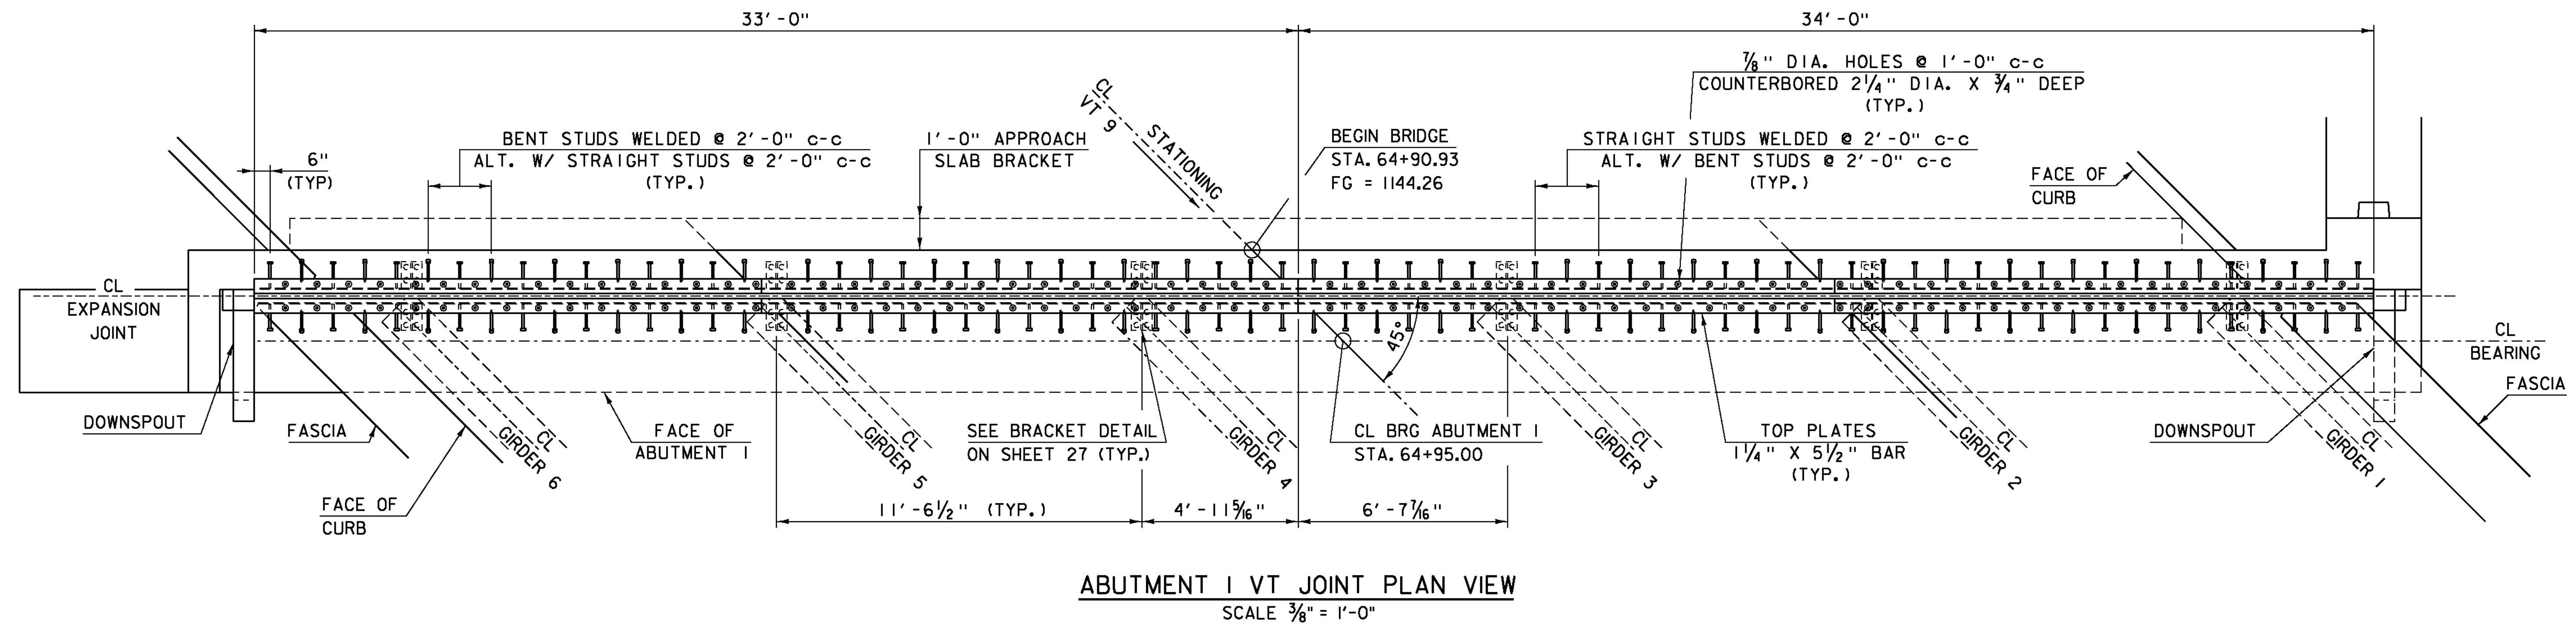


PROJECT NAME:	WOODFORD
PROJECT NUMBER:	ER BHF 010-1(44)
FILE NAME:	slb214sup.dgn
PROJECT LEADER:	C. CARLSON
DESIGNED BY:	M. EVANS-MONGEON
BRIDGE EXPANSION JOINT PLAN	
PLOT DATE:	23-MAR-2012
DRAWN BY:	C. MOONEY
CHECKED BY:	M. EVANS-MONGEON
SHEET	28 OF 58

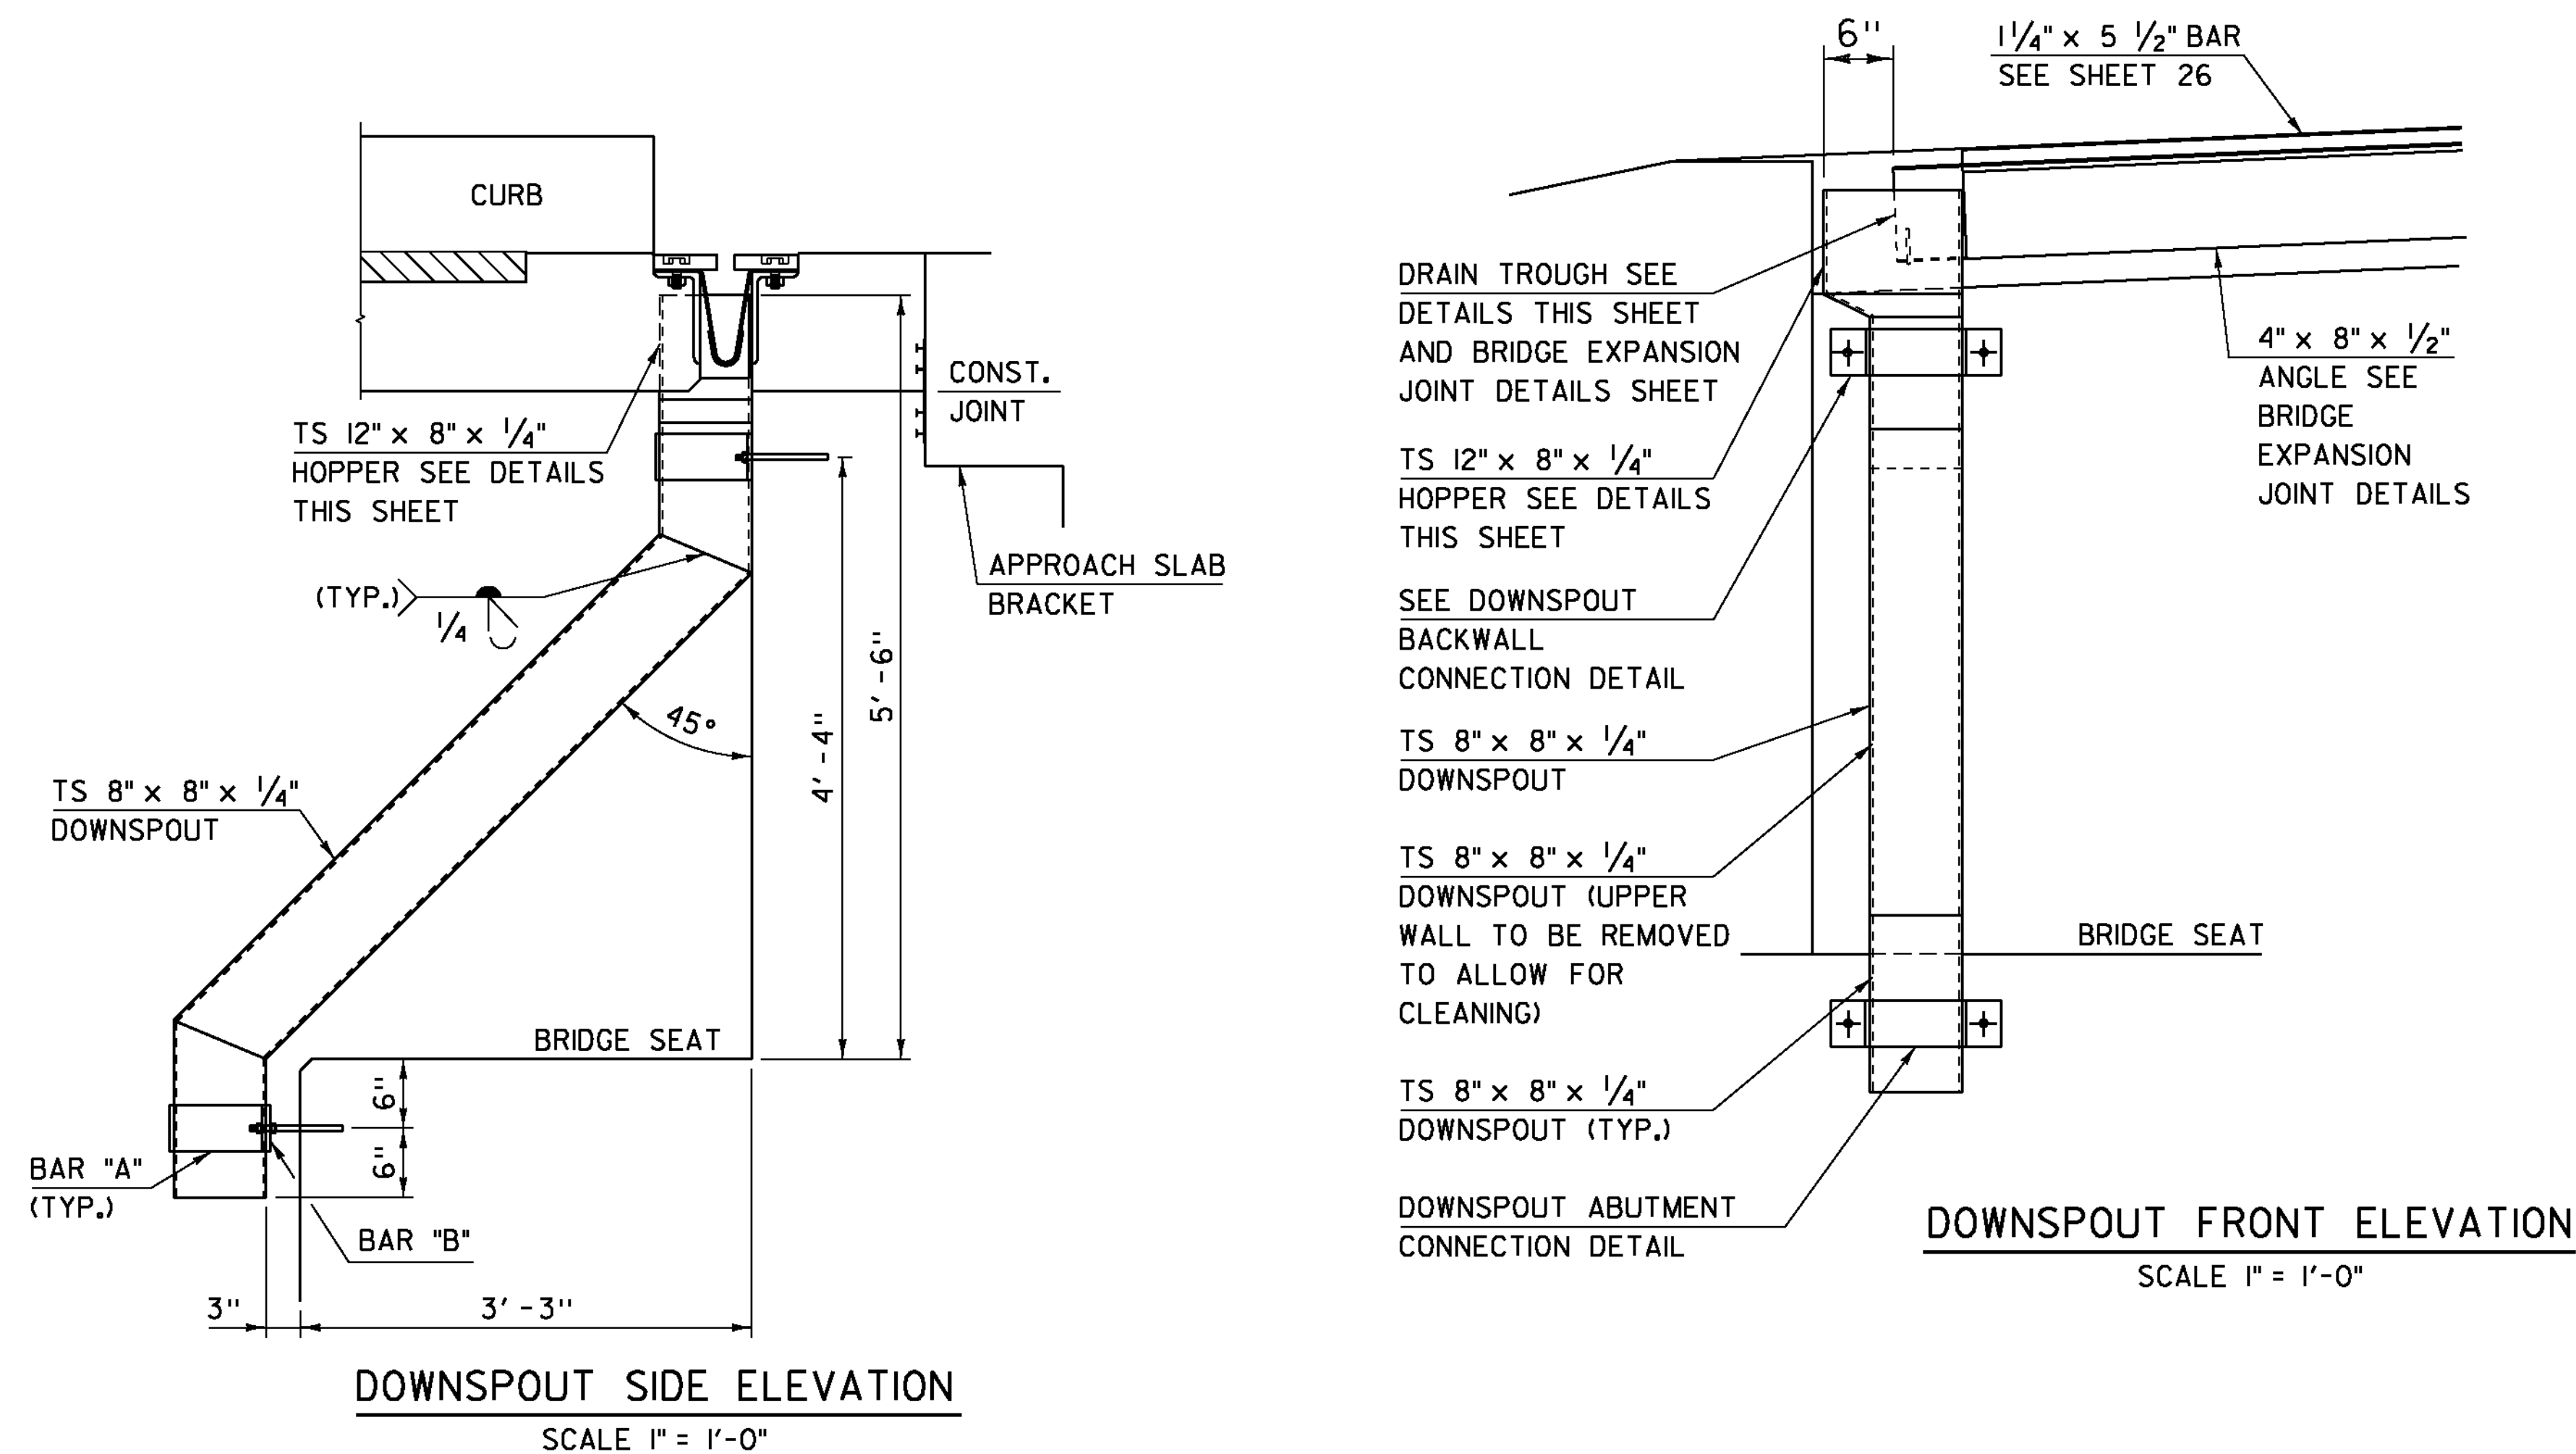


**DOWNSPOUT NOTES**


1. ALL HOLLOW STRUCTURAL STEEL TUBING SHALL CONFORM TO ASTM A-500 GR. B.
2. ALL PLATES, BARS, AND ANGLES SHALL CONFORM TO AASHTO M270M/M270 GR. 36.
3. DOWNSPOUT SHALL BE GALVANIZED IN ACCORDANCE WITH AASHTO M318 /M318 AFTER FABRICATION.
4. ALL BOLTS AND RELATED HARDWARE SHALL BE ASTM A-307 AND SHALL BE GALVANIZED IN ACCORDANCE WITH ASTM A-153 AASHTO M232).
5. ANY PLACE WHERE THE GALVANIZED HAS BEEN REMOVED FROM THE DOWNSPOUT EITHER BY CUTTING, BURNING, WELDING, PLACING, OR ANY OTHER MEANS, IT SHALL BE REPAIRED IN ACCORDANCE WITH SUBSECTION 726.08.
6. THE DOWNSPOUT AND RELATED HARDWARE FOR EACH SHALL BE PAID FOR UNDER THE ITEM 506.55 "STRUCTURAL STEEL, PLATE GIRDER".
7. ALL REQUIRED WELDS FOR DOWNSPOUT SHALL BE DETAILED ON FABRICATION DRAWINGS WHICH SHALL ALSO INCLUDE ALL APPLICABLE WELDING PROCEDURES.
8. AFTER ALL PAVING AND CONCRETE OPERATIONS THE DOWNSPOUT SHALL BE CLEANED OF ALL CONTAMINATION BY FLUSHING.
9. DETAILS SHOWN ARE TYPICAL BOTH SIDES OF BRIDGE AT ABUTMENT #1.

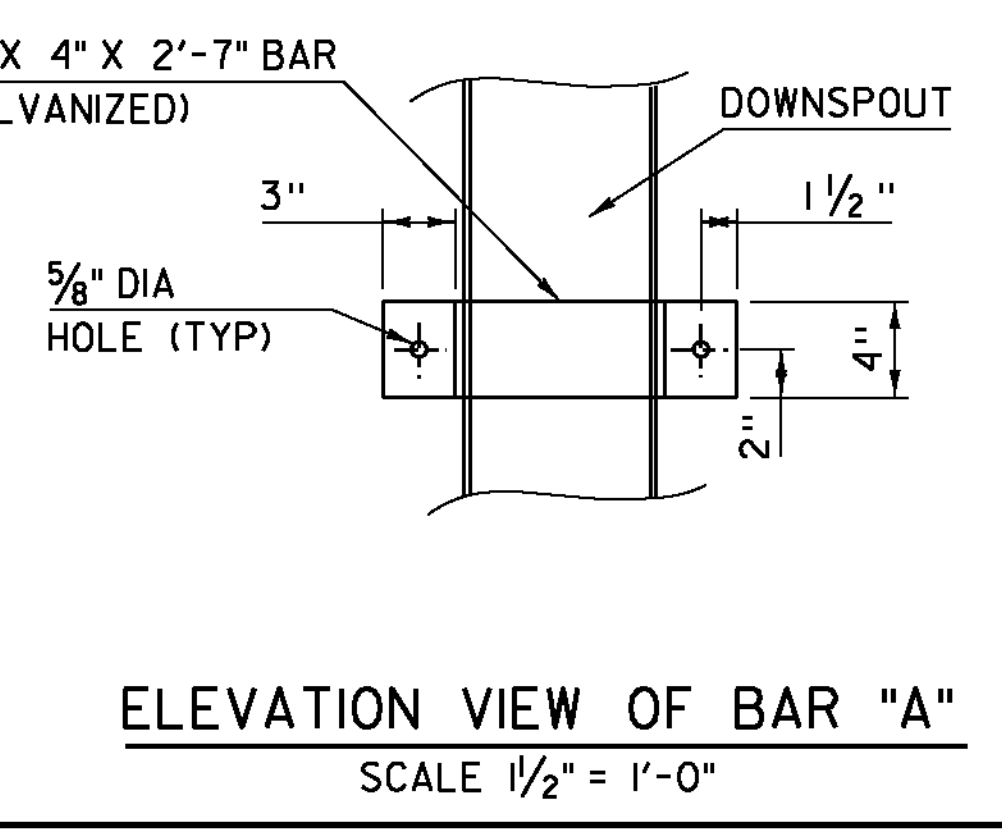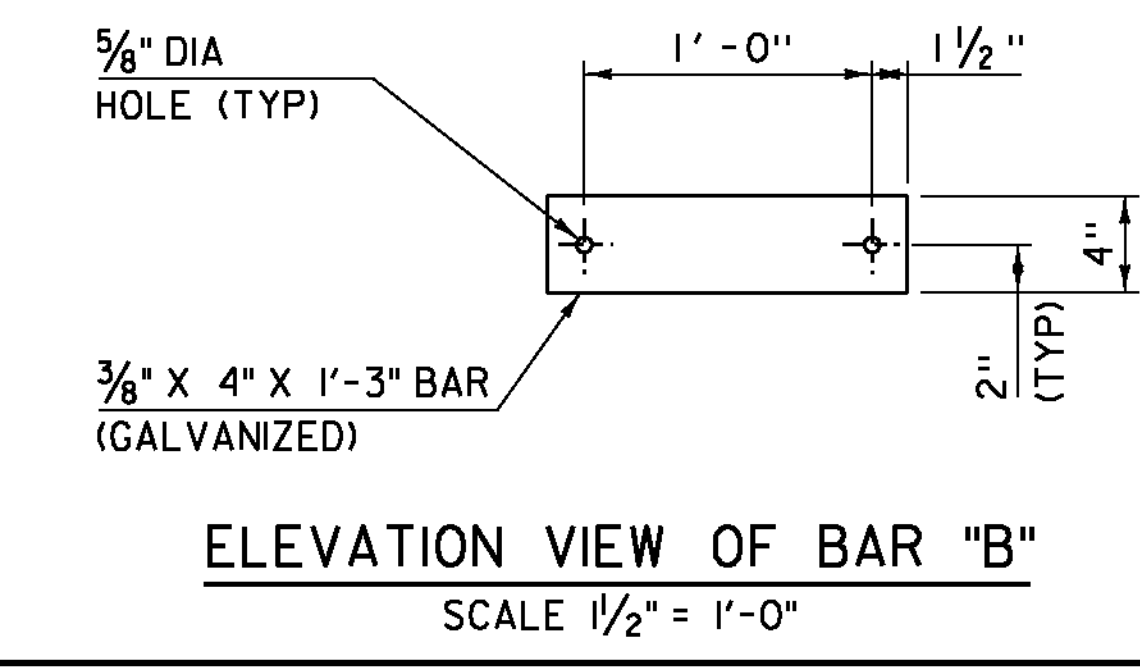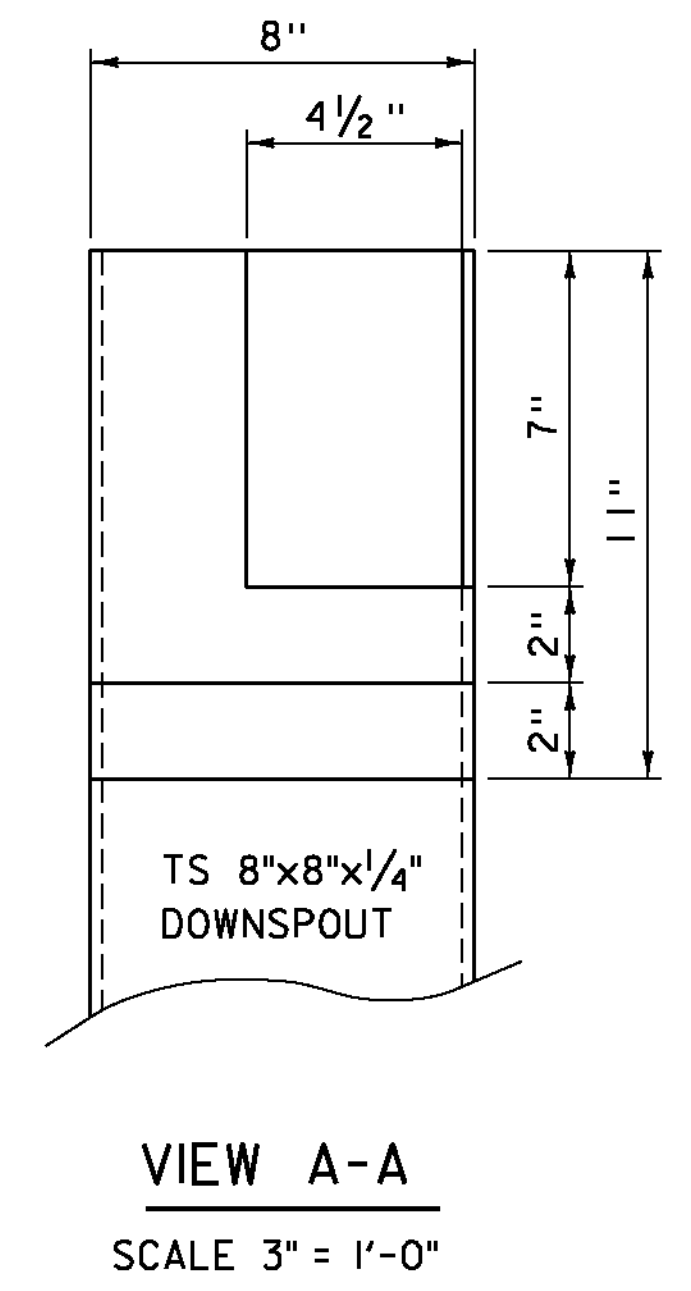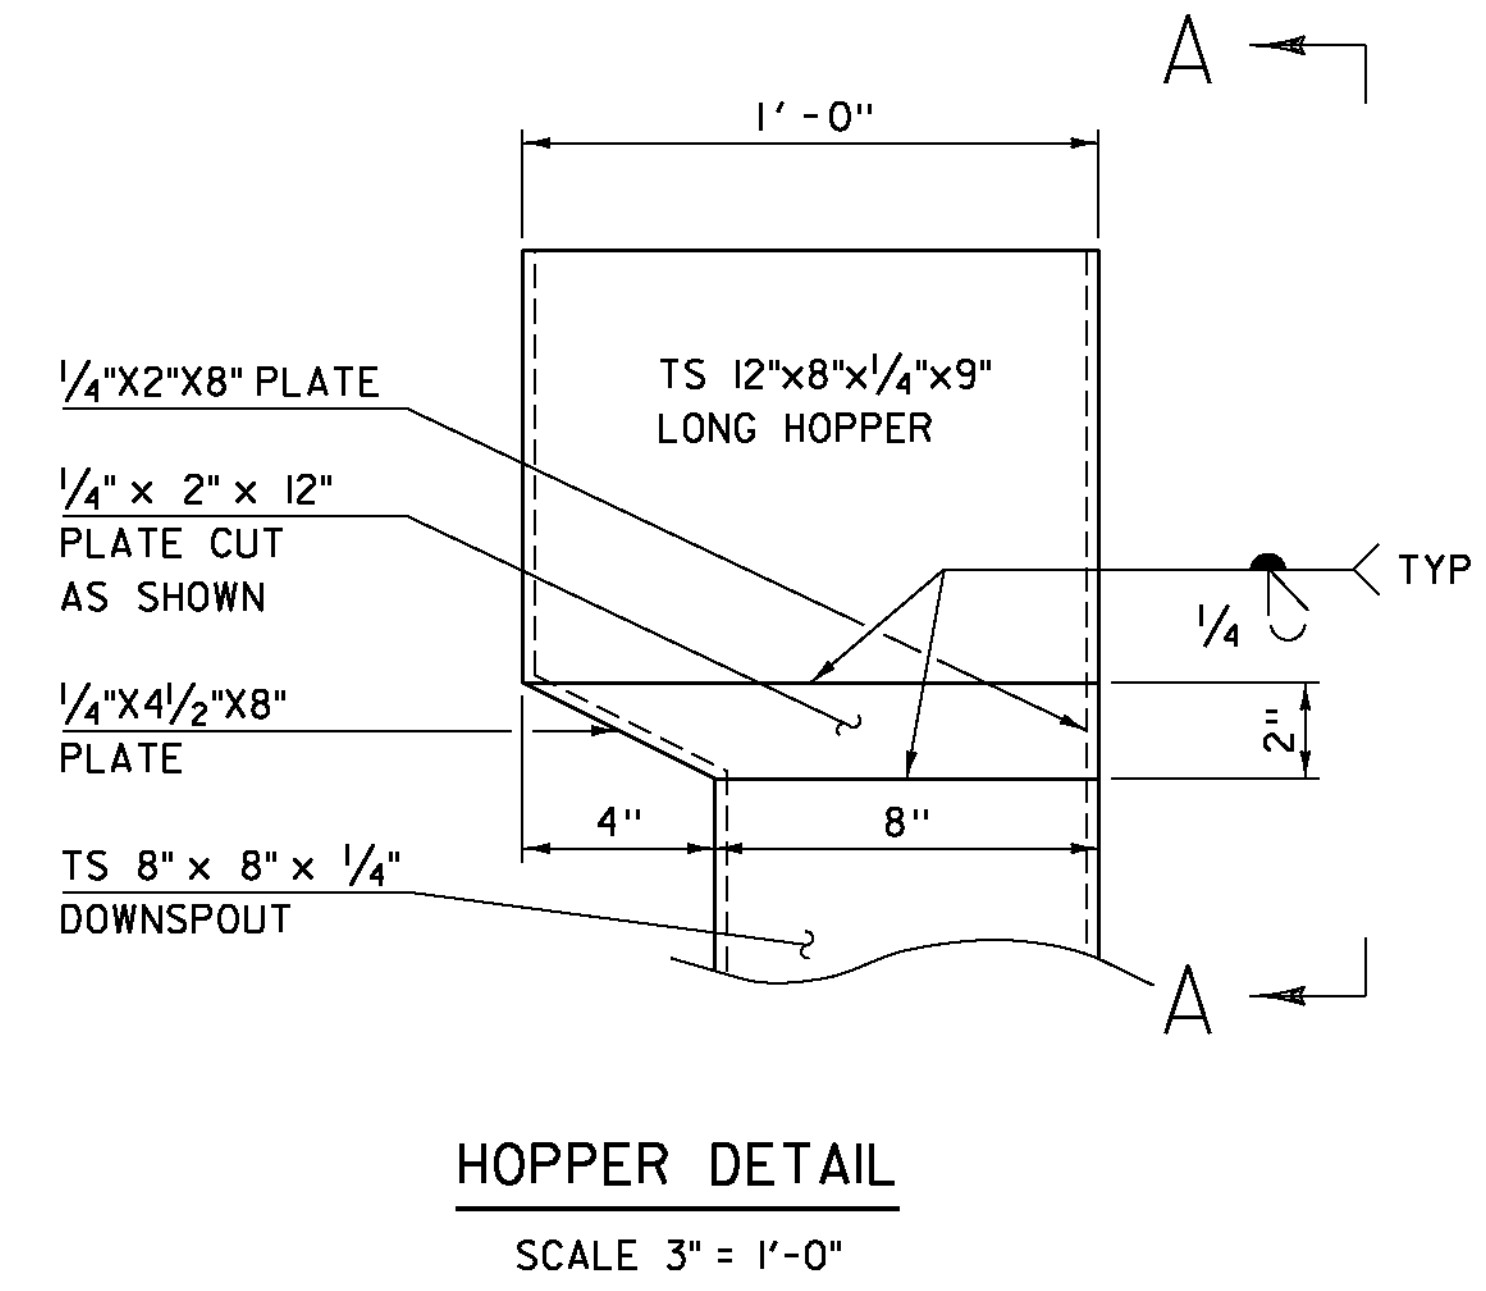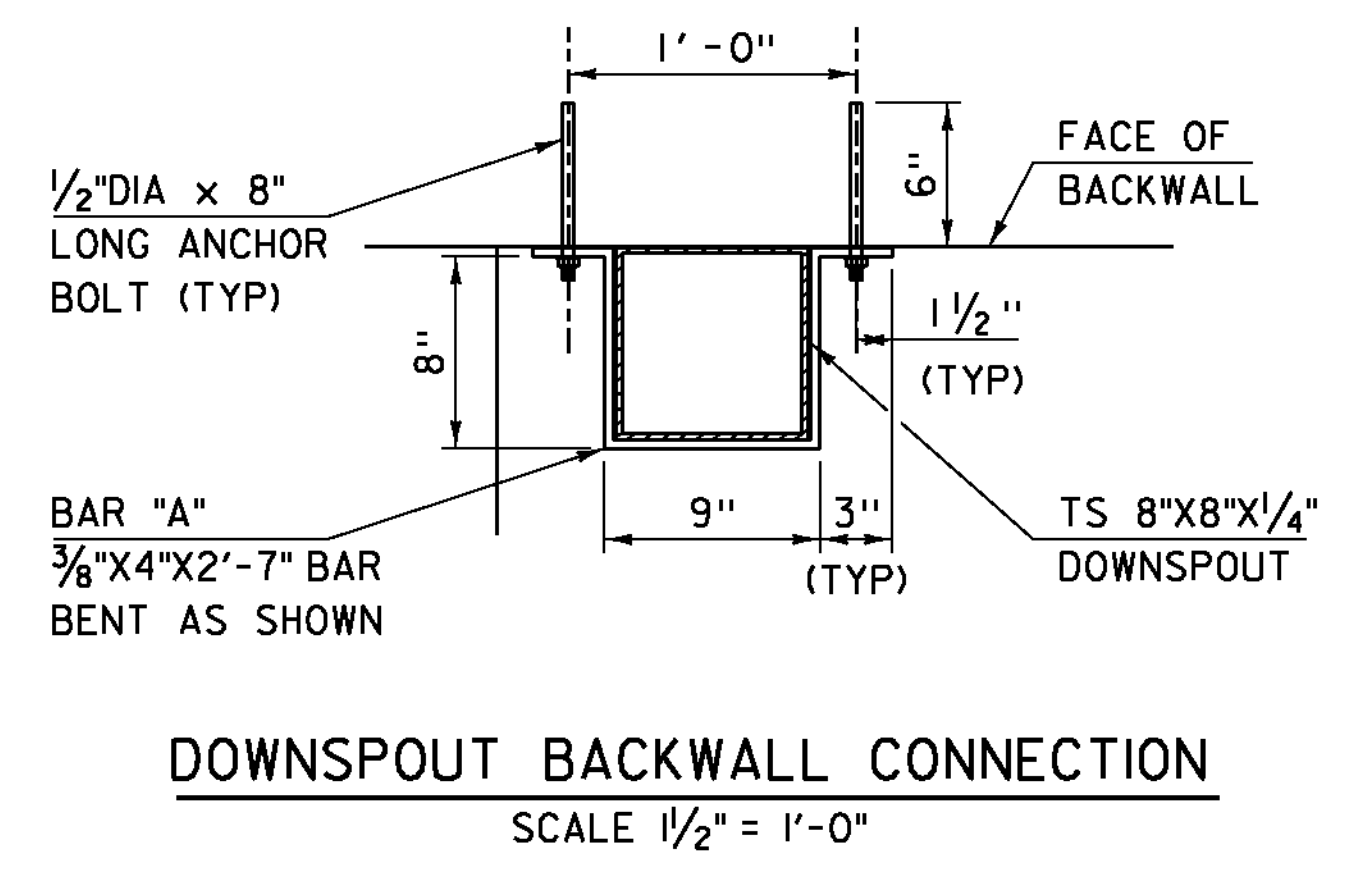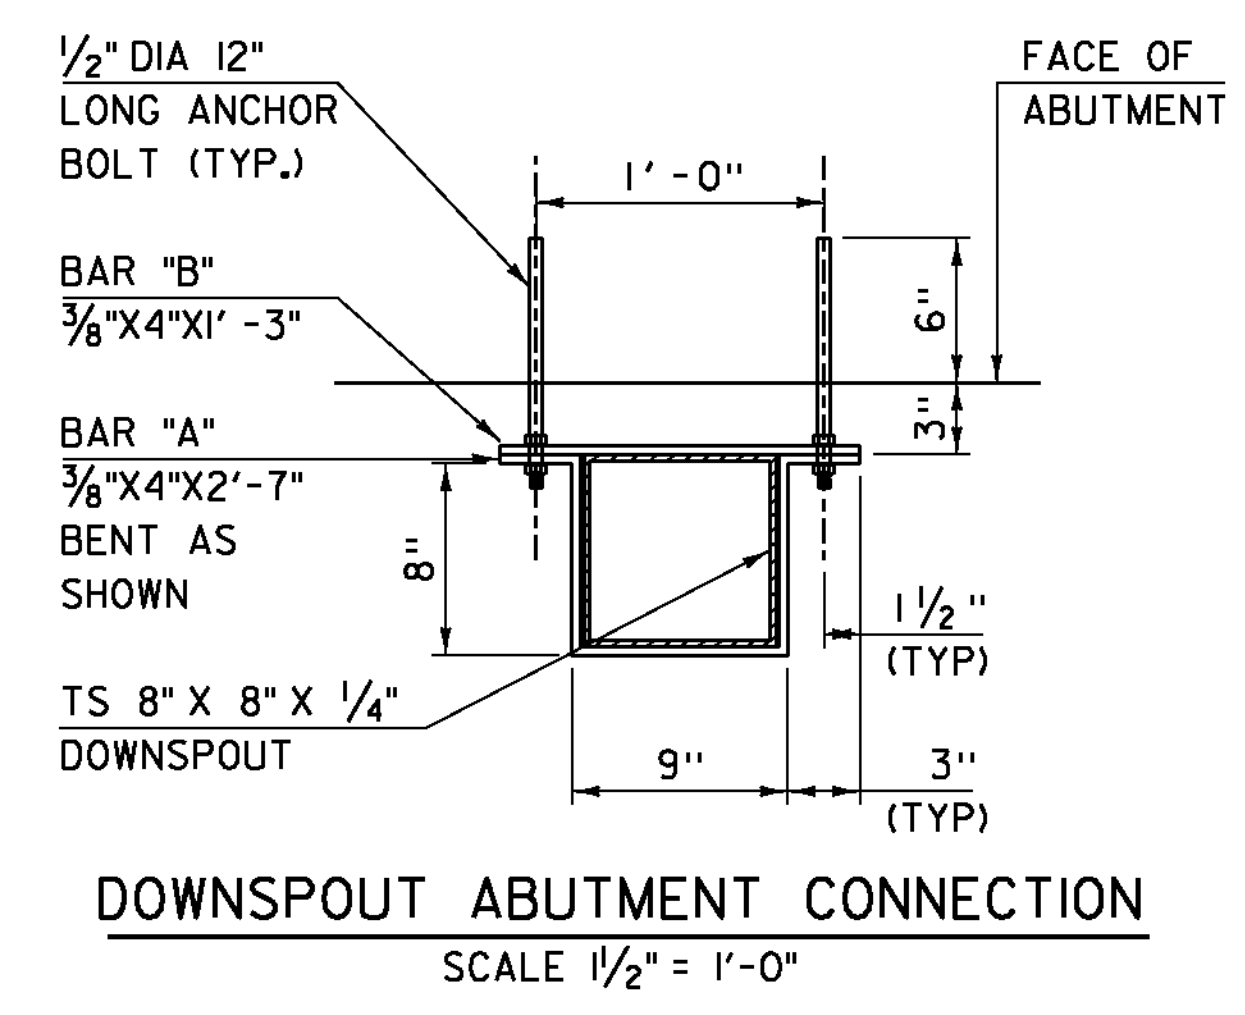


PROJECT NAME: WOODFORD	
PROJECT NUMBER: ER BHF 010-1(44)	
FILE NAME: slb214sup.dgn	PLOT DATE: 23-MAR-2012
PROJECT LEADER: C. CARLSON	DRAWN BY: C. MOONEY
DESIGNED BY: M. EVANS-MONGEON	CHECKED BY: M. EVANS-MONGEON
DOWNSPOUT DETAILS	
SHEET 29 OF 58	

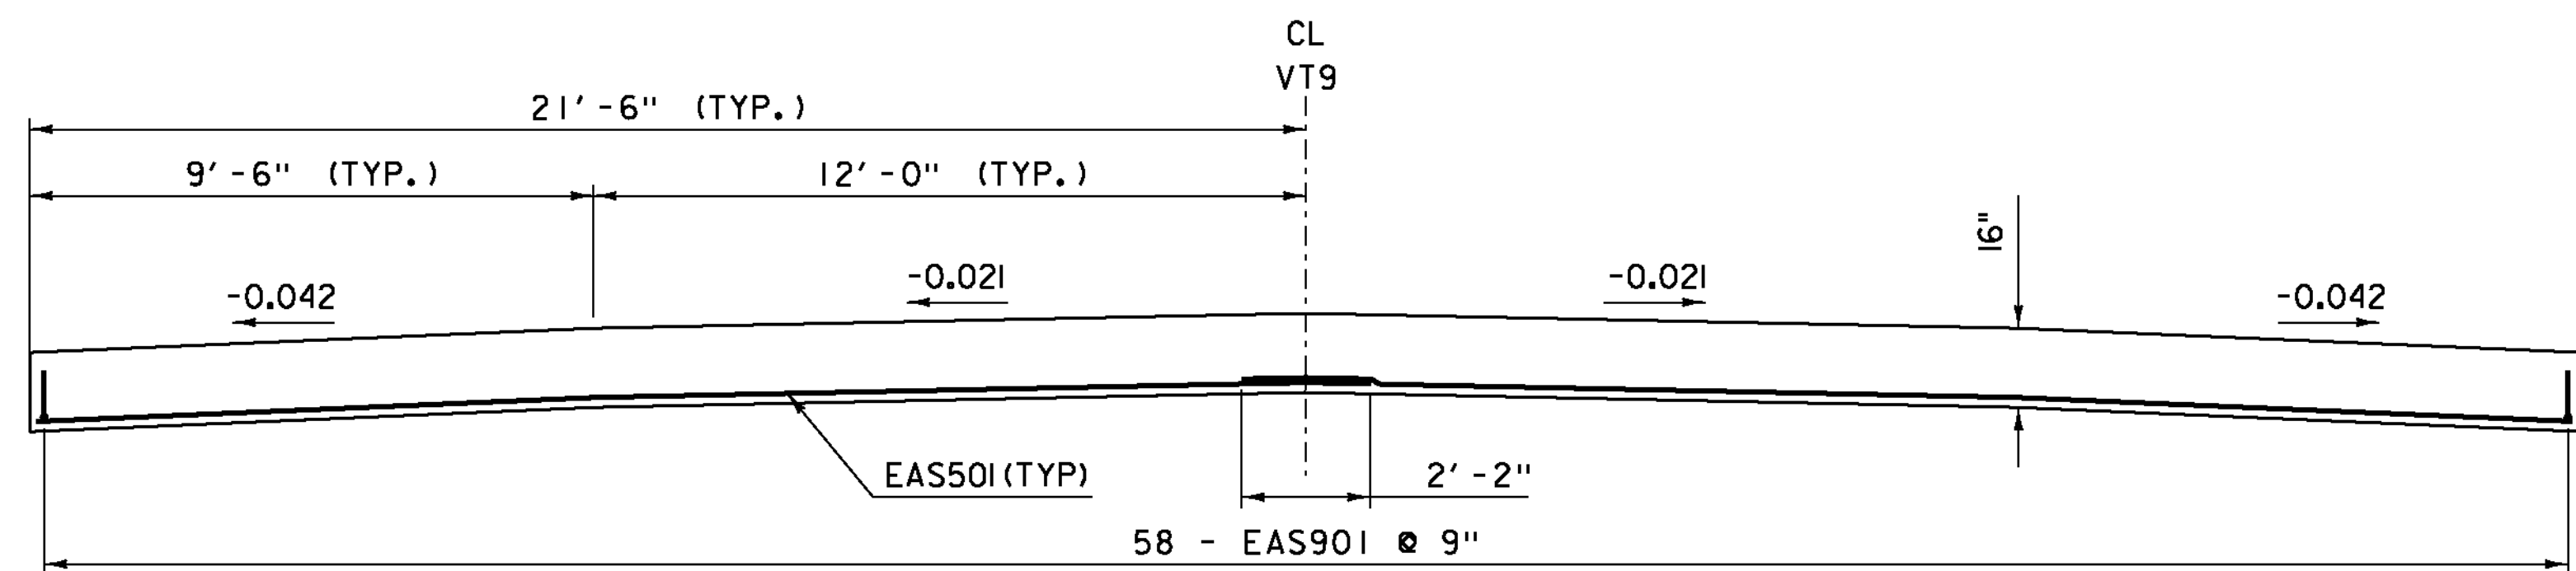


**APPROACH SLAB SECTION**  
SCALE 3/8" = 1'-0"

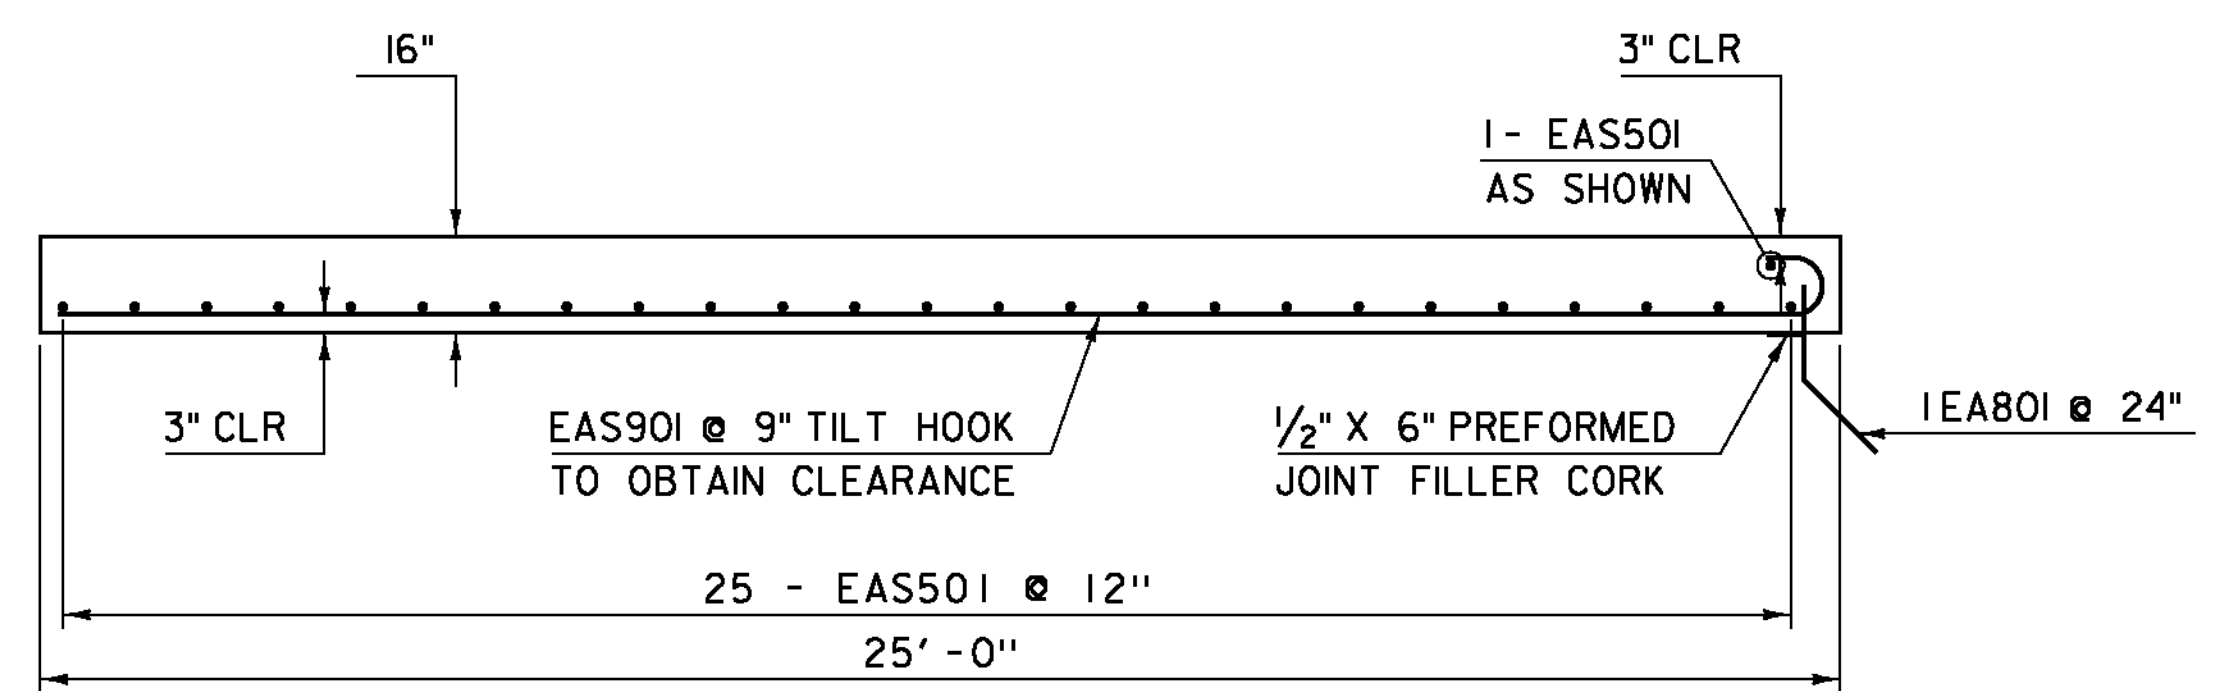

**SECTION A-A**  
SCALE 3/8" = 1'-0"

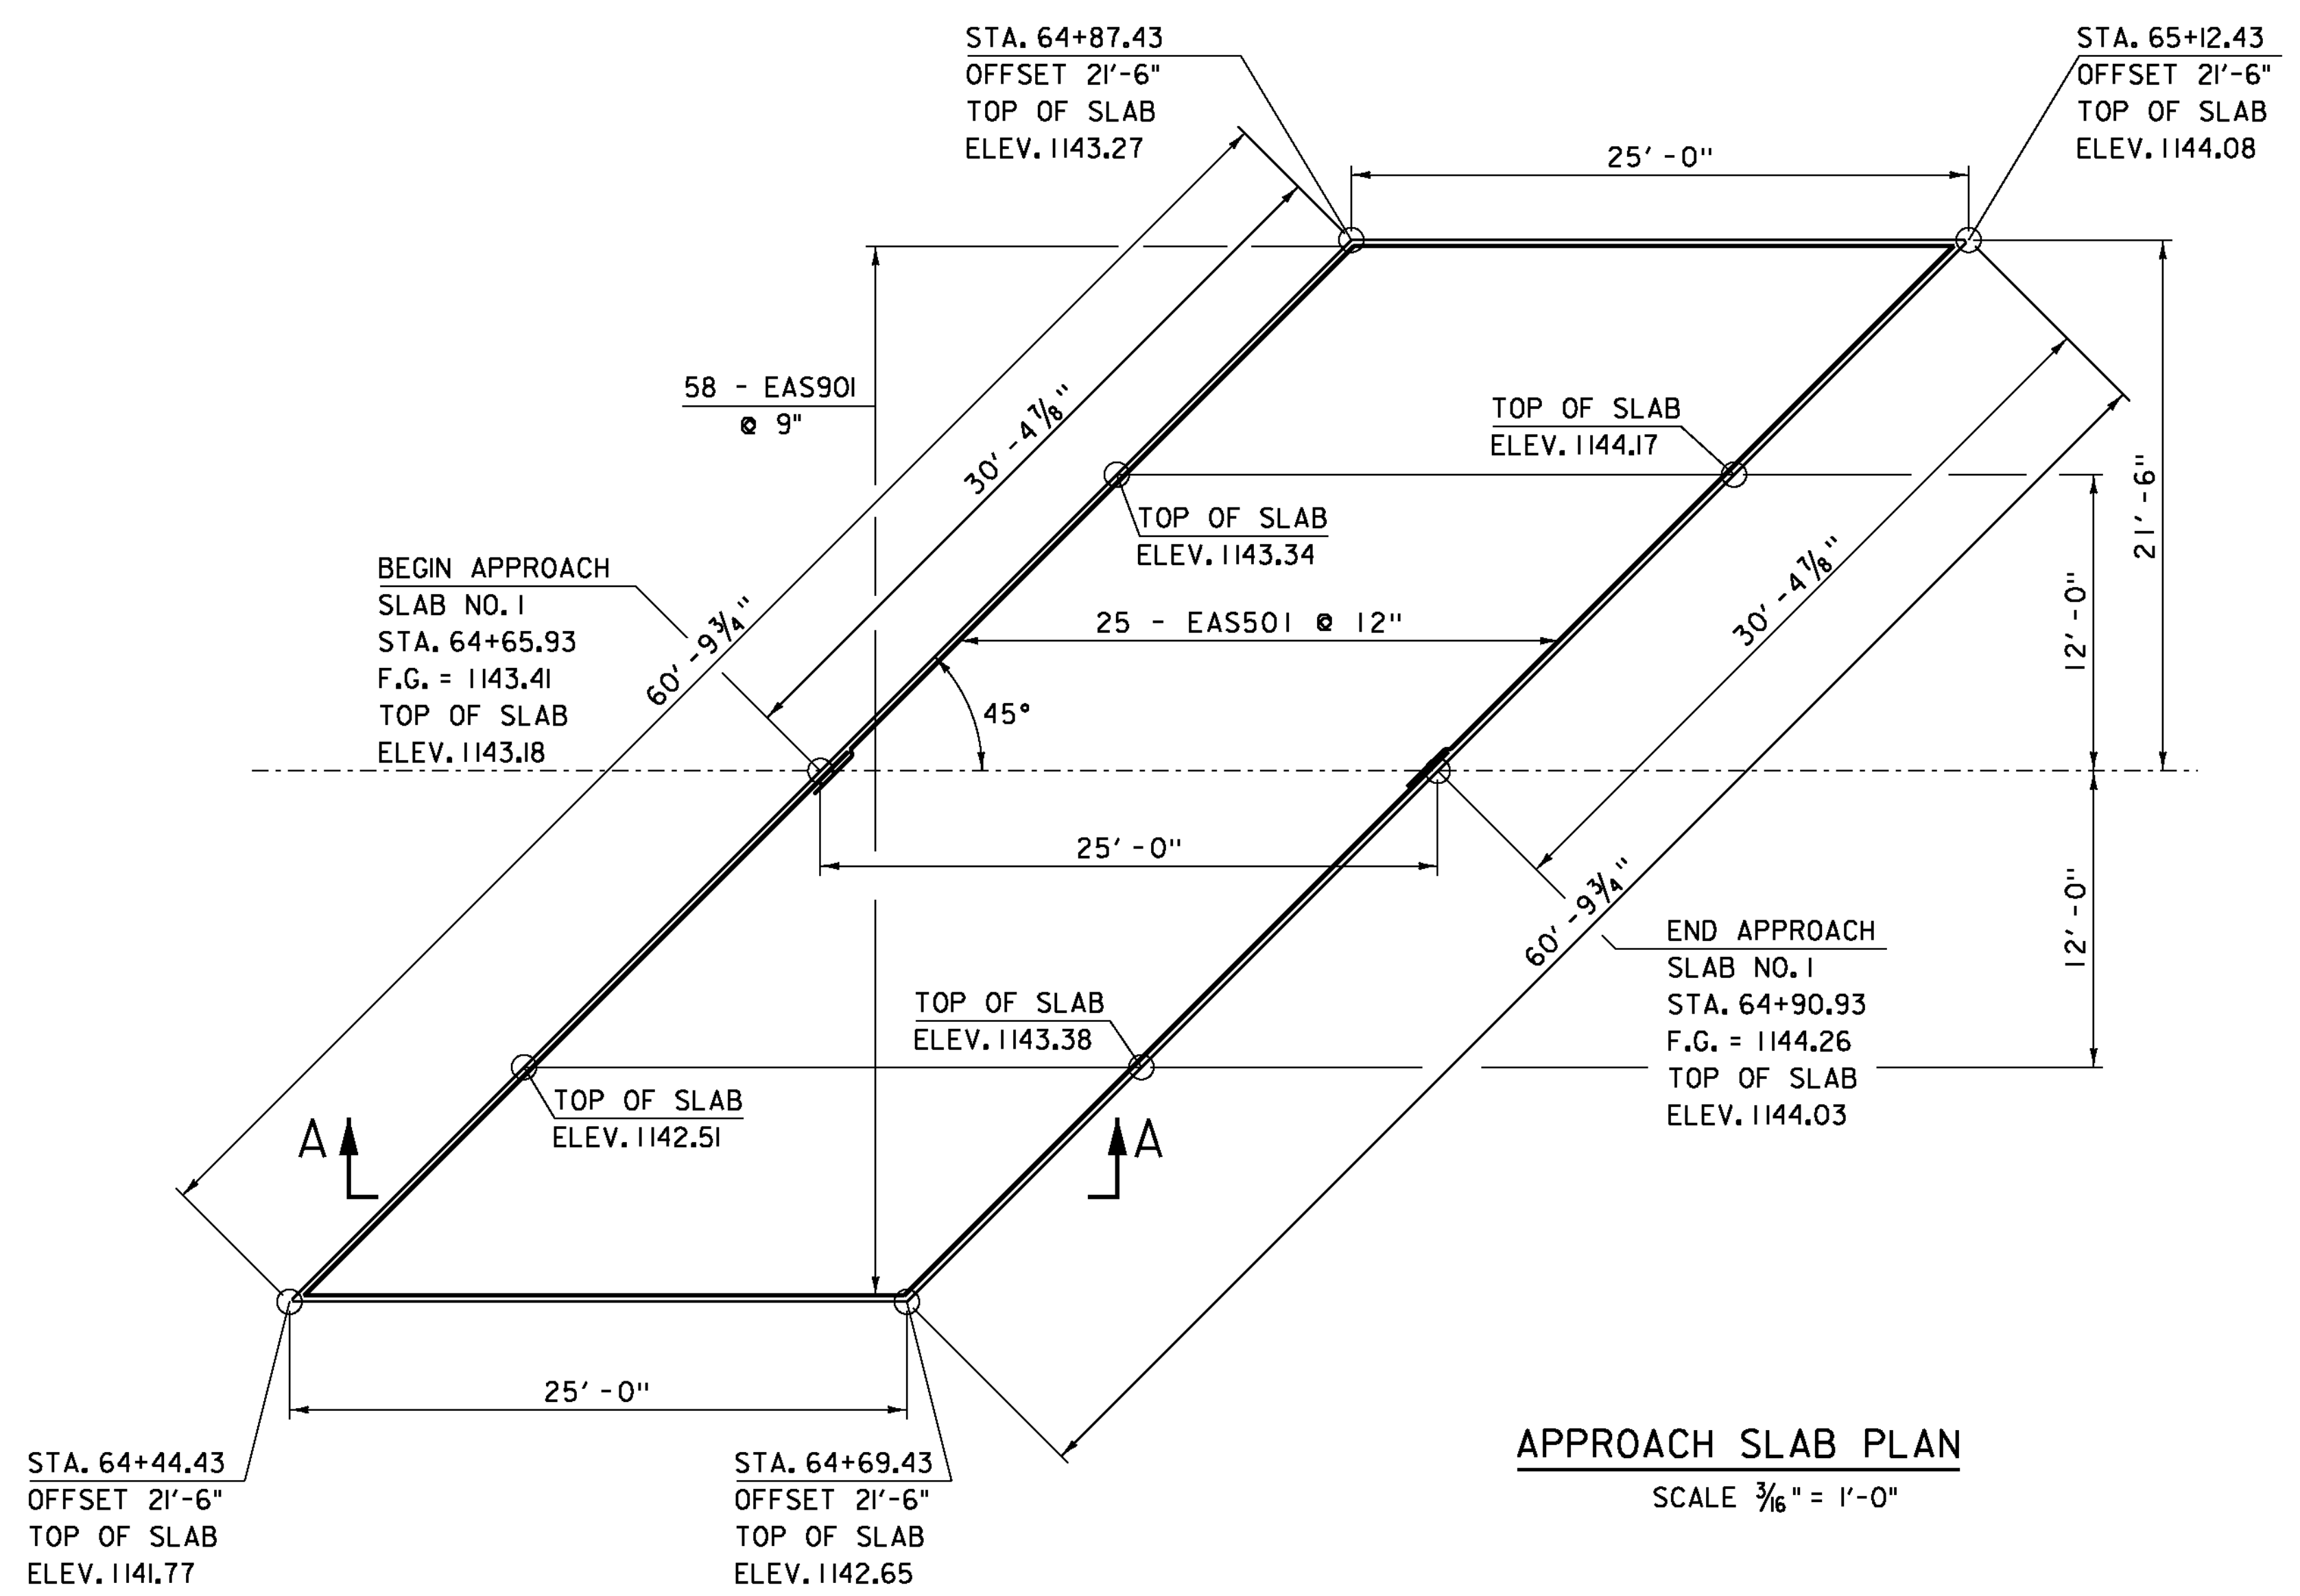


**APPROACH SLAB PLAN**  
SCALE 3/16" = 1'-0"

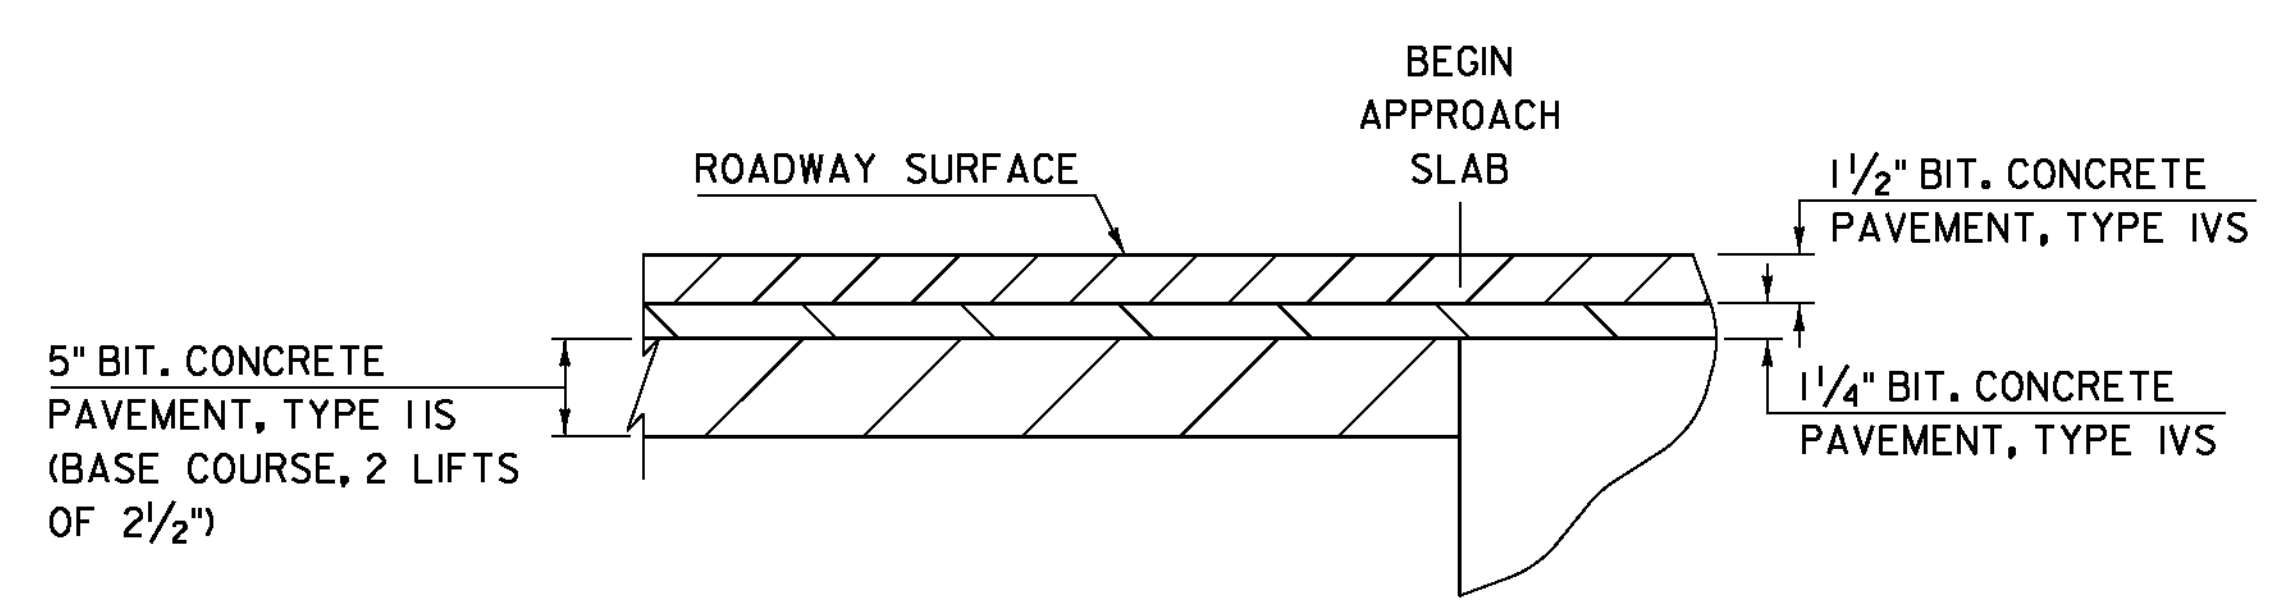

**DETAIL AT APPROACH SLAB END**  
NTS

PROJECT NAME: WOODFORD	
PROJECT NUMBER: ER BHF 010-1(44)	
FILE NAME: slb214sup.dgn	PLOT DATE: 23-MAR-2012
PROJECT LEADER: C. CARLSON	DRAWN BY: C. MOONEY
DESIGNED BY: M. EVANS-MONGEON	CHECKED BY: M. EVANS-MONGEON
APPROACH SLAB DETAILS	SHEET 30 OF 58


RECORD PLANS

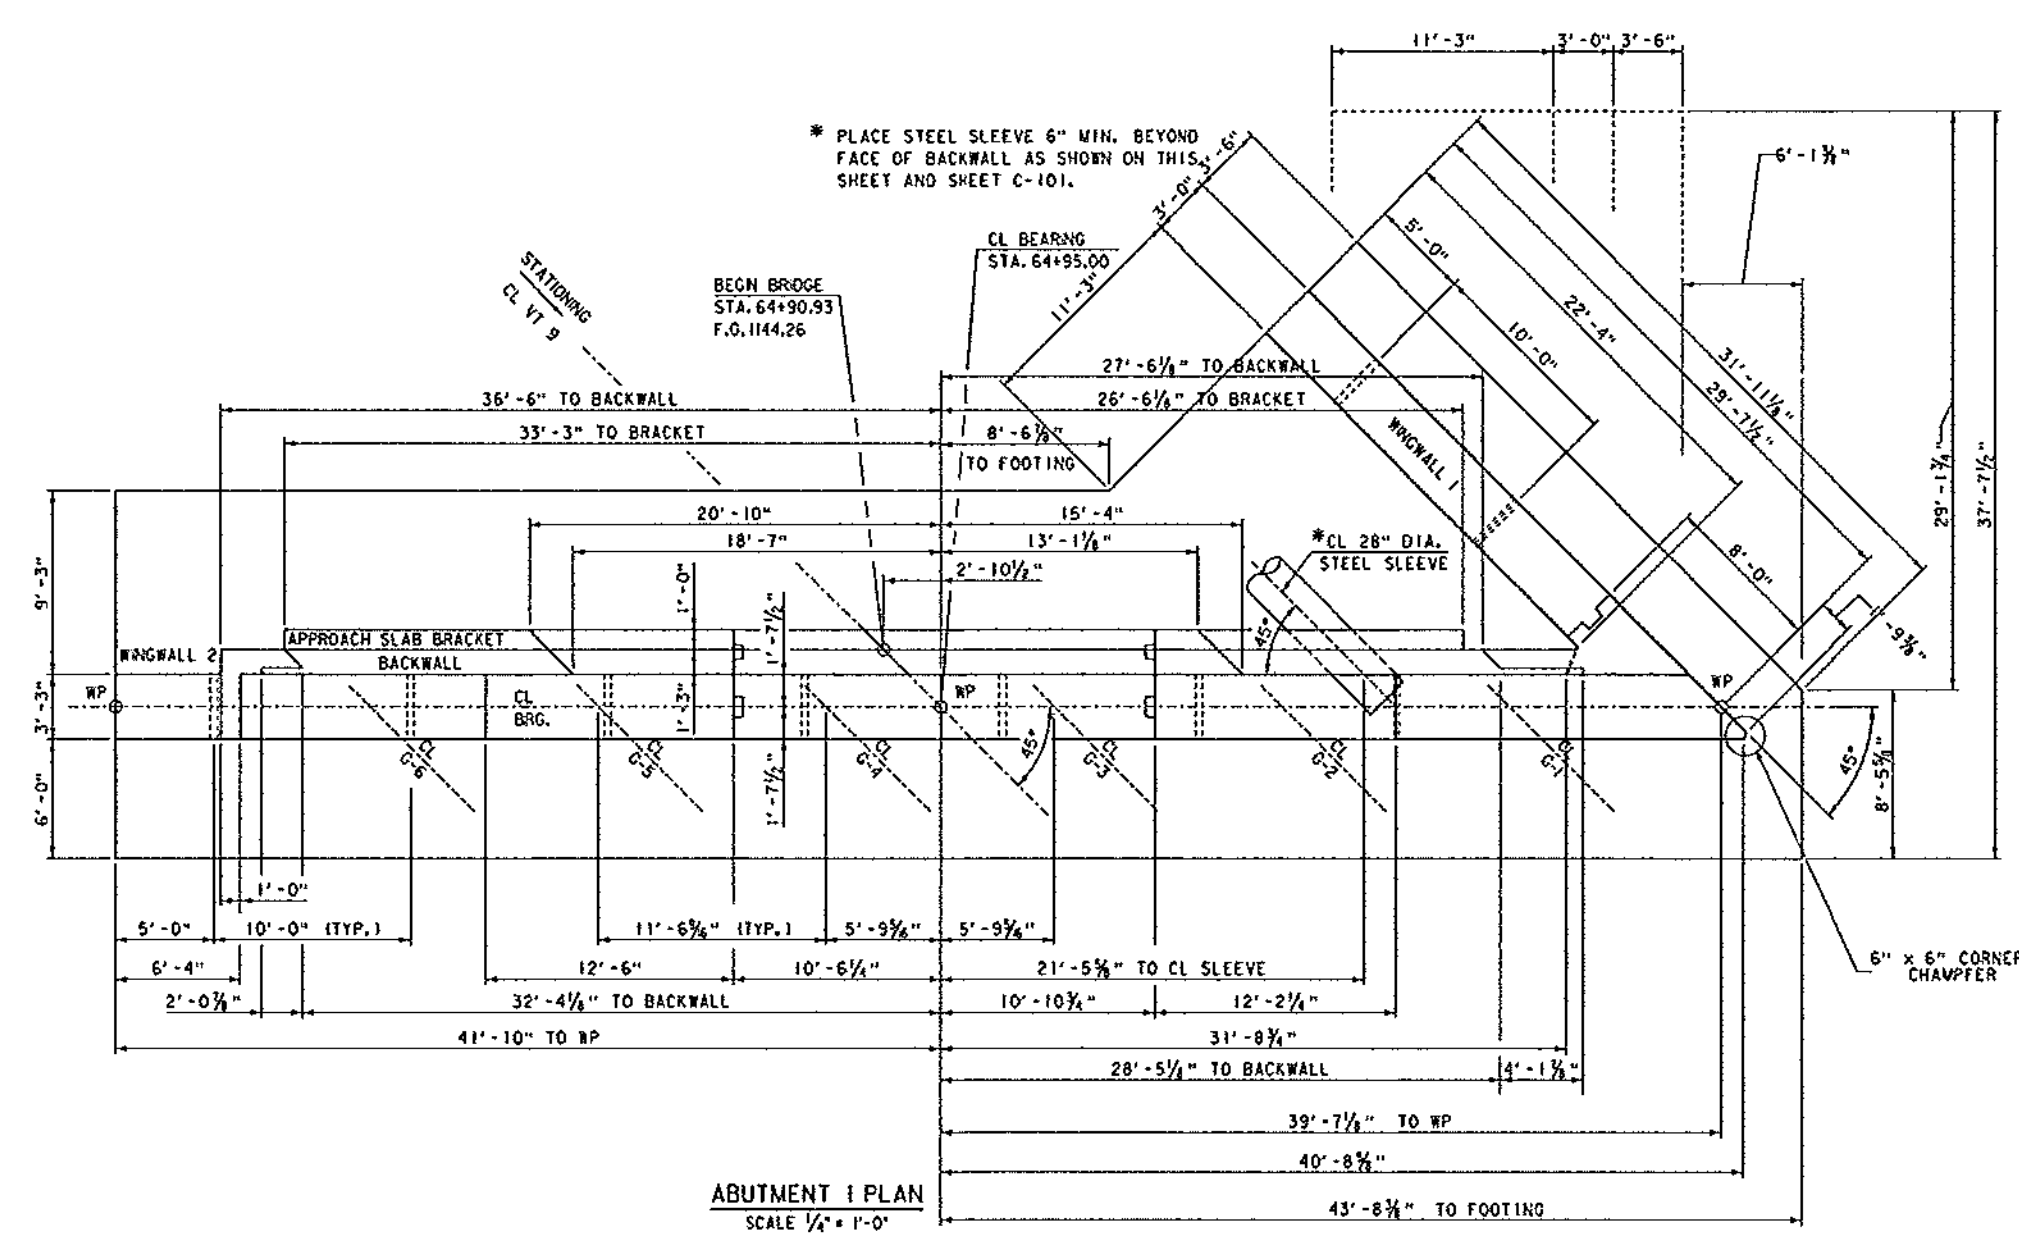

ABUTMENT I PLAN  
SCALE 1/4" = 1'-0"

PROJECT NAME:	
PROJECT NUMBER:	
DATE:	10-SEP-2002
PROJECT LEADER:	DRYAN BY:
DESIGNED BY:	CHECKED BY:
	SHEET 31 OF 58

RECORD PLANS

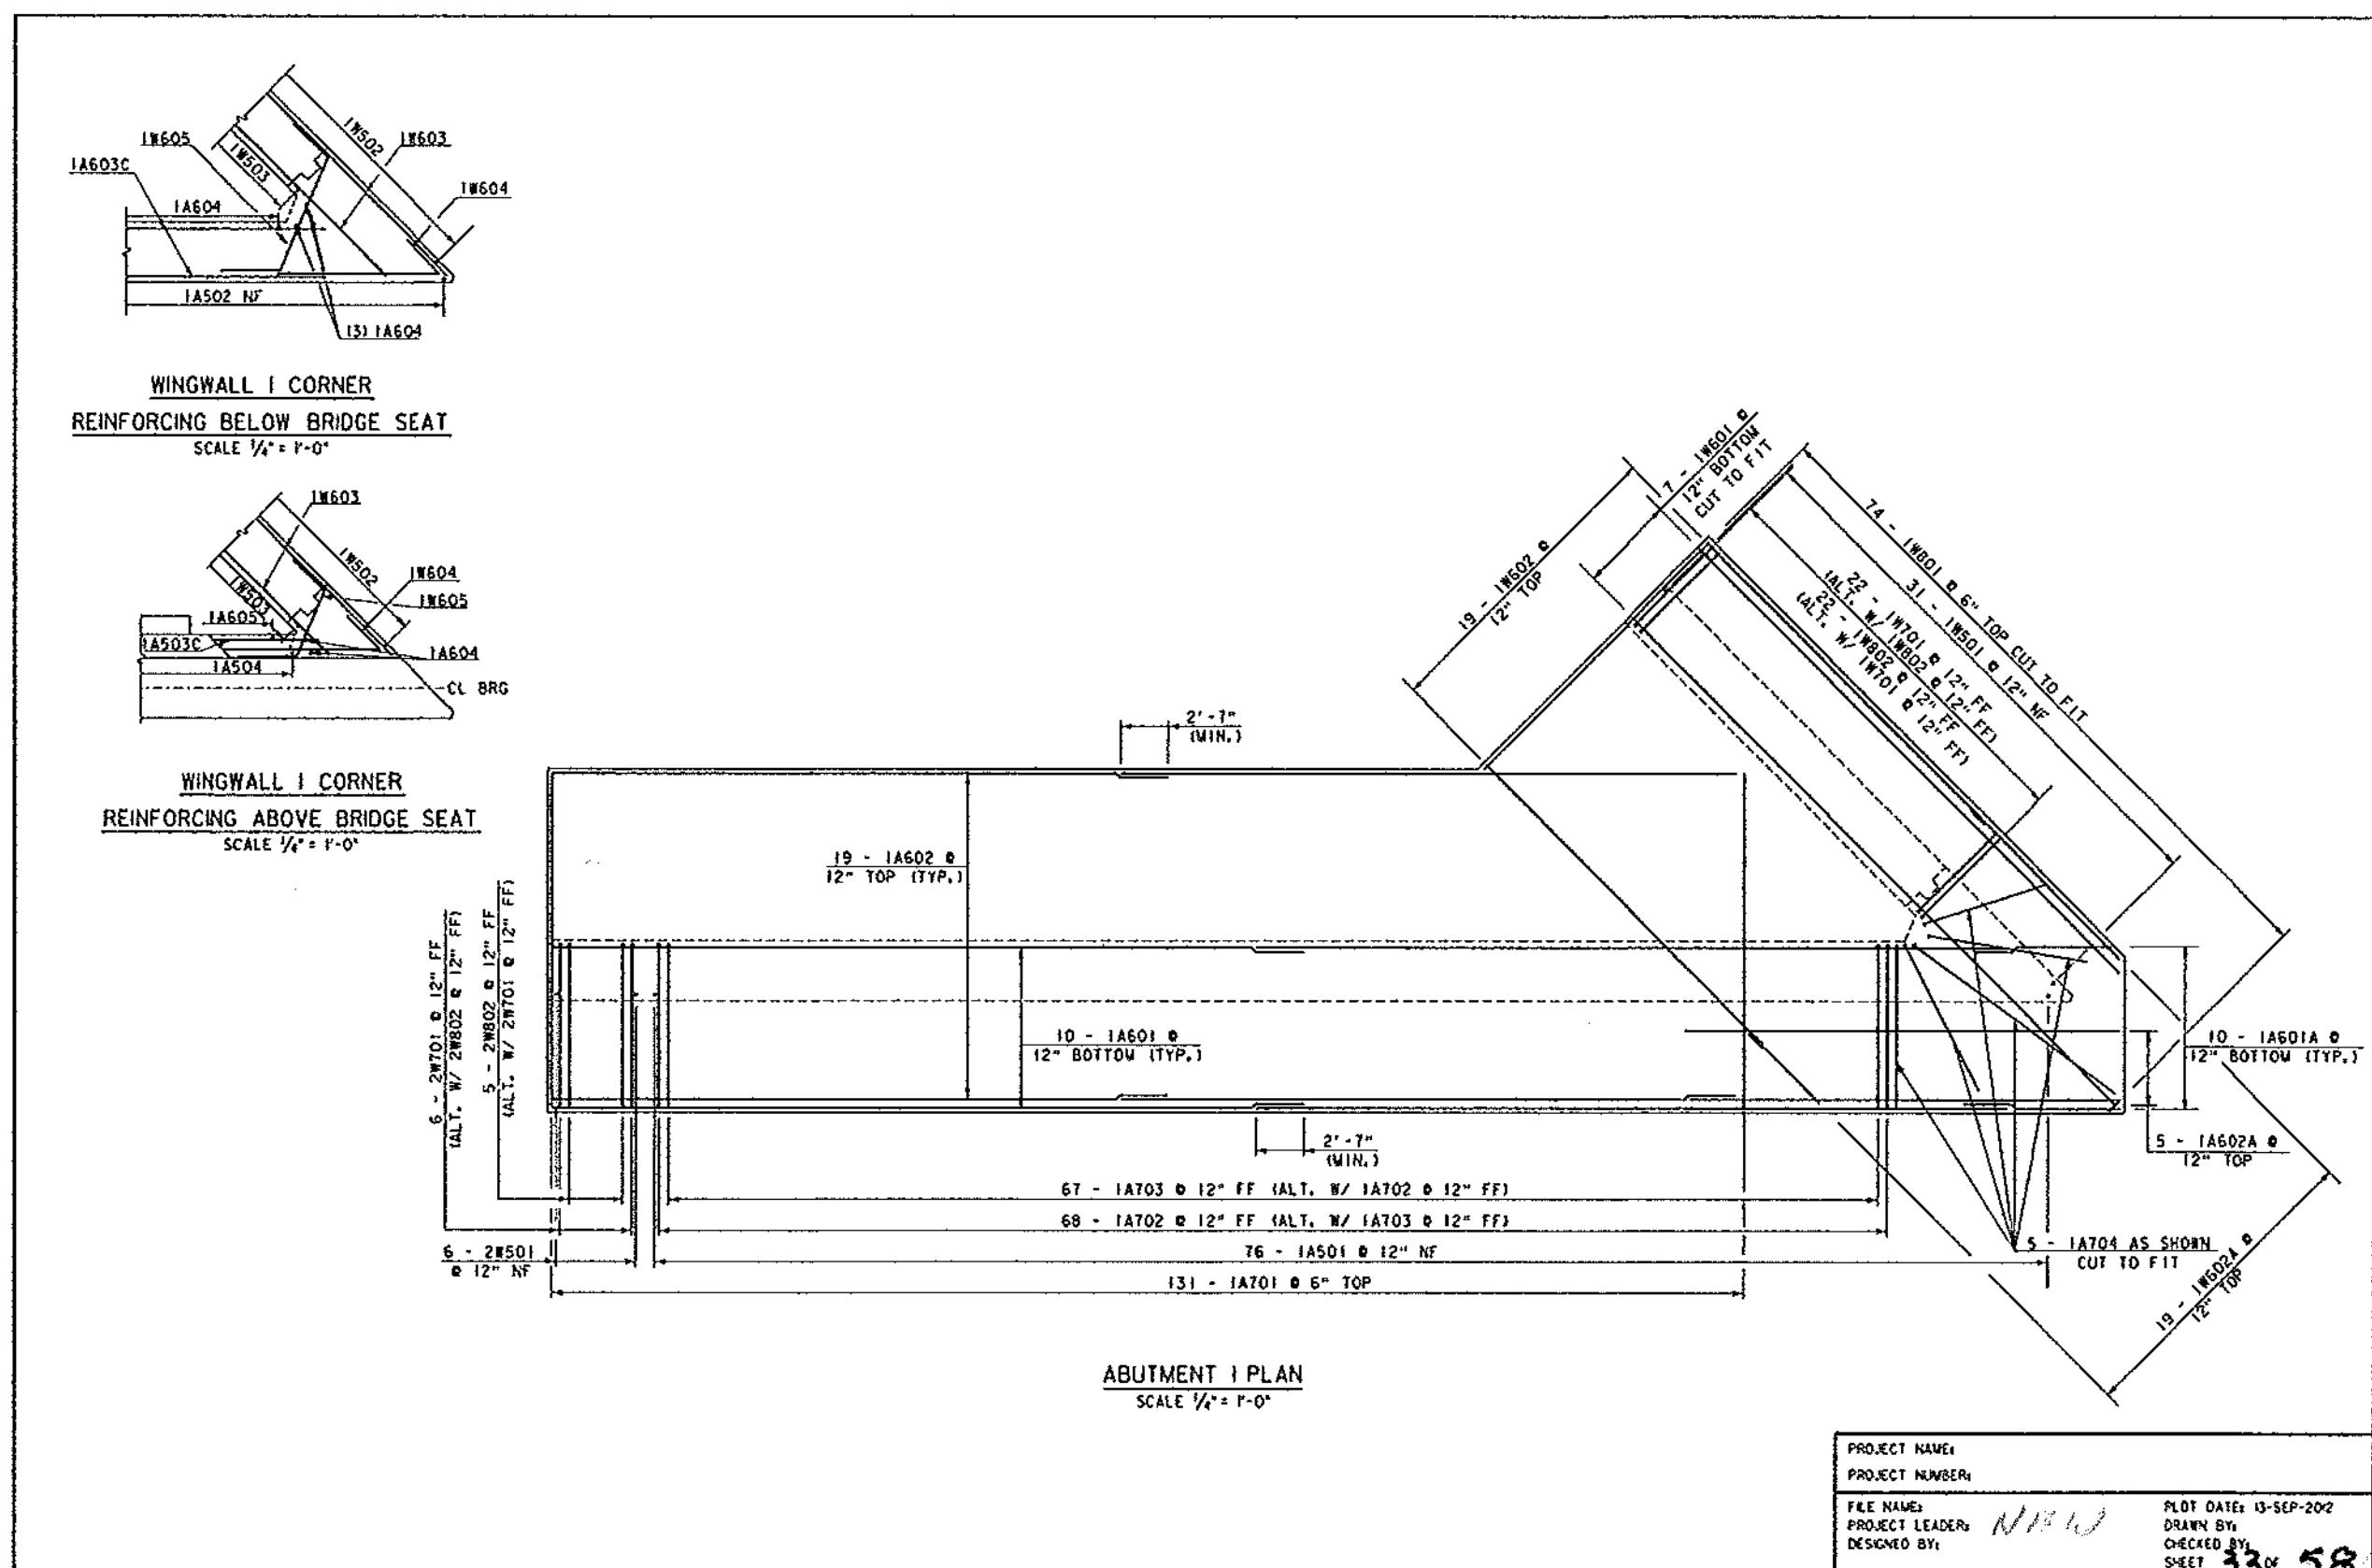


# RECORD PLANS

## STATE OF VERMONT AGENCY OF TRANSPORTATION REINFORCING STEEL SCHEDULE

NO.	QTY	DESCRIPTION	UNIT	QTY	NO.	QTY	DESCRIPTION	UNIT	QTY	NO.	QTY	DESCRIPTION	UNIT	QTY	NO.	QTY	DESCRIPTION	UNIT	QTY	NO.	QTY	DESCRIPTION	UNIT	QTY
1	1	A 11	10.0	1	1	1	A 11	10.0	1	1	1	A 11	10.0	1	1	1	A 11	10.0	1	1	1	1	1	
2	1	A 12	10.0	1	1	1	A 12	10.0	1	1	1	A 12	10.0	1	1	1	A 12	10.0	1	1	1	1	1	
3	1	A 13	10.0	1	1	1	A 13	10.0	1	1	1	A 13	10.0	1	1	1	A 13	10.0	1	1	1	1	1	
40	1	A 50	10.0	1	1	1	A 50	10.0	1	1	1	A 50	10.0	1	1	1	A 50	10.0	1	1	1	1	1	


- NOTES
1. UNLESS OTHERWISE SPECIFIED, ALL BAR REINFORCEMENT FOR CONCRETE IN SIZES UP TO AND INCLUDING 10 IS SHALL CONFORM TO THE REQUIREMENTS OF THE SPECIFICATIONS FOR STEEL BARS FOR CONCRETE REINFORCEMENT, ASTM A618 (ASTM A618) ALL BARS SHALL BE GRADE 60 UNLESS OTHERWISE SPECIFIED.
  2. FOR TYPICAL BENDS OF BARS, RECOMMENDED PRACTICES OF BARS AND HOOPS, AND OTHER STANDARD PRACTICES, SEE CURRENT CONCRETE REINFORCEMENT, EDITION "MINIMUM OF STANDARD PRACTICES".
  3. BARS WHICH REQUIRE MORE ACCURATE BENDS THAN STANDARD PRACTICES SHOULD HAVE LATHS INDICATED.
  4. ALL DIMENSIONS ARE CUT TO OUT OF BAR EXCEPT "X" AND "Y" ON STANDAID IN DEGREE AND 180 DEGREE HOOPS.
  5. "Z" DIMENSIONS ON 180 DEGREE HOOPS TO BE SHOWN ONLY WHERE NECESSARY TO RESTRICT HOOK SIZE, OTHERWISE, STANDARD HOOPS ARE TO BE USED.
  6. "Y" DIMENSIONS ON OTHERS TO BE SHOWN ONLY WHEN NECESSARY TO SHOW CLEARANCES.
  7. WHERE BARS ARE SHOWN IN DEGREE, DIMENSIONS "X" AND "Y" MUST BE SHOWN.
  8. Δ DENOTES BARS TO BE CUT AT FIELD.
  9. # DENOTES ONE EXTRA BAR ADDED FOR TESTING PURPOSES.
  10. △ DENOTES TWO EXTRA BARS ADDED FOR TESTING PURPOSES.
  11. # IN BARS WHICH DENOTES EPOXY COATED REINFORCING STEEL.

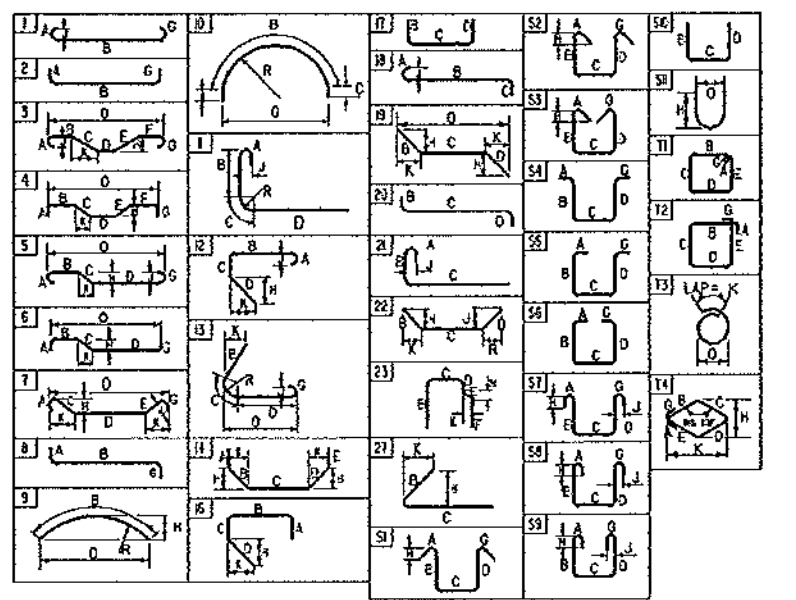

ASTM STANDARD REINFORCING BARS


BAR SIZE	TENSILE STRENGTH (MIN.)	YIELD POINT (MIN.)	ELONGATION (MIN.)
#3	0.376	0.376	0.11
#4	0.668	0.600	0.20
#5	1.043	0.625	0.31
#6	1.602	0.760	0.44
#7	2.044	0.876	0.60
#8	2.670	1.000	0.79
#9	3.400	1.178	1.00
#10	4.300	1.260	1.27
#11	5.310	1.400	1.68
#12	6.430	1.600	2.12
#14	8.700	2.000	2.76
#16	11.200	2.500	3.54
#18	13.900	3.100	4.50

PROJECT NAME: WOODFORD  
PROJECT NUMBER: ER BHF 010-1(44)  
FILE UNDER: WOODFORD  
DESIGNED BY: M. STANLEY  
CHECKED BY: M. STANLEY  
DATE: 11/11/00  
DRAWN BY: J. B. STANLEY  
CHECKED BY: M. STANLEY  
REINFORCING STEEL SCHEDULE  
SHEET 05 OF 08

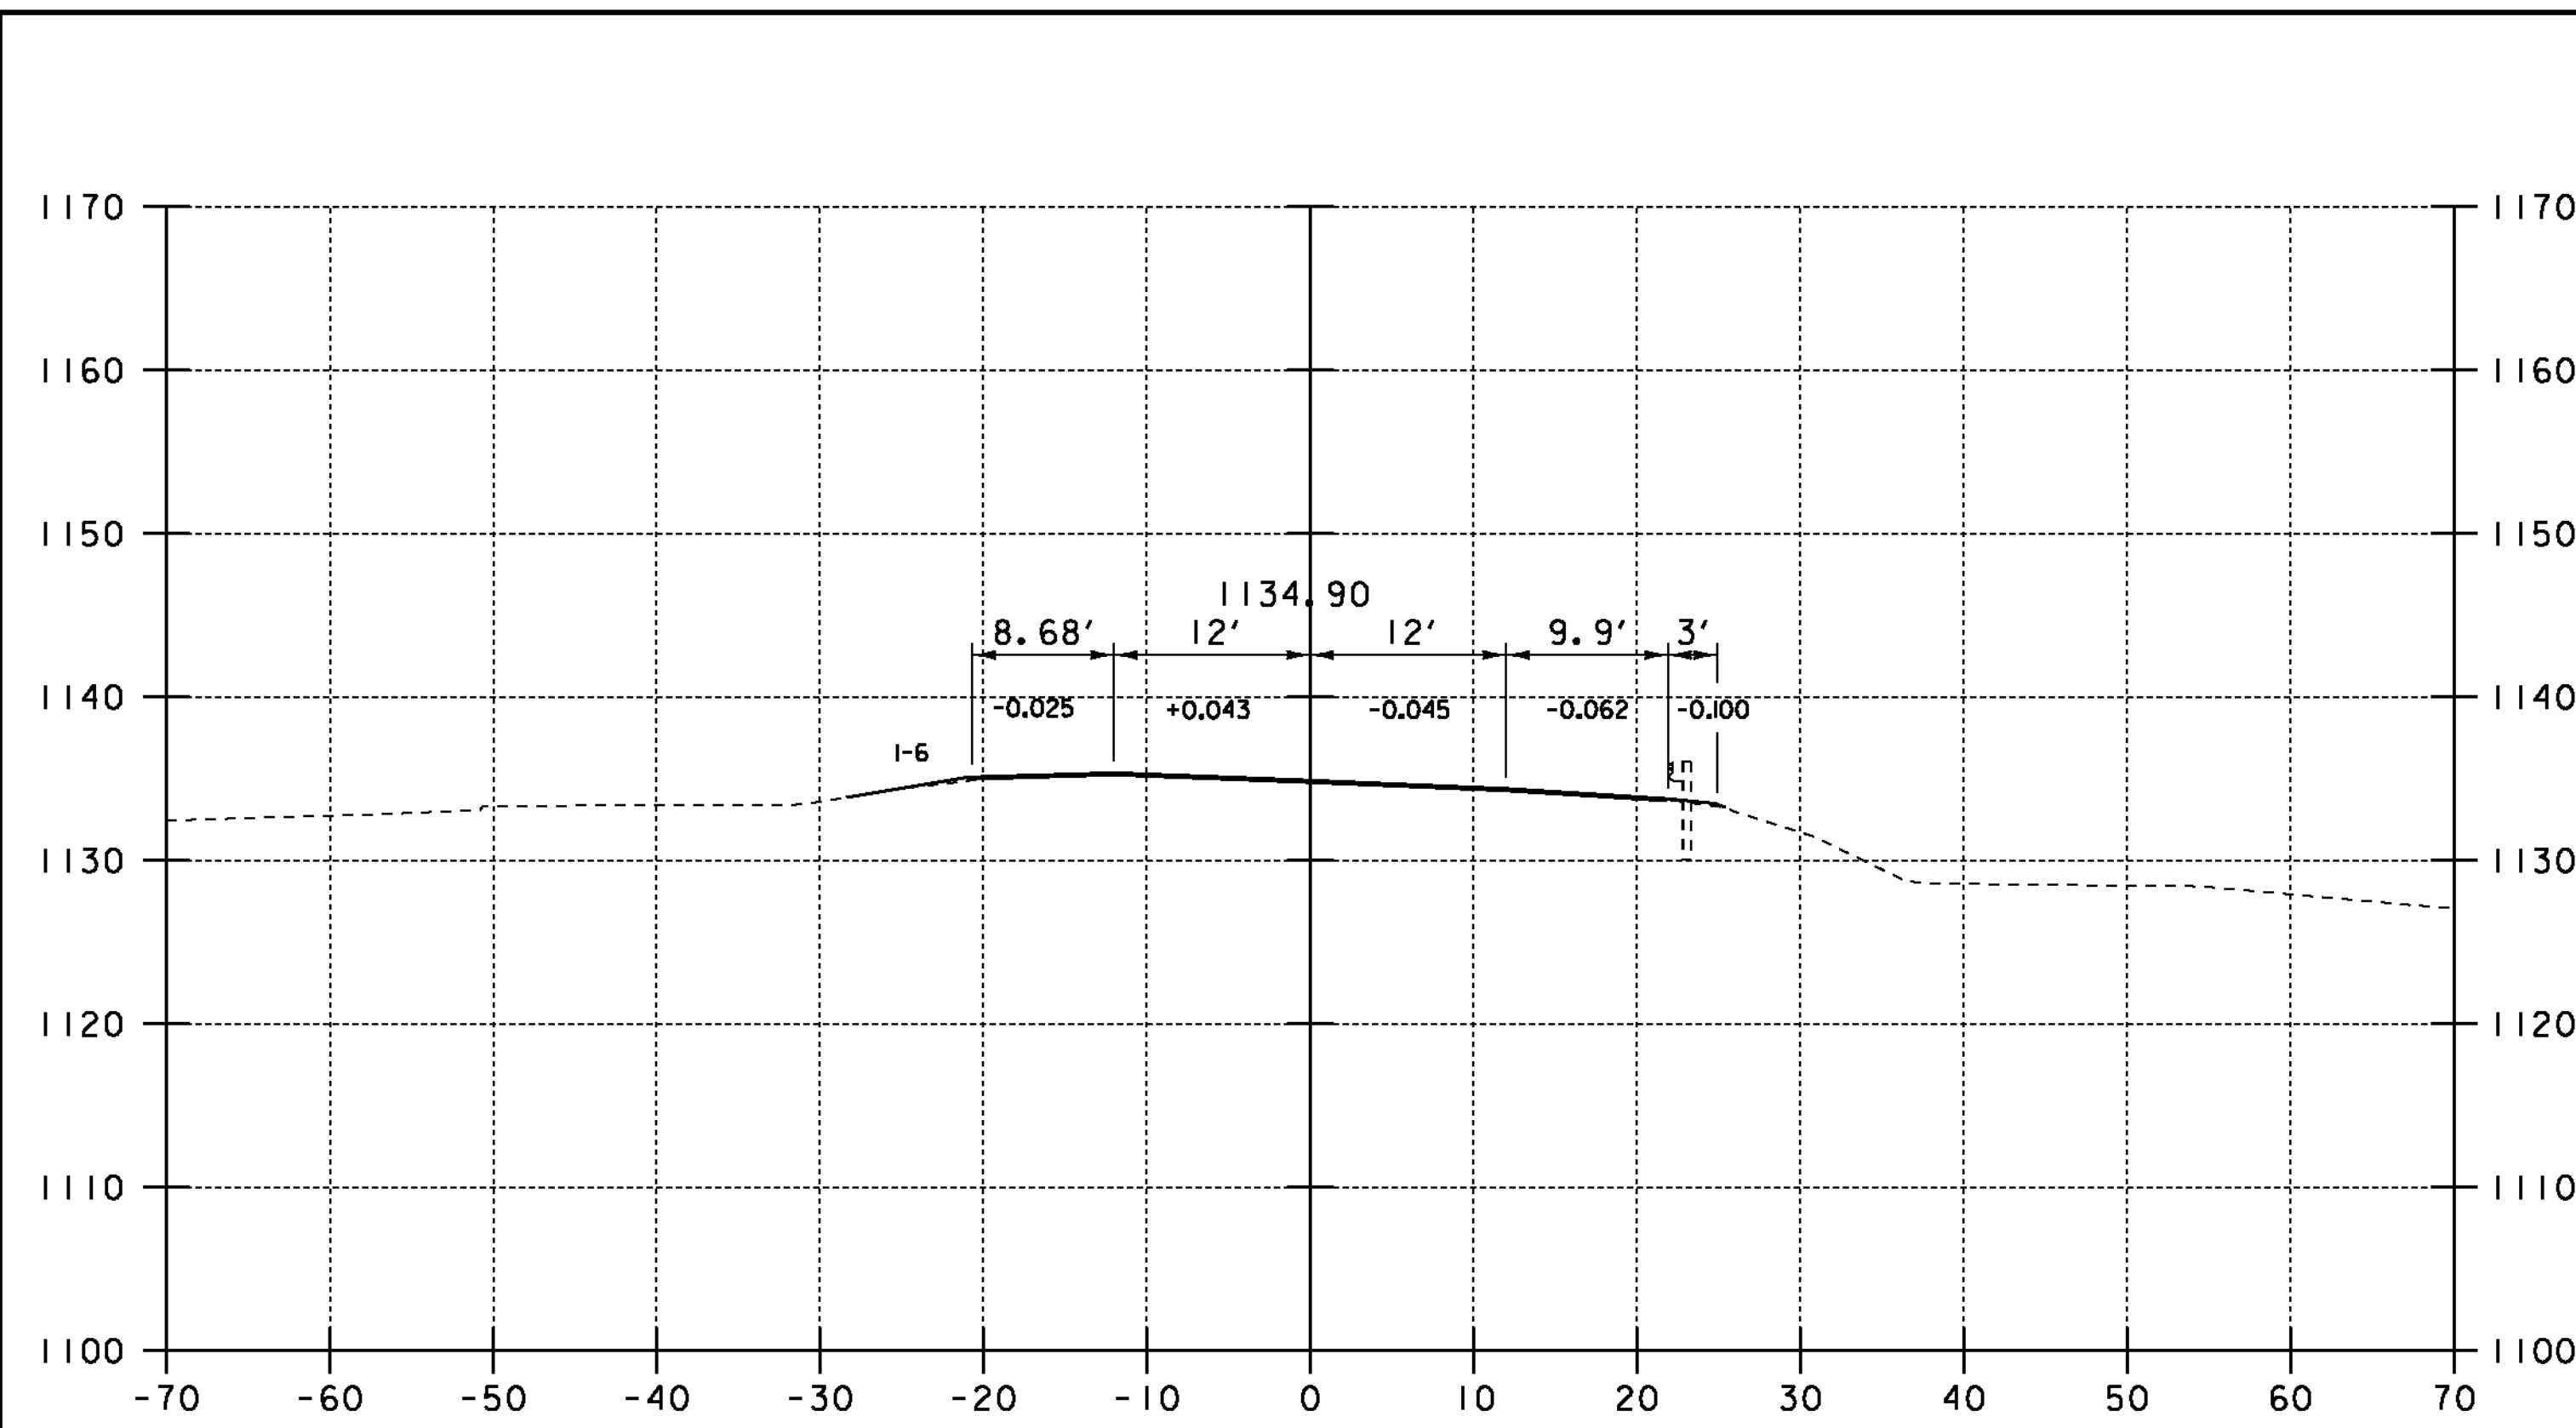


**62+25.00  
BEGIN APPROACH  
MATCH EXISTING**

**62+50**

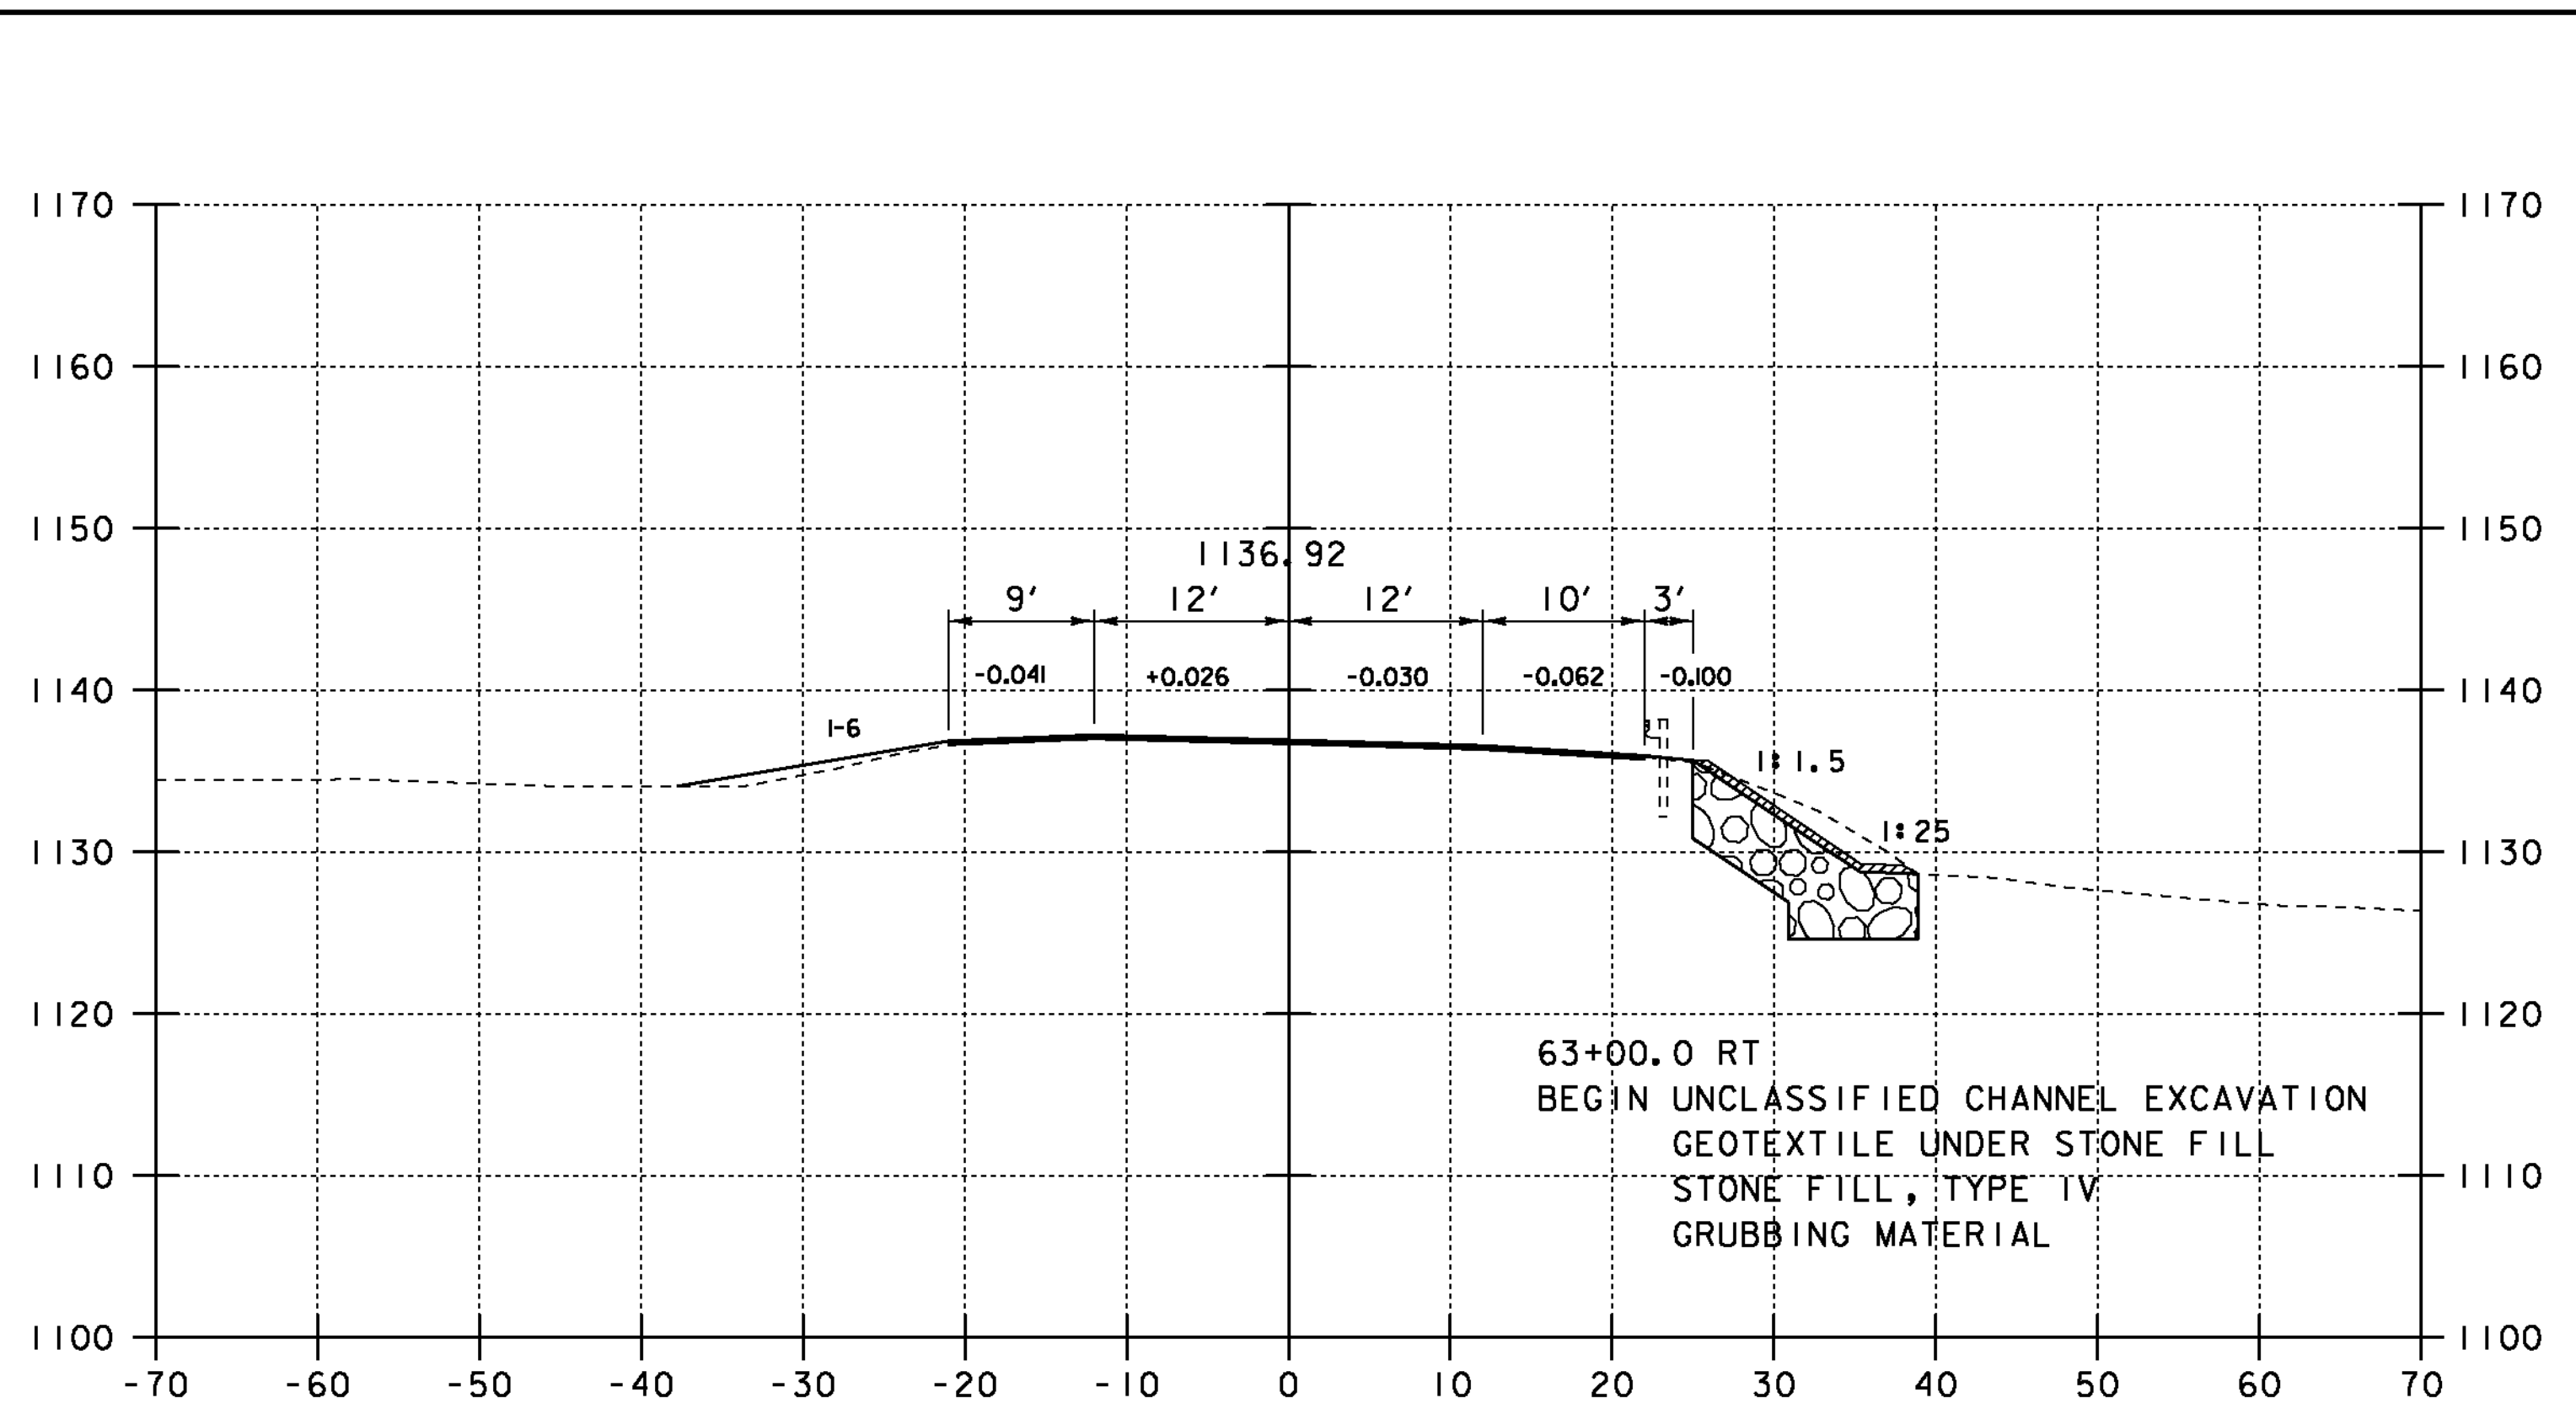


**63+00**

63+00.0 RT  
BEGIN UNCLASSIFIED CHANNEL EXCAVATION  
GEOTEXTILE UNDER STONE FILL  
STONE FILL, TYPE IV  
GRUBBING MATERIAL

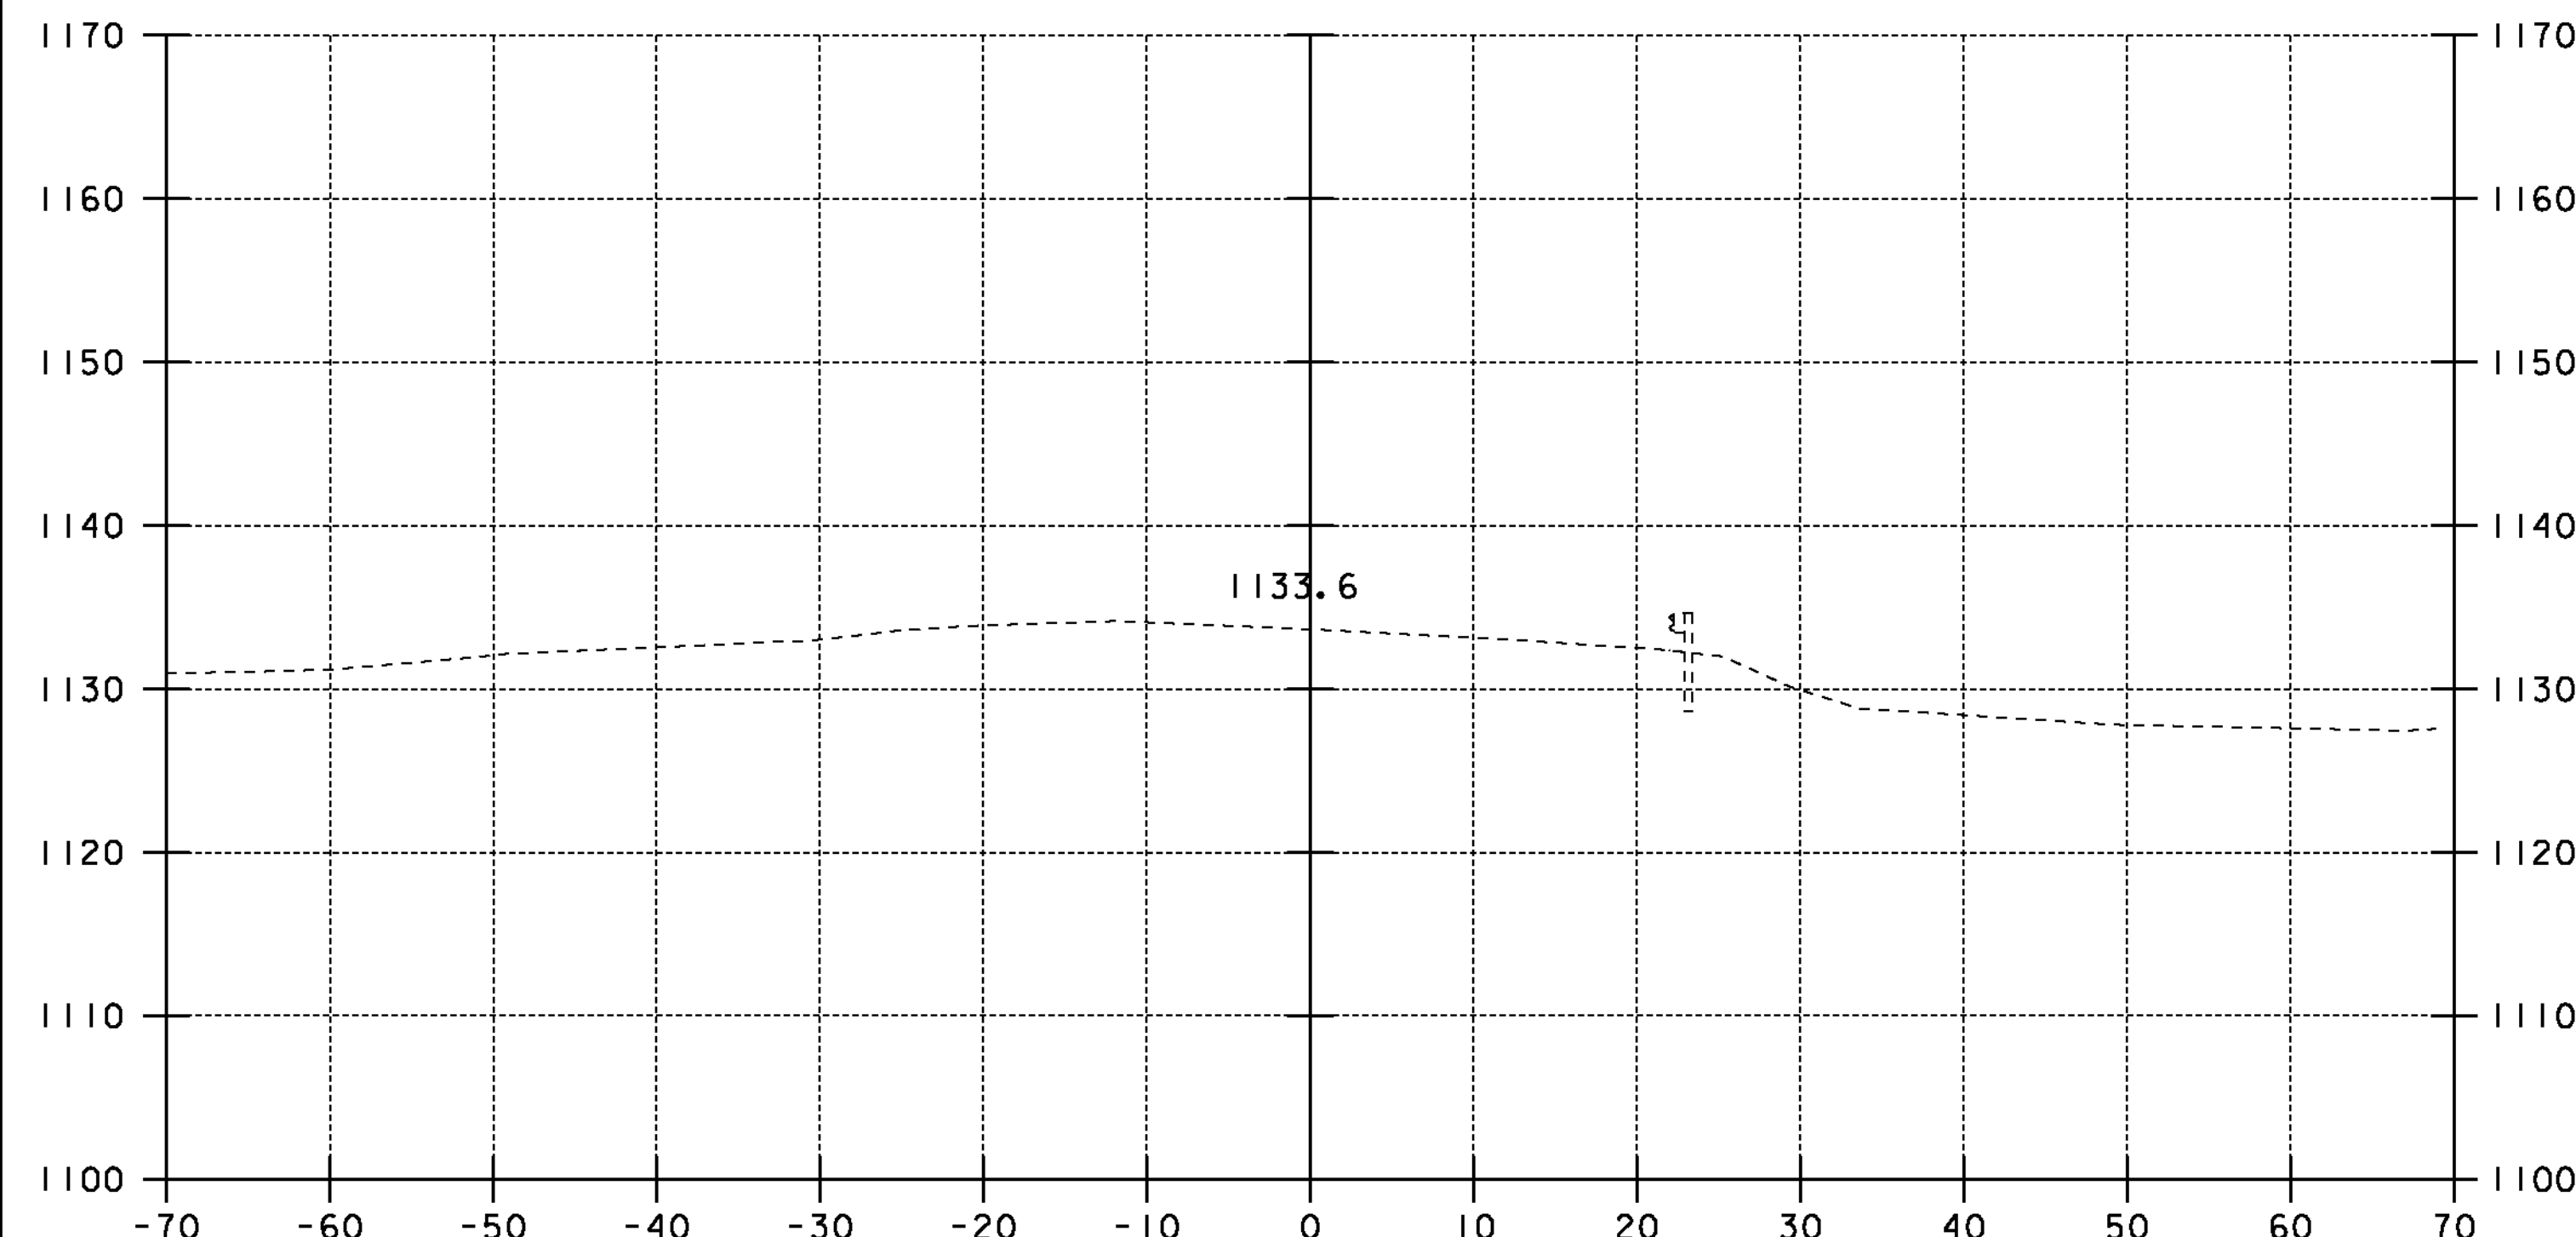


**62+19**

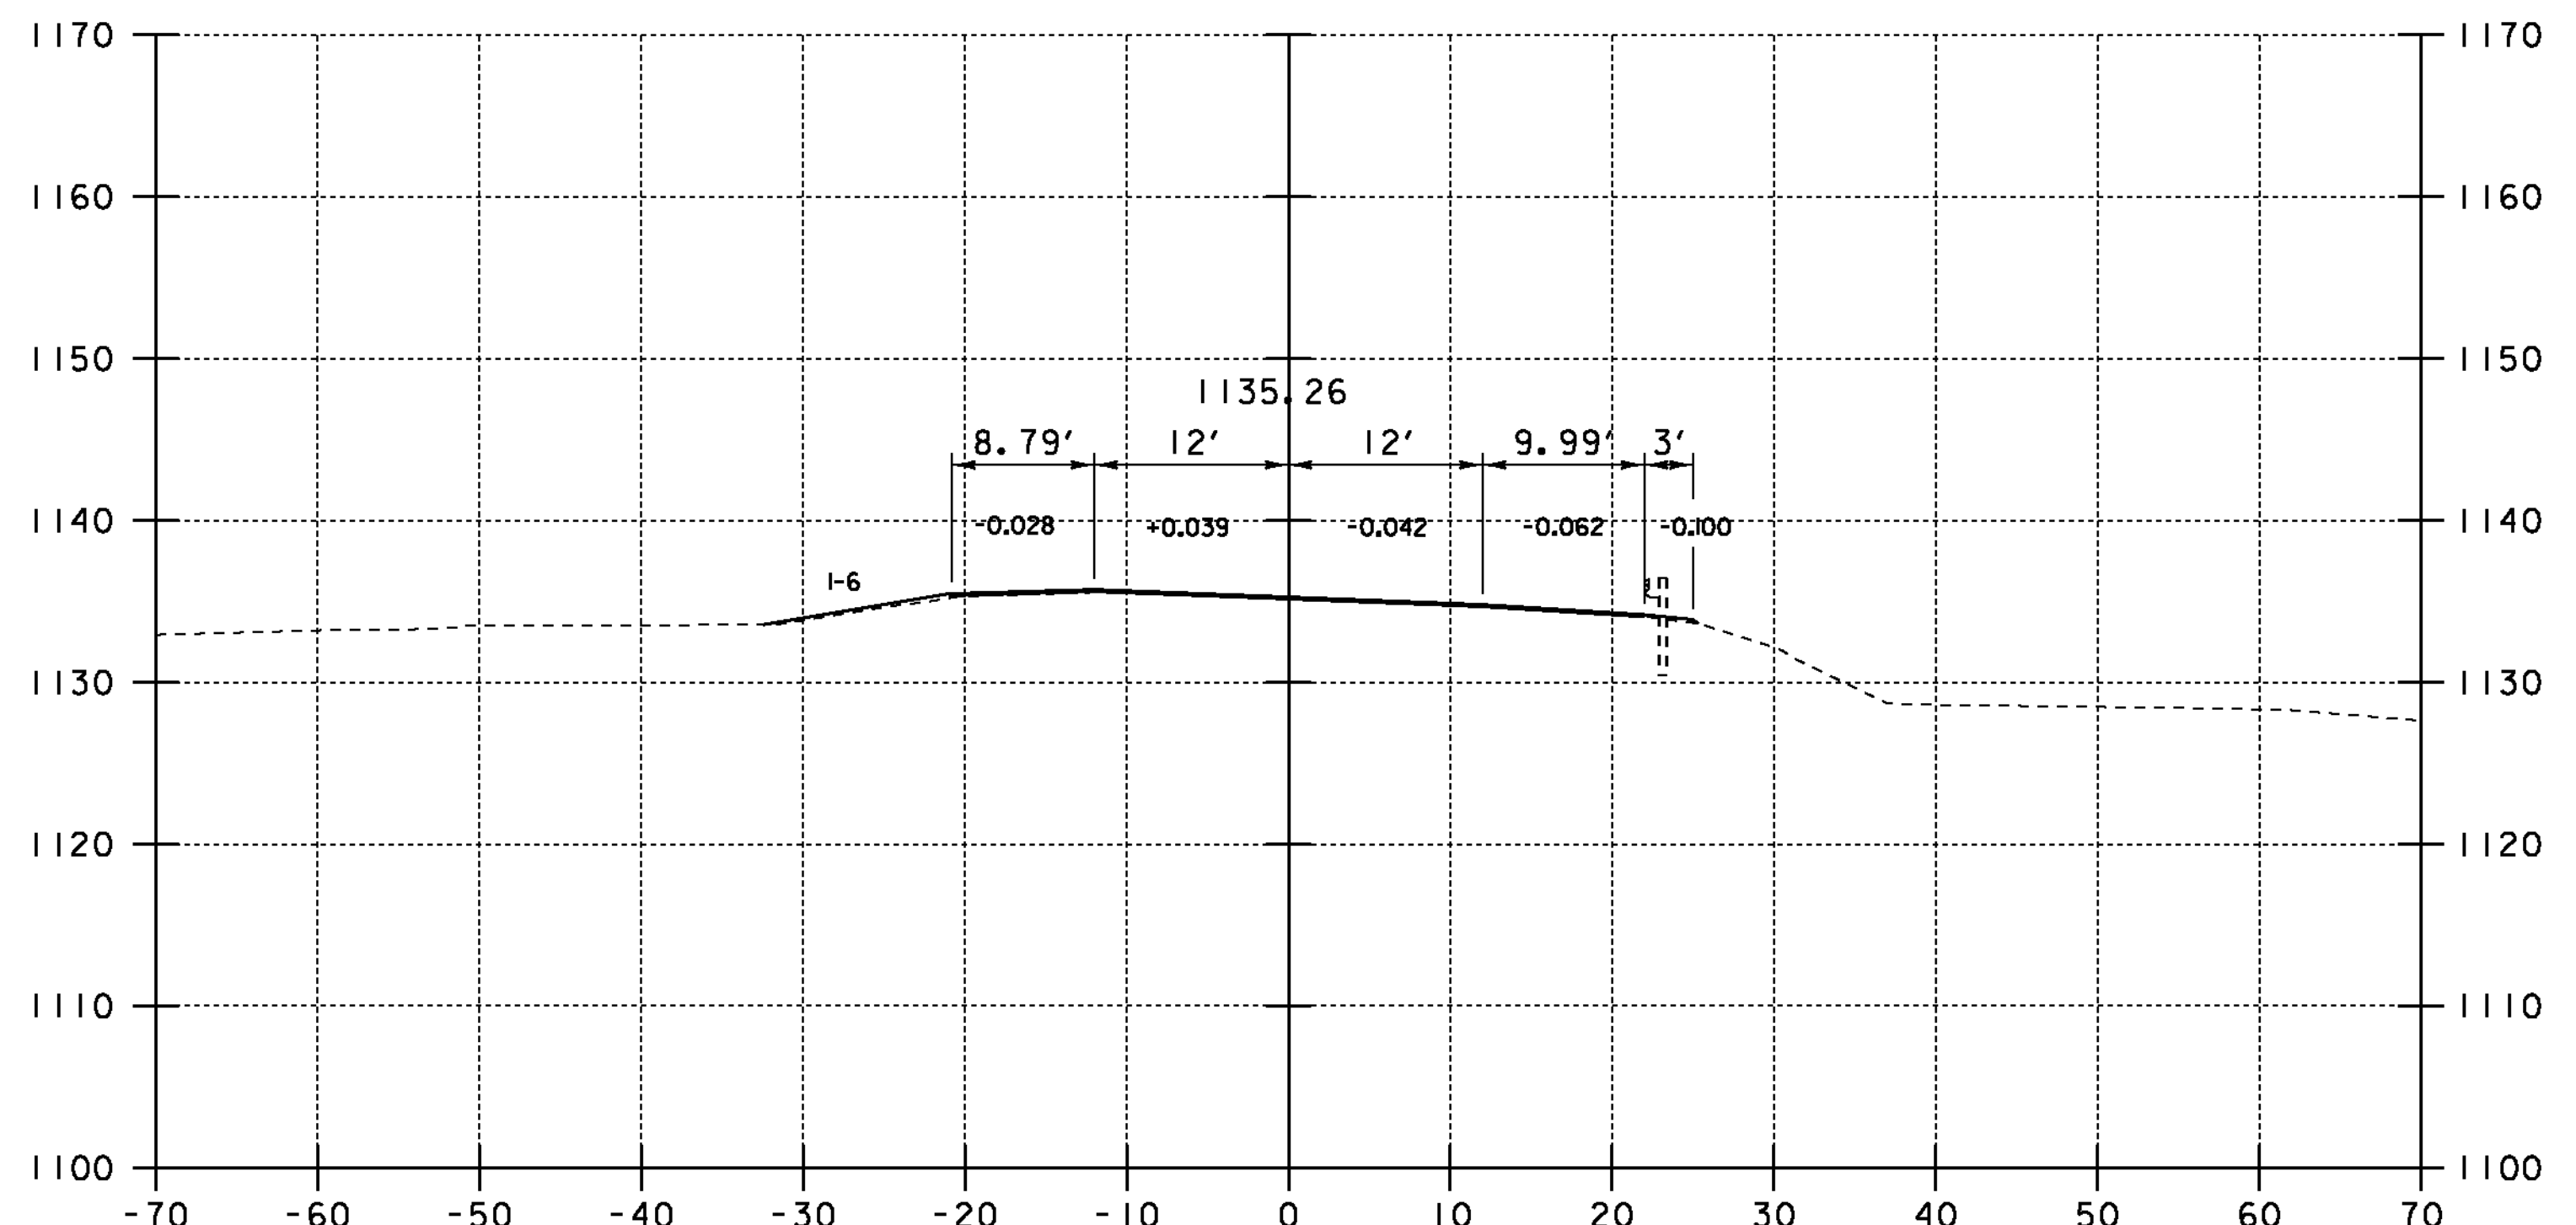


**62+59**


PROJECT NAME: WOODFORD	PLOT DATE: 23-MAR-2012
PROJECT NUMBER: ER BHF 010-1(44)	DRAWN BY: EVANS-MONGEON
FILE NAME: s11b214xs.dgn	CHECKED BY:
PROJECT LEADER: C. CARLSON	ROADWAY CROSS SECTIONS SHEET (1)
DESIGNED BY: M.EVANS-MONGEON	SHEET 36 OF 58

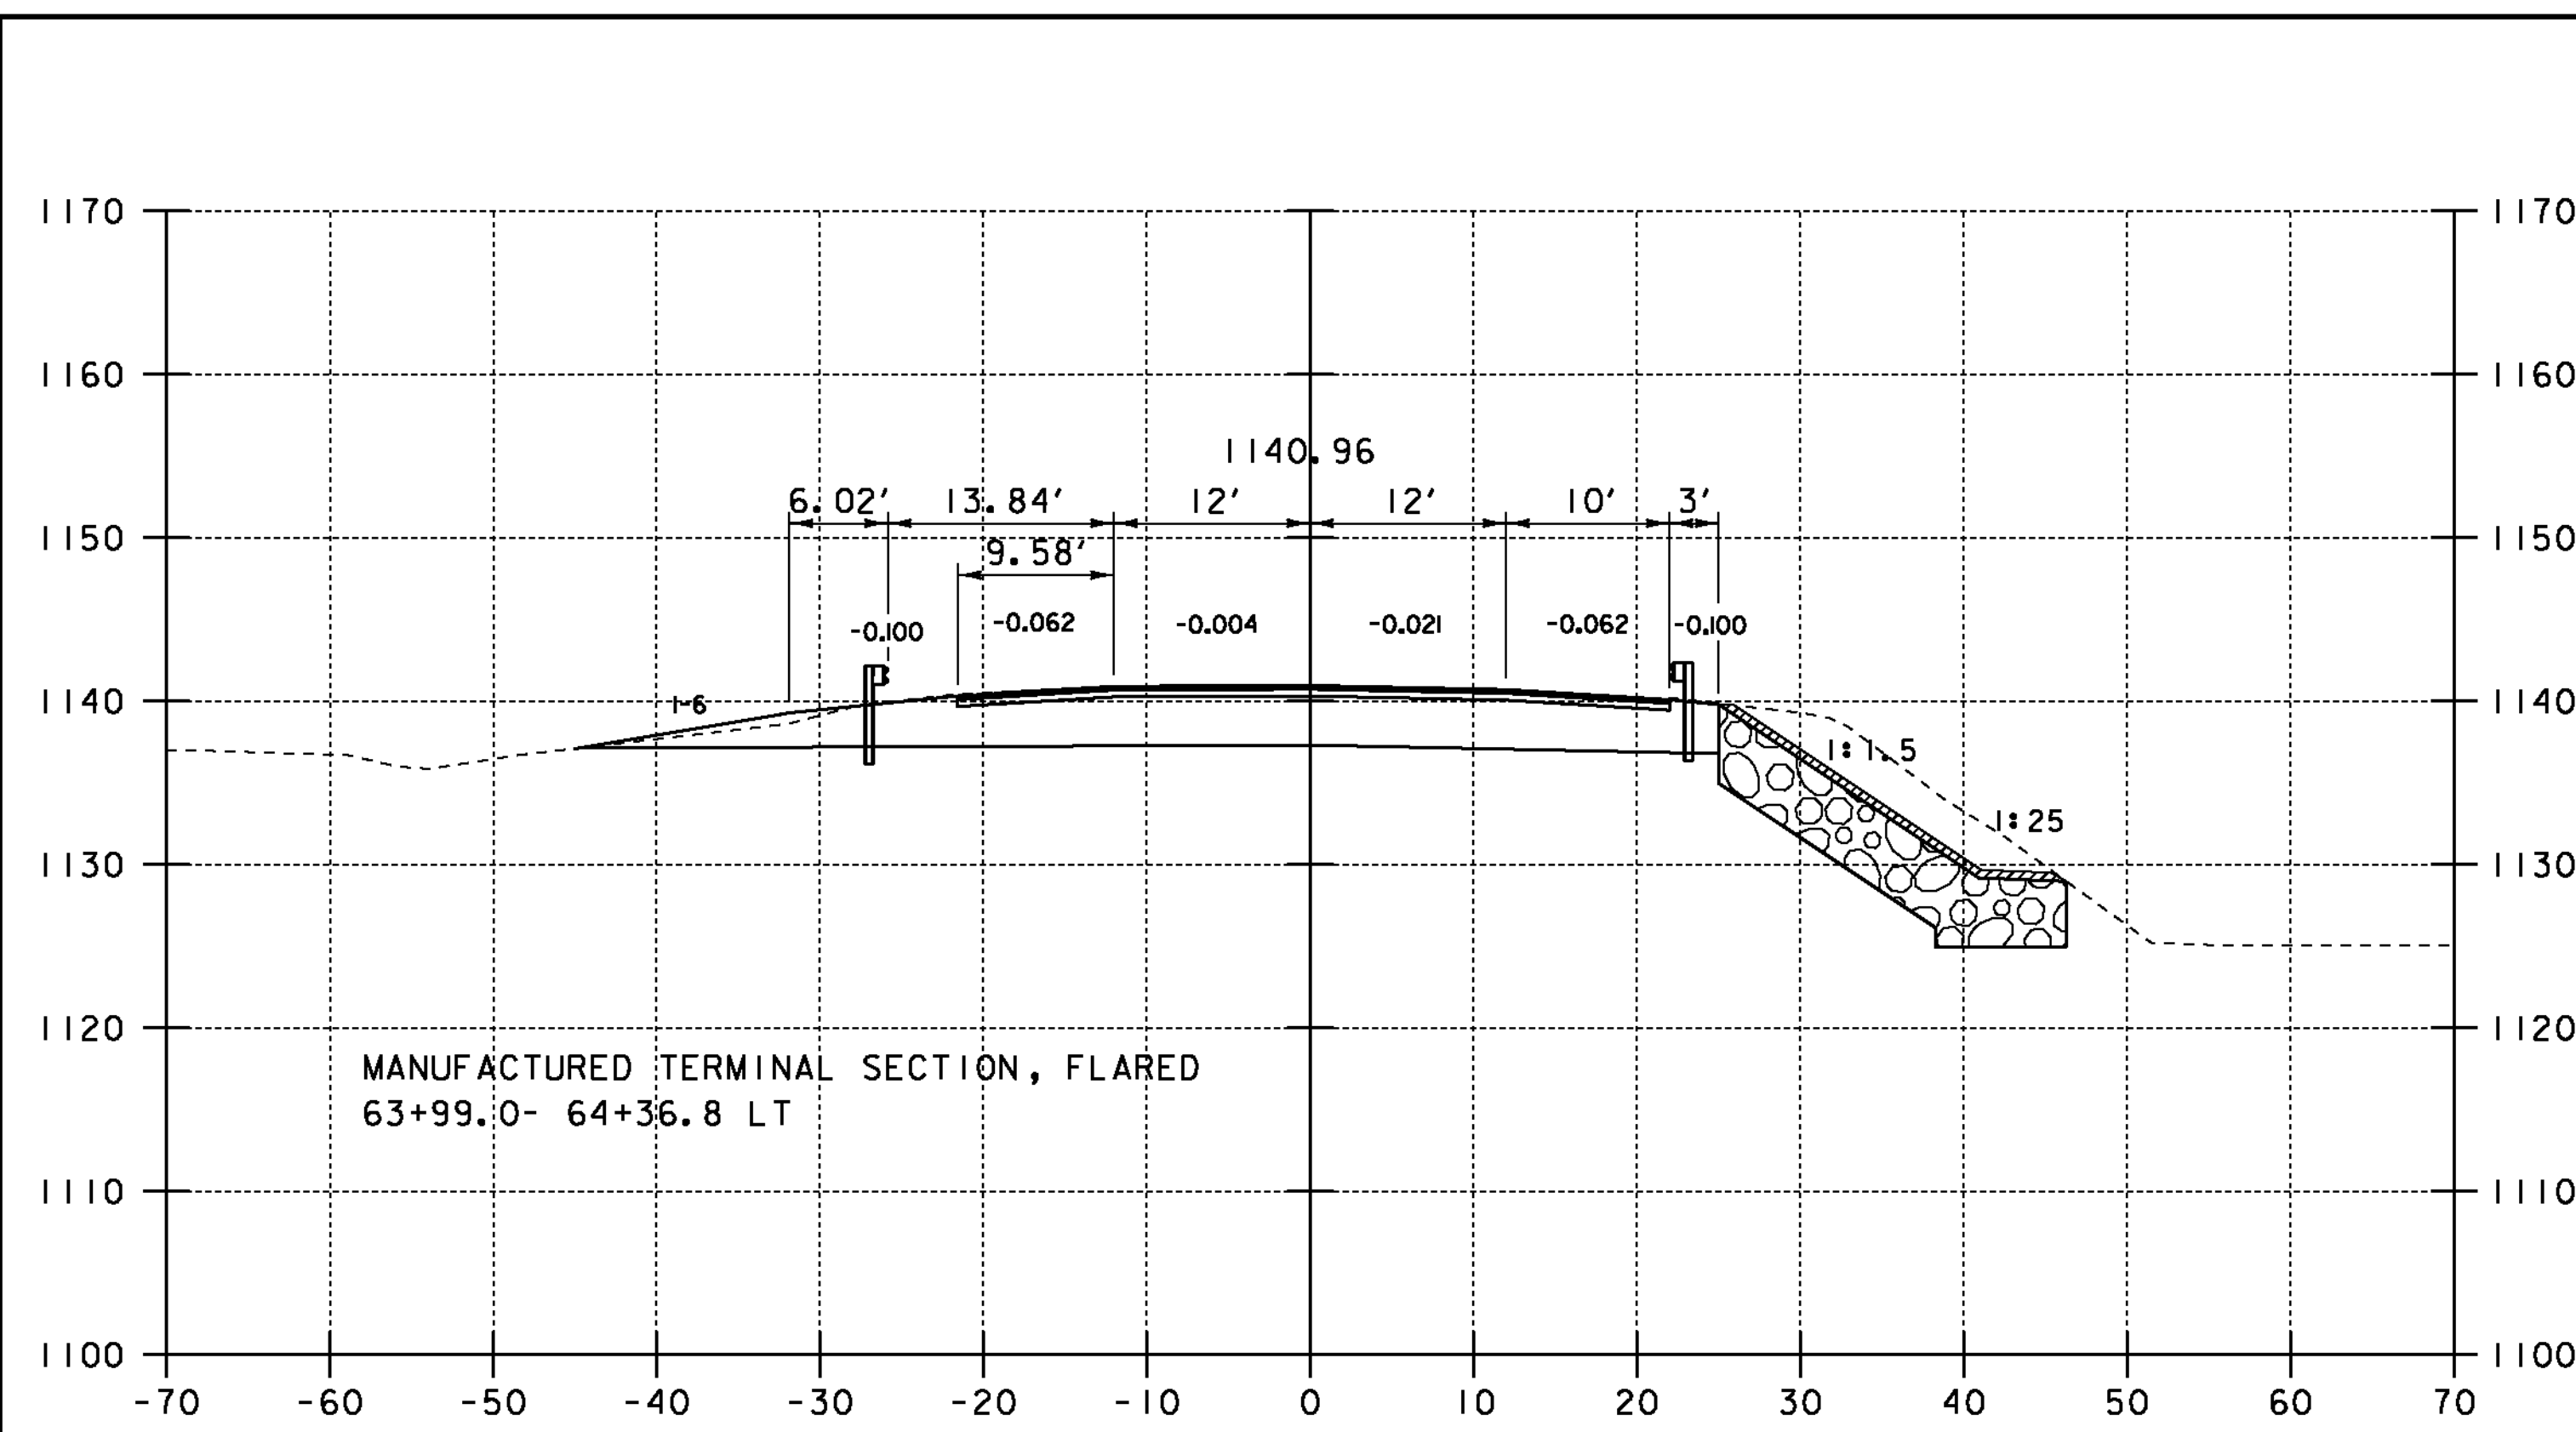


**64+00.00**  
**END APPROACH**  
**BEGIN PROJECT**

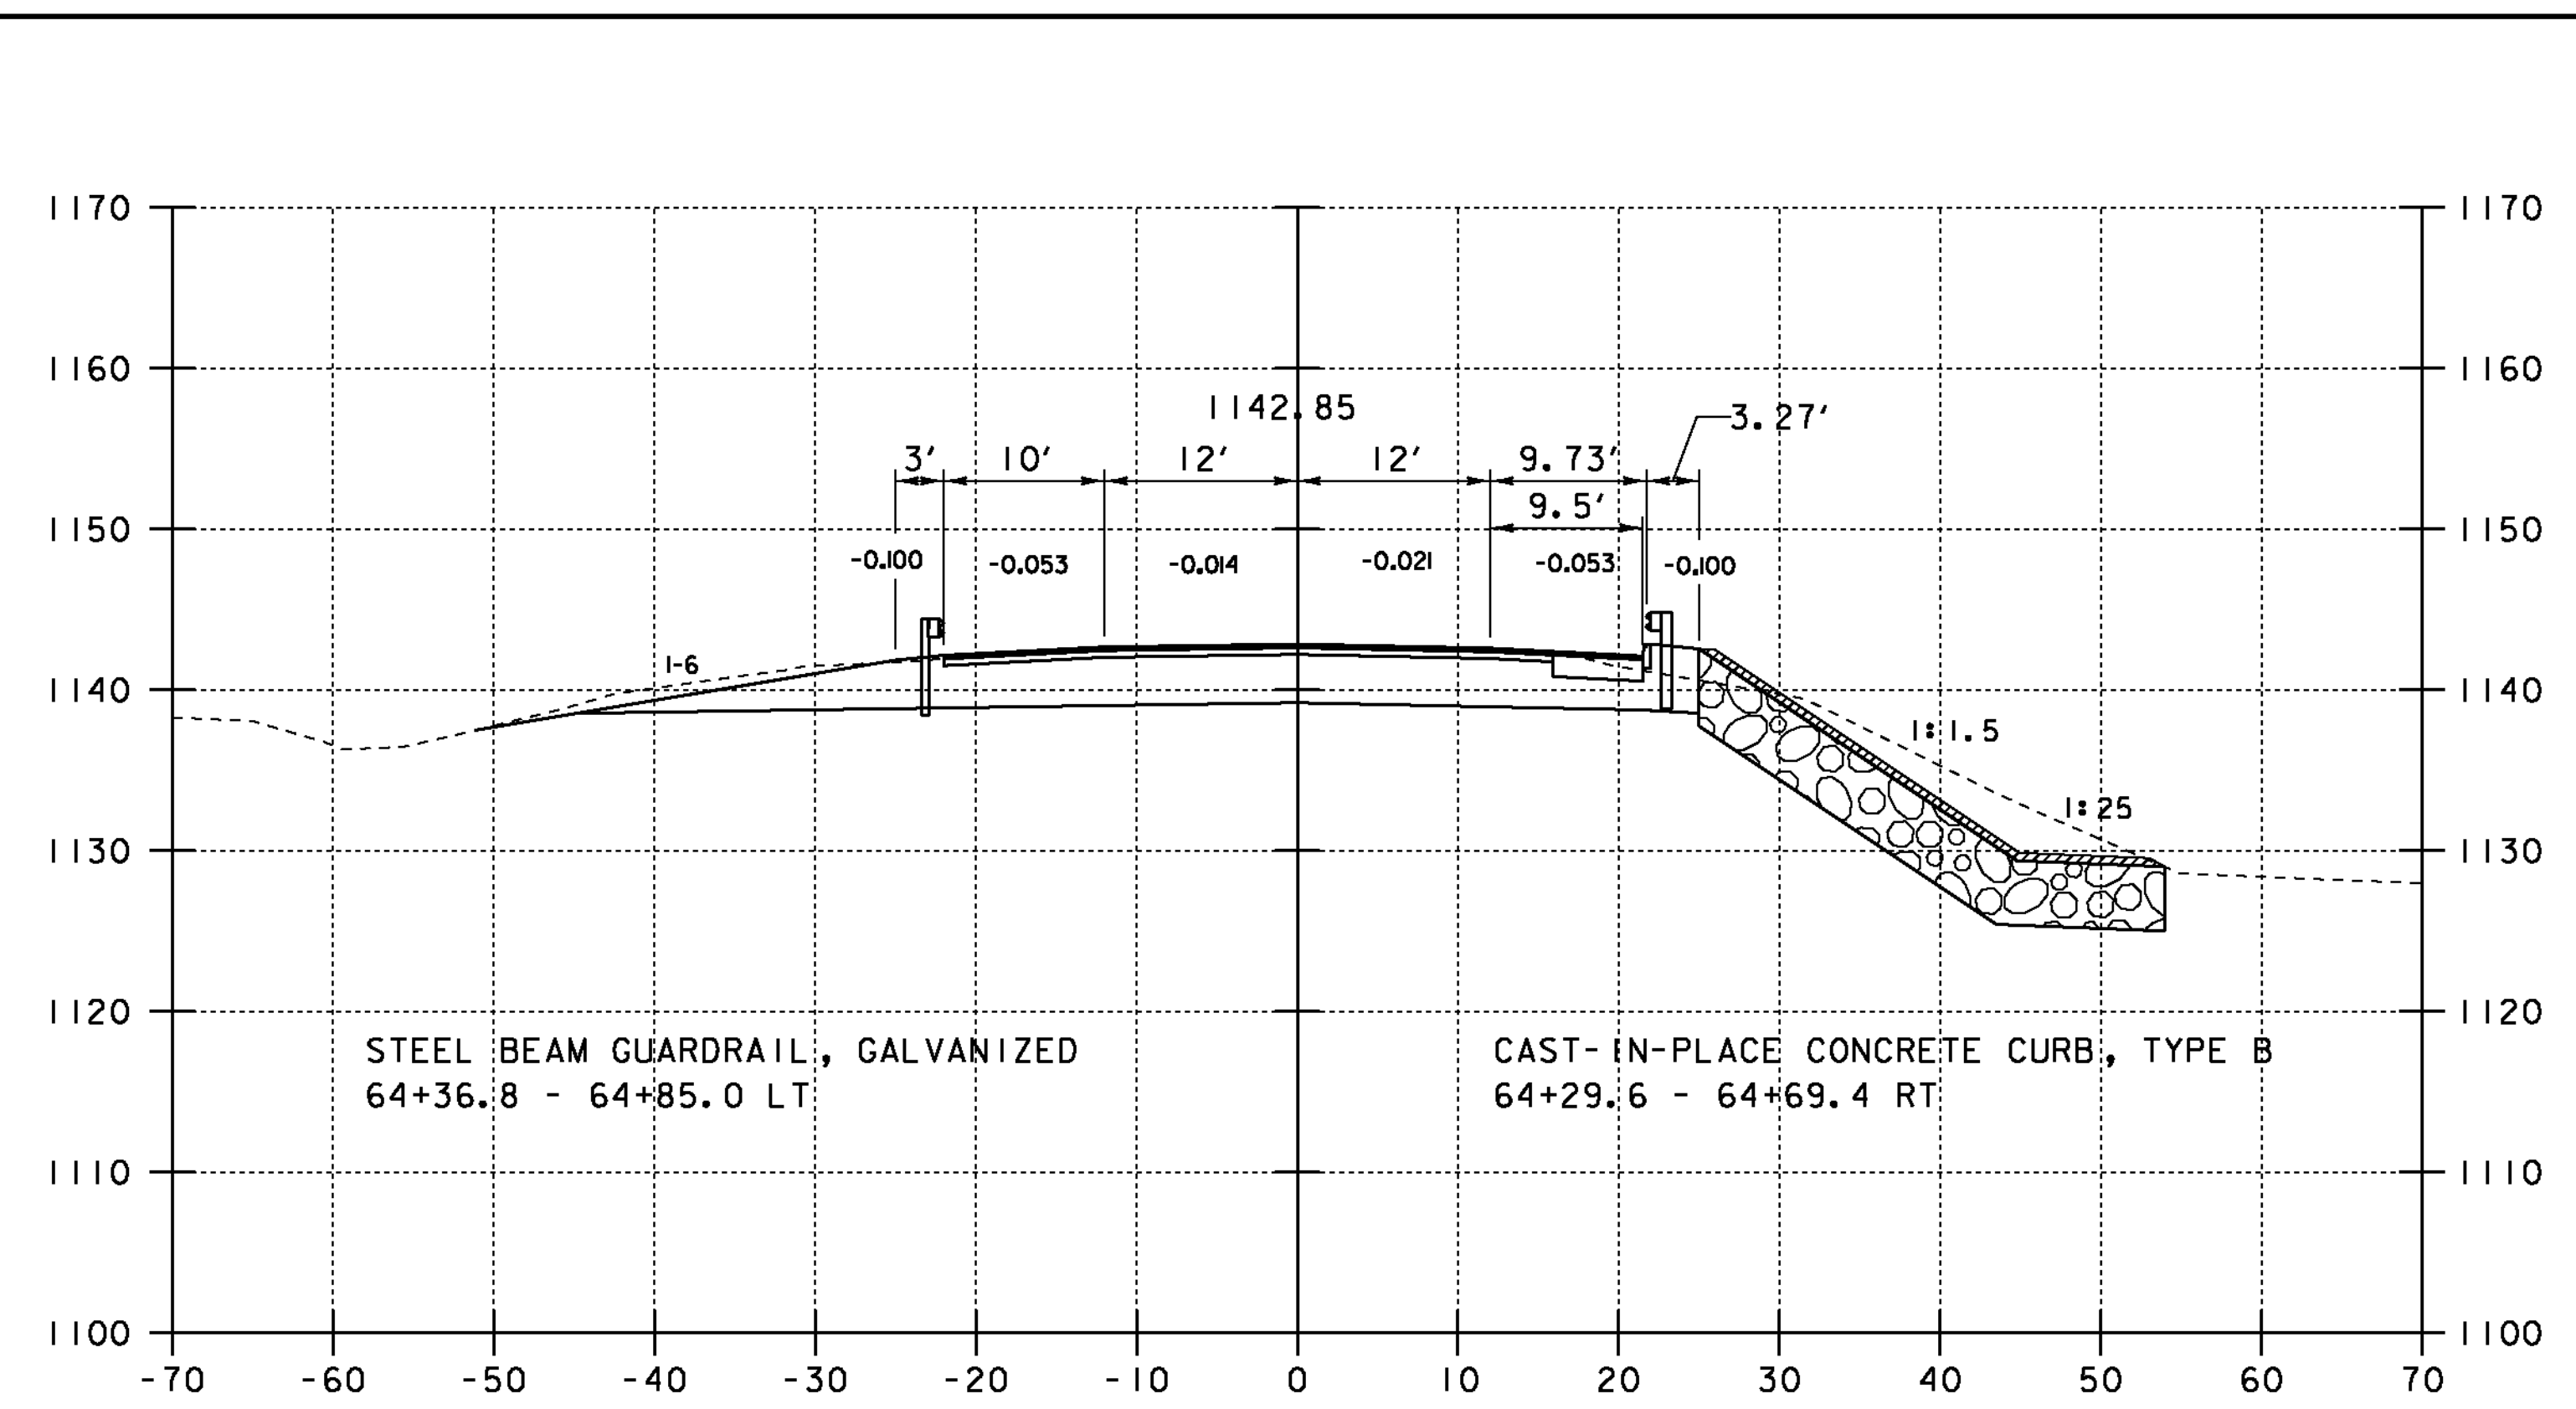

**64+50**

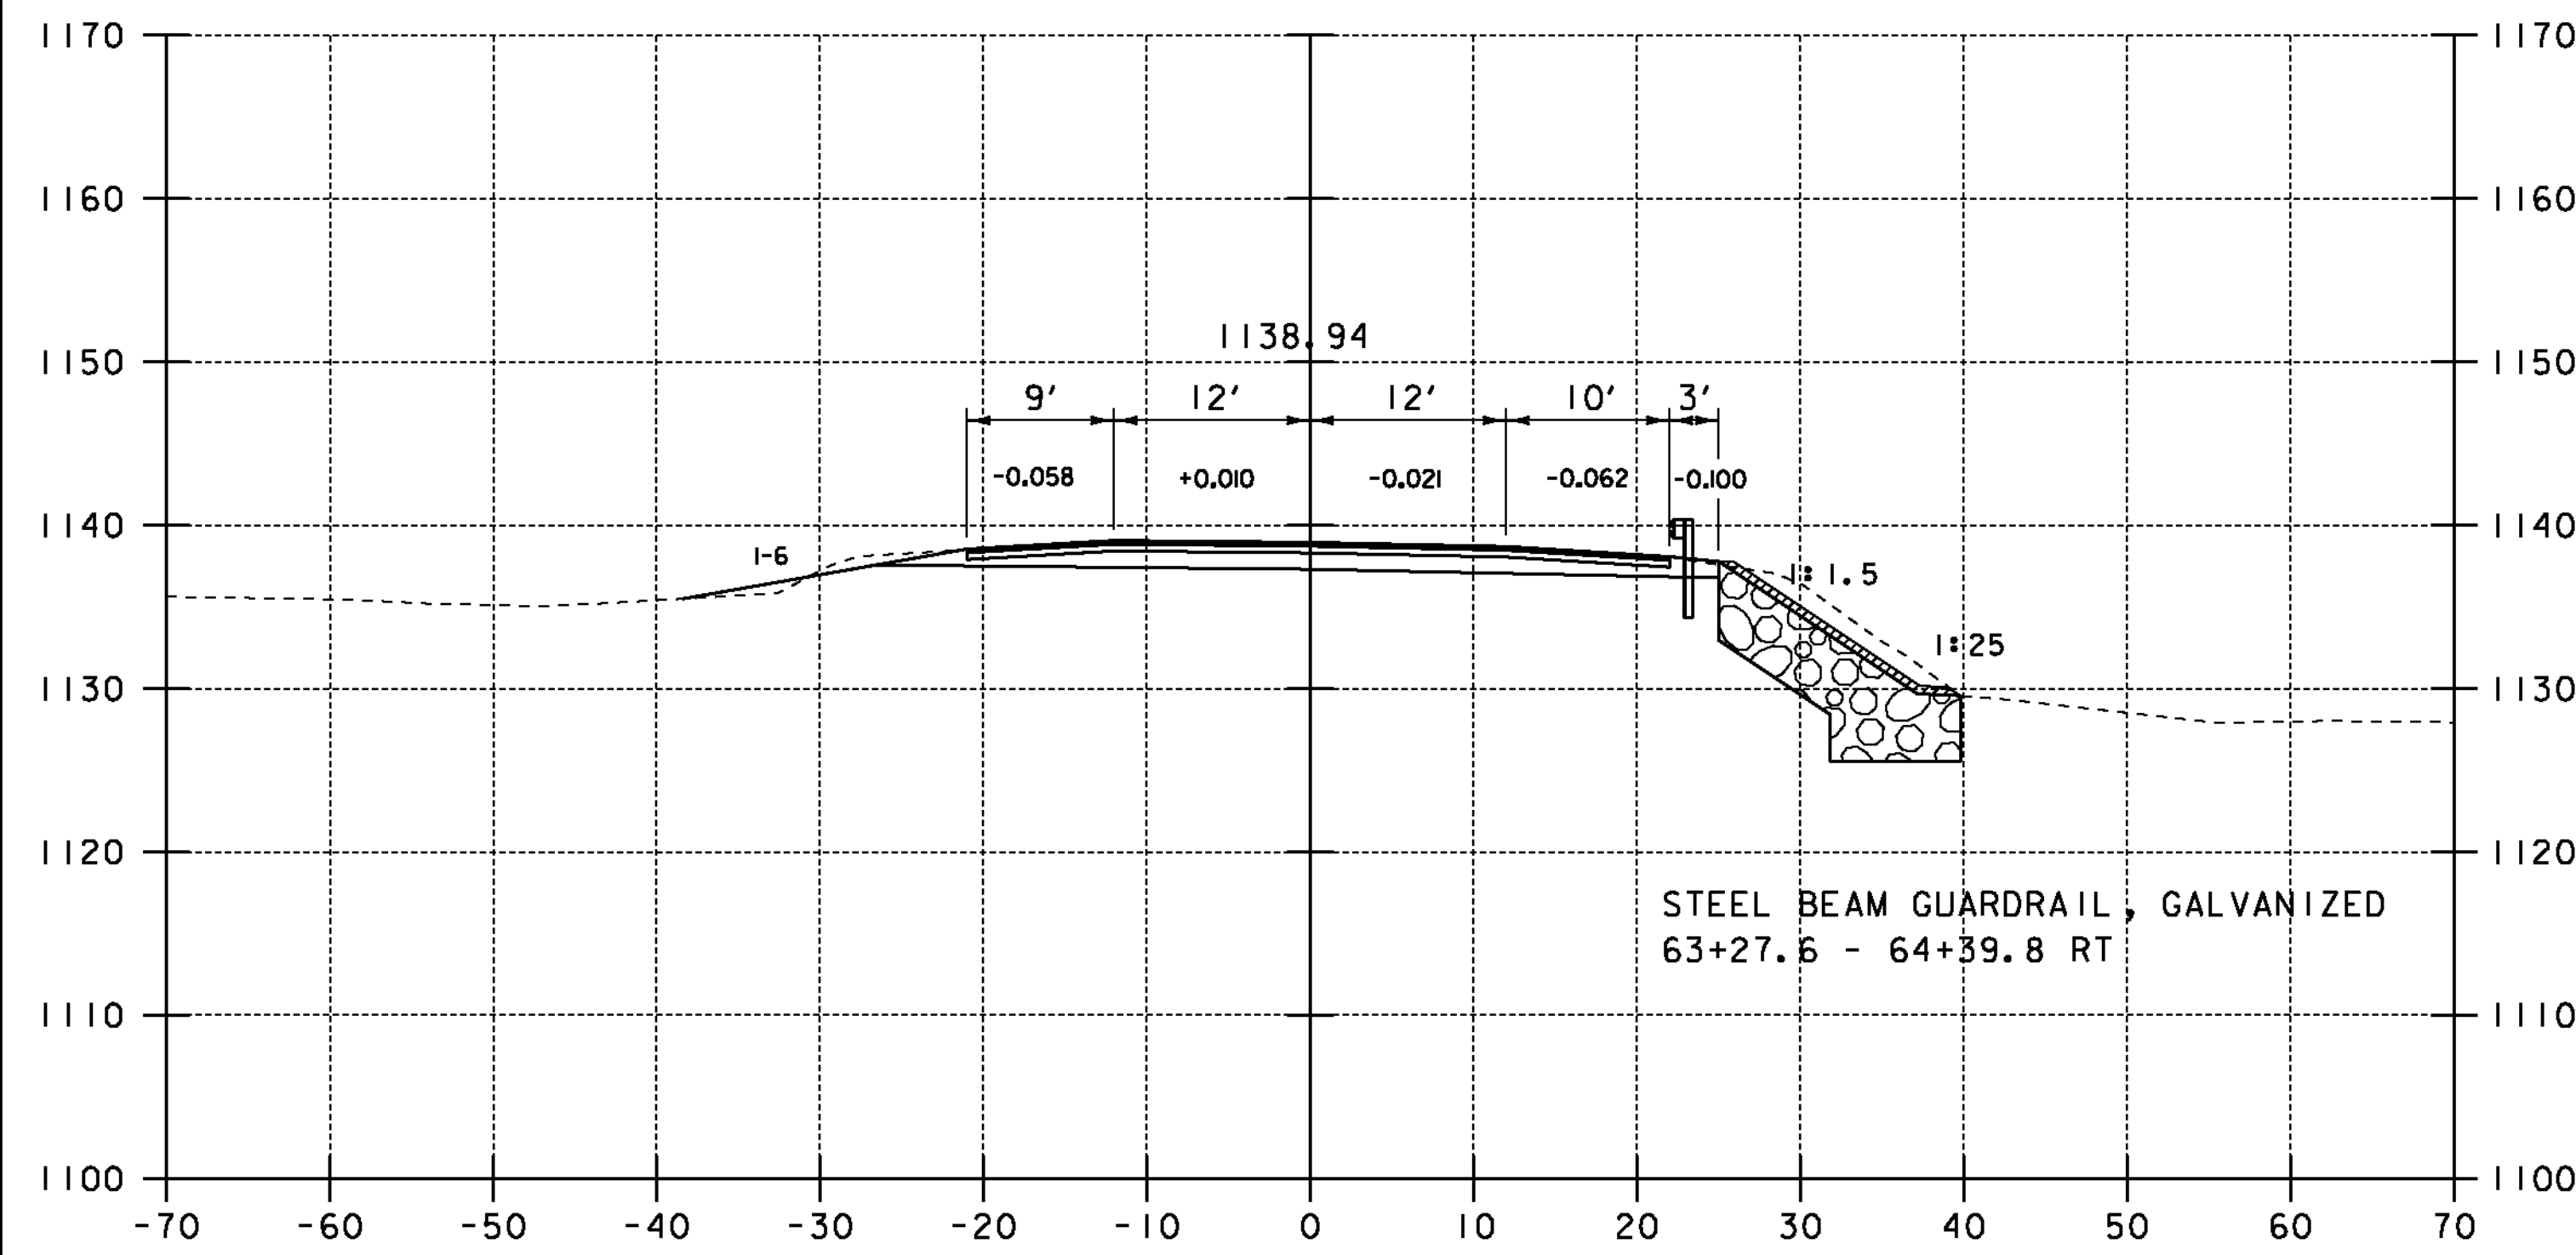


**63+50**

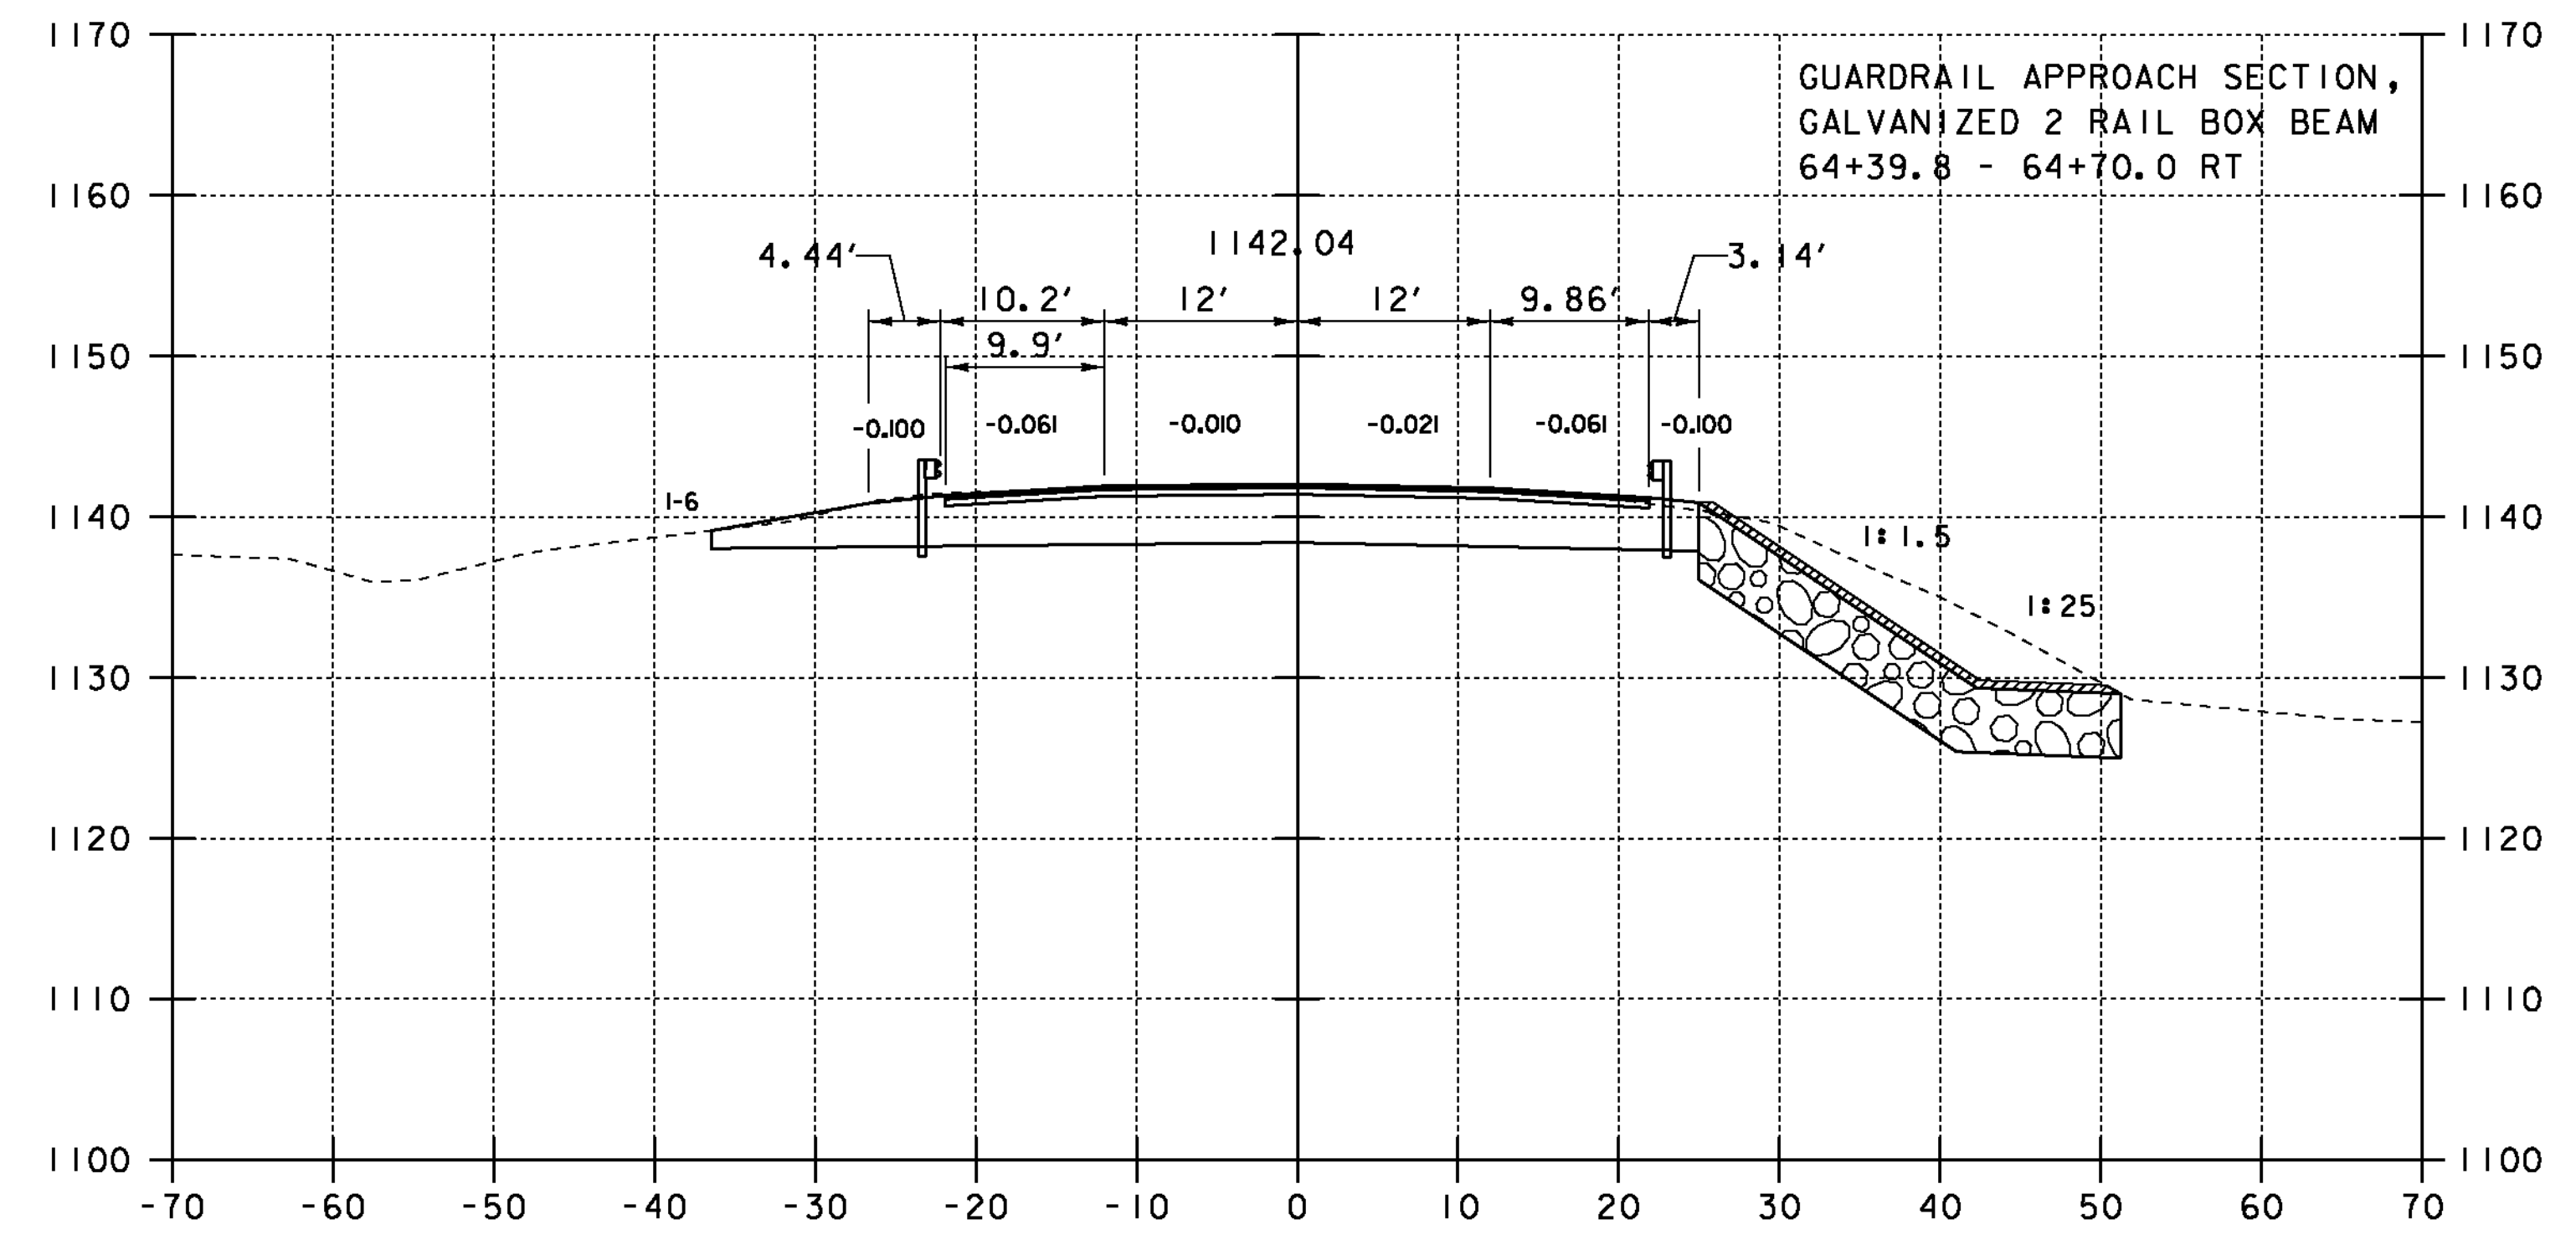


**64+28**


PROJECT NAME:	WOODFORD
PROJECT NUMBER:	ER BHF 010-1(44)
FILE NAME:	s11b214xs.dgn
PROJECT LEADER:	C. CARLSON
DESIGNED BY:	M. EVANS-MONGEON
ROADWAY CROSS SECTIONS SHEET (2)	
PLOT DATE:	23-MAR-2012
DRAWN BY:	EVANS-MONGEON
CHECKED BY:	
SHEET	37 OF 58

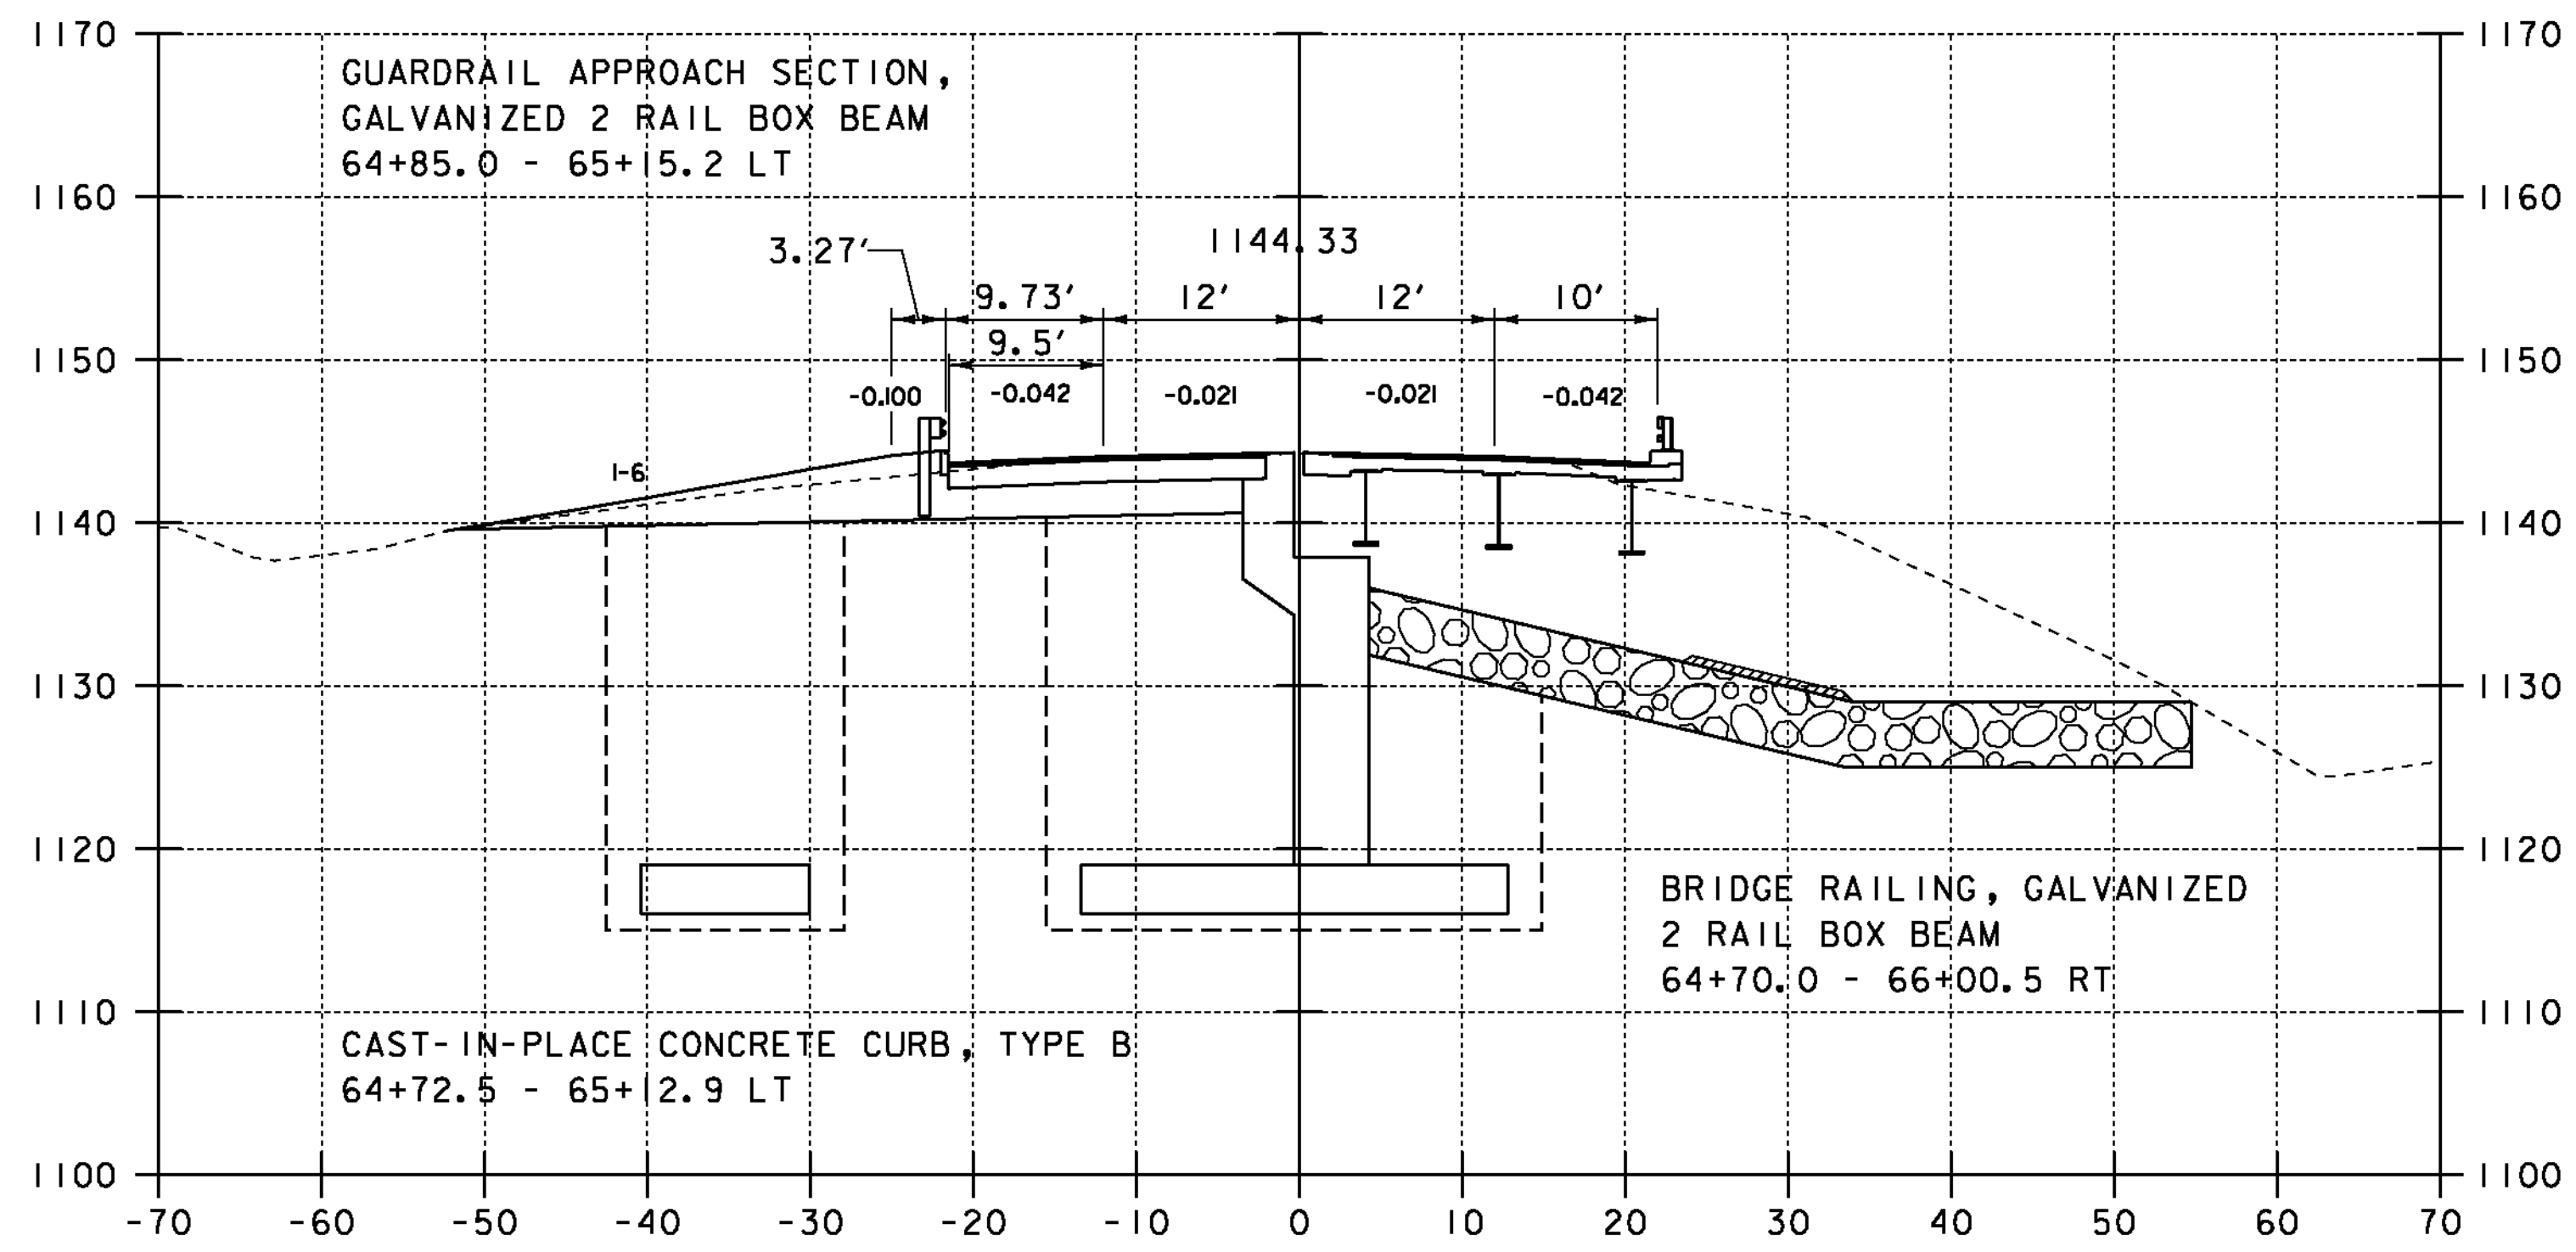


64+93

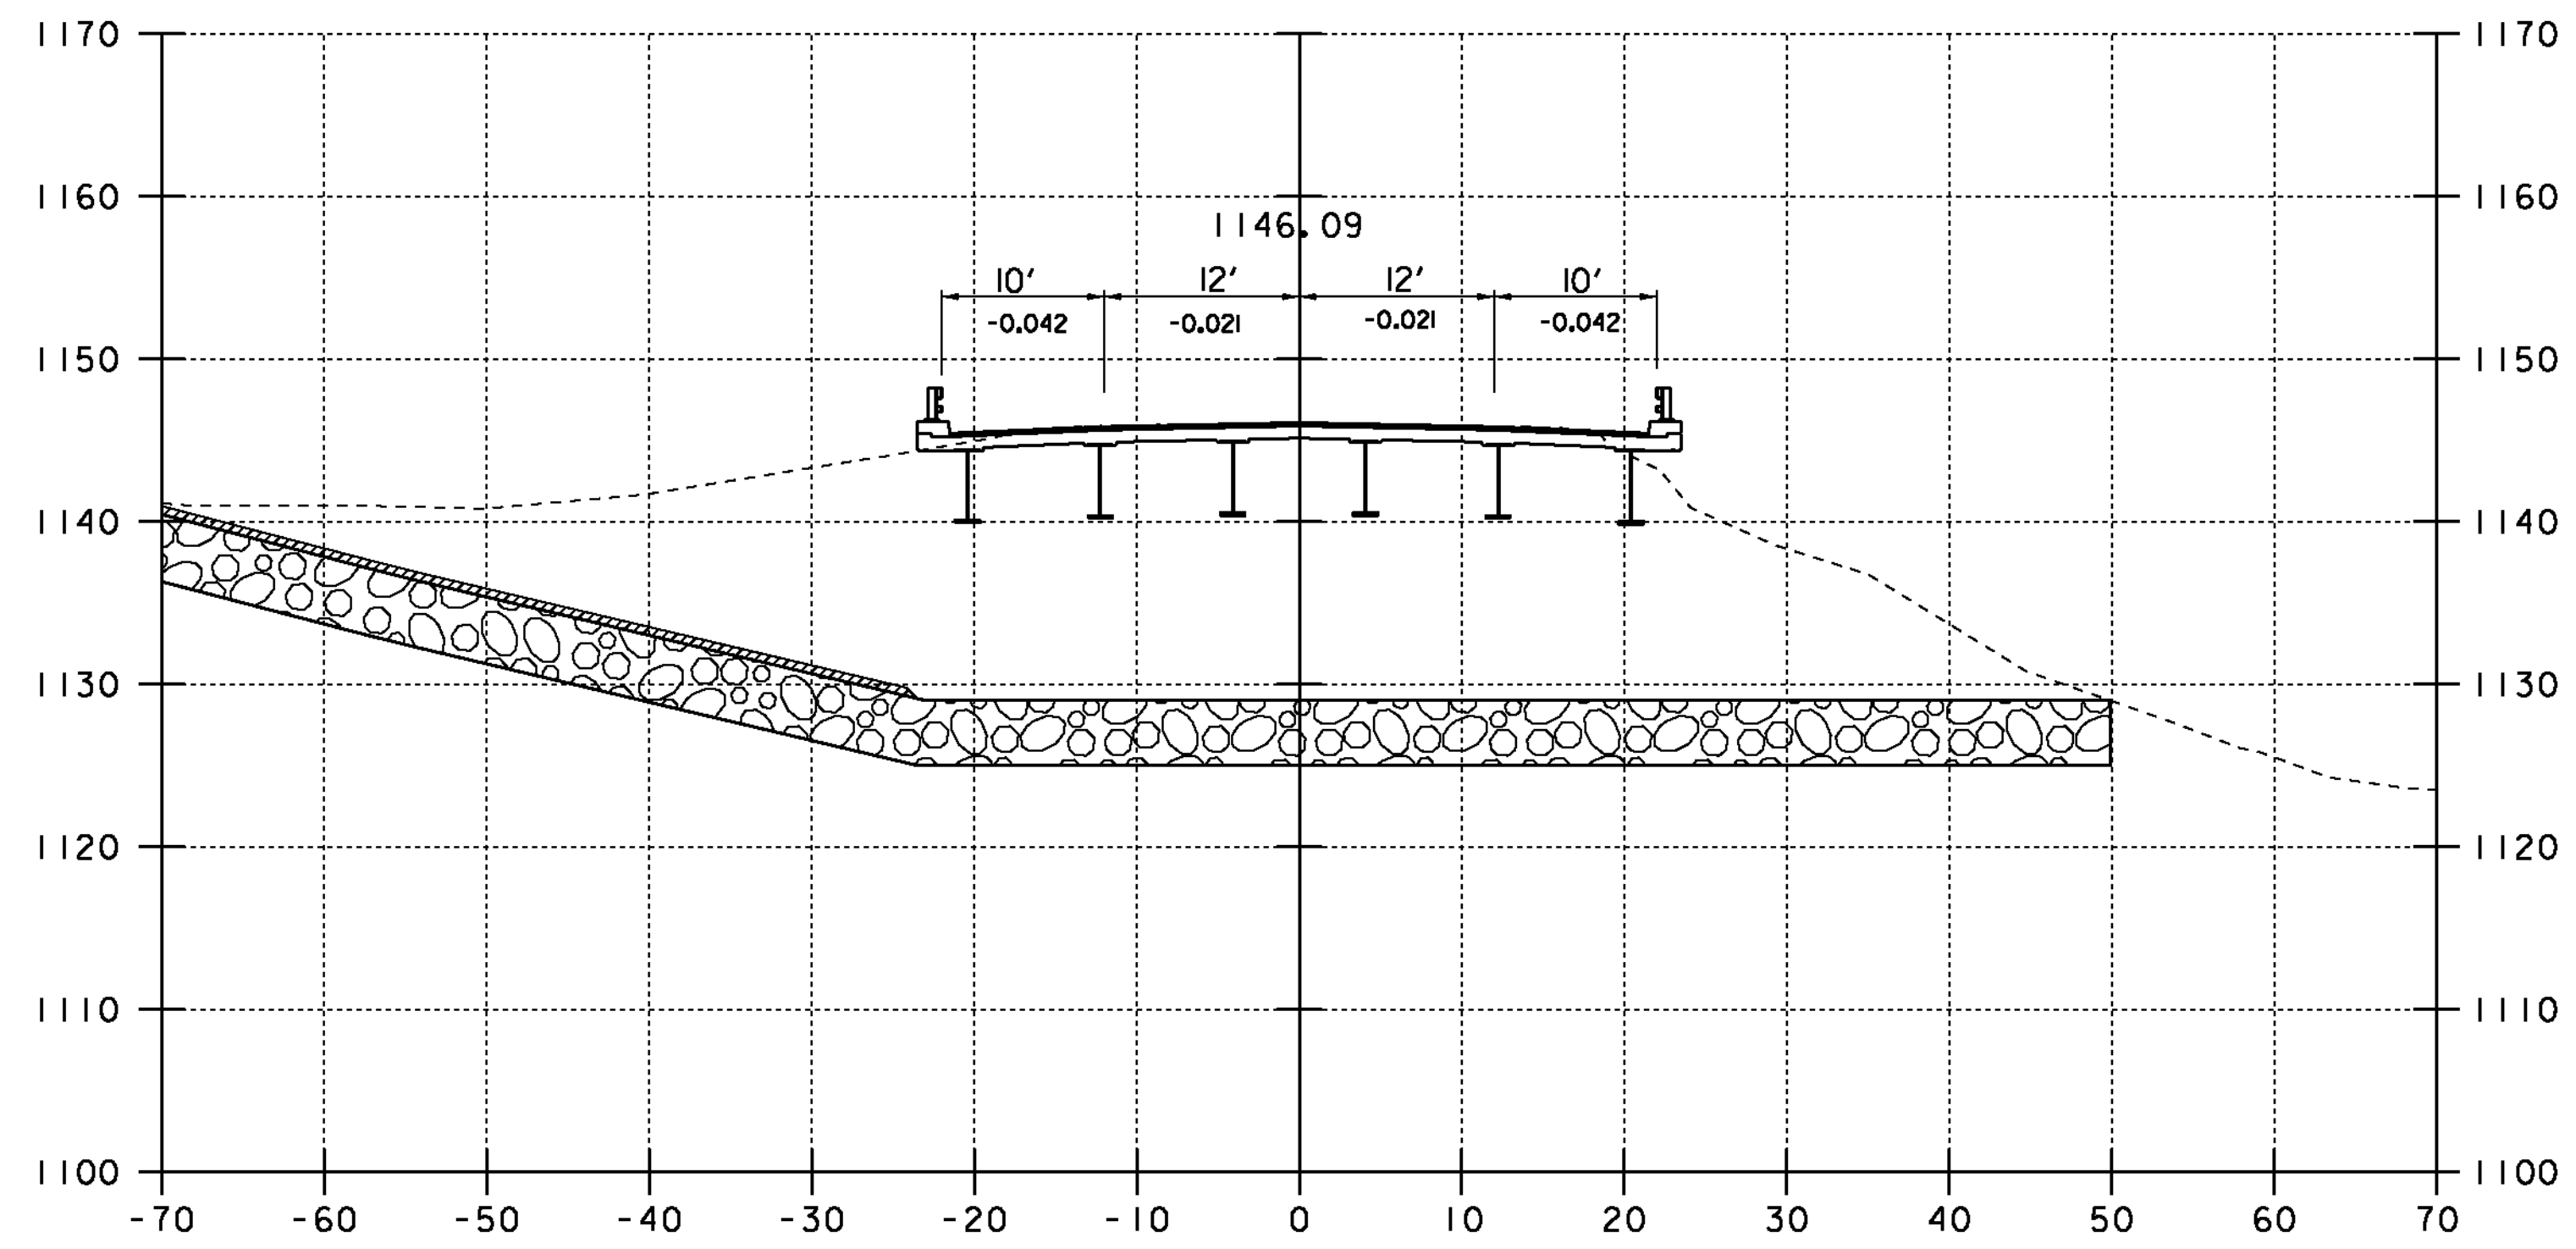

65+50

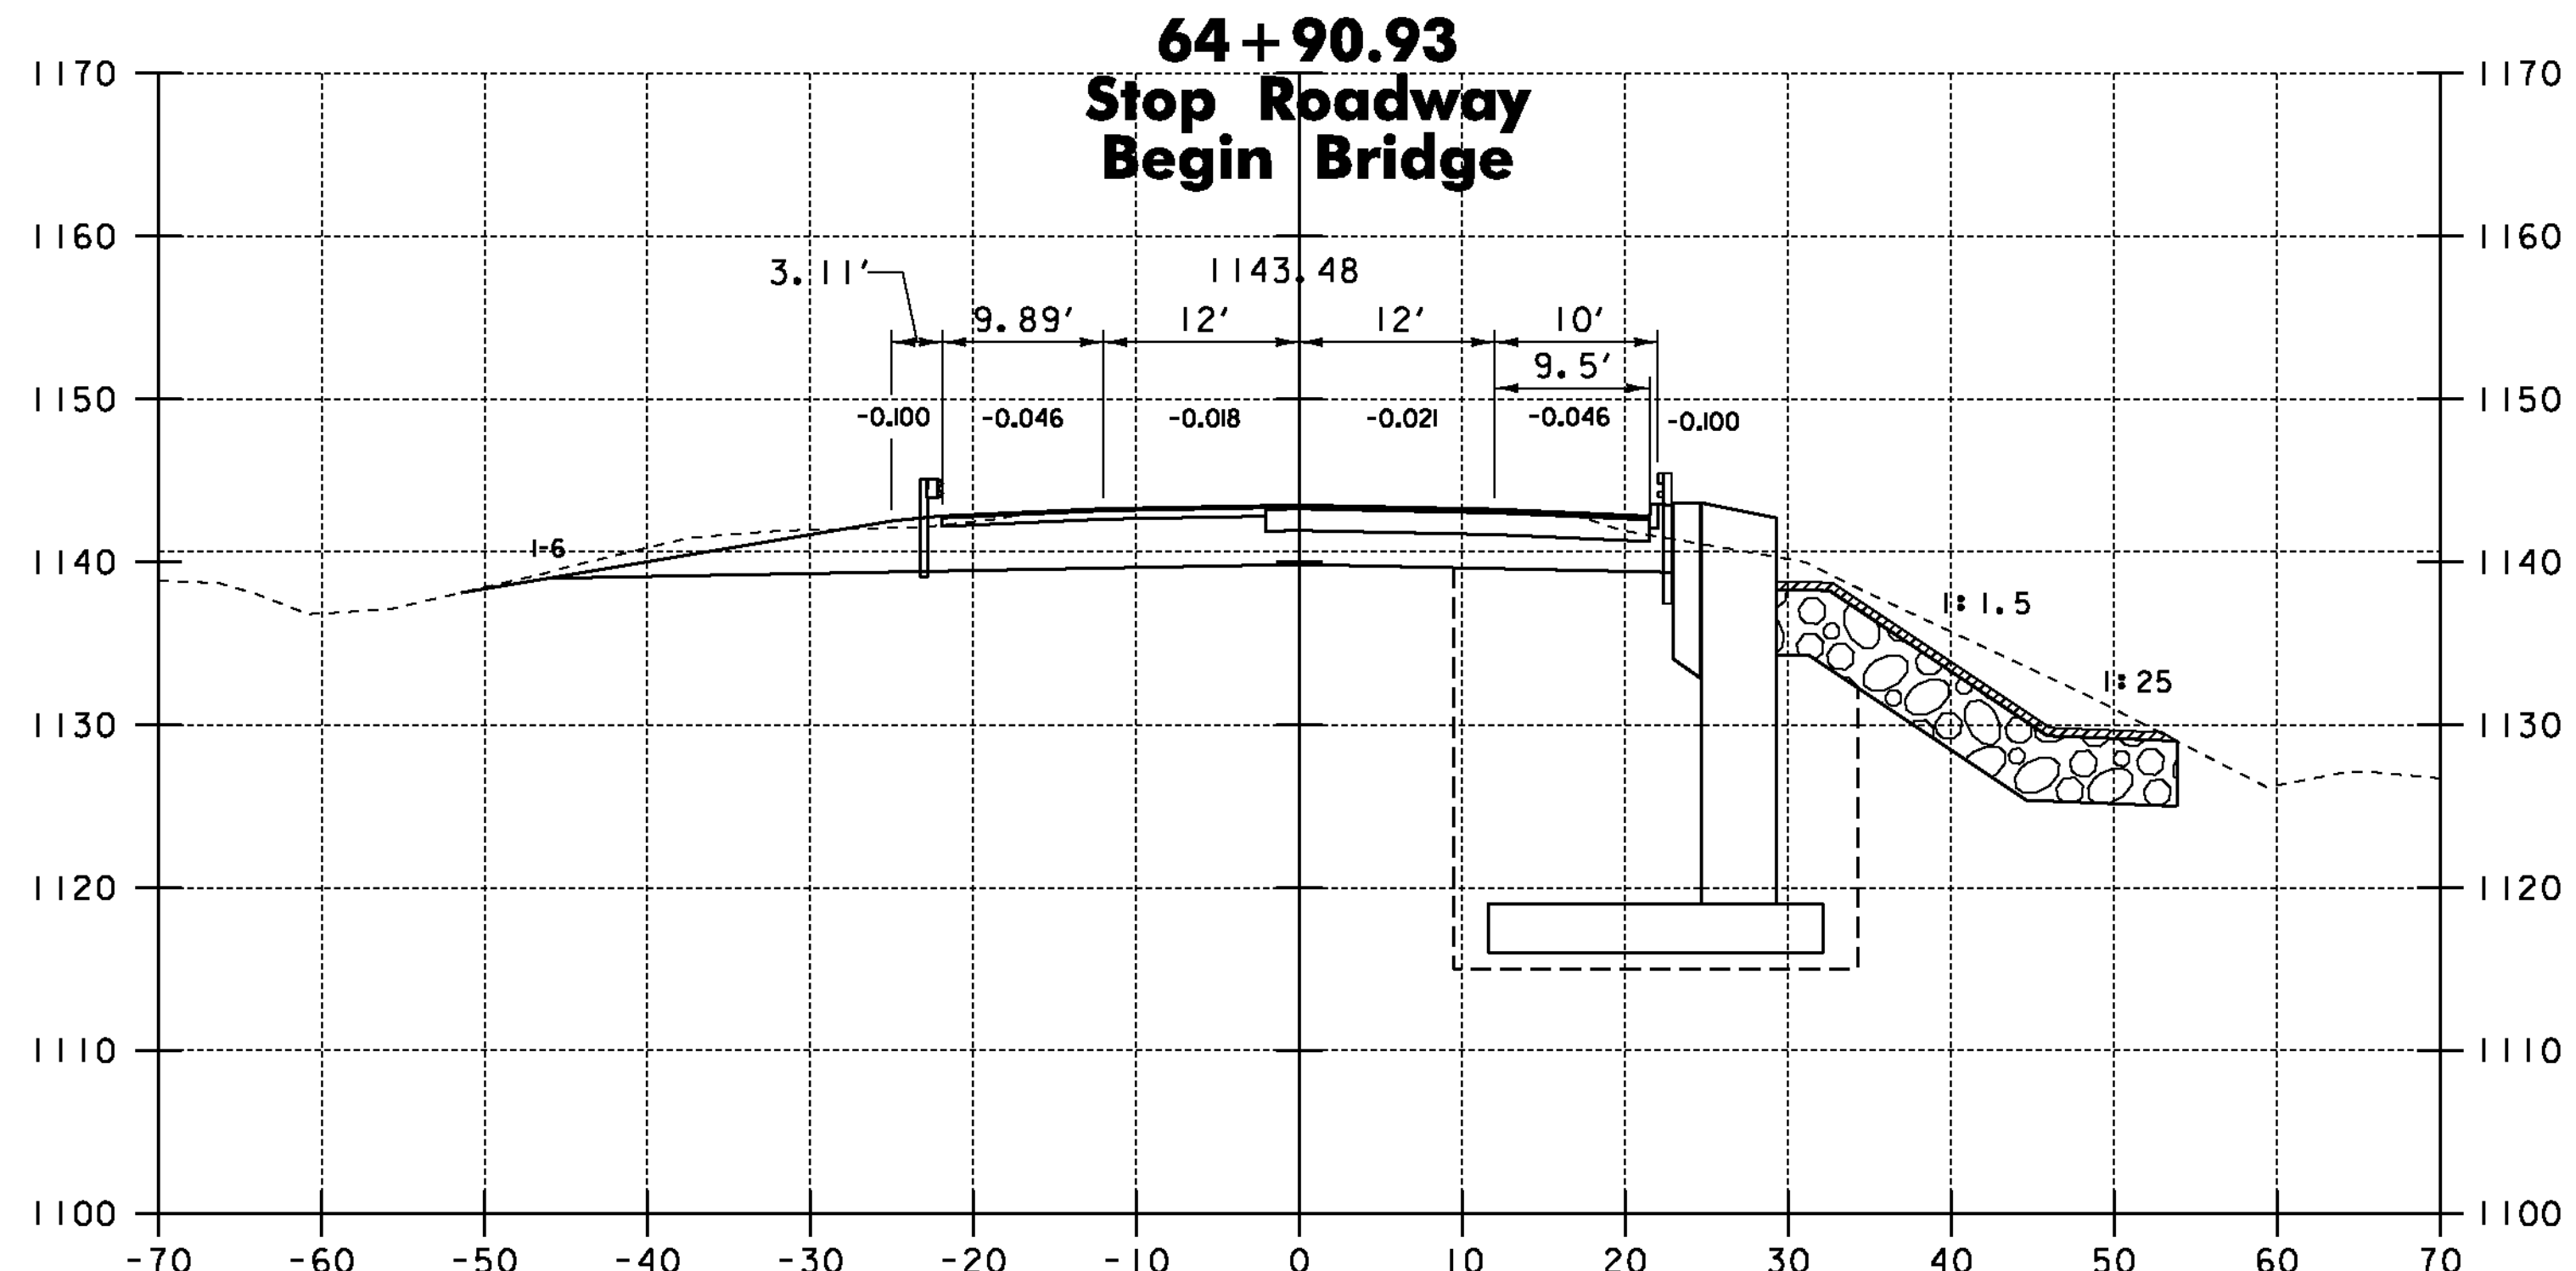


64+68

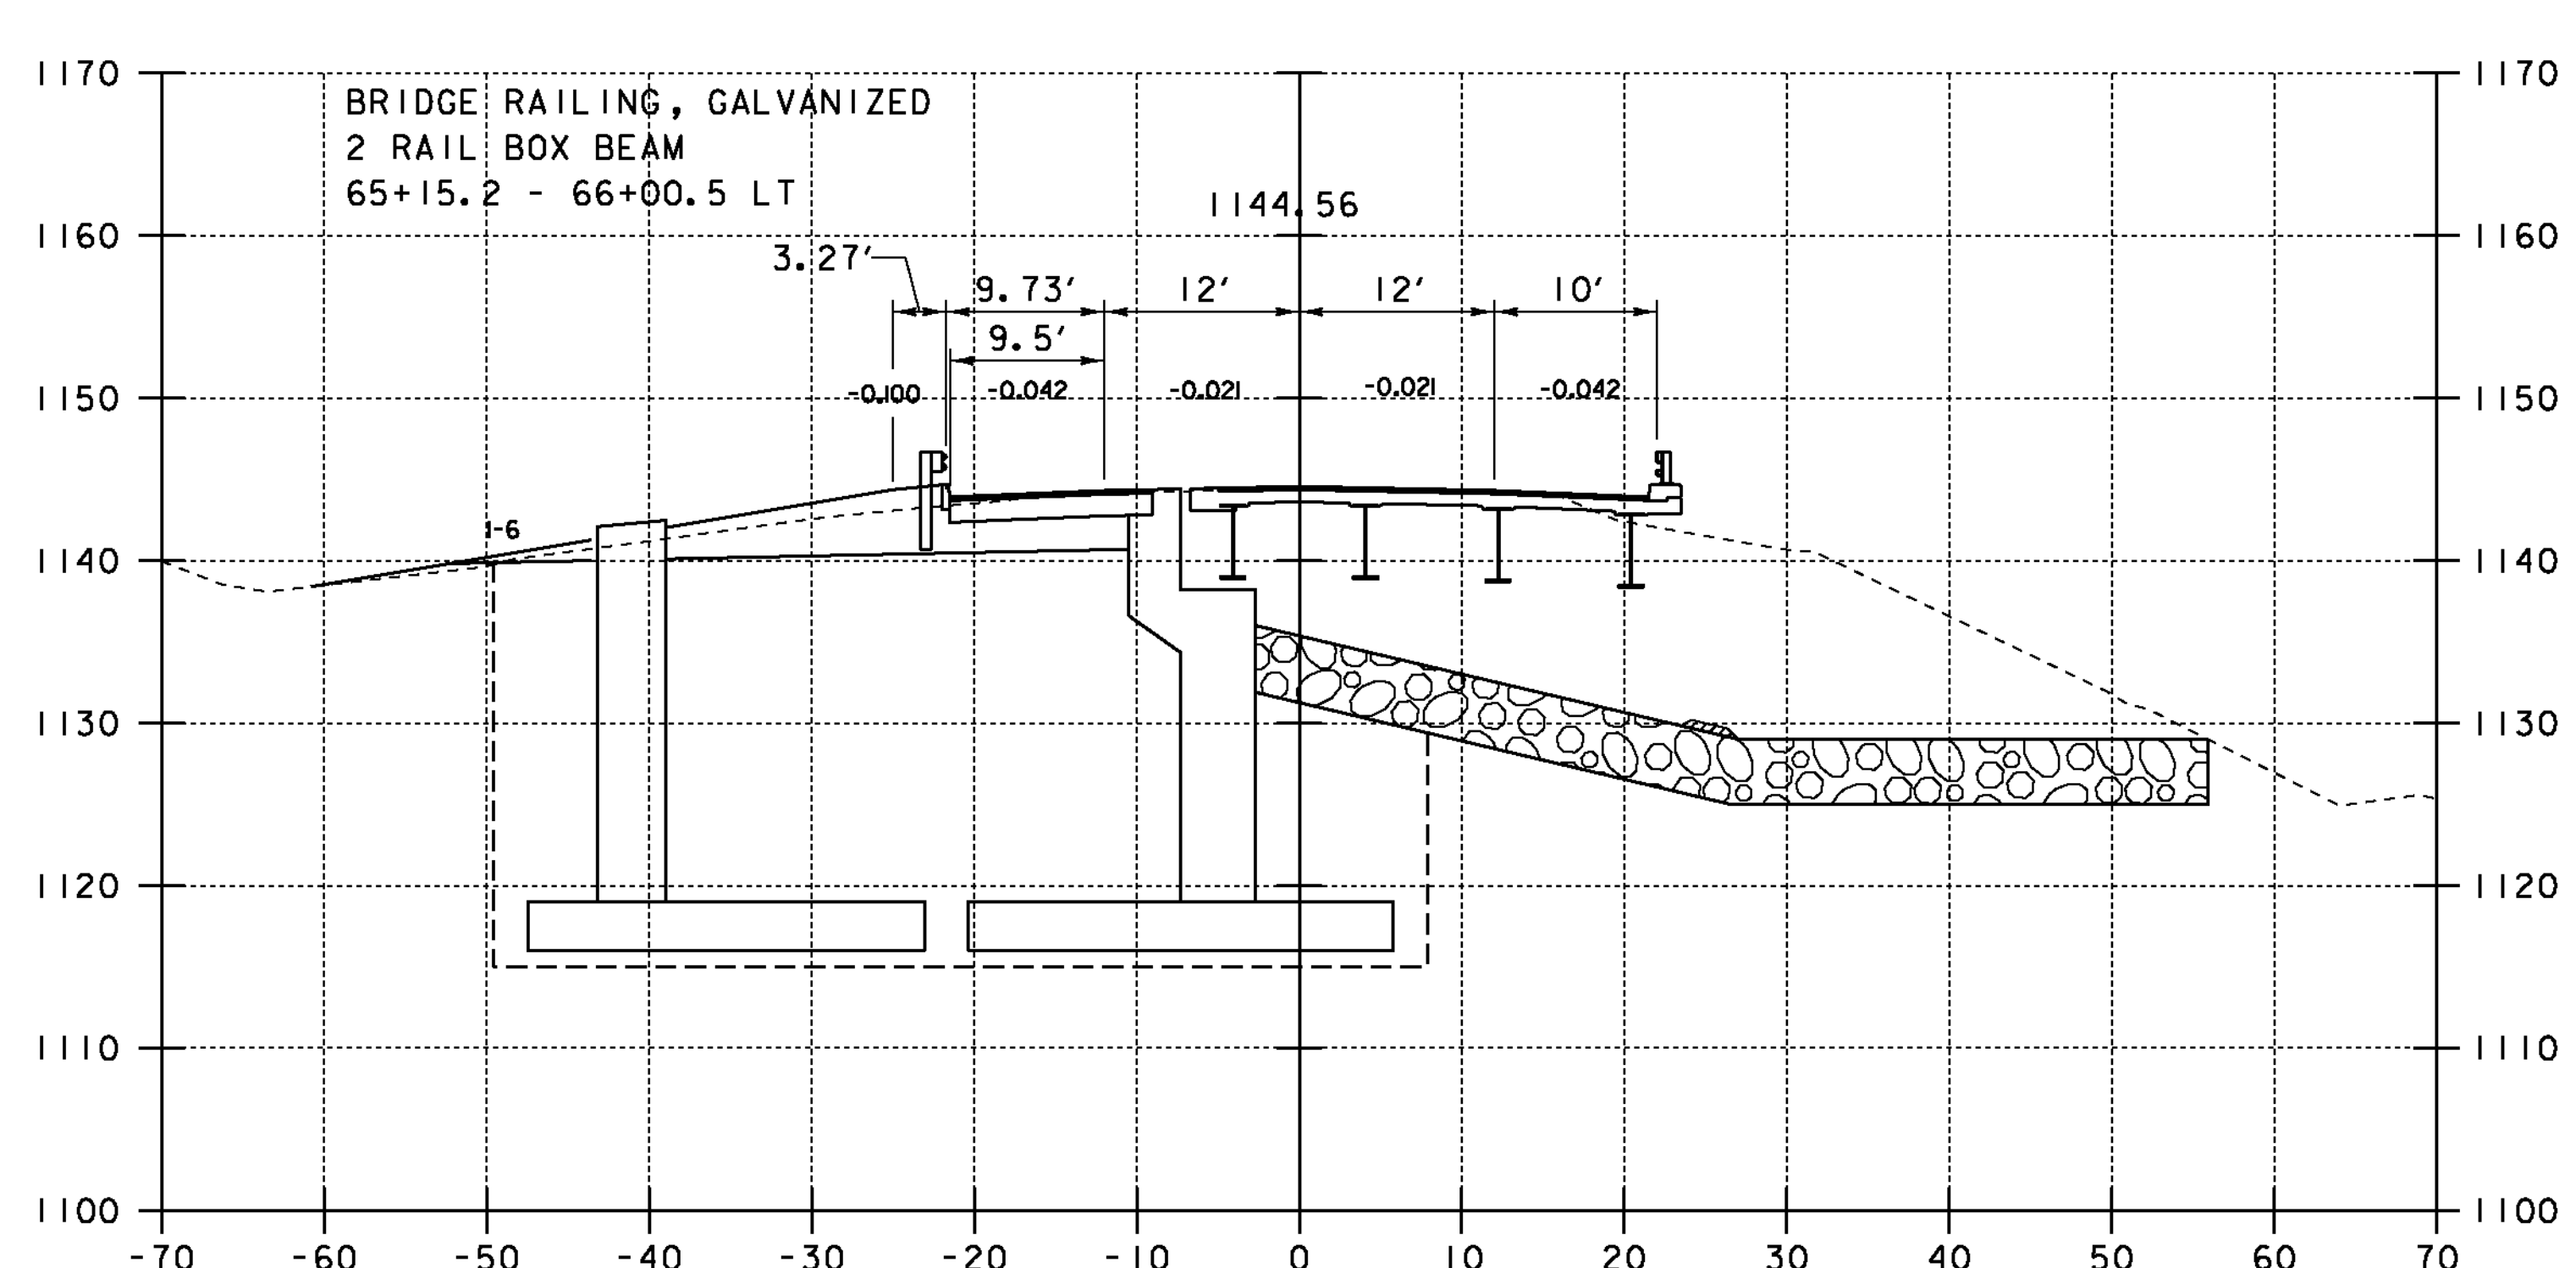


65+00

PROJECT NAME:	WOODFORD
PROJECT NUMBER:	ER BHF 010-1(44)
FILE NAME:	slb214xs.dgn
PROJECT LEADER:	C. CARLSON
DESIGNED BY:	M. EVANS-MONGEON
ROADWAY CROSS SECTIONS SHEET (3)	
PLOT DATE:	23-MAR-2012
DRAWN BY:	EVANS-MONGEON
CHECKED BY:	
SHEET	38 OF 58

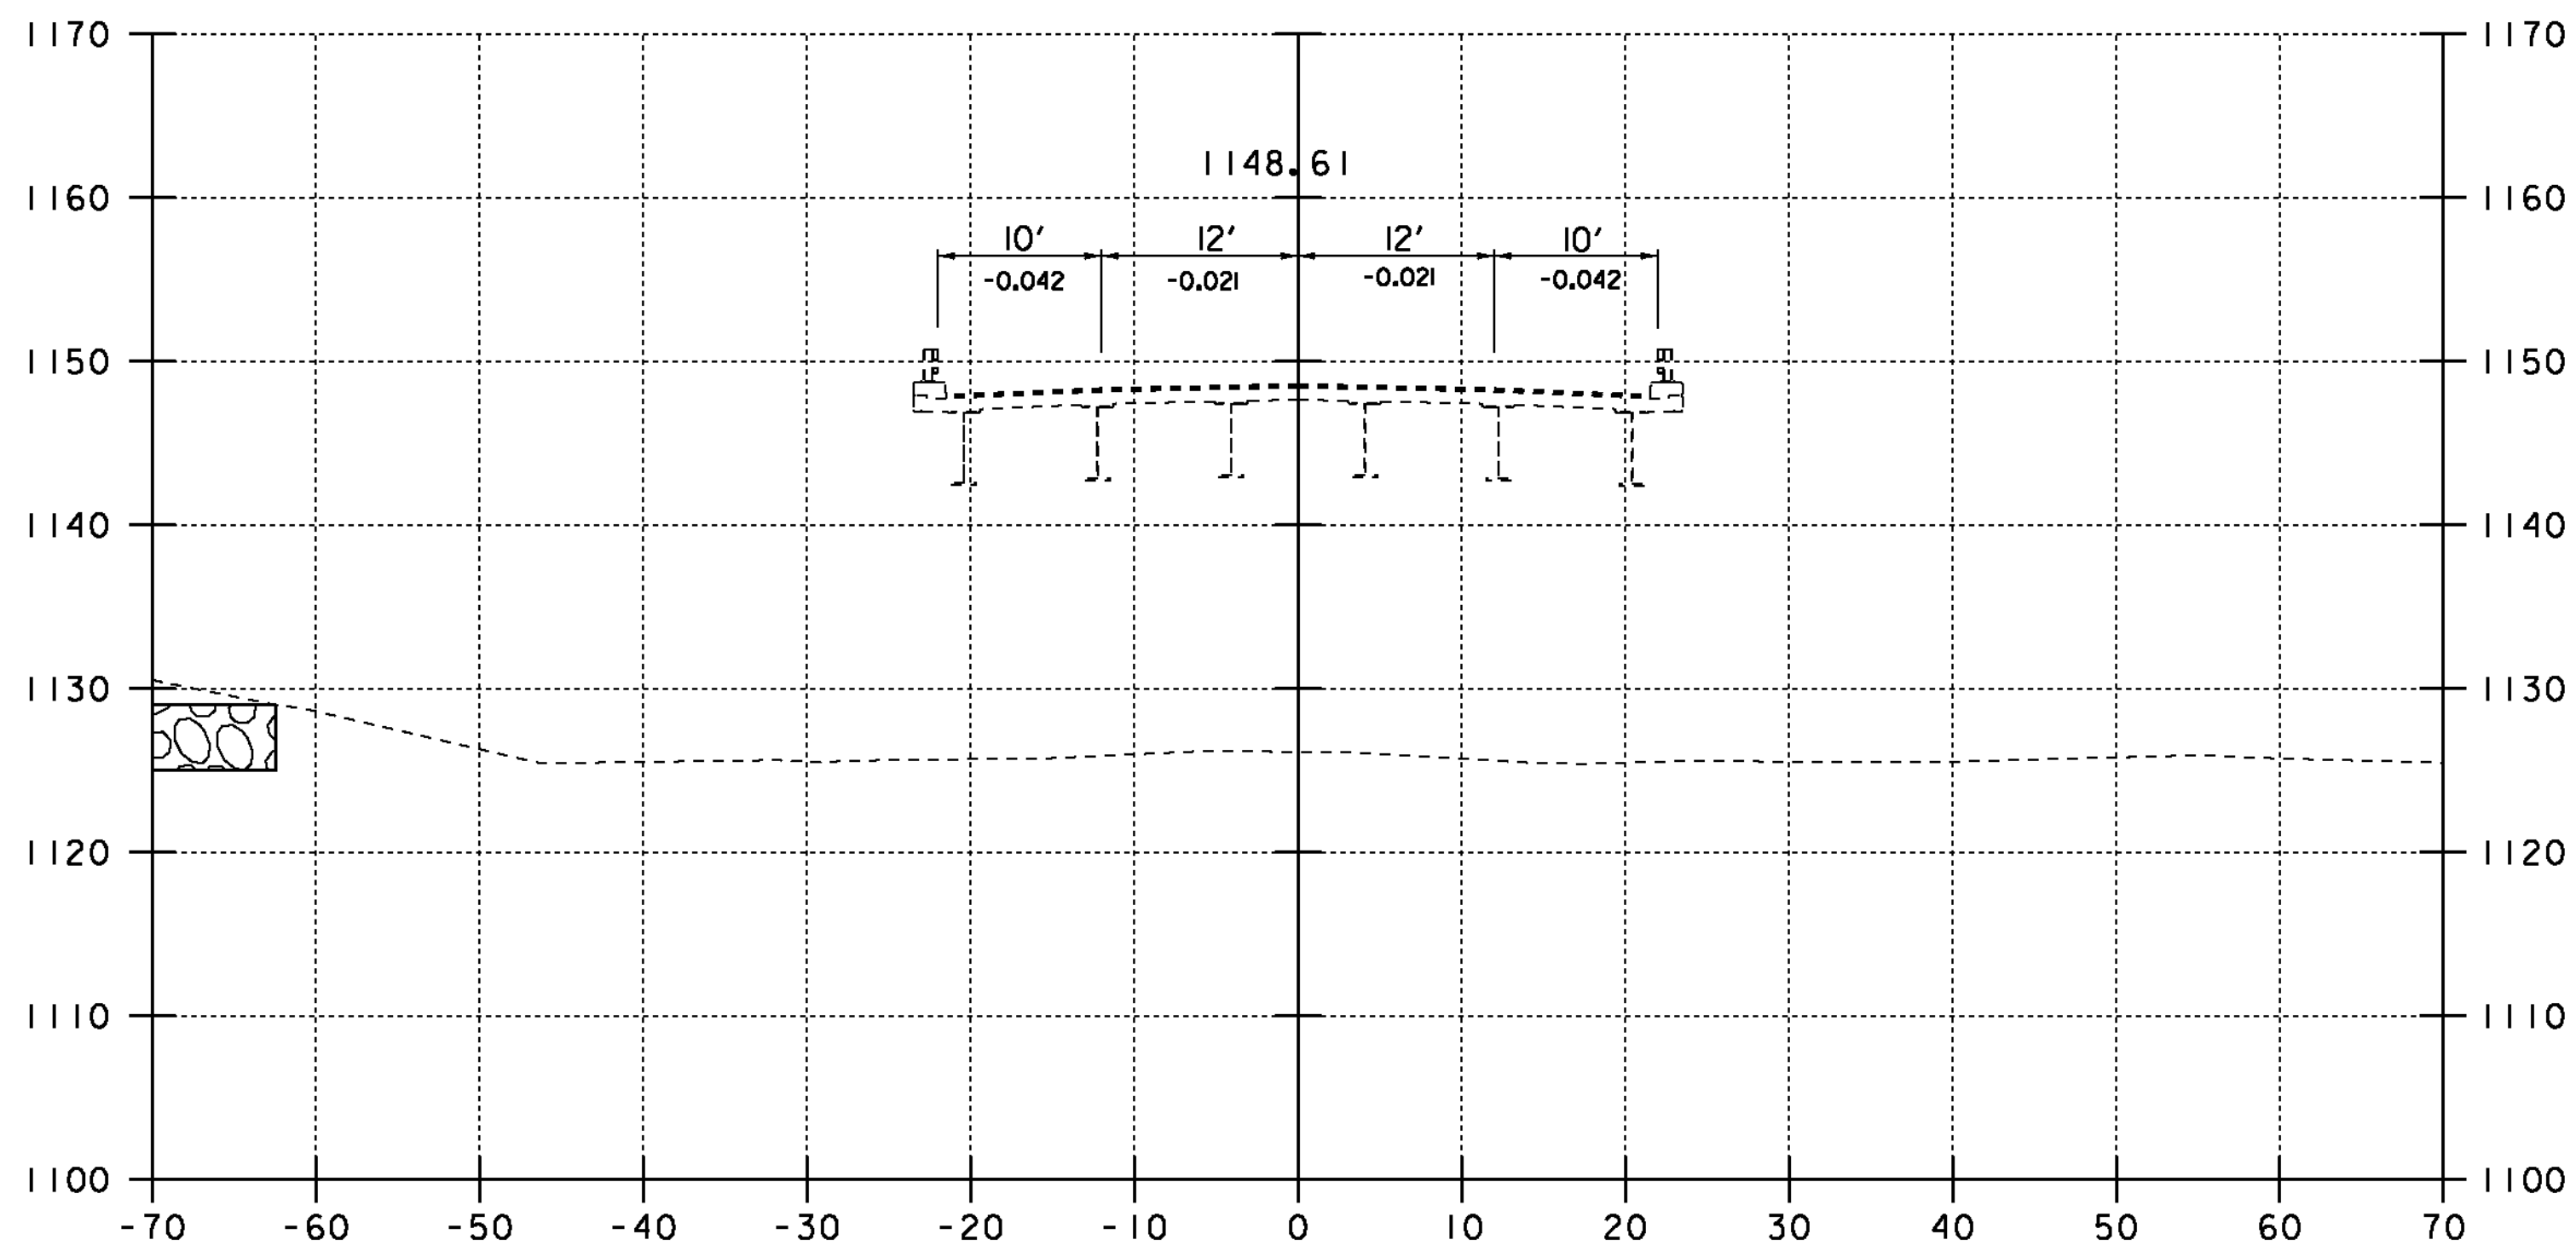


**66+25.00  
END APPROACH  
MATCH EXISTING**

**66+50**

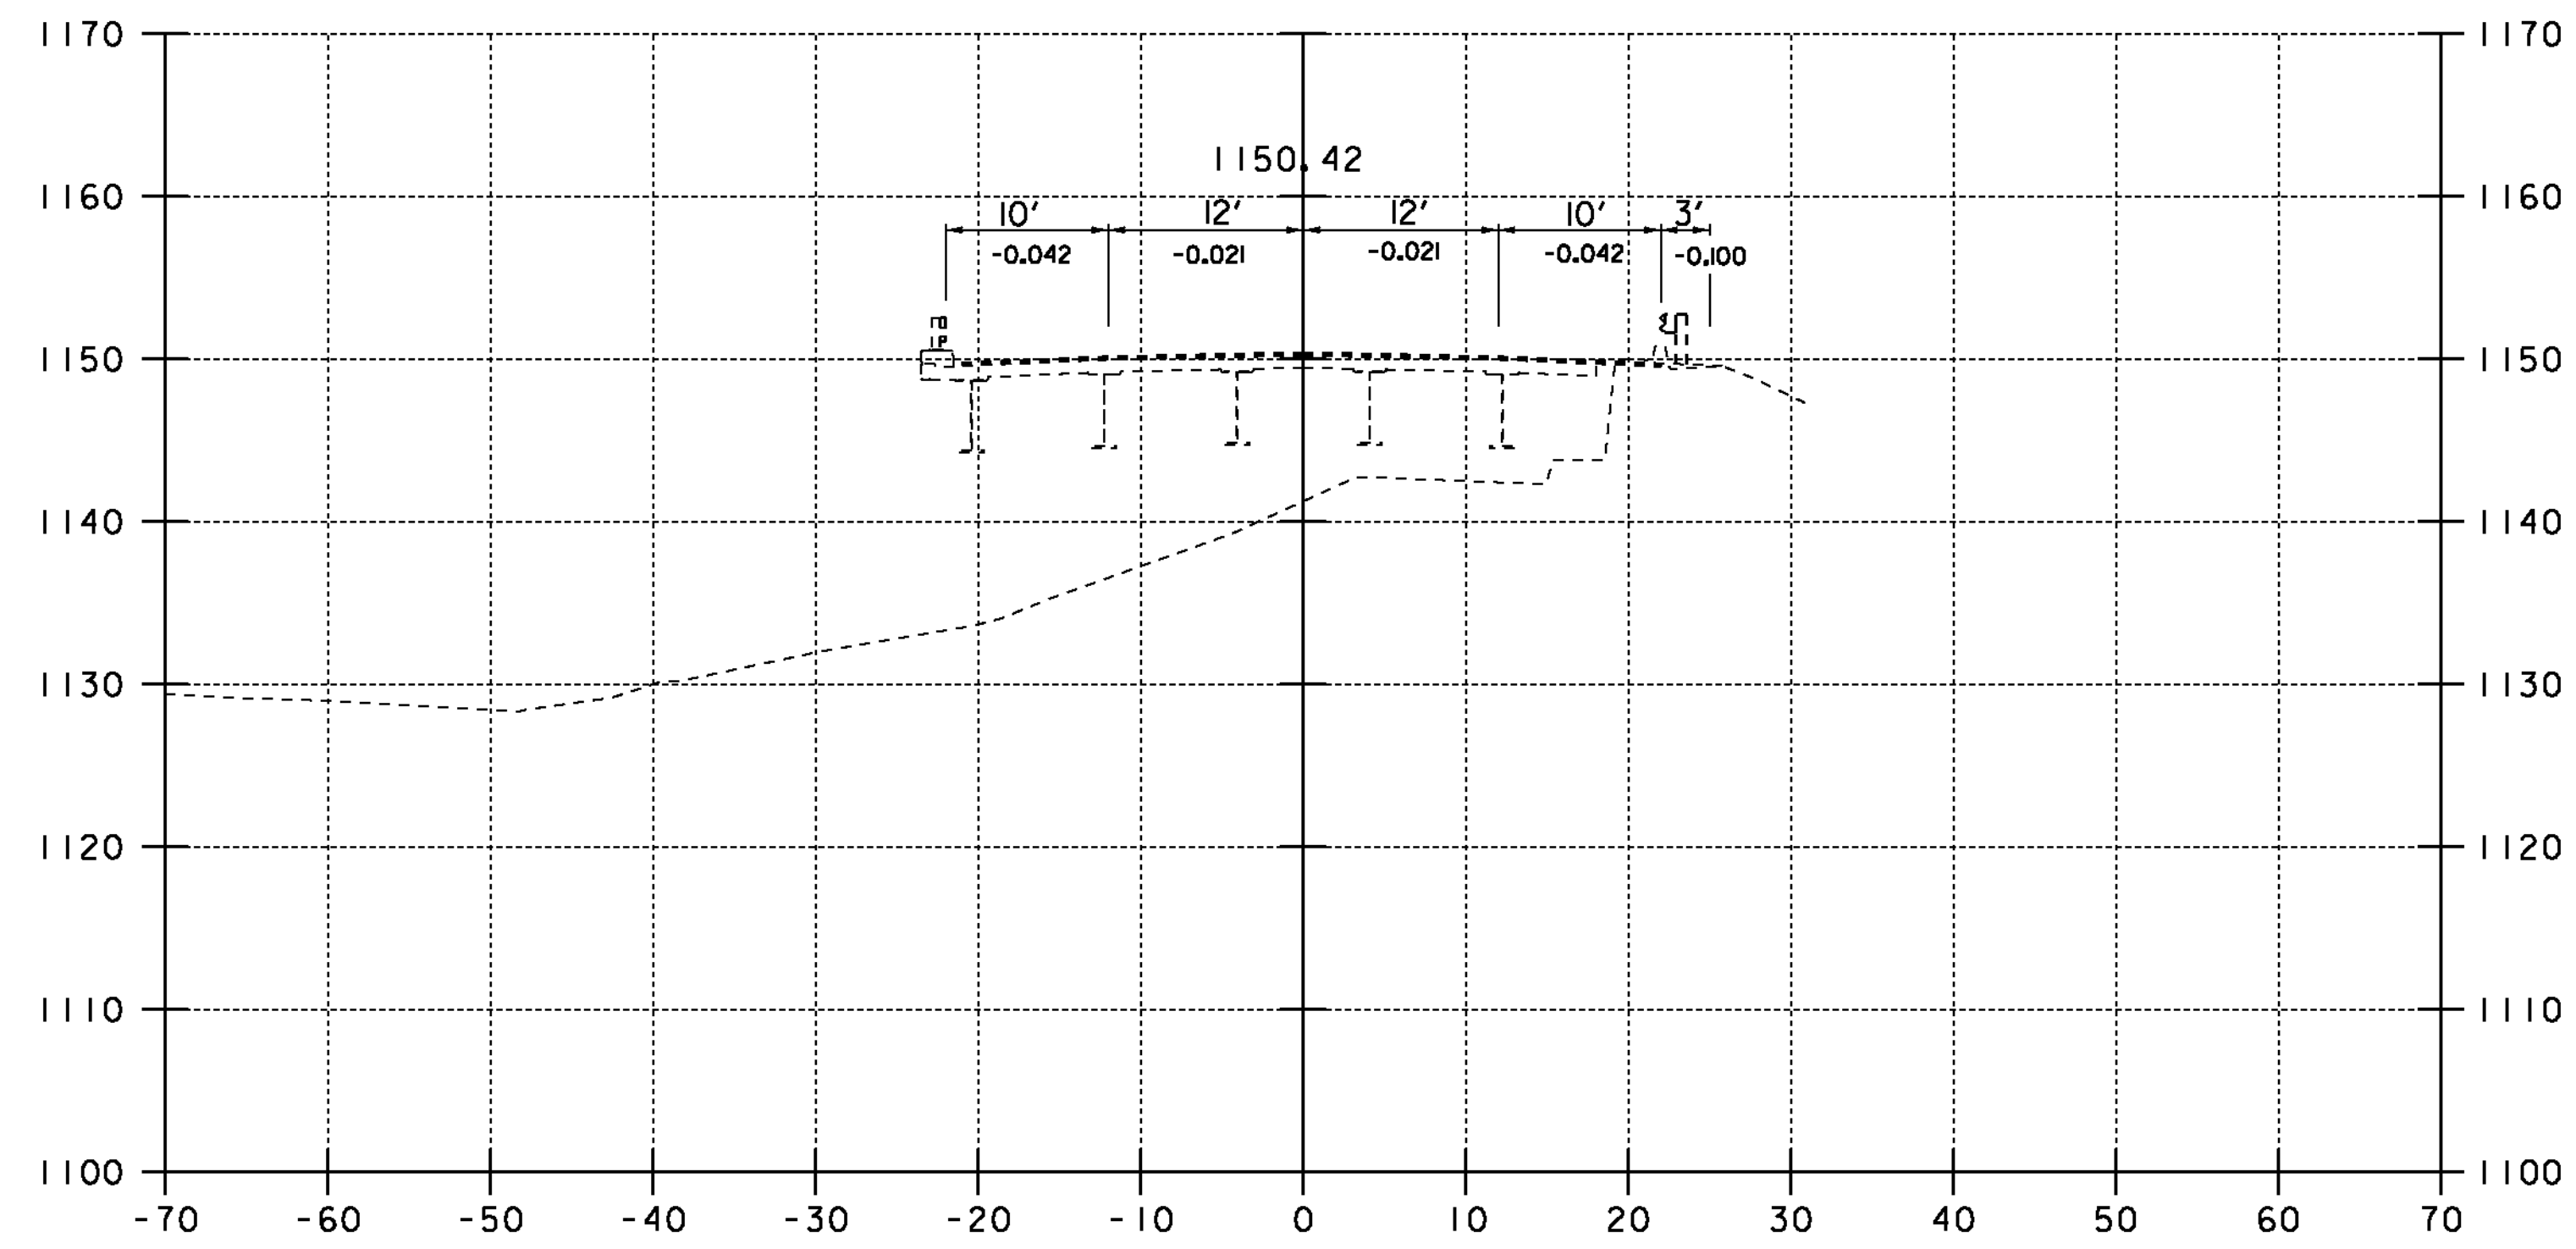


**67+50**

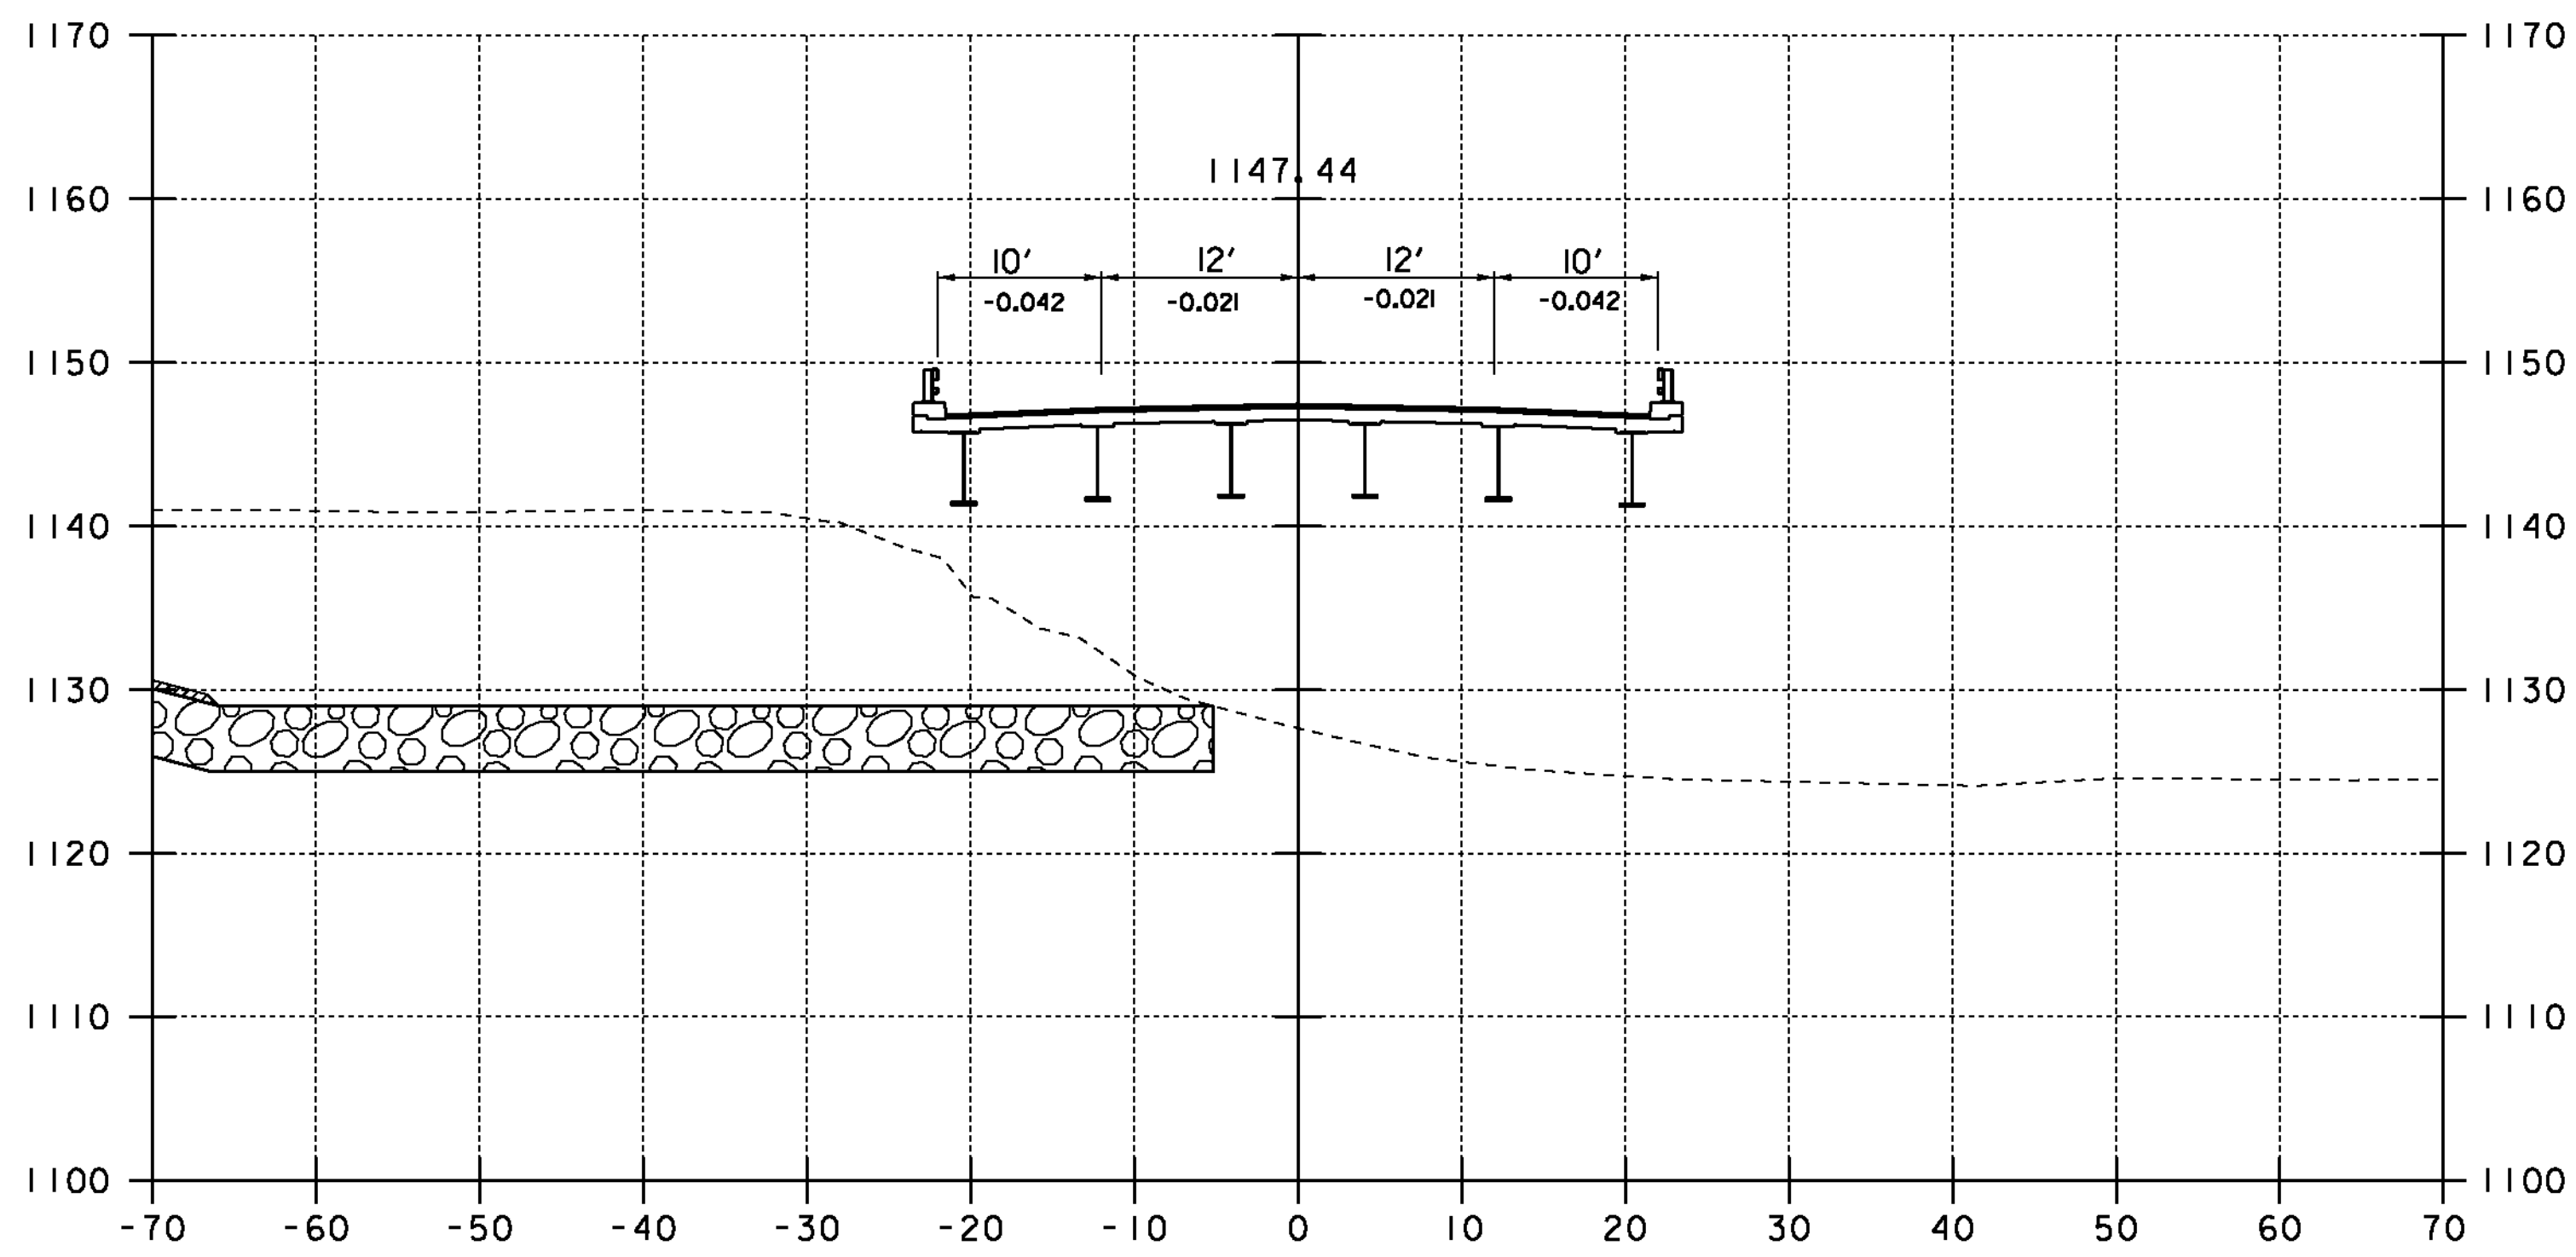




**66+00.50  
END BRIDGE WORK  
END PROJECT  
BEGIN APPROACH**

**66+00**



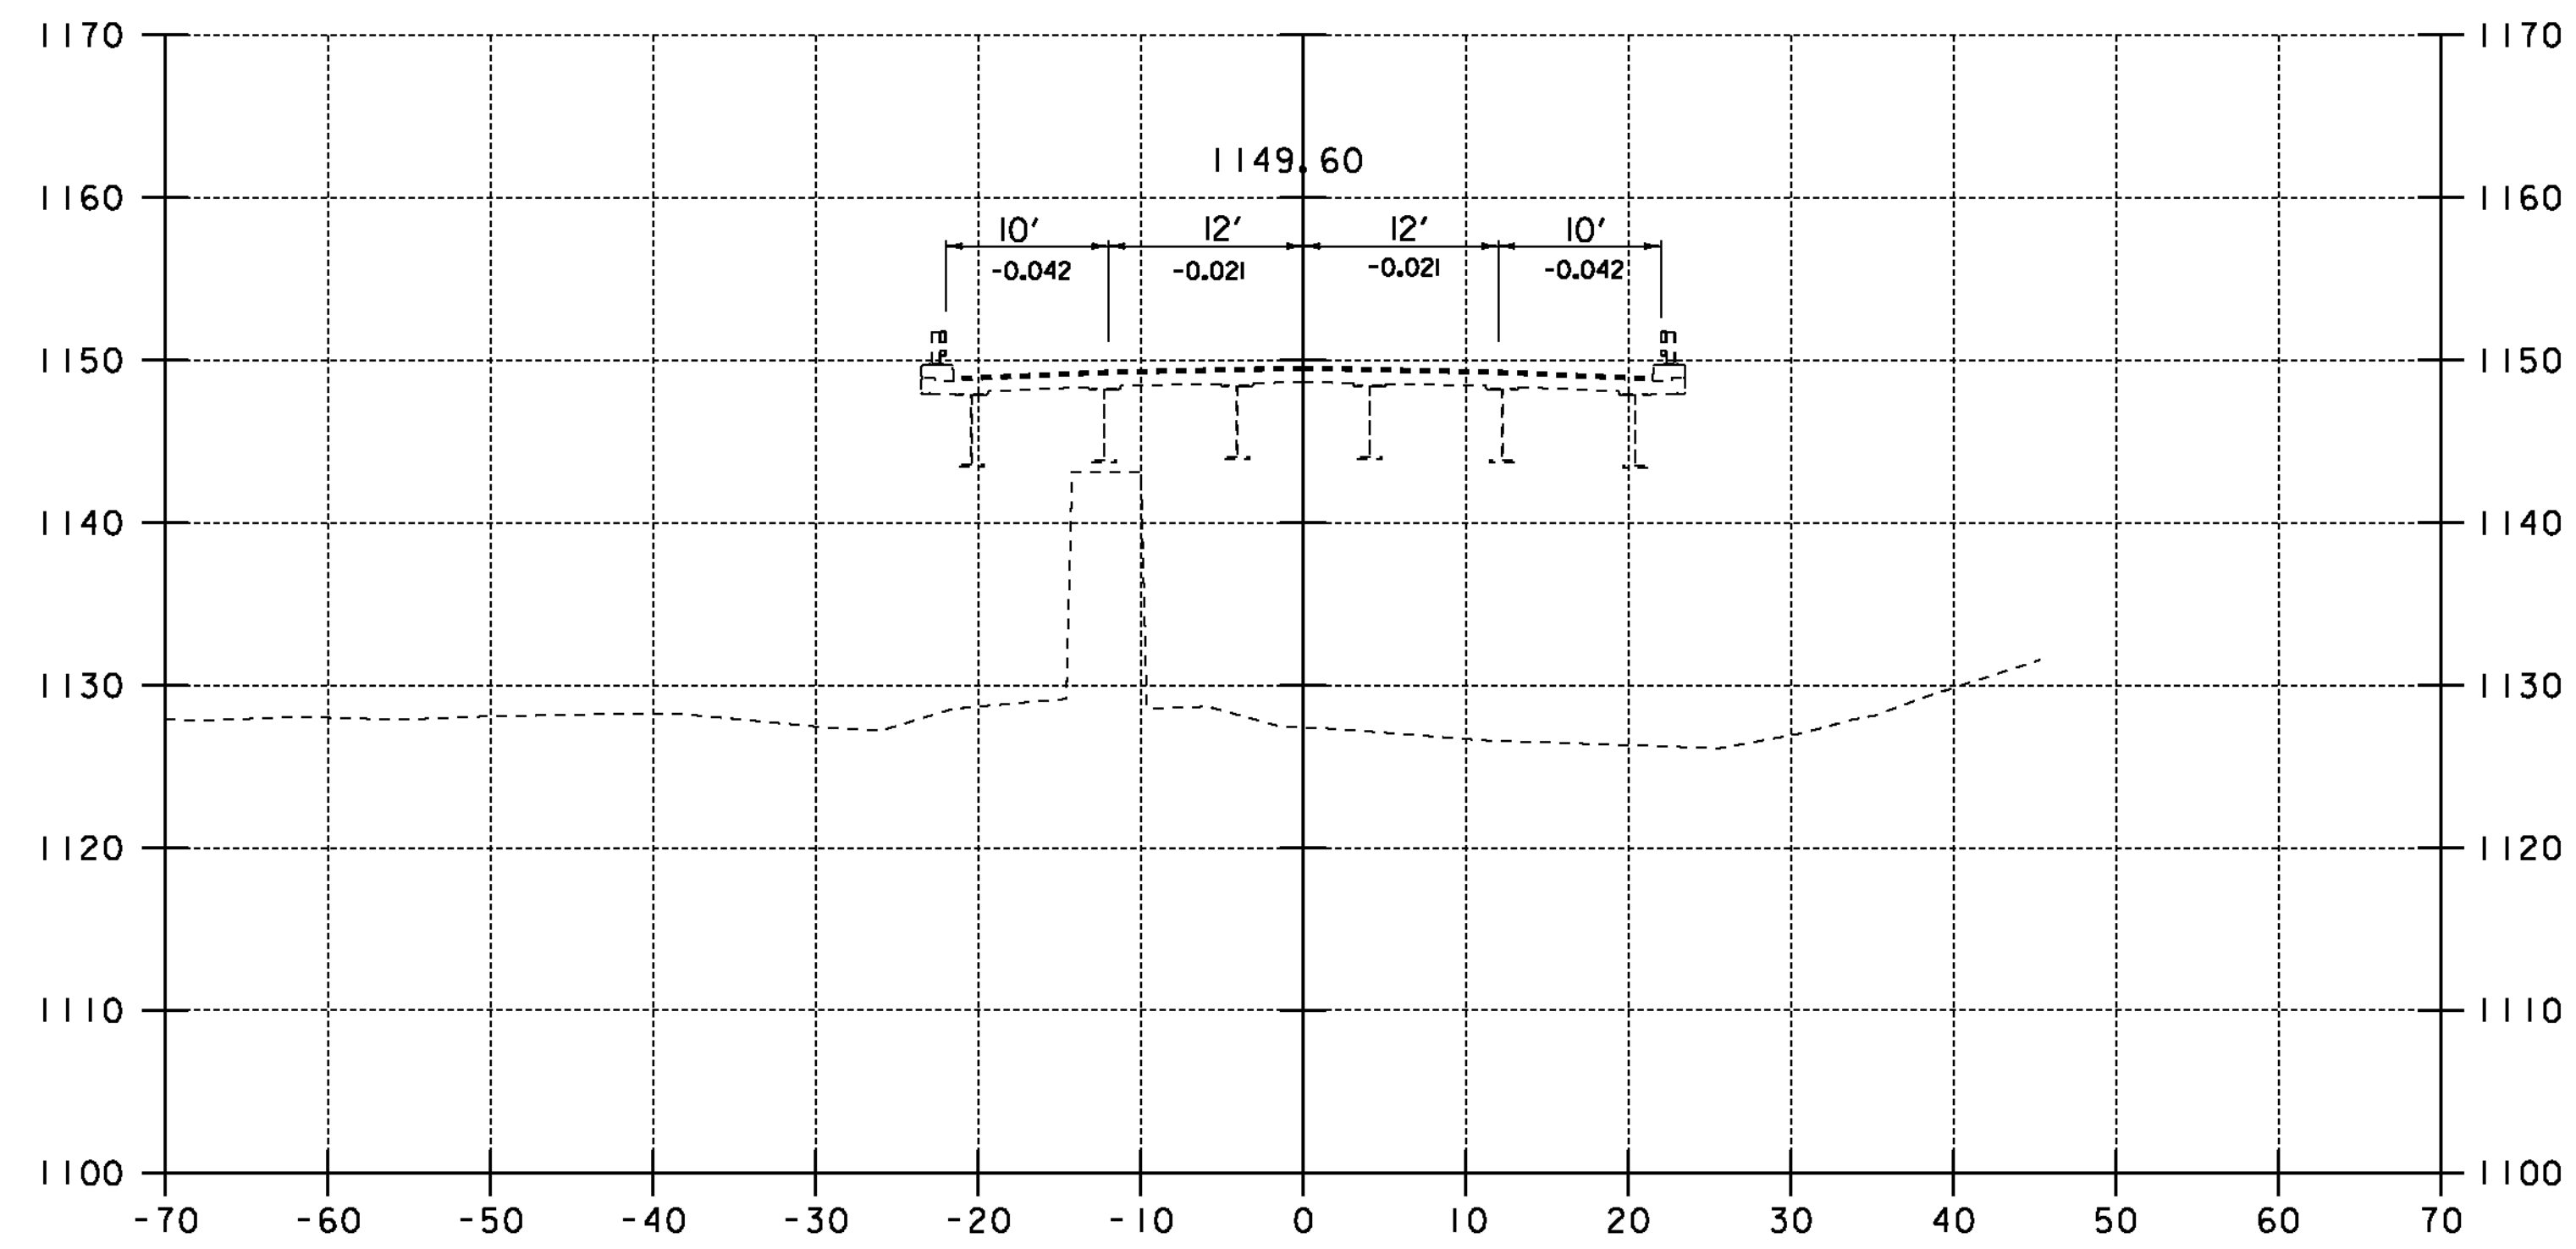


**67+00**




PROJECT NAME: WOODFORD	
PROJECT NUMBER: ER BHF 010-1(44)	
FILE NAME: slib214xs.dgn	PLOT DATE: 23-MAR-2012
PROJECT LEADER: C. CARLSON	DRAWN BY: EVANS-MONGEON
DESIGNED BY: M.EVANS-MONGEON	CHECKED BY:
ROADWAY CROSS SECTIONS SHEET (4)	SHEET 39 OF 58

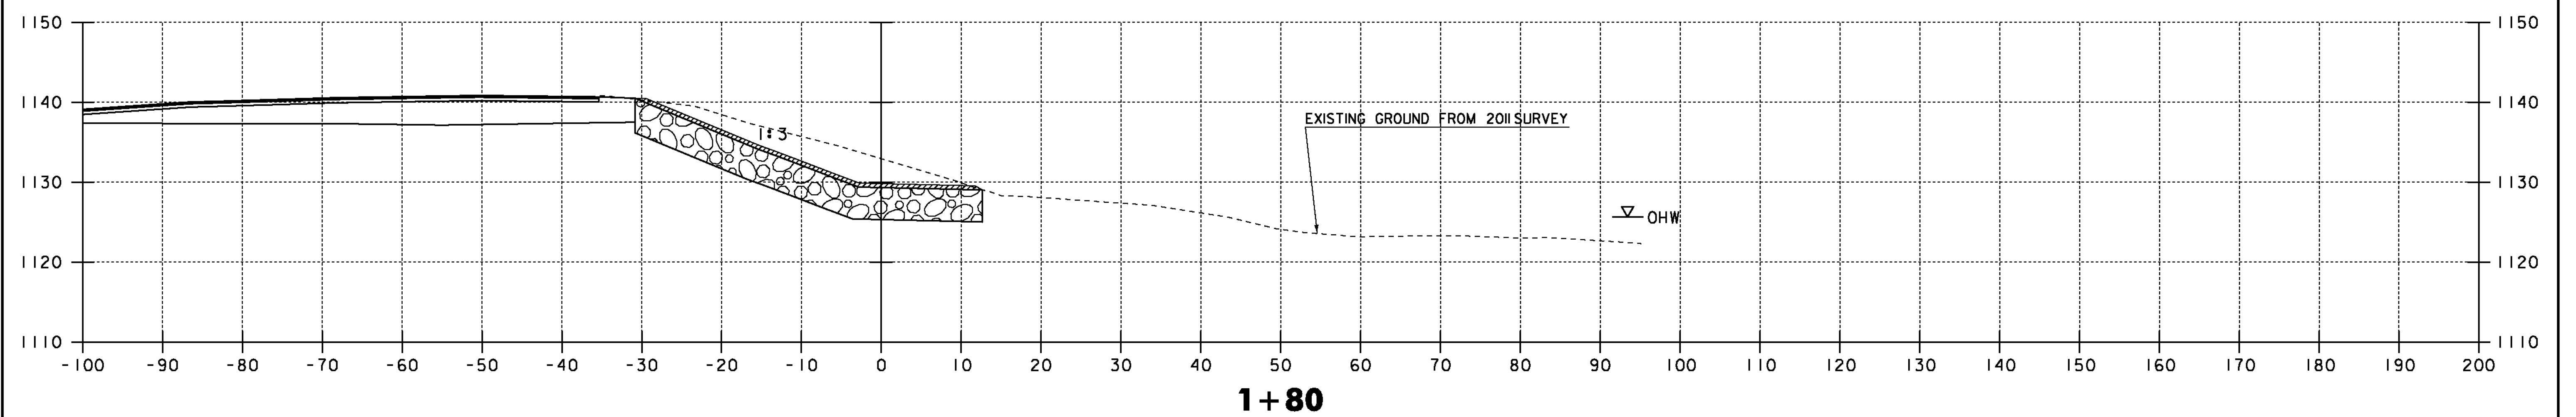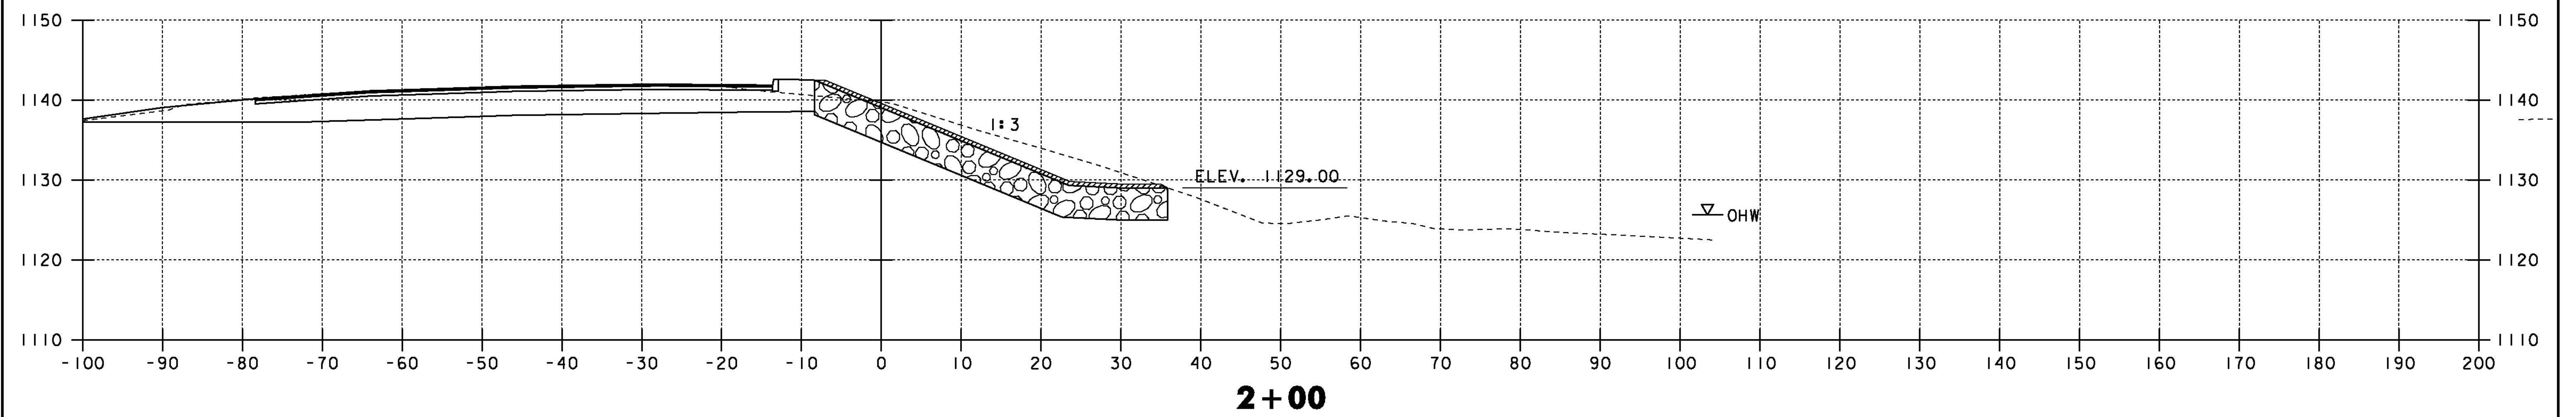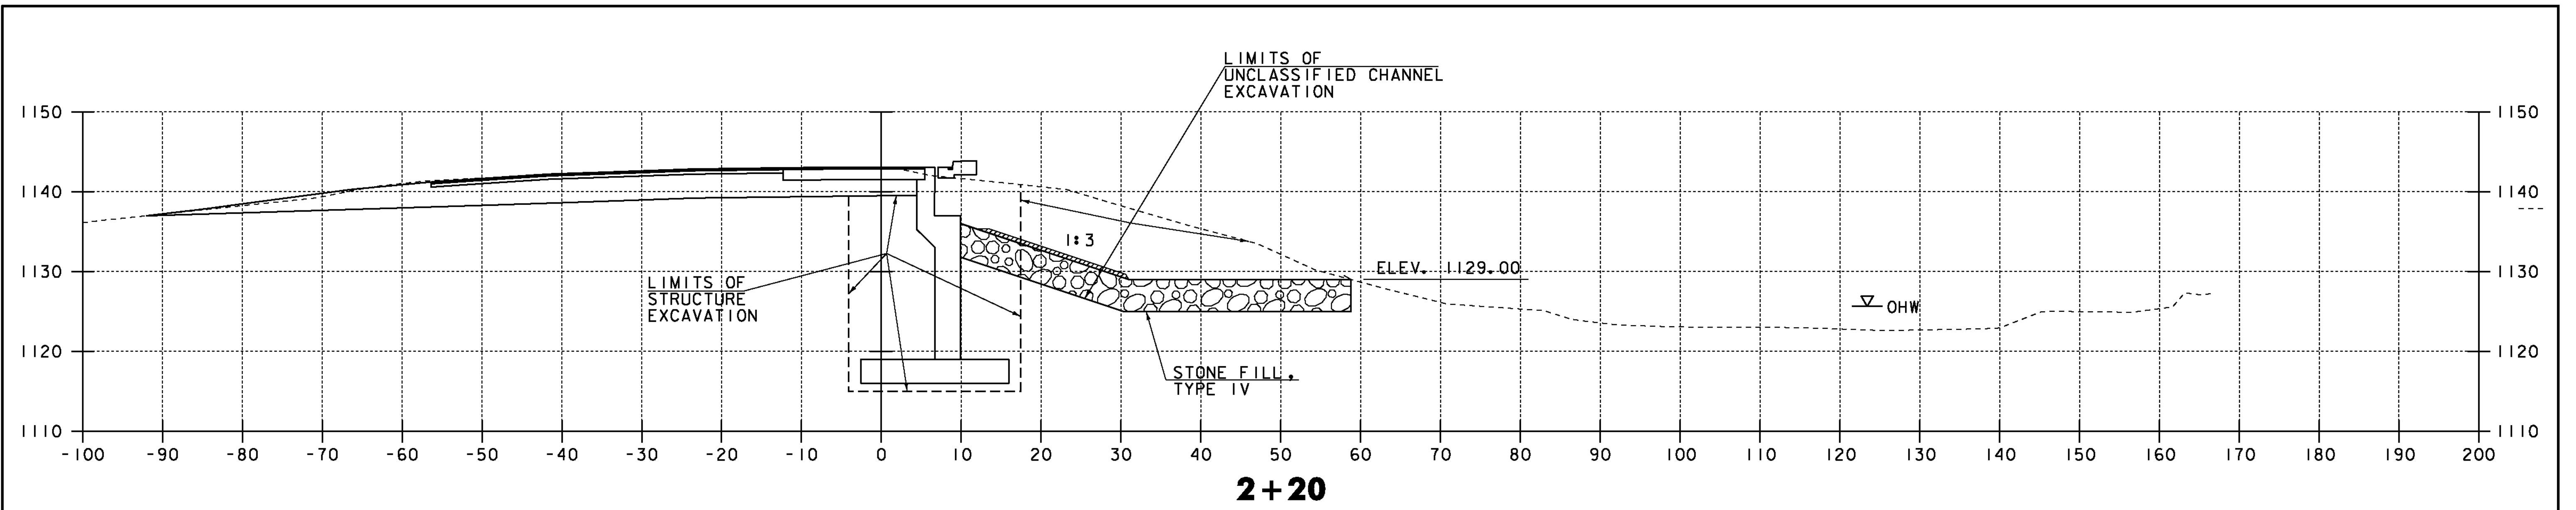

PROJECT NAME:	WOODFORD
PROJECT NUMBER:	ER BHF 010-1(44)
FILE NAME:	sl1b214ch xs.dgn
PROJECT LEADER:	C. CARLSON
DESIGNED BY:	M. EVANS-MONGEON
CHANNEL CROSS SECTIONS SHEET (1)	
PLOT DATE:	23-MAR-2012
DRAWN BY:	G. ROY
CHECKED BY:	EVANS-MONGEON
SHEET 40 OF 58	

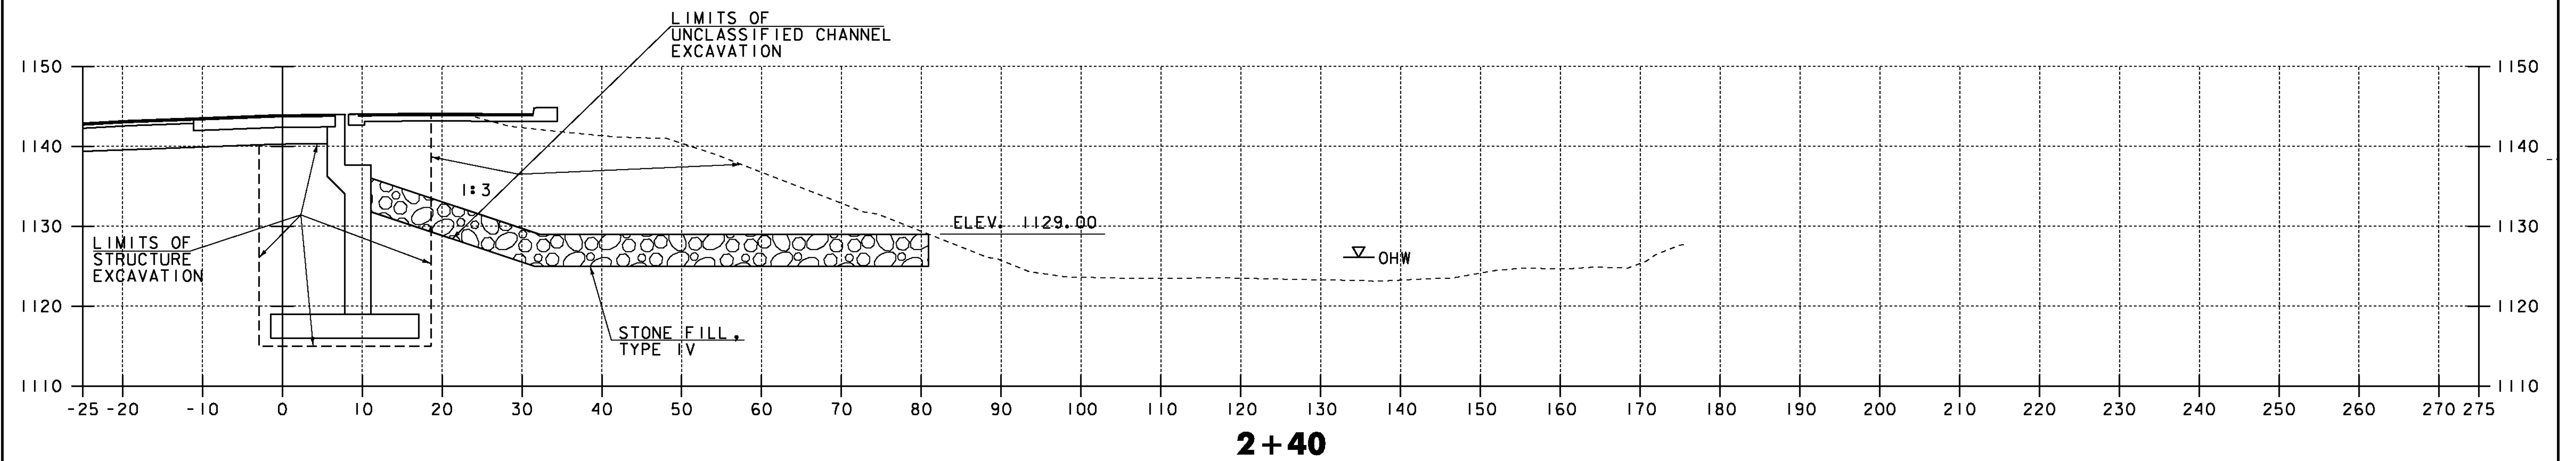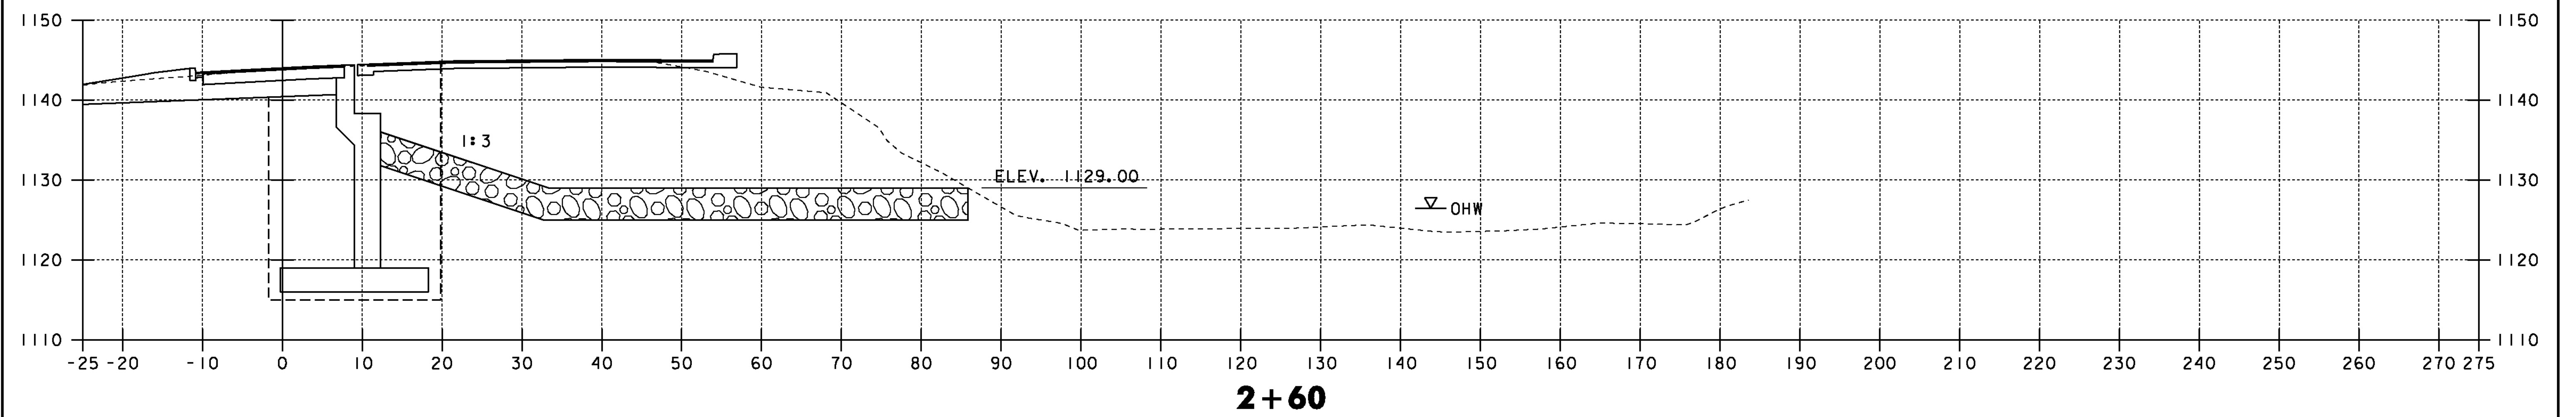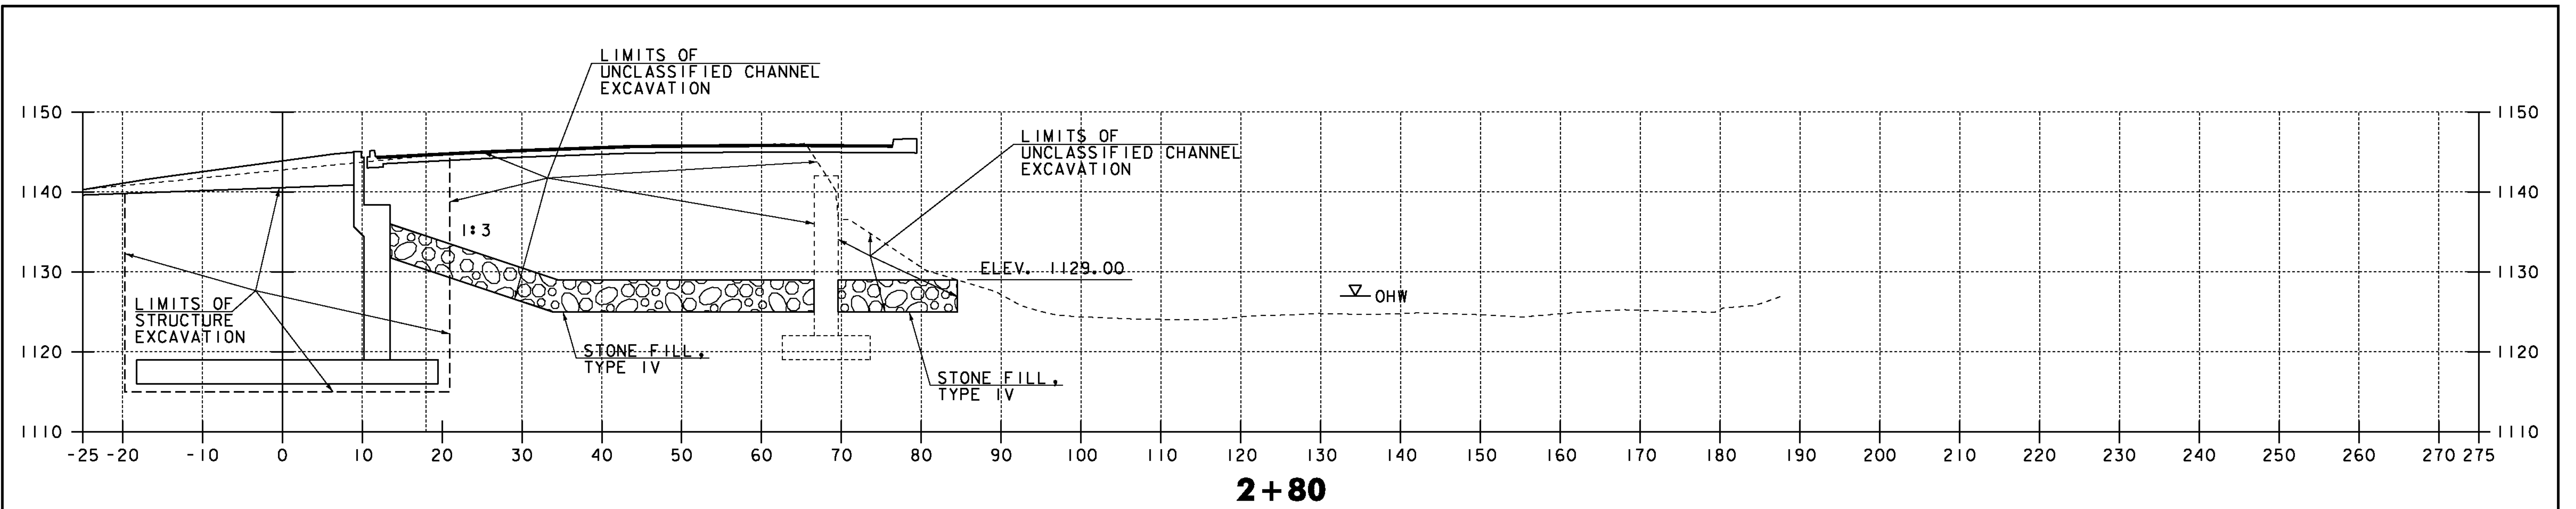


PROJECT NAME: WOODFORD	
PROJECT NUMBER: ER BHF 010-1(44)	
FILE NAME: sl1b214ch xs.dgn	PLOT DATE: 23-MAR-2012
PROJECT LEADER: C. CARLSON	DRAWN BY: G. ROY
DESIGNED BY: M. EVANS-MONGEON	CHECKED BY: EVANS-MONGEON
CHANNEL CROSS SECTIONS SHEET (2)	SHEET 41 OF 58

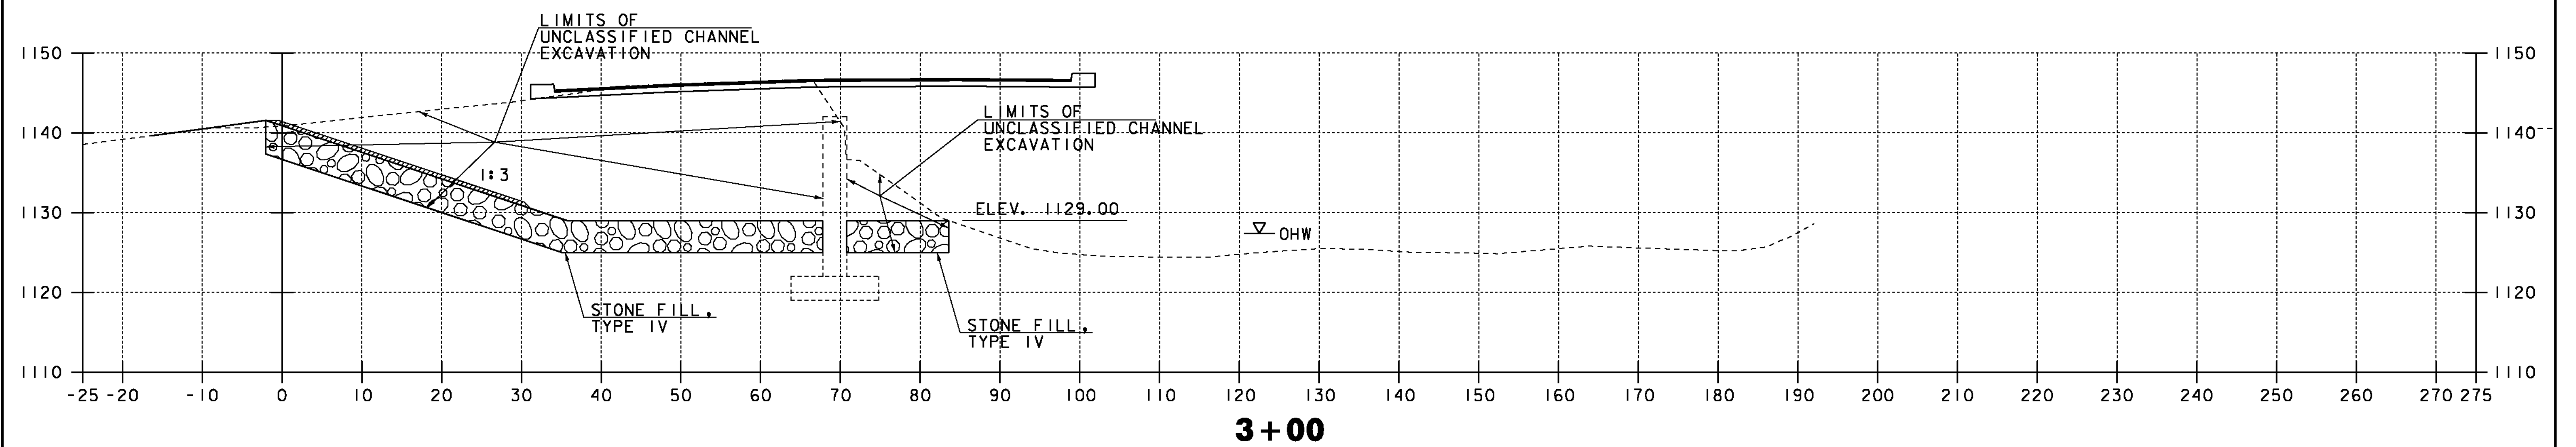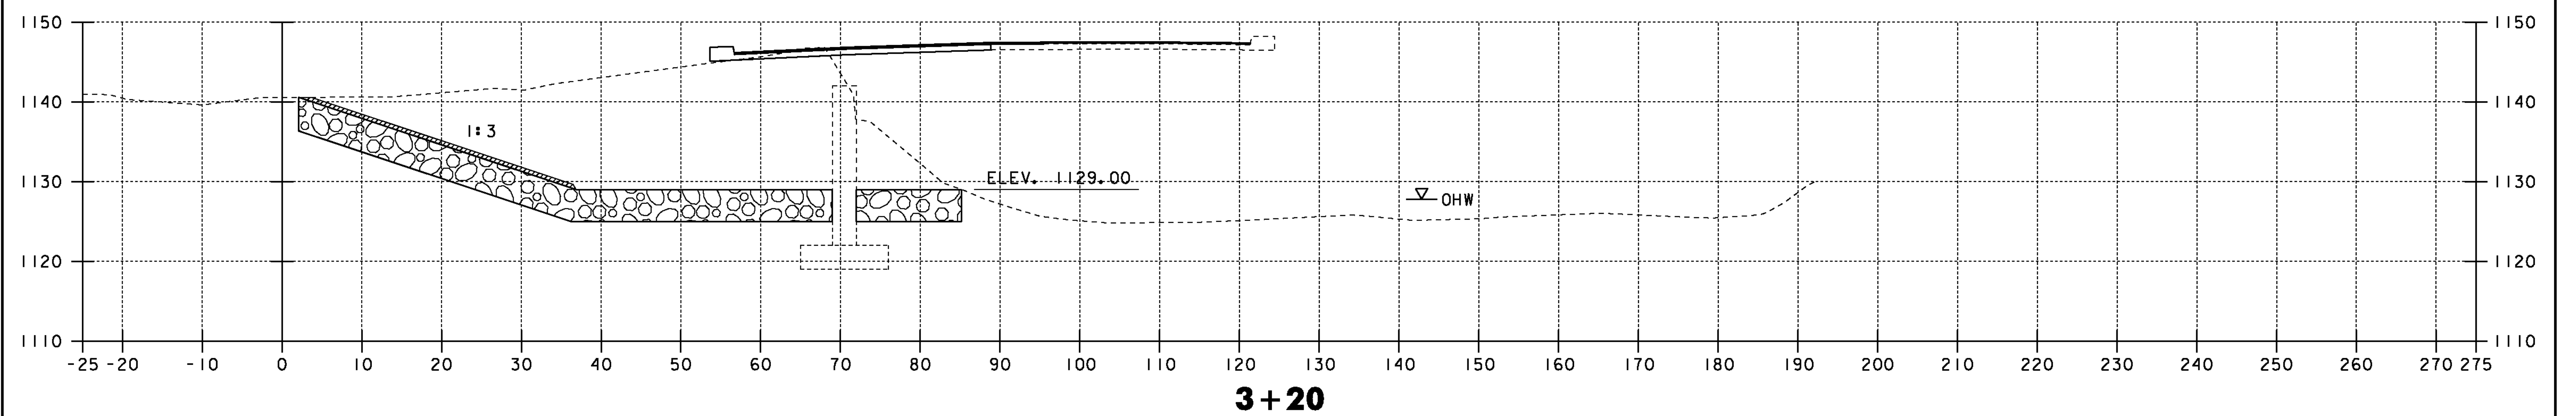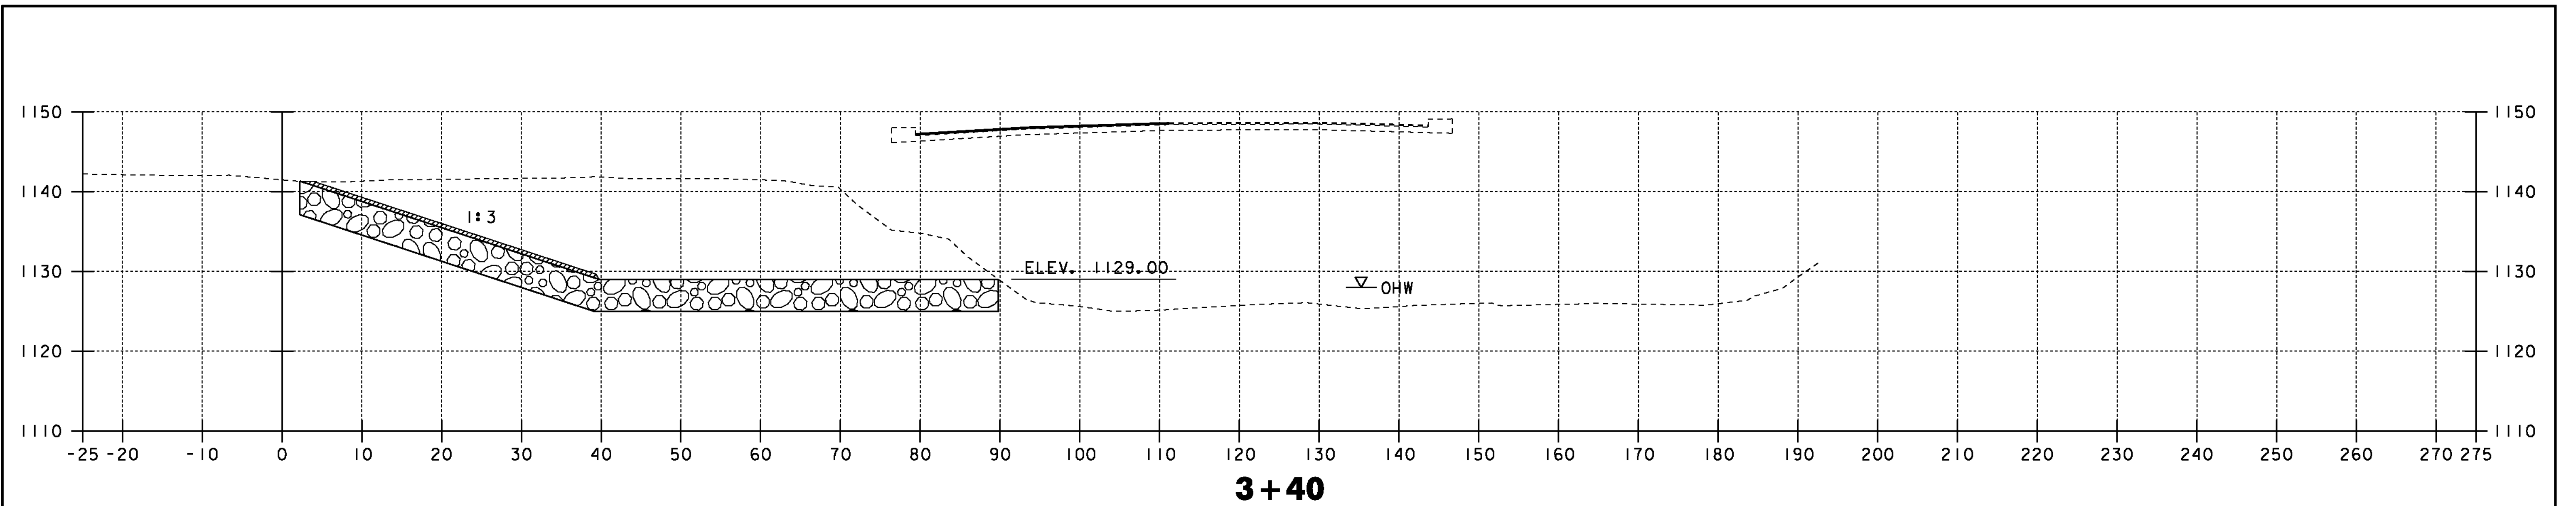


PROJECT NAME:	WOODFORD
PROJECT NUMBER:	ER BHF 010-1(44)
FILE NAME:	sl1b214ch xs.dgn
PROJECT LEADER:	C. CARLSON
DESIGNED BY:	M. EVANS-MONGEON
CHANNEL CROSS SECTIONS SHEET (3)	
PLOT DATE:	23-MAR-2012
DRAWN BY:	G. ROY
CHECKED BY:	EVANS-MONGEON
SHEET	42 OF 58


STA. 4+44.4 RT.  
 END UNCLASSIFIED CHANNEL EXCAVATION  
 GEOTEXTILE UNDER STONE FILL  
 STONE FILL TYPE IV  
 GRUBBING MATERIAL

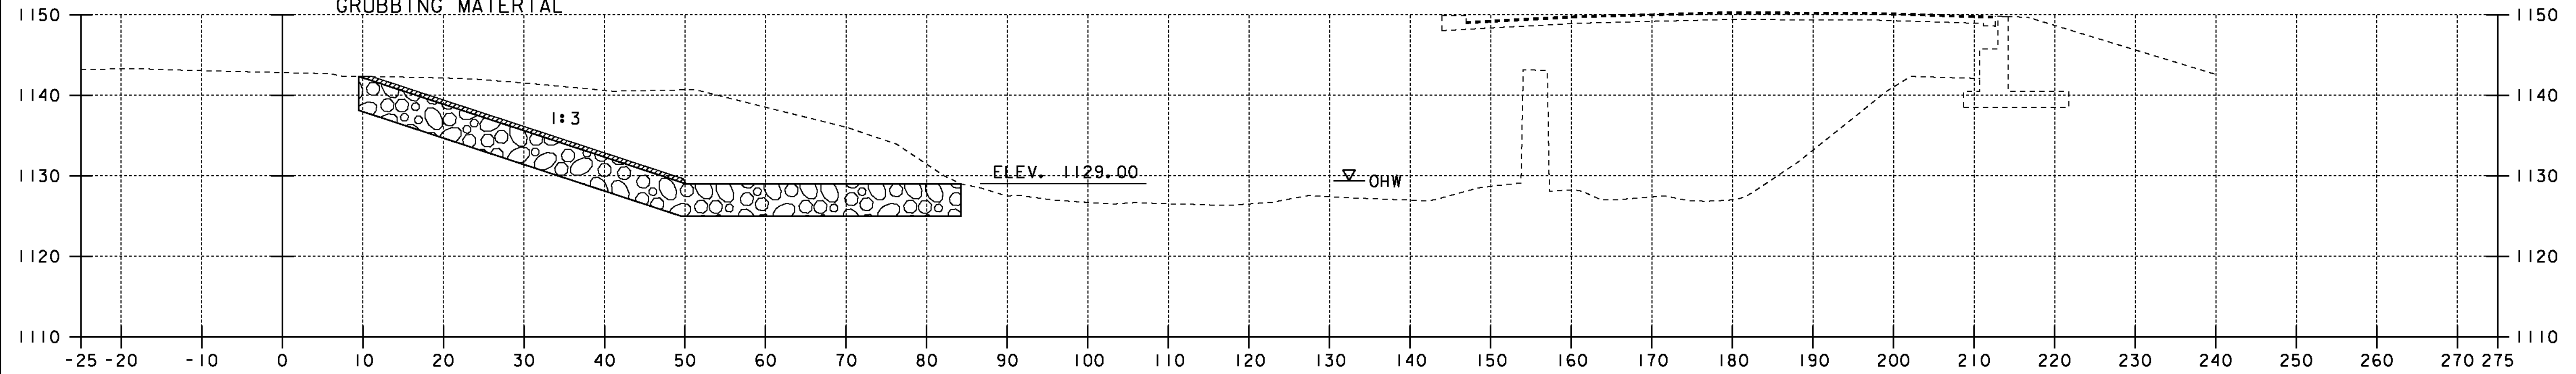

**4+00**


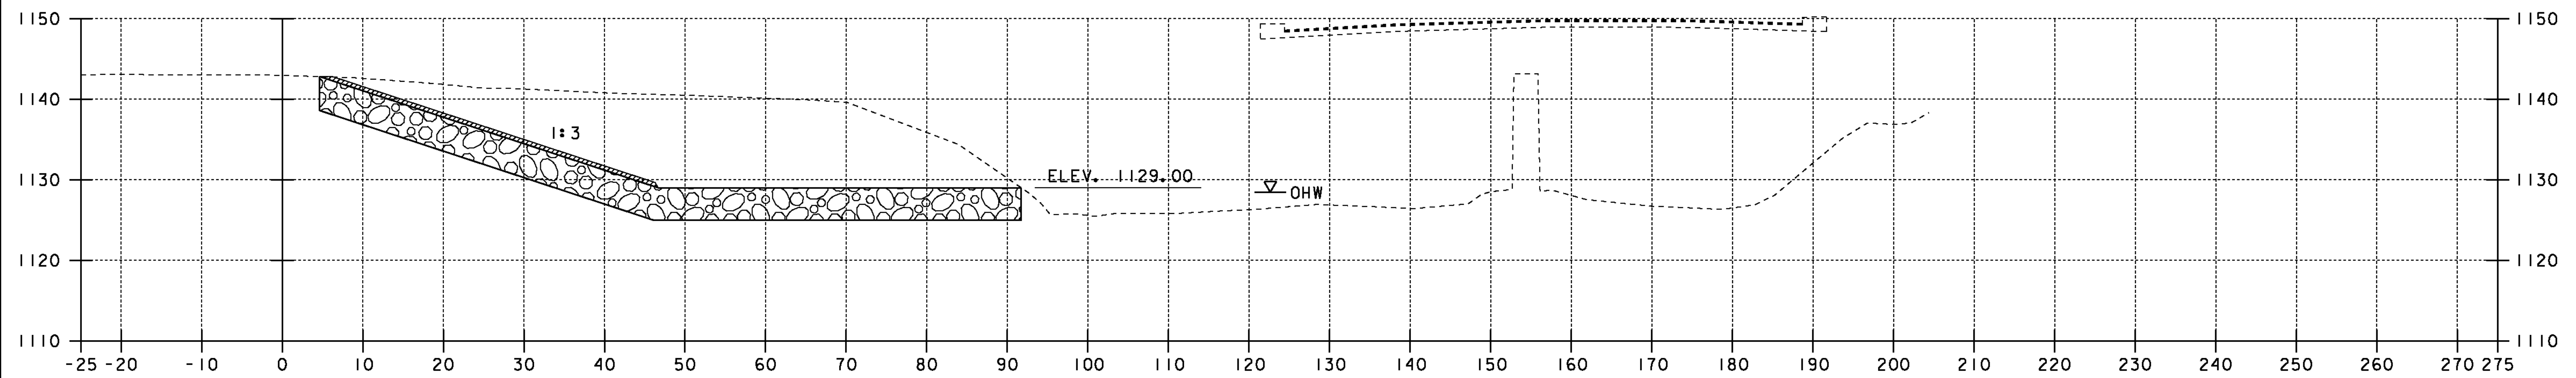


**3+80**

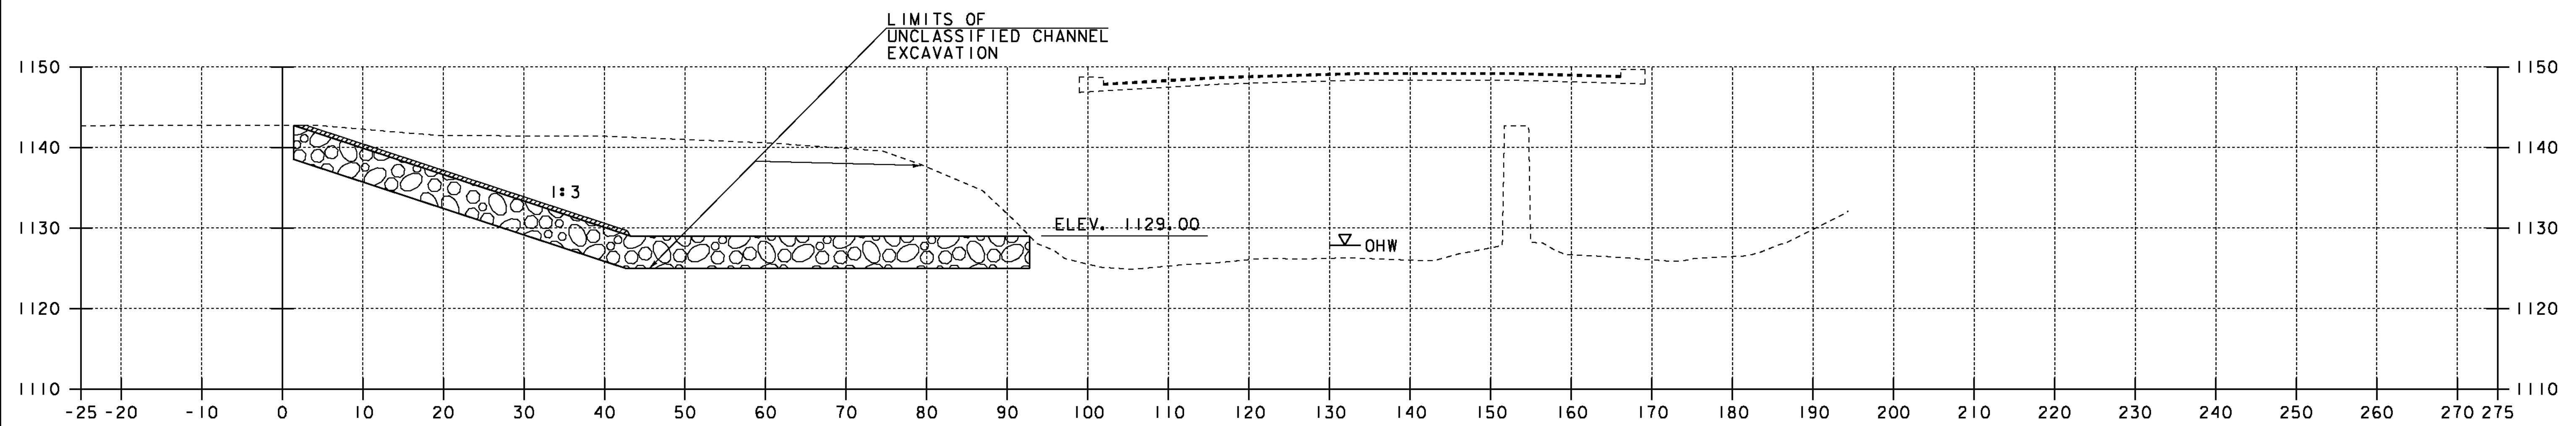

**3+60**

PROJECT NAME:	WOODFORD
PROJECT NUMBER:	ER BHF 010-1(44)
FILE NAME:	sl1b214ch xs.dgn
PROJECT LEADER:	C. CARLSON
DESIGNED BY:	M. EVANS-MONGEON
CHANNEL CROSS SECTIONS SHEET (4)	
PLOT DATE:	23-MAR-2012
DRAWN BY:	G. ROY
CHECKED BY:	EVANS-MONGEON
SHEET	43 OF 58

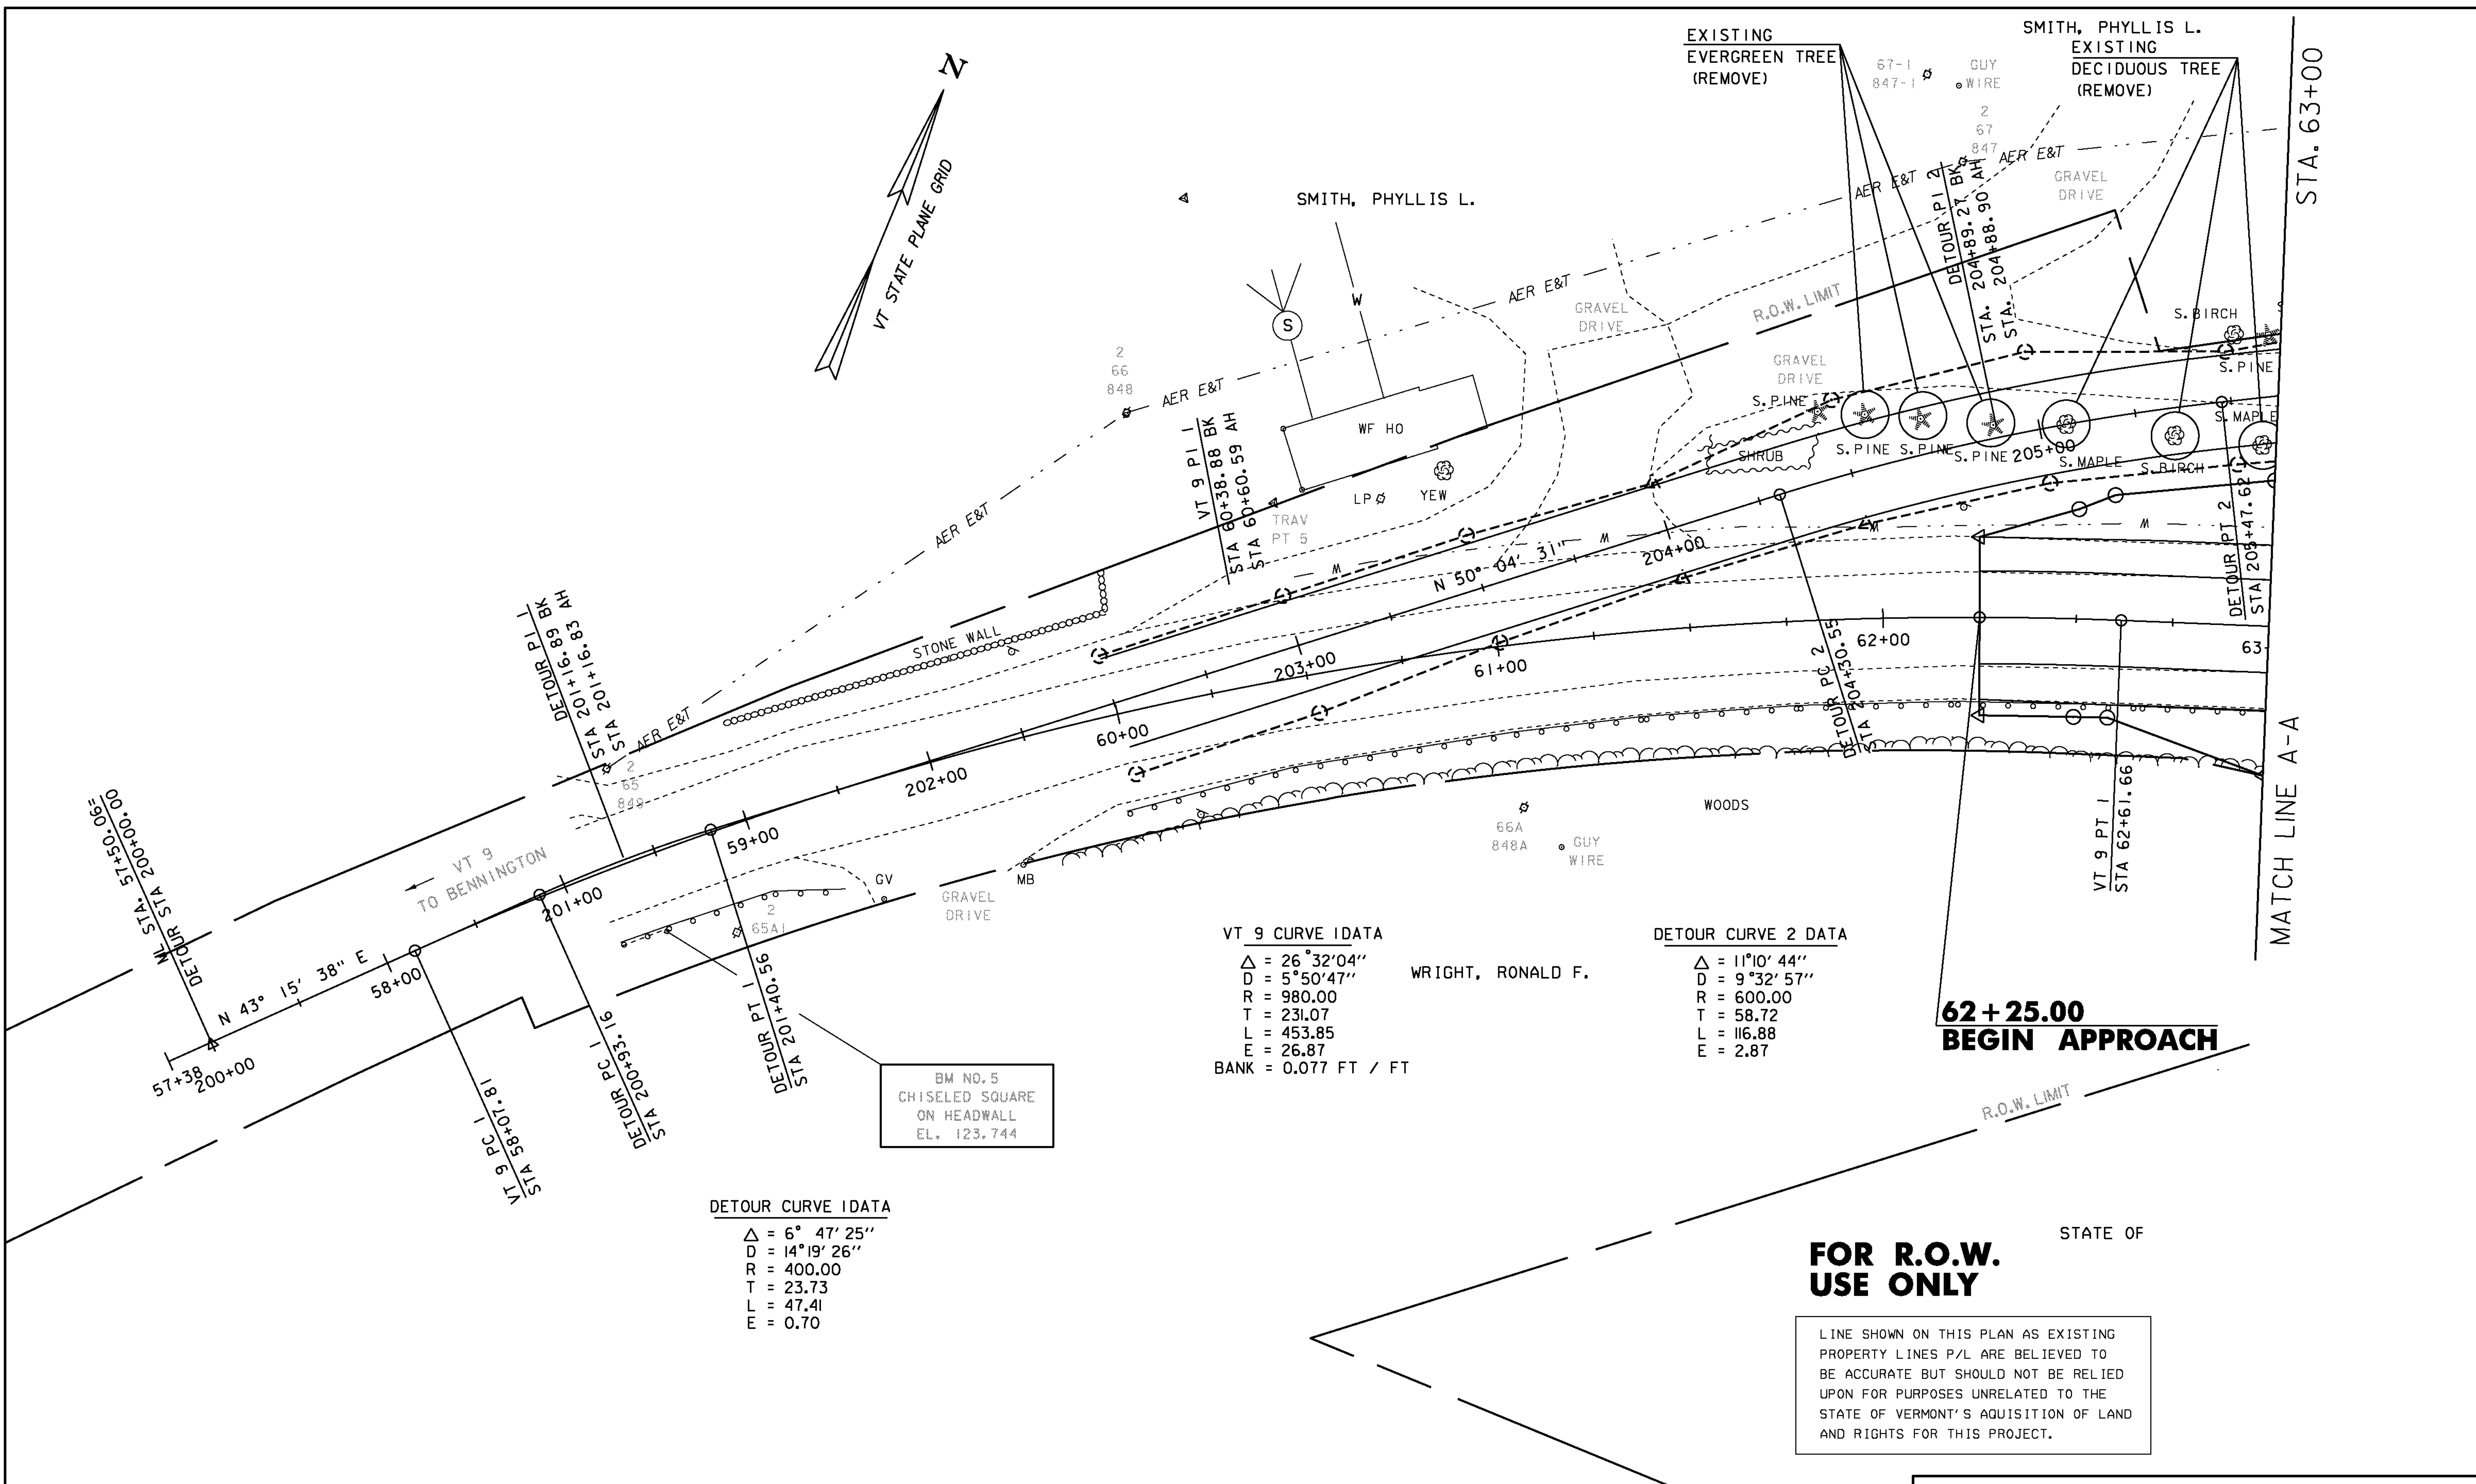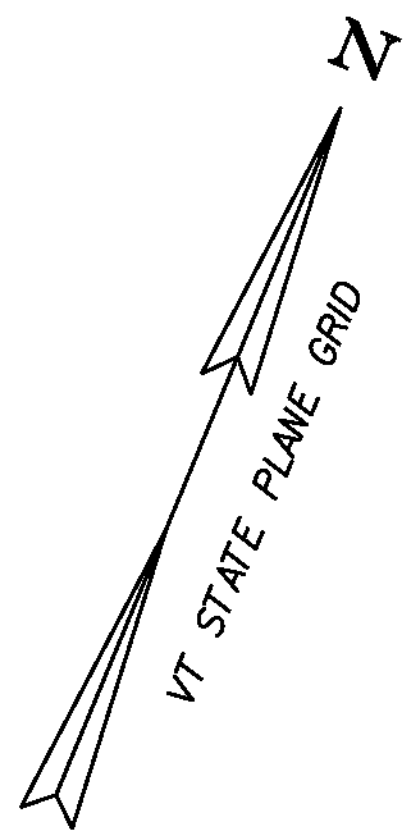

**VT 9 CURVE 1 DATA**  
 $\Delta = 26^\circ 32' 04''$   
 $D = 5^\circ 50' 47''$   
 $R = 980.00$   
 $T = 231.07$   
 $L = 453.85$   
 $E = 26.87$   
 BANK = 0.077 FT / FT

WRIGHT, RONALD F.

**DETOUR CURVE 2 DATA**  
 $\Delta = 11^\circ 10' 44''$   
 $D = 9^\circ 32' 57''$   
 $R = 600.00$   
 $T = 58.72$   
 $L = 116.88$   
 $E = 2.87$


**DETOUR CURVE 1 DATA**  
 $\Delta = 6^\circ 47' 25''$   
 $D = 14^\circ 19' 26''$   
 $R = 400.00$   
 $T = 23.73$   
 $L = 47.41$   
 $E = 0.70$

BM NO. 5  
 CHISELED SQUARE  
 ON HEADWALL  
 EL. 123.744

**62+25.00  
 BEGIN APPROACH**

**FOR R.O.W.  
 USE ONLY**

LINE SHOWN ON THIS PLAN AS EXISTING  
 PROPERTY LINES P/L ARE BELIEVED TO  
 BE ACCURATE BUT SHOULD NOT BE RELIED  
 UPON FOR PURPOSES UNRELATED TO THE  
 STATE OF VERMONT'S ACQUISITION OF LAND  
 AND RIGHTS FOR THIS PROJECT.

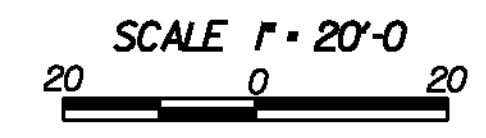

PROJECT NAME: WOODFORD	PLOT DATE: 23-MAR-2012
PROJECT NUMBER: ER BHF 010-1(44)	DRAWN BY: EVANS-MONGEON
FILE NAME: s11b214bdr.dgn	CHECKED BY:
PROJECT LEADER: C. CARLSON	SHEET 44 OF 58
DESIGNED BY: M.EVANS-MONGEON	
R.O.W. PLAN SHEET (1)	

**64+00.00**  
**END APPROACH**  
**BEGIN PROJECT**  
**F.G. 1140.96**

**64+90.93**  
**BEGIN BRIDGE**  
**F.G. 1144.26**

**66+00.50**  
**END BRIDGE WORK**  
**BEGIN APPROACH**  
**F.G. 1147.44**

SMITH, PHYLLIS L.

DETOUR CURVE 3 DATA

$\Delta = 19^\circ 24' 14''$   
 $D = 14^\circ 19' 26''$   
 $R = 400.00$   
 $L = 434.82$   
 $E = 5.80$

EXISTING (BURIED) WATER  
 MAIN TO BE REMOVED  
 SEE PROJECT NOTES

TEMPORARY DETOUR  
 CONSTRUCTION LIMITS

TEMPORARY DETOUR  
 CONSTRUCTION LIMITS

CAST-IN-PLACE CONCRETE CURB, TYPE B

64+29.6 - 64+69.4 RT  
 64+72.5 - 65+12.9 LT

STEEL BEAM GUARDRAIL, GALVANIZED

64+36.8 - 64+85.0 RT  
 64+14.8 - 64+39.8 RT

GUARDRAIL APPROACH SECTION,  
 GALVANIZED 2 RAIL BOX BEAM

64+85.0 - 65+15.2 LT  
 64+39.8 - 64+70.0 RT

MANUFACTURED TERMINAL SECTION, FLARED

63+99.0 - 64+36.8 LT

BRIDGE RAILING, GALVANIZED  
 2 RAIL BOX BEAM


64+70.0 - 66+00.50 RT  
 65+15.2 - 66+00.50 LT

4" YELLOW LINE

62+25.0 - 66+30.5 DBL SOLID

4" WHITE LINE

62+25.0 - 66+30.5 LT  
 62+25.0 - 66+30.5 RT

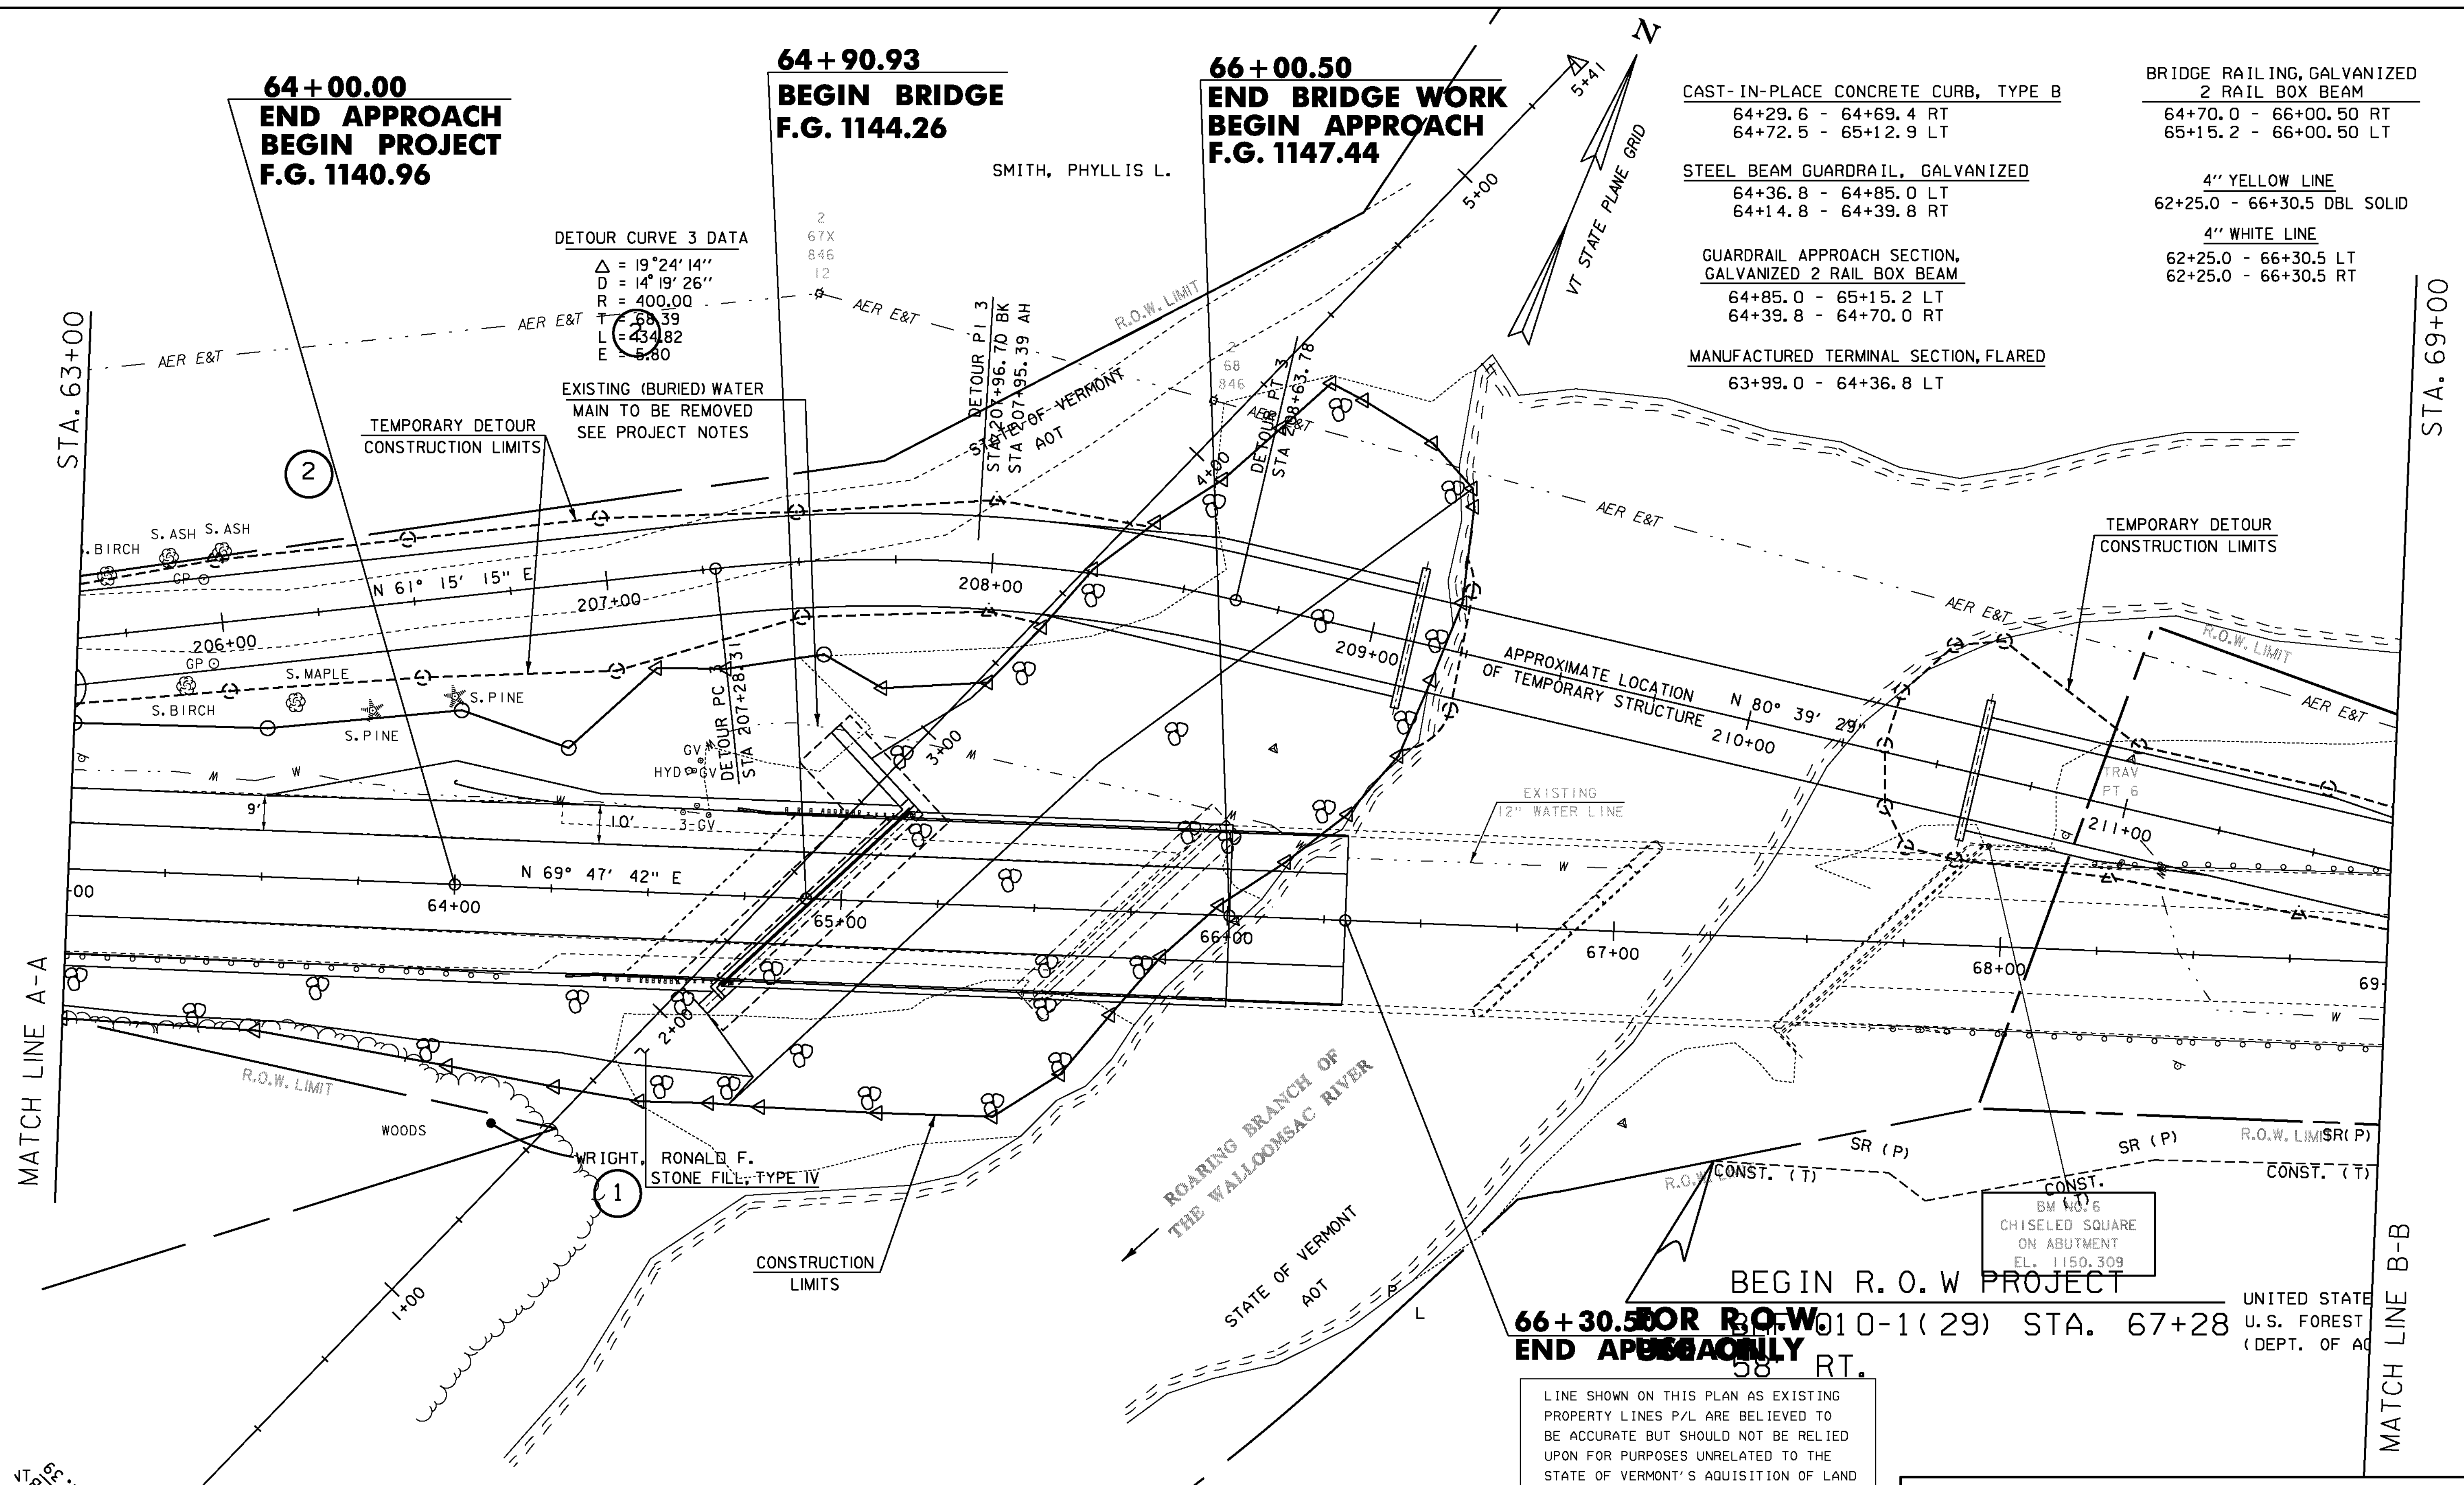

**66+30.50 FOR R.O.W. END APPROACH ONLY**

LINE SHOWN ON THIS PLAN AS EXISTING  
 PROPERTY LINES P/L ARE BELIEVED TO  
 BE ACCURATE BUT SHOULD NOT BE RELIED  
 UPON FOR PURPOSES UNRELATED TO THE  
 STATE OF VERMONT'S ACQUISITION OF LAND  
 AND RIGHTS FOR THIS PROJECT.

SCALE 1" = 20'-0"

PROJECT NAME:	WOODFORD	PLOT DATE:	23-MAR-2012
PROJECT NUMBER:	ER BHF 010-1(44)	DRAWN BY:	EVANS-MONGEON
FILE NAME:	slb214bdr.dgn	CHECKED BY:	
PROJECT LEADER:	C. CARLSON	ROW PLAN SHEET (2)	SHEET 45 OF 58

UNITED STATE  
 U.S. FOREST  
 (DEPT. OF AC)

BM 40.6  
 CHISELED SQUARE  
 ON ABUTMENT  
 EL. 1150.309

BEGIN R.O.W PROJECT

010-1(29) STA. 67+28

58' RT.

MATCH LINE A-A

MATCH LINE B-B

STA. 69+00


STA. 63+00

20+00 STA 0+02.39  
 P&T

END R. O. W PROJECT

BHF 010-1(29) STA. 72+39 27' LT.

ADVENT CHRISTIAN CHURCH OF WOODFORD  
(LESSOR)  
TOWN OF WOODFORD  
(LESSEE)

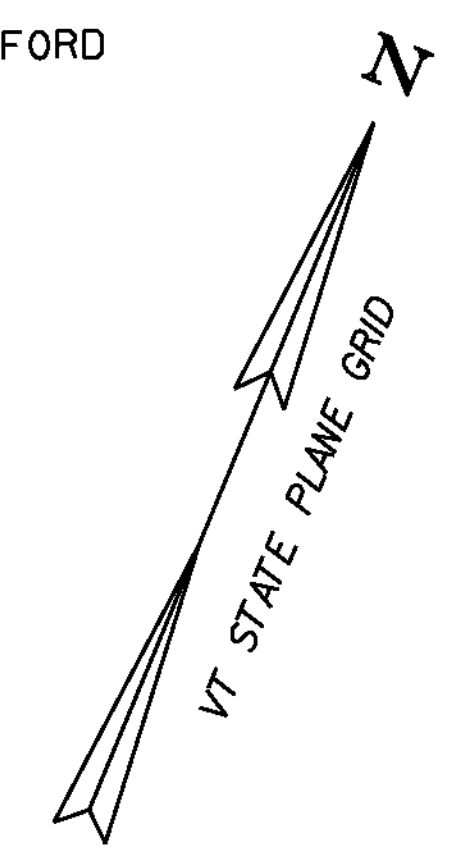



STATE OF VERMONT  
AOT  
DETOUR CURVE 4 DATA  
 $\Delta = 10^{\circ} 51' 47''$   
 $D = 24^{\circ} 54' 40''$   
 $R = 230.00$   
 $T = 21.87$   
 $L = 43.61$   
 $E = 1.04$

VT 9 CURVE 2 DATA  
 $\Delta = 30^{\circ} 39' 47''$   
 $D = 5^{\circ} 24' 19''$   
 $R = 1060.00$   
 $T = 290.61$   
 $L = 567.28$   
 $E = 39.12$   
BANK = 0.074 FT / FT

**FOR R.O.W.  
USE ONLY**

LINE SHOWN ON THIS PLAN AS EXISTING  
PROPERTY LINES P/L ARE BELIEVED TO  
BE ACCURATE BUT SHOULD NOT BE RELIED  
UPON FOR PURPOSES UNRELATED TO THE  
STATE OF VERMONT'S ACQUISITION OF LAND  
AND RIGHTS FOR THIS PROJECT.

PROJECT NAME: WOODFORD	PLOT DATE: 23-MAR-2012
PROJECT NUMBER: ER BHF 010-1(44)	DRAWN BY: EVANS-MONGEON
FILE NAME: s11b214bdr.dgn	CHECKED BY:
PROJECT LEADER: C. CARLSON	SHEET 46 OF 58
DESIGNED BY: M. EVANS-MONGEON	
ROW PLAN SHEET (3)	

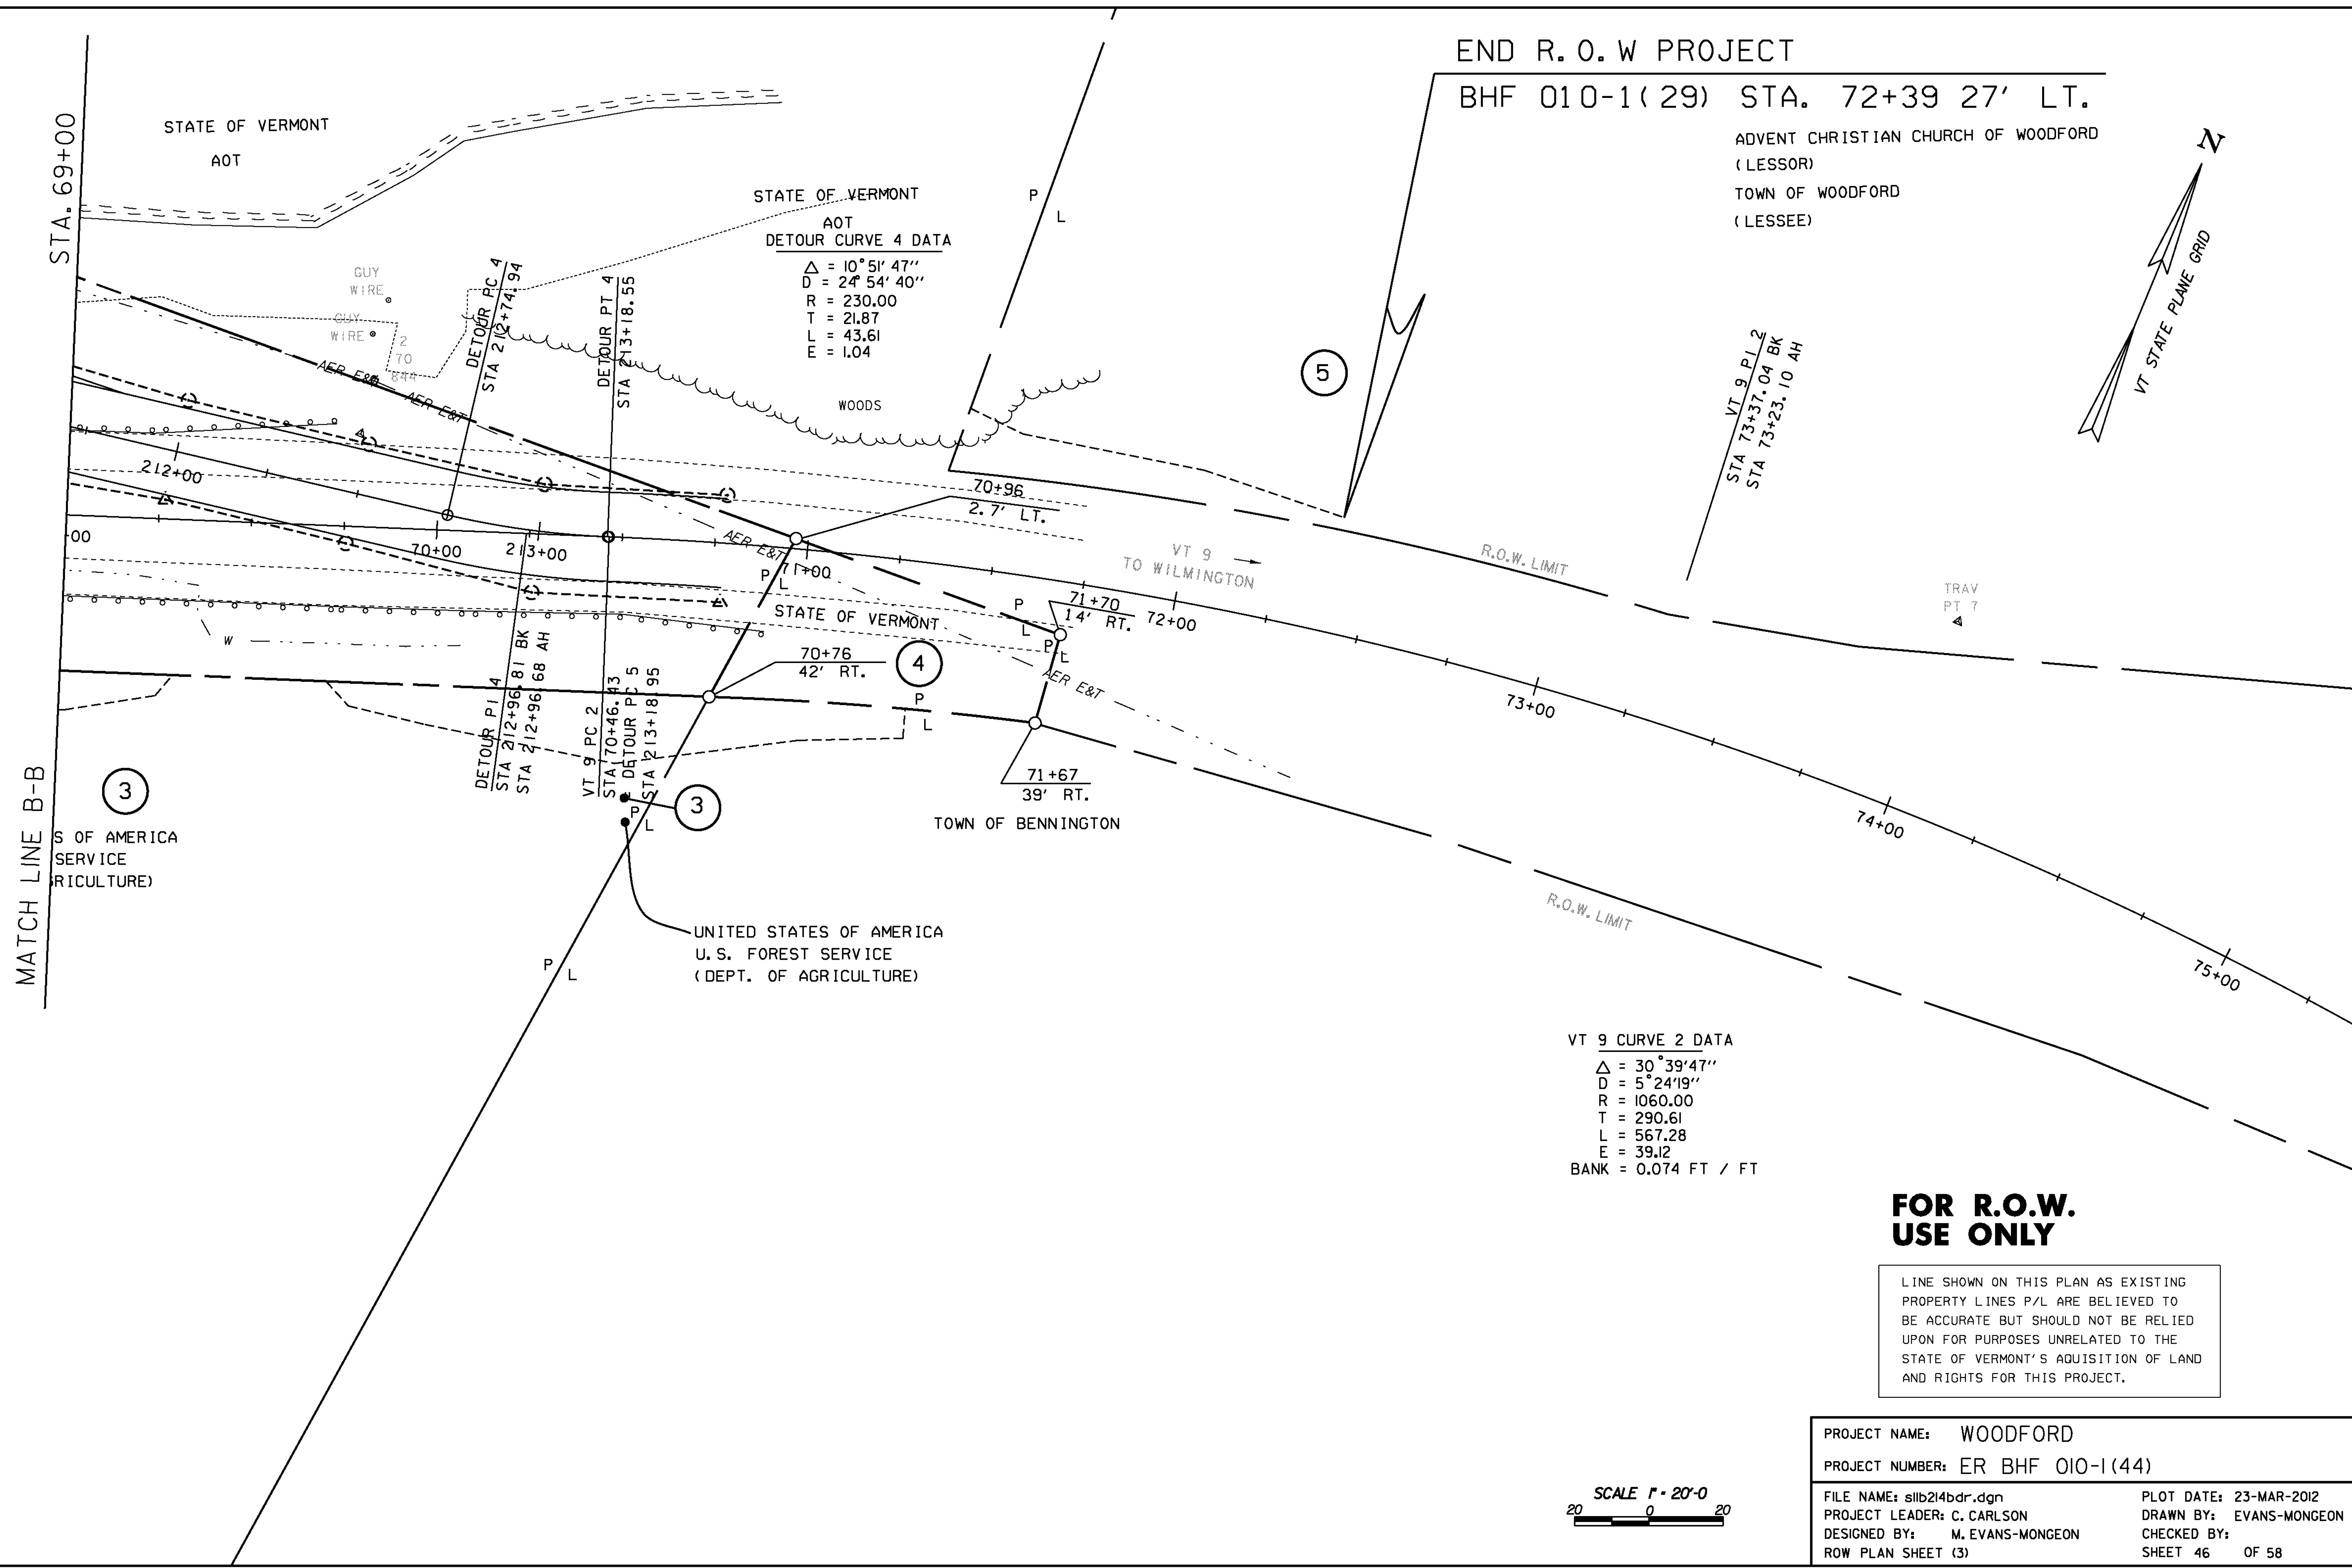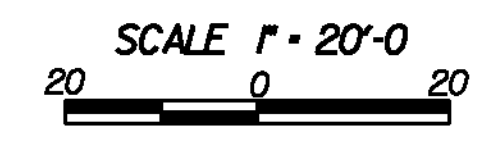

## EPSC PLAN NARRATIVE

### 1.1 PROJECT DESCRIPTION

THIS PROJECT INVOLVES THE RECONSTRUCTION OF BRIDGE 11 ON VT 9 IN WOODFORD. A NEW ABUTMENT WILL BE CONSTRUCTED ON THE WESTERN END OF BRIDGE 11 AND THE WESTERMOST SPAN WILL BE REPLACED WITH NEW STEEL GIRDE RS AND A NEW CONCRETE DECK. A TEMPORARY BRIDGE WILL BE CONSTRUCTED UPSTREAM OF THE EXISTING BRIDGE AND WILL BE REMOVED AT THE COMPLETION OF THE PROJECT. THE BRIDGE IS LOCATED IN THE TOWN OF WOODFORD, ON VT ROUTE 9, APPROXIMATELY 1.2 MILES EAST OF THE BENNINGTON-WOODFORD TOWN LINE, OVER THE ROARING BRANCH OF THE WALLOOMSAC RIVER.

NOTE: AREA OF DISTURBANCE INCLUDES LIMITS OF EARTH DISTURBANCE WITHIN THE PROJECT AREA AS WELL AS WASTE, BORROW, AND STAGING AREAS, AND OTHER EARTH DISTURBING ACTIVITIES WITHIN OR DIRECTLY ADJACENT TO THE PROJECT LIMITS AS SHOWN ON THE ATTACHED EPSC PLAN.

TOTAL AREA OF DISTURBANCE AS SHOWN ON THE ATTACHED EPSC PLAN IS APPROXIMATELY 1.64 ACRES.

IT IS ANTICIPATED THAT THIS PROJECT WILL LAST ONE CONSTRUCTION SEASON.

### 1.2 SITE INVENTORY

#### 1.2.1 TOPOGRAPHY

THE TERRAIN HAS MODERATE TO STEEP SLOPES IN THE VICINITY OF THE PROJECT SITE. VT ROUTE 9 IS A PAVED STATE HIGHWAY. DEVELOPMENT ALONG VT ROUTE 9 CONSISTS OF A MIX OF PERMANENT RESIDENCES AND MUNICIPAL BUILDINGS LYING ON THE OUTSKIRTS OF THE PROJECT LIMITS. THE EXISTING CABLE, TELEPHONE, AND ELECTRICAL UTILITIES EXIST WITHIN THE PROJECT SITE AND WILL NOT BE RELOCATED. A MUNICIPAL WATER MAIN CURRENTLY TRAVELS ACROSS THE NORTH SIDE OF THE EXISTING BRIDGE AND WILL BE RELOCATED TO THE TEMPORARY BRIDGE DURING CONSTRUCTION AND THEN FINALLY ONTO THE NEW BRIDGE.

#### 1.2.2 DRAINAGE, WATERWAYS, BODIES OF WATER, AND PROXIMITY TO NATURAL OR MAN-MADE WATER FEATURES

THE ROARING BROOK OF THE WALLOOMSAC RIVER IS THE ONLY WATER SOURCE ON THE PROJECT SITE. THERE ARE SEVERAL DRAINAGE WAYS IN THE PROJECT AREA THAT CARRY RUNOFF FROM THE ROAD TO THE RIVER, BUT THERE ARE NO KNOWN EPHEMERAL STREAMS OR PONDS WITHIN THE PROJECT SITE.

THERE EXIST UNLINED DRAINAGE DITCHES ALONG THE SIDES OF VT ROUTE 9. THE BANKS SLOPE STEEPLY IN THE VICINITY OF THE BRIDGE AND SOUTH WEST OF THE BRIDGE. THE DRAINAGE AREA AT THE CROSSING IS 37.7 MILES<sup>2</sup>.

#### 1.2.3 VEGETATION

THE PROJECT SITE CONTAINS A MIXTURE OF RESIDENTIAL AND FORESTED LANDS. IN THE RESIDENTIAL AREAS THERE ARE SCATTERED TREES CONSISTING OF SOME ASH, CHERRY, MAPLE, POPLAR, APPLE BIRCH AND PINE. THERE ARE ALSO SOME SHRUBS AND GRASSY LAWNS IN THE RESIDENTIAL AREA. IN ORDER TO PLACE THE TEMPORARY BRIDGE APPROXIMATELY 6 OF THE TREES THAT WERE PLACED IN 2006, AS PART OF PROJECT WOODFORD BHF 010-1 (29), WILL HAVE TO BE REMOVED. UPON PROJECT COMPLETION, THE CHANNEL WILL BE ARMORED WITH STONE FILL TYPE IV AS SPECIFIED ON THE PLANS. DISTURBED VEGETATION WILL BE REESTABLISHED WITH STANDARD SEED AND MULCH PRACTICES.

#### 1.2.4 SOILS

ALL SOIL DATA CAME FROM THE U.S. DEPARTMENT OF AGRICULTURE SOIL CONSERVATION SERVICE FOR THE COUNTY OF BENNINGTON, VERMONT. THE SOIL TYPE IDENTIFIED FOR THIS PROJECT SITE IS COLTON GRAVELLY LOAMY SAND, 8% TO 15% SLOPES, THE SOIL IS CONSIDERED HIGHLY ERODIBLE WITH A K VALUE OF 0.17. IT BELONGS TO HYDROLOGICAL GROUP A AND THE PERMEABILITY OF THIS SOIL IS MODERATELY RAPID TO VERY RAPID.

#### 1.2.5 SENSITIVE RESOURCE AREAS

CRITICAL HABITATS: NO  
HISTORICAL OR ARCHEOLOGICAL AREAS: NO  
PRIME AGRICULTURAL LAND: NO  
THREATENED AND ENDANGERED SPECIES: NO  
WATER RESOURCE: ROARING BRANCH  
WETLANDS: NO

### 1.3 RISK EVALUATION

THIS PROJECT FALLS UNDER THE JURISDICTION OF GENERAL PERMIT 3-9020 FOR STORMWATER RUNOFF FROM CONSTRUCTION SITES FOR LOW RISK PROJECTS. ANY MODIFICATIONS TO THE PROJECT THAT INCREASE THE RISK TO ENVIRONMENTAL RESOURCES SHALL BE EVALUATED IN ACCORDANCE WITH THE PERMIT REQUIREMENTS. THE CONTRACTOR WILL BE RESPONSIBLE FOR ANY ADDITIONAL PERMITTING.

### 1.4 EROSION PREVENTION AND SEDIMENT CONTROL

THE EROSION CONTROL PLANS ARE MEANT AS A GUIDELINE FOR PREVENTING EROSION AND CONTROLLING SEDIMENT TRANSPORT. THE PRINCIPLES OUTLINED IN THIS NARRATIVE CONSIST OF APPLYING MEASURES THROUGHOUT CONSTRUCTION OF THE PROJECT IN ORDER TO MINIMIZE SEDIMENT TRANSPORT TO THE RECEIVING WATERS. THE MEASURES INCLUDE STABILIZATION AND STRUCTURAL PRACTICES, STORM WATER CONTROLS AND OTHER POLLUTION PREVENTION PRACTICES. THEY HAVE BEEN PROPOSED BY THE DESIGNER AS A BASIS FOR PROTECTING RESOURCES AND WILL NEED TO BE BUILT UPON BASED ON THE SPECIFIC MEANS AND METHODS OF THE CONTRACTOR. REFER TO THE LOW RISK SITE HANDBOOK AND APPROPRIATE DETAIL SHEETS FOR SPECIFIC GUIDANCE AND CONSTRUCTION DETAILING.

ALL MEASURES SHALL BE REGULARLY MAINTAINED AND SHALL BE CHECKED FOR SEDIMENT BUILD-UP. SEDIMENT SHALL BE DISPOSED OF AT AN APPROVED SITE WHERE IT WILL NOT BE SUBJECT TO EROSION.

#### 1.4.1 MARK SITE BOUNDARIES

SITE BOUNDARIES AND AREAS CONSTRUCTION EQUIPMENT CAN ACCESS SHALL BE DELINEATED.

PROJECT DEMARCATION FENCING (PDF) SHALL BE USED TO PHYSICALLY MARK SITE BOUNDARIES. BECAUSE THIS PROJECT FALLS UNDER THE CGP 3-9020, BARRIER FENCE SHALL BE USED INSTEAD OF PROJECT DEMARCATION FENCE WITHIN 100 FEET OF A WATER RESOURCE (STREAM, BROOK, LAKE, POND, WETLAND, ETC).

#### 1.4.2 LIMIT DISTURBANCE AREA

PREVENTING INITIAL SOIL EROSION BY MINIMIZING THE EXPOSED AREA IS MUCH MORE EFFECTIVE THAN TREATING ERODED SEDIMENT. EARTH DISTURBANCE CAN BE MINIMIZED THROUGH CONSTRUCTION PHASING BY ONLY OPENING UP EARTH AS NECESSARY. THIS CAN LIMIT THE AREA THAT WILL BE DISTURBED AND EXPOSED TO EROSION. EMPLOY TEMPORARY CONSTRUCTION STABILIZATION PRACTICES IN INCREMENTAL STAGES AS PHASES CHANGE. FOR PROJECTS WHICH FALL UNDER THE CONSTRUCTION GENERAL PERMIT, ONLY THE ACREAGE LISTED ON THE PERMIT AUTHORIZATION MAY BE EXPOSED AT ANY GIVEN TIME.

MAINTAINING VEGETATED BUFFERS ALONG STREAM BANKS, WETLANDS OR OTHER SENSITIVE AREAS IS A CRUCIAL EROSION AND SEDIMENT CONTROL MEASURE THAT SHOULD BE ESTABLISHED WHEREVER POSSIBLE.

#### 1.4.3 SITE ENTRANCE/EXIT STABILIZATION

TRACKING OF SEDIMENT ONTO PUBLIC HIGHWAYS SHALL BE MINIMIZED TO REDUCE THE POTENTIAL FOR RUNOFF ENTERING RECEIVING WATERS. INSTALLATION SHALL COINCIDE WITH THE CONTRACTOR'S PROGRESS SCHEDULE.

STABILIZED CONSTRUCTION ENTRANCES SHALL BE INSTALLED AS PROPOSED ON THE EPSC PLAN AND ANYWHERE EQUIPMENT WILL BE GOING FROM AREAS OF EXPOSED SOILS TO PAVED SURFACES.

#### 1.4.4 INSTALL SEDIMENT BARRIERS

SEDIMENT BARRIERS SHALL BE UTILIZED TO INTERCEPT RUNOFF AND ALLOW SUSPENDED SEDIMENT TO SETTLE OUT. THEY SHALL BE INSTALLED PRIOR TO ANY UP SLOPE WORK.

SILT FENCE WILL BE INSTALLED AS PROPOSED ON THE EPSC PLAN. BECAUSE THIS PROJECT FALLS UNDER THE CGP 3-9020, WOVEN WIRE REINFORCED SILT FENCE SHALL BE USED INSTEAD OF SILT FENCE WITHIN 100 FEET UPSLOPE OF RECEIVING WATERS.

FILTER CURTAIN WILL BE INSTALLED AS PROPOSED ON THE EPSC PLAN SURROUNDING THE STONE FILL AT ABUTMENT 1 IN ORDER TO KEEP SEDIMENT FROM ENTERING THE ROARING BRANCH WHILE THE STONE FILL IS BEING PLACED.

#### 1.4.5 DIVERT UPLAND RUNOFF

DIVERSIONARY MEASURES SHALL BE USED TO INTERCEPT RUNOFF FROM ABOVE THE CONSTRUCTION AND DIRECT IT AROUND THE DISTURBED AREA SO THAT CLEAN WATER DOES NOT BECOME MUDDIED WHILE TRAVELING OVER EXPOSED SOILS ON THE CONSTRUCTION SITE.

THE PROJECT AREA IS RELATIVELY FLAT. THEREFORE IT IS NOT ANTICIPATED THAT DIVERSION MEASURES WILL BE NECESSARY.

#### 1.4.6 SLOW DOWN CHANNELIZED RUNOFF

CHECK STRUCTURES SHALL BE UTILIZED TO REDUCE THE VELOCITY, AND THUS THE EROSION POTENTIAL, OF CONCENTRATED FLOW IN CHANNELS.

NO STONE CHECK DAMS WILL BE NECESSARY FOR THIS PROJECT.

#### 1.4.7 CONSTRUCT PERMANENT CONTROLS

PERMANENT STORMWATER TREATMENT DEVICES SHALL BE INSTALLED AS SHOWN ON THE PLANS AND IN ACCORDANCE WITH PERMIT CONDITIONS. STONE FILL TYPE IV WILL BE INSTALLED ALONG THE CHANNEL TO PREVENT EROSION FROM STORMWATER RUNOFF. A SHALLOW DITCH WILL CONTROL STORMWATER RUNOFF ON THE LEFT SIDE OF THE ROAD FROM BEGIN PROJECT TO BEGIN BRIDGE.

#### 1.4.8 STABILIZE EXPOSED SOILS DURING CONSTRUCTION

ALL AREAS OF DISTURBANCE MUST HAVE TEMPORARY STABILIZATION IN PLACE WITHIN 48 HOURS OF DISTURBANCE OR IN ACCORDANCE WITH THE CONSTRUCTION GENERAL PERMIT 3-9020 AUTHORIZATION.

SURFACE ROUGHENING OF ALL EXPOSED SLOPES, COMBINED WITH TEMPORARY MULCHING, SHALL BE UTILIZED ON A REGULAR BASIS. BIODEGRADABLE EROSION CONTROL MATTING OR AN EQUIVALENT SHALL BE USED TO STABILIZE ALL SLOPES STEEPER THAN 1:3.

THE FORECAST OF RAINFALL EVENTS SHALL TRIGGER IMMEDIATE PROTECTION OF EXPOSED SOILS.

#### 1.4.9 WINTER STABILIZATION

VARIOUS MEASURES SPECIFIC TO WINTER MAY BE NECESSARY SHOULD THE PROJECT EXTEND INTO WINTER (OCTOBER 15 THROUGH APRIL 15). REFER TO THE LOW RISK SITE HANDBOOK FOR GUIDANCE.

#### 1.4.10 STABILIZE SOIL AT FINAL GRADE

EXPOSED SOIL MUST BE STABILIZED WITHIN 48 HOURS OF REACHING FINAL GRADE.

SEED, MULCH, FERTILIZER AND LIME SHALL BE USED TO ESTABLISH PERMANENT VEGETATION. FOR SLOPES STEEPER THAN 1:3, BIODEGRADABLE EROSION CONTROL MATTING OR AN EQUIVALENT SHALL BE USED INSTEAD OF MULCH.

#### 1.4.11 DE-WATERING ACTIVITIES

DISCHARGE FROM DEWATERING ACTIVITIES THAT FLOWS OFF OF THE CONSTRUCTION SITE MUST NOT CAUSE OR CONTRIBUTE TO A VIOLATION OF THE VERMONT WATER QUALITY STANDARDS.

TREATMENT OF DEWATERING THE ABUTMENT EXCAVATION IS ANTICIPATED. A LOCATION FOR TREATMENT HAS BEEN PROPOSED AND IS SHOWN ON THE PLANS. HOWEVER THE SPECIFIC MEANS FOR TREATMENT OF DISCHARGE SHALL BE PROVIDED BY THE CONTRACTOR.

#### 1.4.12 INSPECT YOUR SITE

INSPECT THE PROJECT SITE BASED ON SPECIAL PROVISION REQUIREMENTS OR CONSTRUCTION GENERAL PERMIT AUTHORIZATION STIPULATIONS.

### 1.5 SEQUENCE AND STAGING

THIS SECTION WILL BE DEVELOPED BY THE CONTRACTOR USING THE GUIDANCE OUTLINED IN THE VTRANS EPSC PLAN CONTRACTOR CHECKLIST.

#### 1.5.1 CONSTRUCTION SEQUENCE


#### 1.5.2 OFF-SITE ACTIVITIES

IN ADDITION TO THE CONTRACTOR CHECKLIST ANY ACTIVITIES OUTSIDE THE CONSTRUCTION LIMITS SHALL FOLLOW SUBSECTIONS 105.25- 105.29 OF THE STANDARD SPECIFICATIONS FOR CONSTRUCTION.


#### 1.5.3 UPDATES

PROJECT NAME:	WOODFORD
PROJECT NUMBER:	ER BRF 010-1(44)
FILE NAME:	slb214epsc narrative.dgn
PROJECT LEADER:	C. CARLSON
DESIGNED BY:	M. EVANS-MONGEON
EPSC NARRATIVE	
PLOT DATE:	23-MAR-2012
DRAWN BY:	EVANS-MONGEON
CHECKED BY:	G. ROY
SHEET	47 OF 58

SOIL INFORMATION  
 BERKSHIRE FINE LOAMY SAND  
 HYDRO GROUP B  
 HIGHLY ERODIBLE

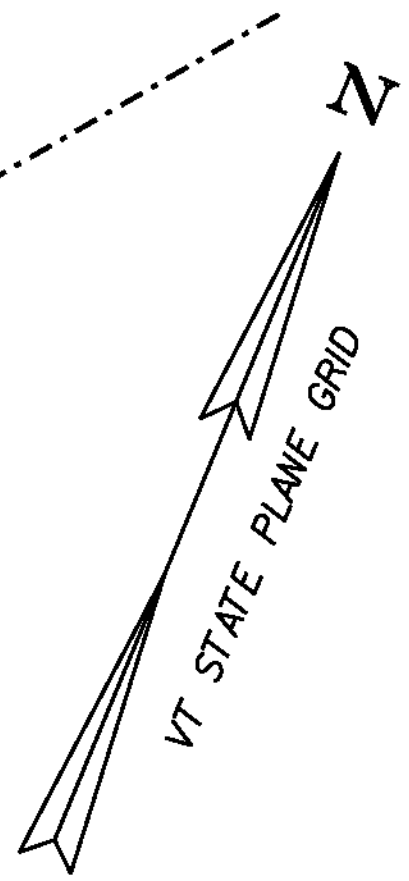



SOIL INFORMATION  
 UDIPSAMMENTS AND UDORTHENTS  
 HYDRO GROUP NOT RATED

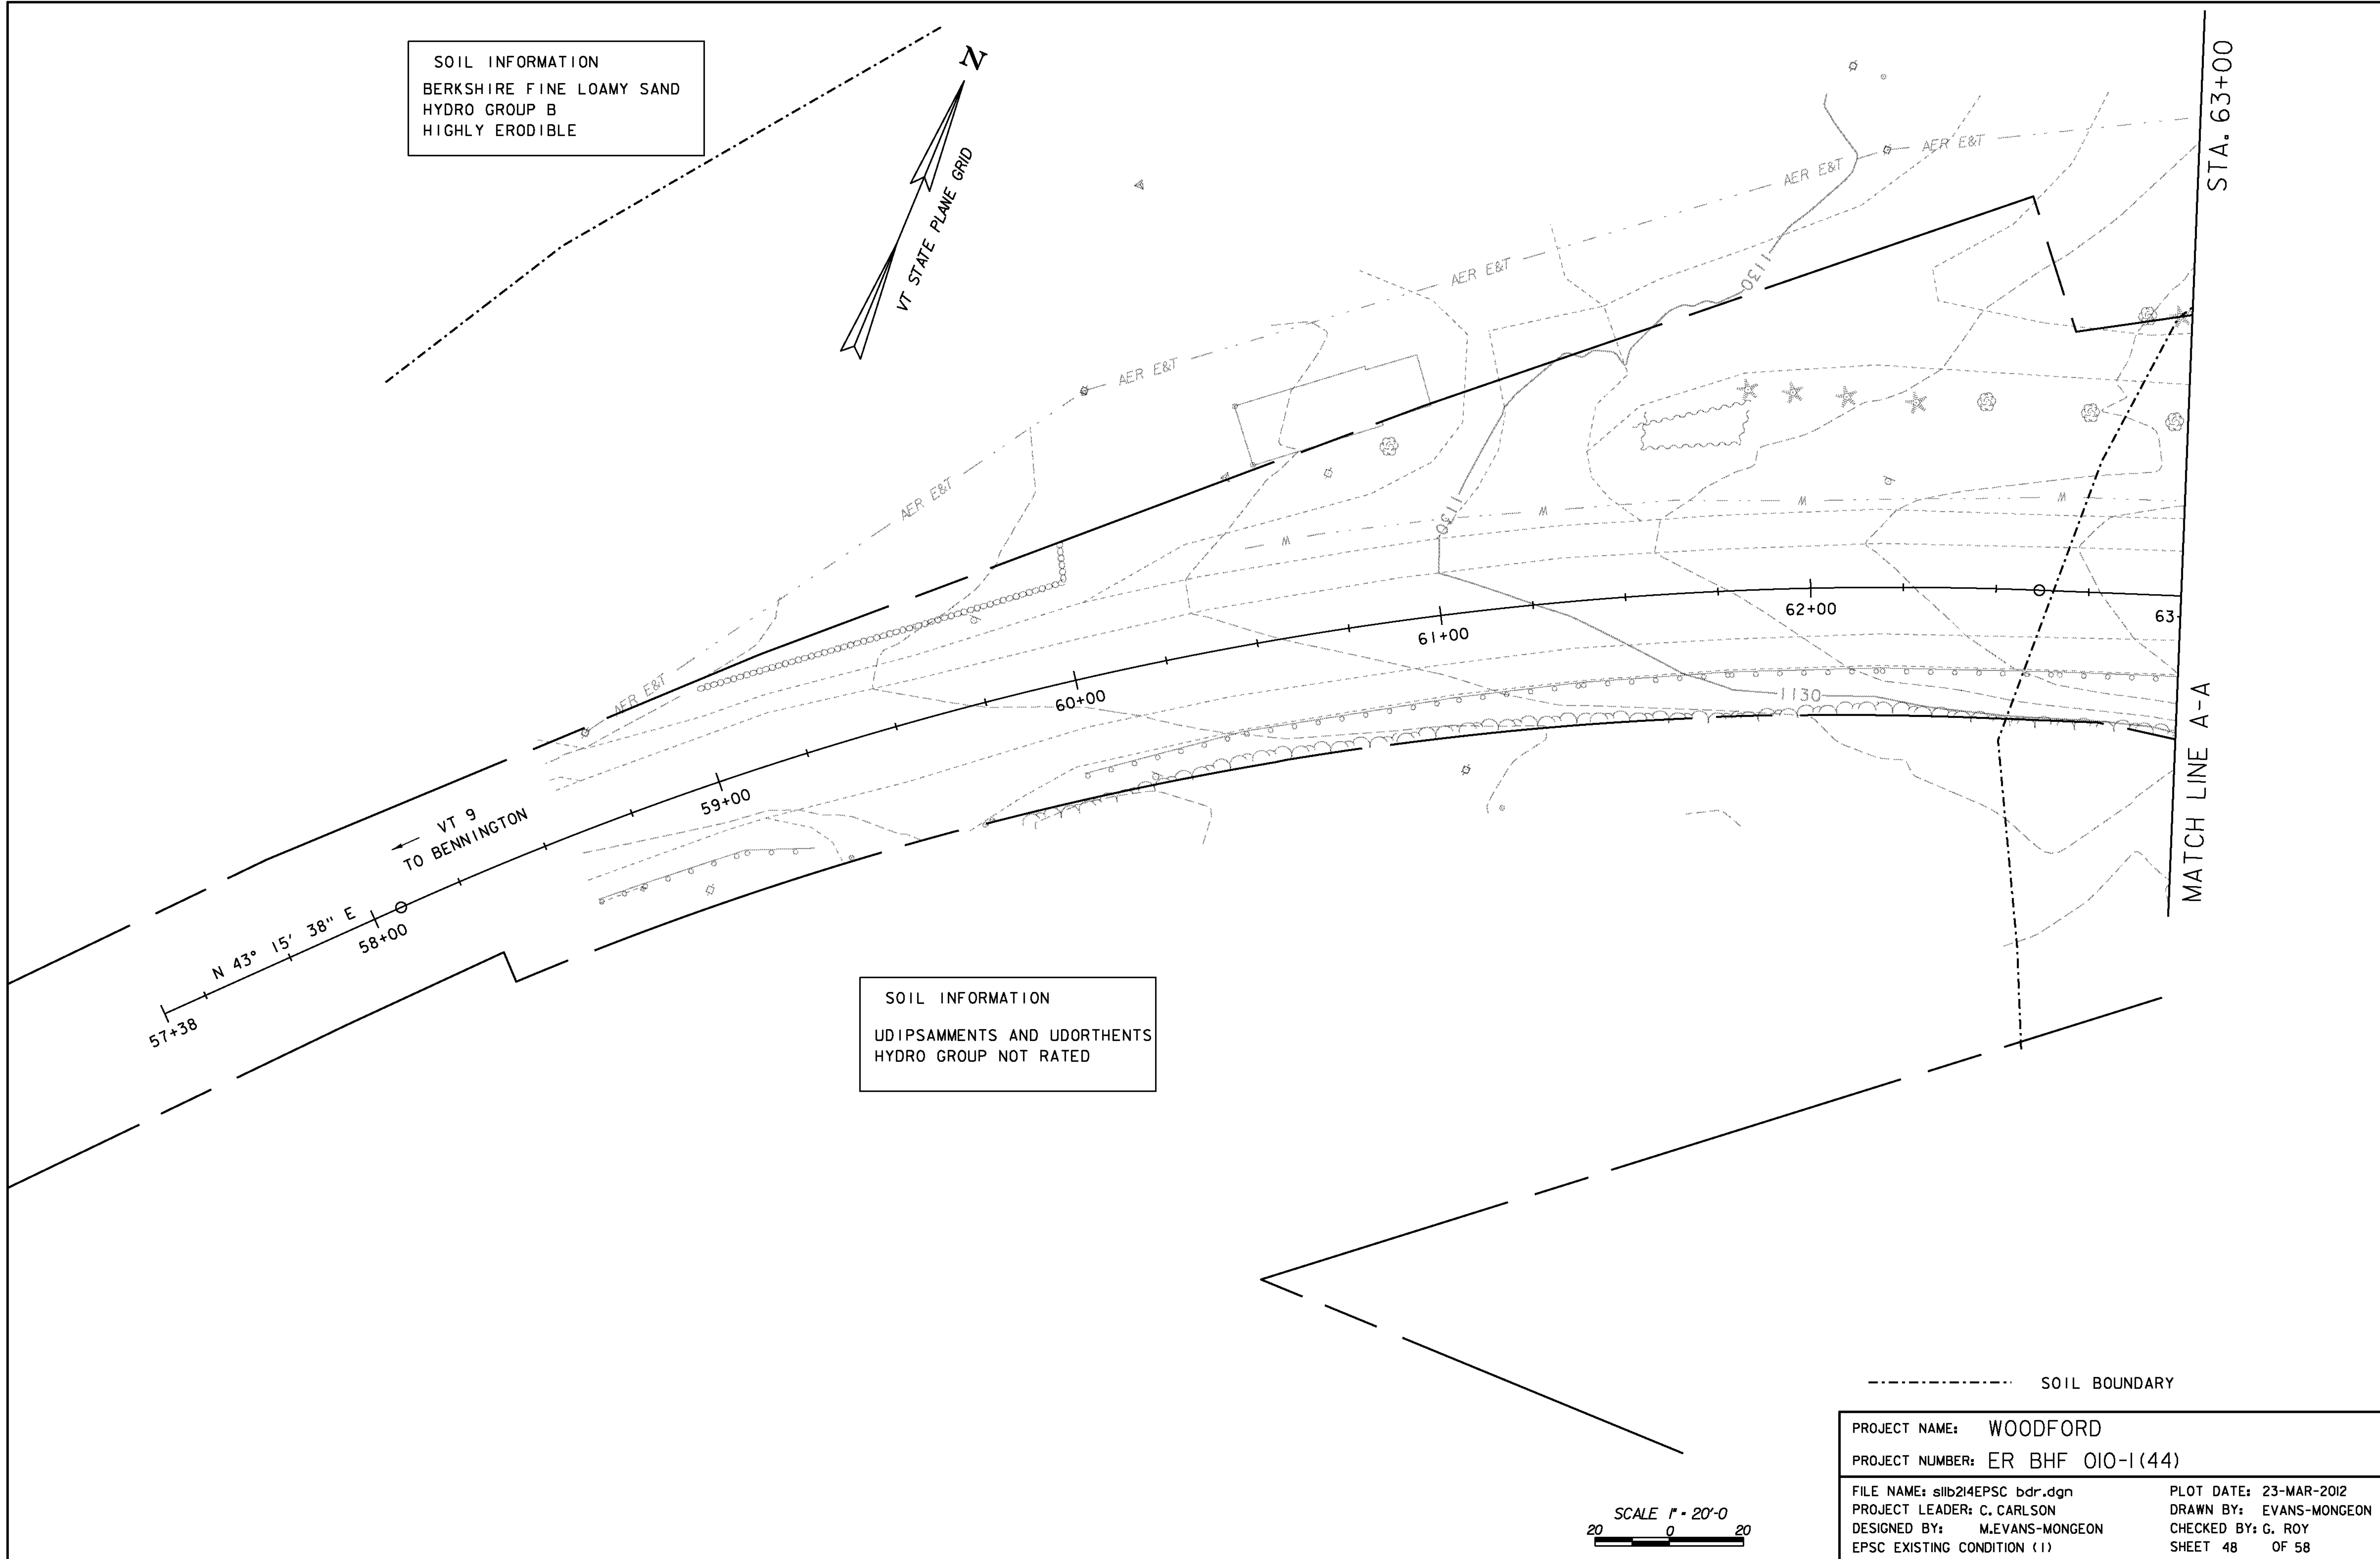

PROJECT NAME: WOODFORD	
PROJECT NUMBER: ER BHF 010-1(44)	
FILE NAME: s11b214EPSC bdr.dgn	PLOT DATE: 23-MAR-2012
PROJECT LEADER: C. CARLSON	DRAWN BY: EVANS-MONGEON
DESIGNED BY: M.EVANS-MONGEON	CHECKED BY: G. ROY
EPSC EXISTING CONDITION (1)	SHEET 48 OF 58

SOIL INFORMATION  
 UDIPSAMMENTS AND UDORTHENTS  
 HYDRO GROUP NOT RATED

SOIL INFORMATION  
 COLTON GRAVELLY LOAMY SAND  
 HYDRO GROUP A  
 WELL DRAINED  
 POTENTIALLY HIGHLY ERODIBLE

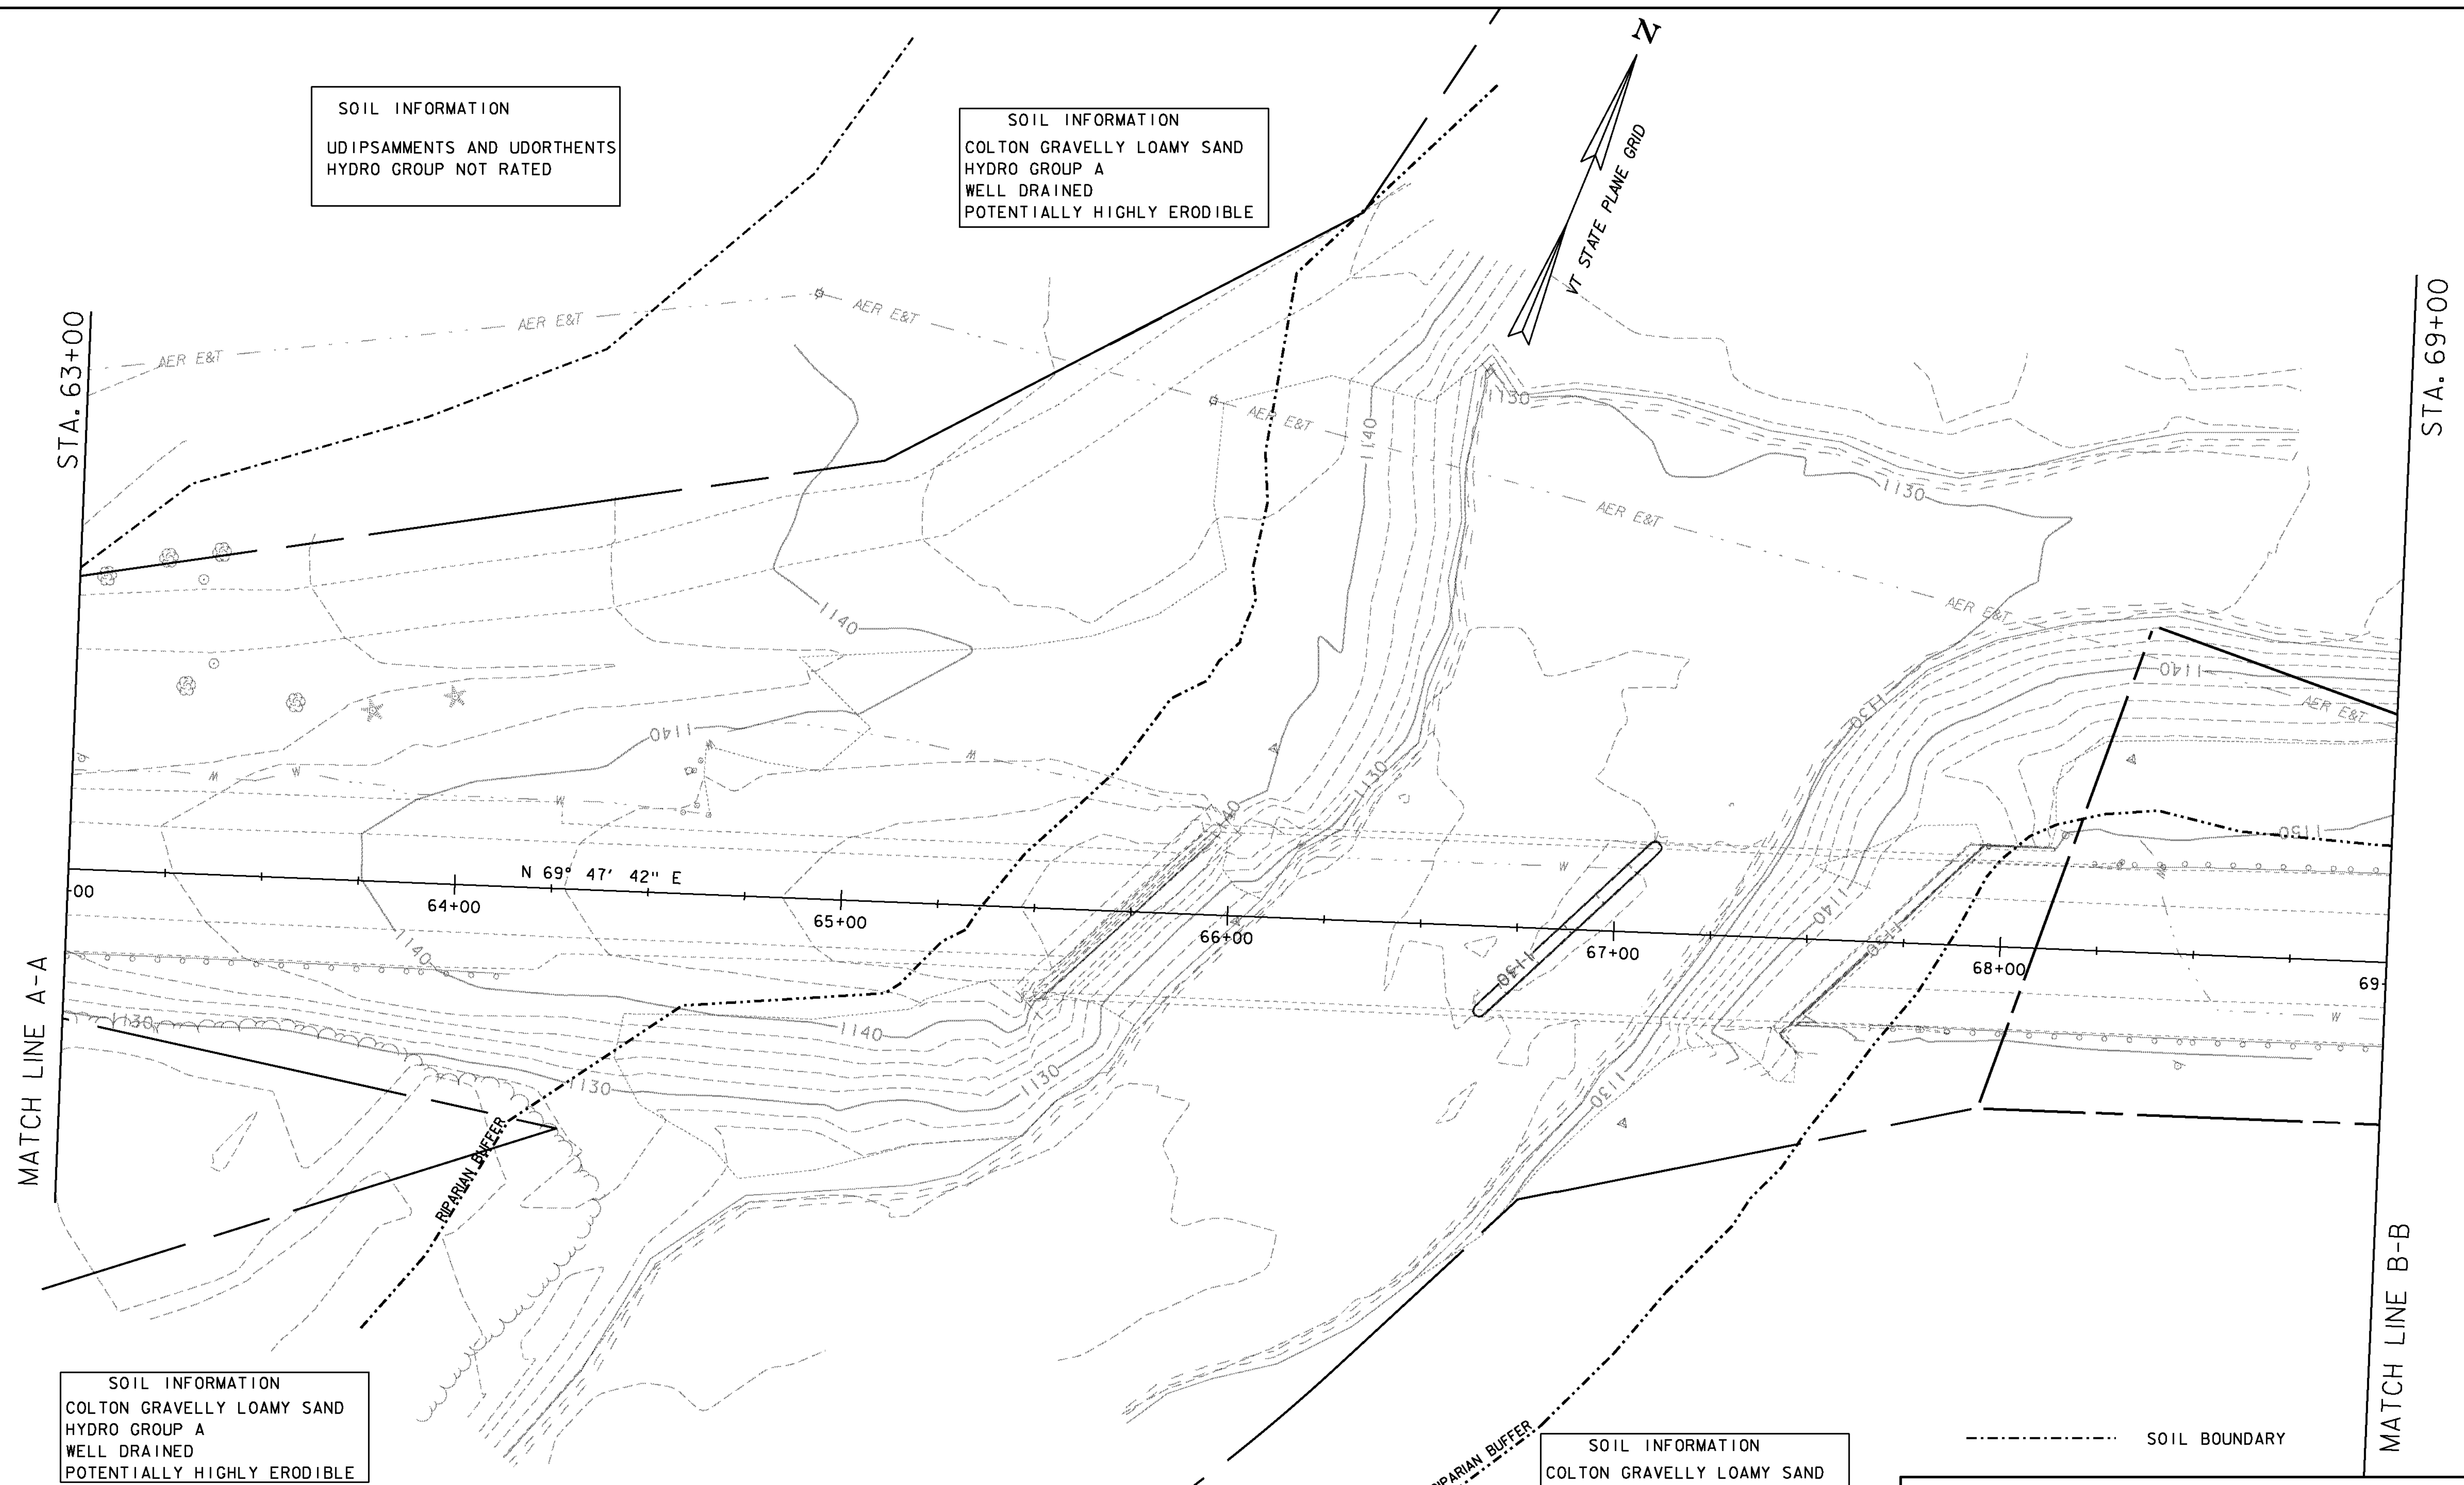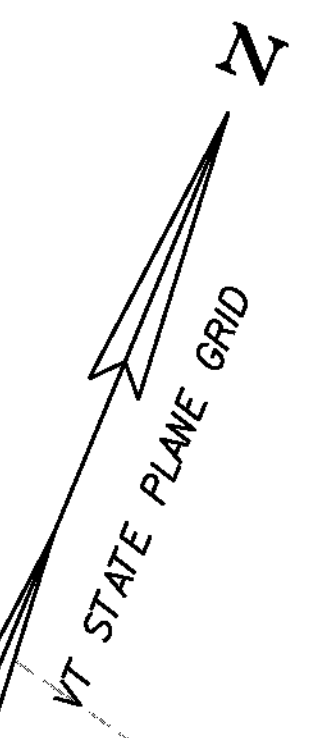

N 69° 47' 42" E

STA. 63+00


STA. 69+00

MATCH LINE A-A

MATCH LINE B-B

SOIL INFORMATION  
 COLTON GRAVELLY LOAMY SAND  
 HYDRO GROUP A  
 WELL DRAINED  
 POTENTIALLY HIGHLY ERODIBLE

SOIL INFORMATION  
 COLTON GRAVELLY LOAMY SAND  
 HYDRO GROUP A  
 WELL DRAINED  
 POTENTIALLY HIGHLY ERODIBLE

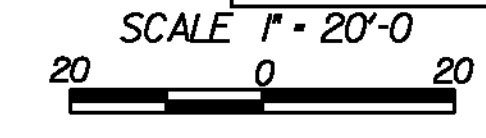


----- SOIL BOUNDARY

PROJECT NAME: WOODFORD	PLOT DATE: 23-MAR-2012
PROJECT NUMBER: ER BHF 010-1(44)	DRAWN BY: EVANS-MONGEON
FILE NAME: s11b214EPSC bdr.dgn	CHECKED BY: G. ROY
DESIGNED BY: M.EVANS-MONGEON	SHEET 49 OF 58
EPSC EXISTING CONDITION (2)	

STA. 69+00

MATCH LINE B-B

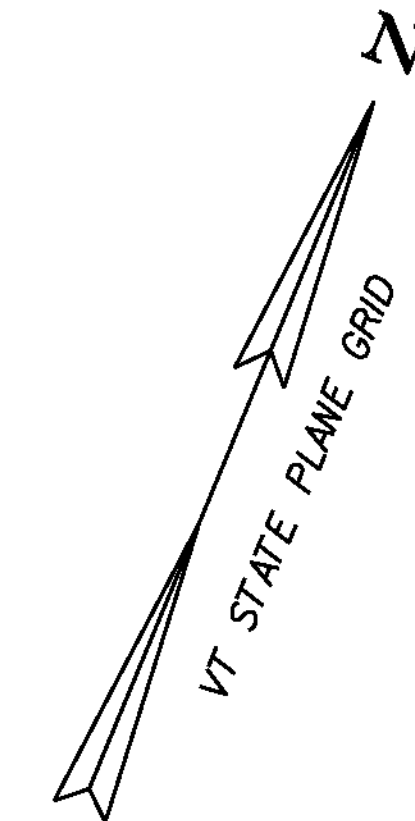

SOIL INFORMATION  
 COLTON GRAVELLY LOAMY SAND  
 HYDRO GROUP A  
 WELL DRAINED  
 POTENTIALLY HIGHLY ERODIBLE


SOIL INFORMATION  
 BERKSHIRE FINE LOAMY SAND  
 HYDRO GROUP B  
 HIGHLY ERODIBLE



SCALE 1" = 20'-0"

----- SOIL BOUNDARY

PROJECT NAME: WOODFORD  
 PROJECT NUMBER: ER BHF 010-1(44)

FILE NAME: s11b214EPSC bdr.dgn PLOT DATE: 23-MAR-2012  
 PROJECT LEADER: CAROLYN CARLSON DRAWN BY: EVANS-MONGEON  
 DESIGNED BY: M.EVANS-MONGEON CHECKED BY: G. ROY  
 EPSC EXISTING CONDITION (3) SHEET 50 OF 58

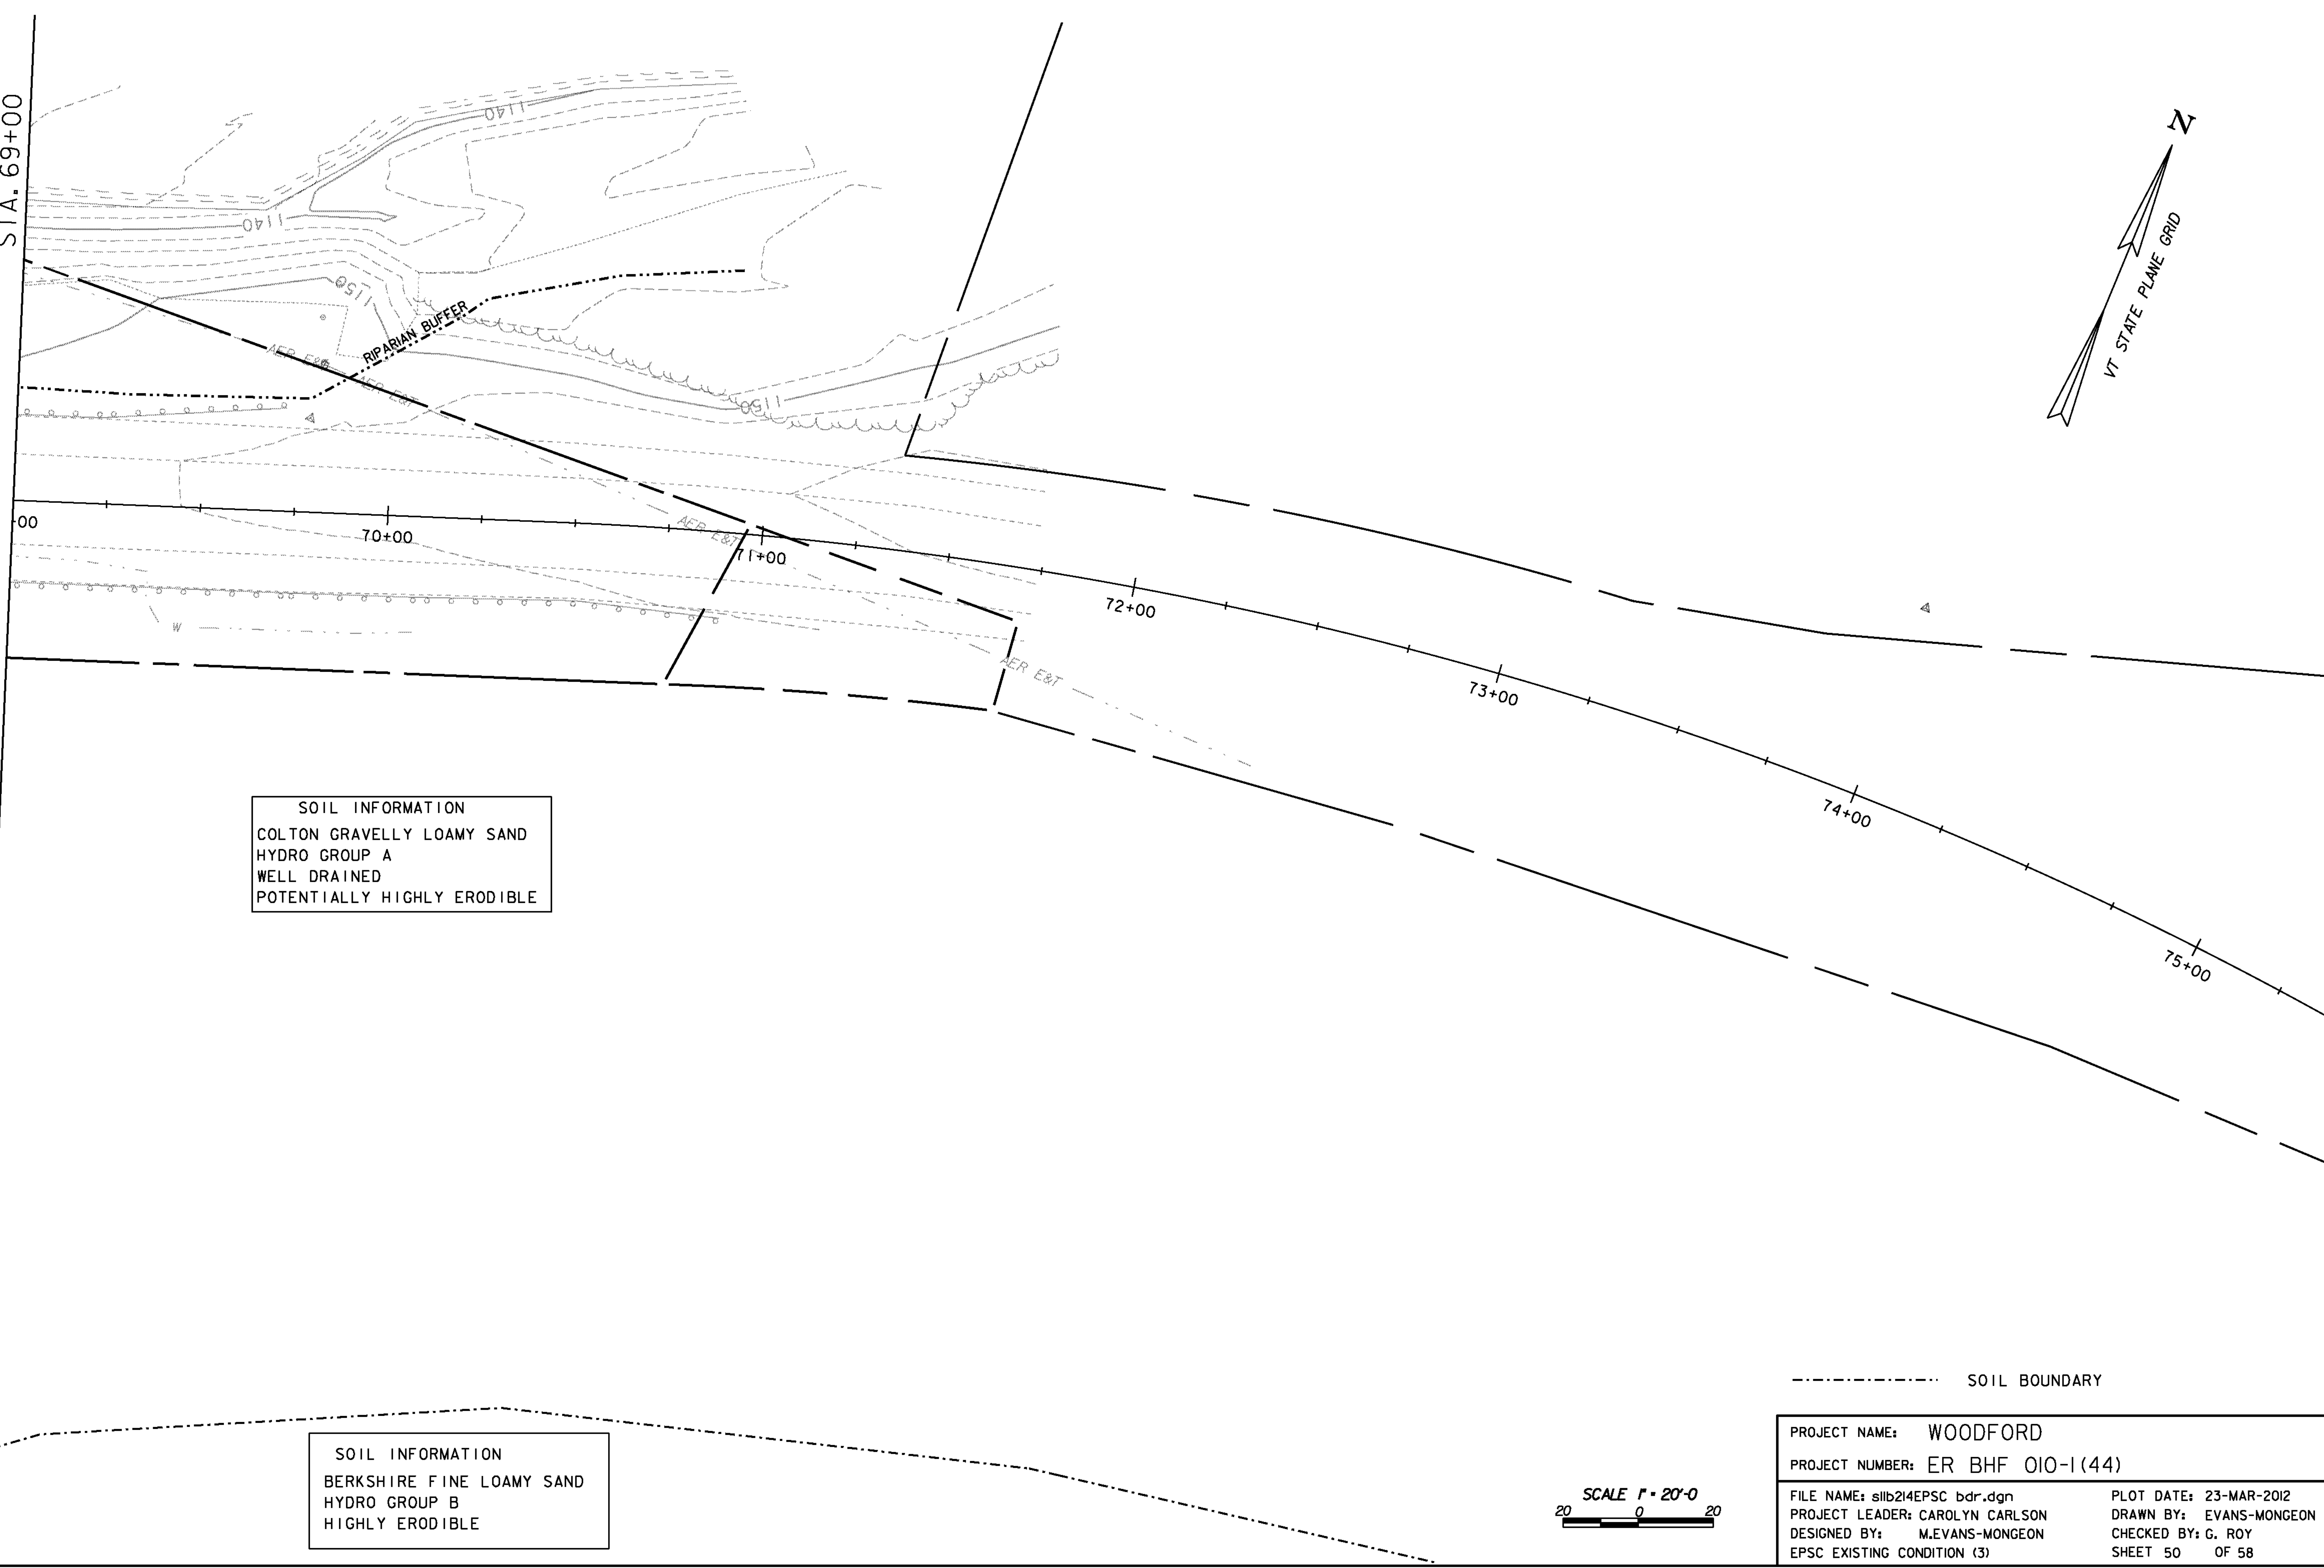

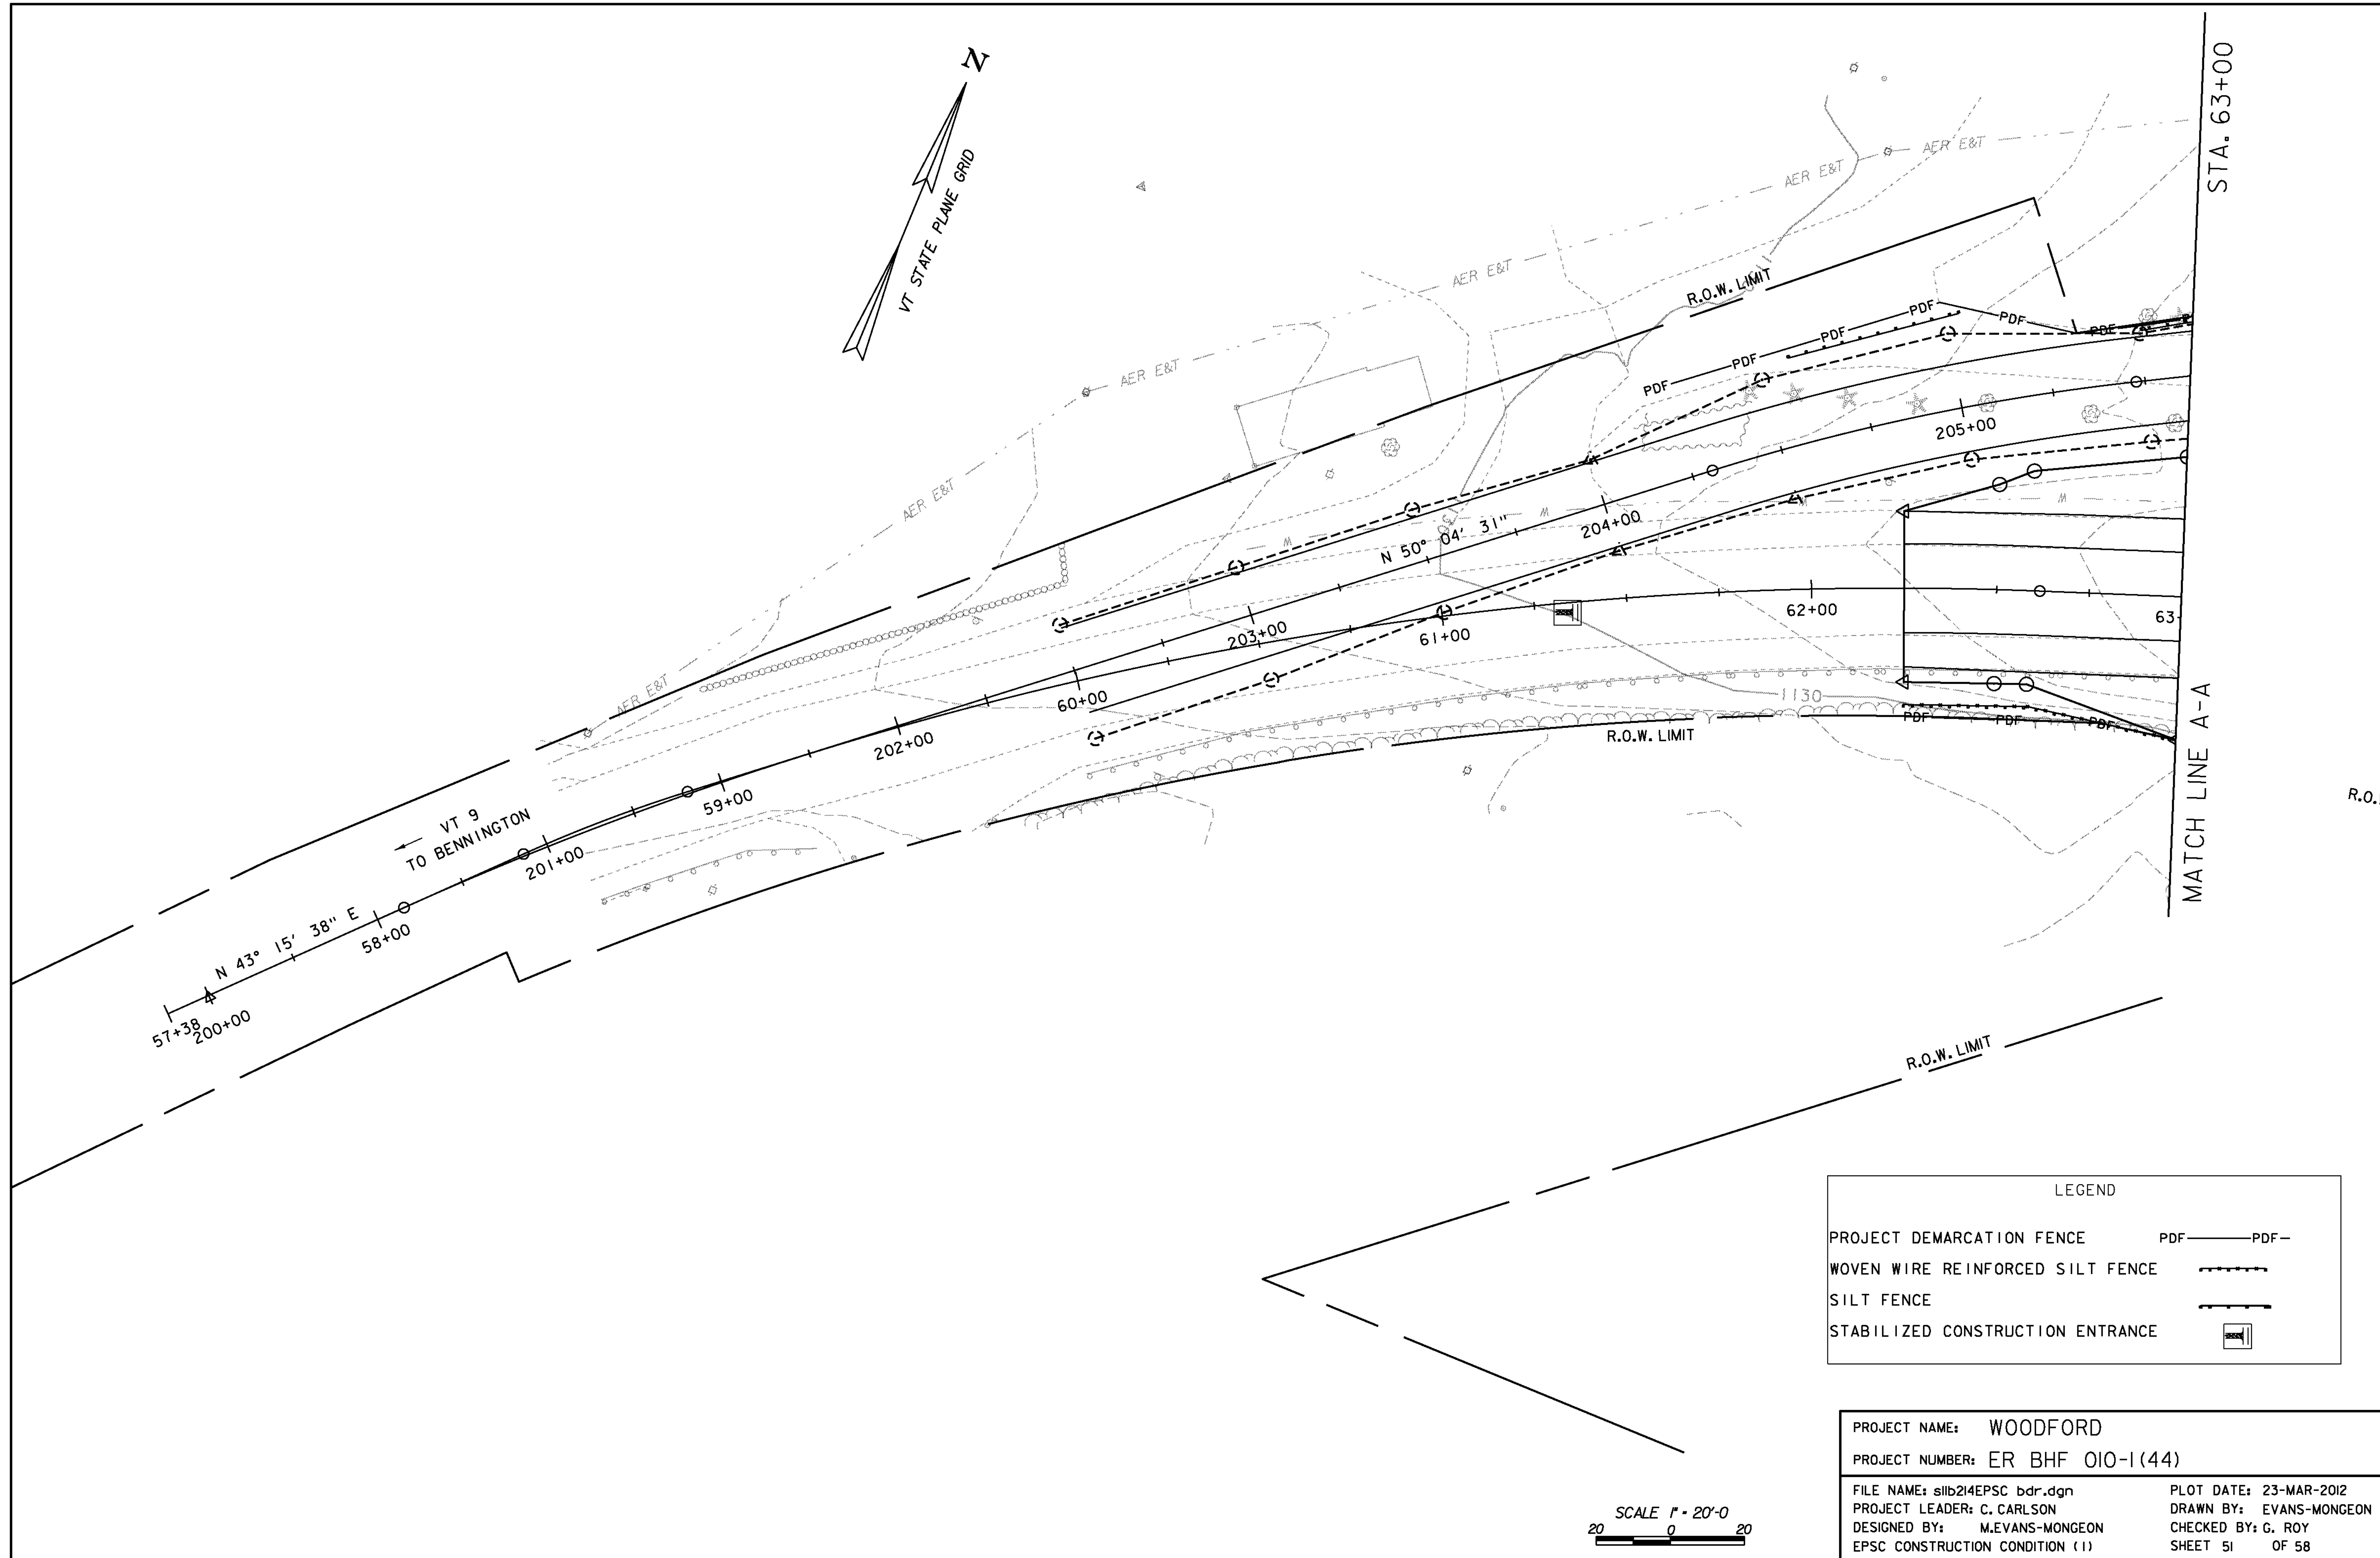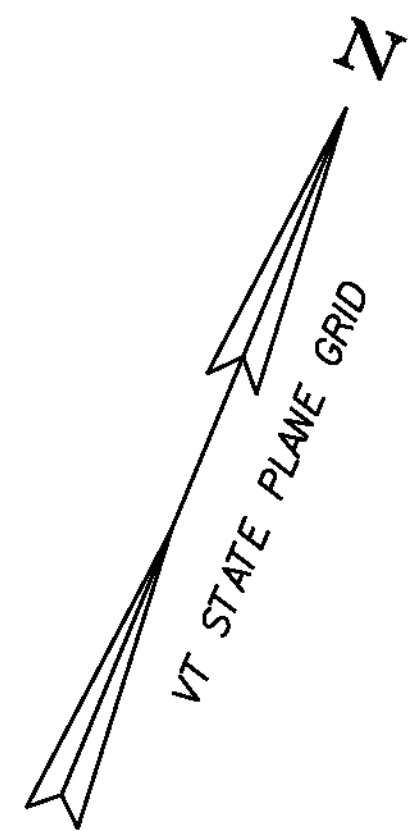


STA. 63+00


MATCH LINE A-A

R.O.

LEGEND	
PROJECT DEMARCATION FENCE	PDF — PDF —
WOVEN WIRE REINFORCED SILT FENCE	— — — — —
SILT FENCE	— — — — —
STABILIZED CONSTRUCTION ENTRANCE	

PROJECT NAME:	WOODFORD
PROJECT NUMBER:	ER BHF 010-1(44)
FILE NAME:	s1lb214EPSC bdr.dgn
PROJECT LEADER:	C. CARLSON
DESIGNED BY:	M. EVANS-MONGEON
EPSC CONSTRUCTION CONDITION (1)	
PLOT DATE:	23-MAR-2012
DRAWN BY:	EVANS-MONGEON
CHECKED BY:	G. ROY
SHEET	51 OF 58

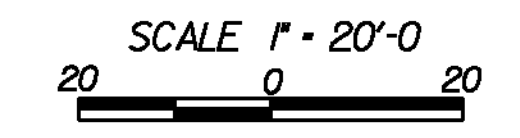

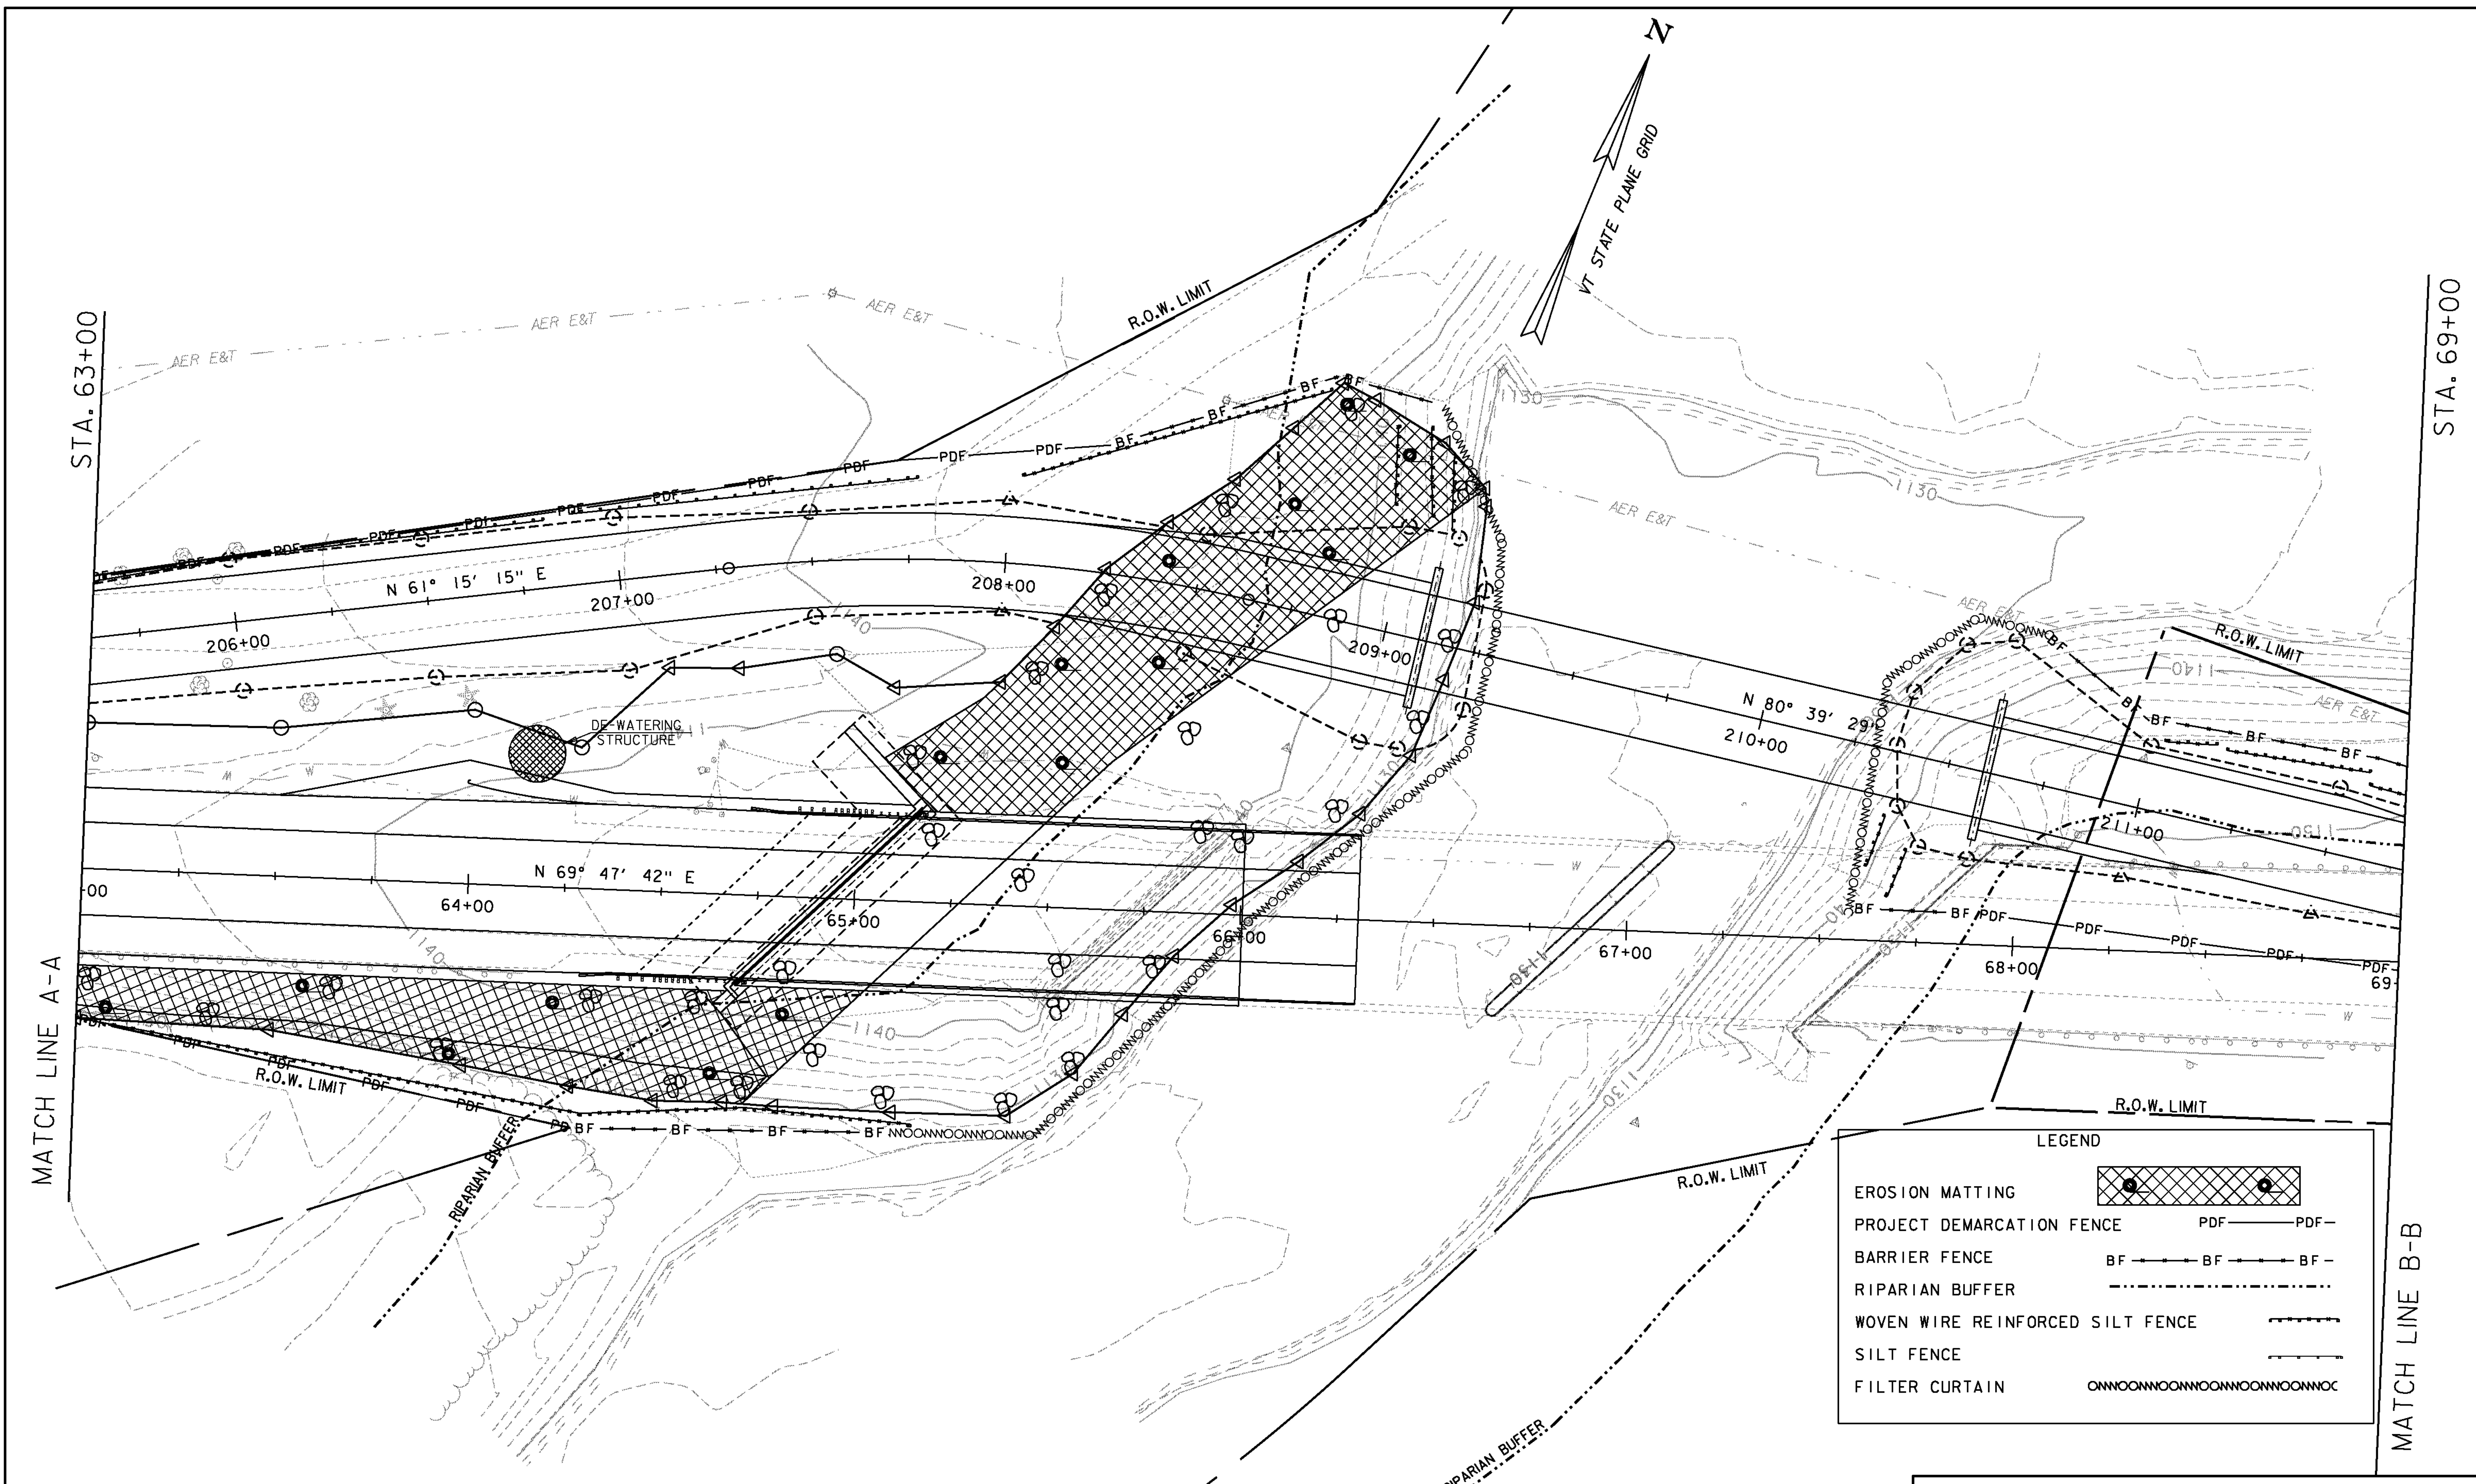


STA. 63+00

STA. 69+00


MATCH LINE A-A

MATCH LINE B-B

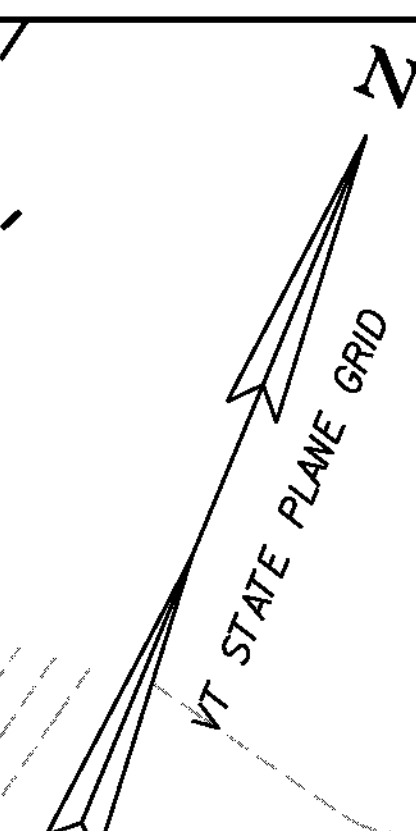

LEGEND

EROSION MATTING	
PROJECT DEMARCATION FENCE	PDF — PDF —
BARRIER FENCE	BF — BF — BF —
RIPARIAN BUFFER	.....
WOVEN WIRE REINFORCED SILT FENCE	-----
SILT FENCE	-----
FILTER CURTAIN	ONNOONNOONNOONNOONNOONNO

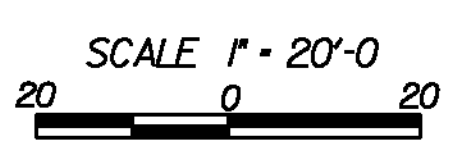


PROJECT NAME:	WOODFORD
PROJECT NUMBER:	ER BHF 010-1(44)
FILE NAME:	slb214EPSC bdr.dgn
PROJECT LEADER:	C. CARLSON
DESIGNED BY:	M. EVANS-MONGEON
EPSC CONSTRUCTION CONDITION (2)	
PLOT DATE:	23-MAR-2012
DRAWN BY:	EVANS-MONGEON
CHECKED BY:	G. ROY
SHEET	52 OF 58




STA. 69+00


MATCH LINE B-B

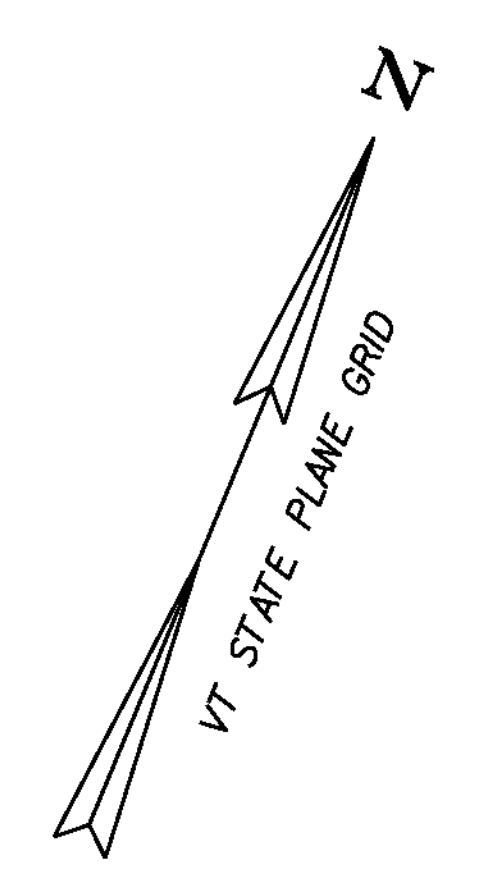

LEGEND	
PROJECT DEMARCATION FENCE	PDF—PDF—
BARRIER FENCE	BF—BF—BF—
WOVEN WIRE REINFORCED SILT FENCE	—+—+—+—+—
SILT FENCE	—+—+—+—+—
STABILIZED CONSTRUCTION ENTRANCE	


PROJECT NAME:	WOODFORD
PROJECT NUMBER:	ER BHF 010-1(44)
FILE NAME:	s11b214EPSC bdr.dgn
PROJECT LEADER:	CAROLYN CARLSON
DESIGNED BY:	M.EVANS-MONGEON
EPSC CONSTRUCTION CONDITION (3)	
PLOT DATE:	23-MAR-2012
DRAWN BY:	EVANS-MONGEON
CHECKED BY:	G. ROY
SHEET	53 OF 58

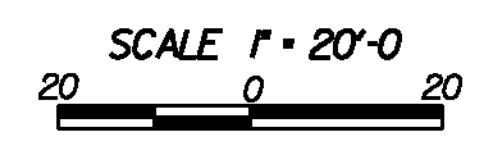

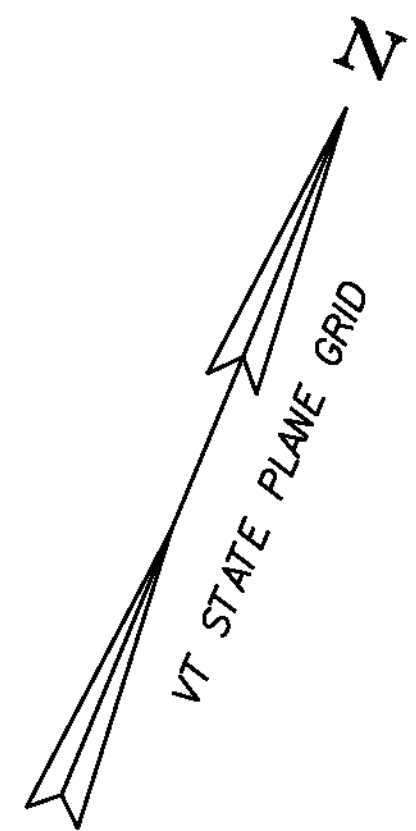

STA. 63+00

MATCH LINE A-A

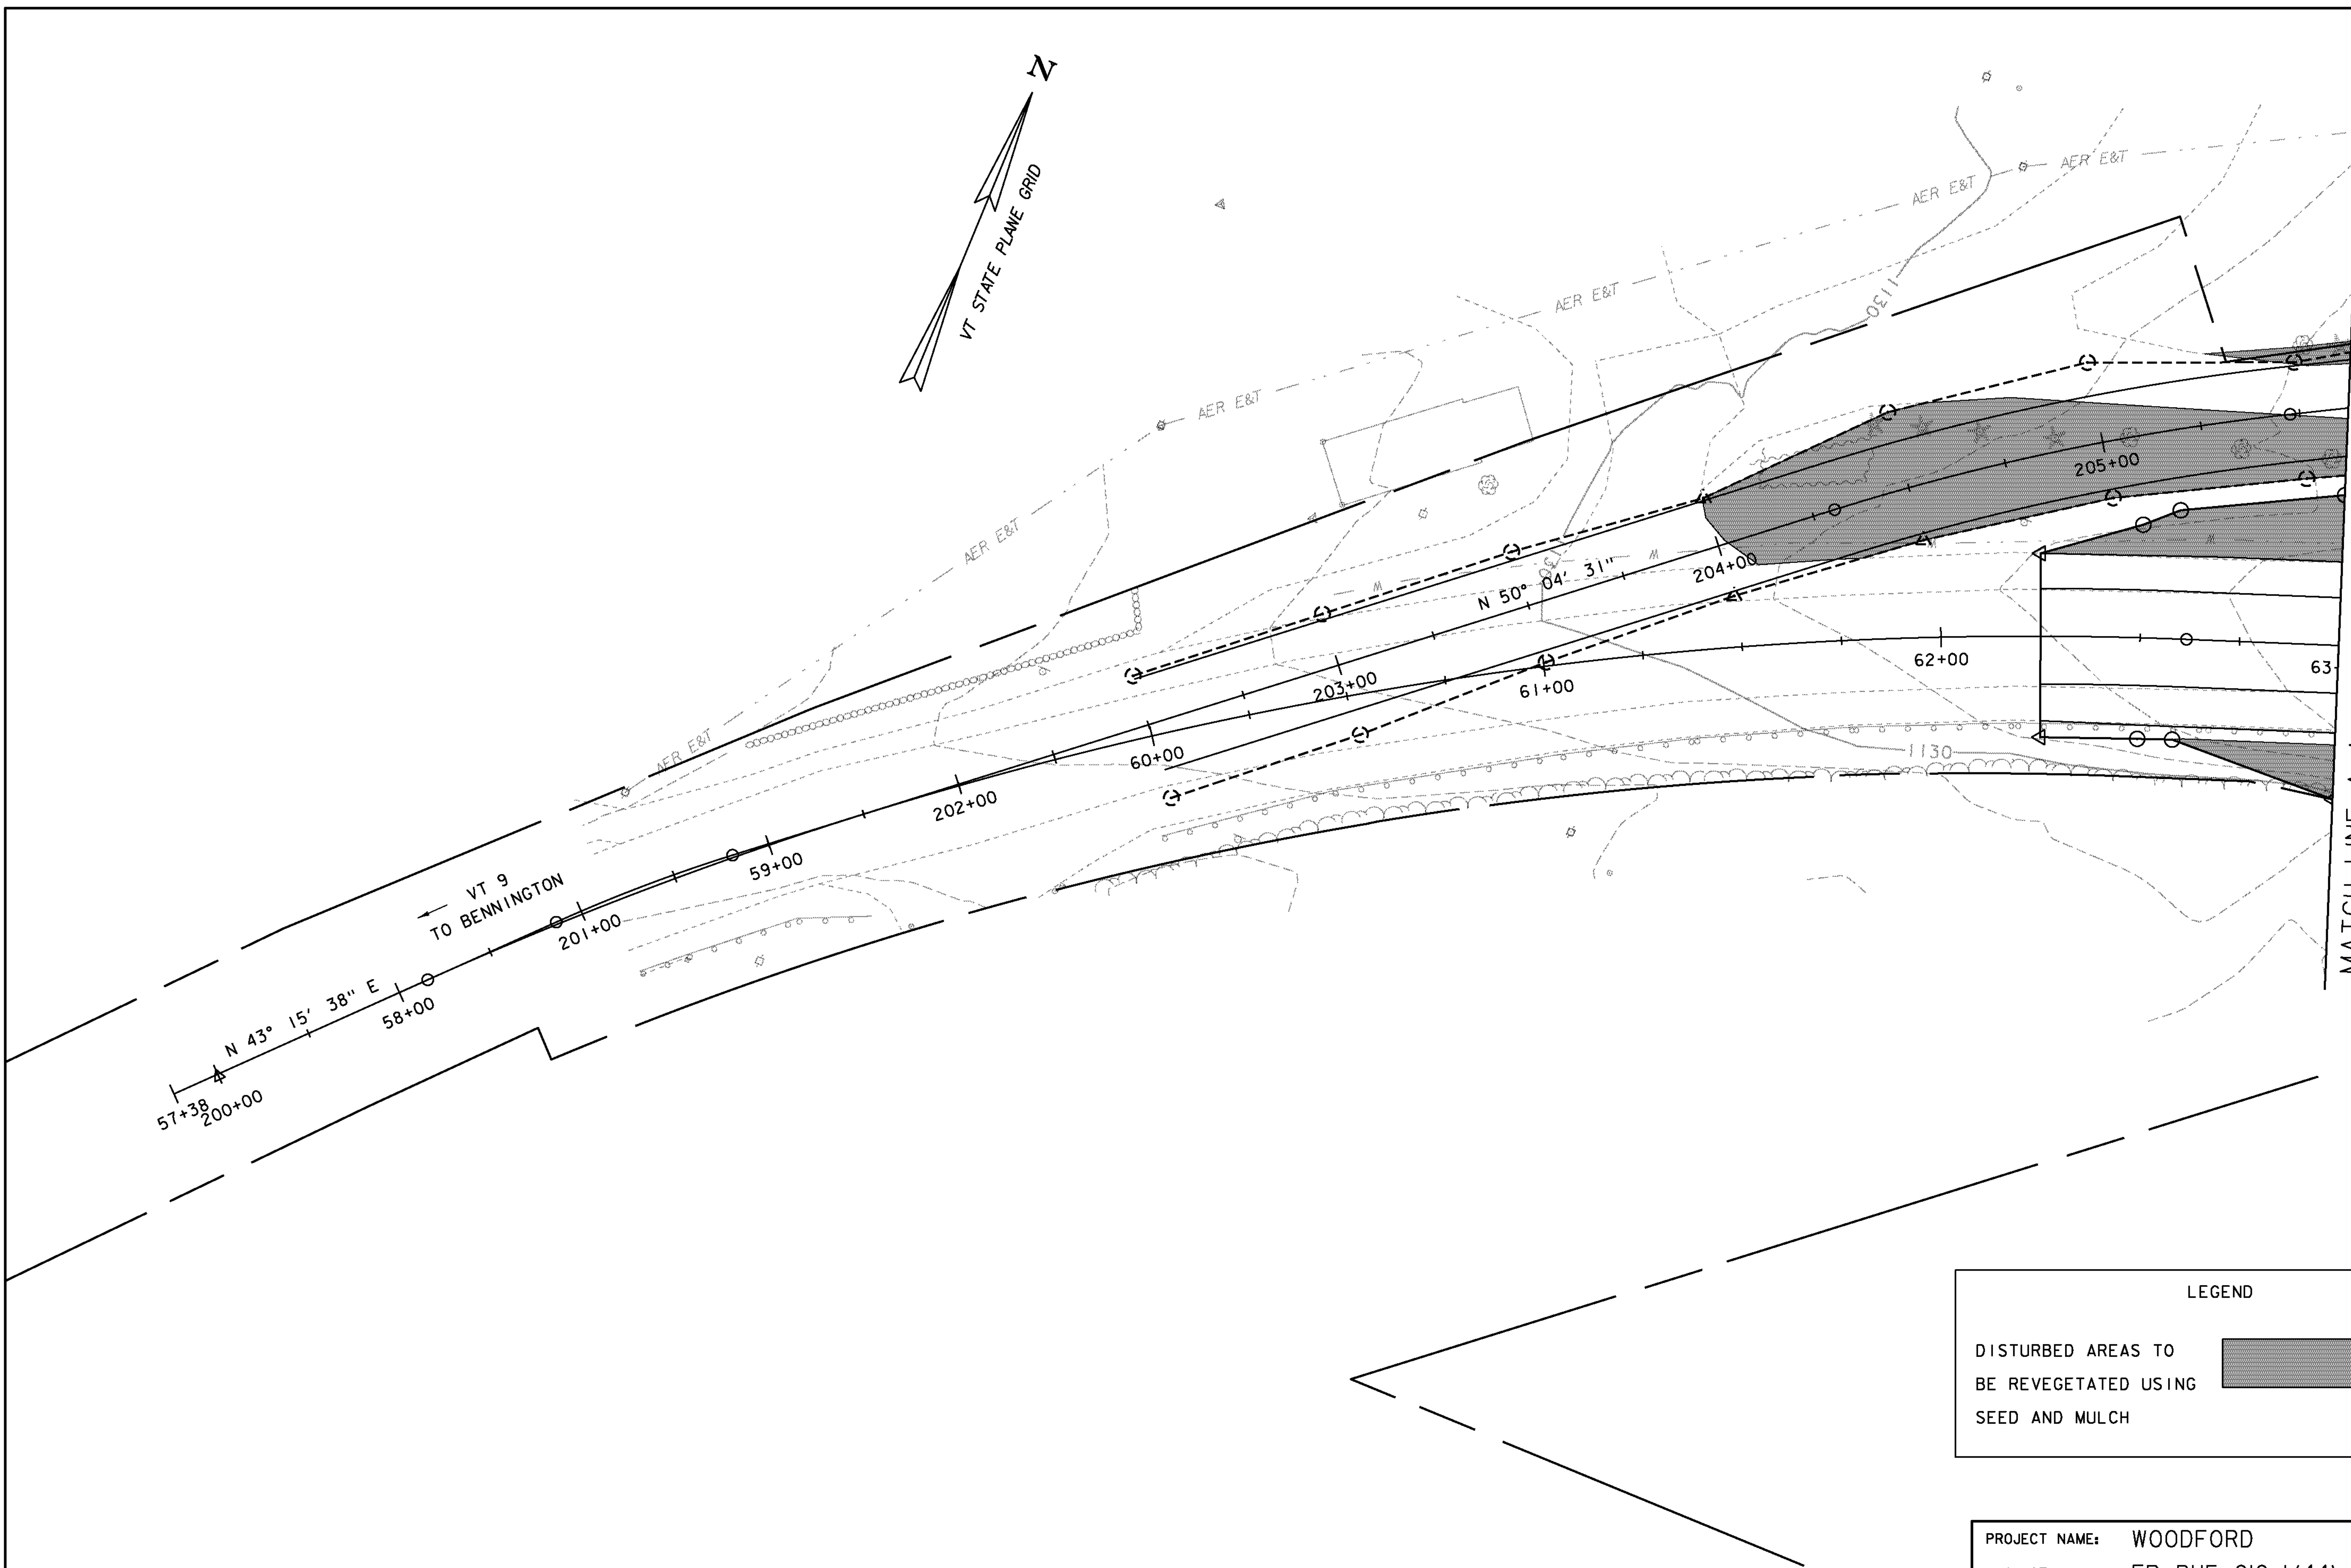


LEGEND

DISTURBED AREAS TO BE REVEGETATED USING SEED AND MULCH

SCALE 1" = 20'-0"

PROJECT NAME:	WOODFORD
PROJECT NUMBER:	ER BHF 010-1(44)
FILE NAME:	s1lb214EPSC bdr.dgn
PROJECT LEADER:	C. CARLSON
DESIGNED BY:	M. EVANS-MONGEON
EPSC FINAL CONDITION (1)	
PLOT DATE:	23-MAR-2012
DRAWN BY:	EVANS-MONGEON
CHECKED BY:	G. ROY
SHEET	54 OF 58

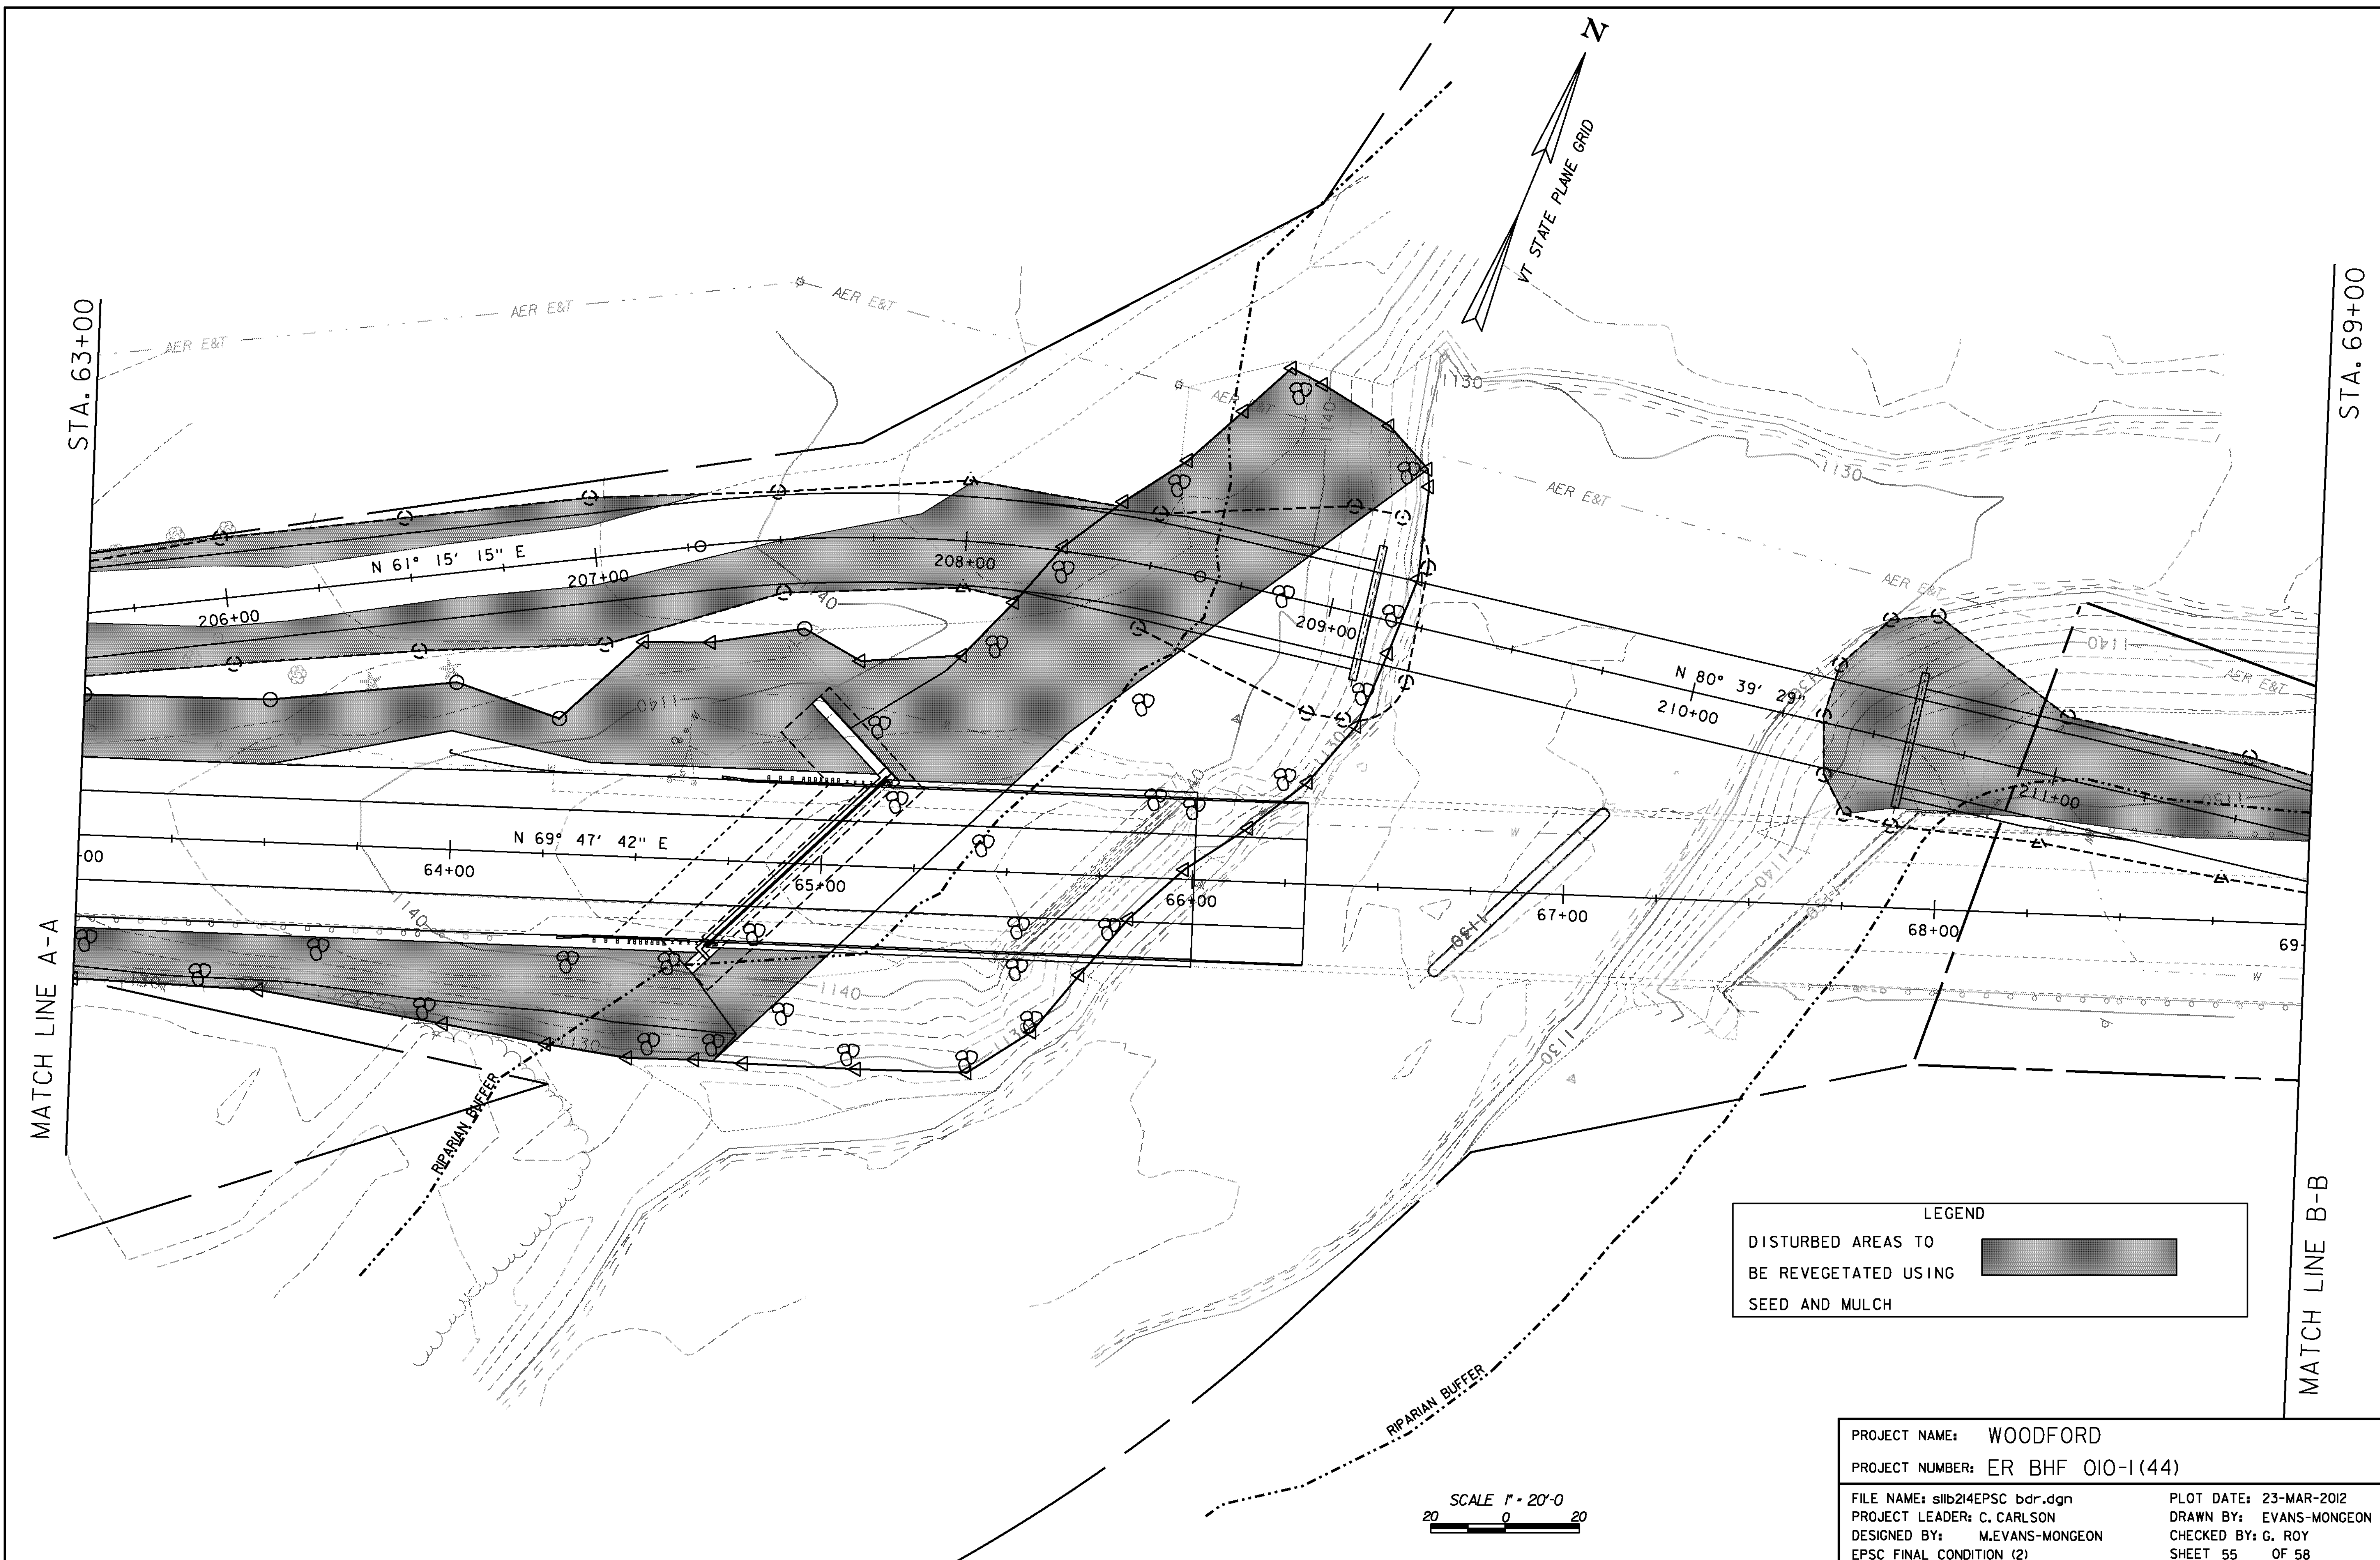

STA. 63+00

STA. 69+00



MATCH LINE A-A


MATCH LINE B-B

LEGEND  
 DISTURBED AREAS TO  
 BE REVEGETATED USING  
 SEED AND MULCH


SCALE 1" = 20'-0"  
 20 0 20

PROJECT NAME:	WOODFORD
PROJECT NUMBER:	ER BHF 010-1(44)
FILE NAME:	s11b214EPSC bdr.dgn
PROJECT LEADER:	C. CARLSON
DESIGNED BY:	M. EVANS-MONGEON
EPSC FINAL CONDITION (2)	
PLOT DATE:	23-MAR-2012
DRAWN BY:	EVANS-MONGEON
CHECKED BY:	G. ROY
SHEET	55 OF 58

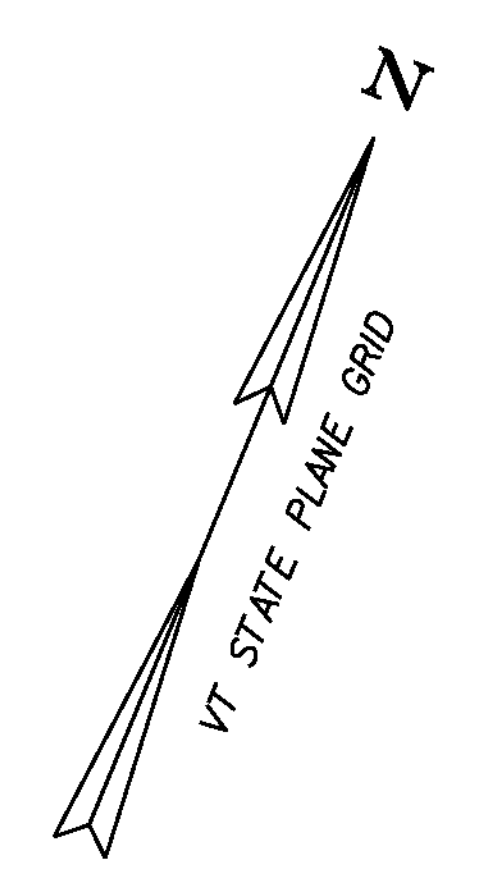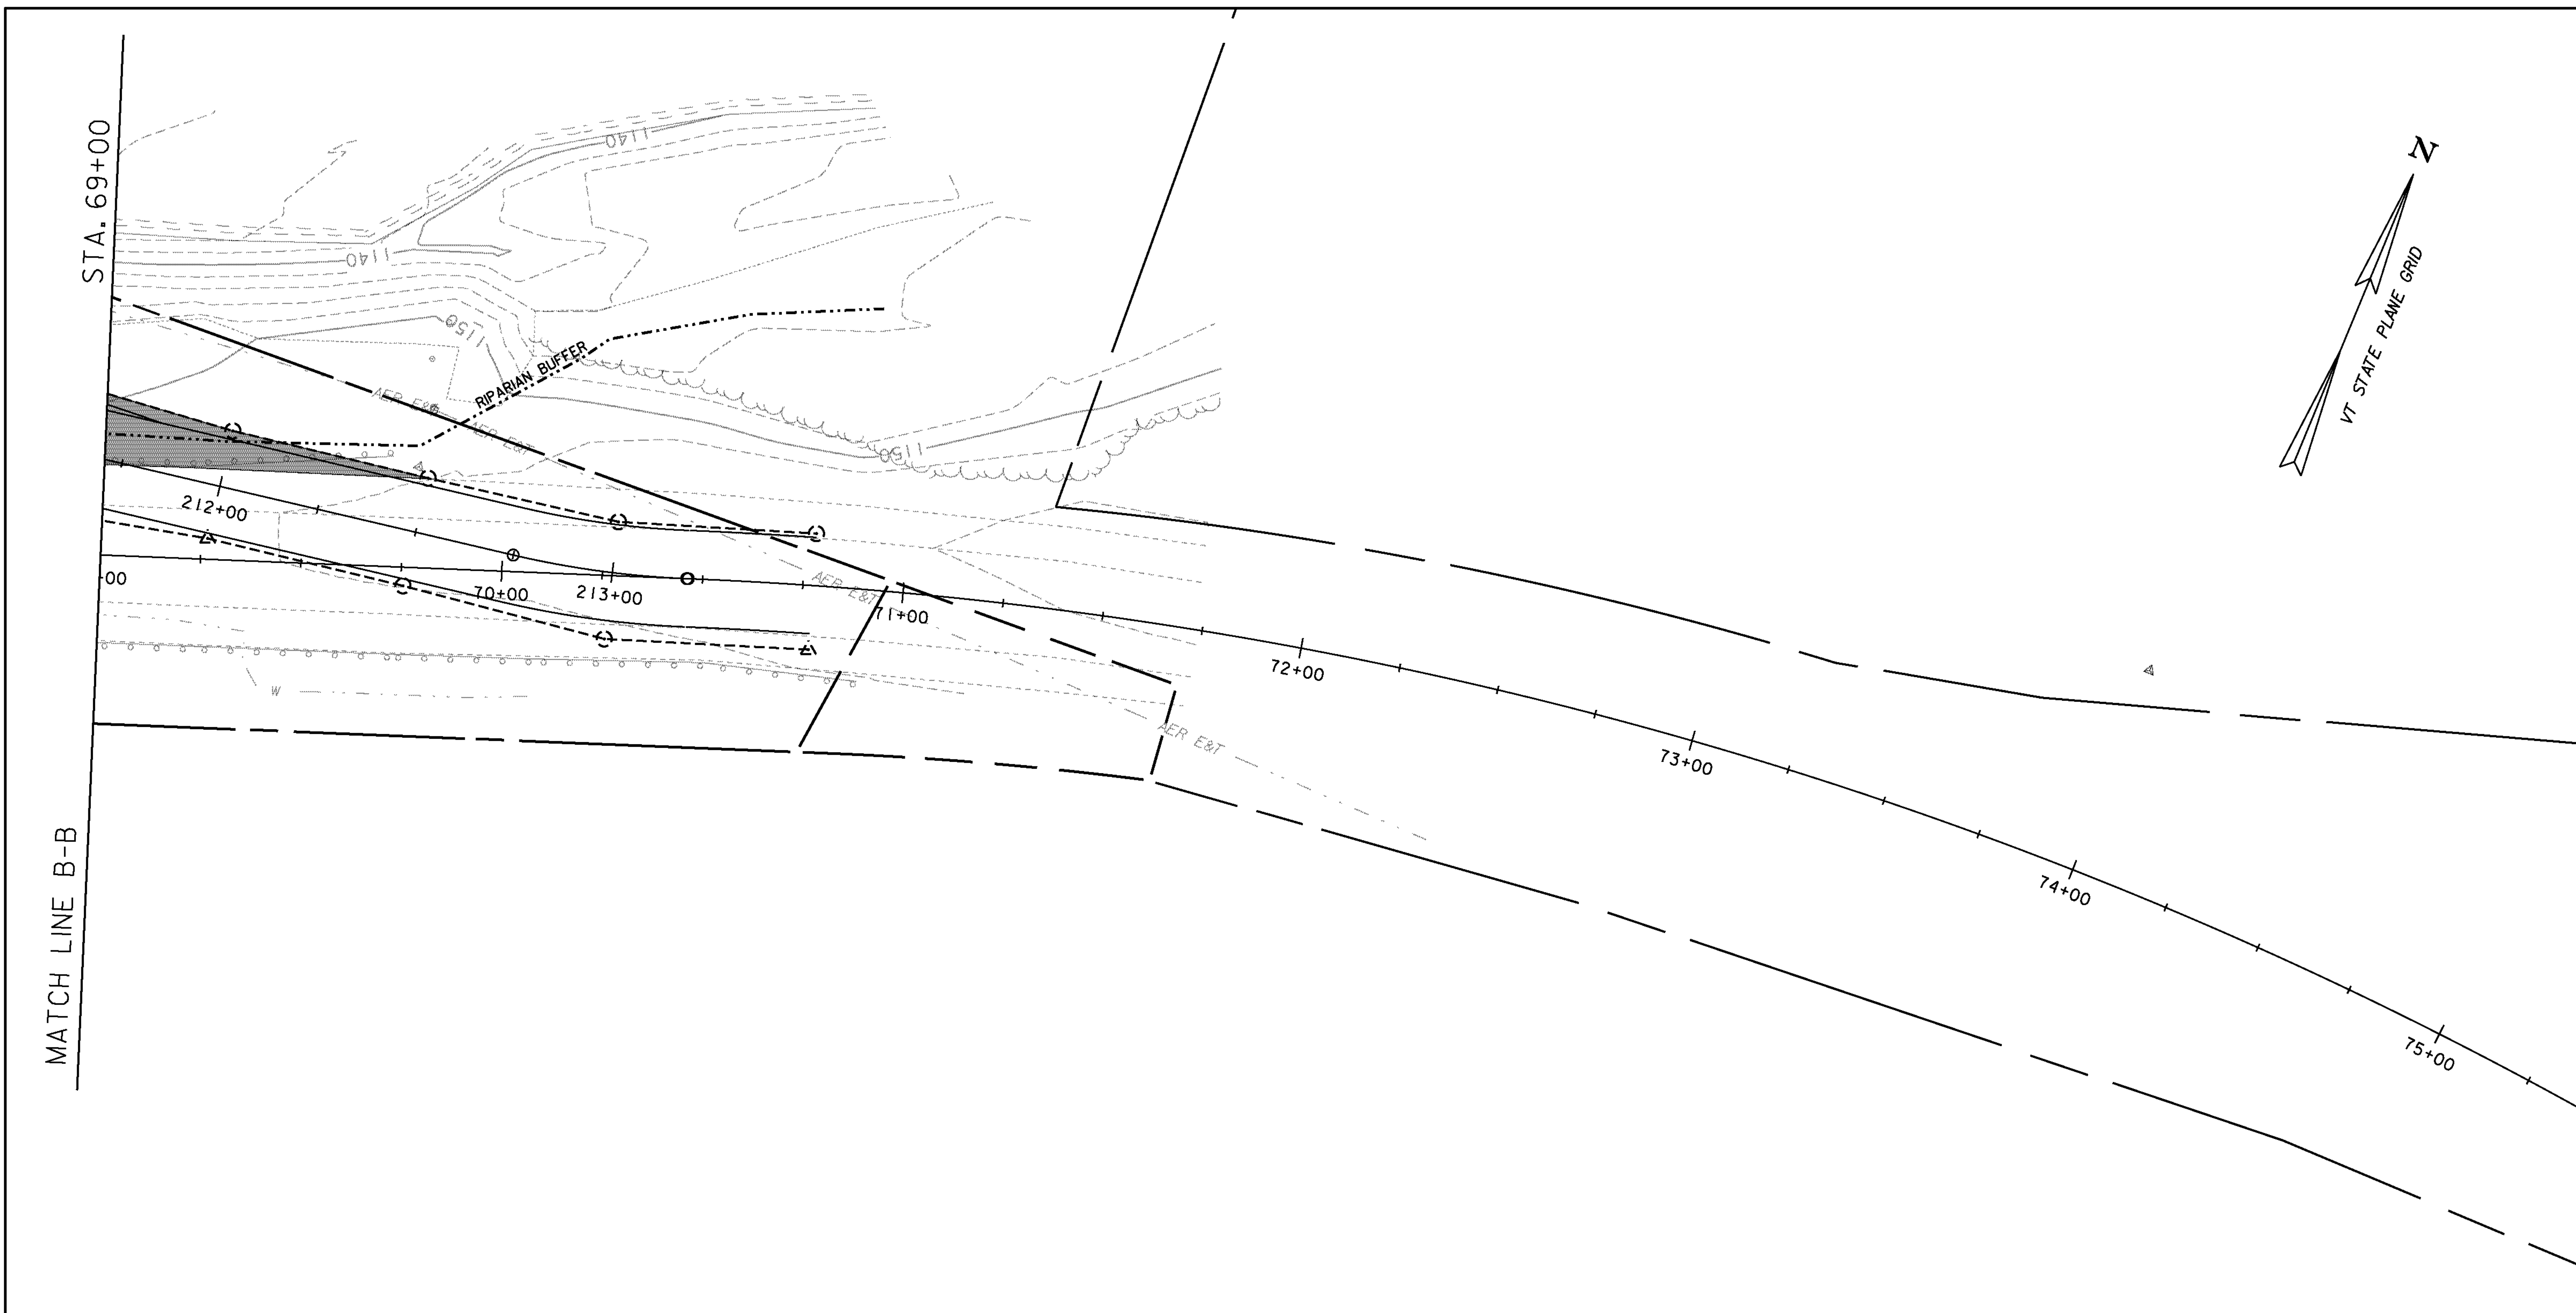

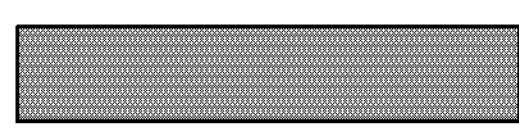LEGEND	
DISTURBED AREAS TO BE REVEGETATED USING SEED AND MULCH	

PROJECT NAME: WOODFORD	PLOT DATE: 23-MAR-2012
PROJECT NUMBER: ER BHF 010-1(44)	DRAWN BY: EVANS-MONGEON
FILE NAME: s11b214EPSC bdr.dgn	CHECKED BY: G. ROY
PROJECT LEADER: CAROLYN CARLSON	SHEET 56 OF 58
DESIGNED BY: M.EVANS-MONGEON	
EPSC FINAL CONDITION (3)	

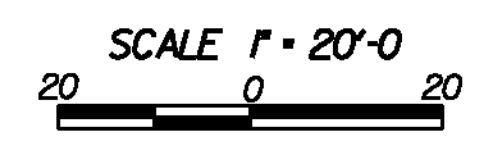

MATCH LINE B-B

STA. 69+00

212+00  
70+00  
213+00  
71+00  
72+00  
73+00  
74+00  
75+00

RIPARIAN BUFFER

ACR E&B

ACR E&T

ACR E&T


1140

1140

1150

1100

W

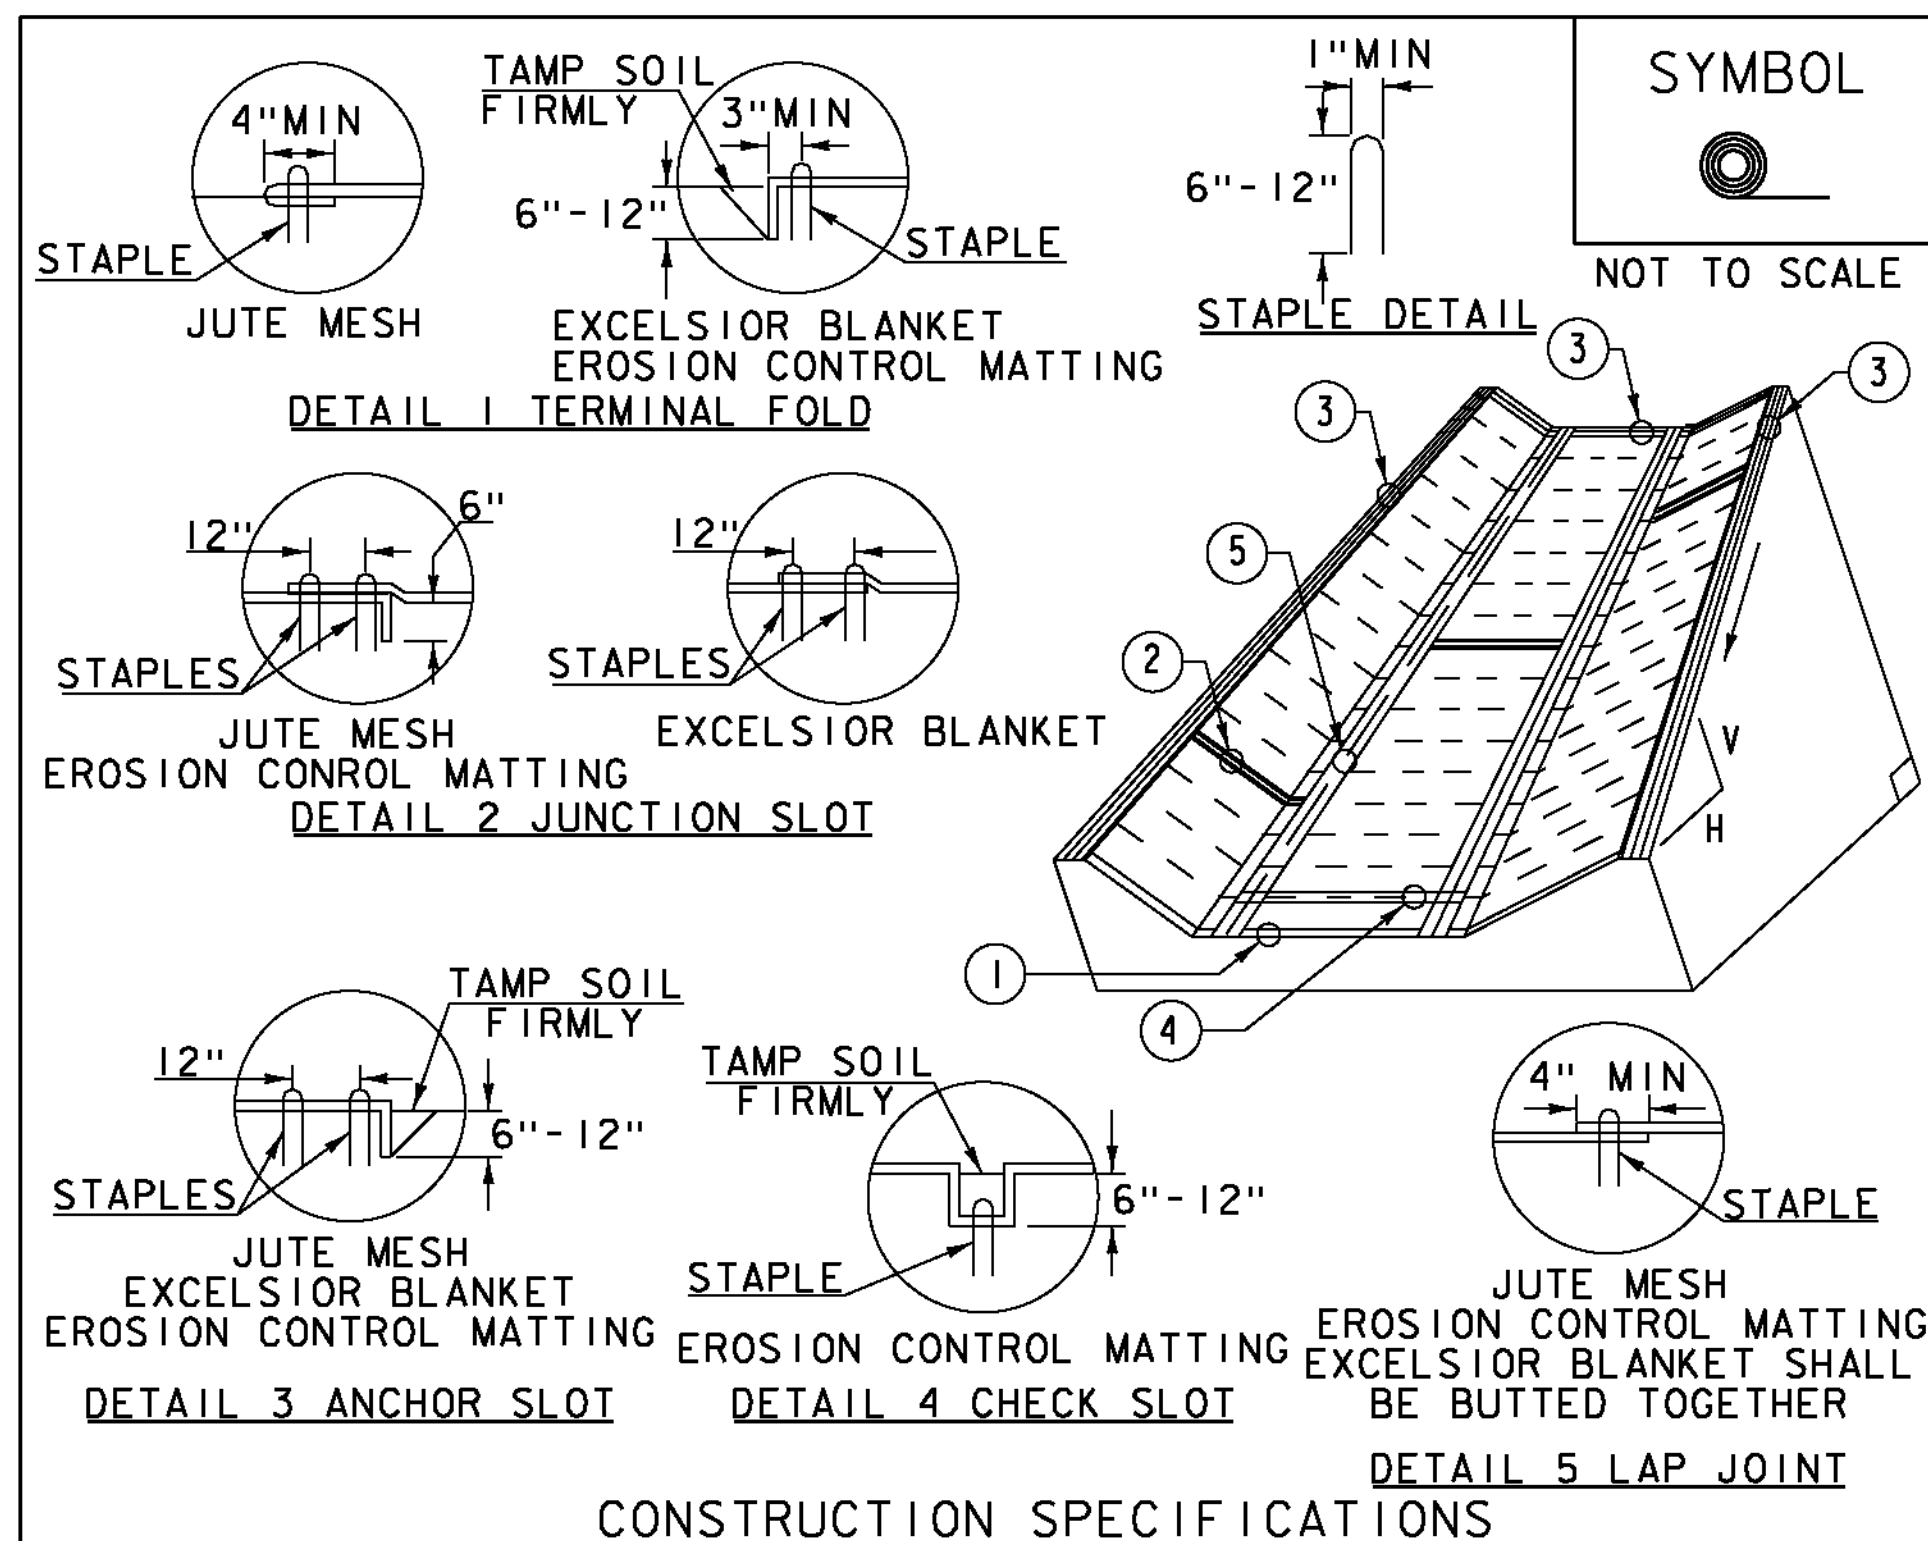

**CONSTRUCTION SPECIFICATIONS**


1. EROSION MATTING, CHECK SLOTS, SHALL BE SPACED IN DITCH CHANNEL SO THAT ONE OCCURS WITHIN EACH 50' ON SLOPES OF MORE THAN 4% AND LESS THAN 6%. ON SLOPES OF 6% OR MORE, THEY SHALL BE SPACED SO THAT ONE OCCURS WITHIN EACH 25'.
2. APPLY FERTILIZER, LIME SEED PRIOR TO PLACING MATTING.
3. STAPLES ARE TO BE PLACED ALTERNATELY, IN COLUMNS APPROXIMATELY 2' APART AND IN ROWS APPROXIMATELY 3' APART. APPROXIMATELY 175 STAPLES ARE REQUIRED PER 4' X 225' ROLL OF MATERIAL AND 125 STAPLES ARE REQUIRED PER 4' X 150' ROLL OF MATERIAL.
4. DISTURBED AREAS SHALL BE SMOOTHLY GRADED. EROSION CONTROL MATERIAL SHALL BE PLACED LOOSELY OVER GROUND SURFACE. DO NOT STRETCH.
5. ALL TERMINAL ENDS AND TRANSVERSE LAPS SHALL BE STAPLED AT APPROXIMATELY 12" INTERVALS.

ADAPTED FROM DETAILS PROVIDED BY: NEW YORK STATE DEC  
ORIGINALLY DEVELOPED BY USDA-NRCS  
VERMONT DEPARTMENT OF ENVIRONMENTAL CONSERVATION

**ROLLED EROSION CONTROL PRODUCT (RECP) DITCH**

NOTES:  
REFER TO "THE VERMONT STANDARDS & SPECIFICATIONS FOR EROSION PREVENTION & SEDIMENT CONTROL -2006-" FROM THE VT AGENCY OF NATURAL RESOURCES FOR ADDITIONAL GUIDANCE.  
THIS WORK SHALL BE PERFORMED IN ACCORDANCE WITH SECTION 653 AND AS SHOWN IN THE PLANS FOR TEMPORARY EROSION MATTING (PAY ITEM 653.20) OR PERMANENT EROSION MATTING (PAY ITEM 653.21).

REVISIONS		
MARCH 8, 2007	JMF	
APRIL 16, 2007	WHF	
JANUARY 13, 2009	WHF	

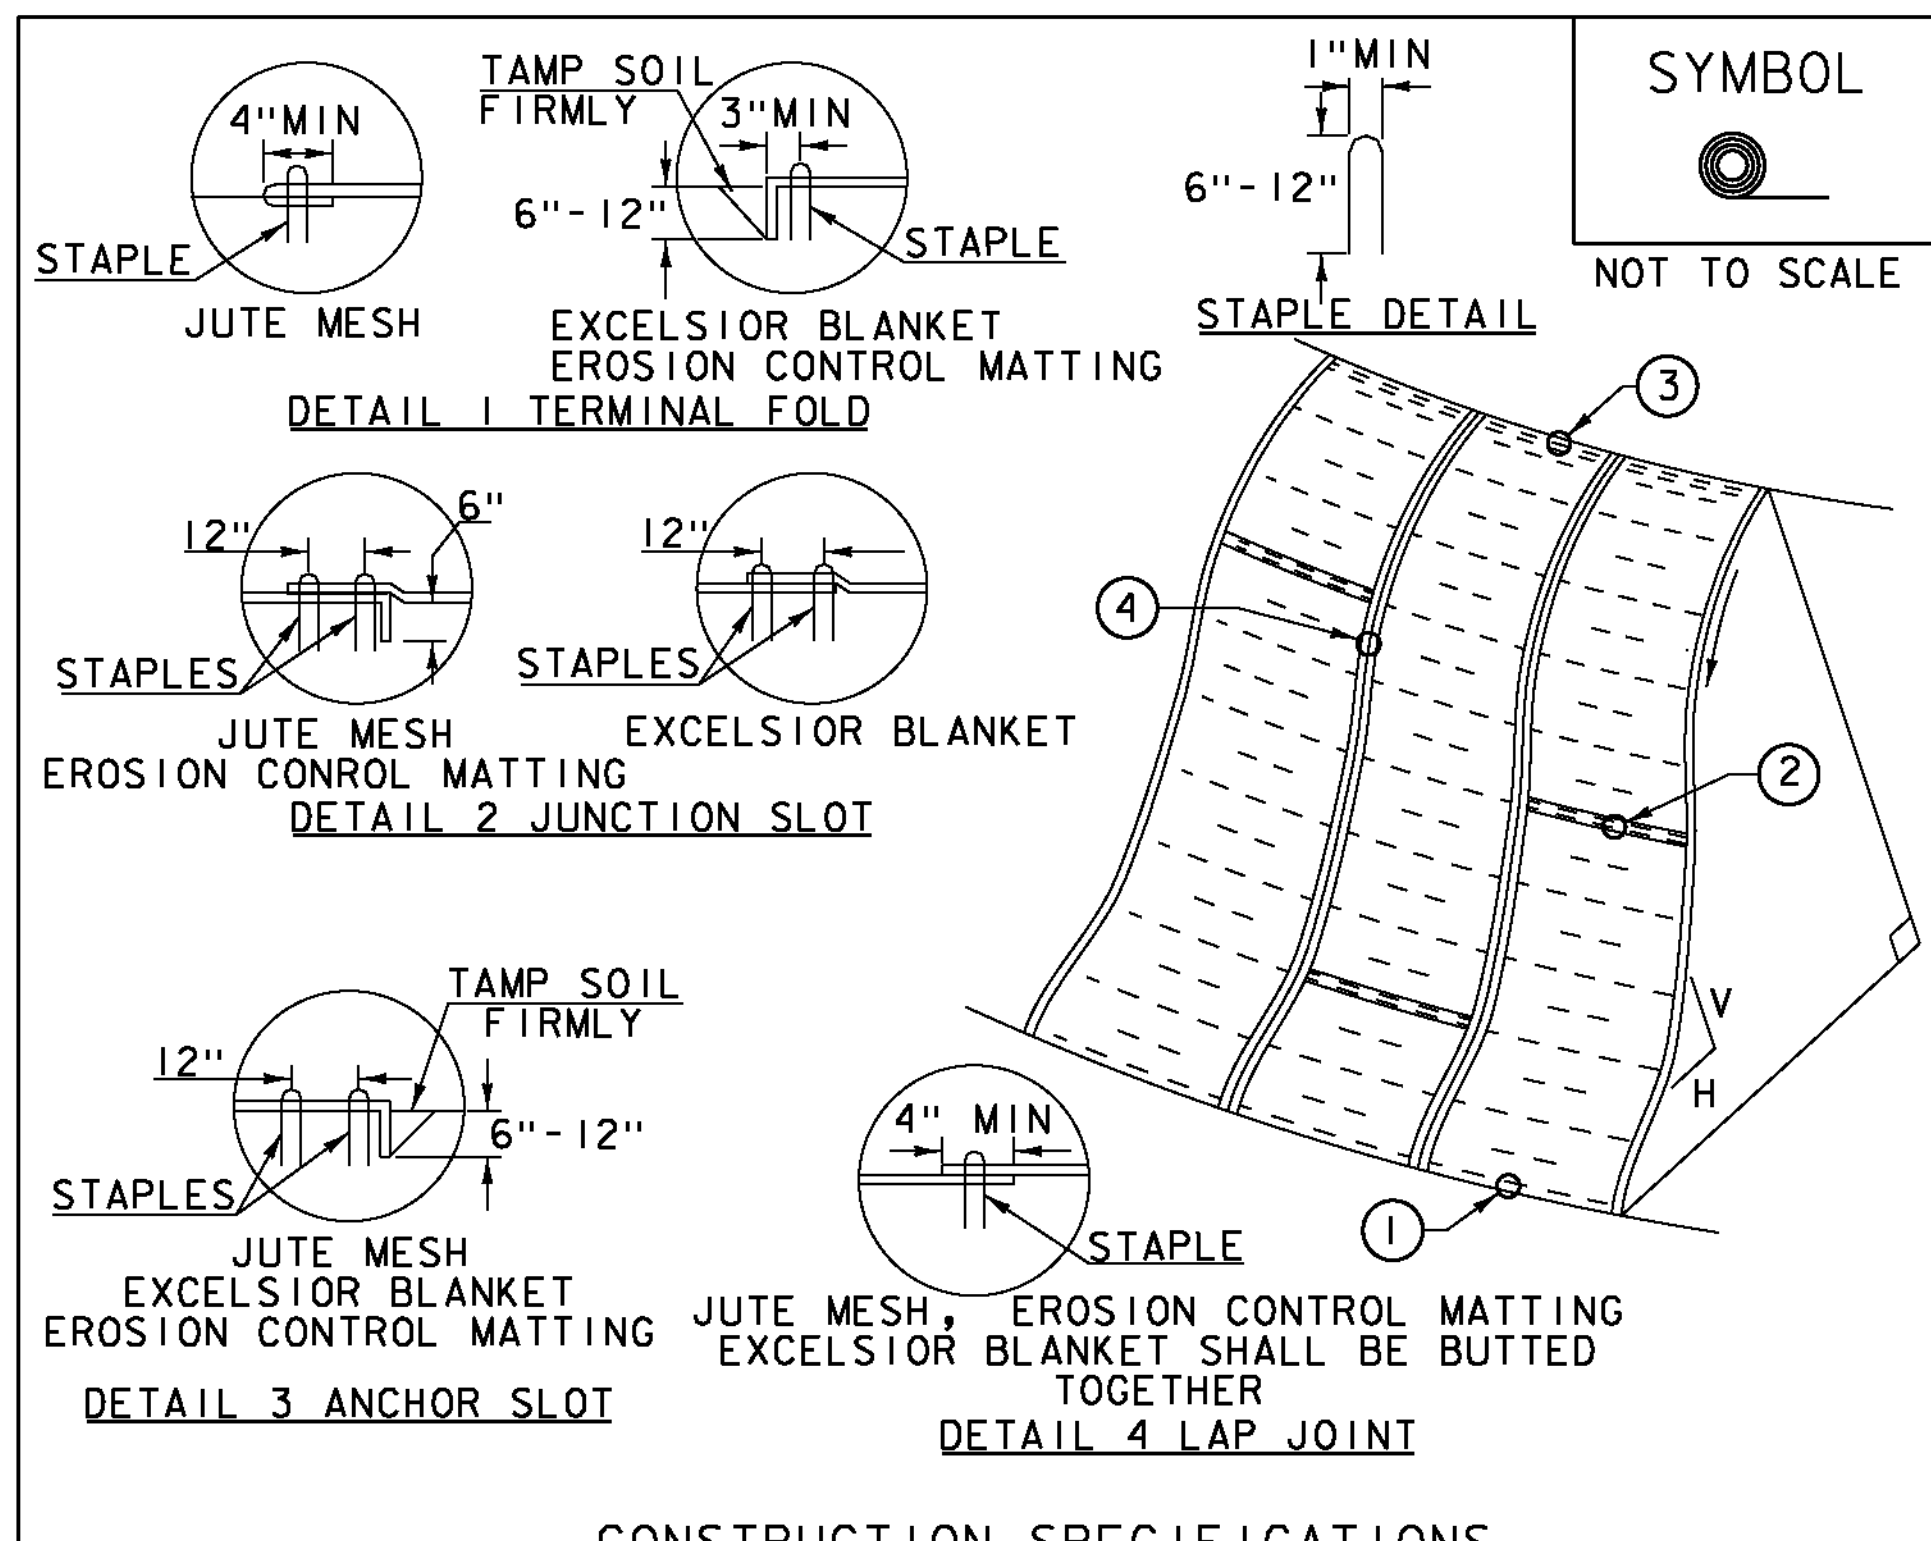

**CONSTRUCTION SPECIFICATIONS**


1. APPLY TO SLOPES GREATER THAN 3H:1V OR WHERE NECESSARY TO AID IN ESTABLISHING VEGETATION.
2. APPLY FERTILIZER, LIME SEED PRIOR TO PLACING MATTING.
3. STAPLES ARE TO BE PLACED ALTERNATELY, IN COLUMNS APPROXIMATELY 2' APART AND IN ROWS APPROXIMATELY 3' APART. APPROXIMATELY 175 STAPLES ARE REQUIRED PER 4' X 225' ROLL OF MATERIAL AND 125 STAPLES ARE REQUIRED PER 4' X 150' ROLL OF MATERIAL.
4. DISTURBED AREAS SHALL BE SMOOTHLY GRADED. EROSION CONTROL MATERIAL SHALL BE PLACED LOOSELY OVER GROUND SURFACE. DO NOT STRETCH.
5. ALL TERMINAL ENDS AND TRANSVERSE LAPS SHALL BE STAPLED AT APPROXIMATELY 12" INTERVALS.

ADAPTED FROM DETAILS PROVIDED BY: NEW YORK STATE DEC  
ORIGINALLY DEVELOPED BY USDA-NRCS  
VERMONT DEPARTMENT OF ENVIRONMENTAL CONSERVATION

**ROLLED EROSION CONTROL PRODUCT (RECP) SIDE SLOPE**

NOTES:  
REFER TO "THE VERMONT STANDARDS & SPECIFICATIONS FOR EROSION PREVENTION & SEDIMENT CONTROL -2006-" FROM THE VT AGENCY OF NATURAL RESOURCES FOR ADDITIONAL GUIDANCE.  
THIS WORK SHALL BE PERFORMED IN ACCORDANCE WITH SECTION 653 AND AS SHOWN IN THE PLANS FOR TEMPORARY EROSION MATTING (PAY ITEM 653.20) OR PERMANENT EROSION MATTING (PAY ITEM 653.21).

REVISIONS		
APRIL 16, 2007	JMF	
JANUARY 13, 2009	WHF	

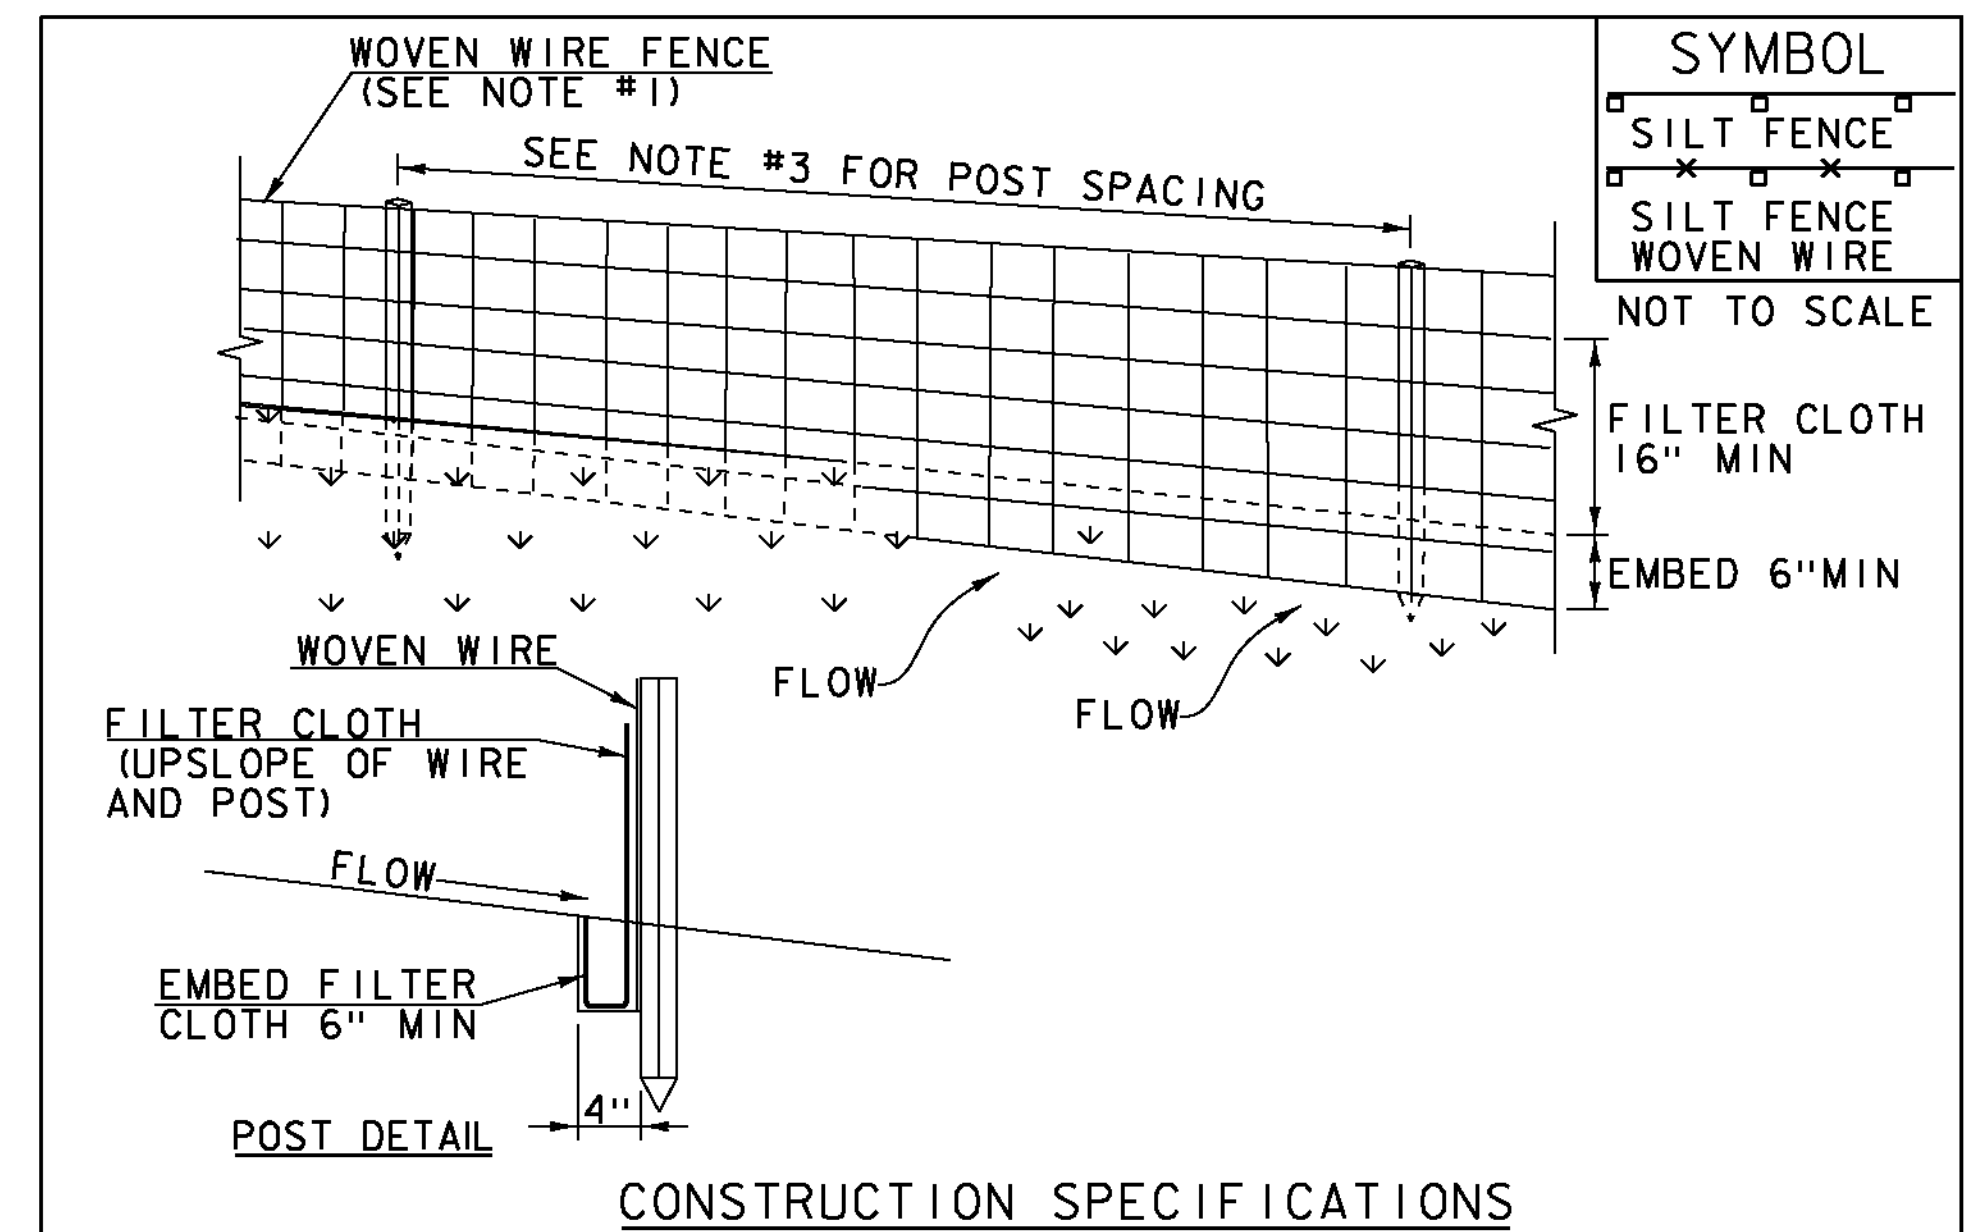

**CONSTRUCTION SPECIFICATIONS**

1. WOVEN WIRE REINFORCED FENCE IS REQUIRED WITHIN 100' UPSLOPE OF RECEIVING WATERS WHEN THE PROJECT FALLS UNDER A CONSTRUCTION STORMWATER PERMIT. WOVEN WIRE SHALL BE A MIN. 14 GAUGE WITH A 6" MAX. MESH OPENING.
2. FILTER CLOTH SHALL BE EITHER FILTER X, MIRAF1100X, STABILINKA T140N OR APPROVED EQUIVALENT.
3. POST SPACING FOR WIRE-BACKED FENCE SHALL BE 10' MAXIMUM. FOR FILTER-CLOTH FENCE, WHEN ELONGATION IS >50%, POST SPACING SHALL NOT EXCEED 4' AND WHEN ELONGATION IS <50%, POST SPACING SHALL NOT EXCEED 6'.
4. WOVEN WIRE FENCE IS TO BE FASTENED SECURELY TO FENCE POSTS WITH WIRE TIES. FILTER CLOTH IS TO BE FASTENED SECURELY TO WOVEN WIRE FENCE WITH TIES SPACED EVERY 24" AT TOP AND MID SECTION.
5. WHEN TWO SECTIONS OF FILTER CLOTH ADJOIN EACH OTHER THEY SHALL BE OVER-LAPPED BY 6" AND FOLDED.
6. MAINTENANCE SHALL BE PERFORMED AS NEEDED AND MATERIAL REMOVED WHEN SEDIMENT REACHES HALF OF FABRIC HEIGHT.

ADAPTED FROM DETAILS PROVIDED BY: NEW YORK STATE DEC  
ORIGINALLY DEVELOPED BY USDA-NRCS  
VERMONT DEPARTMENT OF ENVIRONMENTAL CONSERVATION

**SILT FENCE**


NOTES:  
REFER TO "THE VERMONT STANDARDS & SPECIFICATIONS FOR EROSION PREVENTION & SEDIMENT CONTROL -2006-" FROM THE VT AGENCY OF NATURAL RESOURCES FOR ADDITIONAL GUIDANCE.

THIS WORK SHALL BE PERFORMED IN ACCORDANCE WITH SECTION 649 AND AS SHOWN IN THE PLANS FOR GEOTEXTILE FOR SILT FENCE (PAY ITEM 649.51) OR GEOTEXTILE FOR SILT FENCE, WOVEN WIRE REINFORCED (PAY ITEM 649.515).

REVISIONS		
MARCH 21, 2008	WHF	
DECEMBER 11, 2008	WHF	
JANUARY 13, 2009	WHF	

PROJECT NAME: WOODFORD  
PROJECT NUMBER: ER BHF 010-1(44)

FILE NAME: s1lb214eps details.dgn PLOT DATE: 23-MAR-2012  
PROJECT LEADER: C. CARLSON DRAWN BY: EVANS-MONGEON  
DESIGNED BY: M.EVANS-MONGEON CHECKED BY:  
EPSC DETAILS (1) SHEET 57 OF 58

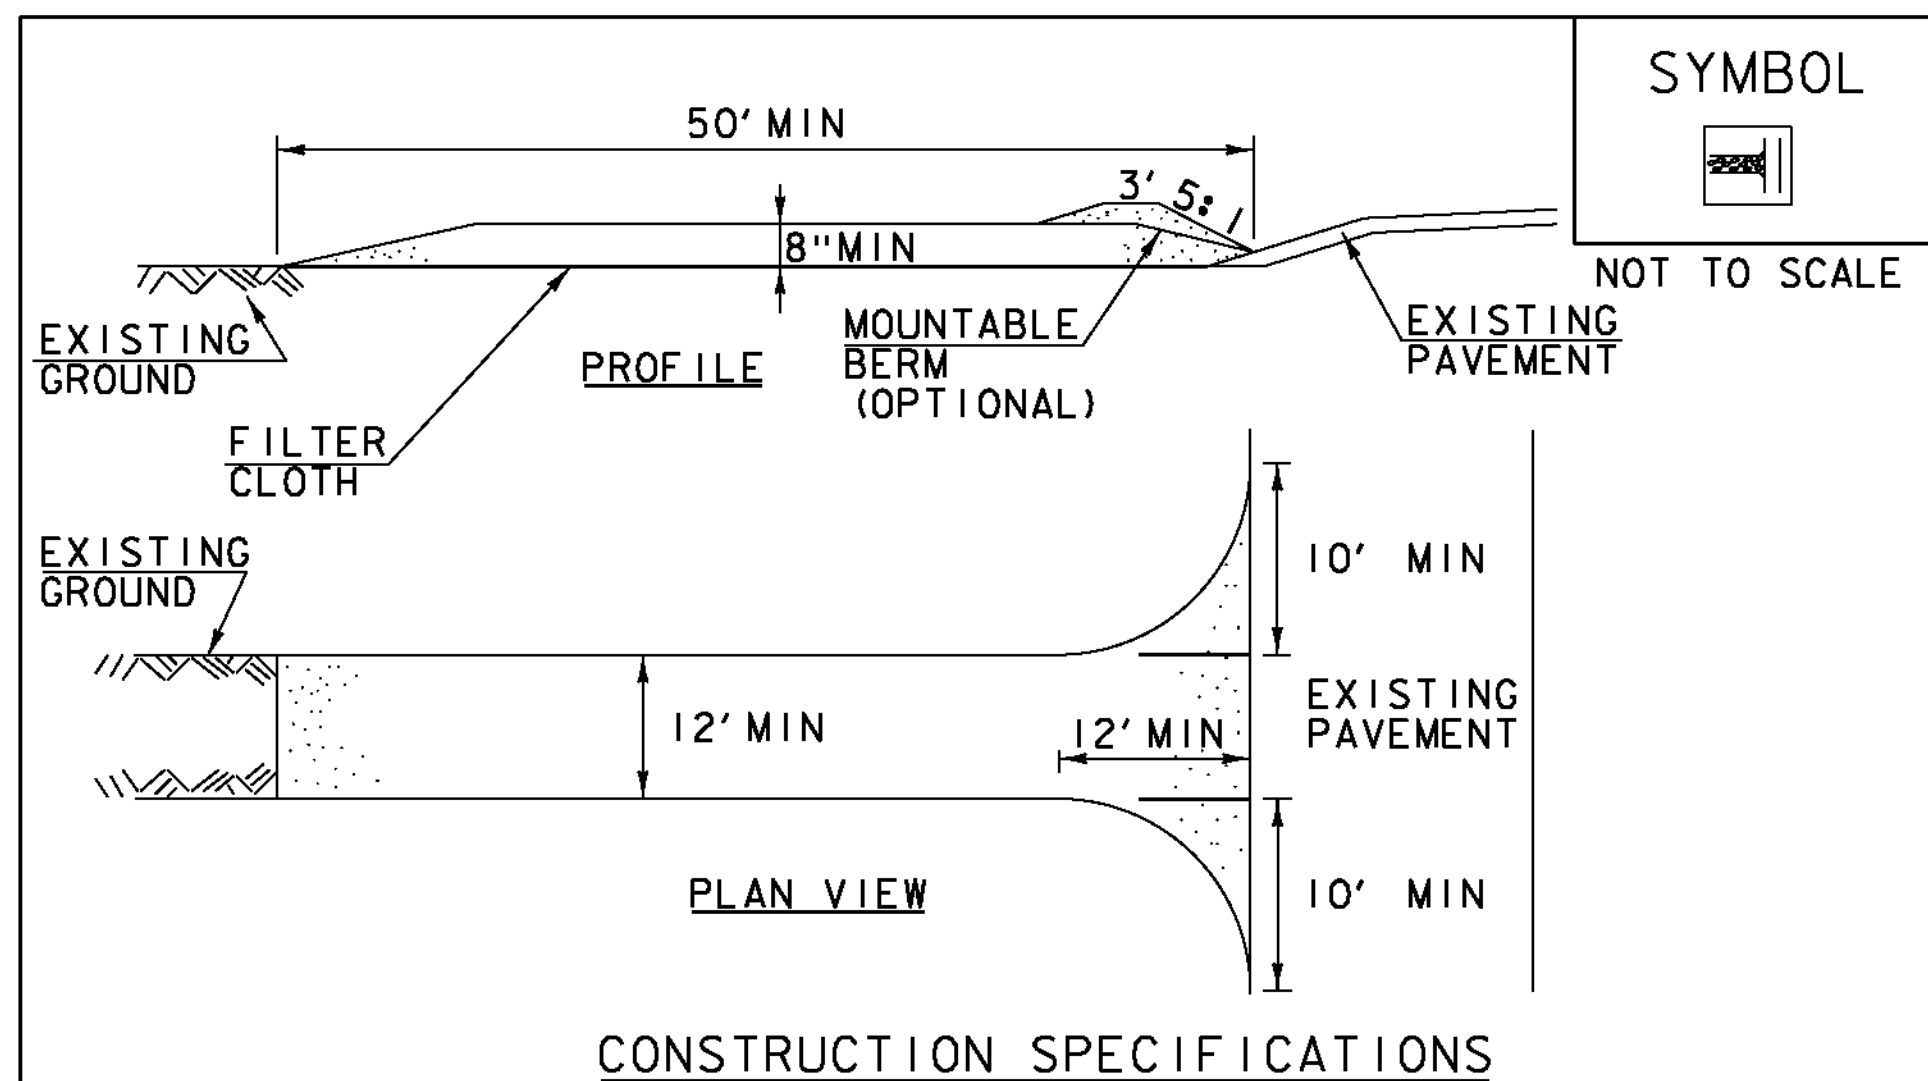

**CONSTRUCTION SPECIFICATIONS**

1. STONE SIZE- USE 1-4" STONE, RECLAIMED OR RECYCLED CONCRETE EQUIVALENT.
2. LENGTH- NOT LESS THAN 50' (EXCEPT ON A SINGLE RESIDENCE LOT WHERE A 30' MINIMUM LENGTH APPLIES).
3. THICKNESS- NOT LESS THAN 8".
4. WIDTH- 12' MINIMUM, BUT NOT LESS THAN THE FULL WIDTH AT POINTS WHERE INGRESS OR EGRESS OCCURS. 24" IF SINGLE ENTRANCE TO SITE.
5. GEOTEXTILE MUST BE PLACED OVER THE ENTIRE AREA PRIOR TO PLACING STONE.
6. SURFACE WATER- ALL SURFACE WATER FLOWING OR DIVERTED TOWARD CONSTRUCTION ENTRANCES SHALL BE PIPED BENEATH THE ENTRANCE. IF PIPING IS IMPRACTICAL, A MOUNTABLE BERM WITH 5:1 SLOPES WILL BE PERMITTED.
7. MAINTENANCE- THE ENTRANCE SHALL BE MAINTAINED IN A CONDITION WHICH WILL PREVENT TRACKING OR FLOWING OF SEDIMENT ONTO PUBLIC RIGHTS-OF-WAY, ALL SEDIMENT SPILLED, DROPPED, WASHED OR TRACKED ONTO PUBLIC RIGHTS-OF-WAY MUST BE REMOVED IMMEDIATELY.
8. WHEN WASHING IS REQUIRED, IT SHALL BE DONE ON AN AREA STABILIZED WITH STONE AND WHICH DRAINS INTO AN APPROVED SEDIMENT TRAPPING DEVICE.
9. PERIODIC INSPECTION AND NEEDED MAINTENANCE SHALL BE PROVIDED ACCORDING TO PERMIT REQUIREMENTS.


ADAPTED FROM DETAILS PROVIDED BY: NEW YORK STATE DEC  
ORIGINALLY DEVELOPED BY USDA-NRCS  
VERMONT DEPARTMENT OF ENVIRONMENTAL CONSERVATION

**STABILIZED CONSTRUCTION ENTRANCE**

NOTES:  
REFER TO "THE VERMONT STANDARDS & SPECIFICATIONS FOR EROSION PREVENTION & SEDIMENT CONTROL -2006- " FROM THE VT AGENCY OF NATURAL RESOURCES FOR ADDITIONAL GUIDANCE.

THIS WORK SHALL BE PERFORMED IN ACCORDANCE WITH SECTION 653 FOR VEHICLE TRACKING PAD (PAY ITEM 653.35) OR AS SPECIFIED IN THE CONTRACT.

REVISIONS	
MARCH 24, 2008	WHF
JANUARY 13, 2009	WHF

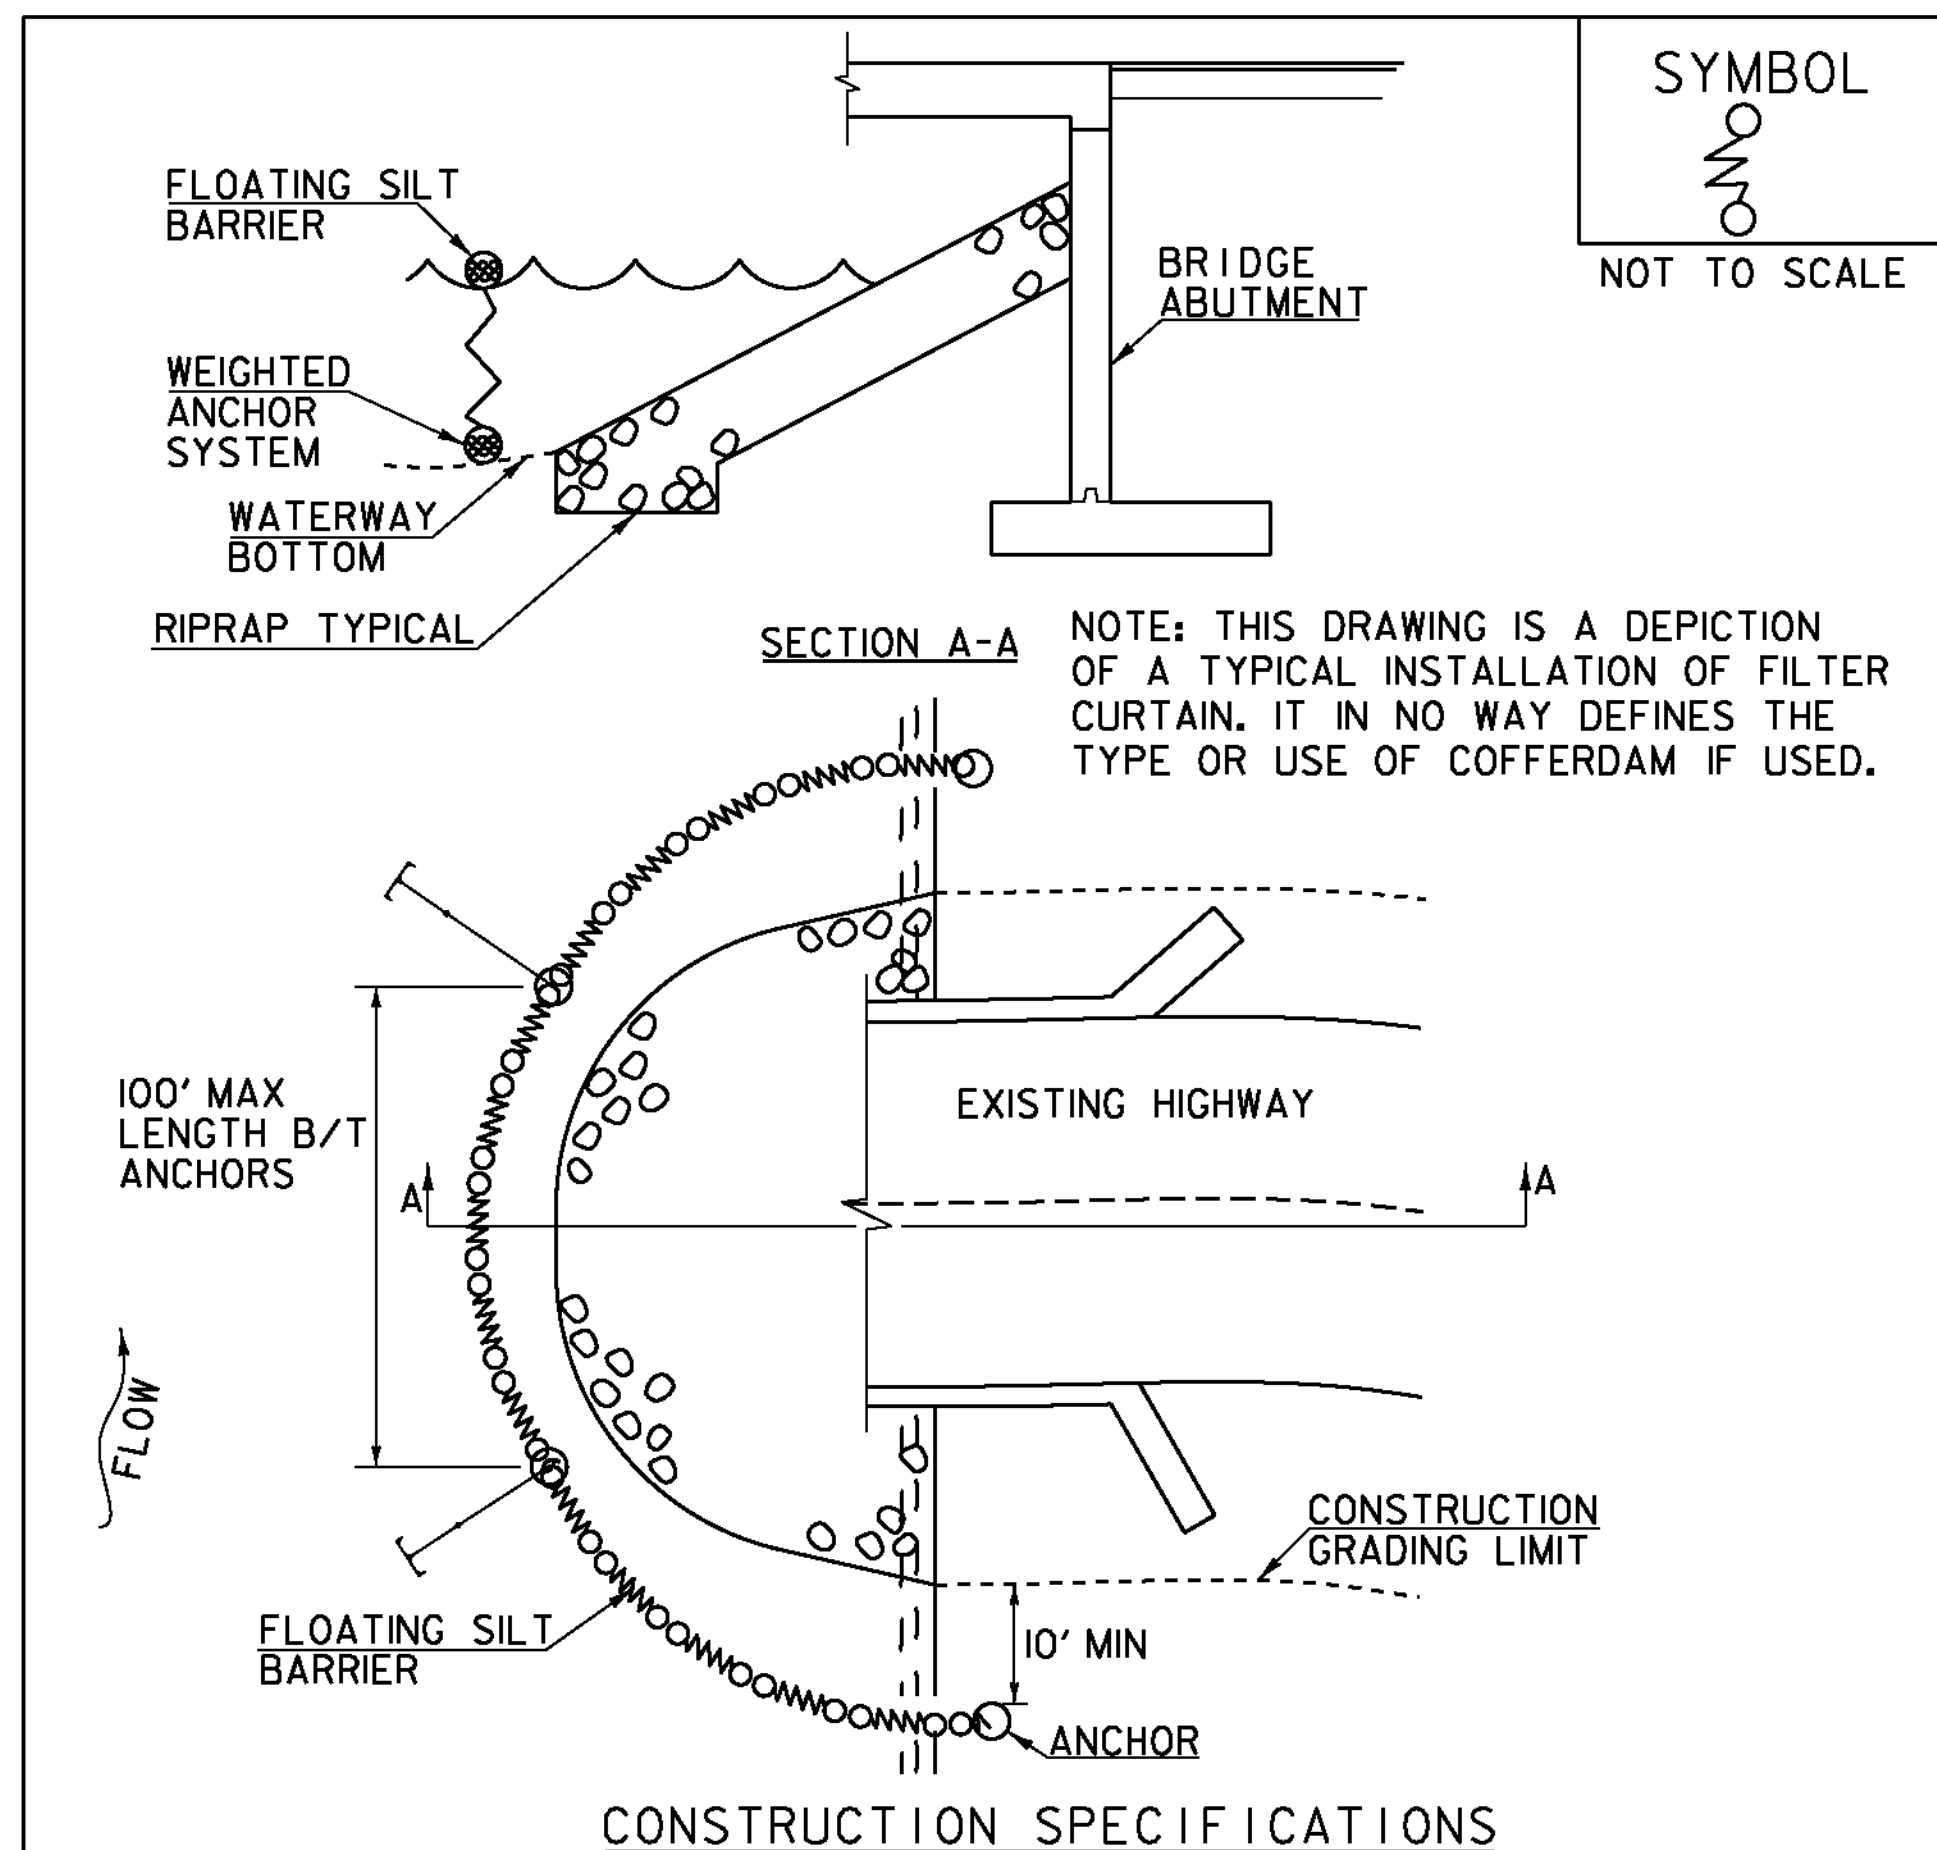

**CONSTRUCTION SPECIFICATIONS**

1. FILTER CURTAIN SHALL NOT BE PLACED ACROSS A FLOWING WATERWAY, OR IN A WATERWAY WITH STREAM VELOCITIES GREATER THAN 1.5 FEET/SECOND.
2. MAXIMUM 100' LENGTH BETWEEN ANCHORS.
3. LAST SECTION SHALL TERMINATE A MINIMUM OF 10' BEYOND LIMIT OF DISTURBANCE.
4. THE WEIGHTED ANCHOR SYSTEM SHALL BE A TYPE WHICH ALLOWS THE CURTAIN TO CONFORM TO THE BOTTOM OF THE WATERWAY.
5. THE CURTAIN SHALL BE REMOVED BY SLOWLY PULLING TOWARD THE SHORE MINIMIZING THE ESCAPE OF SEDIMENTS INTO WATERWAY.

**FILTER CURTAIN**

THIS WORK SHALL BE PERFORMED IN ACCORDANCE WITH SECTION 649 FOR GEOTEXTILE FOR FILTER CURTAIN (PAY ITEM 649.61).

REVISIONS	
APRIL 1, 2008	WHF
JANUARY 13, 2009	WHF
SEPTEMBER 4, 2009	WHF

VAOT RURAL AREA MIX					
% WEIGHT	LBS/AC		NAME	GERM %	PURITY %
	BROADCAST	HYDROSEED			
37.5%	22.5	45	CREeping RED FESCUE	85%	98%
37.5%	22.5	45	TALL FESCUE	90%	95%
5.0%	3	6	RED TOP	90%	95%
15.0%	9	18	BIRDSFOOT TREFOIL	85%	98%
5.0%	3	6	ANNUAL RYE GRASS	85%	95%
100%	60	120			

VAOT URBAN AREA MIX					
% WEIGHT	LBS/AC		NAME	GERM %	PURITY %
	BROADCAST	HYDROSEED			
42.5%	34	68	CREeping RED FESCUE	85%	98%
10.0%	8	16	PERENNIAL RYE GRASS	90%	95%
42.5%	34	68	KENTUCKY BLUE GRASS	85%	85%
5.0%	4	8	ANNUAL RYE GRASS	85%	95%
100%	80	160			

SOIL AMENDMENT GUIDANCE			
FERTILIZER		LIME	
BROADCAST	HYDROSEED	BROADCAST	HYDROSEED
10-20-10	FOLLOW	PELLETIZED	FOLLOW
500 LBS/AC	MANUFACTURER	2 TONS/AC	MANUFACTURER

**CONSTRUCTION GUIDANCE**

1. RURAL SEED MIX: USE AS INDICATED IN THE PLANS AND/OR FOR ALL ESTABLISHED UPLAND (NON WETLAND) AREAS DISTURBED BY THE CONTRACTOR.
2. URBAN SEED MIX: USE AS INDICATED IN THE PLANS AND/OR FOR ALL ESTABLISHED LAWN AREAS DISTURBED BY THE CONTRACTOR.
3. ALL SEED MIXTURES: SHALL NOT HAVE A WEED CONTENT EXCEEDING 0.40% BY WEIGHT AND SHALL BE FREE OF ALL NOXIOUS SEED.
4. FERTILIZER AND LIMESTONE: SHALL FOLLOW RATES SHOWN ON PLAN OR AS DIRECTED BY THE ENGINEER
5. HAY MULCH: TO BE PLACED ON EARTH SLOPES AT THE RATE OF 2 TONS/ACRE, ACHIEVE 90% GROUND COVER OR AS DIRECTED BY THE ENGINEER.
6. TOPSOIL: TO BE USED WITH SEED AS INDICATED ON THE PLANS, OR AS DIRECTED BY THE ENGINEER.
7. HYDROSEEDING: ALTHOUGH GUIDANCE IS GIVEN ABOVE THE SITE CONDITIONS AND THE TYPE OF HYDROSEED WILL ULTIMATELY DICTATE THE AMOUNTS AND TYPES OF SOIL AMENDMENTS TO BE APPLIED
8. TURF ESTABLISHMENT: PLACING SEED, FERTILIZER, LIME AND MULCH PRIOR TO SEPTEMBER 15 AND AFTER APRIL 15 CAN BETTER ENSURE A VIGOROUS GROWTH OF GRASS.

ADAPTED FROM VTRANS TECHNICAL LANDSCAPE MANUAL FOR ROADWAYS AND TRANSPORTATION FACILITIES

**TURF ESTABLISHMENT**



REVISIONS	
JUNE 23, 2009	WHF
JANUARY 15, 2010	WHF
FEBRUARY 16, 2011	WHF

PROJECT NAME: WOODFORD

PROJECT NUMBER: ER BHF 010-1(44)

FILE NAME: s11b214eps details.dgn  
PROJECT LEADER: C. CARLSON  
DESIGNED BY: M.EVANS-MONGEON  
EPSC DETAILS (2)

PLOT DATE: 23-MAR-2012  
DRAWN BY: EVANS-MONGEON  
CHECKED BY:  
SHEET 58 OF 58

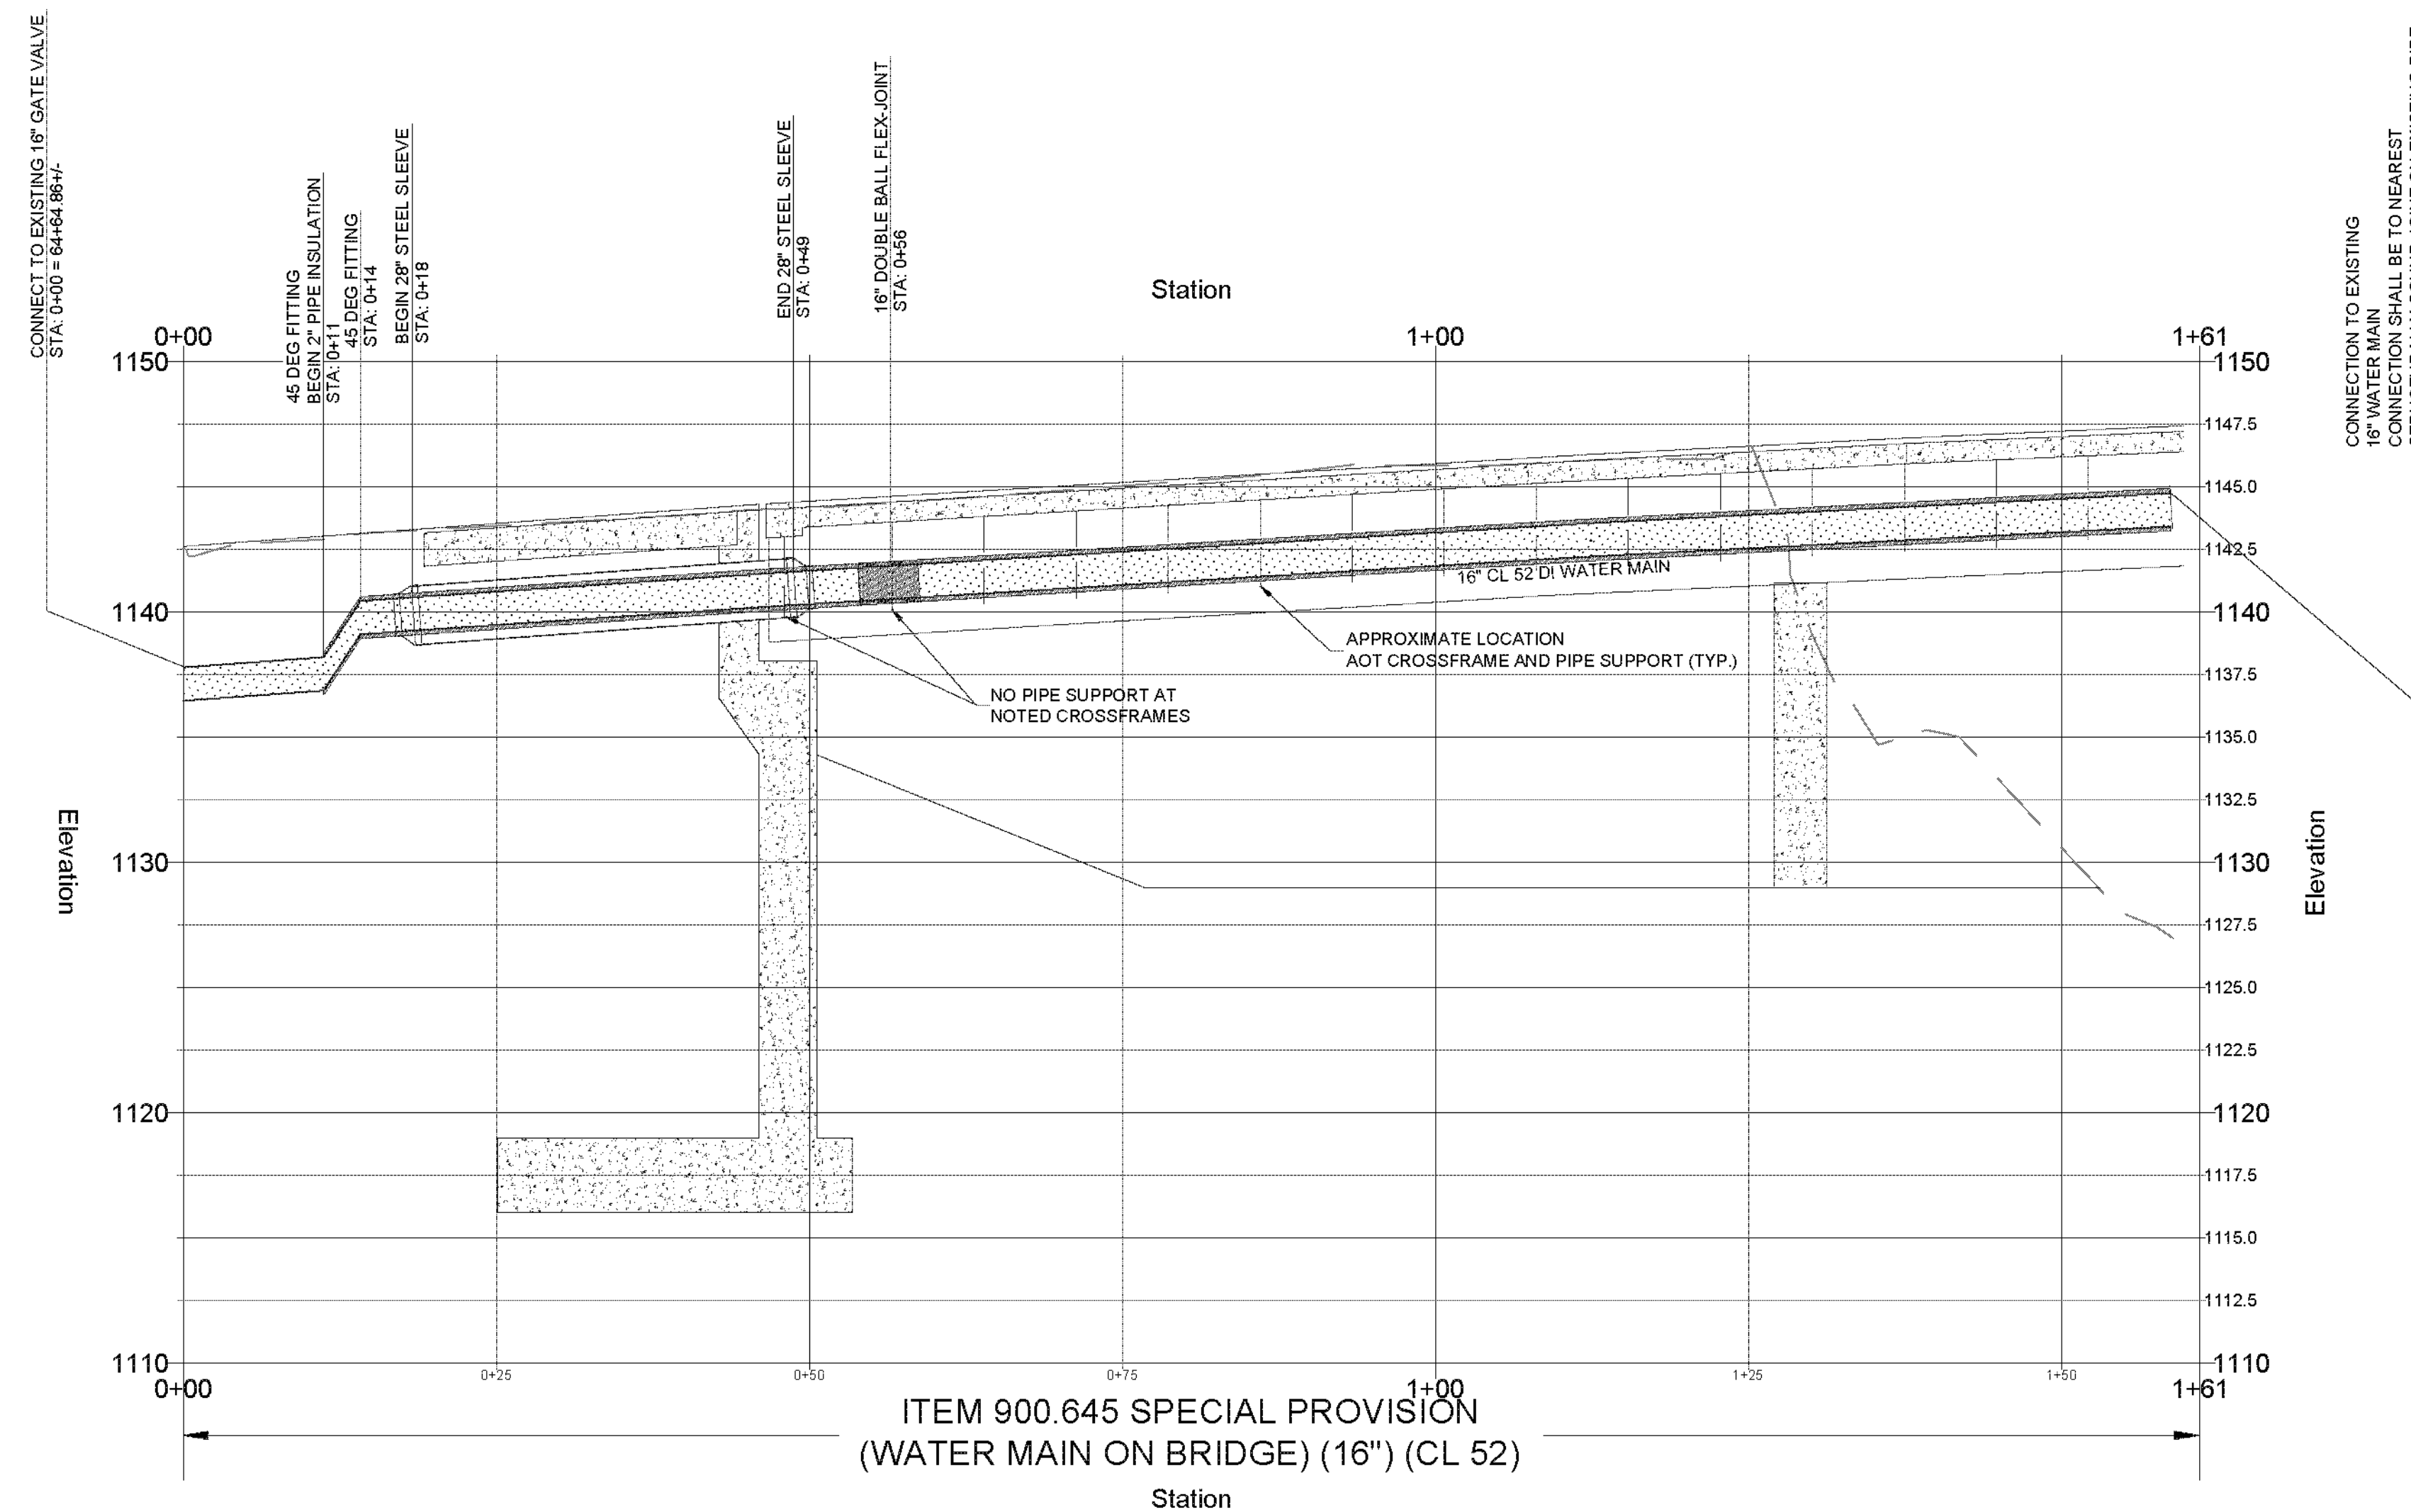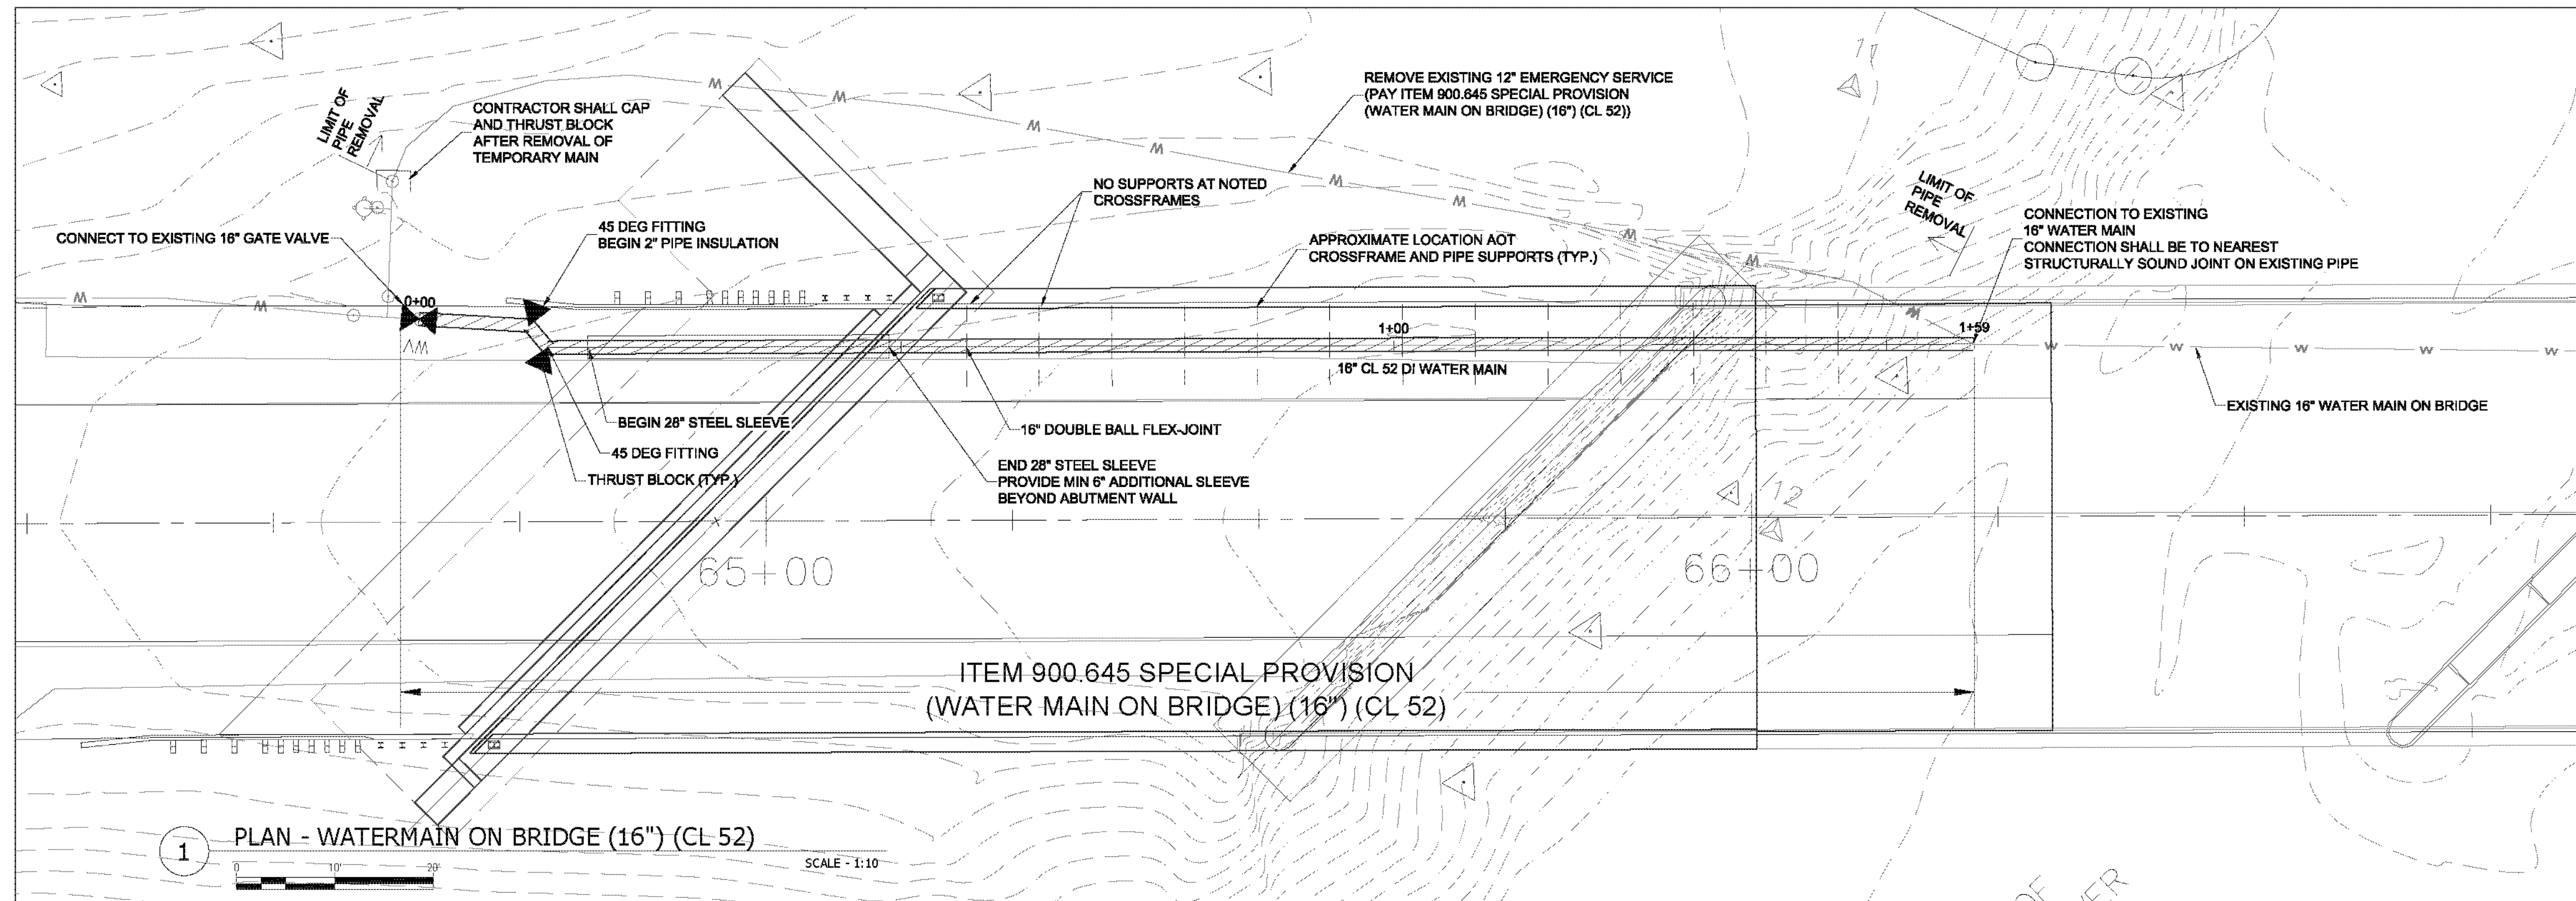

### GENERAL NOTES

- CONSTRUCTION NOTES:
1. ALL WORK SHALL BE COMPLETED AND TESTED IN ACCORDANCE WITH THE TOWN OF BENNINGTON CONSTRUCTION ORDINANCE, STATE AGENCY OF NATURAL RESOURCES REGULATIONS, STATE AGENCY OF TRANSPORTATION STANDARD SPECIFICATIONS FOR CONSTRUCTION, 2011 EDITION AND AWWA WATERLINE CONSTRUCTION STANDARDS C600 AND C652.
  2. INSTALL EXPANSION JOINT NEAR BRIDGE WEST END ABUTMENT TO ALLOW FOR MAINTENANCE ACCESS. JOINT TO BE ROMAC INDUSTRIES DOUBLE BALL TYPE OR APPROVED EQUAL WITH MIN 8" OFFSET DEFLECTION OR ENGINEER APPROVED EQUAL. SUPPORT JOINT TO MANUFACTURERS INSTALLATION RECOMMENDATIONS. PIPING MATERIALS TO BE ATLANTIC STATES OR APPROVED EQUAL CLASS 52, MIN 4 BRASS WEDGES SHALL BE INSTALLED PER JOINT.
  3. BRIDGE PIPE SHALL BE MECHANICAL JOINT DUCTILE IRON PIPE WITH MEGALUG RESTRAINTS. ALL PIPE TO BE MECHANICALLY RESTRAINED AT JOINTS.
  4. IF THERE ARE ANY CONFLICTS OR INCONSISTENCIES WITH THE PLANS OR SPECIFICATIONS, THE CONTRACTOR SHALL CONTACT THE ENGINEER FOR VERIFICATION BEFORE WORK CONTINUES ON THE ITEM IN QUESTION.
  5. CONTRACTOR SHALL CHLORINATE, (2) NEGATIVE BACTERIA TESTS AND PRESSURE TEST NEW SEGMENT OF WATER PIPE PRIOR TO FINAL CONNECTION OF SYSTEM. TESTING SHALL BE IN ACCORDANCE WITH AWWA STANDARDS C600 AND C652, TOWN OF BENNINGTON AND STATE OF VERMONT STANDARDS. CONTRACTOR SHALL COORDINATE WITH ENGINEER AND TOWN OF BENNINGTON PRIOR TO TESTING. TEST SHALL ENCOMPASS ENTIRE BRIDGE FROM VALVE TO VALVE.

**MSK ENGINEERING AND DESIGN, INC.**  
P.O. BOX 396, 46 CHURCH STREET  
SHAFTSBURY, VT 05252  
PH: (802) 447-4602 FAX: (802) 446-1201




NO.	DATE	REVISIONS DESCRIPTION

ER BHF 010-1 (44)  
VT ROUTE 9  
WOODFORD, VT

DRAWINGS THIS SHEET  
**WATERMAIN ON  
BRIDGE - PERMANENT**

NUMBER	DATE
DRAWN	03-01-12
JMD	JRS

SHEET NUMBER  
**C-101**

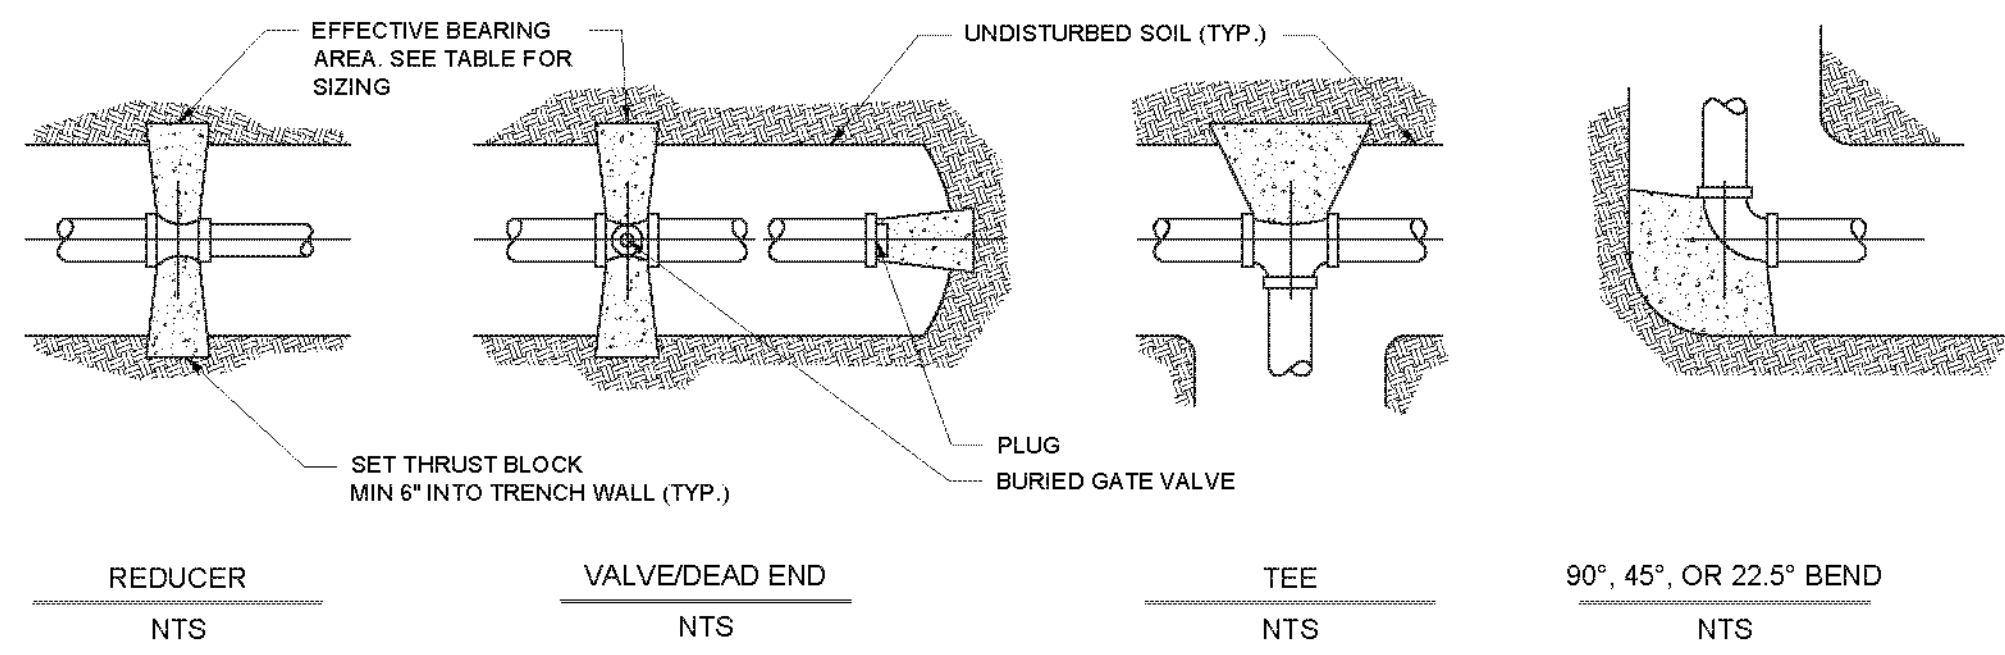


MINIMUM BEARING SURFACE AREA OF CONCRETE THRUST BLOCKS (IN SQUARE FEET)

REDUCERS			4-8"				10"				12"				SOIL CONDITION	SAFE BEARING LOAD (PSF)
8X6	10X8	12X8	ENDS & TEES	90° ELB	45° ELB	22.5° OR LESS	ENDS & TEES	90° ELB	45° ELB	22.5° OR LESS	ENDS & TEES	90° ELB	45° ELB	22.5° OR LESS		
3.0	5.0	6.0	4.0	6.0	3.0	2.0	6.0	8.0	5.0	2.0	8.0	12.0	6.0	3.0	SOUND SHALE	10000
3.0	5.0	6.0	4.5	6.5	3.5	2.0	8.0	11.0	6.0	3.0	10.0	14.0	7.5	4.0	CEMENTED GRAVEL AND SAND	4000
7.0	7.0	11.0	7.0	9.0	5.0	3.0	10.0	14.0	7.0	4.0	14.0	19.0	11.0	5.0	COARSE AND FINE COMPACT SAND	3000
8.0	9.0	14.0	15.0	20.0	10.0	5.0	21.0	31.0	15.0	8.0	30.0	40.0	20.0	10.0	MEDIUM CLAY (CAN BE SPADED)	2000
8.0	11.0	16.0	20.0	28.0	15.0	8.0	29.0	41.0	22.0	11.0	41.0	58.0	31.0	16.0	SOFT CLAY	1000

MAX WATER PRESSURE 300 PSI

**C1** TYPICAL CONCRETE THRUST BLOCK DETAIL  
NTS


- NOTES:  
1. PLACE 3 MIL MINIMUM POLYETHYLENE SHEETING BETWEEN ALL CONCRETE THRUST BLOCKS AND PIPE AND/OR FITTINGS TO PREVENT BONDING

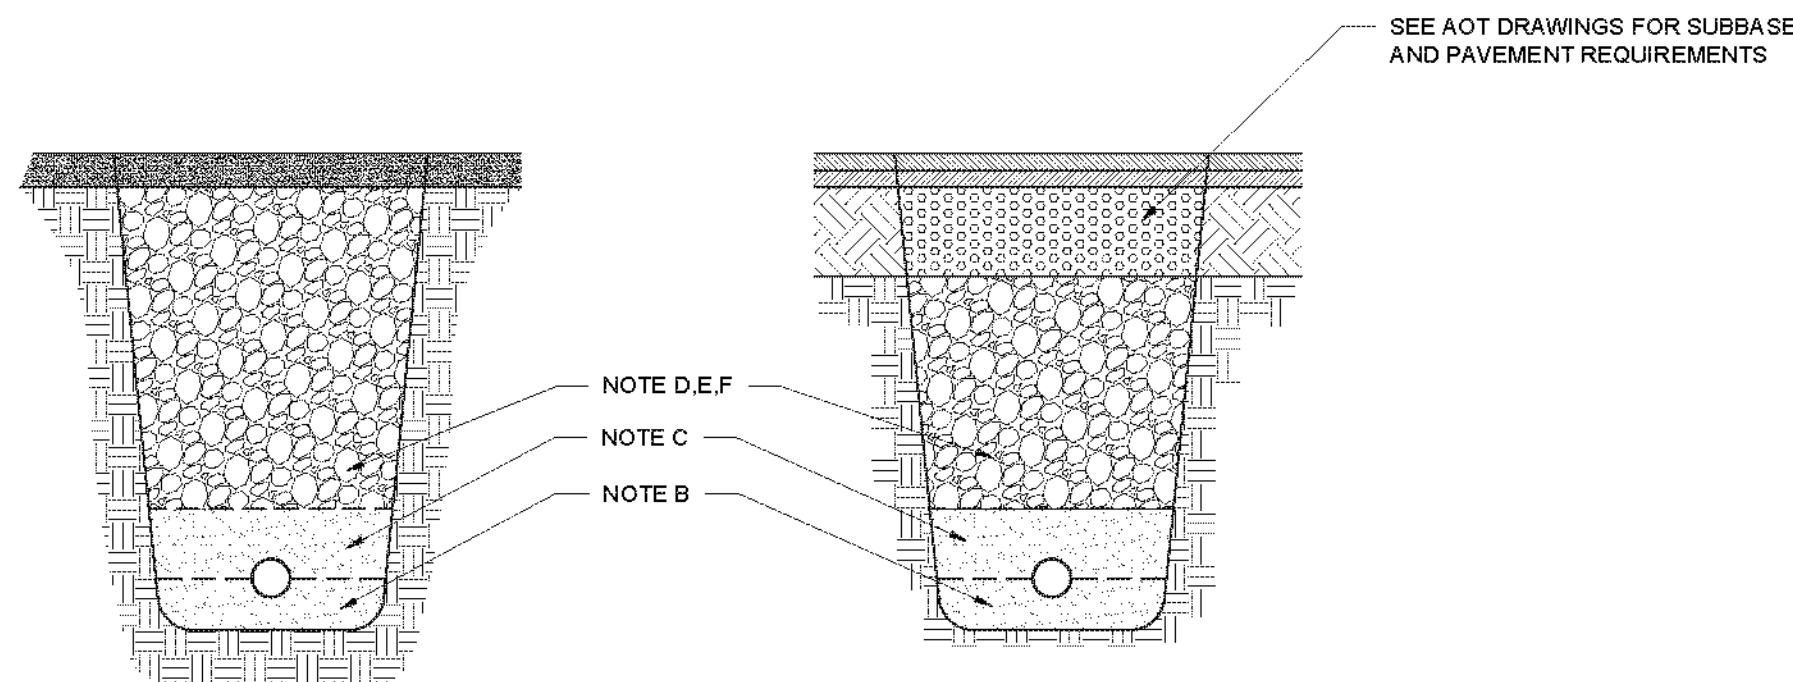

**C2** TYPICAL TRENCH DETAIL  
Scale: NTS

INSTALLATION SPECIFICATIONS


- A.** MINIMUM BURIAL DEPTH 5'-6" (4'-0" FOR SEWER) IF CONDITIONS PREVENT MINIMUM BURIAL DEPTH, ALL SECTIONS OF LINE LESS THAN MIN. DEPTH SHALL BE INSULATED WITH 1" THICKNESS RIGID FOAM INSULATION PER FOOT LESS THAN MINIMUM (MIN. 2" THICKNESS 250 PSI)
- B.** BED PIPE IN 6" OF CRUSHED STONE (PASSING 1/2" BUT RETAINED ON #4 SIEVE) PIPE SHALL NOT BE LAID IN UNCOMPACTED SOIL OR IN WATER. IF IN LEDGE CONDITIONS, BED PIPE IN A MINIMUM OF 6" OF CLEAN SAND. DO NOT REST PIPE ON LEDGE ROCK.
- C.** BACKFILL OVER PIPE W/ 12" MINIMUM SAND, COMPACTED ENTIRE WIDTH OF TRENCH. BACKFILL WITH BEDDING STONE TO 12" DEPTH IF IN WATER.
- D.** REMAINDER OF BACKFILL TO BE SELECT EARTH OR BANK RUN GRAVEL NOT GREATER THAN 6" IN LARGEST DIMENSION. BACKFILL TO BE COMPACTED IN 6" LIFTS UNDER ROADS AND PAVED AREAS.
- E.** BACKFILL SHALL CONSIST OF SUITABLE MATERIAL REMOVED FROM EXCAVATION AND SHALL BE FREE OF CLODS, DEBRIS, FROZEN CHUNKS, PAVEMENT PIECES, LARGE STONES, ORGANIC MATERIAL OR ANY OTHER MATERIAL DEEMED UNSUITABLE BY THE ENGINEER.
- F.** BACKFILL SHALL BE COMPACTED TO 95% OF MAXIMUM DRY DENSITY IN ALL TRENCH EXCAVATIONS. (85% OF LAWN/GRASS AREA)

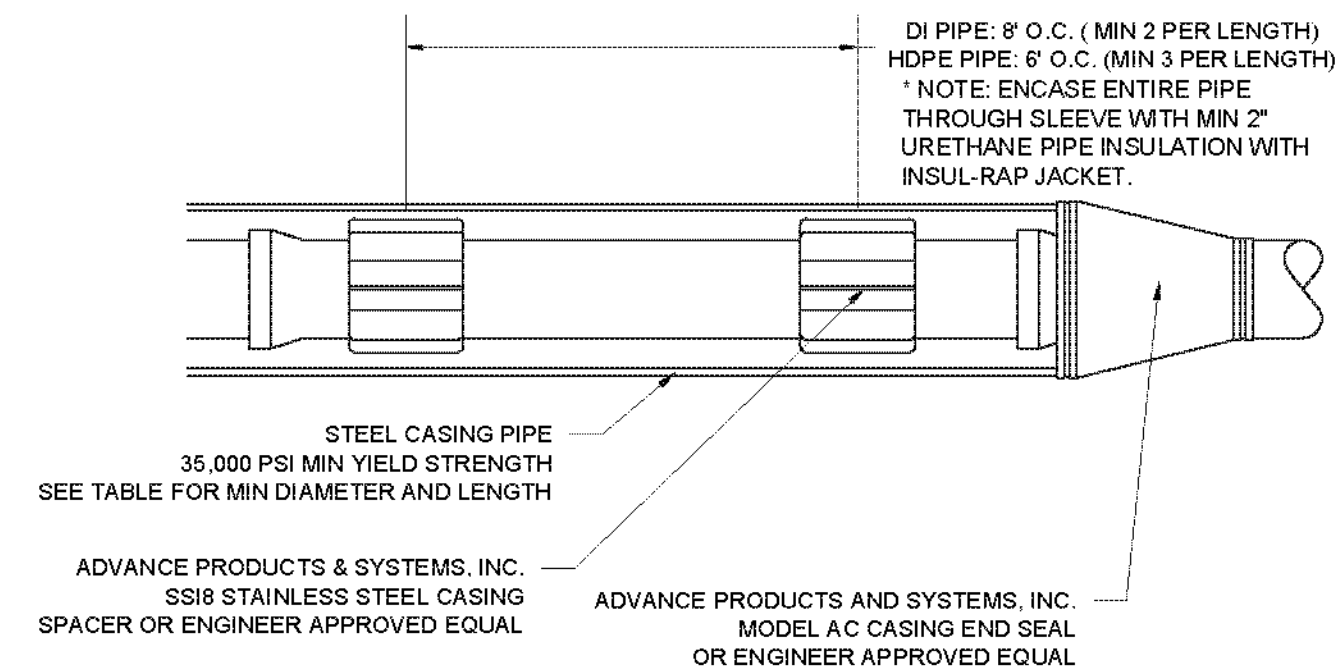

**C3** SLEEVE PIPE DETAIL  
Scale: NTS

SLEEVE PIPE SIZE AND THICKNESS		
CARRIER DIA	CASING DIA/MATL	MIN THICKNESS
3/4"-2" K' CU	4" HDPE	N/A
4" DI	14" STEEL	0.312 inch
6" DI	16" STEEL	0.312 inch
8" DI	18" STEEL	0.312 inch
10" DI	20" STEEL	0.312 inch
12" DI	22" STEEL	0.312 inch
16" DI	28" STEEL	0.375 inch

- NOTES:  
1. D17 HDPE PIPE MAY BE SUBSTITUTED FOR STEEL CASING WITH ENGINEER APPROVAL.

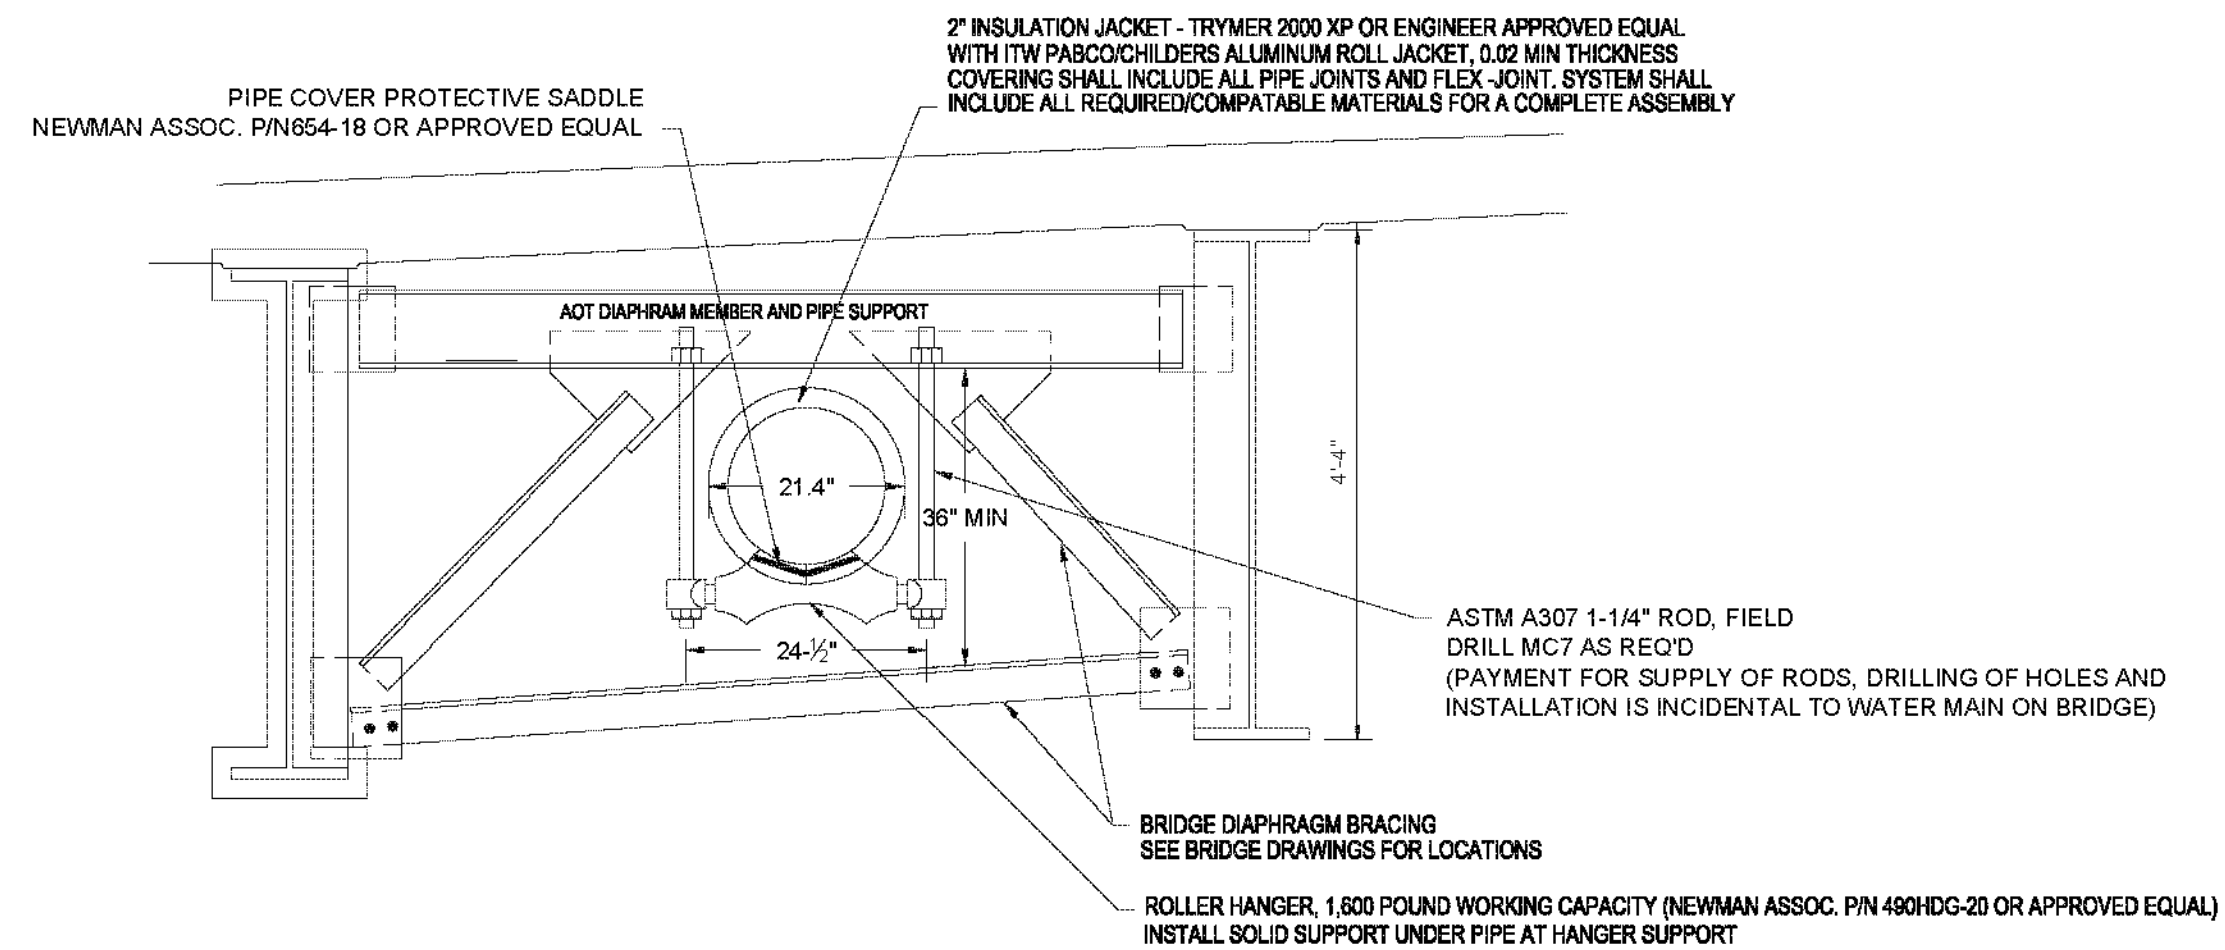

**C4** HANGER SUPPORT DETAIL  
Scale: NTS

- NOTES:  
1. ENGINEER WILL PROVIDE BRIDGE FABRICATION DRAWINGS TO MSK ENGINEERING FOR FINAL COORDINATION OF PIPE SUPPORTS  
2. THE BRIDGE DIAPHRAGM BRACING WILL ALLOW CLEARANCE FOR A 24" OVERALL PIPE AND JACKET DIMENSION. COORDINATE THE FINAL LOCATION OF THE PIPE WITH THE BRIDGE DIAPHRAGM BRACING. REMOVE AND RE-INSTALL THE BOTTOM DIAPHRAGM MEMBER AS REQUIRED TO INSTALL THE PIPE.

MSK ENGINEERING AND DESIGN, INC.  
P.O. BOX 396,46 CHURCH STREET  
SHAFTSBURY, VT 05262  
PH: (802) 447-1602 FAX: (802) 446-1281



NO.	DATE	DESCRIPTION

ER BHF 010-1 (44)  
VT ROUTE 9  
WOODFORD, VT

DRAWINGS THIS SHEET

WATERLINE  
DETAILS

NUMBER	DATE
	08-01-12
DRAWN	CHECKED
JMD	JRS

SHEET NUMBER  
**C-501**

### WRITTEN ORDER No. 21

The following Written Order is hereby issued to, Project Manager Brian Emmons representing the Contractor, T. Buck Construction, Inc on the Woodford ER BHF 010-1(44) project.

You are hereby directed to add plantings to the project to replace those lost during Hurricane Irene and the subsequent recovery and reconstruction projects. A portion of the Woodford Bridge (BHF 010-1(29) sheets 31-32 and 37-39) are attached to use as a guide for placement. You are directed to plant the individual planting shown on the plans North West of the bridge as close to the locations shown as practical, final locations to be determined in the field. Plants to be installed as detailed on sheets 37-39. In addition to the individual plants, approximated quantities of 6-8 CY of item 651.27 Cedar Mulch and 9-12 CY of 651.35 Topsoil Mod. (Compost) will be needed. The anti-desiccant spray referenced on sheet 38 note 2 under Evergreen Tree Planting Detail shall be submitted for approval by the engineer and is considered subsidiary to the individual plantings.

The full list of plants includes;

- 7 Evergreen Trees (Pinus Strobus aka White Pine) Min Ht 5-6' Item 656.20
- 16 Evergreen Seedlings (Pinus Strobus aka White Pine) Min Ht 1-2' Item 656.15
- 2 Deciduous Trees (Betula Papyrifera aka Paper Birch-clump of 3) Min Ht 8-10' Item 656.30
- 3 Deciduous Treed (Acer Saccharum aka Sugar Maple) 1.5-2.0" Cal Item 656.30
- 11 Deciduous Trees (Betula Populifolia aka Gray Birch) Min Ht 4-5' Item 656.30
- 10 Deciduous Trees (Fraxinus Americana aka White Ash) Min Ht 4-5' Item 656.30

Date: February 27, 2013

Signed,



Ronald Lemaire, Resident Engineer

#### Electronic Distribution:

Headquarters via Finals Engineer  
Regional Construction Engineer  
Regional Construction Technician  
Regional Program Services Clerk  
project file




**LEGEND**


- JUTE EROSION MATTING
- PROPOSED DECIDUOUS TREE
- PROPOSED EVERGREEN TREE
- PROPOSED DECIDUOUS TREE (SMALL)
- PROPOSED EVERGREEN TREE (SMALL)

**DECIDUOUS TREES (SEE NOTE 3)**  
 STA 62+53 TO 62+82 LT (2 BP)  
 STA 62+46 TO 63+07 LT (4 BPO)  
 STA 63+36 TO 63+64 LT (4 FA)  
 STA 63+13 TO 63+72 LT (3 AS)  
 STA 63+96 TO 63+98 LT (2 BPO)  
**EVERGREEN TREES (SEE NOTE 3)**  
 STA 61+96 TO 62+34 LT (4 PS)  
 STA 63+87 TO 64+00 LT (2 PS)  
**EVERGREEN SEEDLINGS (SEE NOTE 3)**  
 STA 62+58 TO 63+41 LT (5 PS-TR)  
 STA 63+72 TO 63+89 LT (2 PS-TR)

- NOTES:**
1. REFER TO CROSS SECTIONS FOR FINAL GROUND ELEVATIONS
  2. THE GRAY SHADED AREAS DEPICT DISTURBED AREAS WHERE EROSION MATTING, SEEDING & MULCHING WILL BE APPLIED
  3. SEE LANDSCAPE DETAIL & TYPICAL SHEETS FOR SPECIFIC INFORMATION ON SPECIES AND THEIR PLANTING SCHEDULE
  4. SOIL AREAS WHERE LANDSCAPE PLANTINGS WILL BE PLACED, WHICH HAVE BECOME COMPACTED DUE TO CONSTRUCTION ACTIVITIES SHALL BE SCARIFIED WITH AN ALL PURPOSE EXCAVATOR

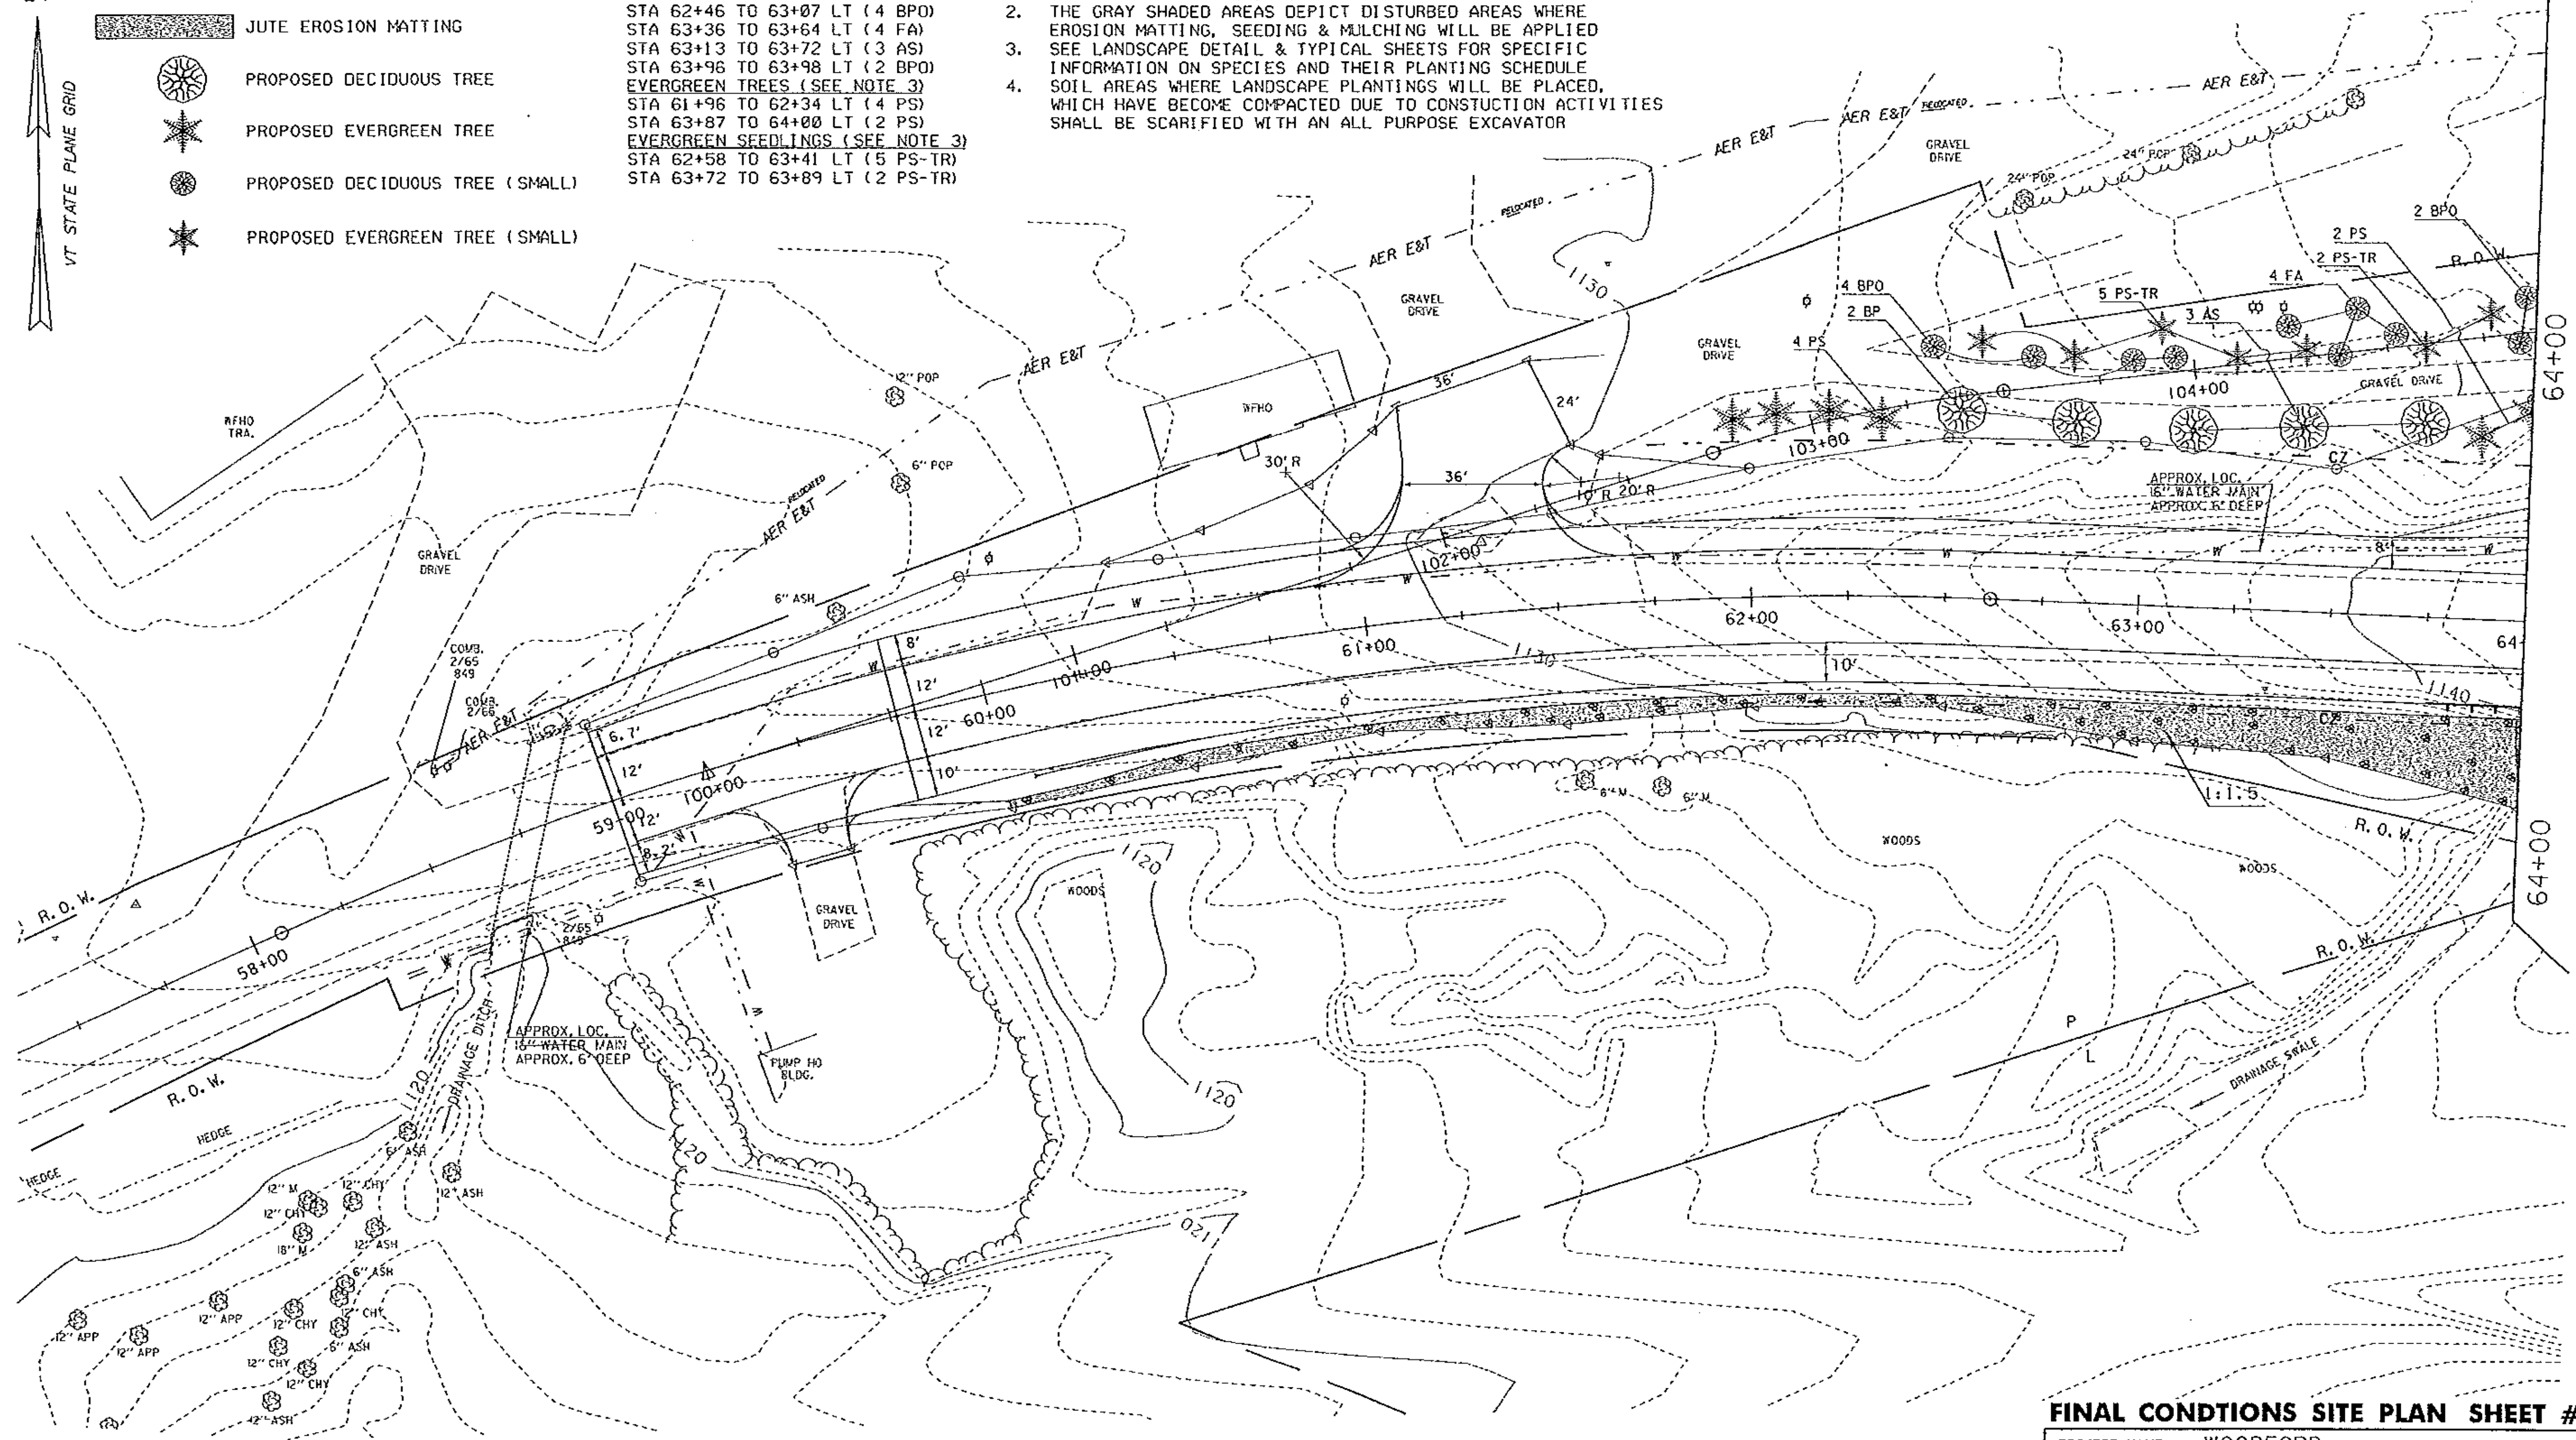

<b>DATUM</b>	
VERTICAL	NGVD 1929
HORIZONTAL	N/A

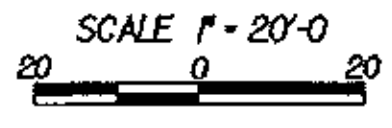

**FINAL CONDITIONS SITE PLAN SHEET #1**




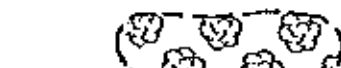
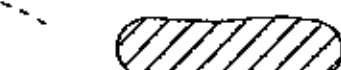
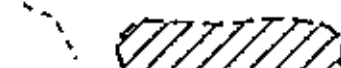

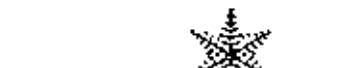

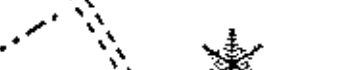
PROJECT NAME:	WOODFORD	PLOT DATE:	03-OCT-2005
PROJECT NUMBER:	BHF 010-1(29)	DRAWN BY:	W FARLEY
FILE NAME:	84e039/structures/84e039erobdr.dgn	DESIGNED BY:	W FARLEY
PROJECT LEADER:	M EVANS-MONGEON	CHECKED BY:	
IPARM:	epsf1n011	SHEET 31	OF 106



DECIDUOUS TREES (SEE NOTE 3)  
 STA 64+23 TO 64+73 LT (5 BPO)  
 STA 64+92 TO 65+44 LT (6 FA)  
 STA 70+49 LT (1 FA)  
 EVERGREEN TREES (SEE NOTE 3)  
 STA 64+14 LT (1 PS)  
 EVERGREEN SEEDLINGS (SEE NOTE 3)  
 STA 64+06 TO 65+32 LT (9 PS-TR)

EMBANKMENT GROUPINGS (SEE NOTE 3)  
 STA 64+02 TO 64+67 RT (2 GROUPS)  
 STA 65+09 TO 65+40 LT (1 GROUP)  
 STA 67+65 TO 69+59 RT (6 GROUPS)  
 STA 68+15 TO 69+13 LT (3 GROUPS) (SEE NOTE 4)  
 FLAT GROUND GROUPINGS (SEE NOTE 3)  
 STA 65+36 TO 66+09 LT (6 GROUPS)  
 STA 68+36 TO 69+06 LT (2 GROUPS)  
 STA 68+83 TO 70+42 LT (5 GROUPS)


- NOTES:
1. REFER TO CROSS SECTIONS FOR FINAL GROUND ELEVATIONS
  2. THE GRAY SHADED AREAS DEPICT DISTURBED AREAS WHERE EROSION MATTING, SEEDING & MULCHING WILL BE APPLIED
  3. SEE LANDSCAPE DETAIL & TYPICAL SHEETS FOR SPECIFIC INFORMATION ON SPECIES AND THEIR PLANTING SCHEDULE
  4. THESE GROUPS WILL UTILIZE THE UPPER PORTION OF THE GROUPING AS SHOWN ON THE LANDSCAPE DETAIL SHEETS
  5. SOIL AREAS WHERE LANDSCAPE PLANTINGS WILL BE PLACED, WHICH HAVE BECOME COMPACTED DUE TO CONSTRUCTION ACTIVITIES SHALL BE SCARIFIED WITH AN ALL PURPOSE EXCAVATOR

LEGEND

-  JUTE EROSION MATTING
-  WETLANDS
-  SHRUBS AND SEEDLING TREES (SLOPE)
-  SHRUBS AND SEEDLING TREES (FLAT)
-  SHRUBS (SLOPE)
-  SHRUBS (FLAT)
-  PROPOSED DECIDUOUS TREE
-  PROPOSED EVERGREEN TREE
-  PROPOSED DECIDUOUS TREE (SMALL)
-  PROPOSED EVERGREEN TREE (SMALL)

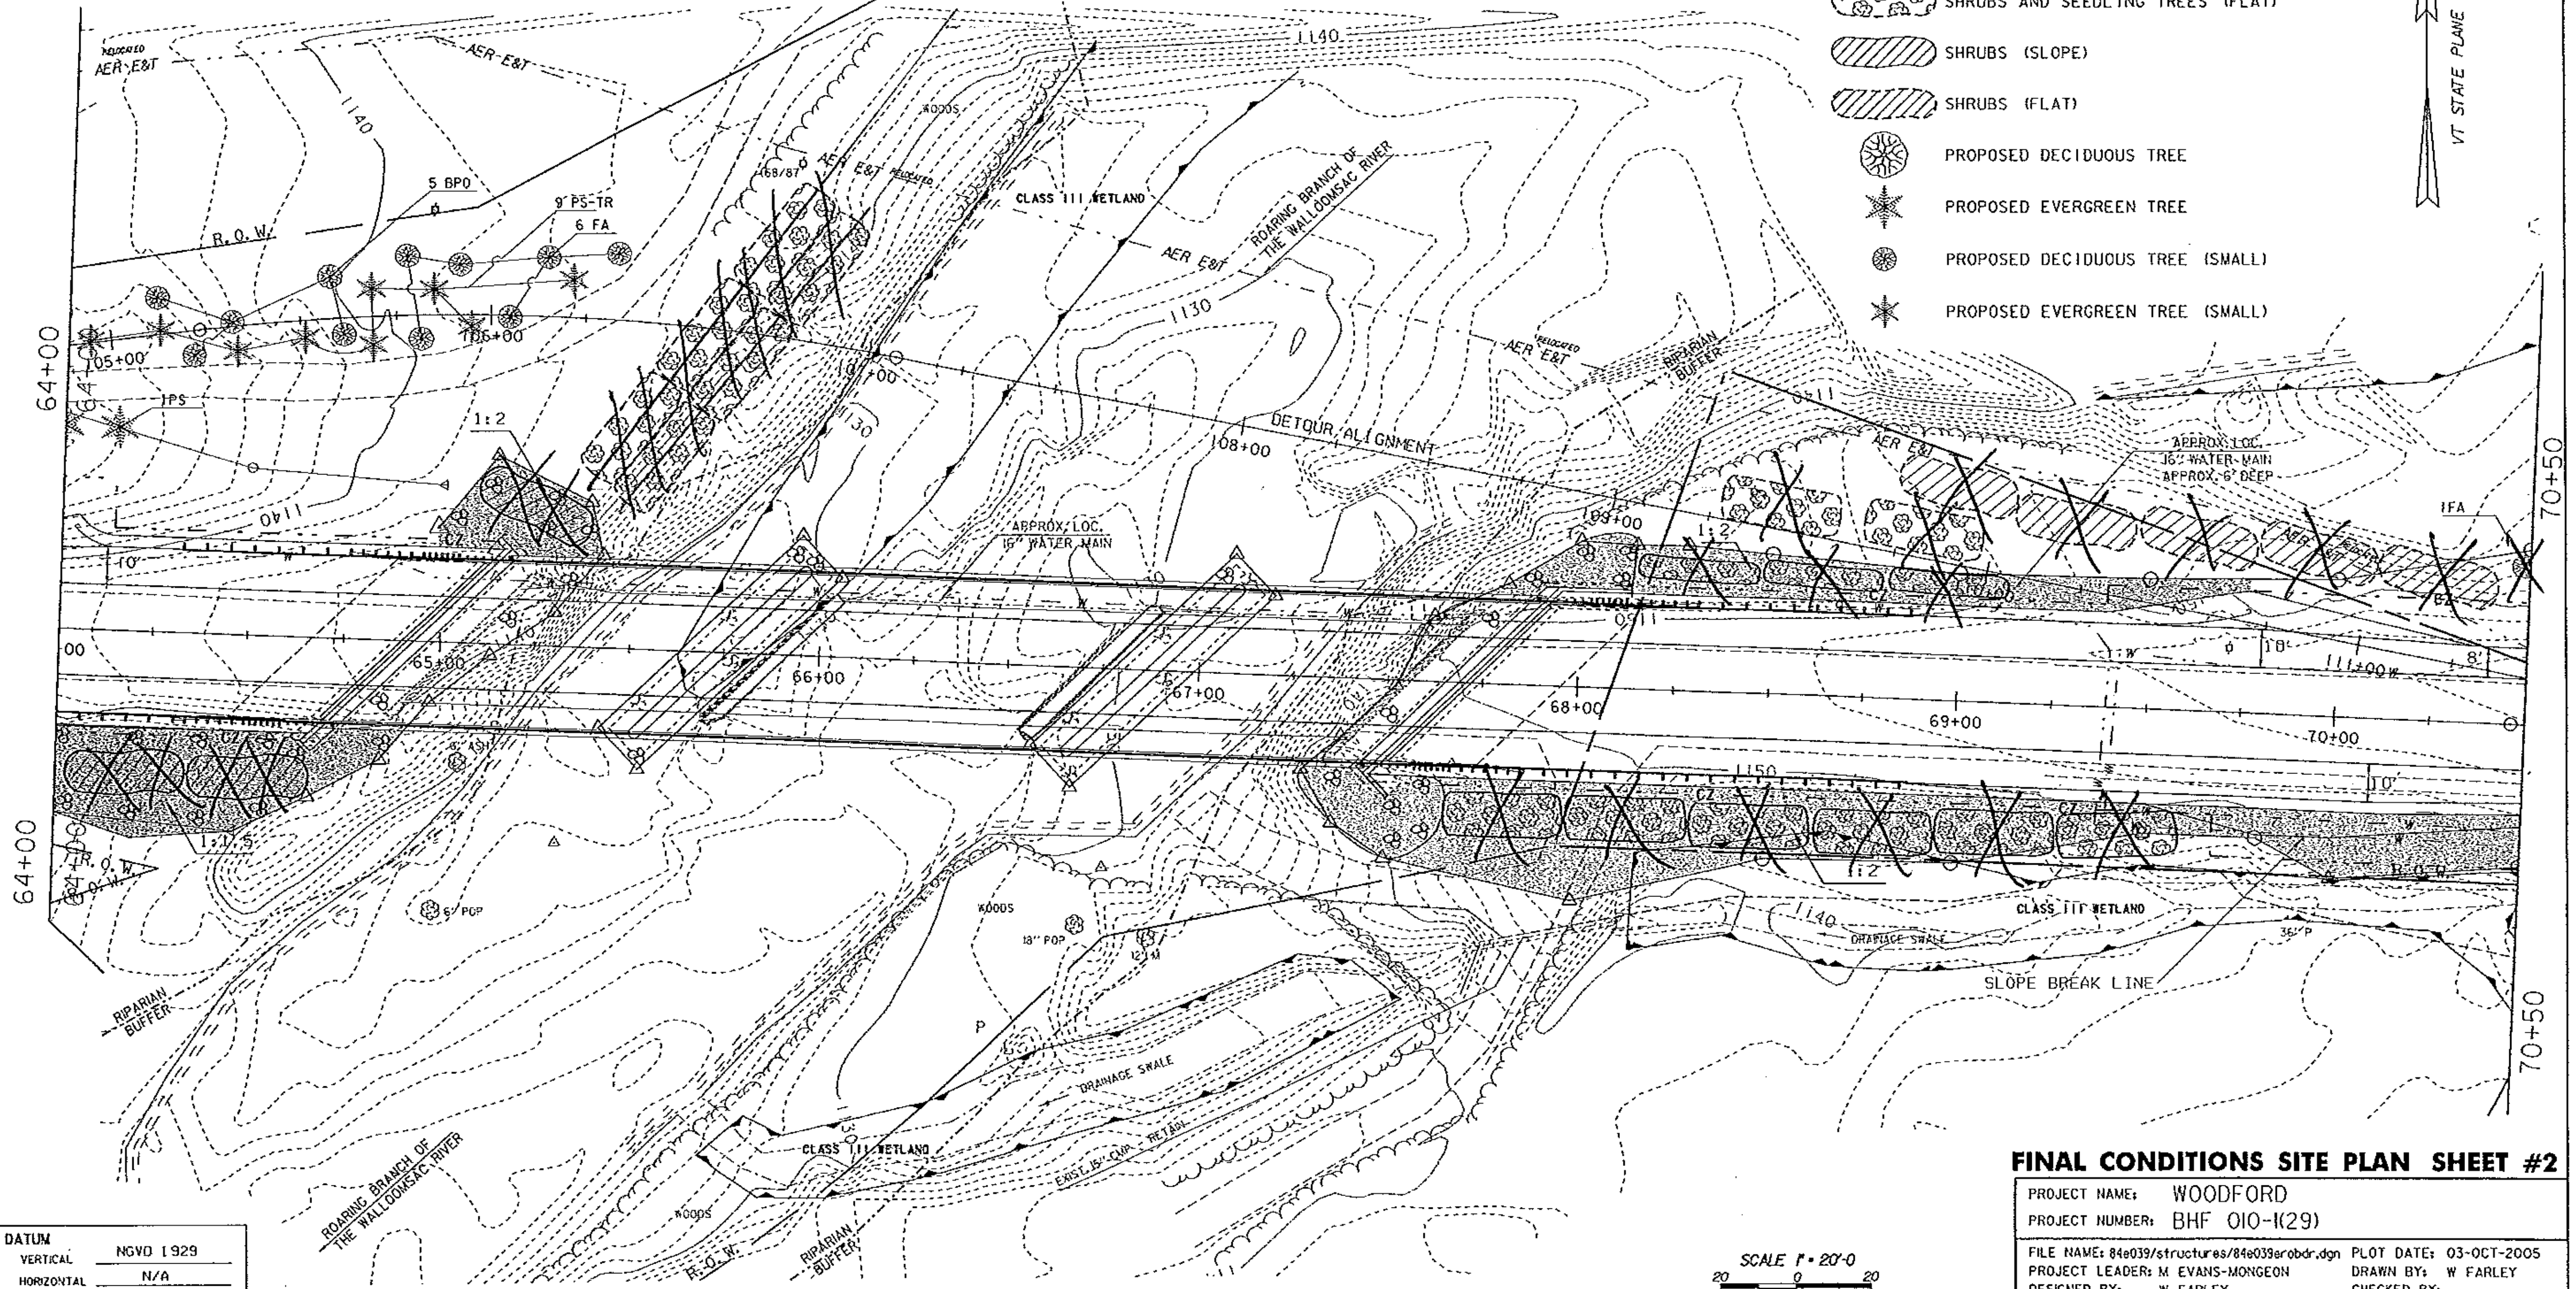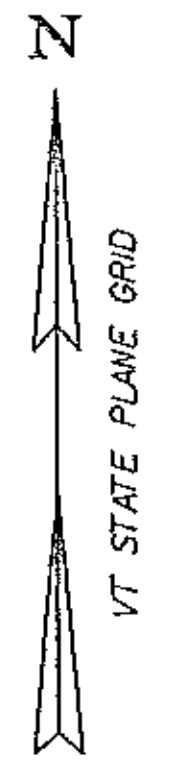

DATUM  
 VERTICAL NGVD 1929  
 HORIZONTAL N/A

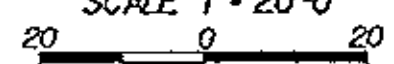SCALE 1" = 20'-0"  


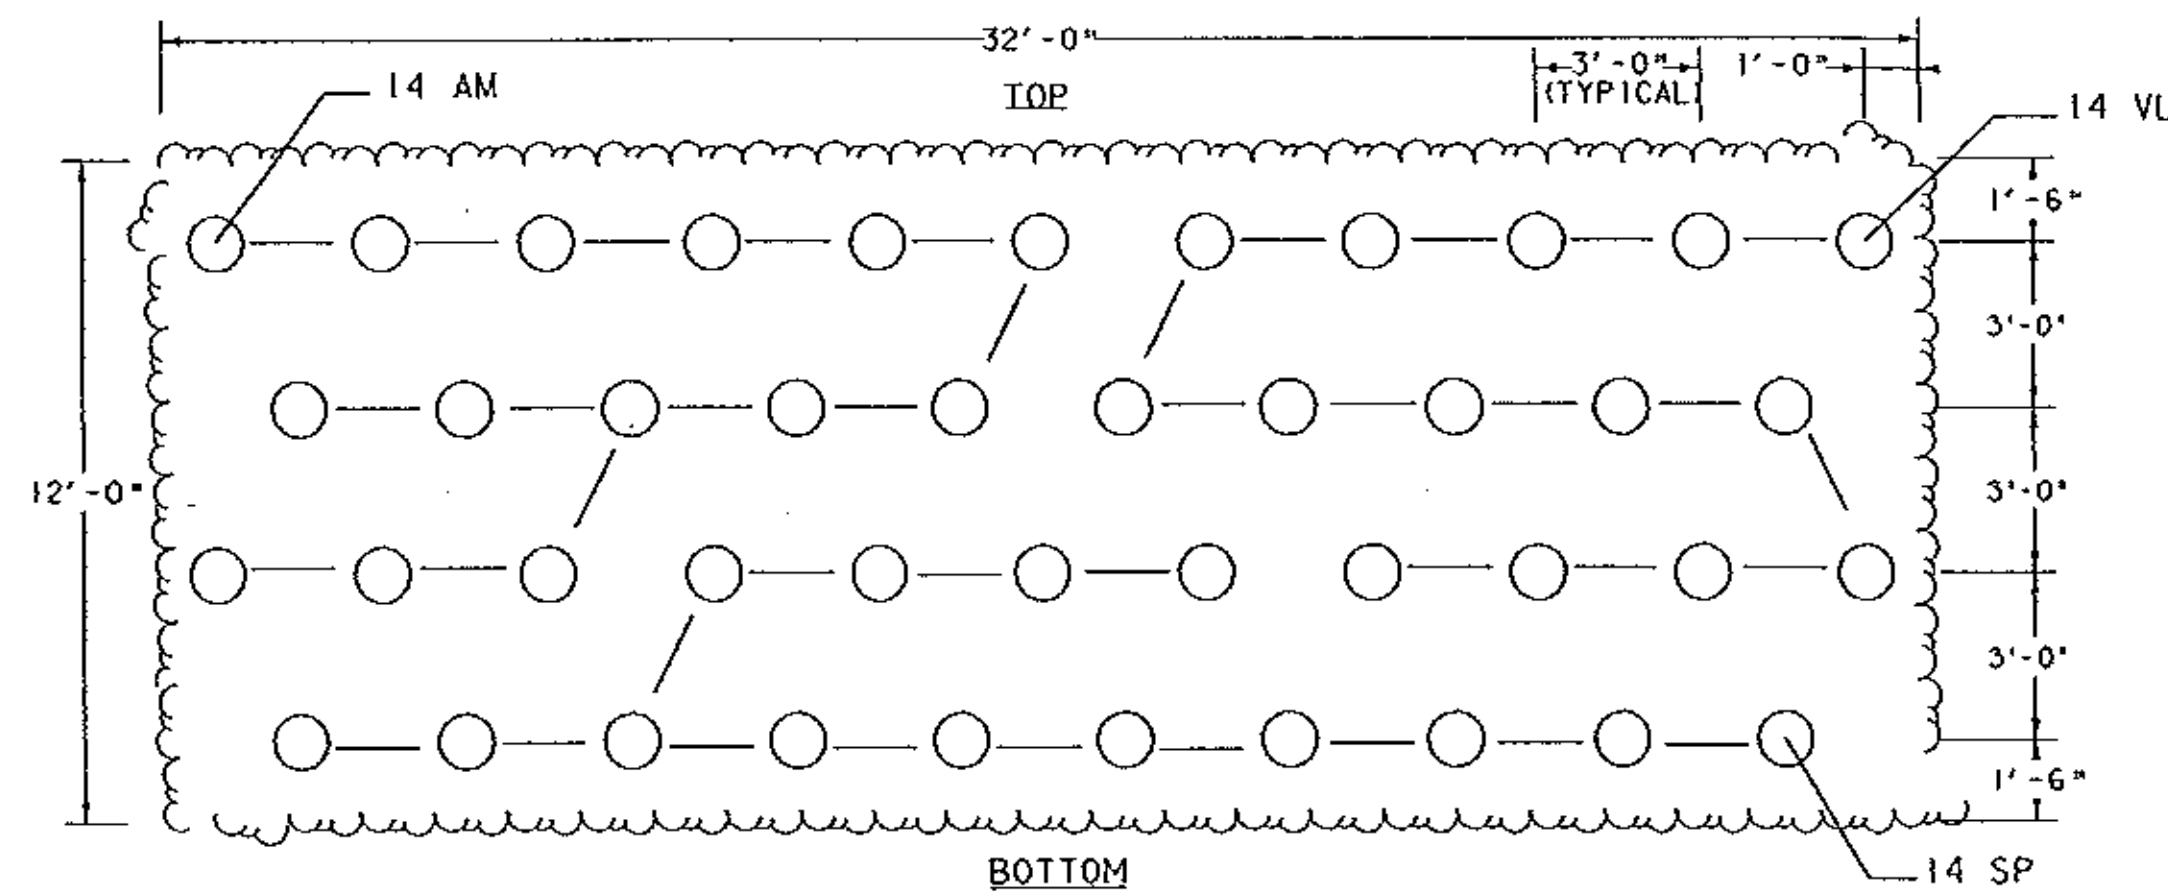
FINAL CONDITIONS SITE PLAN SHEET #2

PROJECT NAME: WOODFORD  
 PROJECT NUMBER: BHF 010-K(29)  
 FILE NAME: 84e039/structures/84e039arobdr.dgn PLOT DATE: 03-OCT-2005  
 PROJECT LEADER: M EVANS-MONGEON DRAWN BY: W FARLEY  
 DESIGNED BY: W FARLEY CHECKED BY:  
 IPARM: epscfino2.1 SHEET 32 OF 106

**PLANT AND TREE LIST**

QUANTITY	UNIT	KEY	BOTANICAL NAME	COMMON NAME	SIZE	SPACING	REMARKS	ITEM #
<del>116</del>	EA	PS-TR	EVERGREEN SEEDLING PINUS STROBUS	WHITE PINE	1-2' MINIMUM HT	6' OC	1 GALLON CONTAINER	656.15
7	EA	PS	EVERGREEN TREES PINUS STROBUS	WHITE PINE	5-6' MINIMUM HT	12' OC	CONTAINER/ B&B	656.20
<b>DECIDUOUS TREES</b>								
3	EA	AS	ACER SACCHARUM	SUGAR MAPLE	1.5-2.0" CAL	30' OC	CONTAINER/ B&B	656.30
2	EA	BP	BETULA Papyrifera	PAPER BIRCH (CLUMP OF 3)	8-10' MINIMUM HT	30' OC	CONTAINER/ B&B	656.30
<del>11</del>	EA	BPO	BETULA POPULIFOLIA	GRAY BIRCH	4-5' MINIMUM HT	6' OC	2 GALLON CONTAINER	656.30
<del>10</del>	EA	FA	FRAXINUS AMERICANA	WHITE ASH	4-5' MINIMUM HT	35' OC	2 GALLON CONTAINER	656.30
<del>34</del>	EA	PRS	PRUNUS SEROTINA	BLACK CHERRY	4-5' MINIMUM HT	6' OC	2 GALLON CONTAINER	656.30
<del>28</del>	EA	PV	PRUNUS VIRGINIANA	CHOKO CHERRY	4-5' MINIMUM HT	6' OC	2 GALLON CONTAINER	656.30
<b>DECIDUOUS SHRUBS</b>								
<del>350</del>	EA	AM	ARONIA MELANOCARPA	BLACK CHOKEBERRY	18" MINIMUM HT	3' OC	1 GALLON CONTAINER	656.35
<del>196</del>	EA	CR	CORNUS RACEMOSA	GRAY DOGWOOD	18" MINIMUM HT	3' OC	1 GALLON CONTAINER	656.35
<del>112</del>	EA	SP	SALIX PURPUREA	STREAMCO WILLOW	18" MINIMUM HT	3' OC	1 GALLON CONTAINER	656.35
<del>112</del>	EA	VL	VIBURNUM LENTAGO	NANNYBERRY	18" MINIMUM HT	3' OC	1 GALLON CONTAINER	656.35

**WOODY SHRUBS GROUPINGS**



**TYPICAL PLANT LIST FOR ONE WOODY SHRUBS DETAIL**

QTY	KEY	COMMON NAME	BOTANICAL NAME
14	VL	NANNY BERRY	VIBURNUM LENTAGO
14	AM	BLACK CHOKEBERRY	ARONIA MELANOCARPA
14	SP	STREAMCO WILLOW	SALIX PURPUREA


**LOCATION OF WOODY SHRUBS PLANTING LAYOUTS AND LENGTHS**

STA 64+02 TO STA 64+67 RT (64' X 12') REPEAT 2 X ON SLOPED GROUND  
 STA 65+09 TO STA 65+40 LT (32' X 12') REPEAT 1 X ON SLOPED GROUND  
 STA 68+83 TO STA 70+42 LT (160' X 12') REPEAT 5 X ON FLAT GROUND

**NOTES:**

1. LOCATIONS AND BED SHAPES ARE APPROXIMATE AND MAY VARY DUE TO SLOPE. FINAL LOCATION AND ELEVATIONS TO BE DETERMINED BY THE ENGINEER BASED ON ACTUAL SLOPE CONDITIONS.
2. SEE EPSC PLAN SHEETS FOR ACTUAL GROUPING LOCATIONS.
3. GROUPING SHAPES ARE TO BE STAKED AND LAID OUT TO GIVE A NATURAL APPEARANCE.
4. TYPICAL GROUPING LAYOUTS SHOWN ARE FOR FLAT AND STEEP SLOPES OF PROJECT WHERE THERE IS NO STONE FILL.
5. WATER ALL SHRUBS AND SEEDLING TREES AT TIME OF PLANTING. EACH SHRUB AND SEEDLING TREE SHALL RECEIVE A MINIMUM OF 5 GALLONS OF WATER TWICE A WEEK.
6. SEE SPECIAL PROVISIONS FOR 651.18 FERTILIZER (\*MOD\*), THE APPLICATION OF MYCORRHIZAL FUNGI PER MANUFACTURER'S RECOMMENDATIONS AND 651.35 TOPSOIL \*MOD\*, THE APPLICATION OF COMPOST.

**SHRUBS AND SEEDLING TREES GROUPING**

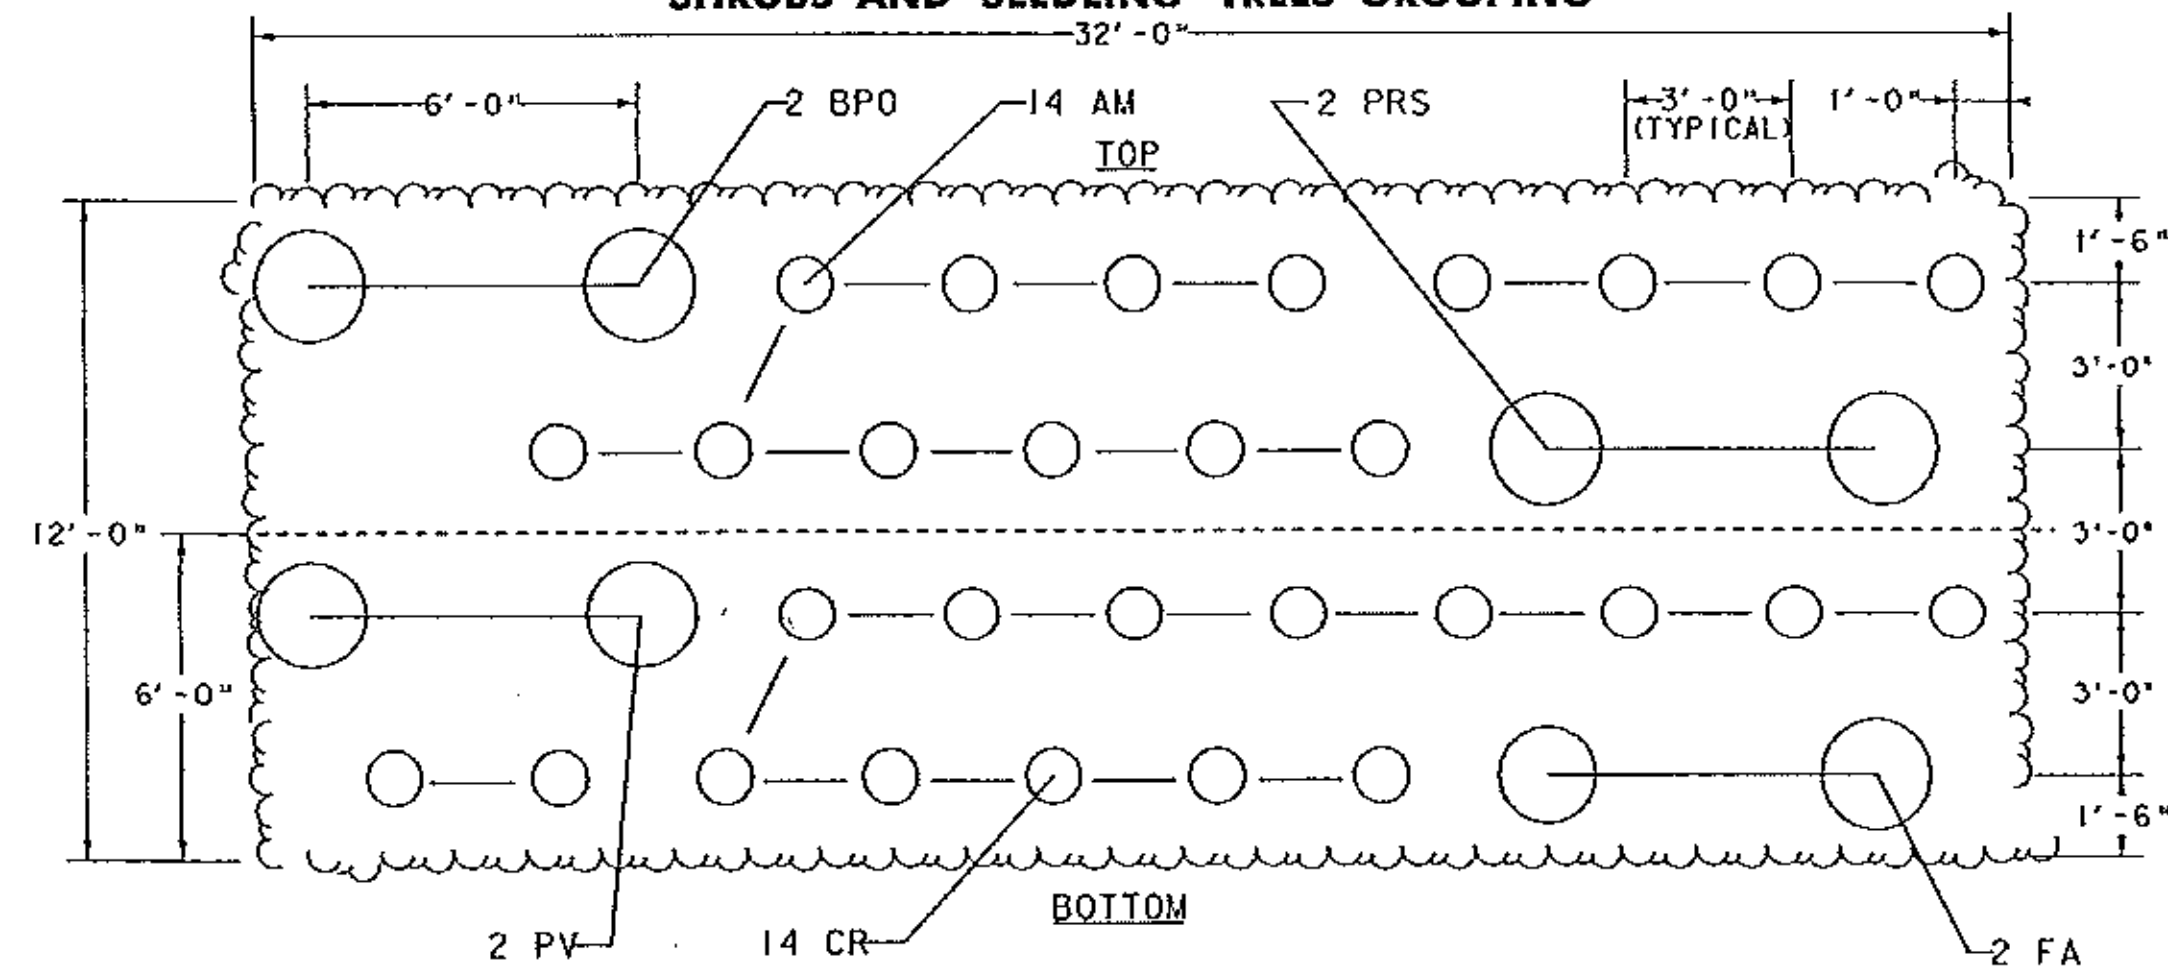

**TYPICAL PLANT LIST FOR ONE SHRUBS AND SEEDLING TREES DETAIL**

QTY	KEY	COMMON NAME	BOTANICAL NAME
2	BPO	GRAY BIRCH	BETULA POPULIFOLIA
2	PRS	BLACK CHERRY	PRUNUS SEROTINA
2	FA	WHITE ASH	FRAXINUS AMERICANA
2	PV	CHOKO CHERRY	PRUNUS VIRGINIANA
14	AM	BLACK CHOKEBERRY	ARONIA MELANOCARPA
14	CR	GRAY DOGWOOD	CORNUS RACEMOSA

**LOCATION OF SHRUBS AND SEEDLING TREES PLANTING LAYOUTS AND LENGTHS**

**PART A**  
 STA 67+65 TO STA 69+59 RT (192' X 12') REPEAT 6 X ON SLOPED GROUND  
**PART B**  
 STA 65+36 TO STA 66+09 LT (96' X 24') REPEAT 6 X ON FLAT GROUND  
 STA 68+36 TO STA 69+06 LT (64' X 12') REPEAT 2 X ON FLAT GROUND


UTILIZE PART A FOR THE FOLLOWING STATIONS:  
 STA 68+15 TO STA 69+13 LT (96' X 6') REPEAT 3 X ON SLOPED GROUND  
 UTILIZE PART B FOR THE FOLLOWING STATIONS:  
 NOT USED

**LANDSCAPE GROUPING DETAIL & PLANT LIST**

PROJECT NAME:	WOODFORD
PROJECT NUMBER:	BHF 010-(129)
FILE NAME:	84e039/structures/84e039r0bdr.dgn
PROJECT LEADER:	M EVANS-MONGEON
DESIGNED BY:	J BROWN
IPARM:	epsclspdet11
PLOT DATE:	03-OCT-2005
DRAWN BY:	L GOLDSTEIN
CHECKED BY:	
SHEET	37 OF 106

NOT TO SCALE

**NOT TO SCALE**

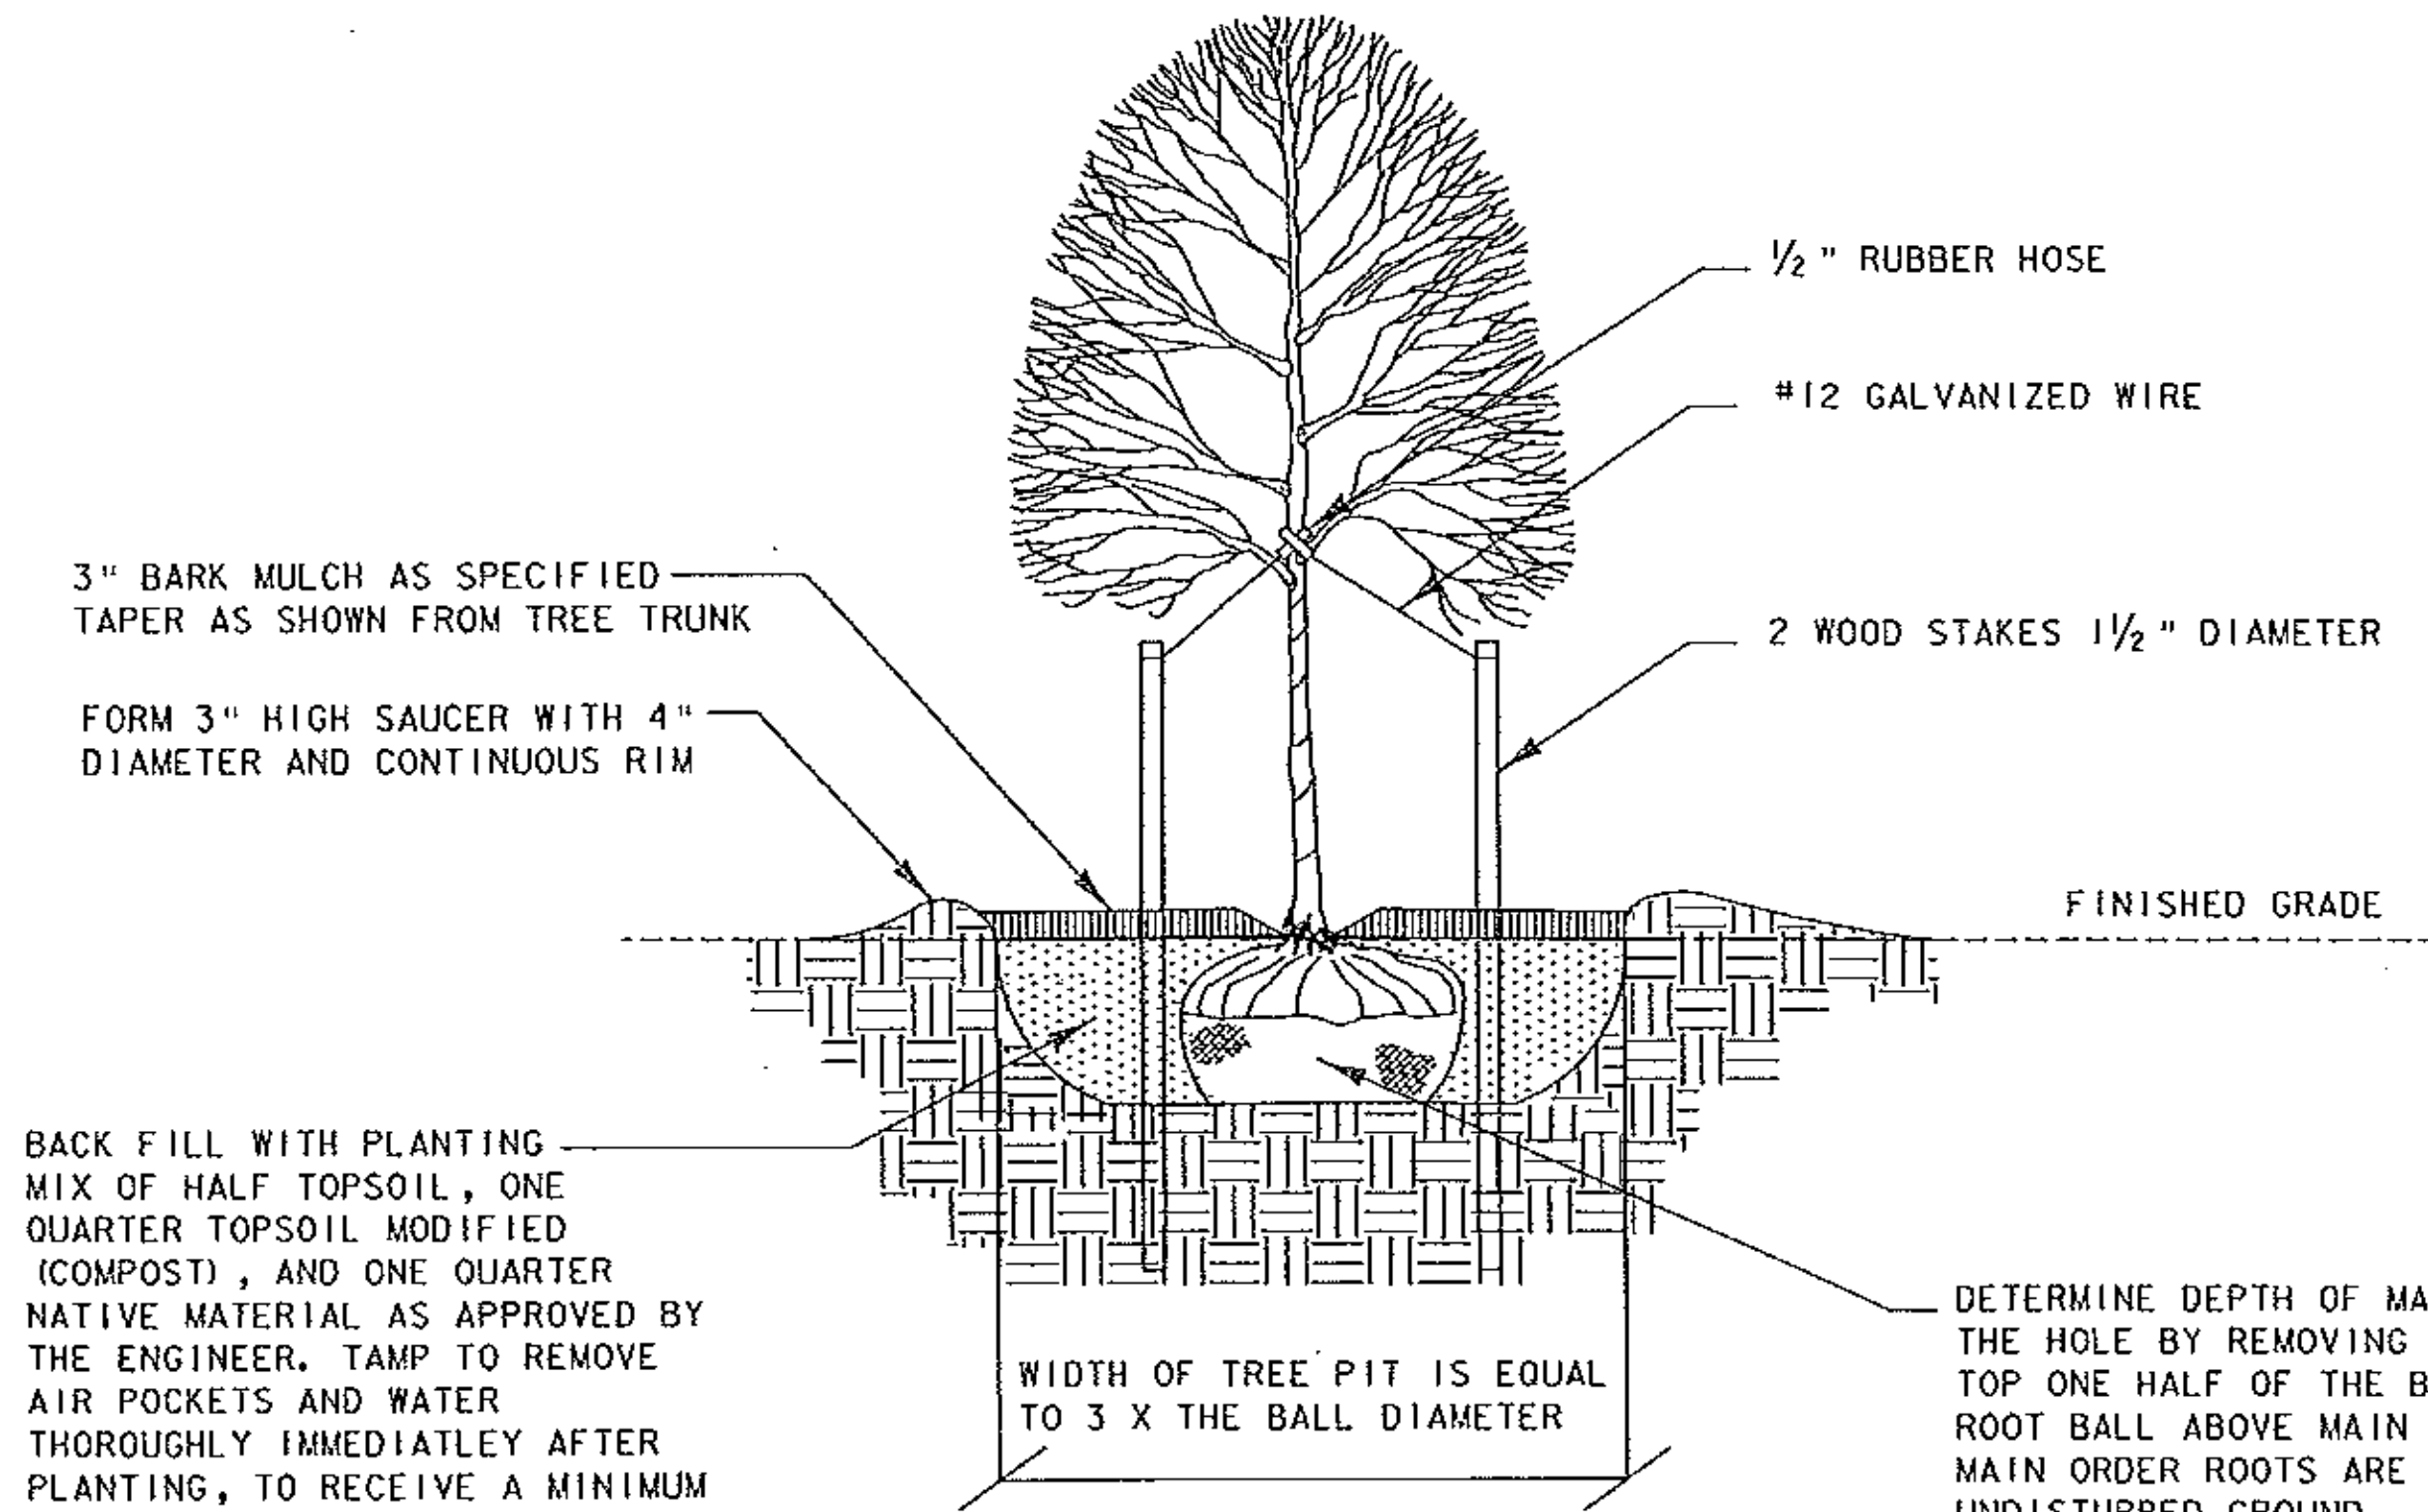

**DECIDUOUS TREE PLANTING DETAIL**

**NOTES:**

1. STAKE ONLY THOSE TREES PLANTED IN WINDY, EXPOSED LOCATIONS, WHERE THEY MIGHT BE BLOWN OVER OR VANDALIZED.
2. COMPLETELY REMOVE ALL GUY WIRES, RUBBER HOSE, AND STAKES ONE YEAR AFTER PLANTING.

**GENERAL LANDSCAPE NOTES:**

1. FOLLOW STATE OF VERMONT AGENCY OF TRANSPORTATION STANDARD SPECIFICATIONS FOR CONSTRUCTION, SECTION 656.
2. SEE SPECIAL PROVISIONS FOR 651.18 FERTILIZER (MOD), THE APPLICATION OF MYCORRHIZAL FUNGI PER MANUFACTURER'S RECOMMENDATIONS AND 651.35 TOPSOIL (MOD), THE APPLICATION OF COMPOST.
3. TREE AND SHRUB SEEDLINGS FOR EROSION CONTROL AND RIPARIAN ZONE PLANTINGS ARE SPECIAL ORDER ITEMS. THE FOLLOWING ARE AMONG THE SOURCES FOR THIS SPECIFIC PLANT MATERIAL.

NEW ENGLAND WETLAND PLANTS, INC.  
800 MAIN ST.  
AMHERST, MA 01002  
820 WEST ST. NURSERY  
AMHERST, MA 01002  
TEL: (413) 256-1752

HIGH REACH FARM  
2847 TAMPICO ROAD  
DANVILLE, VT 05828  
TEL: (802) 748-3512

COBBLE CREEK NURSERY  
991 TYLER BRIDGE ROAD  
BRISTOL, VT 05443  
TEL: (802) 453-3889  
COBSCREEK@MADRIVER.COM


HORSFORD GARDENS & NURSERY  
2111 GREENBUSH ROAD  
CHARLOTTE, VT 05445  
TEL: (802) 425-2811  
FAX: (802) 425-2797

NORTHERN NURSERIES, INC.  
WHOLESALE DISTRIBUTOR (OUT OF CT)  
P.O. BOX 1048  
WHITE RIVER JCT. VT 05001  
TEL: (802) 295-2117  
FAX: (802) 295-4889

HOP RIVER NURSERY  
251 HOP RIVER ROAD  
ROUTE 6  
BOLTON, CT 06043  
TEL. & FAX: (860) 646-7099

BIGELOW NURSERIES  
P.O. BOX 718  
NORTHBOROUGH, MA 01532  
TEL: (508) 845-2143  
FAX: (508) 842-9245

PIERSON NURSERIES, INC.  
24 BUZZELL ROAD  
BIDDEFORD, MAINE 04005  
TEL: (207) 499-2994  
FAX: (207) 499-2912

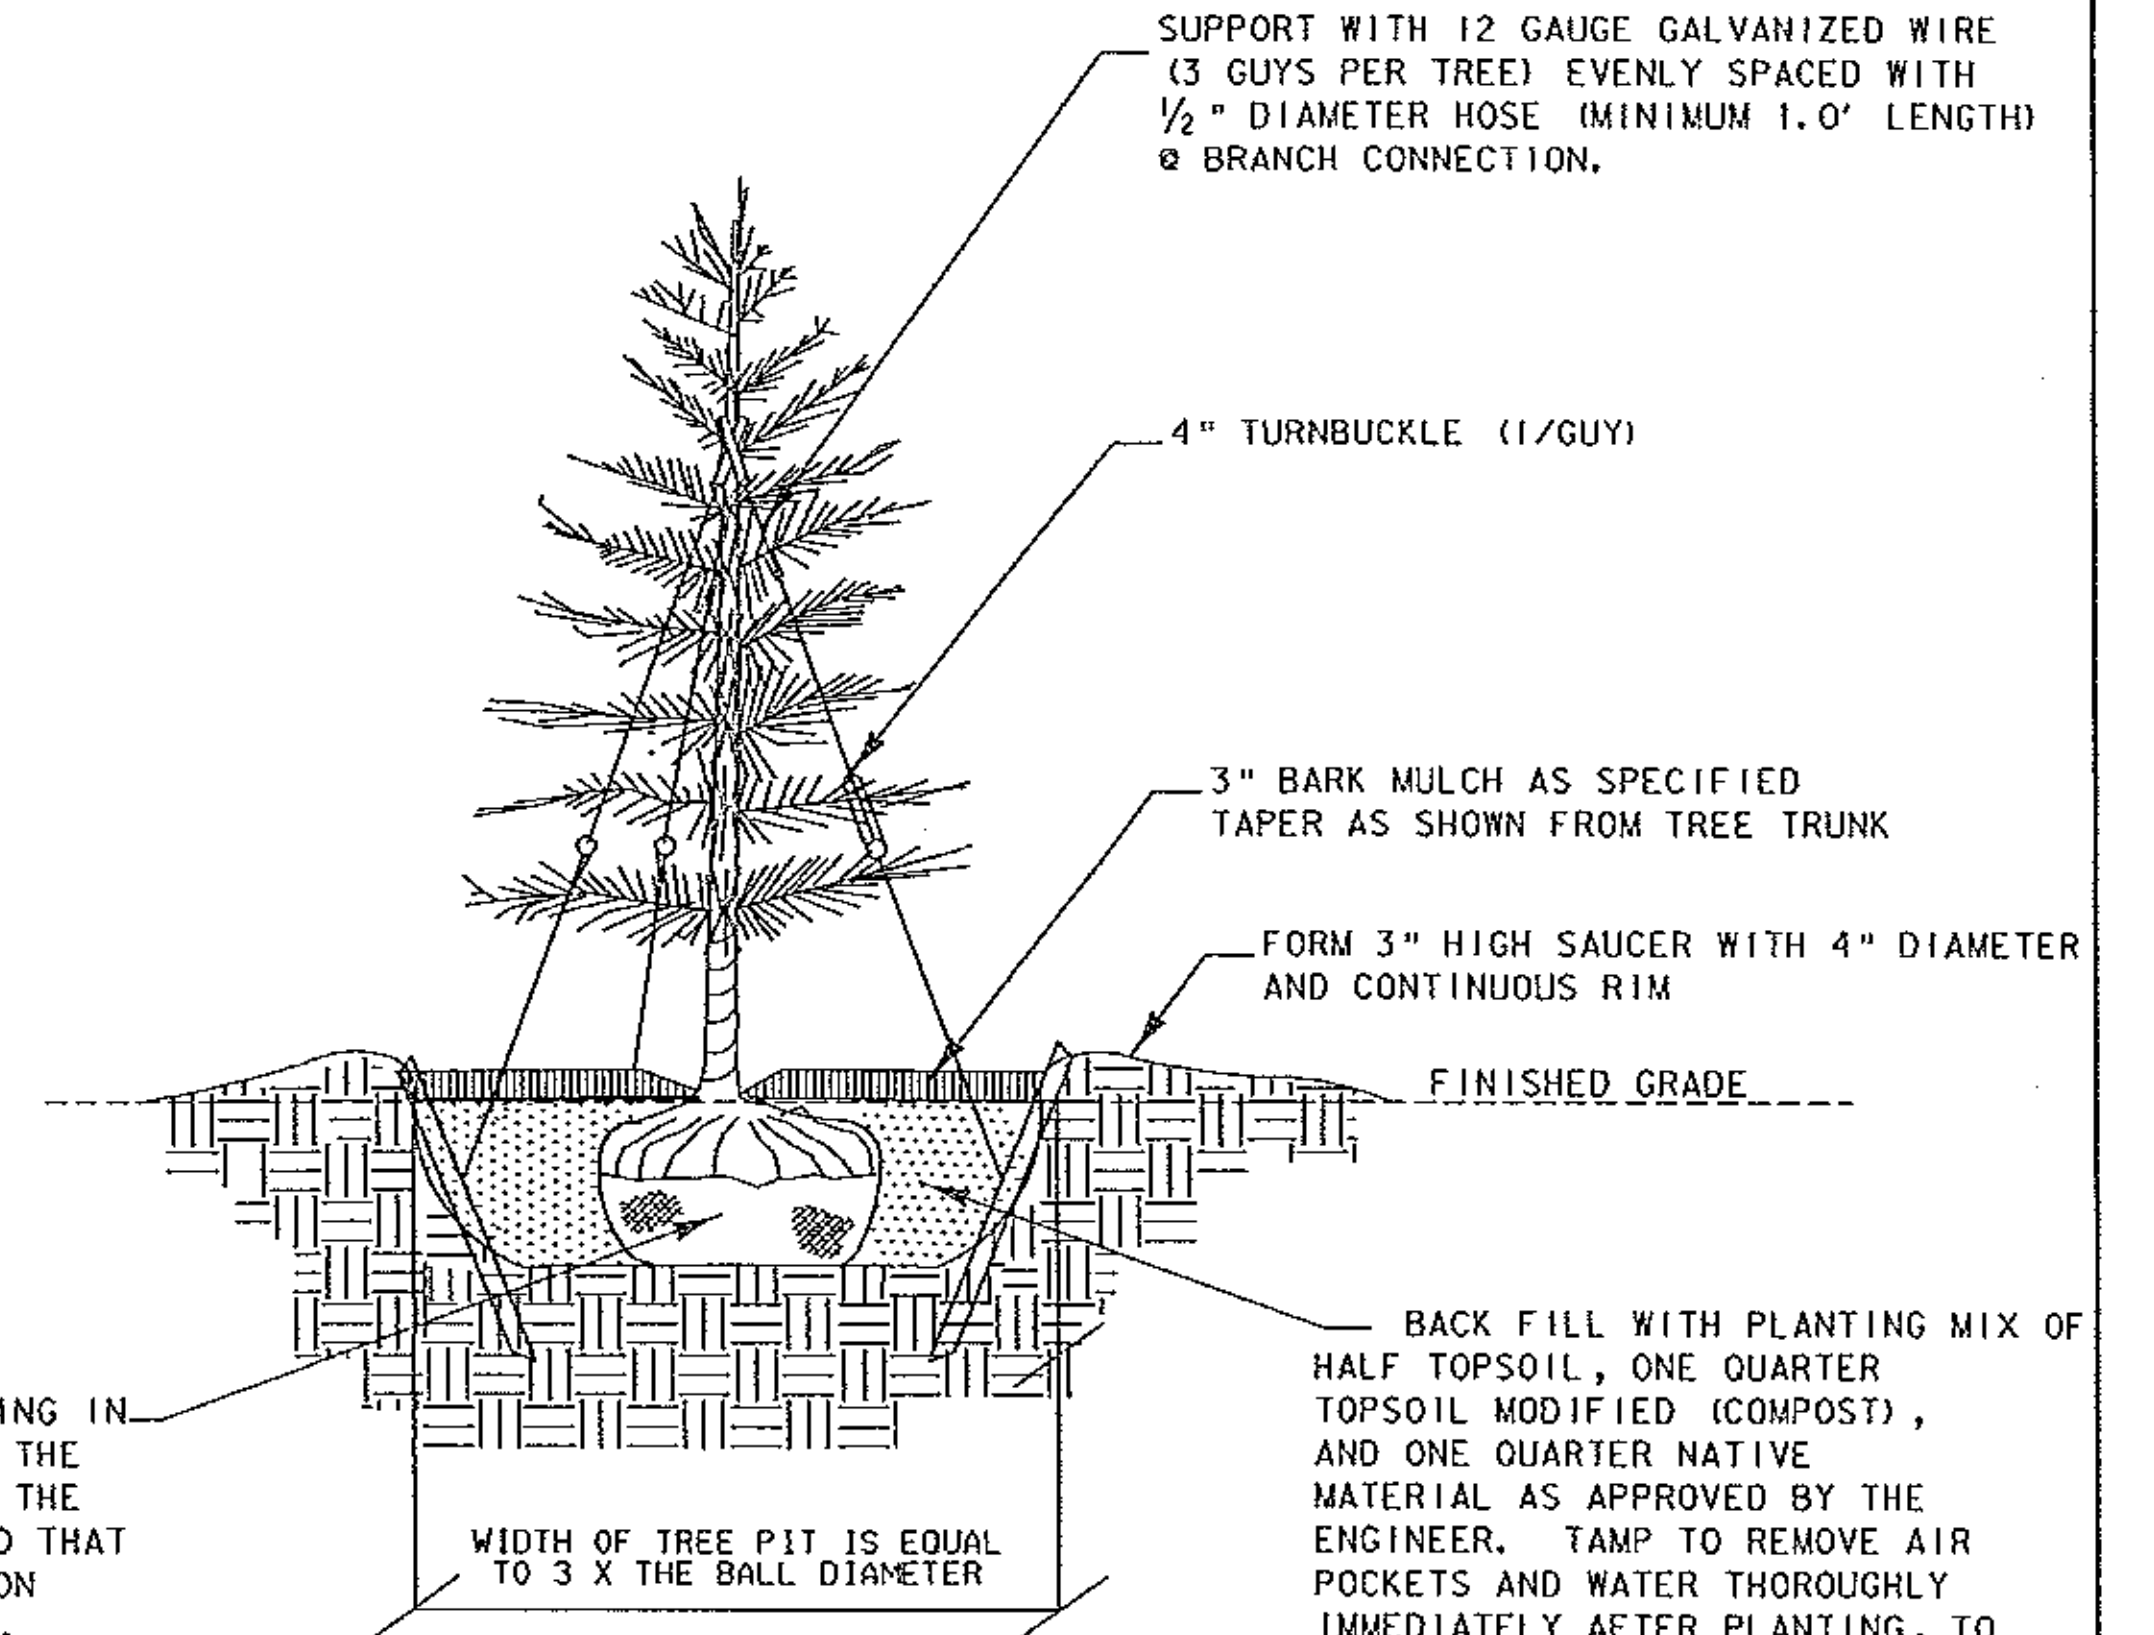

**EVERGREEN TREE PLANTING DETAIL**

**NOTES:**

1. ANTI-DESICCANT SPRAY IS TO BE APPLIED TO ALL EVERGREENS PER MANUFACTURER SPECIFICATIONS.
2. COMPLETELY REMOVE ALL GUY-WIRES AND TURNBUCKEL ONE YEAR AFTER PLANTING.

**SEEDING FORMULA  
RURAL AREAS**

% WT.	LBS./A.	NAME	PUR %	GERM %
37.5	22.5	CREEPING RED FESCUE	98	85
37.5	22.5	TALL FESCUE	95	90
5.0	3.0	RED TOP	95	90
15.0	9.0	BIROSFOT TREFOIL	98	85
5.0	3.0	ANNUAL RYEGRASS	95	85
100.0	60.0			

**GENERAL NOTES**

1. SEED MIXTURE SHALL NOT HAVE A WEED CONTENT EXCEEDING 0.40% BY WEIGHT AND SHALL BE FREE OF ALL NOXIOUS SEED.
2. SEEDS TO BE APPLIED PER SEEDING FORMULAS OR AS DIRECTED BY THE ENGINEER. FERTILIZER: FORMULA 10-20-10, TO BE USED WITH SEED, APPLIED AT THE RATE OF 500 LBS./ACRE. (HYDRO SEEDERS MAY USE 19-19-19 FORMULA).
3. AGRICULTURAL LIMESTONE: TO BE APPLIED AT THE RATE OF 2 TONS/ACRE, OR AS DIRECTED BY THE ENGINEER. HAY MULCH: TO BE PLACED ON EARTH SLOPES AT THE RATE OF 2 TONS/ACRE, OR AS DIRECTED BY THE ENGINEER.

**LANDSCAPE TREE PLANTING DETAIL**

PROJECT NAME: WOODFORD	PLOT DATE: 03-OCT-2005
PROJECT NUMBER: BHF 010-(K29)	DRAWN BY: SQUAD B
FILE NAME: 48a039/structures/84a039arobdr.dgn	CHECKED BY:
PROJECT LEADER: M EVENS-MONGEON	SHEET 38 OF 106
DESIGNED BY: J BROWN	
IPARM: epsclspdet2.j	

NOT TO SCALE

NOTE:  
SHRUBS SHALL BE MULCHED ONLY  
ON FLAT GROUND OR DISCRETION  
OF ENGINEER.

2" BARK MULCH AS SPECIFIED.  
TAPER AT BASE AS SHOWN.

FORM SAUCER WITH 3" HIGH BY 3"  
WIDE CONTINUOUS RIM.

EXISTING GRADE

FINISHED GRADE

BACK FILL MIX CONSISTS OF 1/2  
TOPSOIL, 1/4 COMPOST, AND 1/4  
NATIVE MATERIAL AS APPROVED BY  
THE ENGINEER. TAMP TO REMOVE  
AIR POCKETS AND WATER  
THOROUGHLY AT TIME OF PLANTING.

PLACE SHRUB IN THE HOLE SUCH  
THAT BARE ROOT BALL RESTS ON  
UNDISTURBED GROUND. AVOID  
PLANTING TOO DEEP. TOP OF  
ROOTBALL SHOULD BE AT FINISHED  
GRADE.

PLANTING HOLE SHALL BE AT  
LEAST 3 X THE WIDTH OF  
THE ROOT BALL.

SHRUB AND SEEDLING TREE PLANTING DETAIL

2" BARK MULCH AS SPECIFIED.  
TAPER AT BASE AS SHOWN.

MAINTAIN MINIMUM 3" HIGH BY 3" WIDE  
CONTINUOUS RIM ON LOWER SIDES OF  
PLANTING TO RETAIN WATER.

ORIGINAL GROUND

BIODEGRADABLE  
JUTE MESH

BACK FILL MIX CONSISTS OF 1/2 TOPSOIL,  
1/4 COMPOST, AND 1/4 NATIVE MATERIAL AS  
APPROVED BY THE ENGINEER. TAMP TO  
REMOVE AIR POCKETS AND WATER THOROUGHLY  
AT TIME OF PLANTING.

PLACE SHRUB IN THE HOLE SUCH THAT BARE  
ROOT BALL RESTS ON UNDISTURBED GROUND.  
AVOID PLANTING TOO DEEP. TOP OF ROOTBALL  
SHOULD BE AT FINISHED GRADE.

PLANTING HOLE SHALL BE AT  
LEAST 2 X THE WIDTH OF  
THE ROOT BALL.

SHRUB AND SEEDLING TREE PLANTING ON SLOPES DETAIL

FINISHED GRADE

FORM 3" HIGH BY 3" WIDE LIP  
SAUCER WITH CONTINUOUS RIM OF  
2" BARK MULCH TAPERING AT BASE  
AS SPECIFIED.

NOTE:  
SEE SHRUB AND SEEDLING TREE PLANTING DETAIL.  
SHRUBS SHALL BE MULCHED ON FLAT GROUND ONLY OR AT  
DISCRETION OF ENGINEER.

EXISTING SOIL

SHRUBS AND SEEDLING TREE GROUPINGS CROSS SECTION

(FOR FLAT GROUND)

BACK FILL MIX CONSISTS OF 1/2  
TOPSOIL, 1/4 COMPOST, AND 1/4  
NATIVE MATERIAL AS APPROVED BY  
THE ENGINEER.

TAMP TO REMOVE AIR POCKETS AND  
WATER THOROUGHLY AT TIME OF  
PLANTING.

LANDSCAPE GROUP AND SHRUB CROSS-SECTION

PROJECT NAME: WOODFORD  
PROJECT NUMBER: BHF 010-1(29)

FILE NAME: 84e039/structures/84e039erobdr.dgn PLOT DATE: 03-OCT-2005  
PROJECT LEADER: M EVANS-MONGEON DRAWN BY: L GOLDSTEIN  
DESIGNED BY: J BROWN CHECKED BY:  
IPARM: epsclspdet13.l SHEET 39 OF 106

NOT TO SCALE

LEIGH

**T. BUCK CONSTRUCTION  
ER BHF 010-1(44)  
WOODFORD, VT  
DELAUNCH AND DISASSEMBLY PROCEDURES  
NOVEMBER 2012**

**PROJECT:**

The bridge to be delaunch and disassembled is a 700XS Acrow Panel Bridge in Woodford, VT with one clear span of 200 ft. The truss construction is Triple Double Reinforced Three Heavy (TDR3H). The roadway width curb to curb is 24 ft. The deck is an orthotropic steel deck with an epoxy aggregate anti-skid surface.

**OVERVIEW OF REMOVAL:**

The bridge will be pulled back onto rollers behind the West Abutment. Based on input from the customer, the area behind the centerline of rocking rollers is to be a minimum of 240ft for the bridge disassembly. The bridge will be delaunch using a crane assisted delaunch utilizing a 40 ft Triple Single (TS) Nose and a 10 ft DS Tail. This method requires attaching a crane to the East End of the nose to provide support during the initial pull back until the bridge is safely pulled back onto the rollers behind the West Abutment. Roadway decks will be added to the tail as counterweight (See Launch Sequence Diagram). The deck and guardrail are to be removed prior the delaunching of the bridge.

**BRIDGE WEIGHTS:**


200 ft TDR3H span without deck	300 kips
200 ft TDR3H span with deck	425 kips
40 ft TS Nose	32 kips
10 ft DS Tail	7 kips

**BASIC EQUIPMENT:**

A small rough terrain crane (25 to 35 ton) will be needed for general disassembly. The heaviest component pick will be 7,000 lbs. **NOTE: A crane of adequate capacity will be required for the delaunching of the bridge.** Basic steel worker hand tools, including pinch bars, 3 LB sledge hammers, pry bars, 1 5/8", 2" and 1 1/16" thin-walled, deep well sockets with a 3/4" drive, 6" drive extension, 3/4" universal (swivel), two 4-ton come-alongs or two chain falls, 4-way chain with 3/8" chain slip hooks for picking deck panels (1,500 lbs each), three to four 25-ton jacks, high quality 6 \* 6 and 12 \* 12 timber dunnage, nylon straps or cable for lifting the parts during disassembly, drift pins etc. A compressor and impact wrenches capable of relieving the 650 ft-lbs of bolt torque will be required.

00000000

CRANE REACTION FOR CRANE ASSISTED LAUNCH [ @ F.S. = 1.05 ]

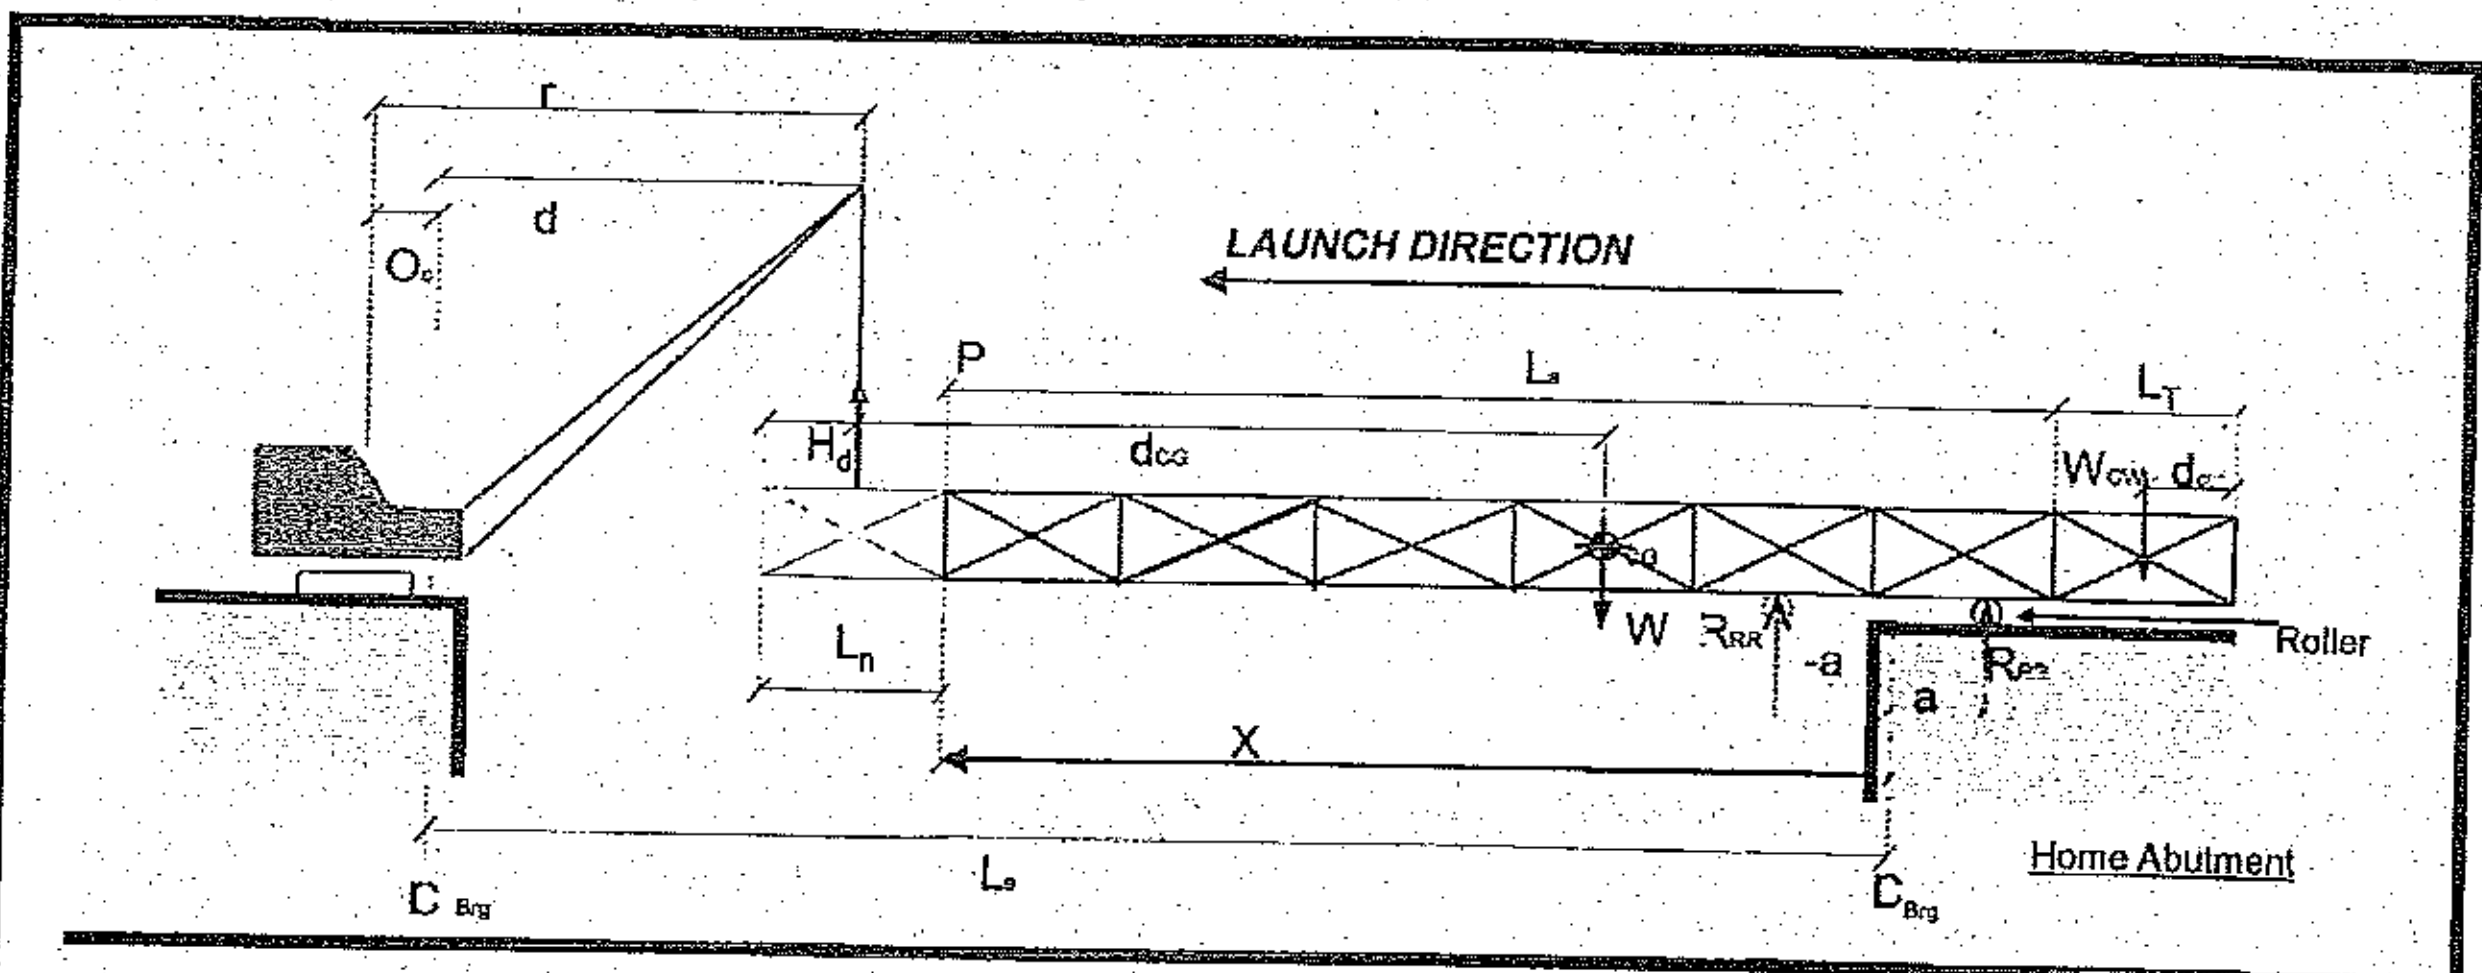

$L_a = 200$  ft       $d_{cw} = 5.0$  ft       $H_d = 0$  ft  
 $d_{cg} = 140.0$  ft       $W_{cw} = 30$  k      **Total Weight = 363.4 k (incl.  $W_{cw}$ )**  
 $L_n = 40$  ft       $L_t = 10$  ft       $a = 0$  ft  
 $W_n = 31.8$  k       $W_t = 6.43$  k       $O_c = 20$  ft

x (ft)	Radius of Crane (r) (ft.)	Hookload, P (Kips)	Reaction at R <sub>RR</sub> (Kips)
90	90	1	362
95	85	3	360
100	80	5	358
105	75	14	349
110	70	26	337
115	65	37	326
120	60	48	315
125	55	58	305
130	50	68	295
135	45	77	286
140	40	85	278
145	35	93	270
150	30	101	262
155	25	108	255
160	20	115	248

\* $O_c$  = Offset of Crane Pin to CenterLine of Bearing at far Abutment

Project: T Buck - Woodford, VT By: MJP Date: 11/21/2012

- Legend:
- r = Radius of Crane
  - $O_c$  = Offset of Crane from CenterLine of Bearing
  - d = distance from hook to CenterLine of Bearing
  - $L_n$  = Length of Nose
  - $L_a$  = Length of Main Bridge
  - $d_{cw}$  = distance from end of bridge to Center of Gravity of the Counter Weight
  - $R_{RR}$  = Reaction at Roller
  - a = distance from Roller to CenterLine of Bearing
  - $d_{cg}$  = Distance from crane hook to Center of Gravity
  - X = Distance from End of Abutment to End of Crane
  - $H_d$  = Distance from CenterLine of Bearing to Crane Hook

**STAGE 8:** Ensure that the crane boom is in line with the bridge and the cable is vertical. The crane will experience the maximum load at this point but reduce with subsequent movements.

Pull bridge back 75ft. (130 ft Max in cantilever) **STOP.**

**STAGE 9:** Disconnect the crane. **STOP.**

**STAGE 10:** Continue to pull bridge back 130ft. **STOP.**

**STAGE 11:** Remove the counterweight from the tail and disassemble the 10 ft DS Tail, the 200 ft TDR3H Bridge and the 40 ft TS Nose.

**NOTE:** - When pushing/pulling the bridge, always connect the pushing machine to the floorbeam.

- Between movements, always tie off the bridge from additional movement.

Prepared By: Michael J. [Signature] Date: 11/20/12

Checked By: Zachary Wilkins Date: 11/21/12

### PRIOR TO DISASSEMBLY

The backwall, guardrail and deck units are to be removed from the bridge prior to the Acrow Representative being on site.

Set up the build area as laid out in the Roller Layout Drawing. Position and secure the balance beams on concrete pads or timber blocking directly on the West Abutment. The balance beams will be placed as close to the center line of bearing as possible, being sure to avoid any rebar that may be present on the abutment for backwall support. The plain roller stations behind the West Abutment will be placed on top of concrete pads or timber blocking, and kept in place by keeper angles, as shown in the Roller Layout Drawing.

### DELAUNCHING 200FT TDR3H SPAN:

**STAGE 1:** Remove the backwalls, deck units and guardrail from the bridge and install the taper chords under each truss line.

Grade the build area behind the West Abutment and install the plain rollers as shown in the Roller Layout drawing. **STOP.**

**STAGE 2:** Jack/Lift the bridge at both abutments high enough to install the rocking rollers and balance beam assemblies at each abutment.

Temporarily lower the bridge onto blocking to allow for assembly of the nose and tail. **STOP.**

**STAGE 3:** Build 40ft TS nose, 10 ft DS Tail. **STOP.**

**STAGE 4:** Install the rocking rollers and balance beams at each abutment.

Lower bridge down onto rocking rollers at the each Abutment. **STOP.**






**STAGE 5:** Install the temporary bracing in the tail and Bay 20 of the bridge as shown in the Blocking/Pulling detail.

Add 20 Decks to the tail. **STOP.**

**STAGE 6:** Attach the pulling machine to the West End of the bridge.

Pull the bridge back 35 ft. **STOP.**

**STAGE 7:** Rig a crane to the East End of the nose as shown in the attached Rigging Diagram Drawing. **STOP.**

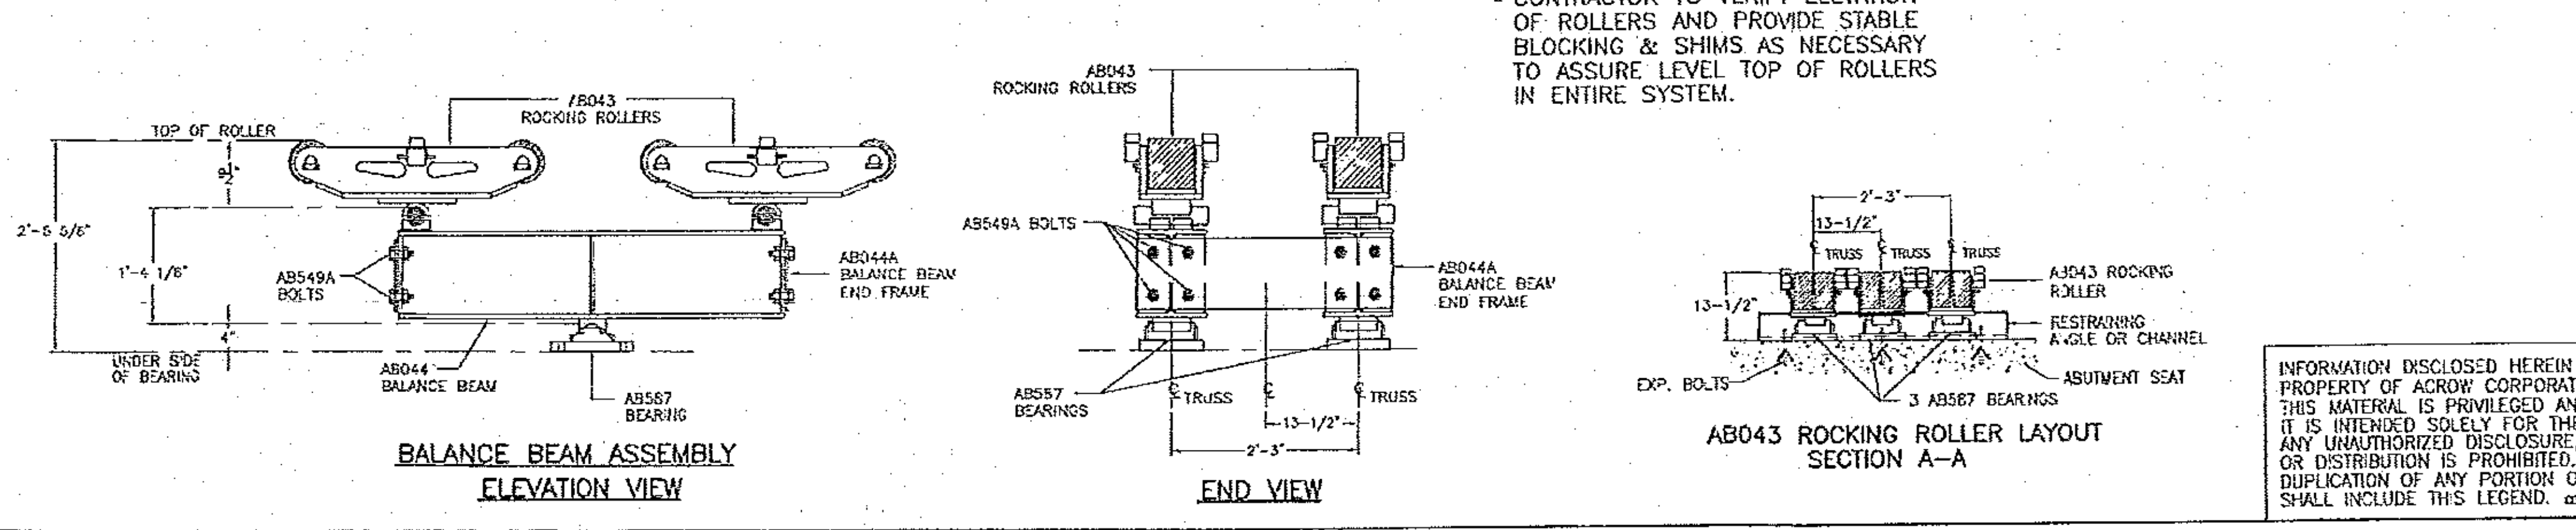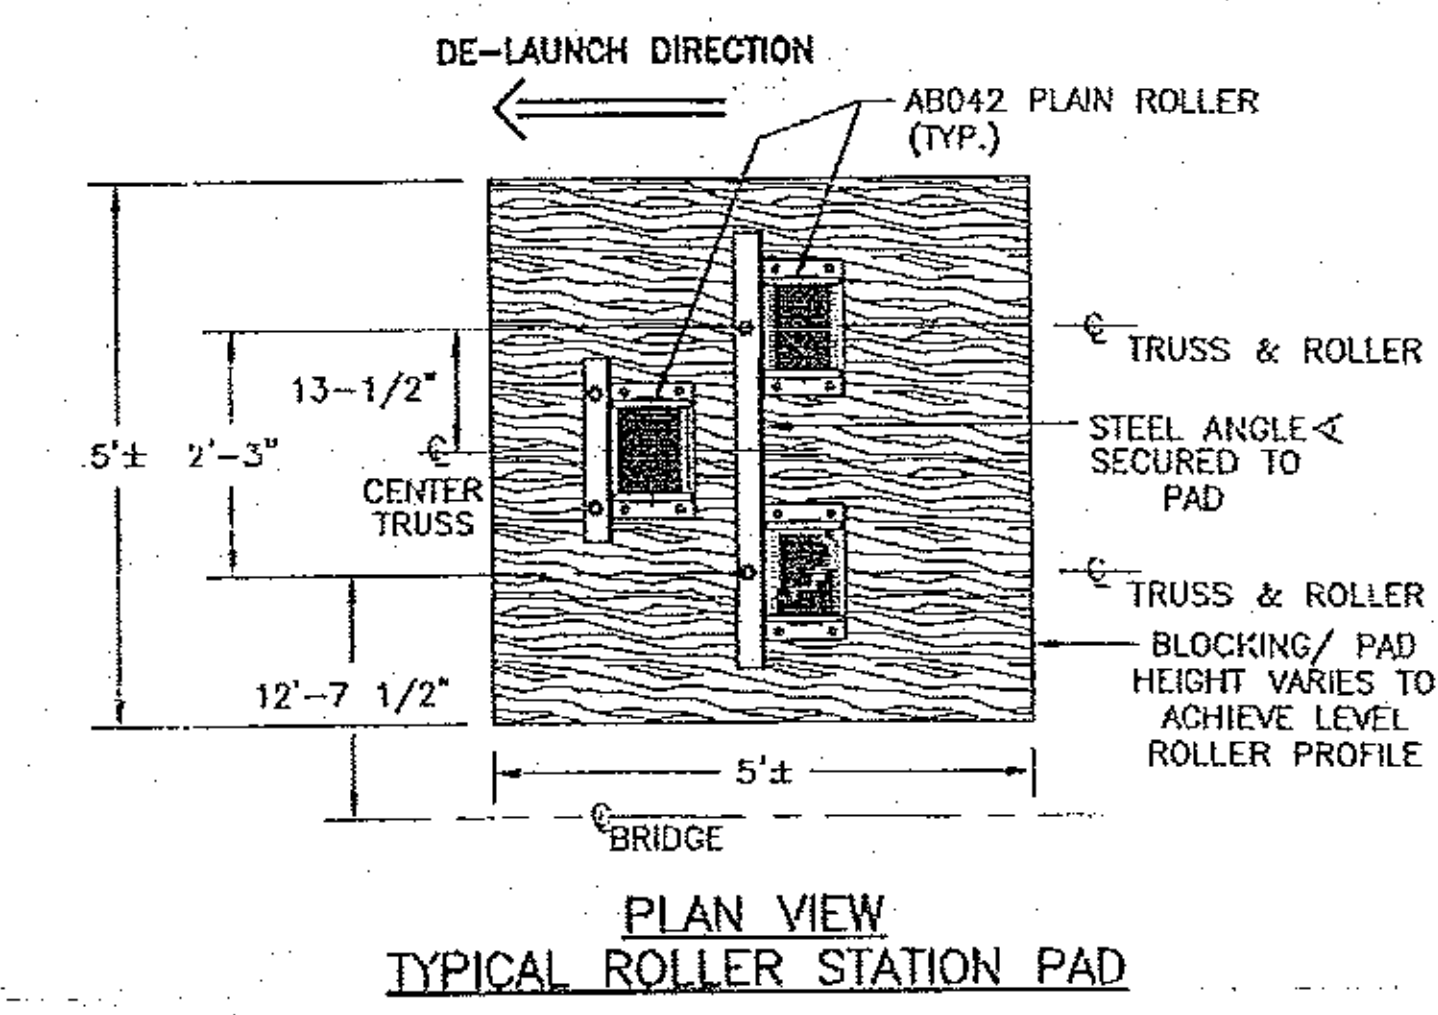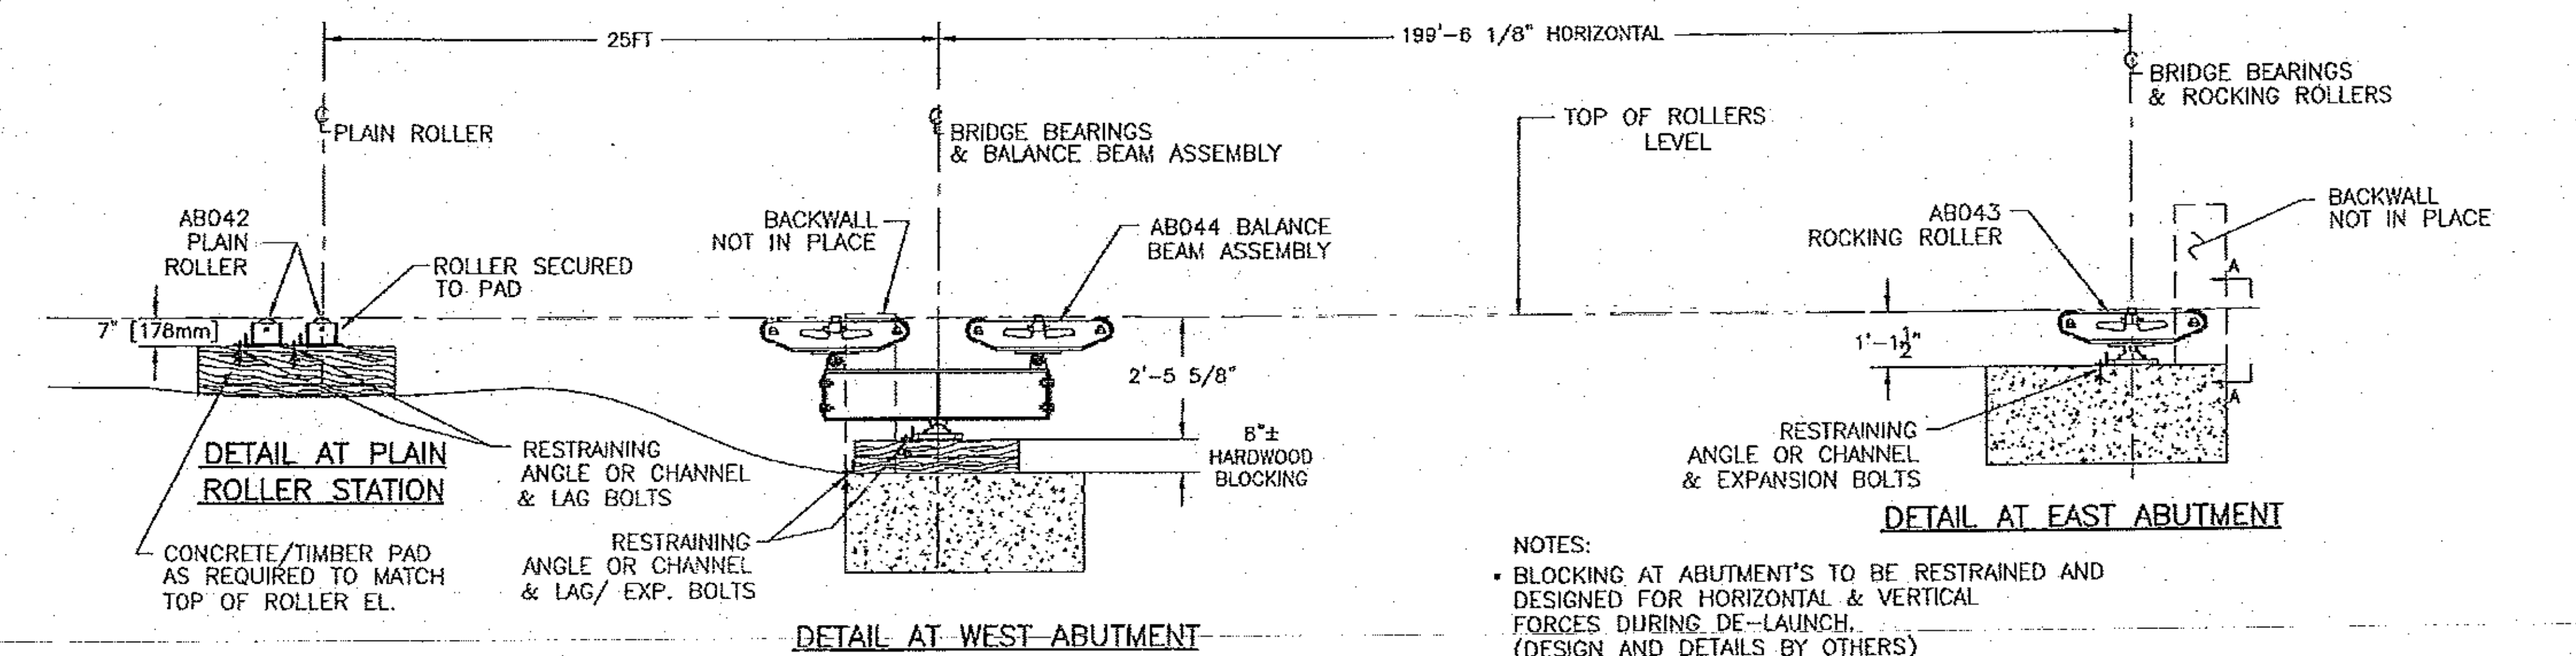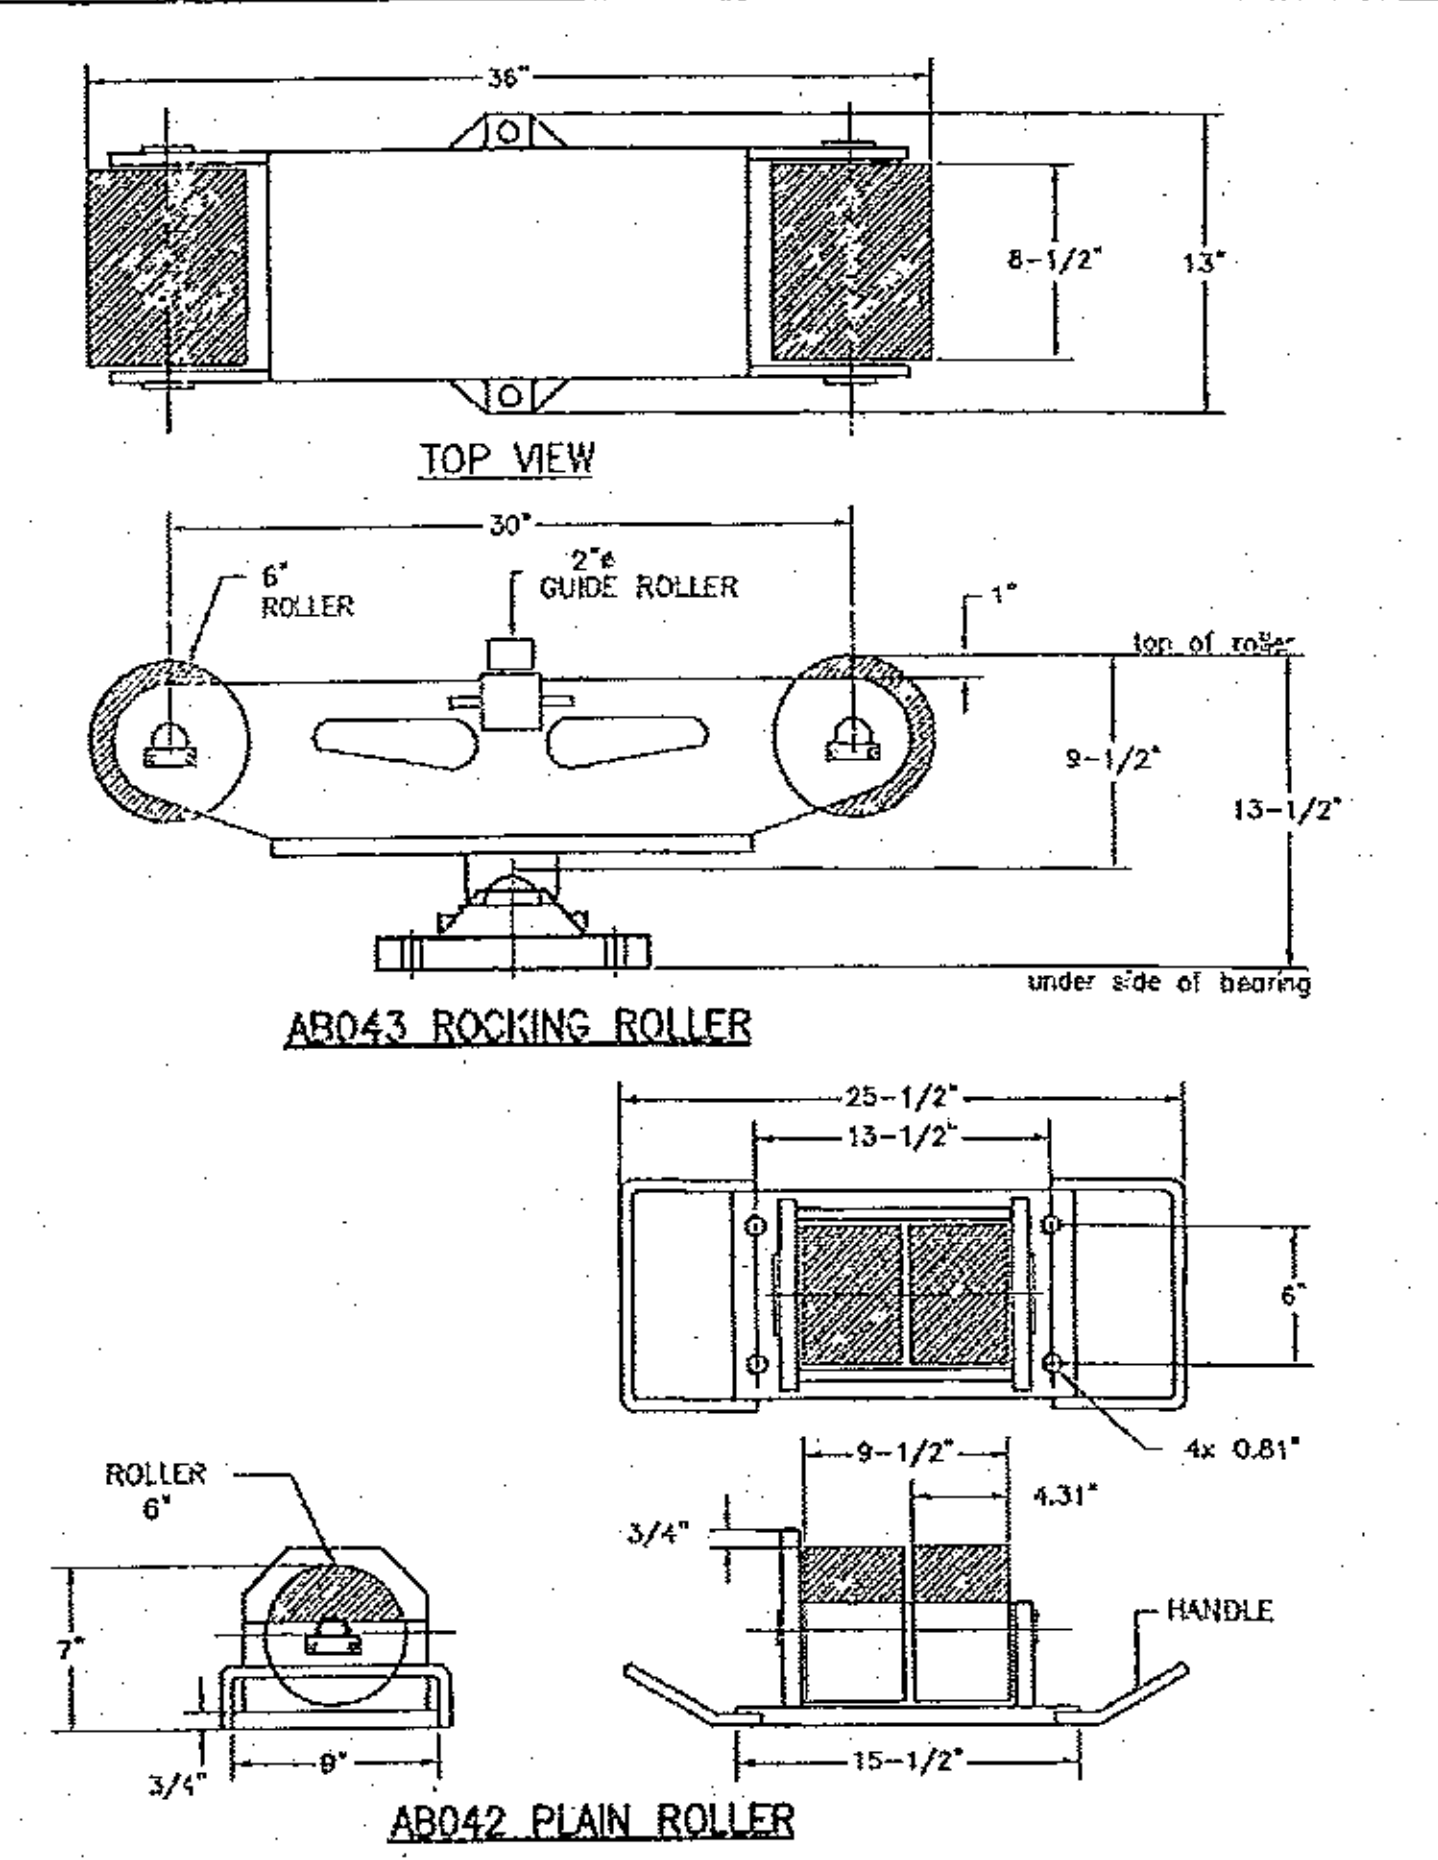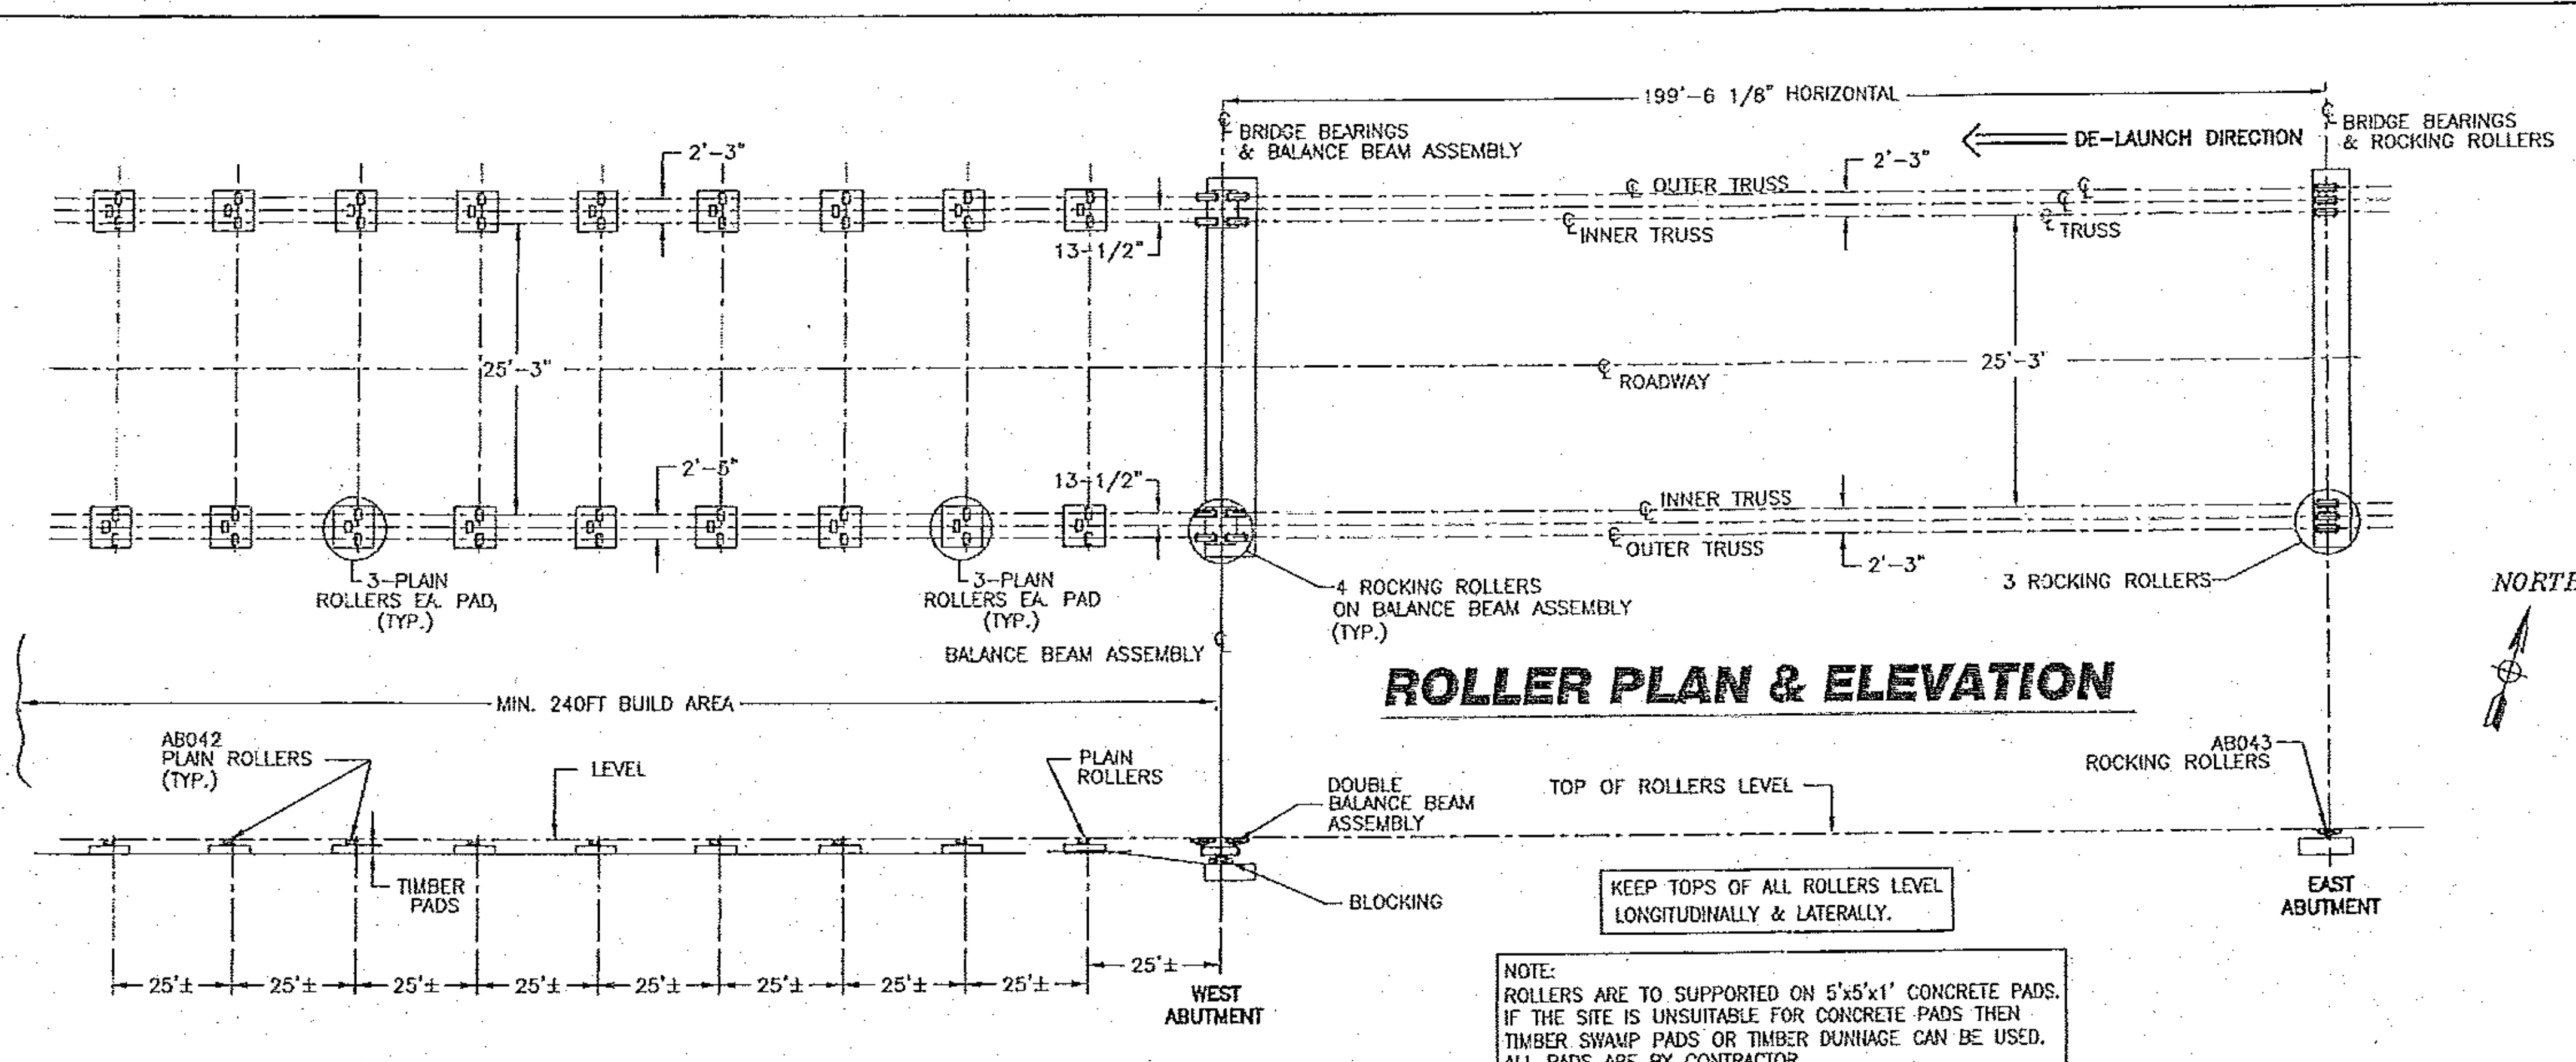

**NOTE:**  
 ROLLERS ARE TO SUPPORTED ON 5'x5'x1' CONCRETE PADS. IF THE SITE IS UNSUITABLE FOR CONCRETE PADS THEN TIMBER SWAMP PADS OR TIMBER DUNNAGE CAN BE USED. ALL PADS ARE BY CONTRACTOR.





**NOTES:**

- BLOCKING AT ABUTMENT'S TO BE RESTRAINED AND DESIGNED FOR HORIZONTAL & VERTICAL FORCES DURING DE-LAUNCH. (DESIGN AND DETAILS BY OTHERS)
- CONTRACTOR TO VERIFY ELEVATION OF ROLLERS AND PROVIDE STABLE BLOCKING & SHIMS AS NECESSARY TO ASSURE LEVEL TOP OF ROLLERS IN ENTIRE SYSTEM.

PAD DIMENSIONS TO BE INCREASED AS REQUIRED FOR UNSTABLE GROUND


INFORMATION DISCLOSED HEREIN IS THE PROPERTY OF ACROW CORPORATION OF AMERICA. THIS MATERIAL IS PRIVILEGED AND CONFIDENTIAL. IT IS INTENDED SOLELY FOR THE ADDRESSEE. ANY UNAUTHORIZED DISCLOSURE, REPRODUCTION, OR DISTRIBUTION IS PROHIBITED. DUPLICATION OF ANY PORTION OF THIS DATA SHALL INCLUDE THIS LEGEND. ©2012 ACROW CORP 2012

BY		ACROW		CREATING ENGINEERED SOLUTIONS WORLDWIDE	
DESCRIPTION		ACROW CORPORATION OF AMERICA		181 NEW ROAD, PARSIPPANY, NJ 07054	
REV. DATE		ACROW 700XS PANEL BRIDGE DE-LAUNCH ROLLER LAYOUT		200FT x 2 LANE 24FT TDR3H BRIDGE WOODFORD, VT ER BHF 010-1(44)	
DRAWN BY		RJ		DATE NOVEMBER 21, 2012	
CHECKED BY		MP		SCALE: AS SHOWN	
APPROVED BY		SP		CONTRACT NO.	
T. BUCK CONSTRUCTION		AUBURN, ME		DRAWING NO. AB1543-DL	
				SHT 1 OF 4	

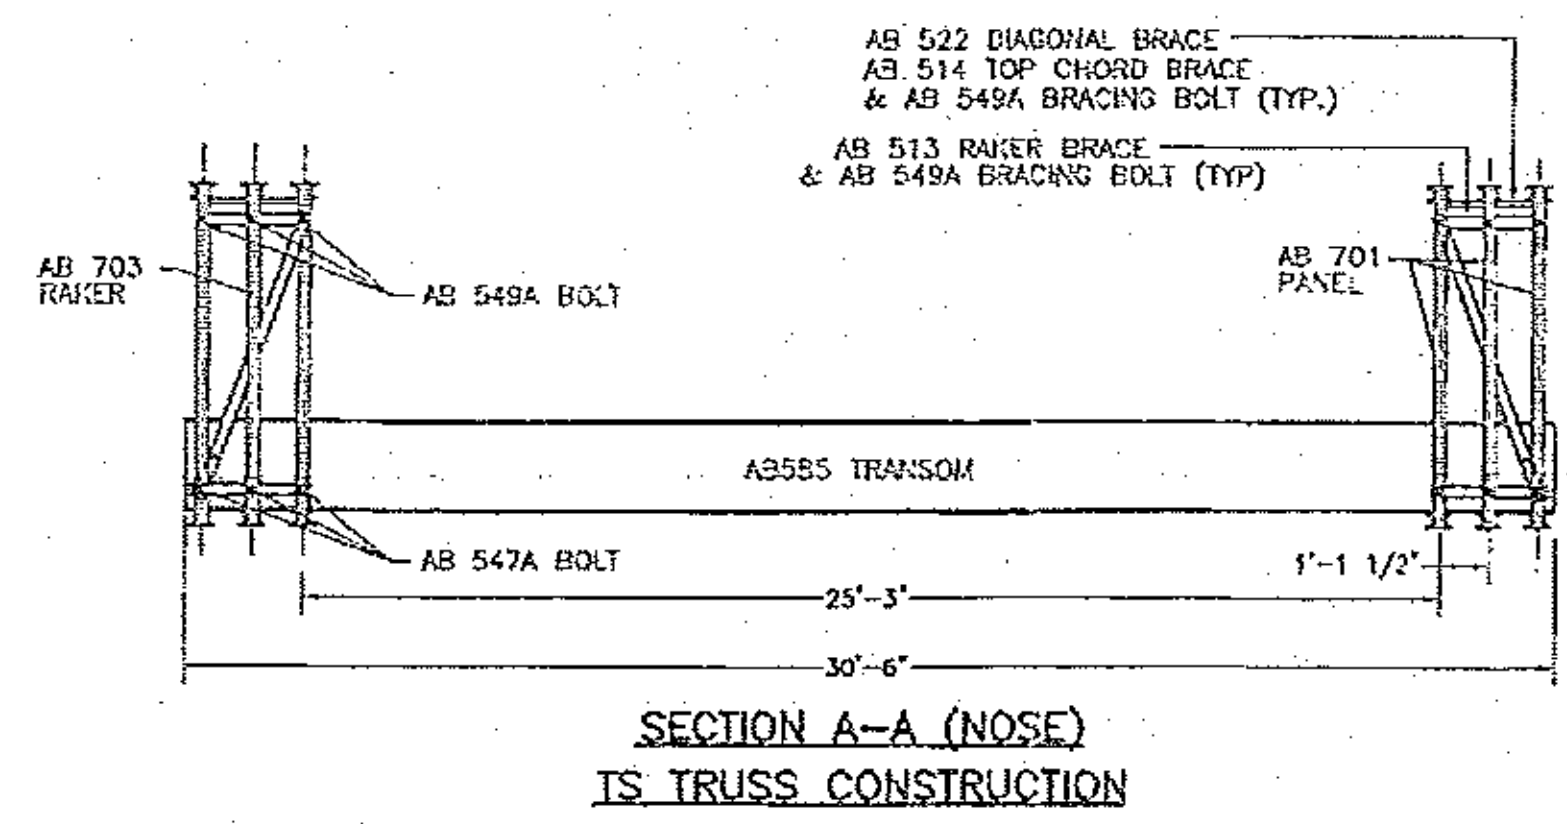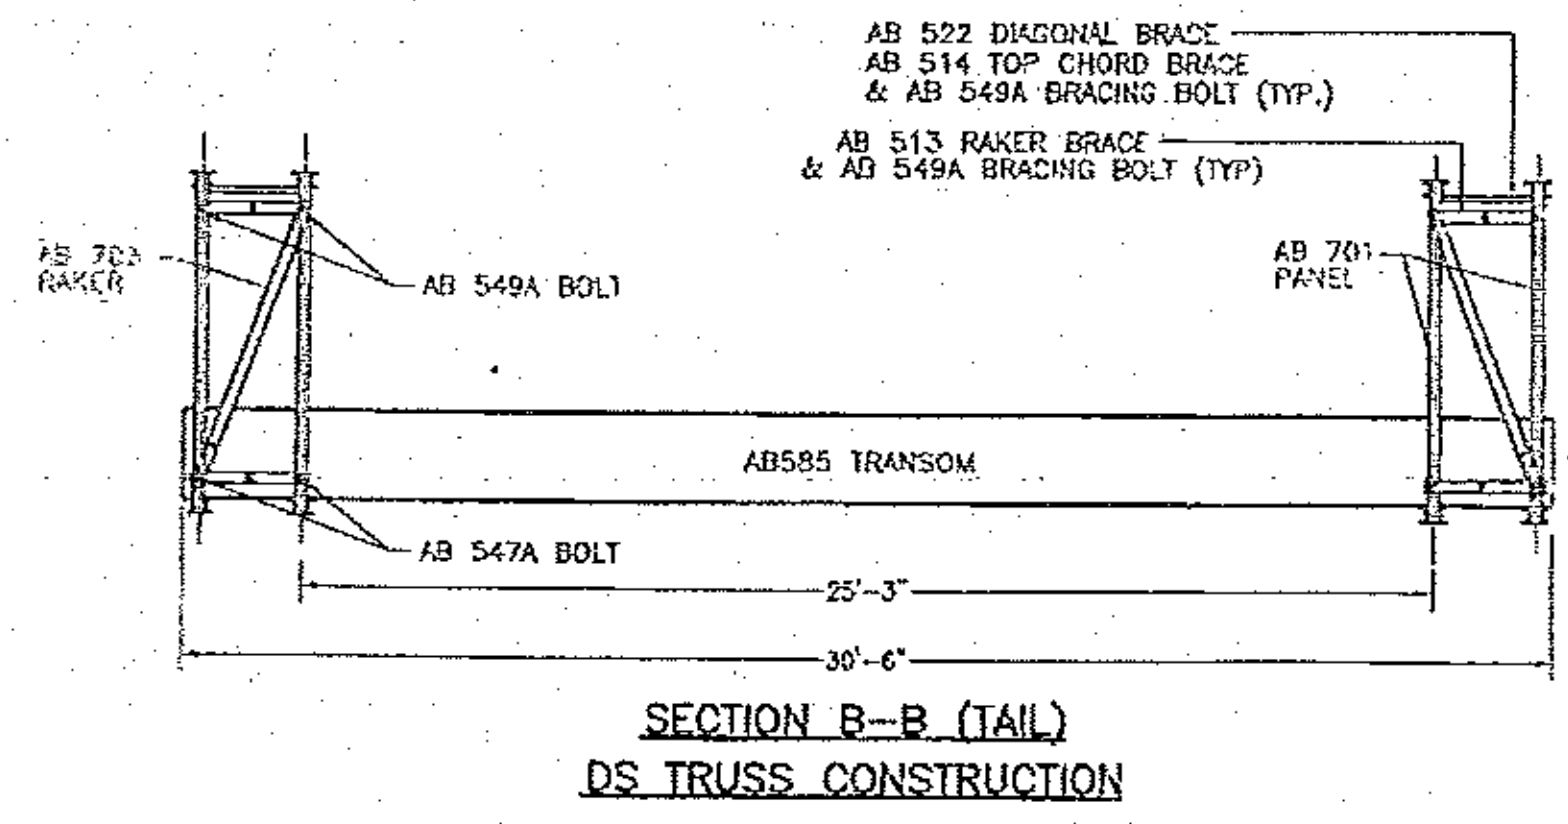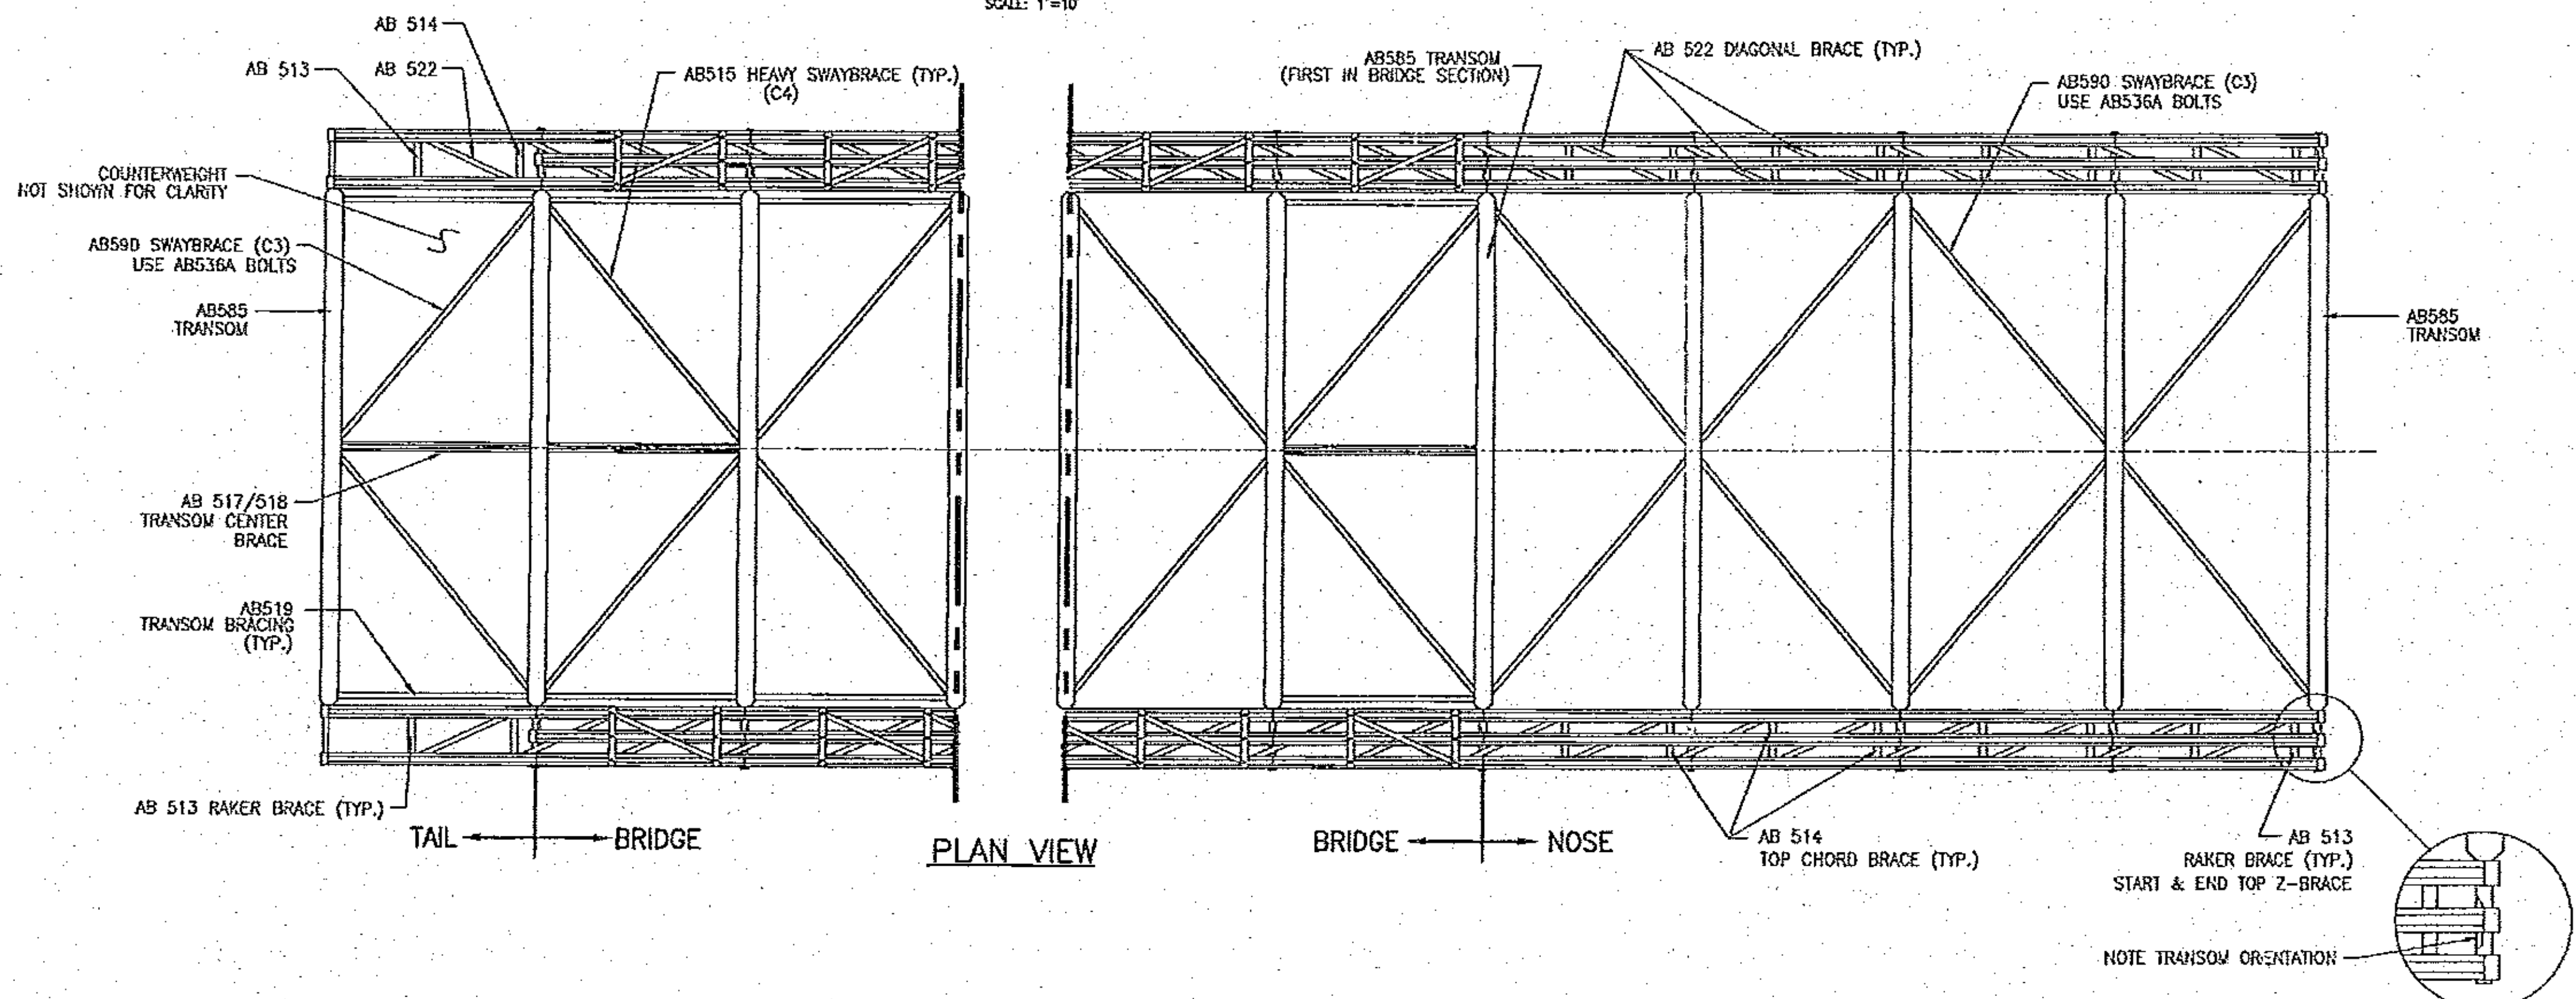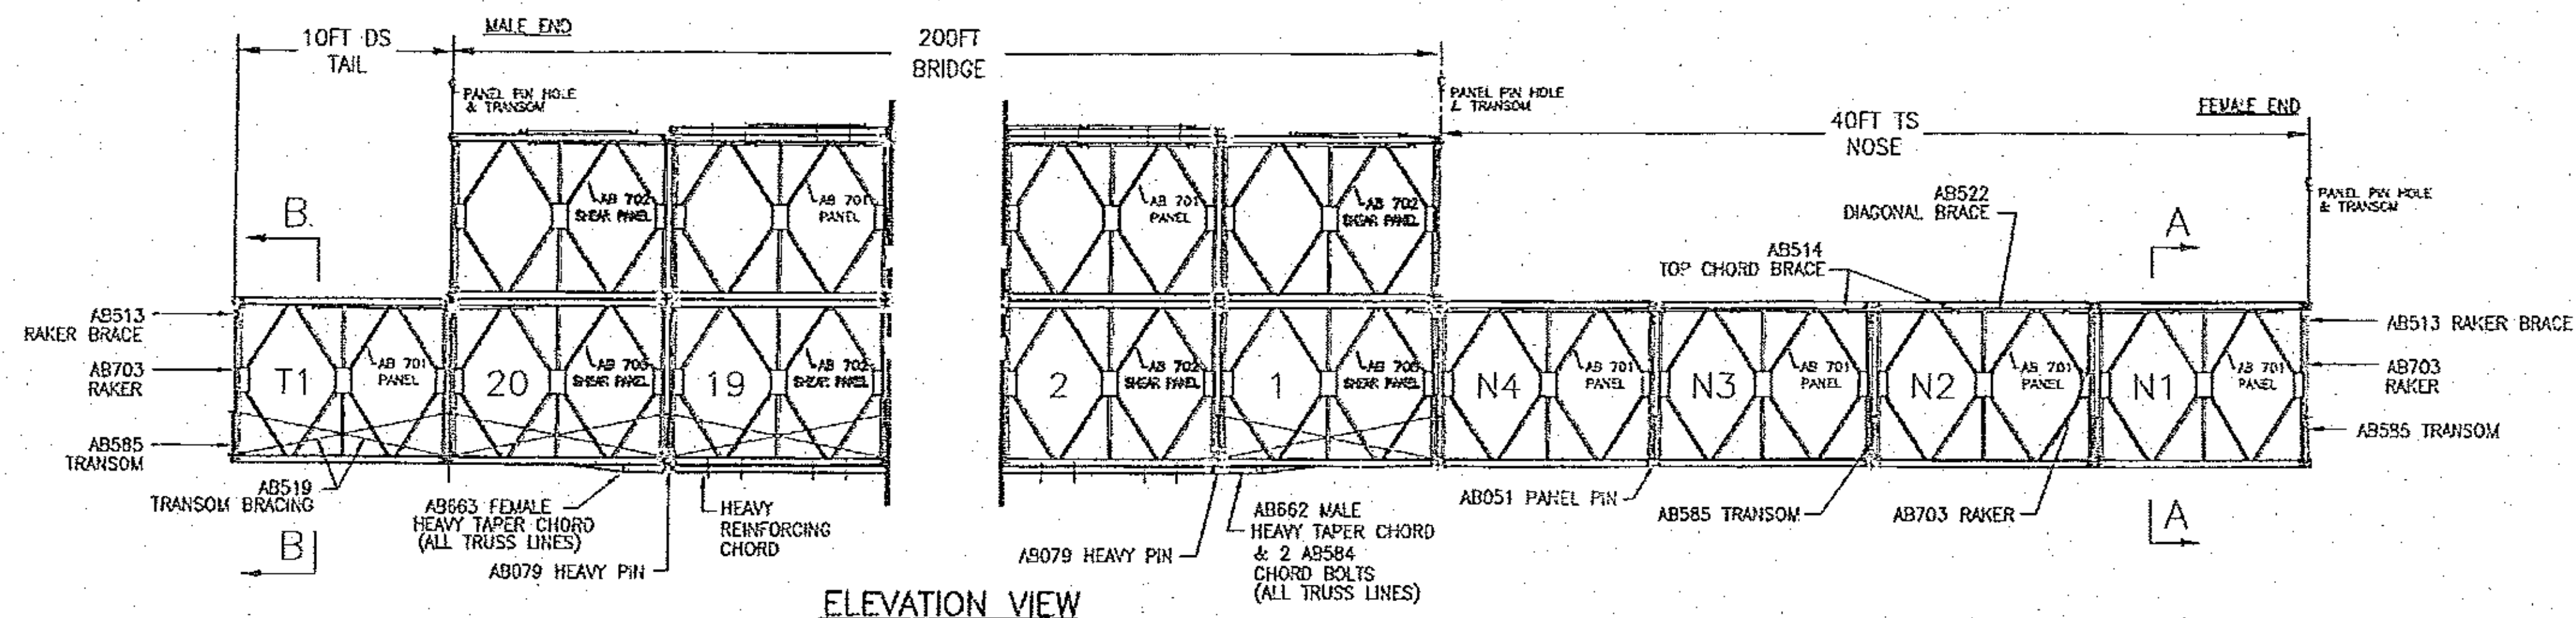


INFORMATION DISCLOSED HEREIN IS THE PROPERTY OF ACROW CORPORATION OF AMERICA. THIS MATERIAL IS PRIVILEGED AND CONFIDENTIAL. IT IS INTENDED SOLELY FOR THE ADDRESSEE. ANY UNAUTHORIZED DISCLOSURE, REPRODUCTION, OR DISTRIBUTION IS PROHIBITED. DUPLICATION OF ANY PORTION OF THIS DATA SHALL INCLUDE THIS LEGEND. COPYRIGHT ACROW CORP 2012

BY	RJ	DATE	NOVEMBER 21, 2012	CONTRACT NO.
CHECKED BY	MP	SCALE	AS SHOWN	
APPROVED BY	SP			
DESCRIPTION	<p><b>ACROW</b> CREATING ENGINEERED SOLUTIONS WORLDWIDE® CORPORATION OF AMERICA 181 NEW ROAD, PARSPIPPANY, NJ 07054</p> <p>ACROW 700XS PANEL BRIDGE DE-LAUNCH NOSE &amp; TAIL 200FT x 2 LANE 24FT TDR3H BRIDGE WOODFORD, VT ER BHF 010-1(44)</p>			
REV. DATE	T. BUCK CONSTRUCTION AUBURN, ME		DRAWING NO. AB1543-DL	REV. SHT 2 OF 4

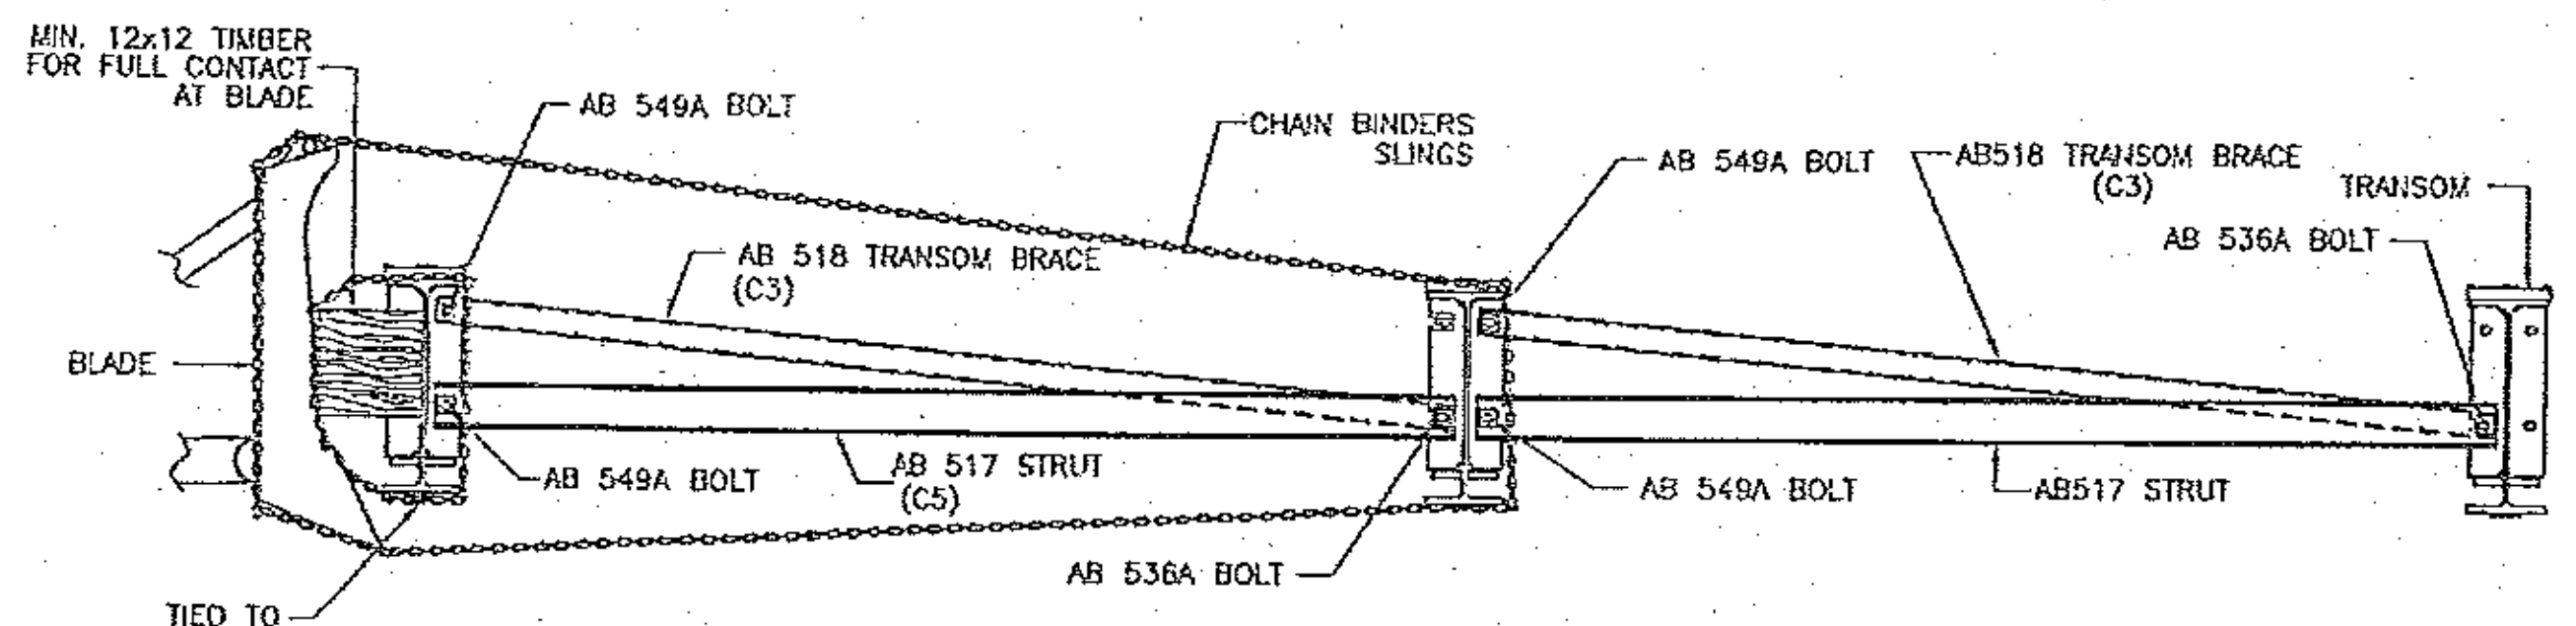


**CENTER OF BRIDGE DETAIL**  
8x8 TIMBER STRUT NOT SHOWN FOR CLARITY


**NOTE:**  
THIS BRACING DETAIL APPLIES TO LAST 2 BAYS FOR EVERY PUSH  
(SWAYBRACING, TIMBER, CENTER & TRANSOM BRACING)

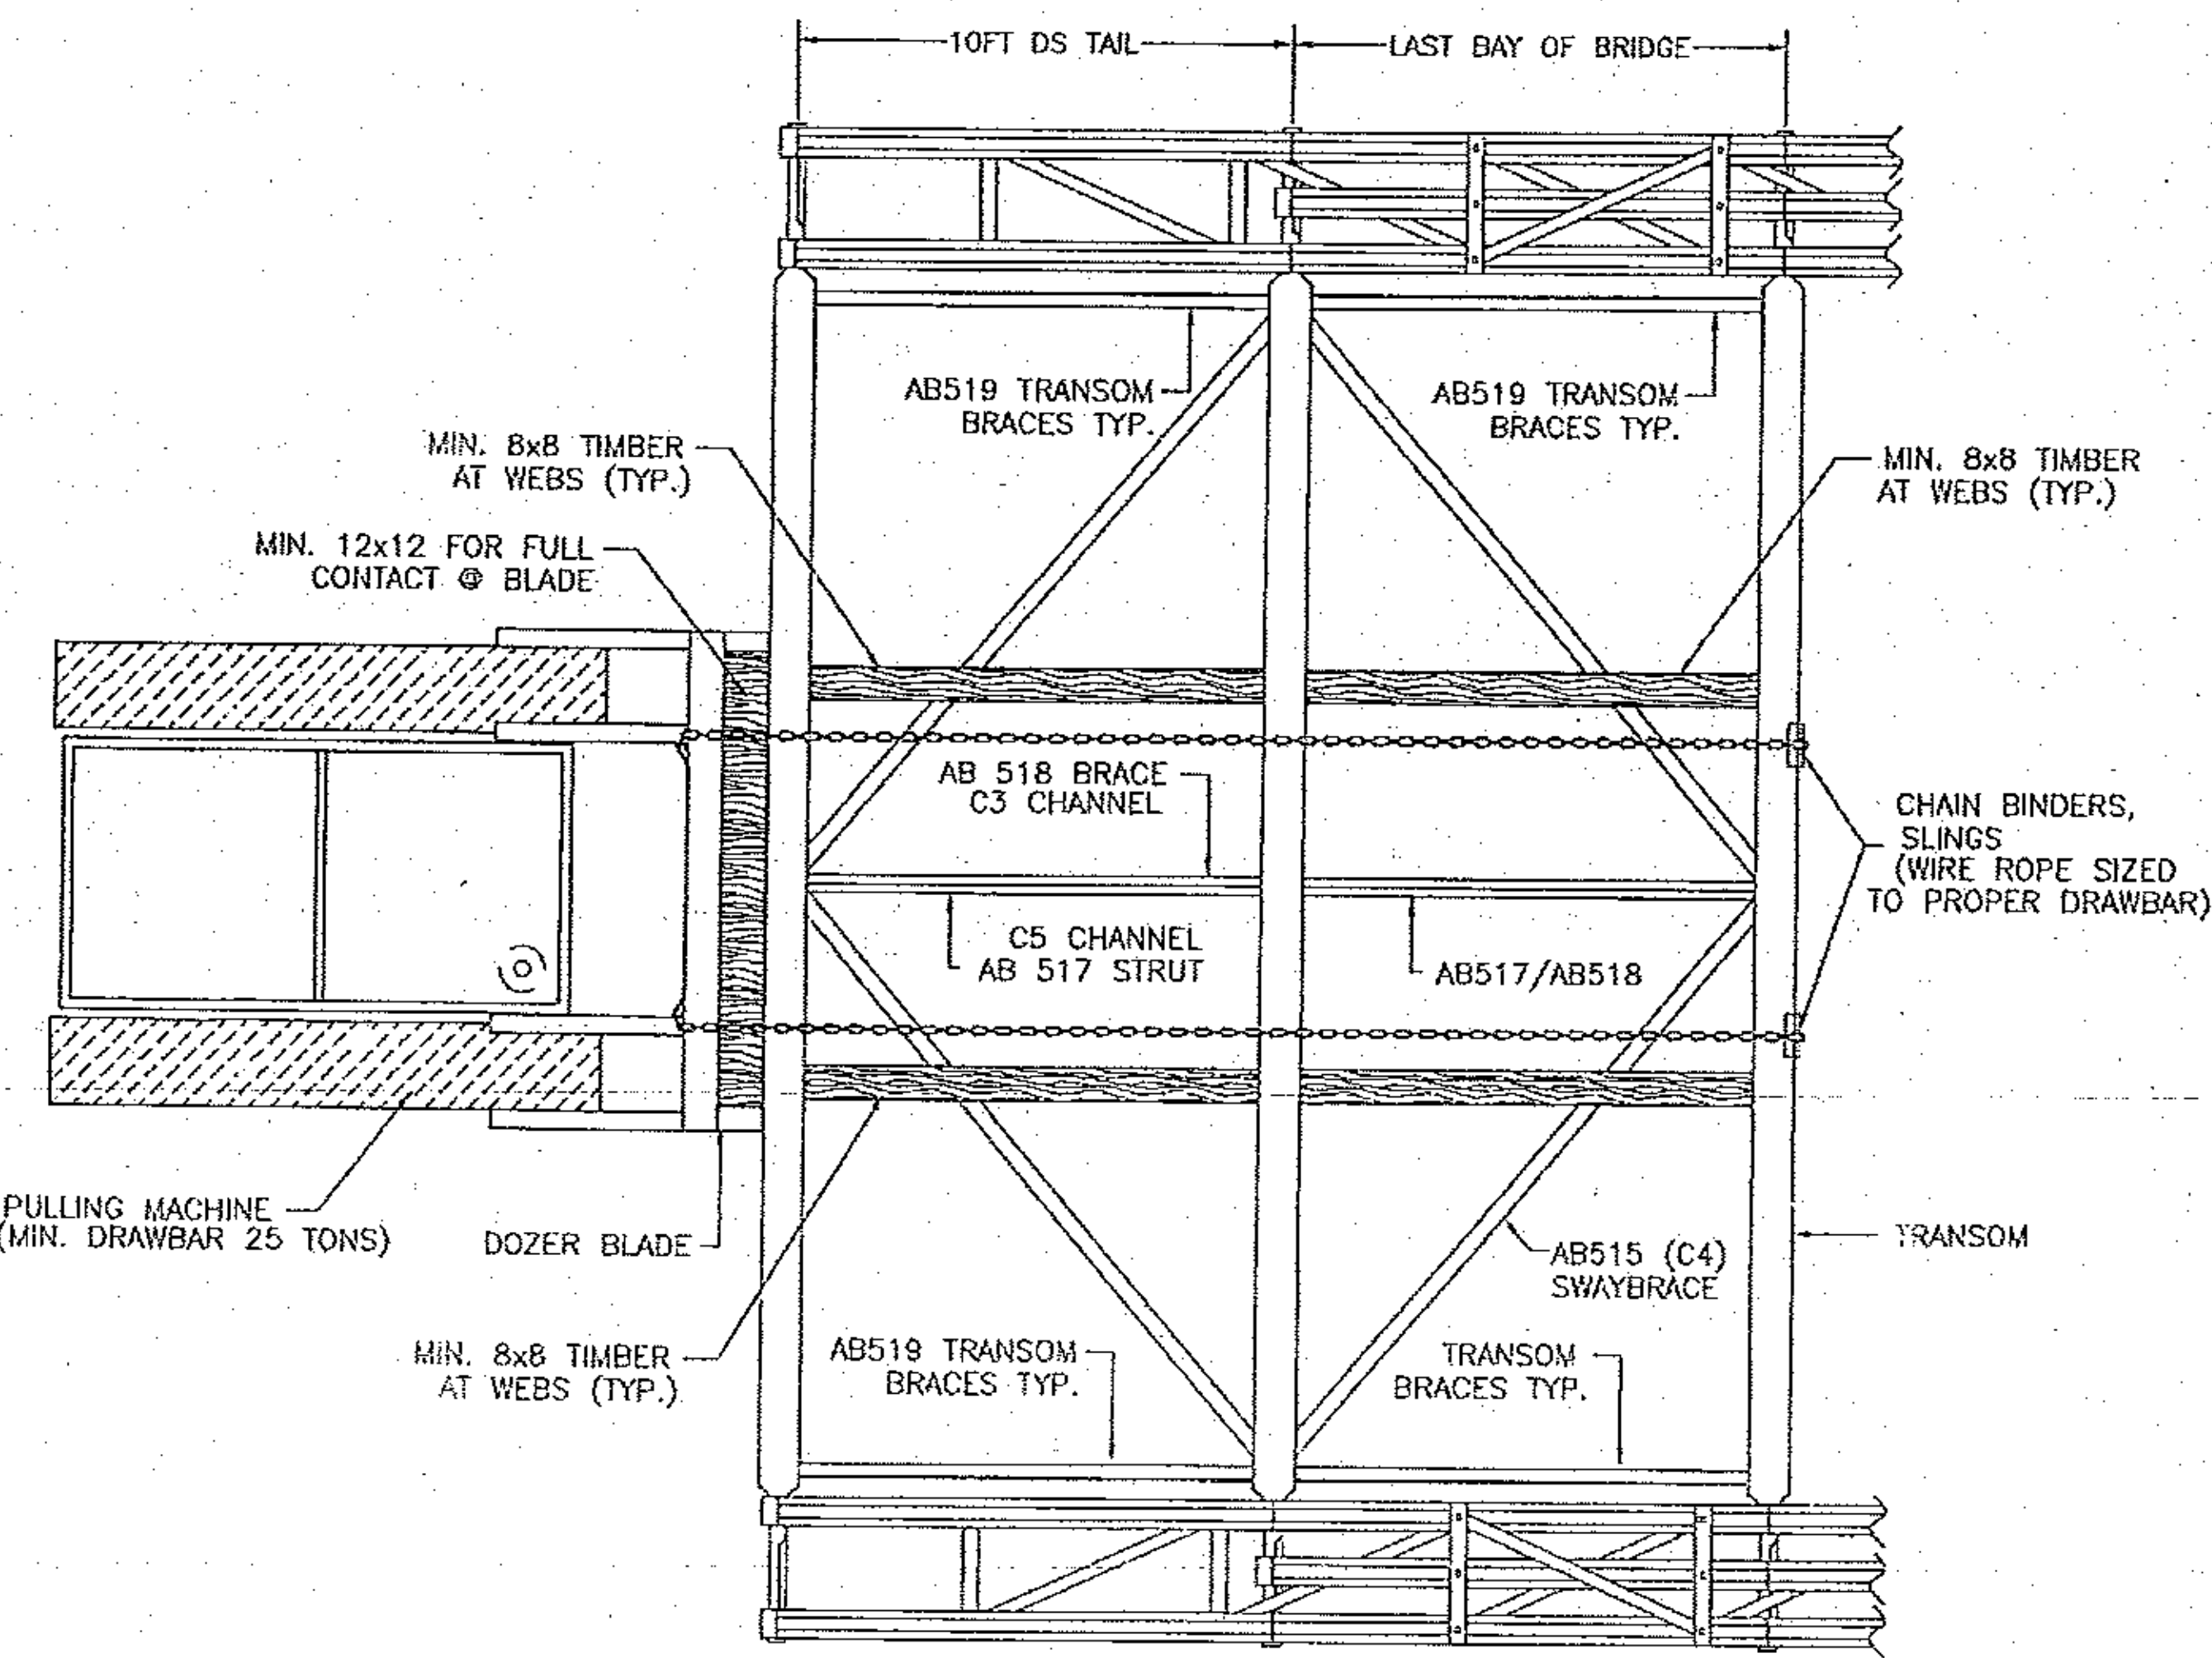


**PLAN**

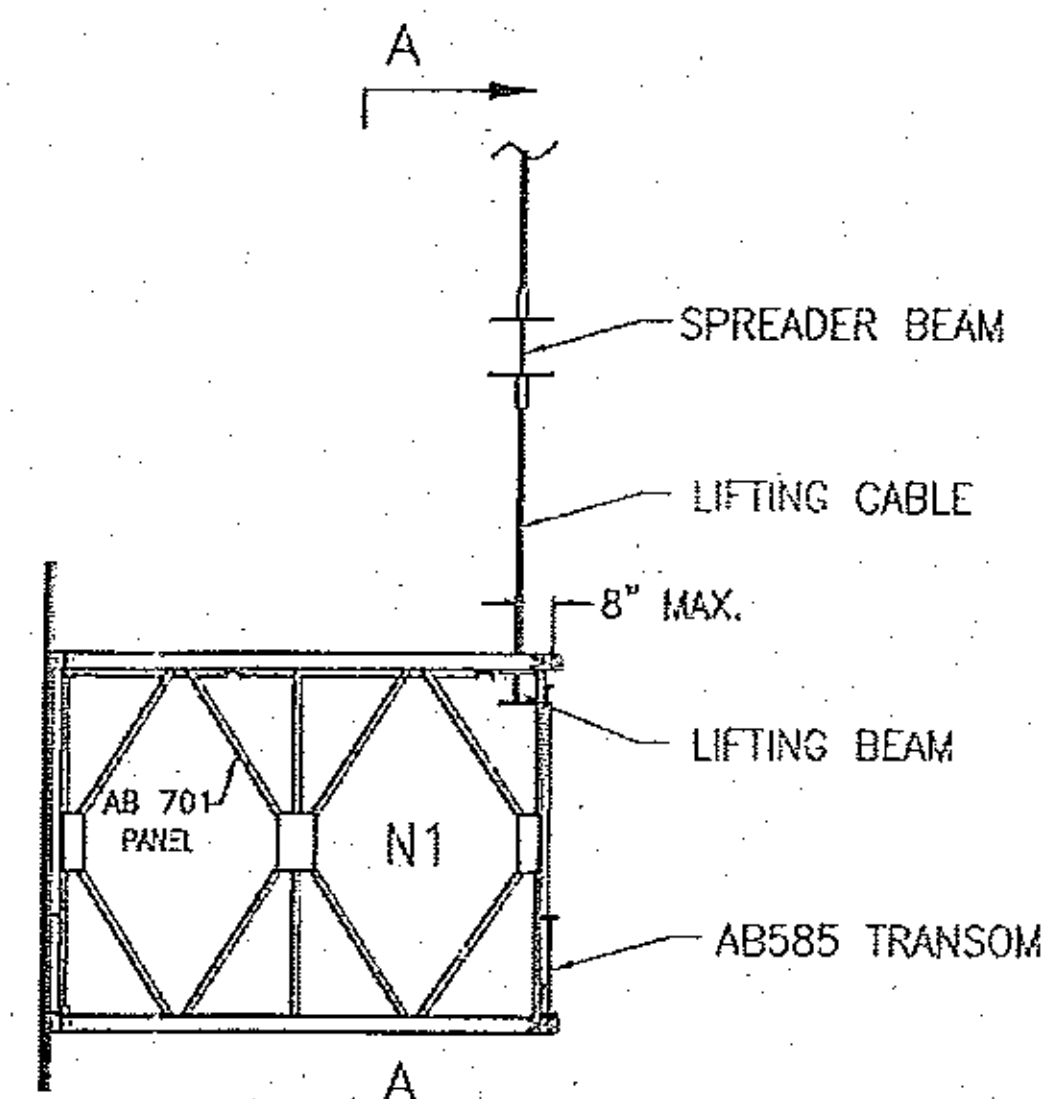

**TS NOSE  
LIFTING DETAIL  
ELEVATION VIEW**

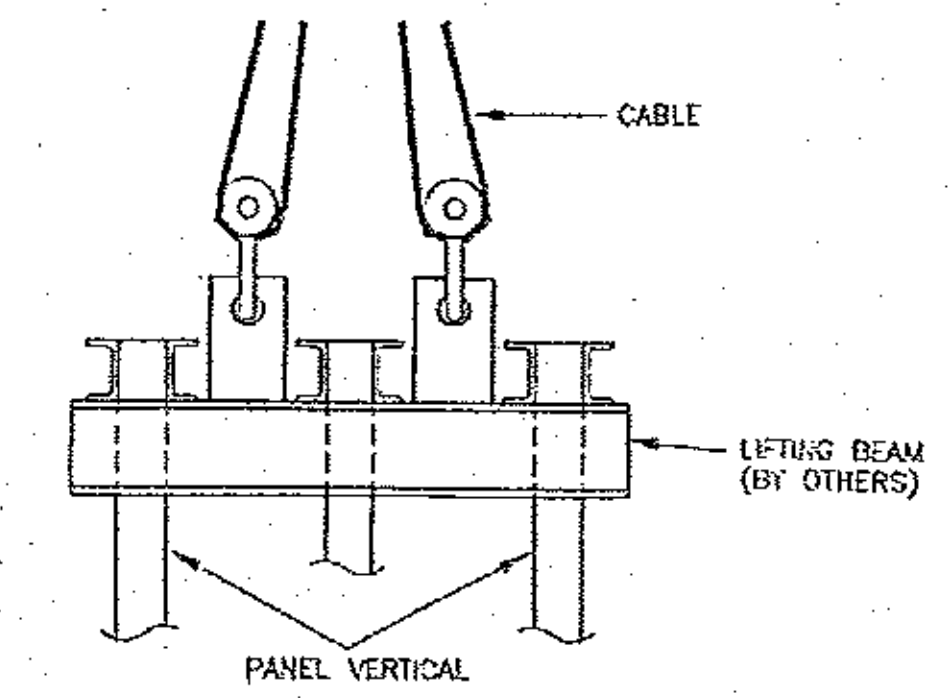

**TYPICAL DETAIL @ TOP CHORD**

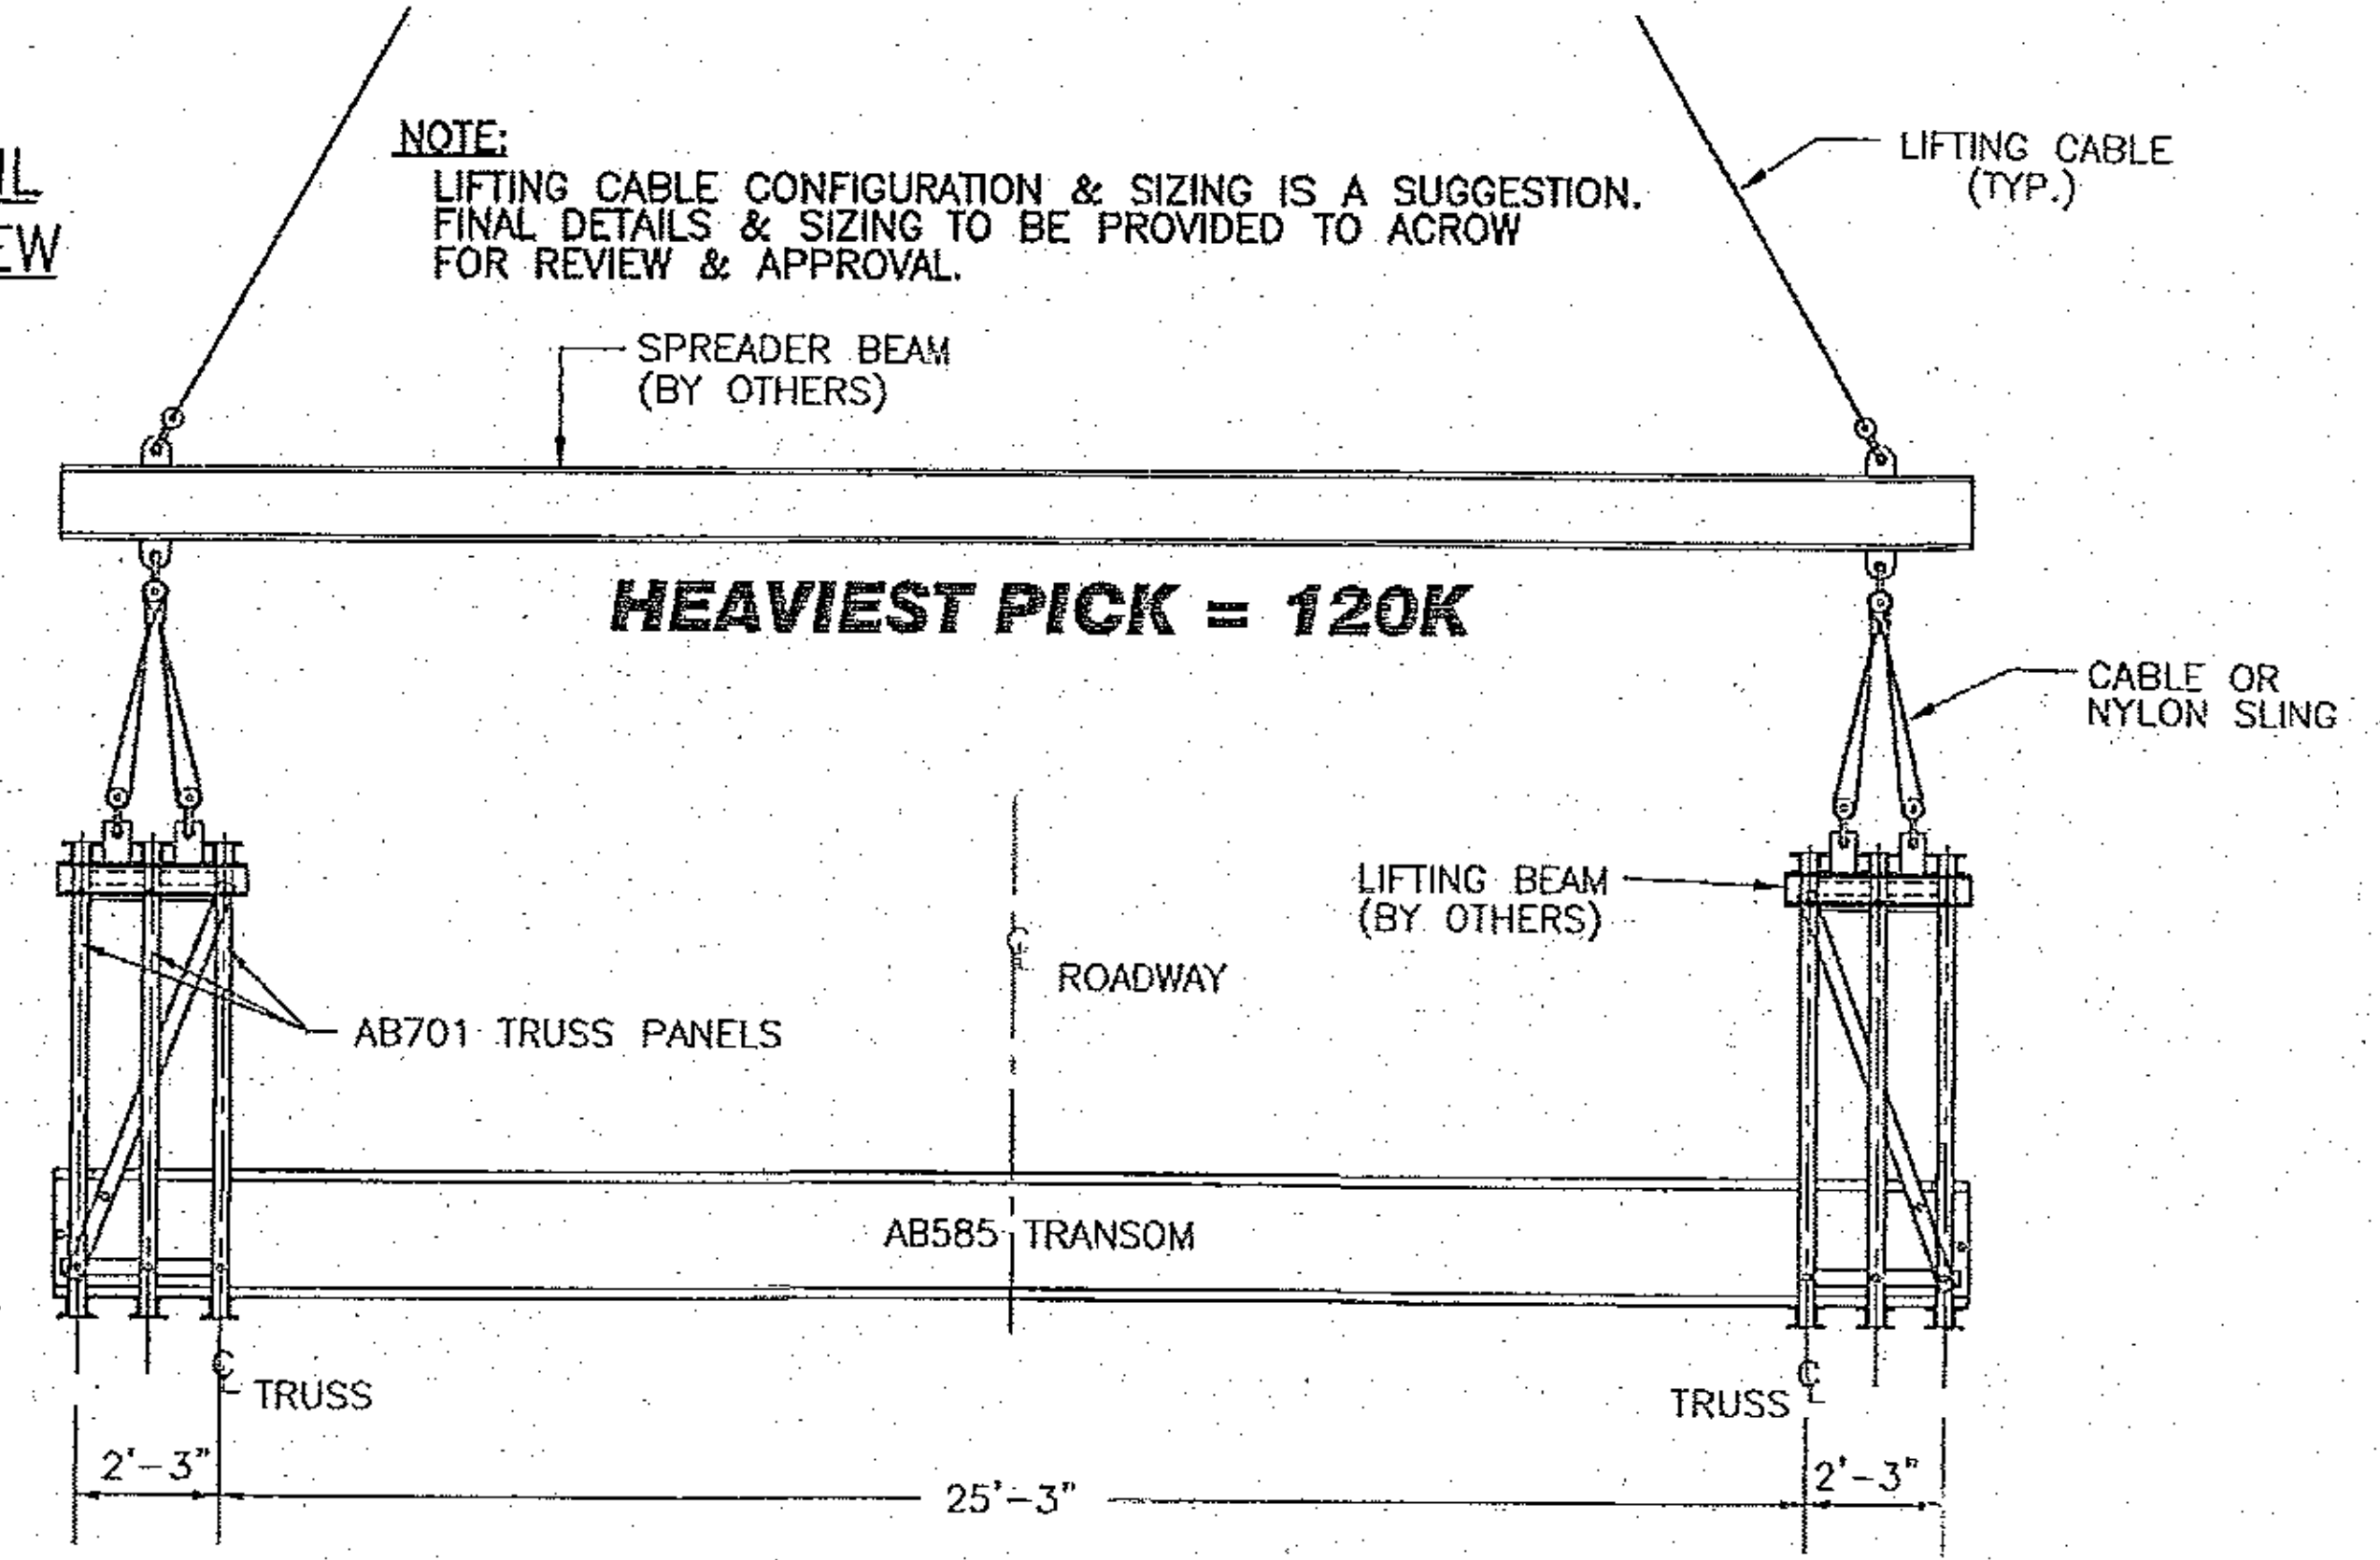


**SECTION A-A  
LIFTING DETAIL**


**NOTES:**  
1. ALL RIGGING PROVIDED & SIZED BY ERECTOR  
2. CRANE SIZING & SET-UP BY OTHERS

INFORMATION DISCLOSED HEREIN IS THE PROPERTY OF ACROW CORPORATION OF AMERICA. THIS MATERIAL IS PRIVILEGED AND CONFIDENTIAL. IT IS INTENDED SOLELY FOR THE ADDRESSEE. ANY UNAUTHORIZED DISCLOSURE, REPRODUCTION, OR DISTRIBUTION IS PROHIBITED. DUPLICATION OF ANY PORTION OF THIS DATA SHALL INCLUDE THIS LEGEND. 00P-100-1 ACROW CORP 2012


				CREATING ENGINEERED SOLUTIONS WORLDWIDE®	
				CORPORATION OF AMERICA 181 NEW ROAD, PARSIPPANY, NJ 07054	
<b>ACROW 700XS PANEL BRIDGE PULLING-BLOCKING/ RIGGING DETAIL 200FT x 2 LANE 24FT TOR3H BRIDGE WOODFORD, VT ER BHF 010-1(44)</b>					
BY	APPR.	DRAWN BY	RJ	DATE	NOVEMBER 21, 2012
DESCRIPTION		CHECKED BY	MP	SCALE:	AS SHOWN
REV. DATE		APPROVED BY	SP		
				CONTRACT NO.	
				DRAWING NO.	
				AB1543-DL	
				REV.	
				SHT 3 OF 4	
<b>T. BUCK CONSTRUCTION AUBURN, ME</b>					

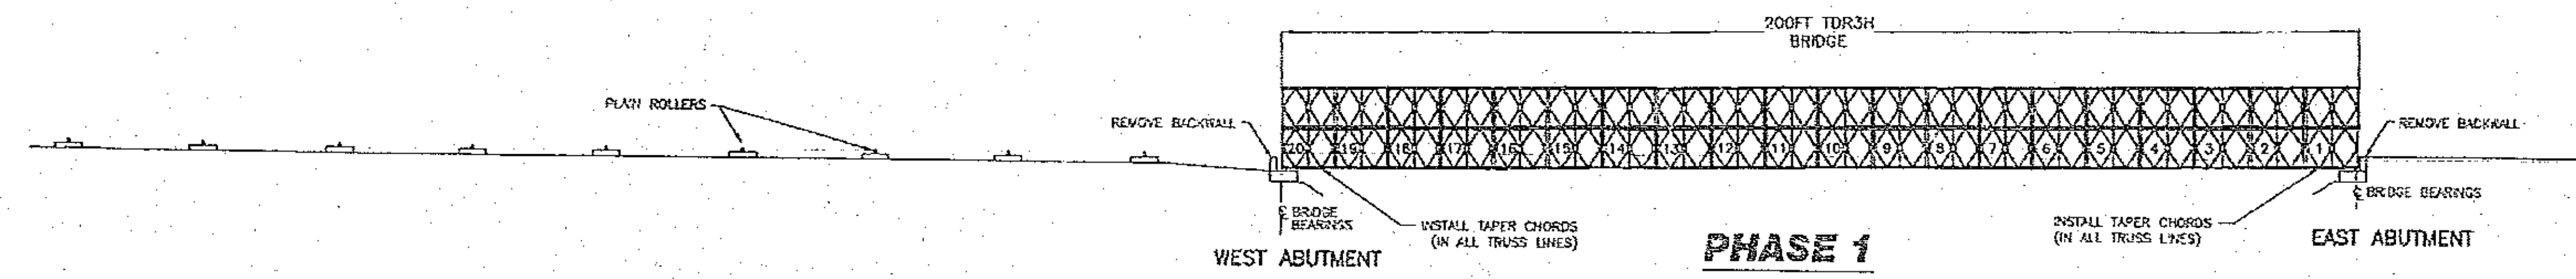


- PHASE 1**
- REMOVE ALL DECK PANELS & GUARDRAIL
  - INSTALL TAPER CHORDS
  - REMOVE THE BACKWALLS AND GRADE BUILD AREA BEHIND THE WEST ABUTMENT AND INSTALL PLAIN ROLLERS AS SHOWN IN THE DE-LAUNCH ROLLER LAYOUT

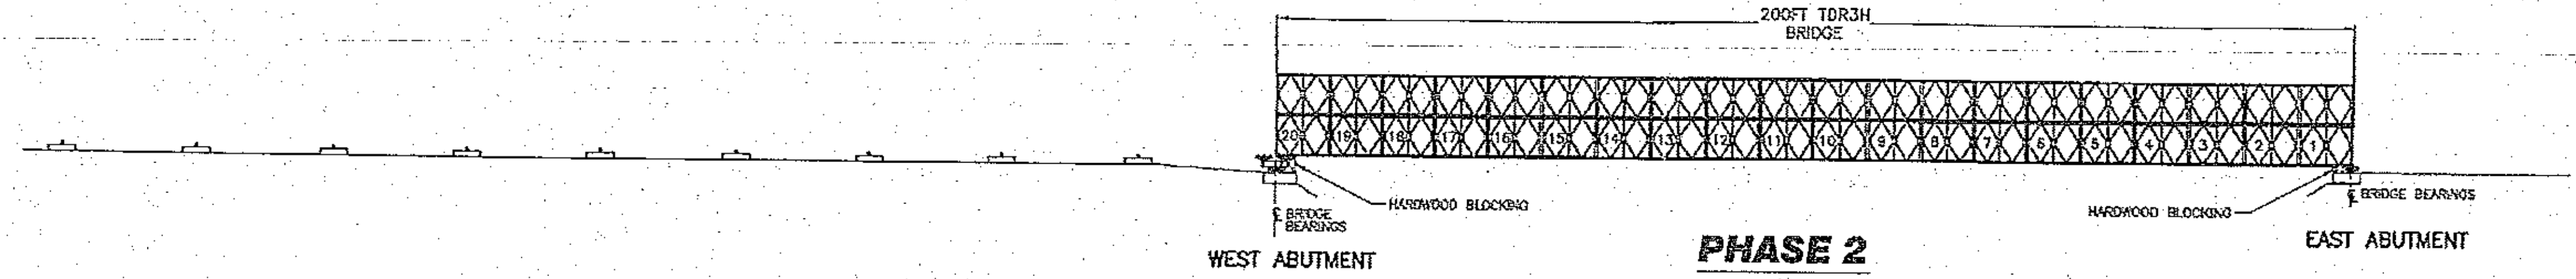


- PHASE 2**
- JACK UP BRIDGE AT EACH ABUTMENT HIGH ENOUGH TO INSTALL ROCKING ROLLERS
  - LOWER BRIDGE ONTO TEMPORARY BLOCKING

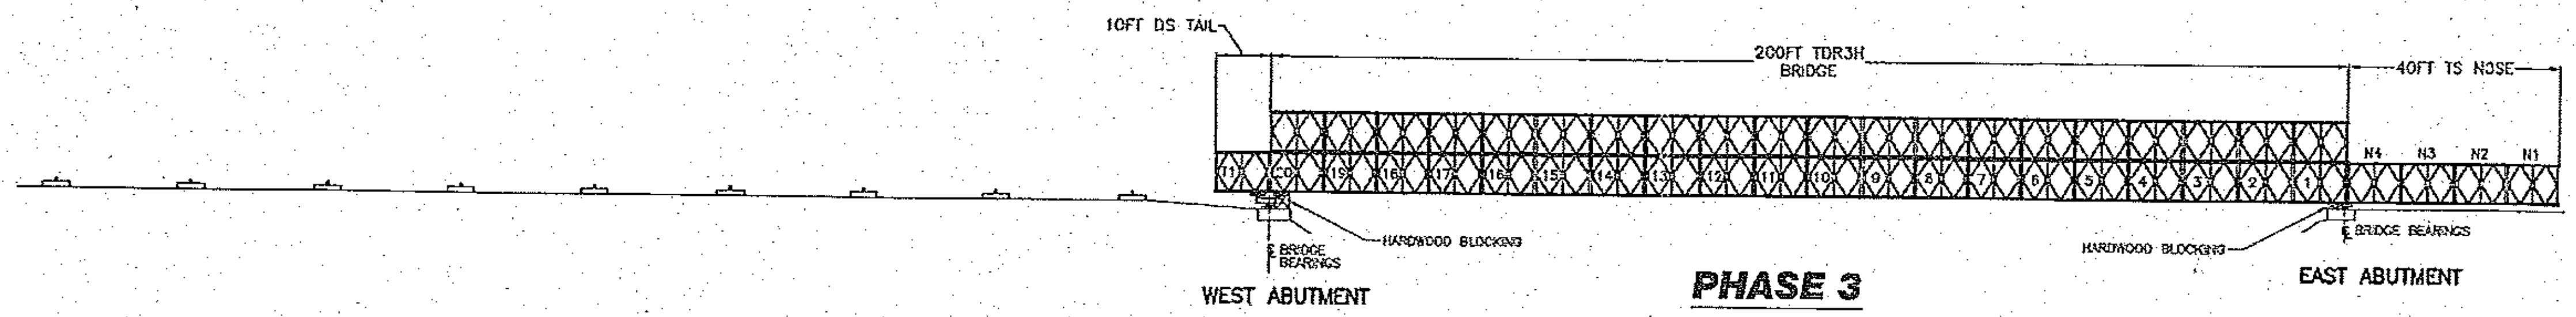


- PHASE 3**
- BUILD 40FT OF TS NOSE & 10FT OF DS TAIL

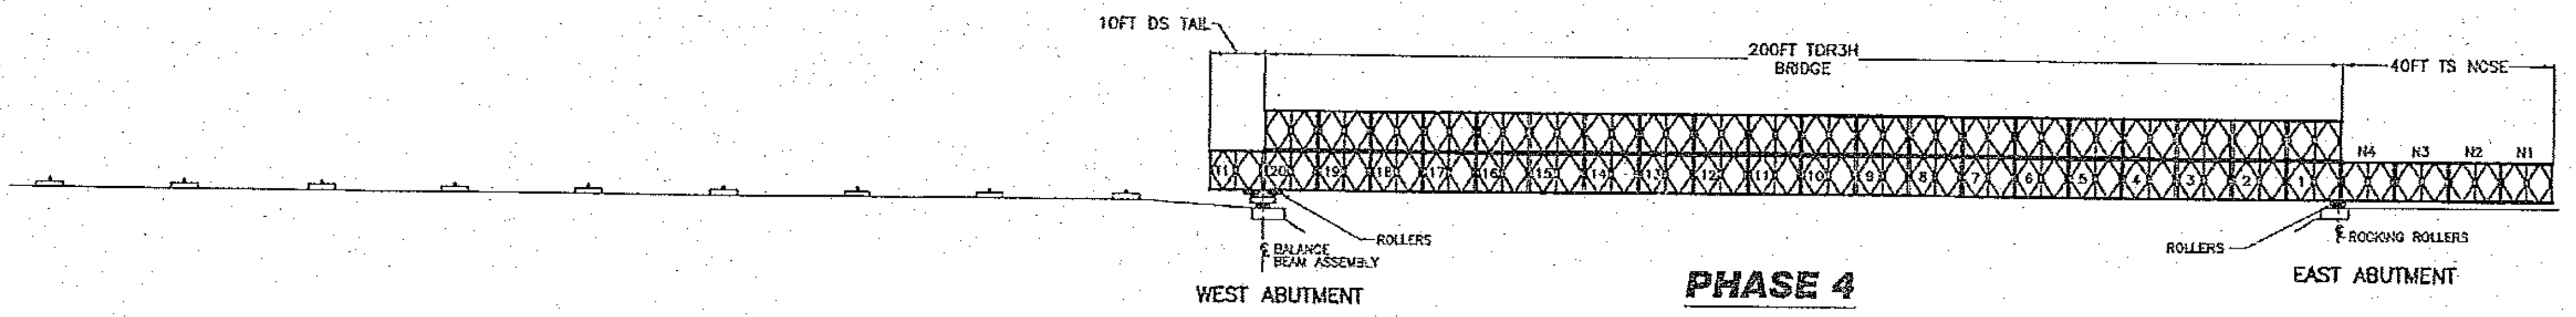


- PHASE 4**
- LOWER BRIDGE ONTO ROLLERS AT EACH ABUTMENT

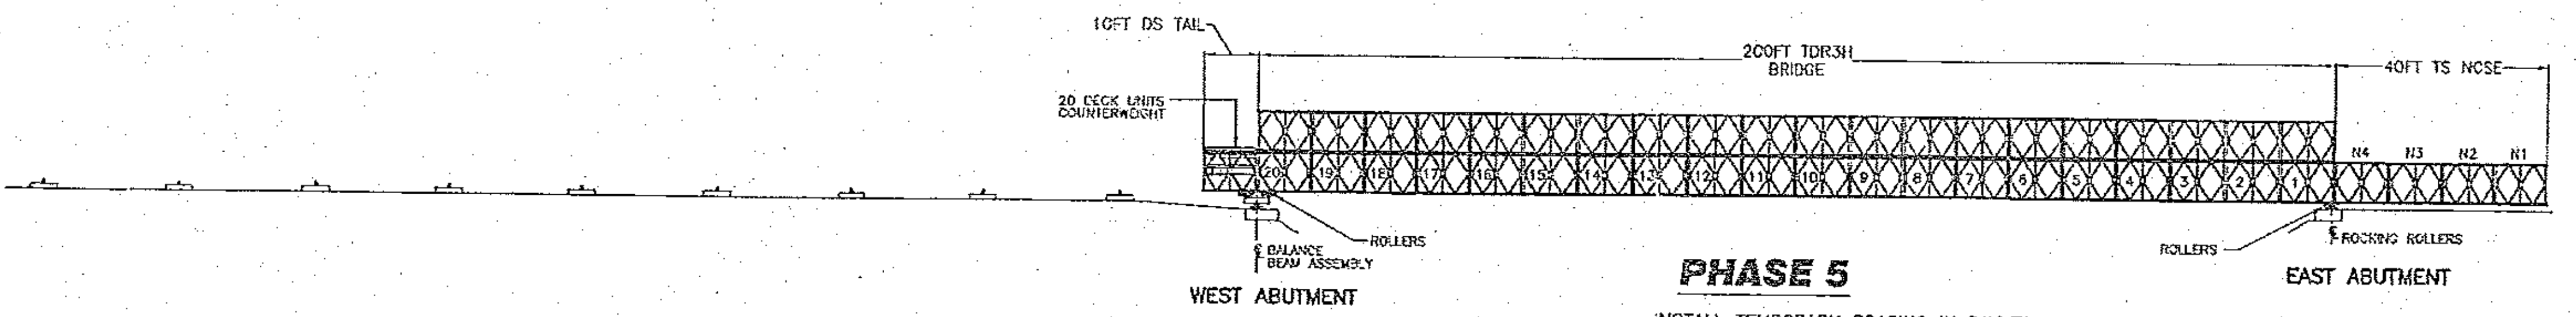

- PHASE 5**
- INSTALL TEMPORARY BRACING IN BAY T1 & 20 AS SHOWN IN THE PULLBACK/ BLOCKING DETAIL
  - ADD 20 DECKS COUNTERWEIGHT TO THE TAIL BAY

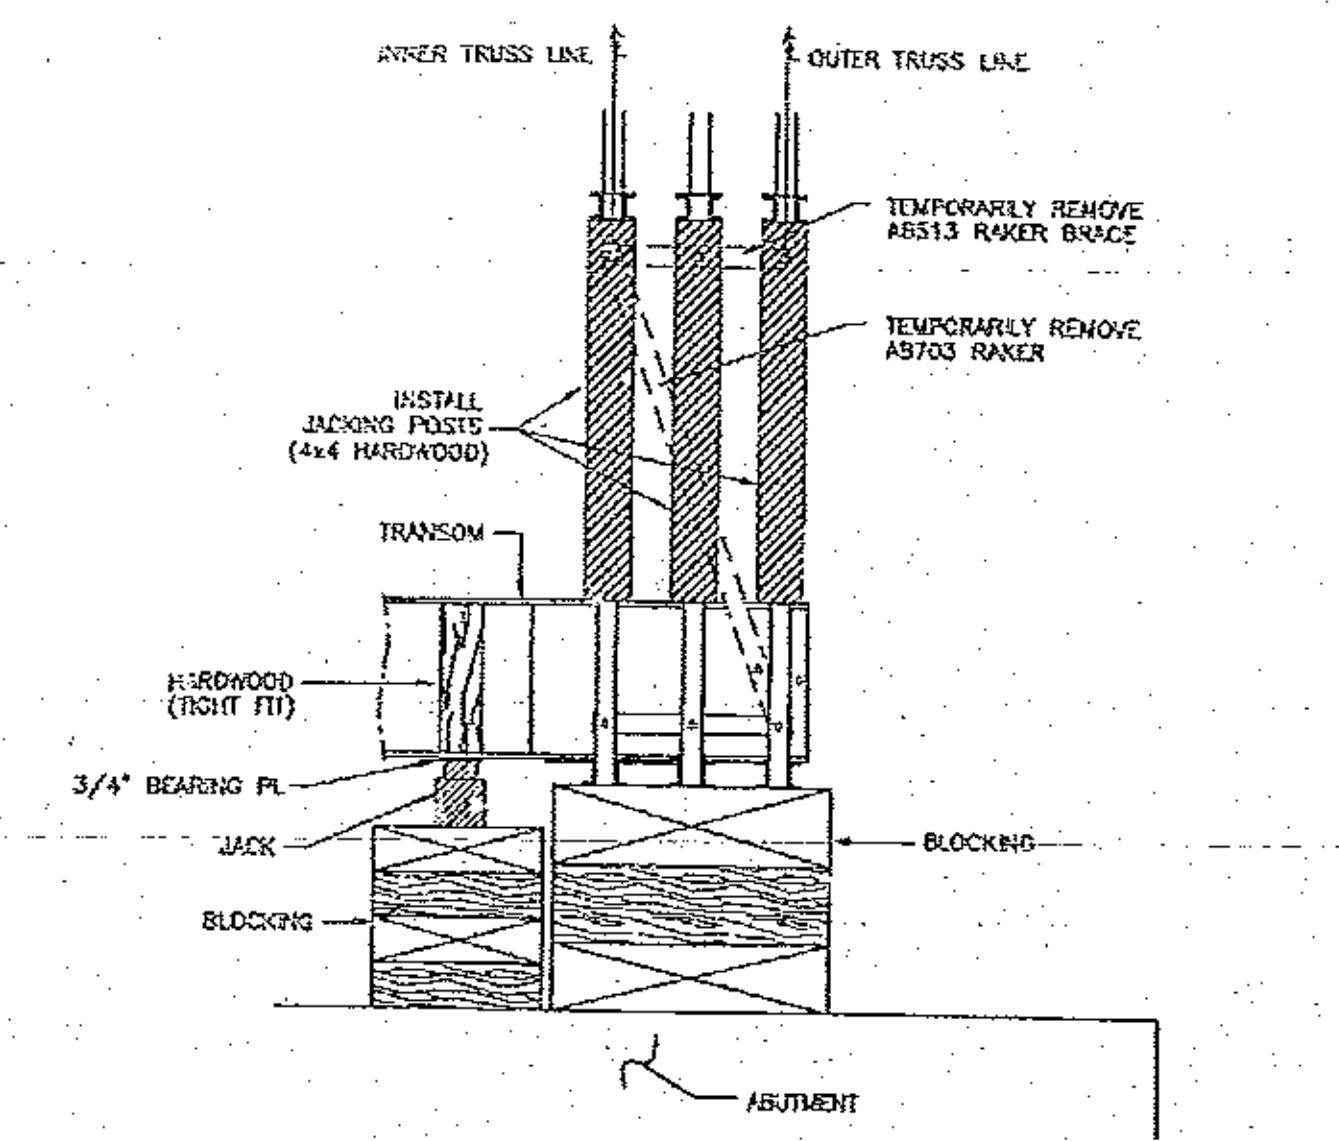


TYPICAL JACKING DETAIL

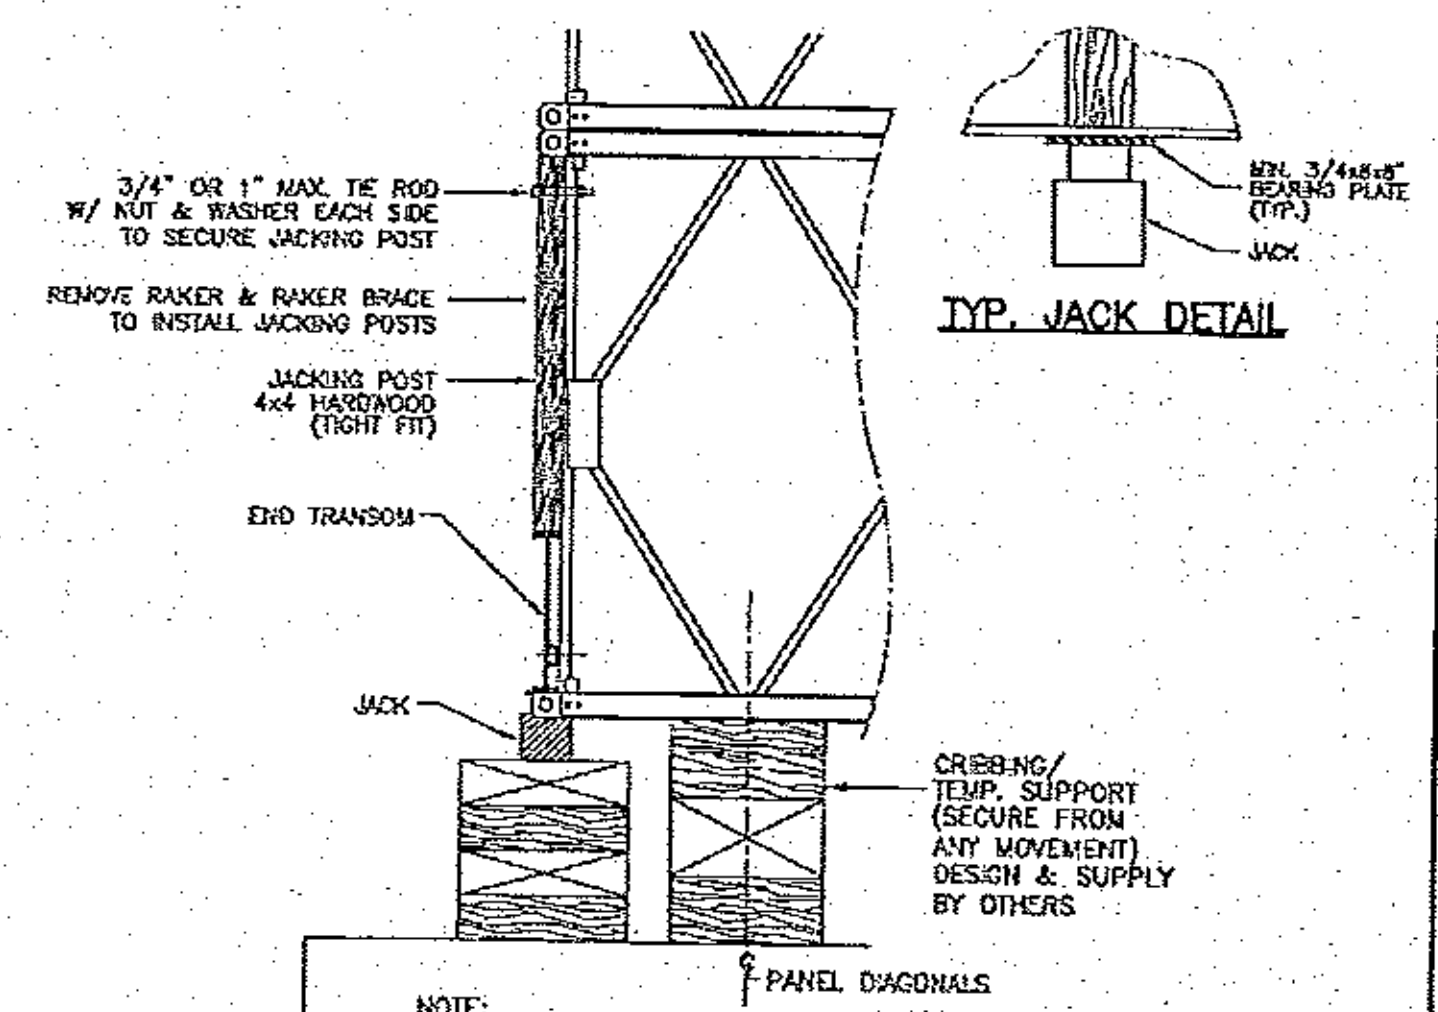

TYPICAL BLOCKING DETAIL ELEVATION VIEW


INFORMATION DISCLOSED HEREIN IS THE PROPERTY OF ACROW CORPORATION OF AMERICA. THIS MATERIAL IS PRIVILEGED AND CONFIDENTIAL. IT IS INTENDED SOLELY FOR THE ADDRESSEE. ANY UNAUTHORIZED DISCLOSURE, REPRODUCTION, OR DISTRIBUTION IS PROHIBITED. DUPLICATION OF ANY PORTION OF THIS DATA SHALL INCLUDE THIS LEGEND. COPYRIGHT ACROW 03/2012

APPR.		<p><b>ACROW</b> CREATING ENGINEERED SOLUTIONS WORLDWIDE®</p> <p>CORPORATION OF AMERICA 181 NEW ROAD, PARSIPPANY, NJ 07054</p>	<p>ACROW 700XS PANEL BRIDGE DE-LAUNCHING SEQUENCE 200FT x 2 LANE 24FT TDR3H BRIDGE WOODFORD, VT ER BHF 010-1(44)</p>
BY			
DESCRIPTION		<p>DRAWN BY: RJ</p> <p>CHECKED BY: MP</p> <p>APPROVED BY: SP</p>	<p>DATE: NOVEMBER 21, 2012</p> <p>SCALE: AS SHOWN</p> <p>CONTRACT NO.</p>
REV. DATE		<p>T. BUCK CONSTRUCTION AUBURN, ME</p>	<p>DRAWING NO. AB1543-DL SHT 4A OF 4</p> <p>REV.</p>

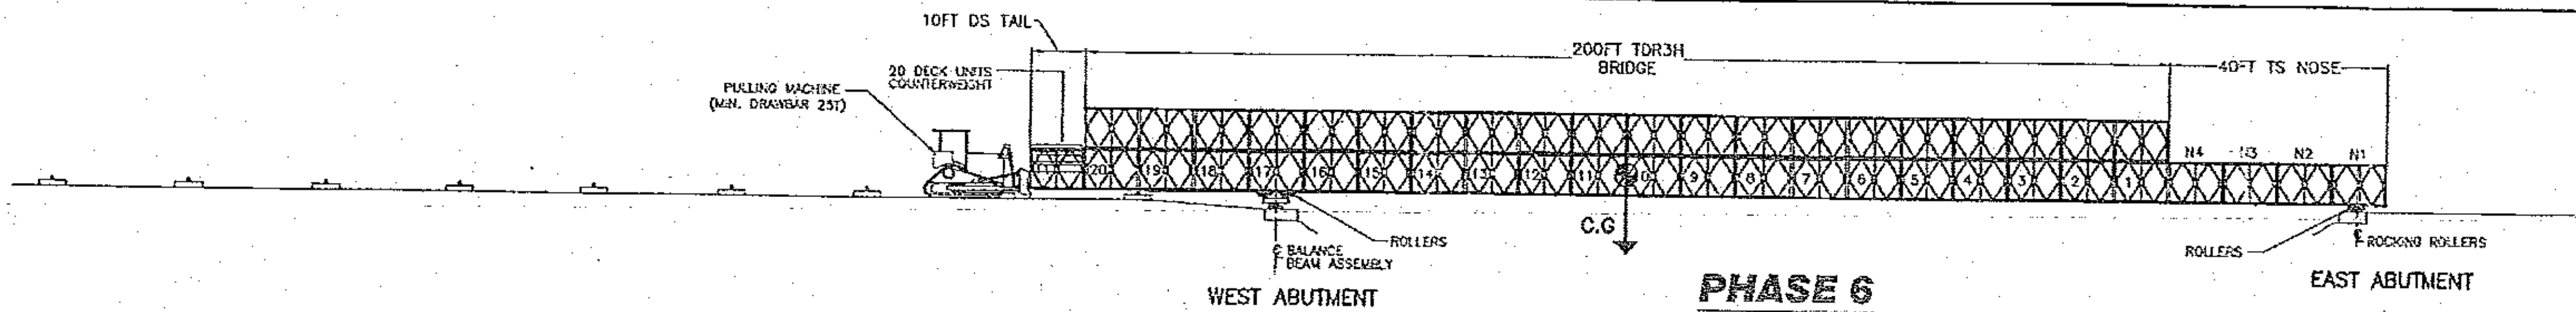


**PHASE 6**

- ATTACH PUSHING MACHINE
- PULL BACK BRIDGE 35FT

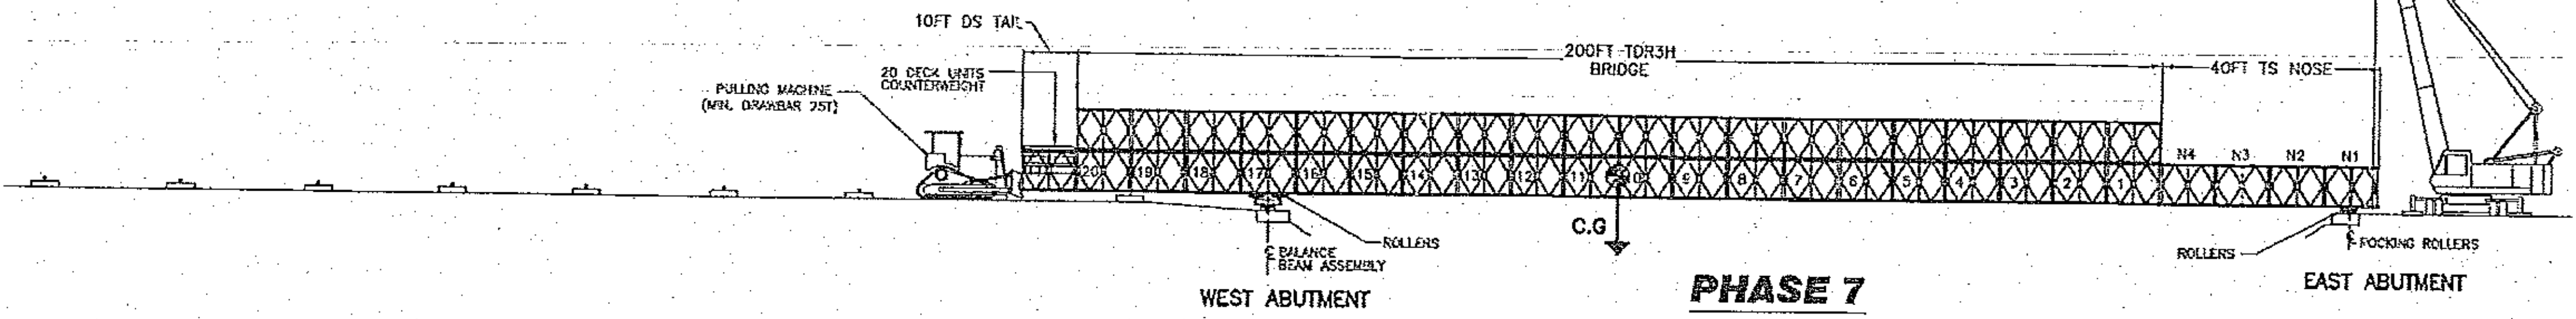


**PHASE 7**

- ATTACH CRANE TO THE NOSE OF THE BRIDGE

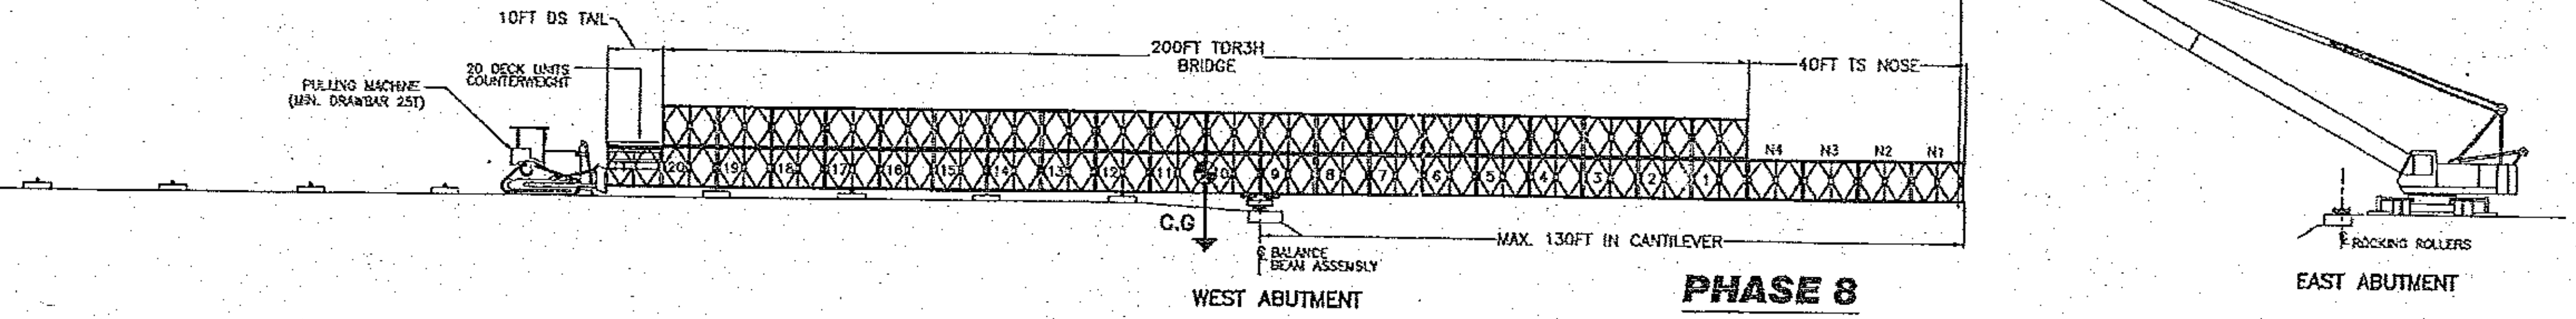


**PHASE 8**

- PULL BACK BRIDGE 75FT (130FT IN CANTILEVER MAX.)

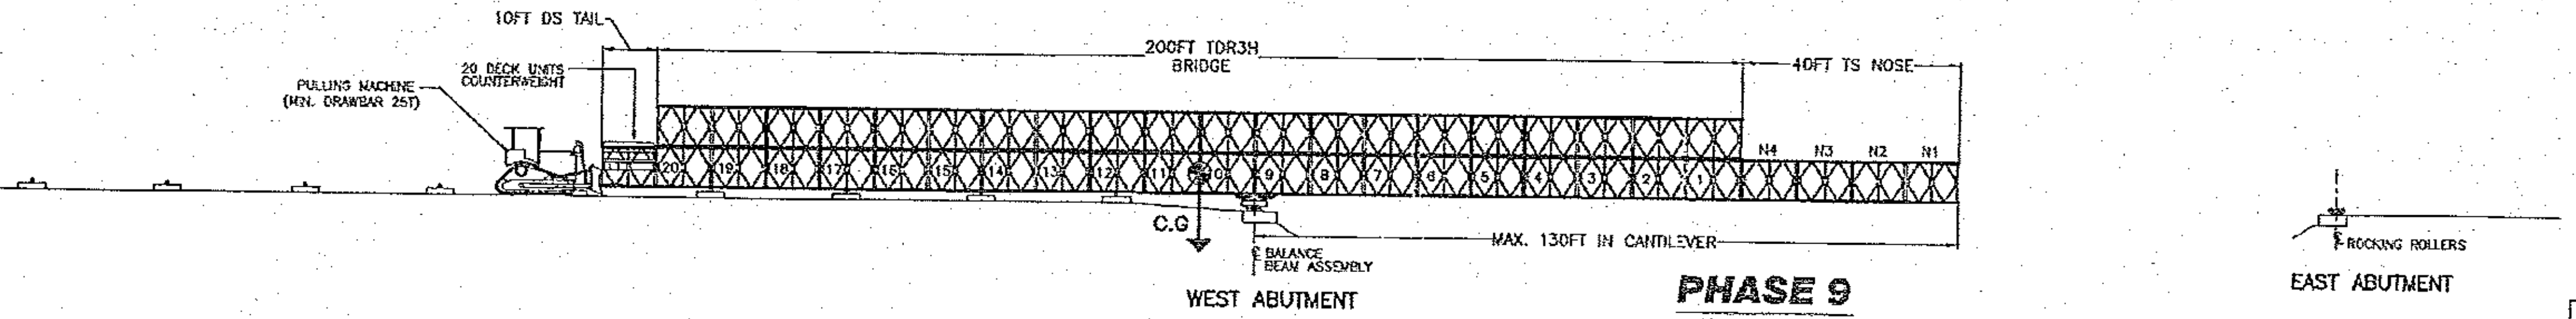

**PHASE 9**

- DETACH CRANE


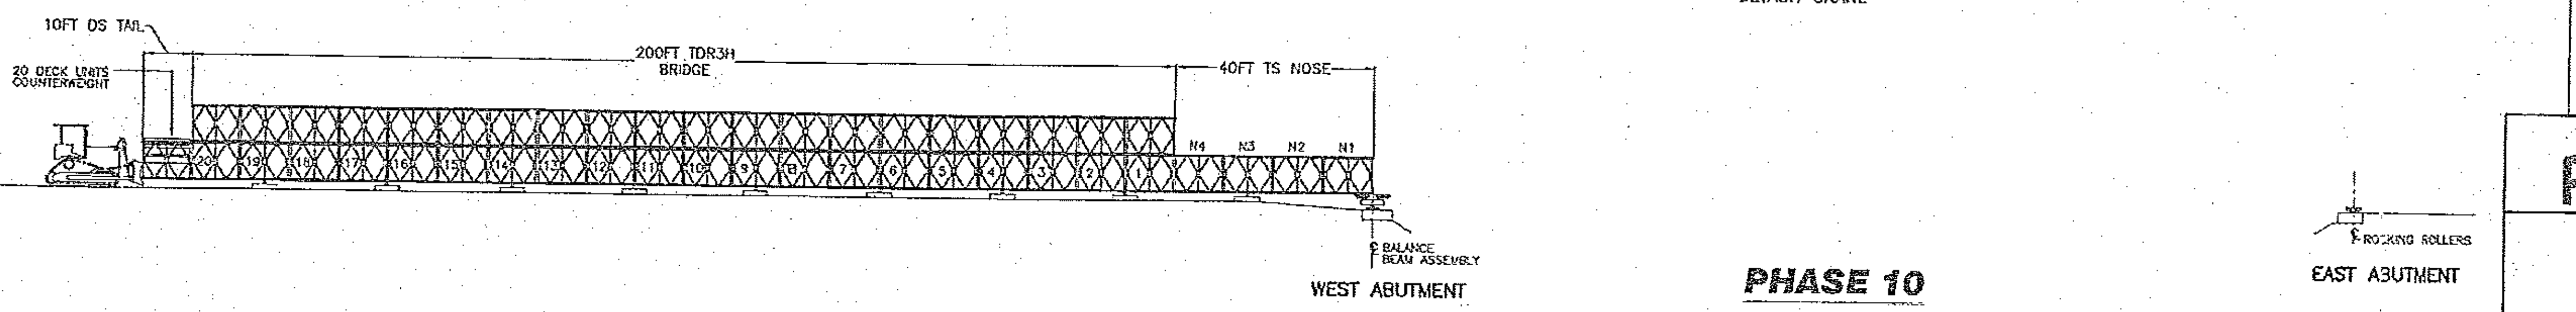


**PHASE 10**

- PULL BACK BRIDGE 130FT

**PHASE 11**

- REMOVE ALL COUNTERWEIGHT
- DISMANTLE TAIL, BRIDGE AND NOSE

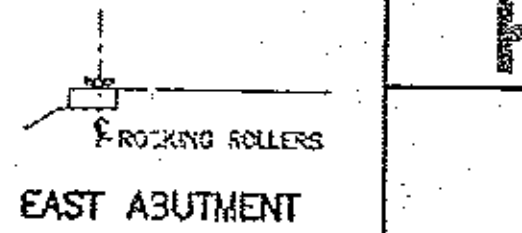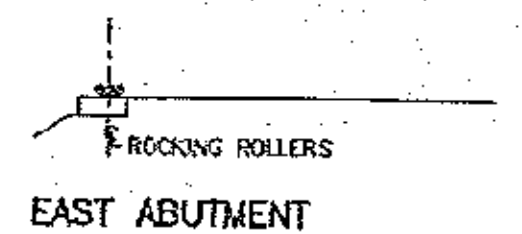

INFORMATION DISCLOSED HEREIN IS THE PROPERTY OF ACROW CORPORATION OF AMERICA. THIS MATERIAL IS PRIVILEGED AND CONFIDENTIAL. IT IS INTENDED SOLELY FOR THE ADDRESSEE. ANY UNAUTHORIZED DISCLOSURE, REPRODUCTION, OR DISTRIBUTION IS PROHIBITED. DUPLICATION OF ANY PORTION OF THIS DATA SHALL INCLUDE THIS LEGEND. COPYRIGHT ACROW CORP 2012

REV.	DATE	DESCRIPTION	BY

**ACROW** CREATING ENGINEERED SOLUTIONS WORLDWIDE  
CORPORATION OF AMERICA  
181 NEW ROAD, PARSONS, NJ 07054

ACROW 700XS PANEL BRIDGE  
DE-LAUNCHING SEQUENCE  
200FT x 2 LANE 24FT TDR3H BRIDGE  
WOODFORD, VT  
ER BHF 010-1(44)

DRAWN BY	RJ	DATE	NOVEMBER 21, 2012	CONTRACT NO.
CHECKED BY	MP	SCALE:	AS SHOWN	
APPROVED BY	SP			

T. BUCK CONSTRUCTION  
AUBURN, ME

DRAWING NO.	REV.
AB1543-DL	
SHT 4B OF 4	

State of Vermont  
Program Development  
One National Life Drive  
Montpelier, VT 05633-5001  
www.aot.state.vt.us

[phone] 802-828-2621  
[fax] 802-828-3566  
[ttd] 800-253-0191

Agency of Transportation

July 16, 2012

Highway Safety Corp  
Glastonbury, CT

Project Name: Woodford Project #: ER BHF 010-1(44)

Structure Identification: VT 9 Over the Roaring Branch of the Walloomsac River

The following bridge railing details item 525.33, "Bridge Railing, Galvanized 2 Rail Box Beam" for the above project (Vendor's Job #1881, transmitted by T. Buck Construction, Inc. and received by our office on Friday, July 13, 2012, have been reviewed and are being returned herewith.

Sheet 1 and 4 and the welding procedures are approved.

Sheet 2 and 3 are approved "as noted". (Please make appropriate changes as indicated on the "as noted" drawing and submit a new "\*.pdf" for our use in the record plans for this project.)

You must provide notice to our fabrication inspector Jeff Clark as to the date fabrication represented by these drawings will begin. Jeff may be contacted by phone at (802)828-0044 or email at [jeff.clark@state.vt.us](mailto:jeff.clark@state.vt.us). That notice must be received at least seven days prior to that date, as per Specification 506.03. Any material fabricated prior to the notification date is subject to rejection without further cause.

Sincerely,



Carolyn W. Carlson, PE  
Project Manager

Attachments

cc:  Resident Engineer Ron Lemaire -w/prints  
 T. Buck Construction, Inc. - w/prints  
 Shop Inspector - Jeff Clark w/prints  
 Materials & Research Section (C&IA Unit) – Letter only  
 F.R. Lafayette – w/prints  
 Construction Division - Letter only  
 CWC

# Highway Safety Corporation

Glastonbury, CT

## Welding Procedure Specification

Material specification A572 gr 50, A709 Gr 50  
 Welding process Gas Metal Arc Welding (GMAW) Spray Transfer  
 Manual, semi-automatic, or automatic Semi-Automatic  
 Position of welding Flat (1F) or Horizontal (2F)  
 Filler metal specification AWS A5.18  
 Filler metal classification ER70S-6  
 Electrode and manufacturer Lincoln Electric Lincoln Weld L-56  
 Flux and manufacturer N/A  
 Shielding gas 86% Argon / 14% CO2 Flow rate 35-45 CFM  
 Single or multiple pass Single or Multiple  
 Single or multiple arc Single  
 Welding current DCEP  
 Polarity Reverse - electrode positive  
 Welding progression Stringers  
 Root treatment clean base metal  
 Preheat and interpass temperature base metal up to 3/4" (50°F) ; over 3/4 thru 1-1/2" ( 150°F ) ; over 1-1/2" thru 2-1/2" (225°F)  
 Postheat treatment None  
 Electrode extension 3/4" ± 1/4"

### WELDING PROCEDURE

Weld size	Pass no.	Electrode size	Welding parameters		Travel speed	Joint detail
			Amperes	Volts		
5/16"	1	0.062"	300 A ± 30	29 V ± 2	15 ipm ± 2	
7/16"	1 & 2	0.062"	↓	↓	15 ipm ± 2	
CKD _____ JUN 27 2012 Resubmit BY _____ APPROVED DATE 7/2/12 ✓						

This procedure may vary due to fabrication sequence, fit-up, pass size, etc. within the limitation of variables given in section 5 of latest edition AWS D1.5

WPS no. W-VTPEDPOST1  
 Revision no. 0  
 Supporting PQR no. Pre-Qualified  
 Project Name Woodford, VT

Fabricator Highway Safety Corporation  
 Prepared By: Paul Radice  
 Date 5/31/12  
 Project Number ER BHF 010-1(44)

Paul A Radice  
 CWI 98670221  
 OCL EXP. 7/1/2013


# Highway Safety Corporation

Glastonbury, CT

## Welding Procedure Specification

Material specification ASTM A500 gr B  
 Welding process Gas Metal Arc Welding (GMAW)  
 Manual, semi-automatic, or automatic Semi-Automatic  
 Position of welding Flat (1F) or Horizontal (2F)  
 Filler metal specification AWS A5.18  
 Filler metal classification ER70S-6  
 Electrode and manufacturer Lincoln Electric Lincoln Weld L-56  
 Flux and manufacturer N/A  
 Shielding gas 86% Argon / 14% CO2 Flow rate 35-45 CFM  
 Single or multiple pass Single  
 Single or multiple arc Single  
 Welding current DCEP  
 Polarity Reverse - electrode positive  
 Welding progression Stringers  
 Root treatment clean base metal  
 Preheat and interpass temperature base metal up to 3/4" (50°F)  
 Postheat treatment None  
 Electrode extension 3/4" ± 1/4"

### WELDING PROCEDURE

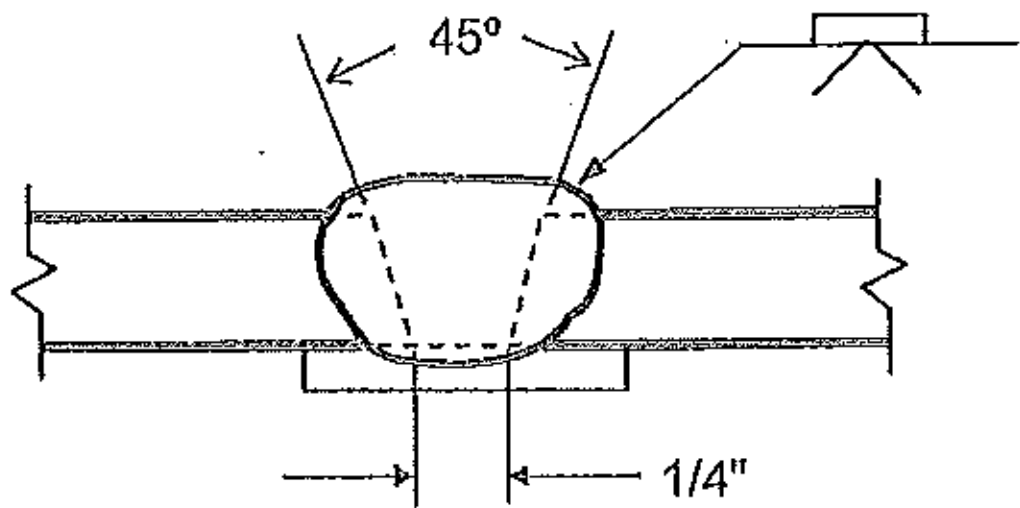
Weld size	Pass no.	Electrode size	Welding parameters		Travel speed	Joint detail
			Amperes	Volts		
	1	0.063"	300 A ± 30	29 V ± 2	15 ipm ± 2	B-U2a-GF 
CK'D BY <u>JUC</u> V Trans Received JUN 27 2012 Resubmit BY <u>APPROVED</u> DATE <u>17/6/12</u>						

This procedure may vary due to fabrication sequence, fit-up, pass size, etc. within the limitation of variables given in section 5 of latest edition AWS D1.1


WPS no. W-VGWBCK  
 Revision no. 0  
 Supporting PQR no. Pre-Qualified  
 Project Name Woodford, VT

Fabricator Highway Safety Corporation  
 Prepared By: Paul Radice  
 Date 5/31/12  
 Project Number ER BHF 010-1(44)

Paul A Radice  
 CWI 98070221  
 QC1 EXP 7/1/201

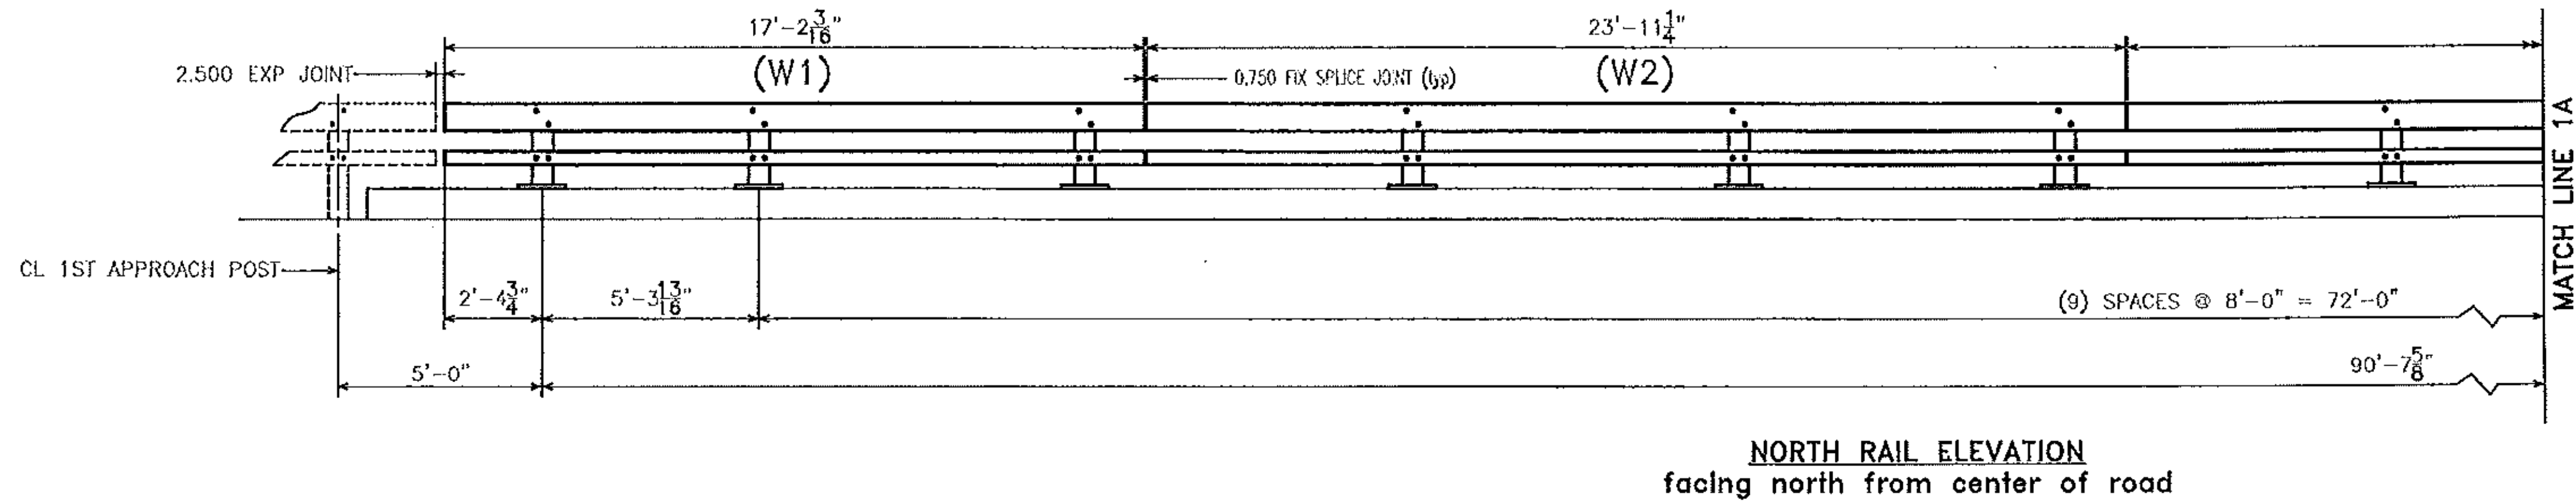

BILL OF MATERIAL (NORTH RAIL)				
Mk#	Qty.	Description	Size/Shape	Material
<b>POST</b>				
12		BRIDGE RAIL PED POST 2'-0 3/8" OAH W/ BASE PLATE		
12		POST UPRIGHT	W6 x 25	1'-11 3/8" A709 Gr. 50
12		POST BASE PLATE	10" x 1"	1'-2" A709 Gr. 50
<b>SPLICE</b>				
5		UPPER SPLICE TUBE FOR 8 x 4 RAIL		
5		TUBE	TS 7x3x3/8	1'-8" A500 Gr. B
10		WELDED LOCK NUT (OUTER HOLES ONLY)	5/8"	A563
5		LOWER SPLICE TUBE FOR 4 x 4 RAIL		
5		TUBE	TS 3x3x5/16	1'-8" A500 Gr. B
10		WELDED LOCK NUT (OUTER HOLES ONLY)	5/8"	A563
<b>RAIL</b>				
W1	1	UPPER RAIL 1 END FC, 1 END DP	TS 8x4x5/16	17'-2 3/16" A500 Gr. B
	1	LOWER RAIL 1 END FC, 1 END DP	TS 4x4x1/4	17'-2 3/16" A500 Gr. B
W2	2	UPPER RAIL FIX SPLICE BOTH ENDS	TS 8x4x5/16	23'-11 1/4" A500 Gr. B
	2	LOWER RAIL FIX SPLICE BOTH ENDS	TS 4x4x1/4	23'-11 1/4" A500 Gr. B
W3	1	UPPER RAIL 1 END FC, 1 END DP	TS 8x4x5/16	20'-9 1/8" A500 Gr. B
	1	LOWER RAIL 1 END FC, 1 END DP	TS 4x4x1/4	20'-9 1/8" A500 Gr. B
W4	1	UPPER RAIL 1 END FC, 1 END DP	TS 8x4x5/16	32'-5 13/16" A500 Gr. B
	1	LOWER RAIL 1 END FC, 1 END DP	TS 4x4x1/4	32'-5 13/16" A500 Gr. B
<b>HARDWARE</b>				
11		ANCHOR PLATE	9 3/8" x 3/8"	1'-1" A36
48		ANCHOR STUD	1" DIA.	12" A449
44		JAMB NUT	1" DIA.	A563
92		HEAVY HEX NUT	1" DIA.	A5630H
48		WASHER	1" DIA.	F436
48		ROUND HEAD BOLT	3/4" DIA.	6" M164 type 1
48		LOCK NUT	3/4" DIA.	A5630H
48		WASHER	3/4" DIA.	F436
40		CAP SCREW	5/8" DIA.	1 3/4" A325
40		WASHER	5/8" DIA.	F436
8		PIPE SPACER (SCH. 40)	3/4" DIA.	1/2" A53
12		BEARING PAD	10" x 1/8"	1'-2" M251

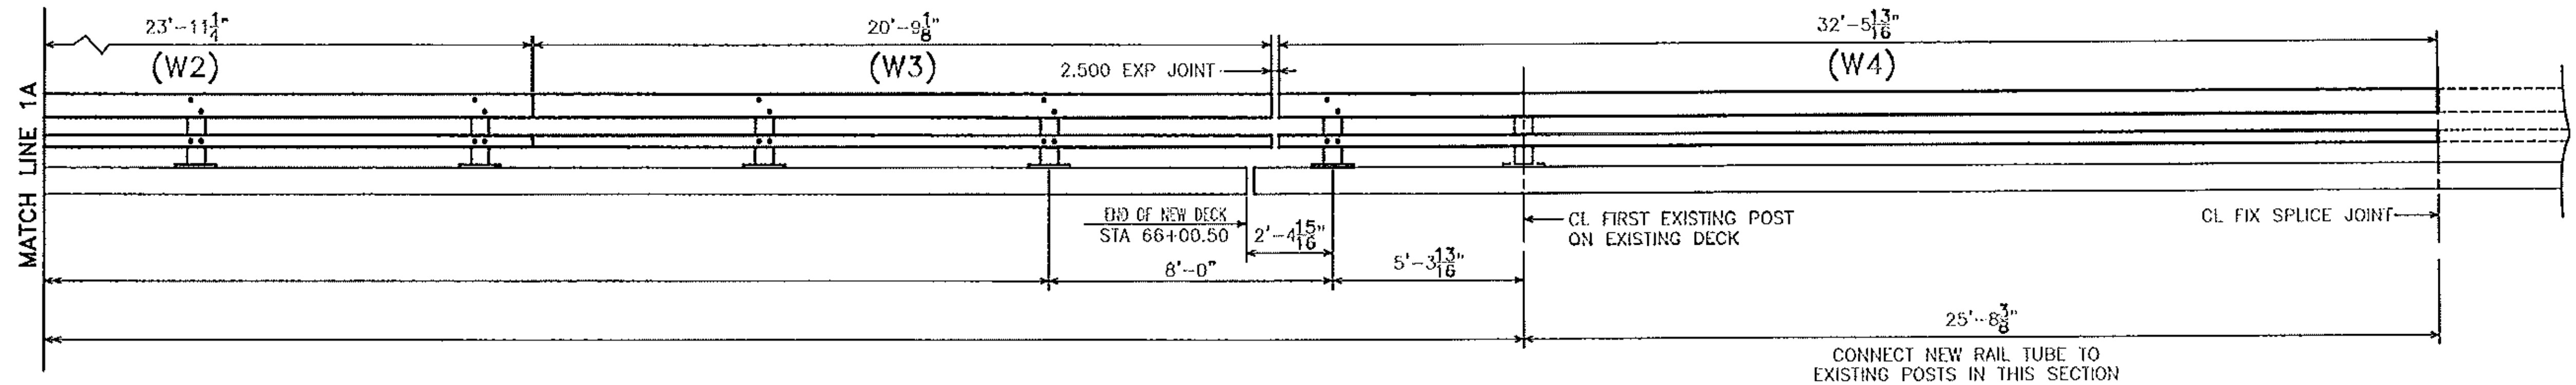

PAY LENGTH ITEM 525.33 NETC 2 RAIL BRIDGE RAIL = 118.7 LF

Vermont Agency of Transportation

# RECEIVED

CK'D BY GFR OK'D BY CAM

07/13/2012

RESUBMIT APPROVED X

BY C. CARLSON DATE 07/16/2012

## HIGHWAY SAFETY CORP

GLASTONBURY, CT  
860-633-9445

ITEM 525.33 NETC 2 RAIL BRIDGE RAIL  
VT RT 9 BRIDGE NO. 11  
TOWN OF WOODFORD  
COUNTY OF BENNINGTON, VERMONT  
PROJECT NO. ER BHF 010-1(44)

**CERTIFIED FABRICATOR**


1881

1 of 4


T BUCK CONSTRUCTION

MMH PAR 05-31-12 NONE D


No.	Remarks	Date
A	CORRECTED SUBMITTAL	
O	Initial submittal	05-31-12
REVISIONS		

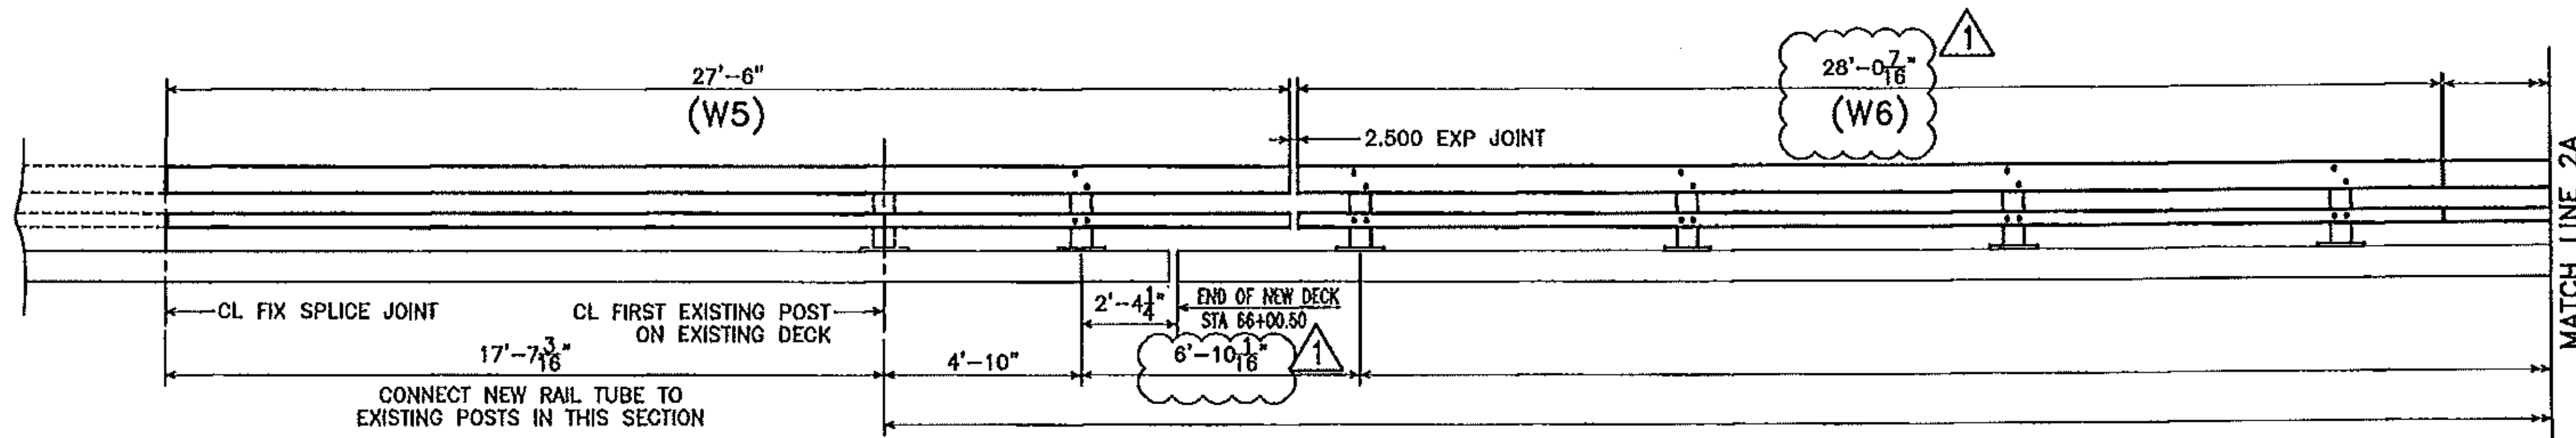

BILL OF MATERIAL (SOUTH RAIL)				
Mk#	Qty.	Description	Size/Shape	Material
<b>POST</b>				
18		BRIDGE RAIL PED POST 2'-0 3/8" OAH W/ BASE PLATE		
18		POST UPRIGHT	W6 x 25	1'-11 3/8" A709 Gr. 50
18		POST BASE PLATE	10" x 1"	1'-2" A709 Gr. 50
<b>SPLICE</b>				
6		UPPER SPLICE TUBE FOR 8 x 4 RAIL		
6		TUBE	TS 7x3x3/8	1'-8" A500 Gr. B
12		WELDED LOCK NUT (OUTER HOLES ONLY)	5/8"	A563
6		LOWER SPLICE TUBE FOR 4 x 4 RAIL		
6		TUBE	TS 3x3x5/16	1'-8" A500 Gr. B
12		WELDED LOCK NUT (OUTER HOLES ONLY)	5/8"	A563
<b>RAIL</b>				
W2	3	UPPER RAIL	FIX SPLICE BOTH ENDS	TS 8x4x5/16 23'-11 1/4" A500 Gr. B
	3	LOWER RAIL	FIX SPLICE BOTH ENDS	TS 4x4x1/4 23'-11 1/4" A500 Gr. B
W5	2	UPPER RAIL	1 END FIX, 1 END EXP	TS 8x4x5/16 27'-6" A500 Gr. B
	2	LOWER RAIL	1 END FIX, 1 END EXP	TS 4x4x1/4 27'-6" A500 Gr. B
W6	1	UPPER RAIL	1 END FIX, 1 END EXP	TS 8x4x5/16 28'-0 7/16" A500 Gr. B
	1	LOWER RAIL	1 END FIX, 1 END EXP	TS 4x4x1/4 28'-0 7/16" A500 Gr. B
<b>HARDWARE</b>				
17		ANCHOR PLATE	9 3/8" x 3/8"	1'-1" A36
72		ANCHOR STUD	1" DIA	12" A449
68		JAMB NUT	1" DIA	A563
140		HEAVY HEX NUT	1" DIA	A563DH
72		WASHER	1" DIA	F436
72		ROUND HEAD BOLT	3/4" DIA	6" M164 type 1
72		LOCK NUT	3/4" DIA	A563DH
72		WASHER	3/4" DIA	F436
48		CAP SCREW	5/8" DIA	1 3/4" A325
48		WASHER	5/8" DIA	F436
8		PIPE SPACER (SCH. 40)	3/4" DIA	1/2" A53
18		BEARING PAD	10" x 1/8"	1'-2" M251

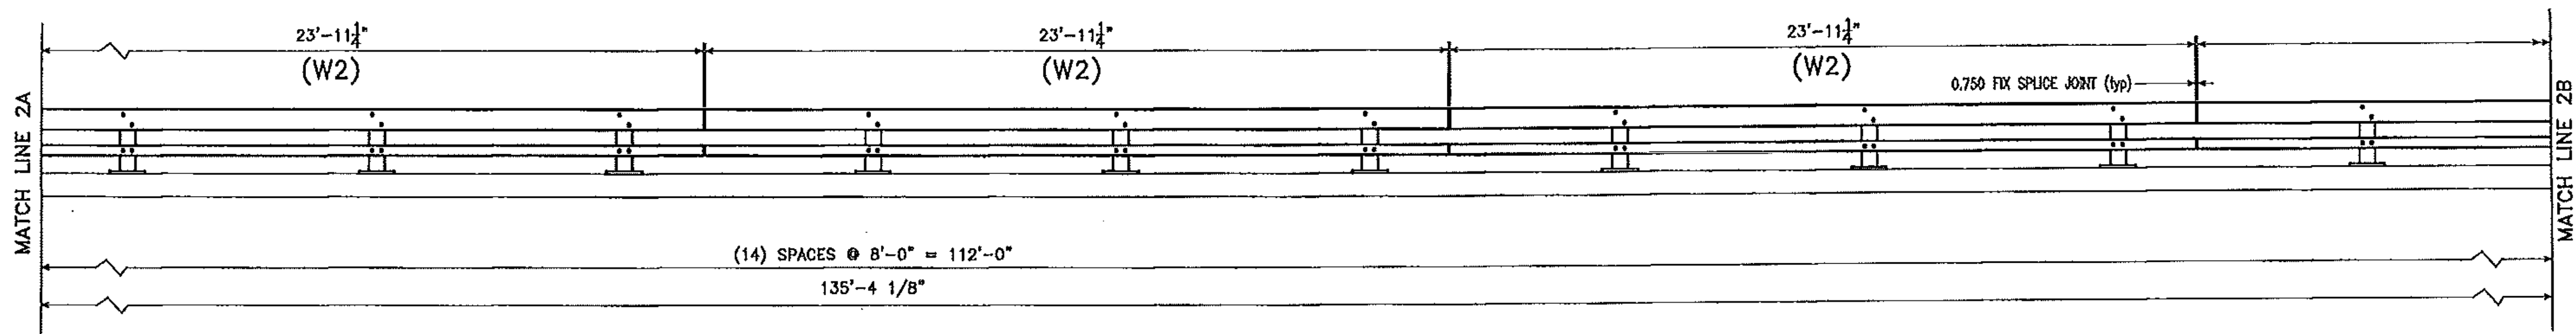

**SOUTH RAIL ELEVATION**  
facing south from center of road

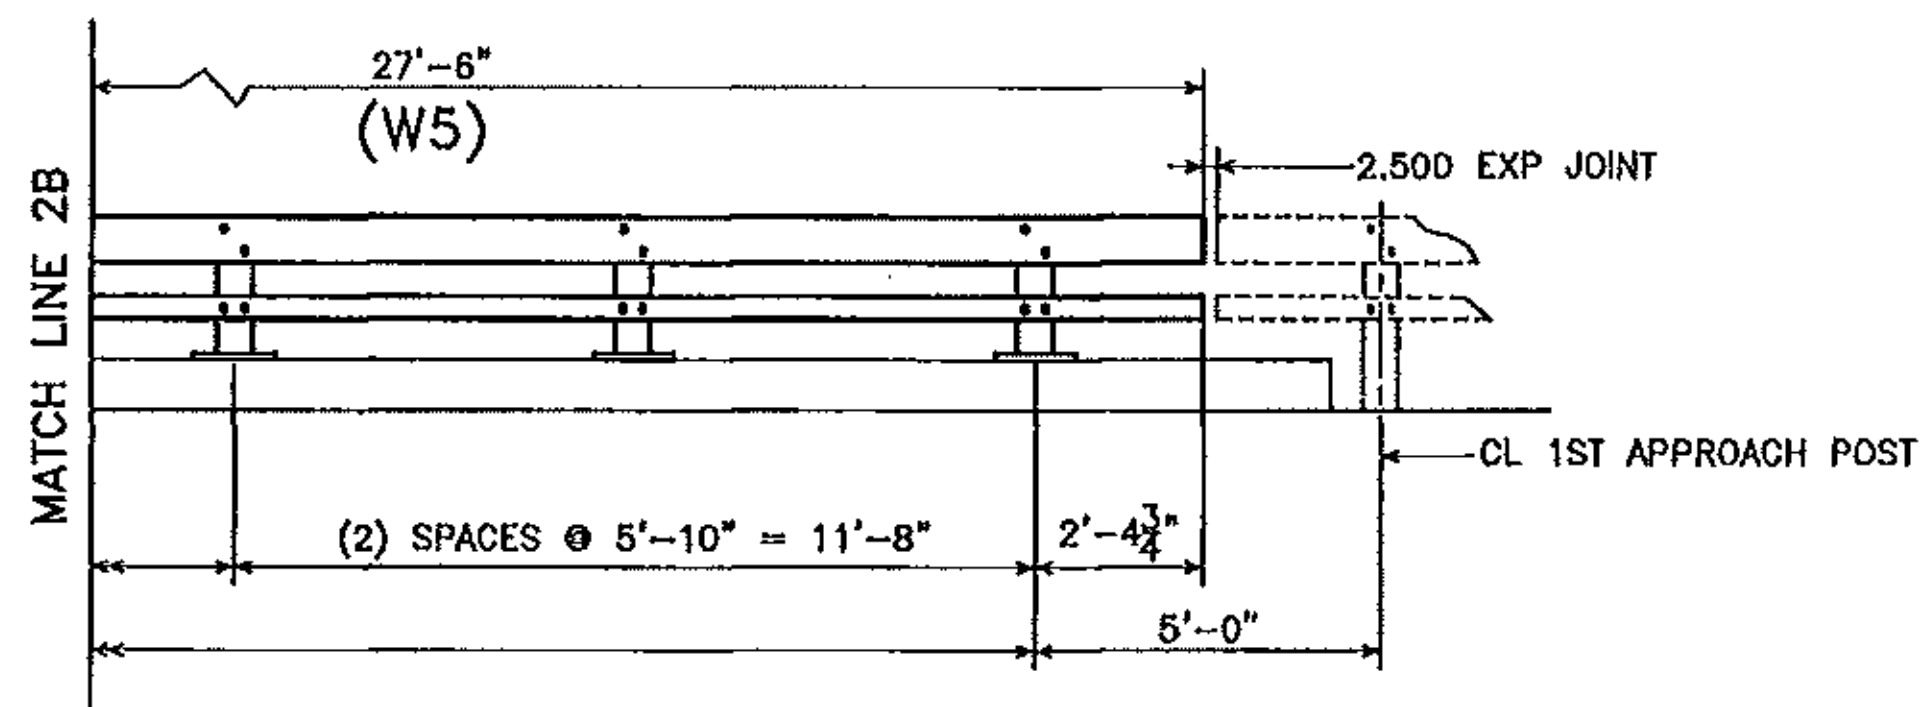

PAY LENGTH ITEM 525.33 NETC 2 RAIL BRIDGE RAIL = 155.3 LF

**HIGHWAY SAFETY CORP**  
GLASTONBURY, CT  
860-633-9445

ITEM 525.33 NETC 2 RAIL BRIDGE RAIL  
VT RT 9 BRIDGE NO. 11  
TOWN OF WOODFORD  
COUNTY OF BENNINGTON, VERMONT  
PROJECT NO. ER BHF 010-1(44)




CERTIFIED FABRICATOR

1881





GENERAL CONTRACTOR  
CONTRACTOR T BUCK CONSTRUCTION  
DATE 05-31-12 SCALE NONE SIZE D

No.	Remarks	Date
1	APPROVED-AS-NOTED CORRECTIONS	07-16-12
A	CORRECTED SUBMITTAL	07-10-12
0	Initial submittal	05-31-12






**REVISIONS**

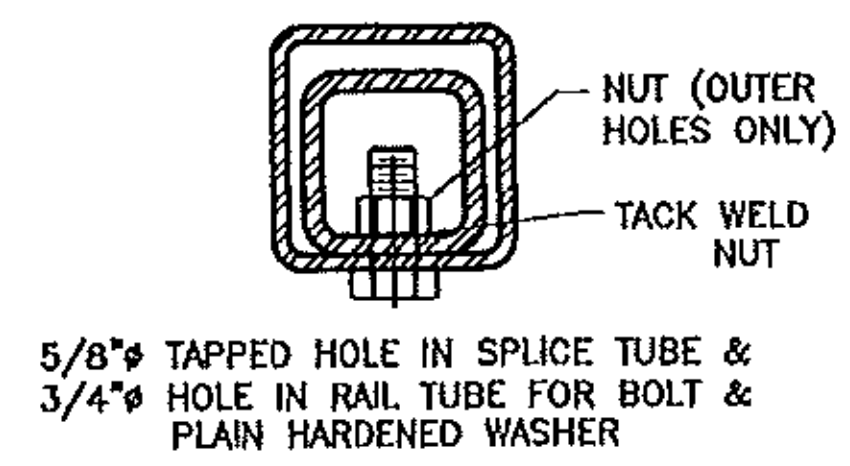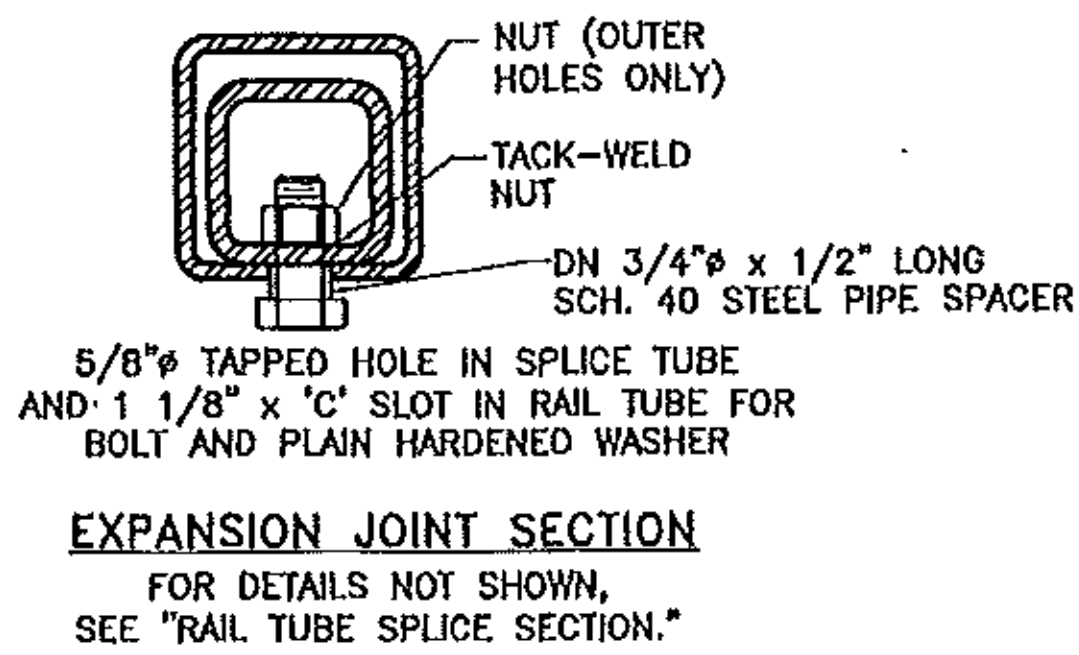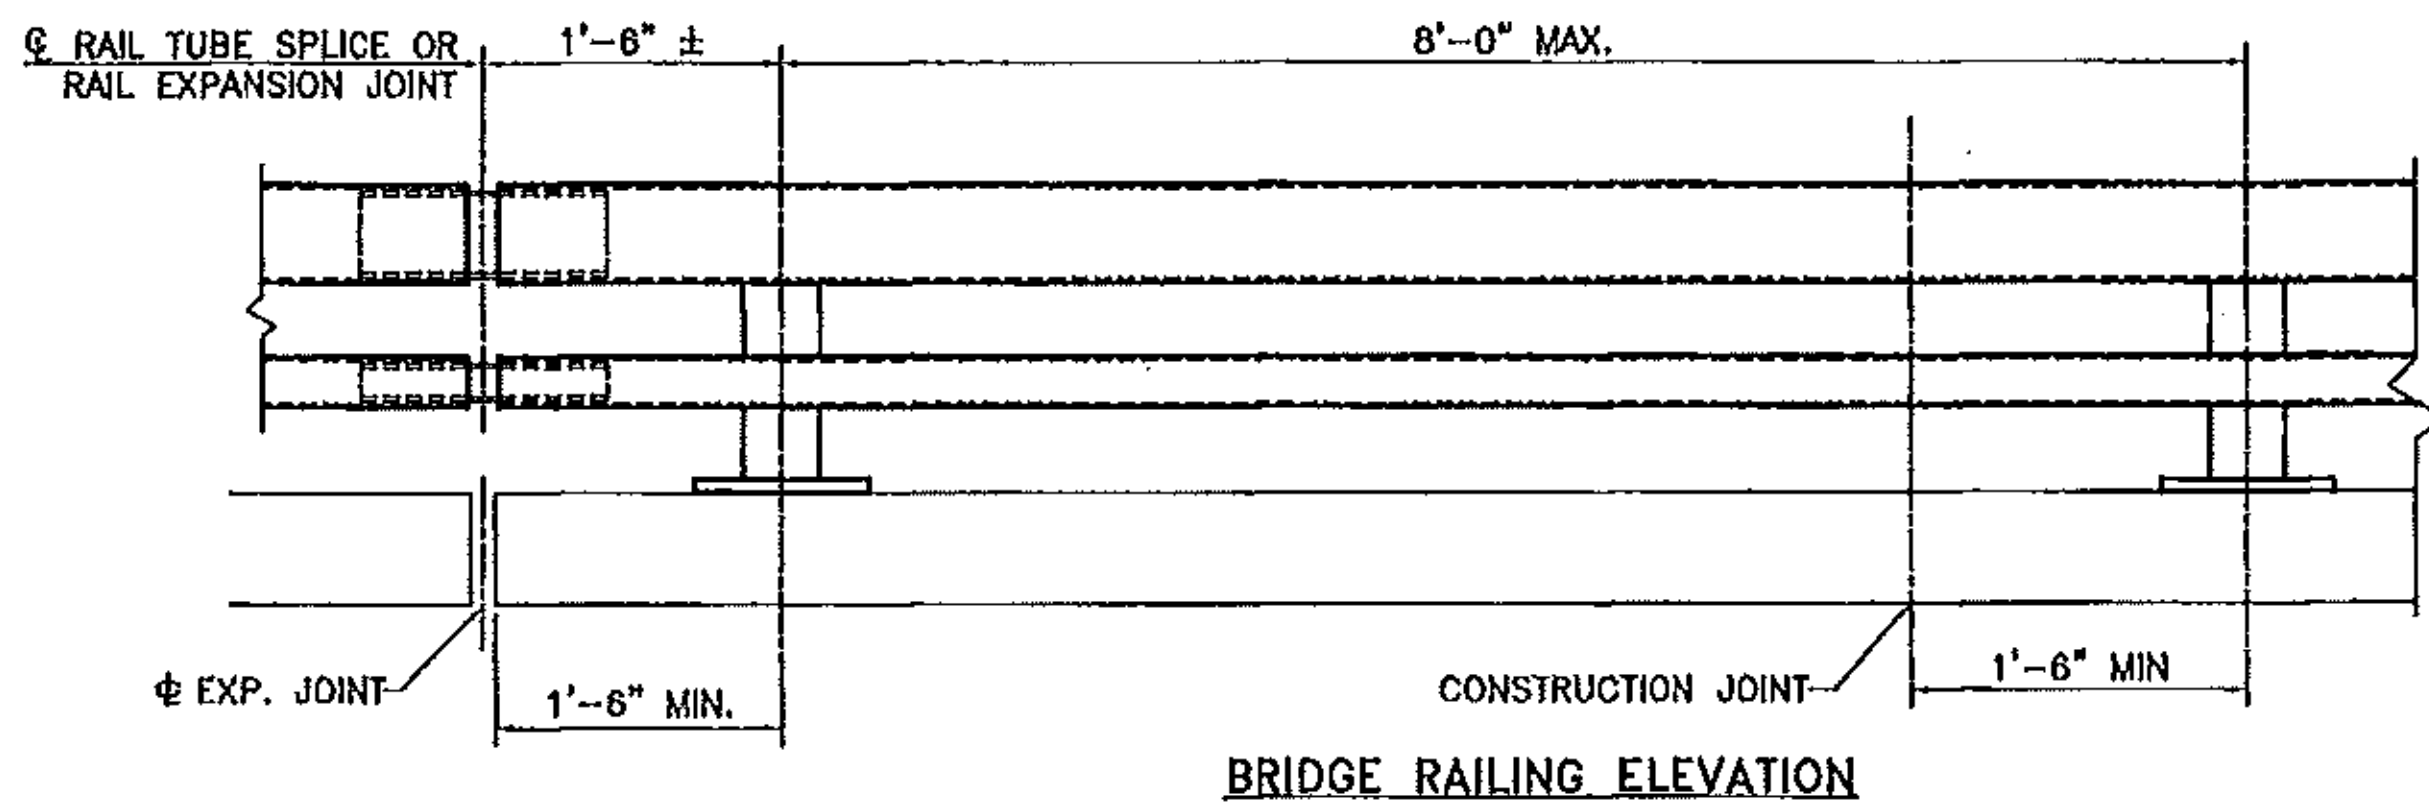

- NOTES:**
1. ALL RAILINGS AND MATERIALS SHALL CONFORM TO THE STANDARD SPECIFICATION FOR CONSTRUCTION SECTION 525, BRIDGE RAILINGS.
  2. PRIOR TO GALVANIZING, ALL EXPOSED CUT OR SHEARED EDGES SHALL BE ROUNDED TO A 1/16" RADIUS AND BE FREE OF BURRS.
  3. RAIL POSTS SHALL BE SET NORMAL TO GRADE.
  4. SECTIONS OF RAIL TUBE SHALL BE ATTACHED TO A MINIMUM OF TWO (2) RAIL POSTS AND PREFERABLY TO AT LEAST FOUR (4) POSTS.
  5. RAIL TUBE EXPANSION JOINT SHALL BE PROVIDED IN ANY RAIL BAY SPANNING A SUPERSTRUCTURE EXPANSION JOINT. EXPANSION JOINT WIDTH SHALL BE "X" AT 45°F AND WILL BE ADJUSTED IN THE FIELD BY THE ENGINEER FOR OTHER TEMPERATURES.
  6. ALL PARTS SHALL BE GALVANIZED AFTER FABRICATION IN ACCORDANCE WITH AASHTO M111, EXCEPT HARDWARE, WHICH SHALL MEET THE REQUIREMENTS OF AASHTO M232.
  7. RAIL POST ANCHORING NUTS SHALL BE TIGHTENED TO A SNUG FIT AND GIVEN AN ADDITIONAL ONE-EIGHTH TURN.
  8. RAIL TUBES SHALL BE ATTACHED USING 3/4" FULL DIAMETER BODY AASHTO M164 (TYPE 1) ROUND HEAD BOLT INSERTED THROUGH THE FACE OF THE TUBE. HOLES IN POSTS SHALL BE 1/16" LARGER THAN THE BOLT SIZE.
  9. HOLES IN RAILS FOR RAIL TUBE ATTACHMENT SHALL BE FIELD-DRILLED. HOLES SHALL BE COATED WITH AN APPROVED ZINC-RICH PAINT PRIOR TO ERECTION.
  10. IF THERE IS A CONFLICT BETWEEN THE DETAILS SHOWN ON THIS SHEET AND THE DESIGN, THE REQUIREMENTS OF THE DESIGN DRAWINGS SHALL BE FOLLOWED.
  11. ANY BENDING OF RAIL SHALL BE BY SHOP PROCEURE ONLY, AND SHALL BE DONE AT THE FABRICATION PLANT.
  12. THE FABRICATOR SHALL SUBMIT SHOP DRAWINGS, INCLUDING WELDING PROCEDURES TO THE STRUCTURES SECTION FOR APPROVAL IN ACCORDANCE WITH SUBSECTION 506.04 OF THE STANDARD SPECIFICATIONS. ALL WELDING SHALL CONFORM WITH SUBSECTION 506.10.
  13. RAIL POSTS AND BASE PLATES SHALL BE TESTED FOR IMPACT PROPERTIES IN ACCORDANCE WITH ASTM A-370 CHARPY IMPACT TESTING USING TYPE A SPECIMEN
  14. EXPANSION JOINT HARDWARE, REFLECTORS AND REFLECTOR HARDWARE PROVIDED BY OTHERS.

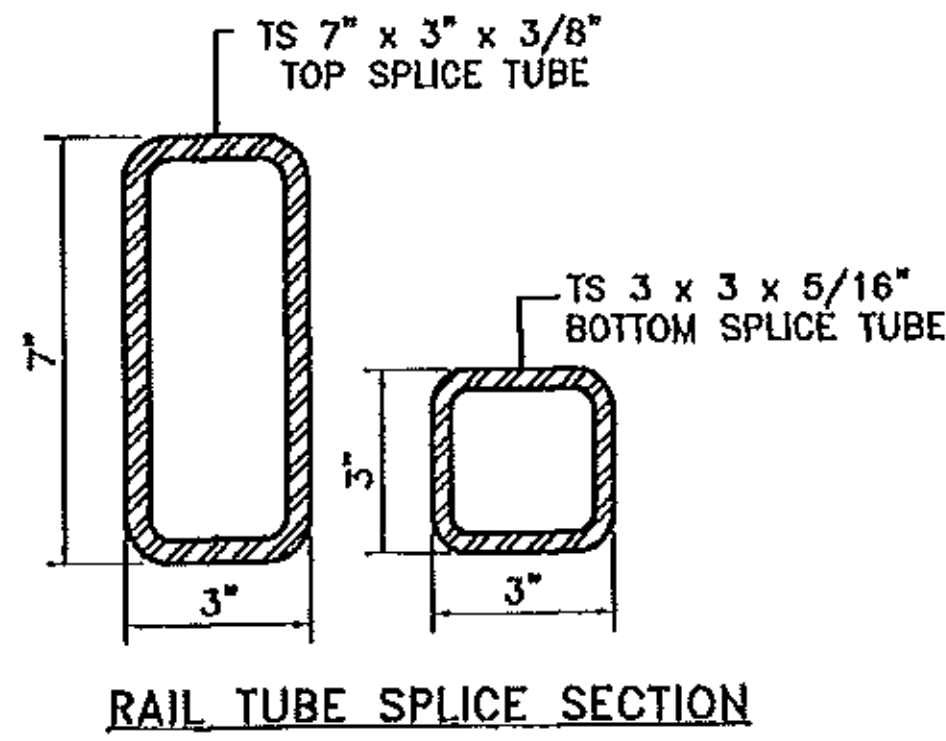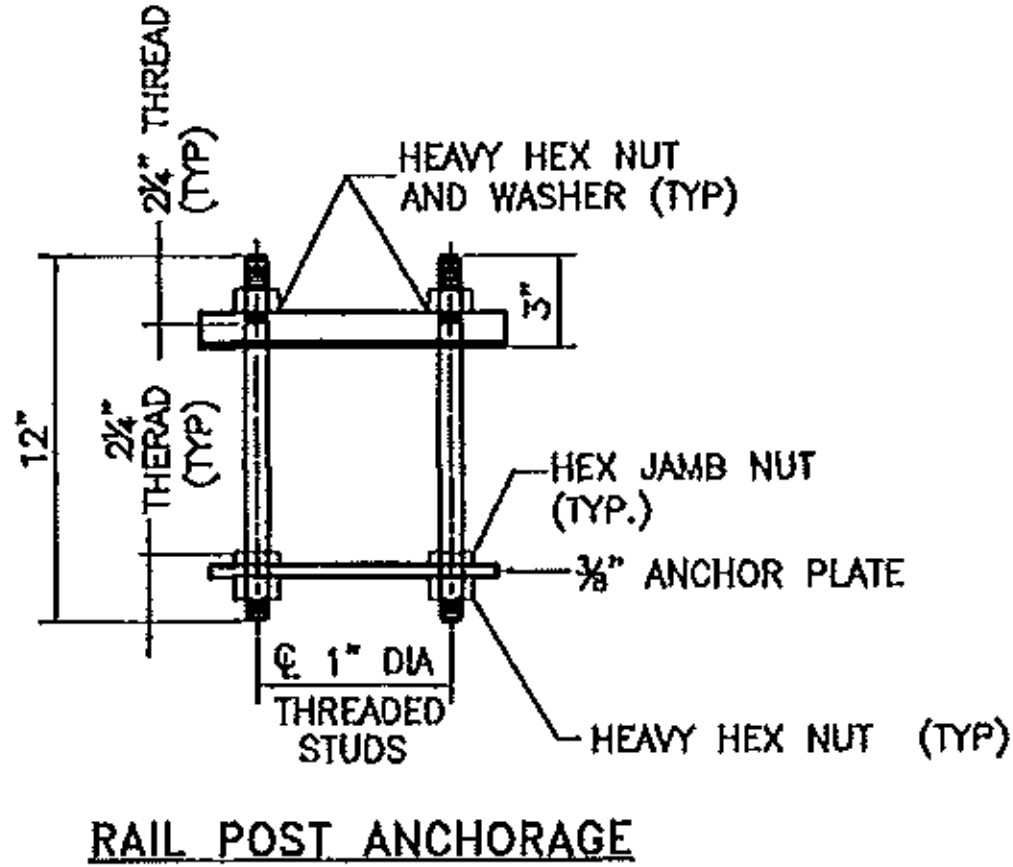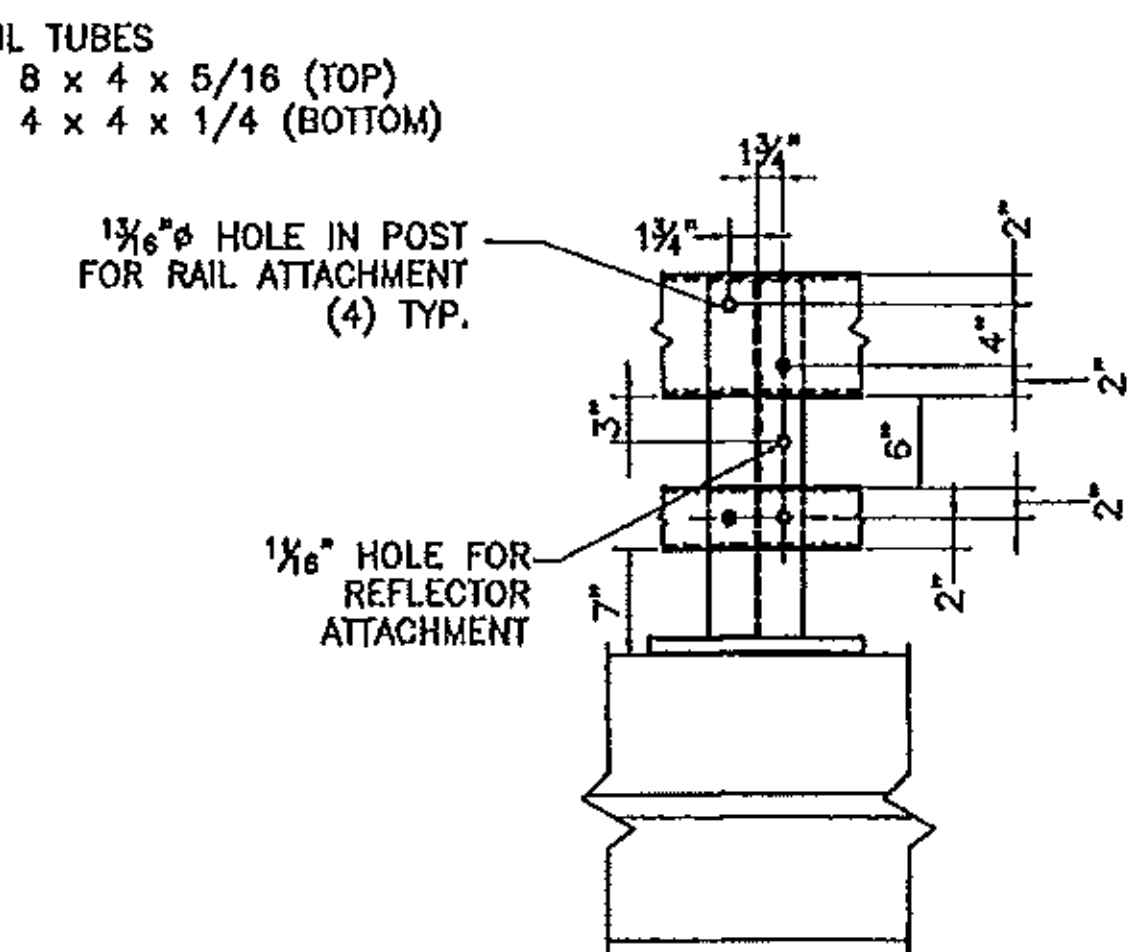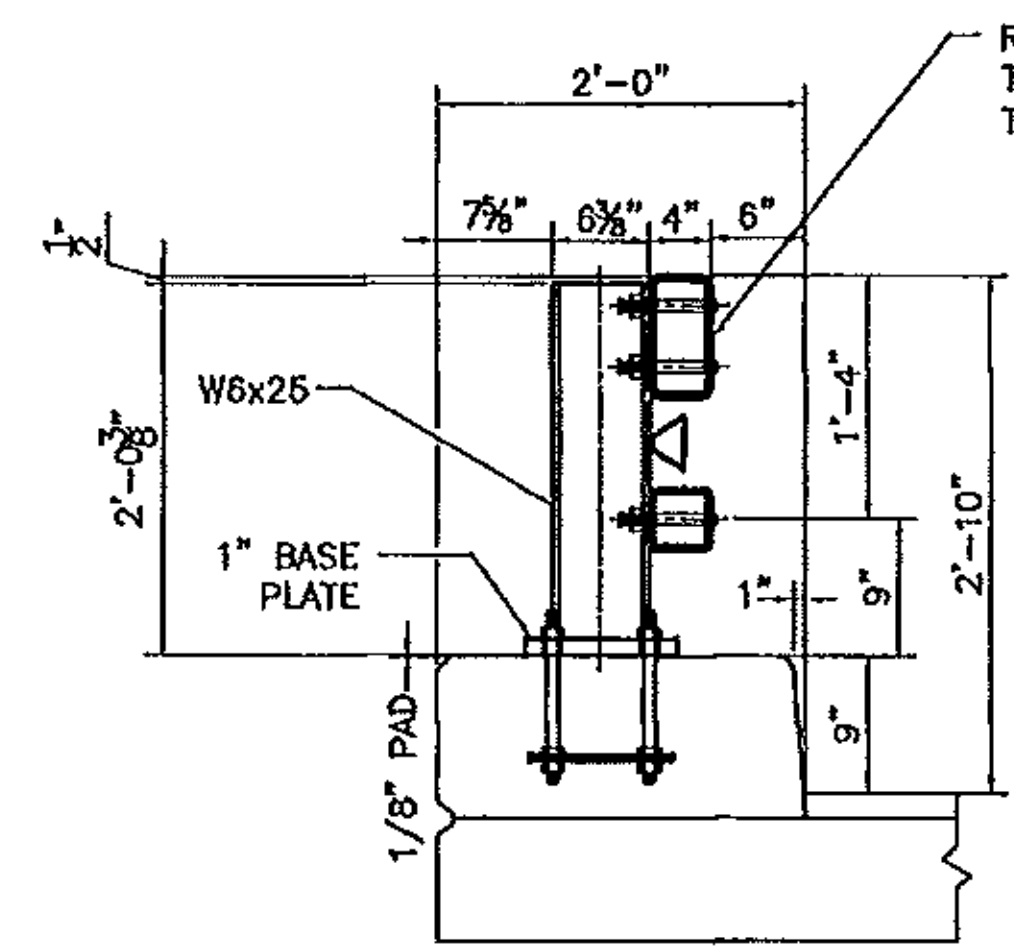

- MATERIALS**
- RAIL TUBES.....ASTM A500, GRADE B OR ASTM A501
  - RAIL POSTS AND BASE PLATES.....ASTM A709/A709M, GRADE 50
  - ALL OTHER SHAPES AND PLATES.....ASTM A709/A709M, GRADE 36
  - ANCHOR STUDS.....ASTM A449
  - ALL OTHER BOLTS (UNLESS NOTED).....AASHTO M164, TYPE1
  - NUTS FOR AASHTO M164 BOLTS AND FOR ANCHOR STUDS SHALL COMPLY WITH AASHTO M291 (ASTM A563).
  - WASHERS SHALL COMPLY WITH AASHTO M293 (ASTM F436) SPECIFICATIONS.
  - 1/8" PAD SHALL COMPLY WITH STANDARD SPECIFICATION SUBSECTION 731.01 OR 731.02.

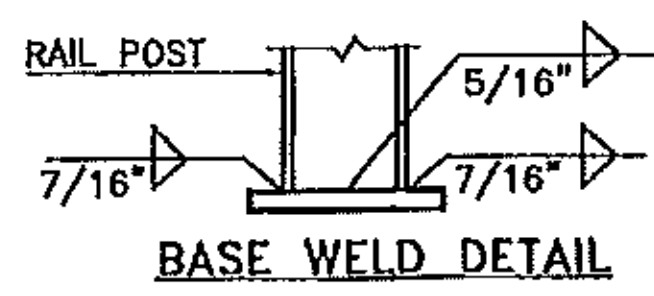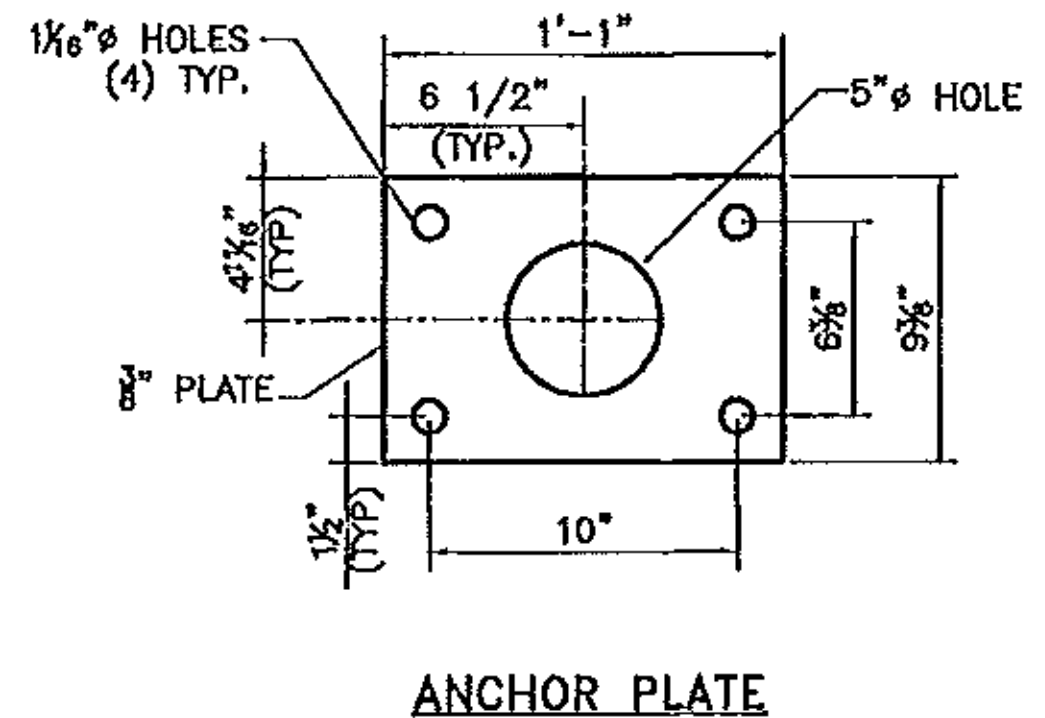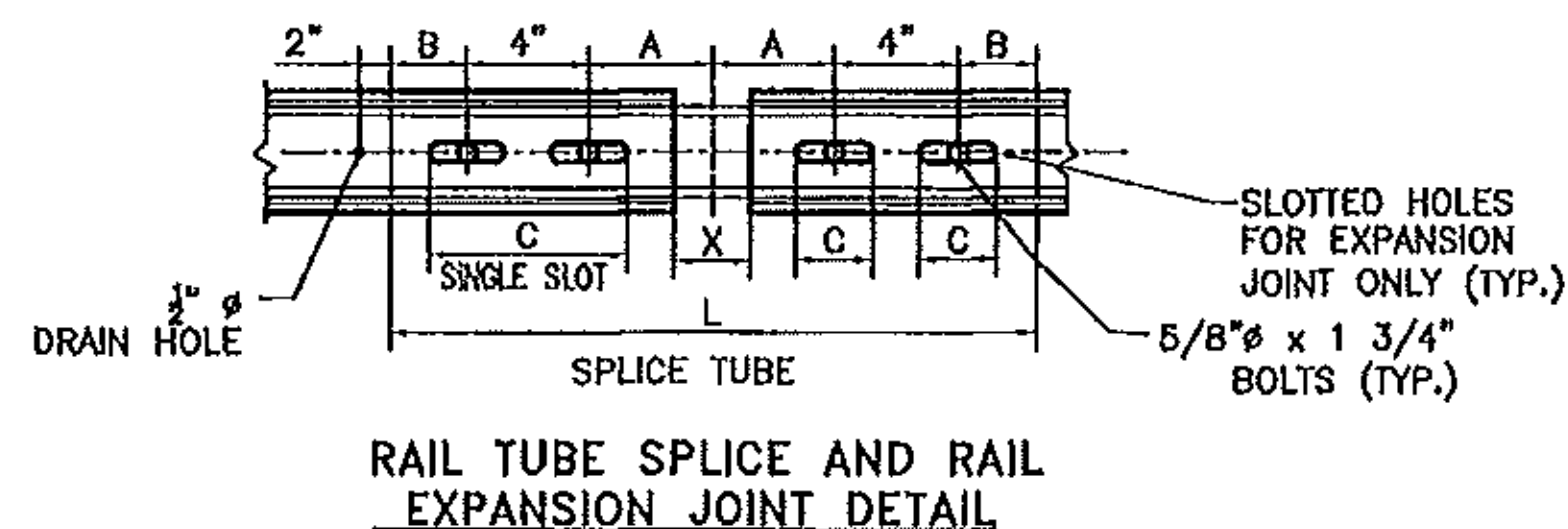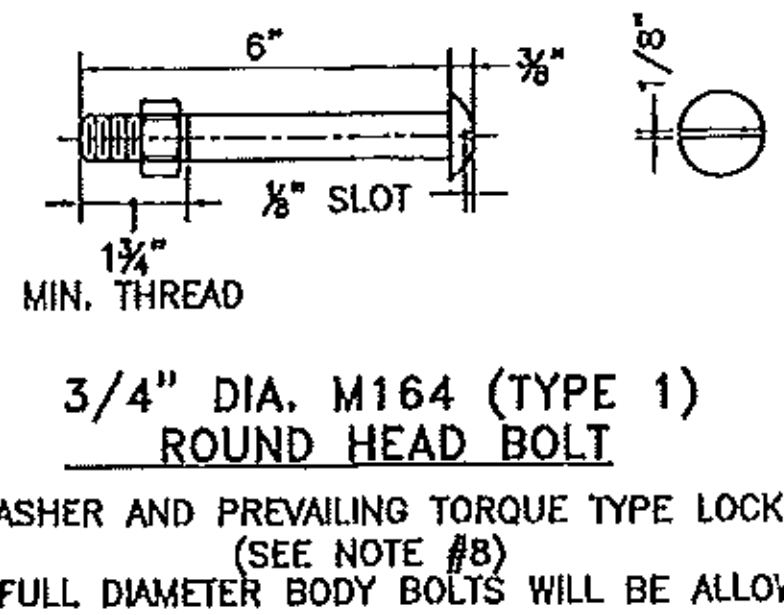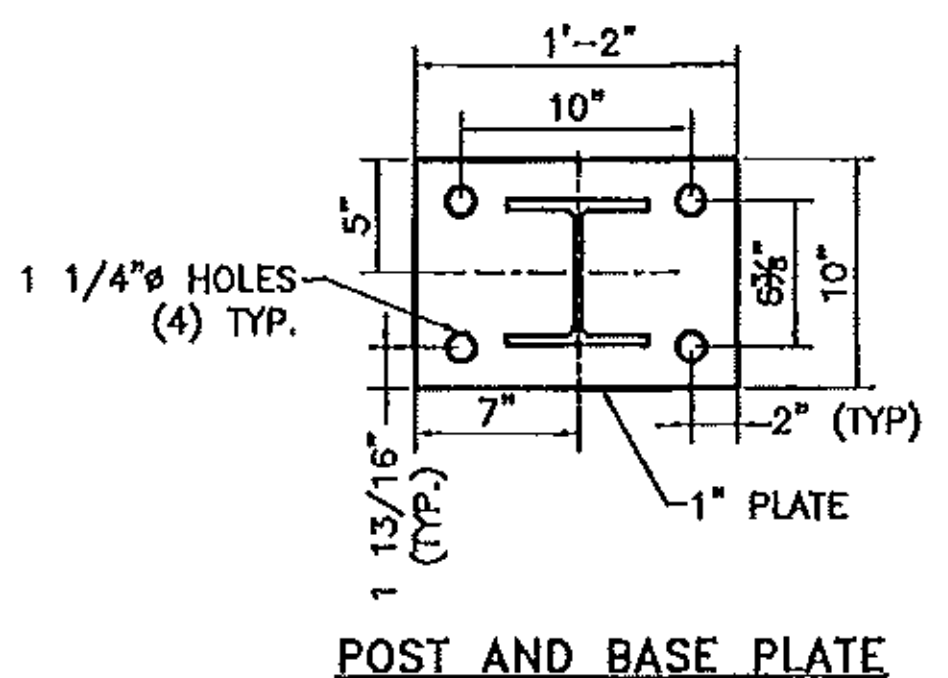

SPLICE TABLE					
T	A	B	C	L	X
N/A	4"	2"	--	20"	3/4"
EXPANSION JOINT TABLE					
<4"	4"	2"	2 1/2"	20"	2 1/2"

T = TOTAL MOVEMENT BETWEEN BRIDGE EXPANSION JOINTS. SEE NOTE 5

No.	REVISIONS	Date
1	APPROVED-AS-NOTED CORRECTIONS	07-16-12
0	Initial submittal	05-31-12

**HIGHWAY SAFETY CORP**  
 GLASTONBURY, CT  
 860-633-9445

ITEM 525.33 NETC 2 RAIL BRIDGE RAIL  
 VT RT 9 BRIDGE NO. 11  
 TOWN OF WOODFORD  
 COUNTY OF BENNINGTON, VERMONT  
 PROJECT NO. ER BHF 010-1(44)













**CERTIFIED FABRICATOR**

1881

3 of 4

Y BUCK CONSTRUCTION

MHW CHECKED PAR DATE 05-31-12 SCALE NONE

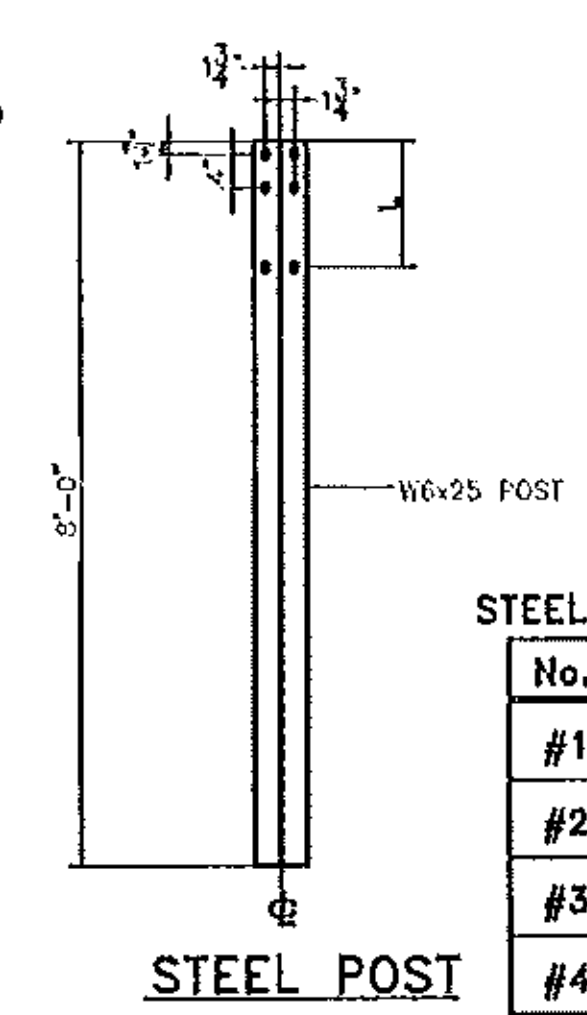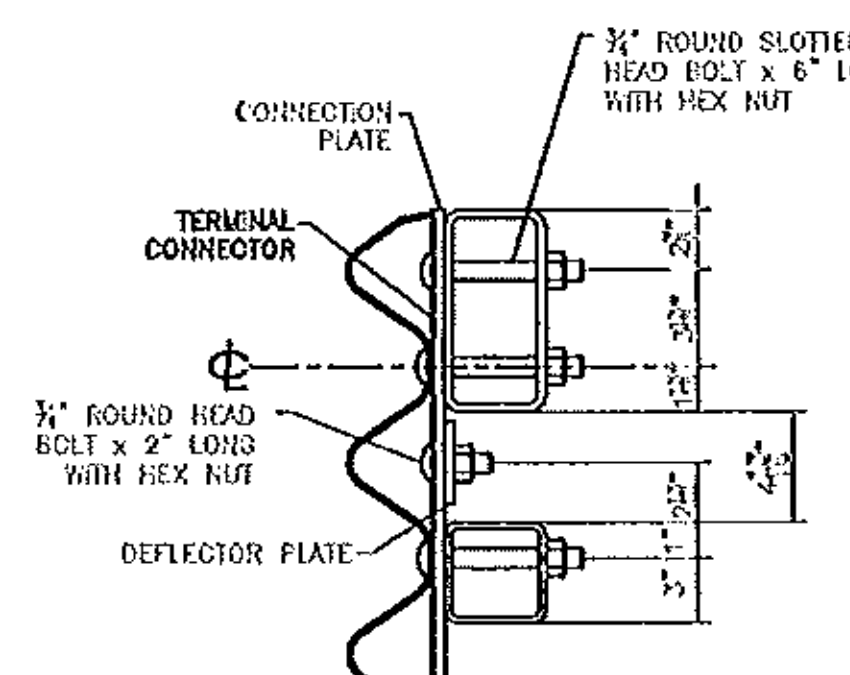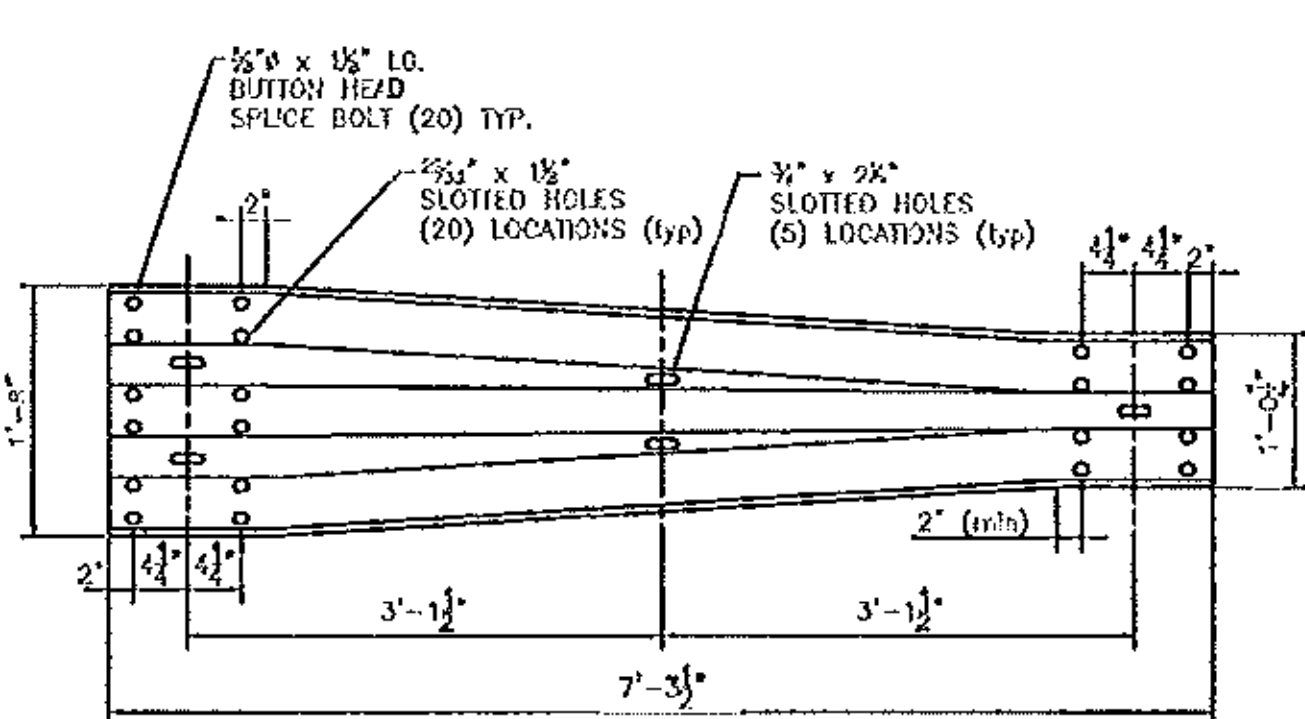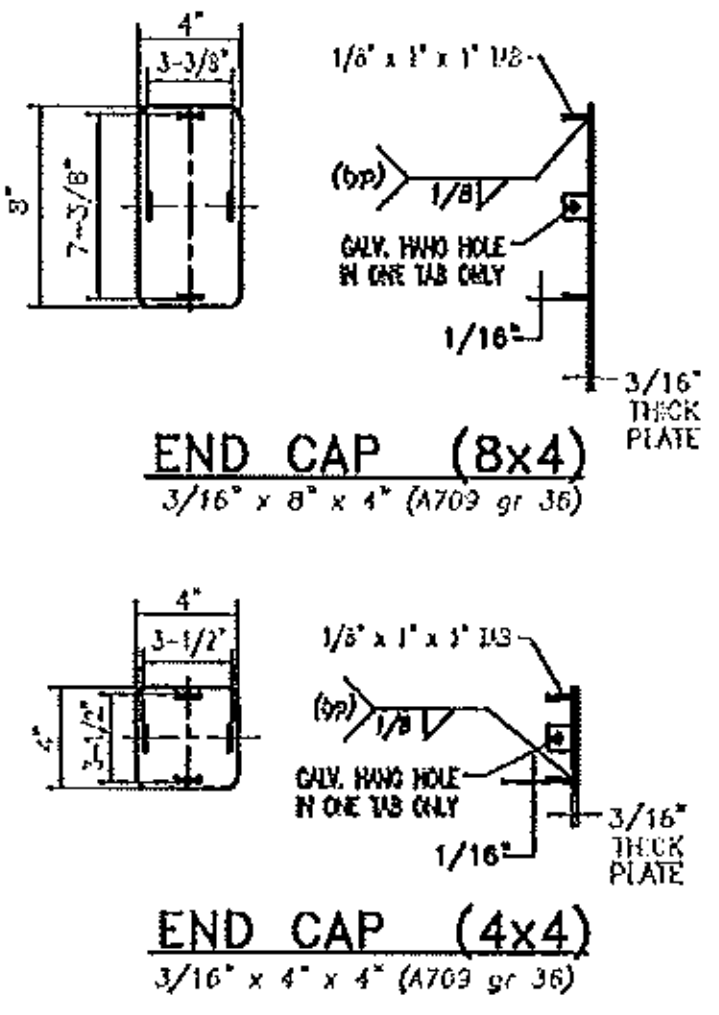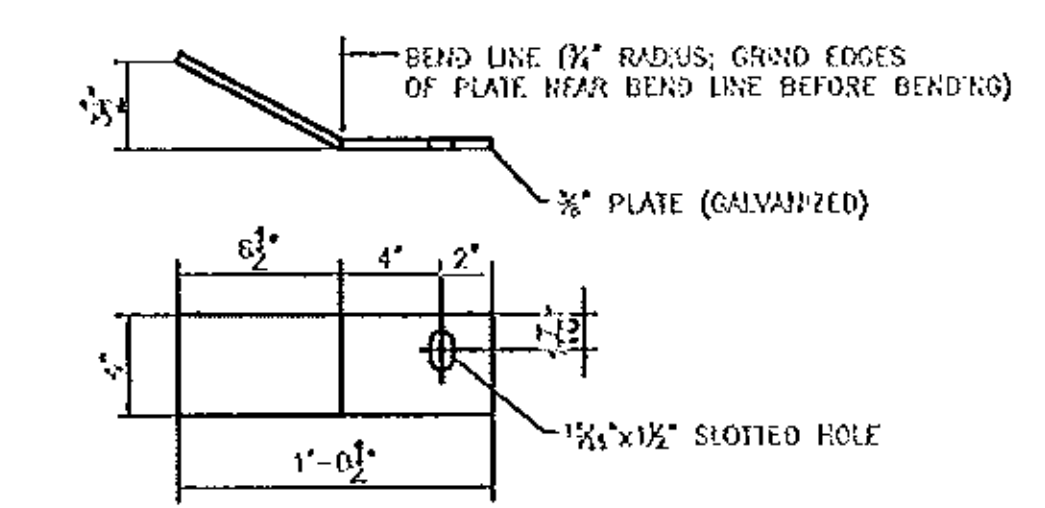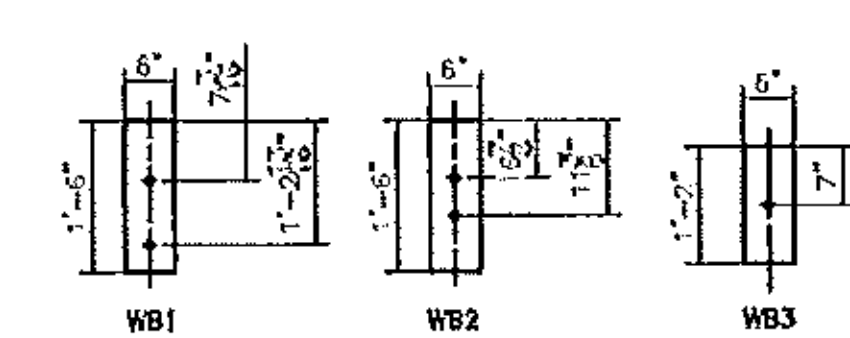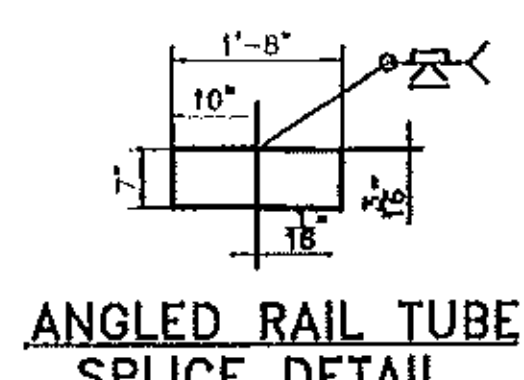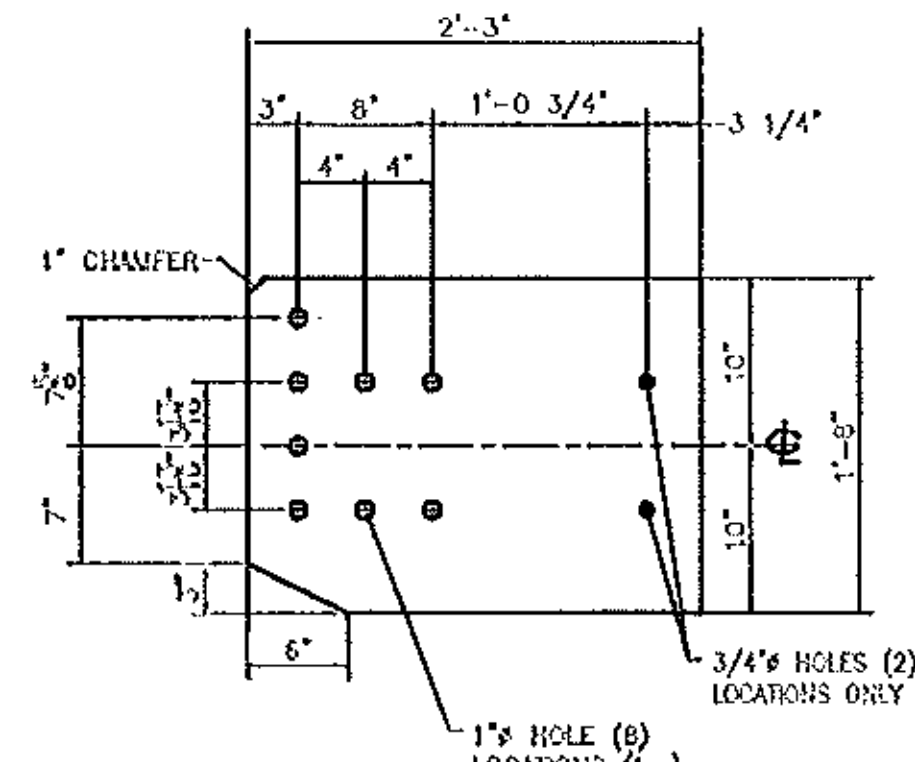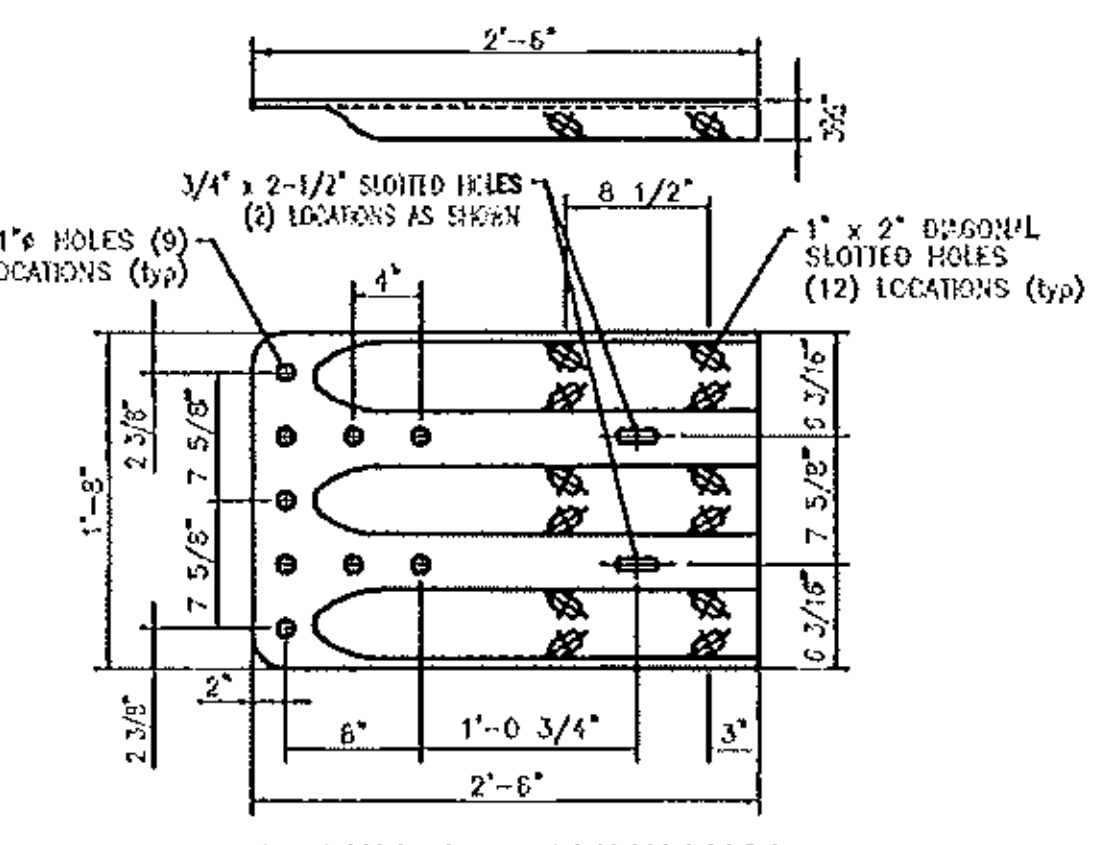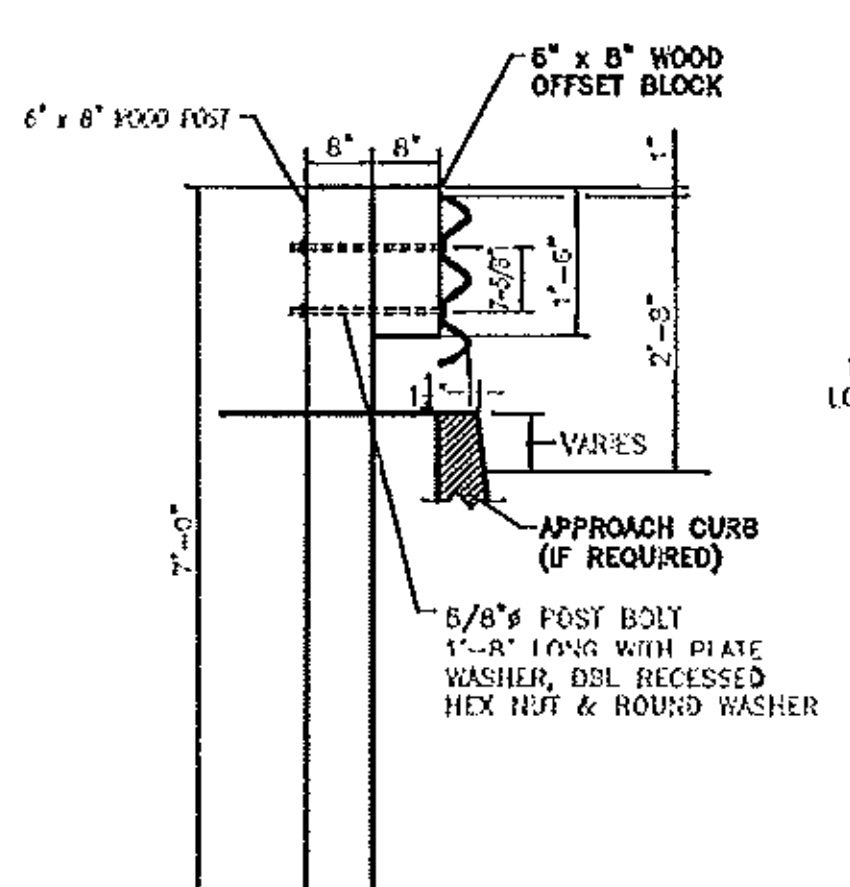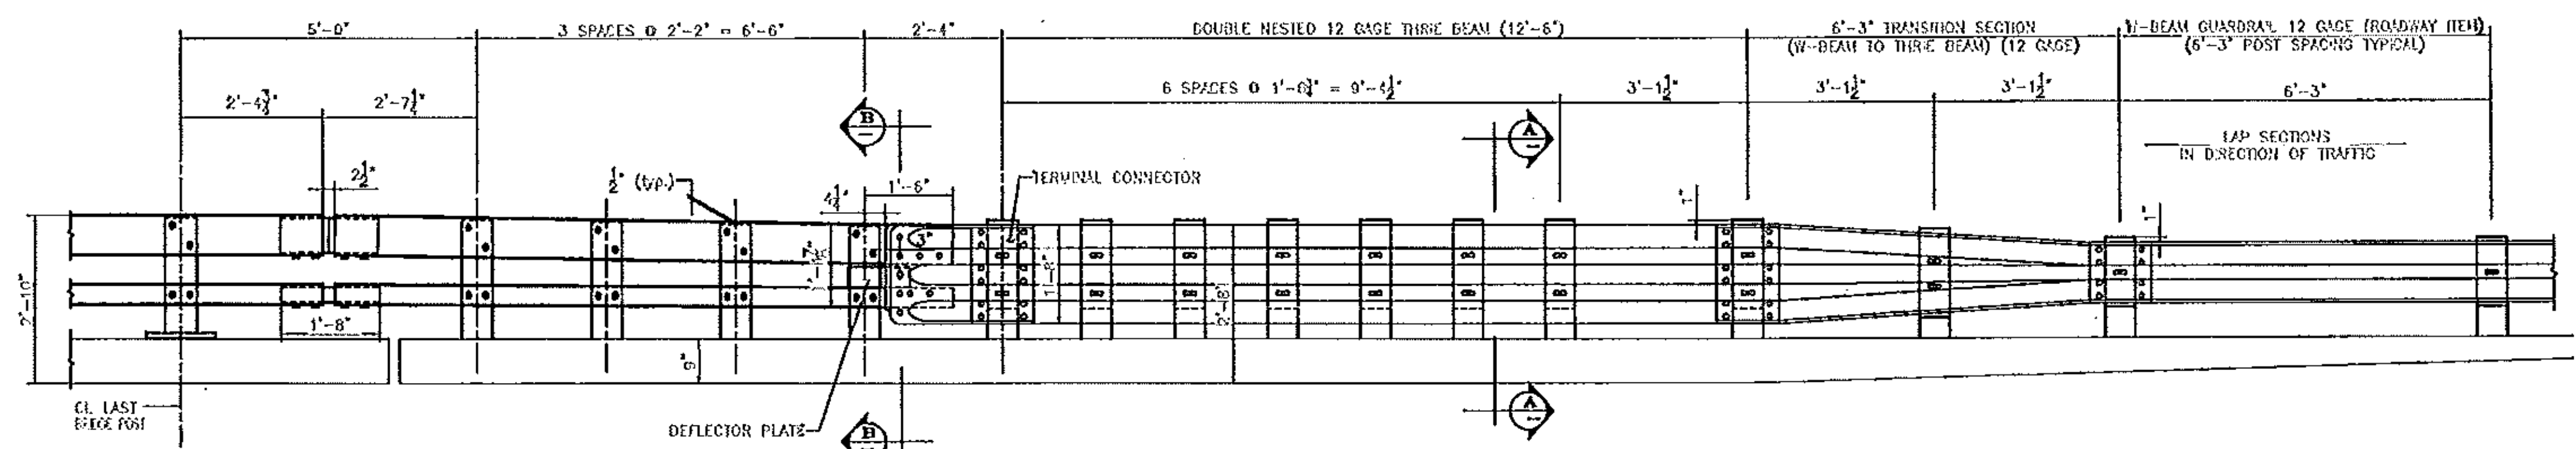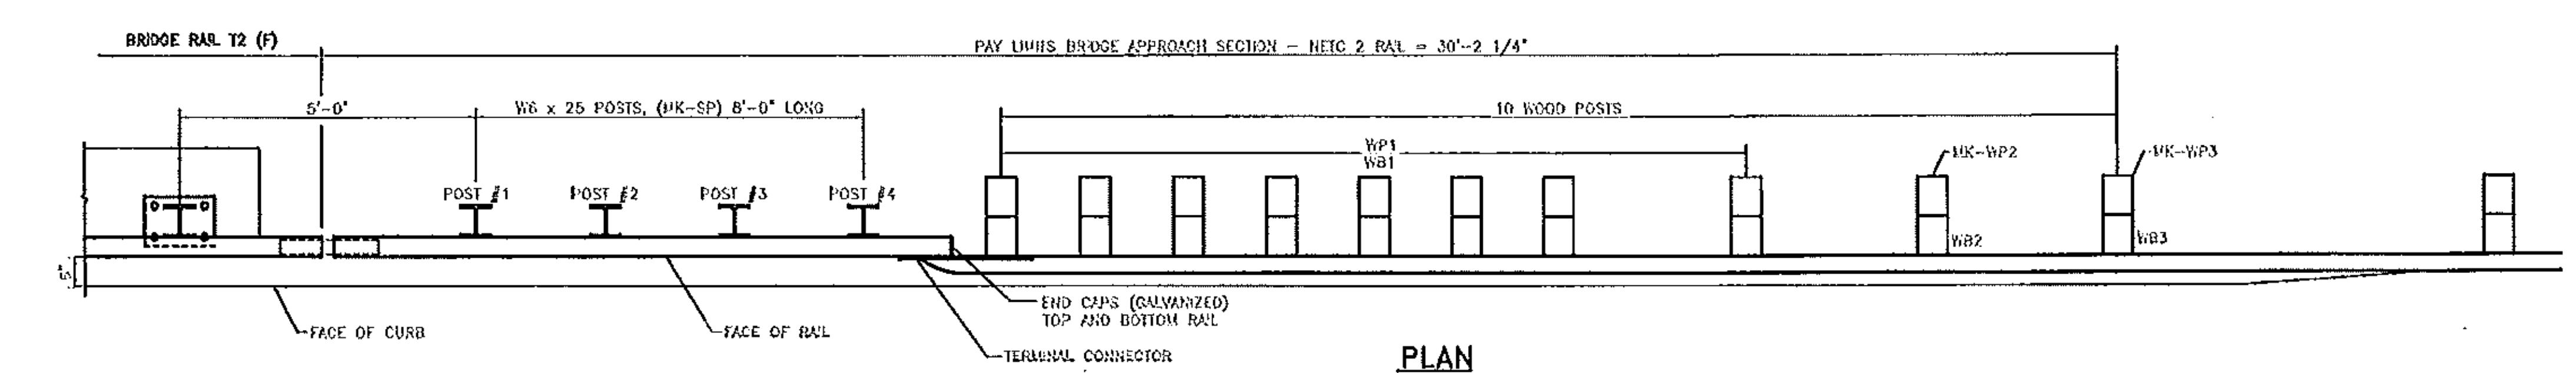

**STEEL POST CHART**

No.	L
#1	1'-3.125"
#2	1'-2.875"
#3	1'-2.625"
#4	1'-2.437"

**REVISIONS**

No.	Remarks	Date
0	Initial submittal	

**BILL OF MATERIAL (2 APPROACHES)**

MK.	Qty.	Description	Size/Shape	Qty. (2)	Material
2	2	UPPER APPROACH RAIL	TS 6x4x0.313"	10'-4.750'	A500 Gr. B
2	2	LOWER APPROACH RAIL	TS 4x4x0.25"	10'-4.750'	A500 Gr. B
SP	8	STEEL POST	W6 x 25	8'-0"	A307 Gr. 50
WP1	16	WOOD POST	6" x 8"	7'-0"	1550R
WP2	2	WOOD POST	6" x 8"	7'-0"	1550R
WP3	2	WOOD POST	6" x 8"	7'-0"	1550R
WB1	16	WOOD BLOCK	6" x 8"	1'-6"	1550R
WB2	2	WOOD BLOCK	6" x 8"	1'-6"	1550R
WB3	2	WOOD BLOCK	6" x 8"	1'-2"	1550R
2	2	ANGLED SPlice TUBE FOR TS 6x4x0.313"			
2	2	TUBE	TS 2x2x0.25"	1'-6"	A500 Gr. B
4	4	WELDED LOCK NUTS	0.625"		A533 Gr. A
2	2	SPlice TUBE FOR TS 4x4x0.250"			
2	2	TUBE	TS 3x3x0.313"	1'-8"	A500 Gr. B
4	4	WELDED LOCK NUTS	0.625"		A533 Gr. A
2	2	TERMINAL CONNECTOR	10 Gs.	2'-6"	M180
2	2	CONNECTION PLATE	0.375" x 1'-3"	2'-3"	A709 Gr. 36
2	2	END CAP FOR TS 6x4 RAIL TUBE			
2	2	PLATE	0.188" x 4"	6"	A709 Gr. 36
8	8	PLATE	0.125" x 1"	1"	A709 Gr. 36
2	2	END CAP FOR TS 4x4 RAIL TUBE			
2	2	PLATE	0.188" x 4"	4"	A709 Gr. 36
8	8	PLATE	0.125" x 1"	1"	A709 Gr. 36
7	7	DEFLECTOR PLATE (LEFT)	0.625"		A709 Gr. 36
1	1	DEFLECTOR PLATE (RIGHT)	0.375" x 1'	125"	A709 Gr. 36
2	2	0.75" x 2" LG. ROUND HEAD BOLT W/NUT			A307
2	2	THREE TRANSITION PANEL	12 Gs.	7'-3.50"	M180 A2
4	4	THREE BEAM	12 Gs.	12'-6"	M180 A2
46	46	0.75" x 6" ROUND HEAD BOLT W/NUT & ROUND WASHER			A307
4	4	0.625" x 20" LG. POST BOLT W/SL. RECESSED NUT, PLATE & ROUND WASHER			A307
34	34	0.625" x 18" LG. POST BOLT W/SL. RECESSED NUT, PLATE & ROUND WASHER			A307
16	16	0.625" x 1.75" LG. CAP SCREW W/WASHER			A325
64	64	0.625" x 1.25" LG. PANEL SPlice BOLT W/DBL. RECESSED NUT			A307
16	16	0.75" x 0.5" LG. (SCH 40) SPACER PIPE			A53

- NOTES:**
- PAYMENT FOR GUARDRAIL APPROACH SECTION - GALVANIZED NETC 2 RAIL SHALL INCLUDE THE TERMINAL CONNECTOR, THE CONNECTION PLATE, THE DEFLECTOR PLATE, RAIL, POSTS, BLOCKS AND ATTACHMENT HARDWARE.
  - REFLECTIVE MATERIAL SHALL MEET REQUIREMENTS OF SUBSECTION 750.03 AND SHALL BE A 0.063" ALUMINUM BACKING WHITE OR YELLOW REFLECTOR. WHITE IS TO BE INSTALLED ON THE DRIVER'S RIGHT. FOR ONE-WAY BRIDGES, YELLOW IS TO BE INSTALLED ON THE DRIVER'S LEFT.
  - ALL APPROACH RAIL SPICES SHALL BE LAPPED IN THE DIRECTION OF TRAFFIC FLOW.
  - ALL APPROACH RAIL MATERIALS, DIMENSION SIZES AND NOTES SHALL BE THE SAME AS THOSE OF THE BRIDGE RAIL, UNLESS OTHERWISE NOTED.
  - APPROACH RAIL BOLTS SHALL BE ASTM A307 GRADE A AND NUTS SHALL BE ASTM A325 (ASTM 563 GRADE A OR BETTER (GALVANIZED). WASHERS SHALL BE ASTM F434.
  - WELD TOP SPlice BAR TO FIT BEND. USE COMPLETE PENETRATION WELD (B-U2).

Vermont Agency of Transportation  
**RECEIVED**  
 CK'D BY GFR OK'D BY CAM  
 05/31/2012

RESUBMIT APPROVED X  
 BY C. CARLSON DATE 07/02/2012

**HIGHWAY SAFETY CORP**  
 GLASTONBURY, CT  
 860-633-8445

ITEM 621.72 NETC 2 RAIL BRIDGE APPROACH  
 VT RT 9  
 TOWN OF WOODFORD  
 COUNTY OF BENNINGTON, VERMONT  
 PROJECT NO. ER BHF 010-1(44)

CERTIFIED FABRICATOR  
 1881

CONTRACTOR  
 T BUCK CONSTRUCTION  
 4 of 4

DATE 05-31-12

**Roy, Gaston**

---

**From:** Abel, Leigh [label@gpinet.com]  
**Sent:** Monday, July 02, 2012 11:03 AM  
**To:** Roy, Gaston; Carlson, Carolyn  
**Cc:** Lemaire, Ron  
**Subject:** Woodford Bridge Bridge Rail Post measurements

Gaston and Carolyn

Ron and I re-measured the bridge rail posts based on stationing. Hopefully this improves the accuracy for their locations. In addition I counted the posts from the first post on the East end of the bridge to the last post we are keeping to make sure the posts in question can be identified going forward.

North side of bridge (station left)

Post # 25 location is Sta. <sup>66+08.23</sup>66+08:77 lt (91 ft 9-1/4" west of sta 67+00)

South side of bridge (station right)

Post # 19 location is Sta. 66+07:31 rt (92 ft 3-3/4" west of sta 67+00)

Hope this helps. <sup>66+07.69</sup>

PS Carolyn do you know the status of the Traffic Control Plan in for review. I haven't seen anything more on it. It was submitted on June 21st.

Thanks  
**Leigh Abel**  
Senior Inspector  
**GPI / Greenman-Pedersen, Inc.**  
Engineering and Construction Services  
Woodford ER BHF 010-1(44) Field Office  
c: (518) 466-6130  
p: (802) 681-7181  
f: (802) 681-7242  
Email: [label@gpinet.com](mailto:label@gpinet.com)  
Web Address: [www.gpinet.com](http://www.gpinet.com)

*An Equal Opportunity Employer*

---

This communication and any attachments are intended only for the use of the individual or entity named as the addressee. It may contain information which is privileged and/or confidential under applicable law. If you are not the intended recipient or such recipient's employee or agent, you are hereby notified that any dissemination, copy or disclosure of this communication is strictly prohibited and to notify the sender immediately.

**Roy, Gaston**

---

**From:** Abel, Leigh [label@gpinet.com]  
**Sent:** Friday, June 29, 2012 7:37 AM  
**To:** Roy, Gaston; Carlson, Carolyn  
**Cc:** Lemaire, Ron; Gilmore, Judy  
**Subject:** Woodford ER BHF 010 - 1(44) Bridge Rail Field Measurements

Mr. Roy

Carolyn asked that we make some field measurements regarding the existing bridge rail and contact you directly with the results.

here is what we found.

South side of bridge

Distance from cl first post left after demo to cl bearing pier #1 = 55.4 ft  
Distance from cl first post left after demo to first up station splice in rail = 17.6 ft

North side of bridge

Distance from cl first post left after demo to cl bearing pier #1 = 11.6 ft  
Distance from cl first post left after demo to first up station splice in rail = 25.7 ft

Please let us know if there are any other questions you might have that we can help you with.


PS...for Carolyn ..visual inspection under the bridge found no cracking.

**Leigh Abel**  
Senior Inspector  
**GPI / Greenman-Pedersen, Inc.**  
Engineering and Construction Services  
Woodford ER BHF 010-1(44) Field Office  
c: (518) 466-6130  
p: (802) 681-7181  
f: (802) 681-7242  
Email: [label@gpinet.com](mailto:label@gpinet.com)  
Web Address: [www.gpinet.com](http://www.gpinet.com)

*An Equal Opportunity Employer*

---


This communication and any attachments are intended only for the use of the individual or entity named as the addressee. It may contain information which is privileged and/or confidential under applicable law. If you are not the intended recipient or such recipient's employee or agent, you are hereby notified that any dissemination, copy or disclosure of this communication is strictly prohibited and to notify the sender immediately.

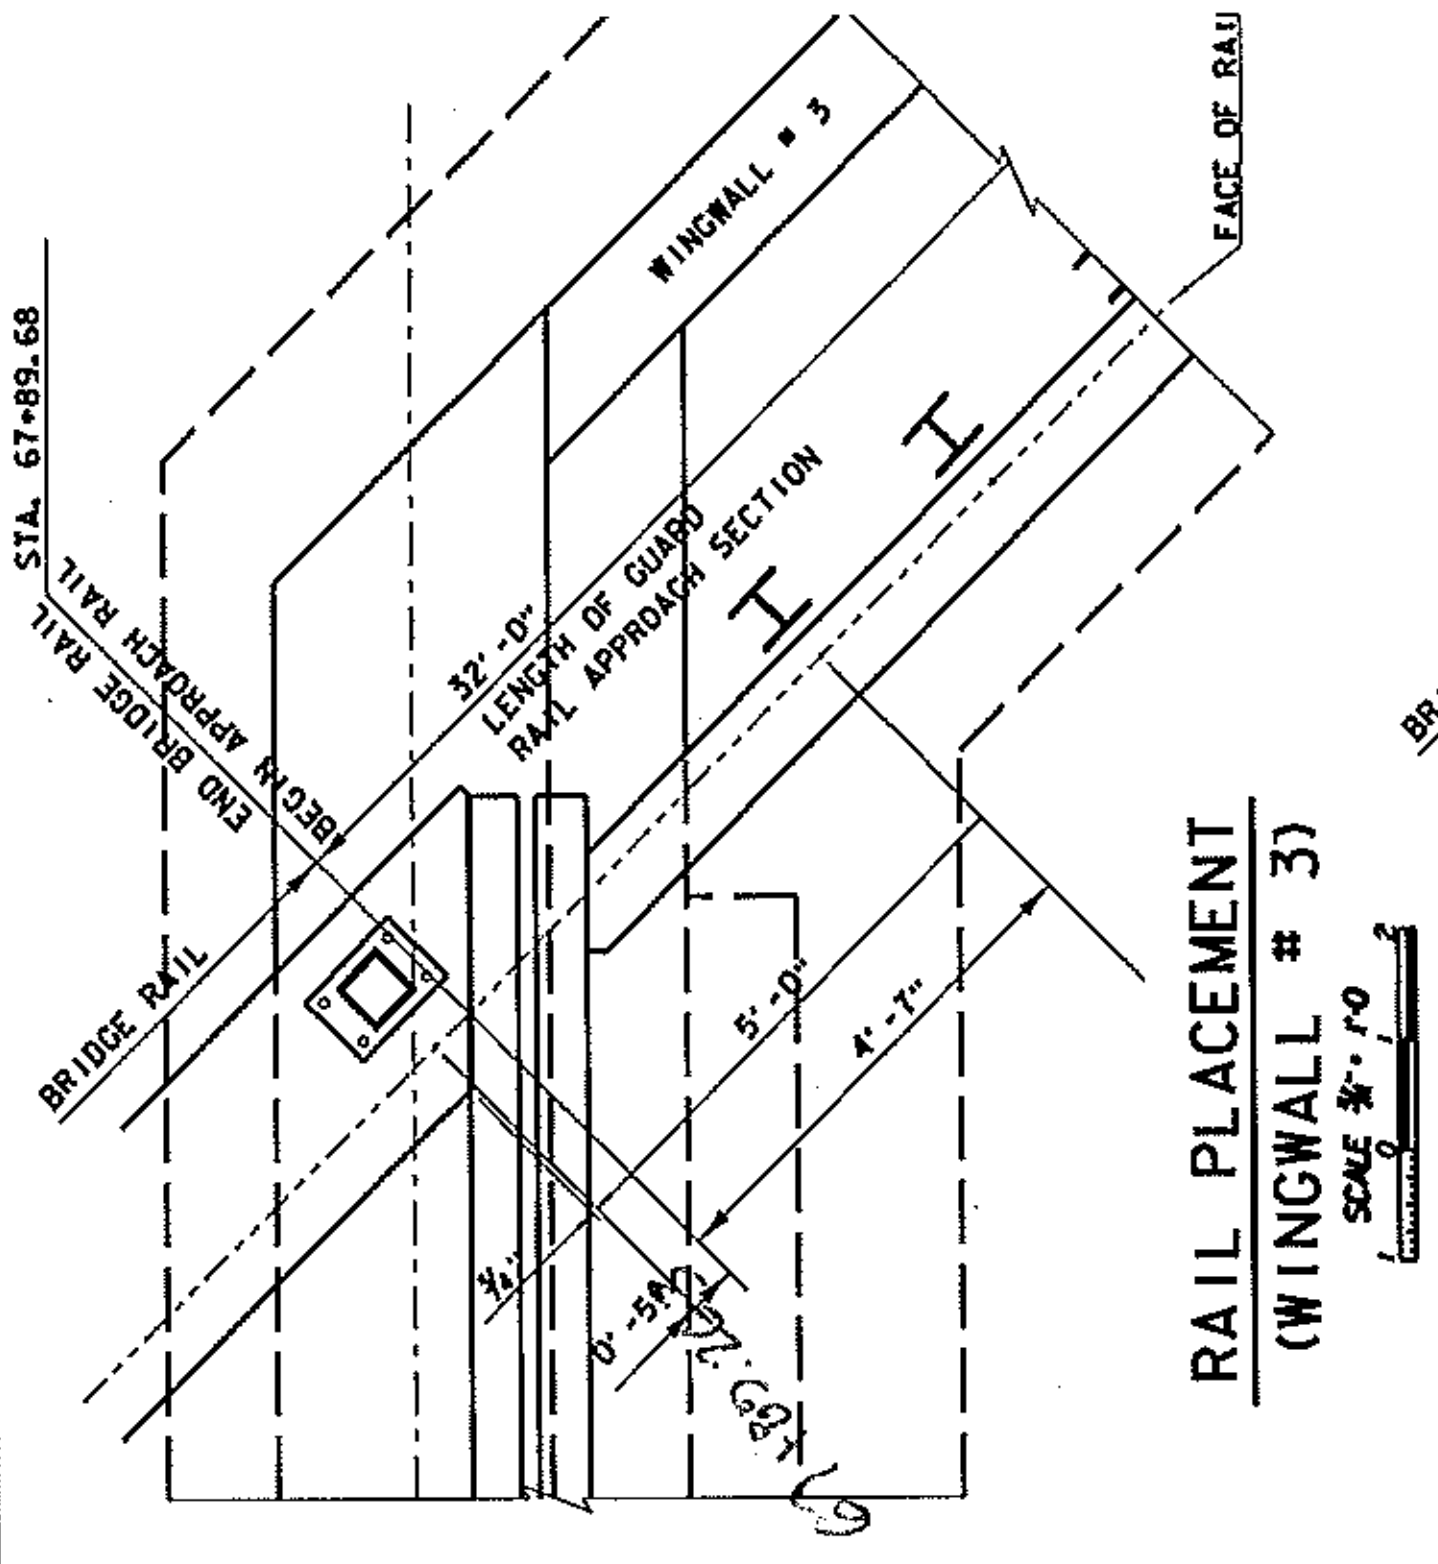

RAIL PLACEMENT  
(WINGWALL # 3)  
SCALE 3/8" = 1'-0"

27.11.14


27.11.14

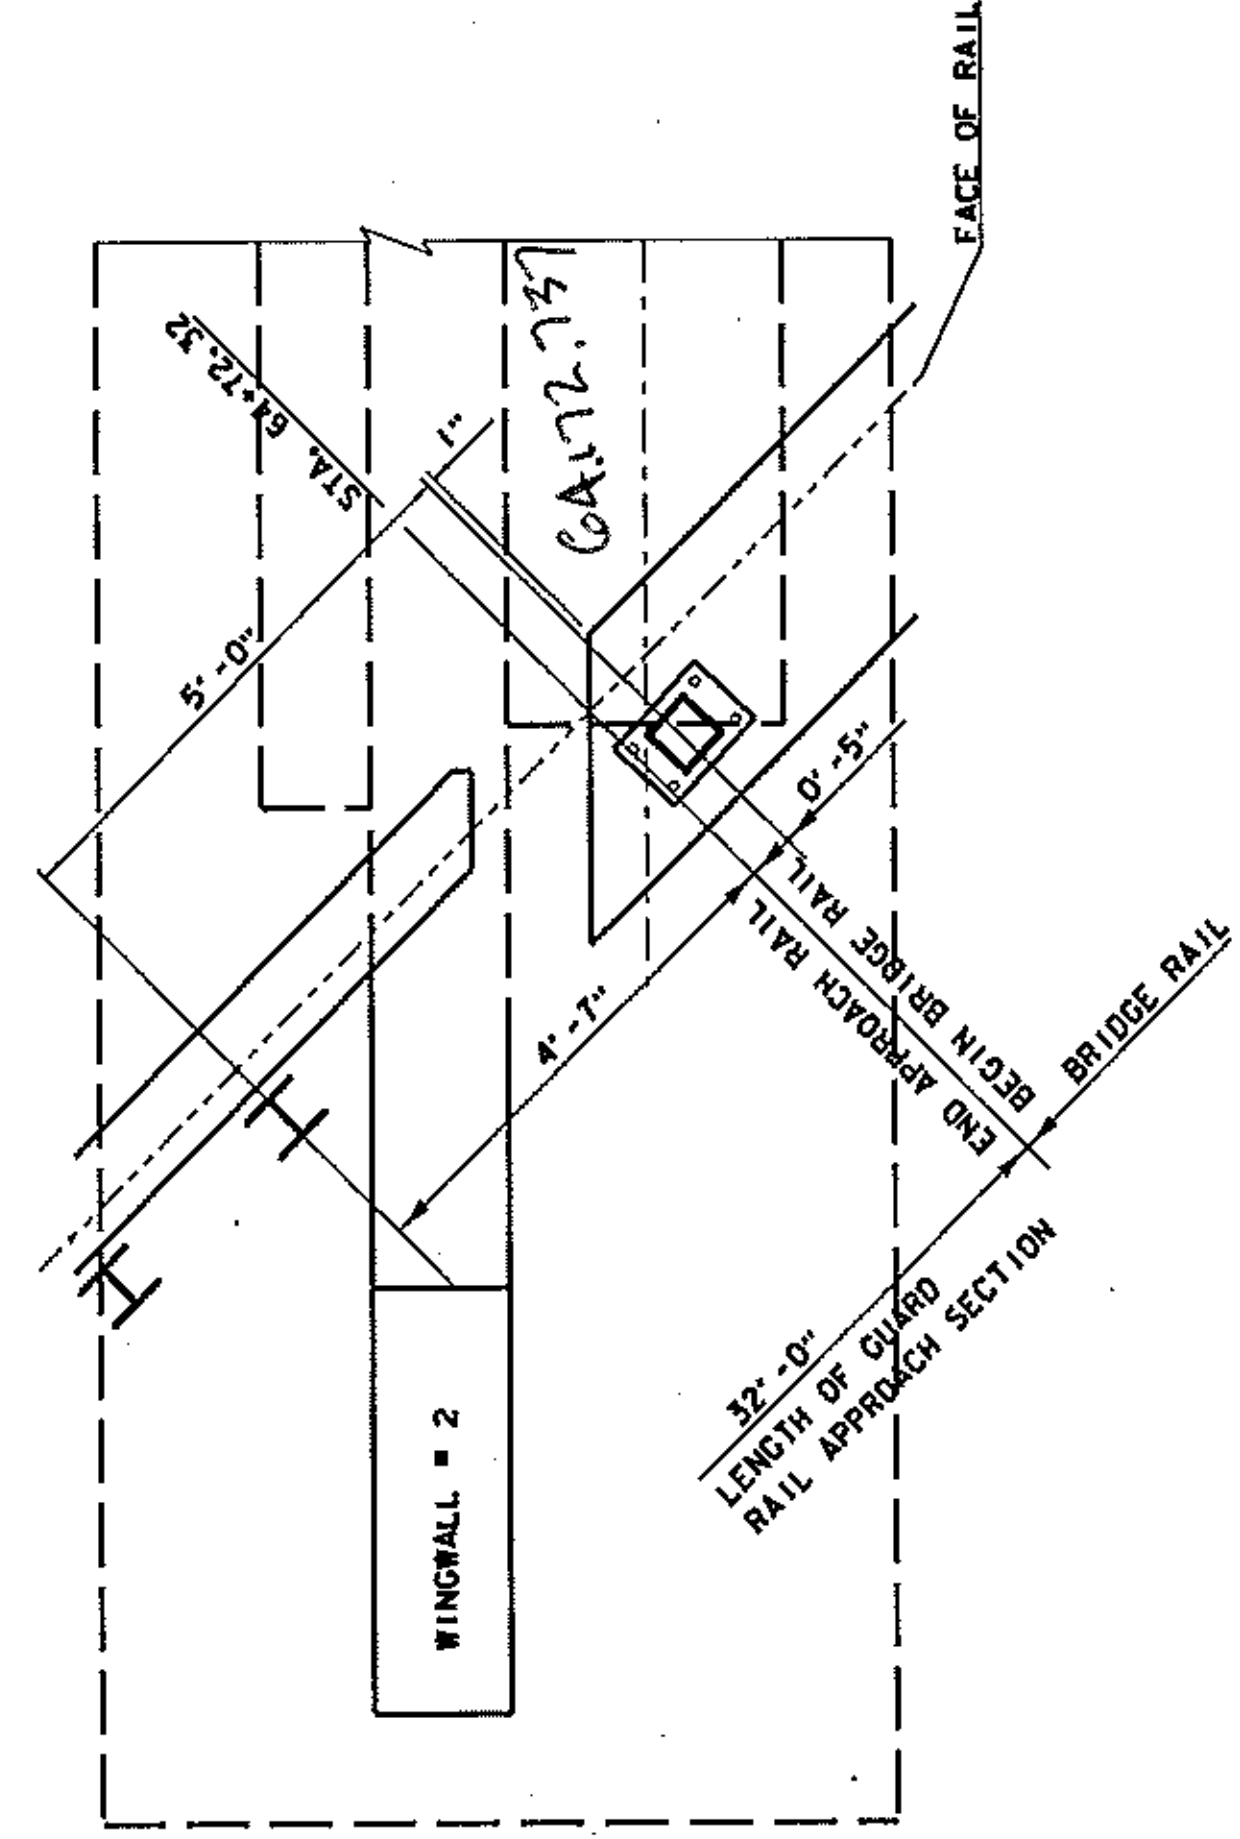

RAIL PLACEMENT  
(WINGWALL # 1)  
SCALE 3/8" = 1'-0"

27.11.14

27.11.14

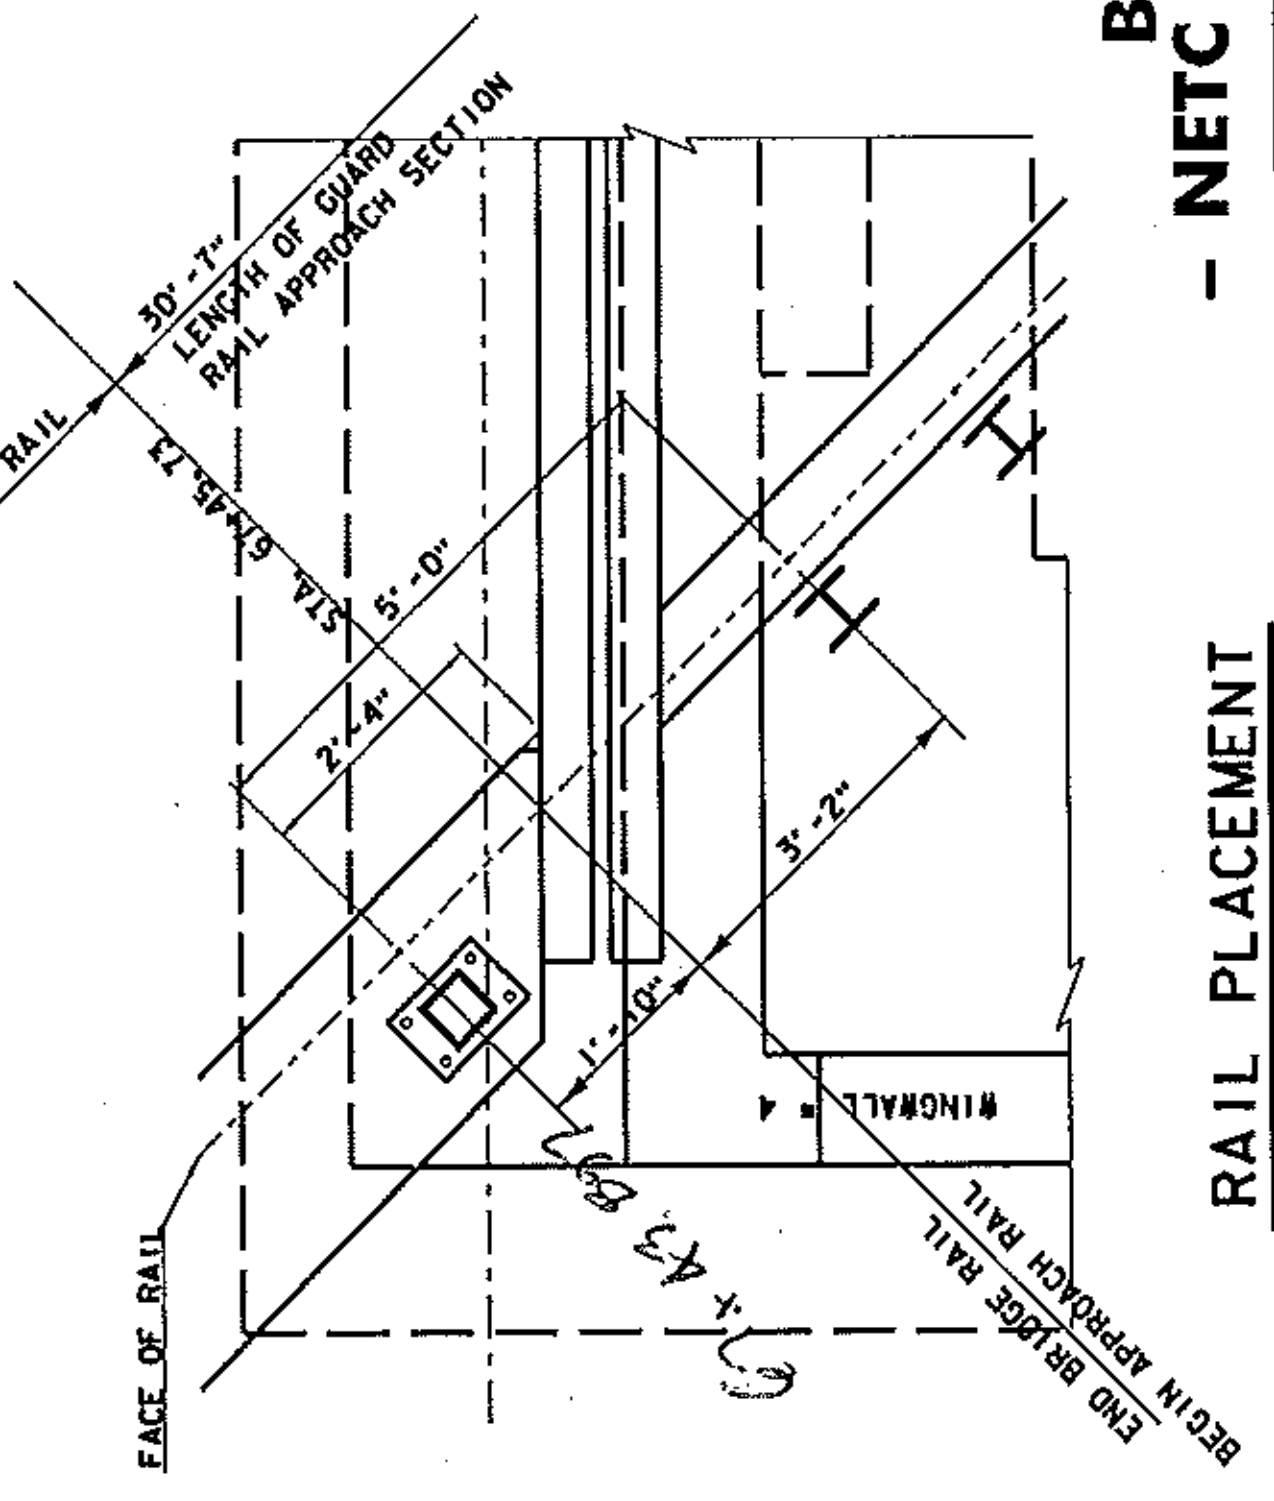

RAIL PLACEMENT  
(WINGWALL # 4)  
SCALE 3/8" = 1'-0"

2006

2006


RAIL PLACEMENT  
(WINGWALL # 2)  
SCALE 3/8" = 1'-0"

2006

2006

BRIDGE  
- NETC 2 R

PROJECT NAME: W  
PROJECT NUMBER: B1  
FILE NAME: /B40037/4  
PROJECT LEADER: A. PI  
DESIGNED BY: MEY


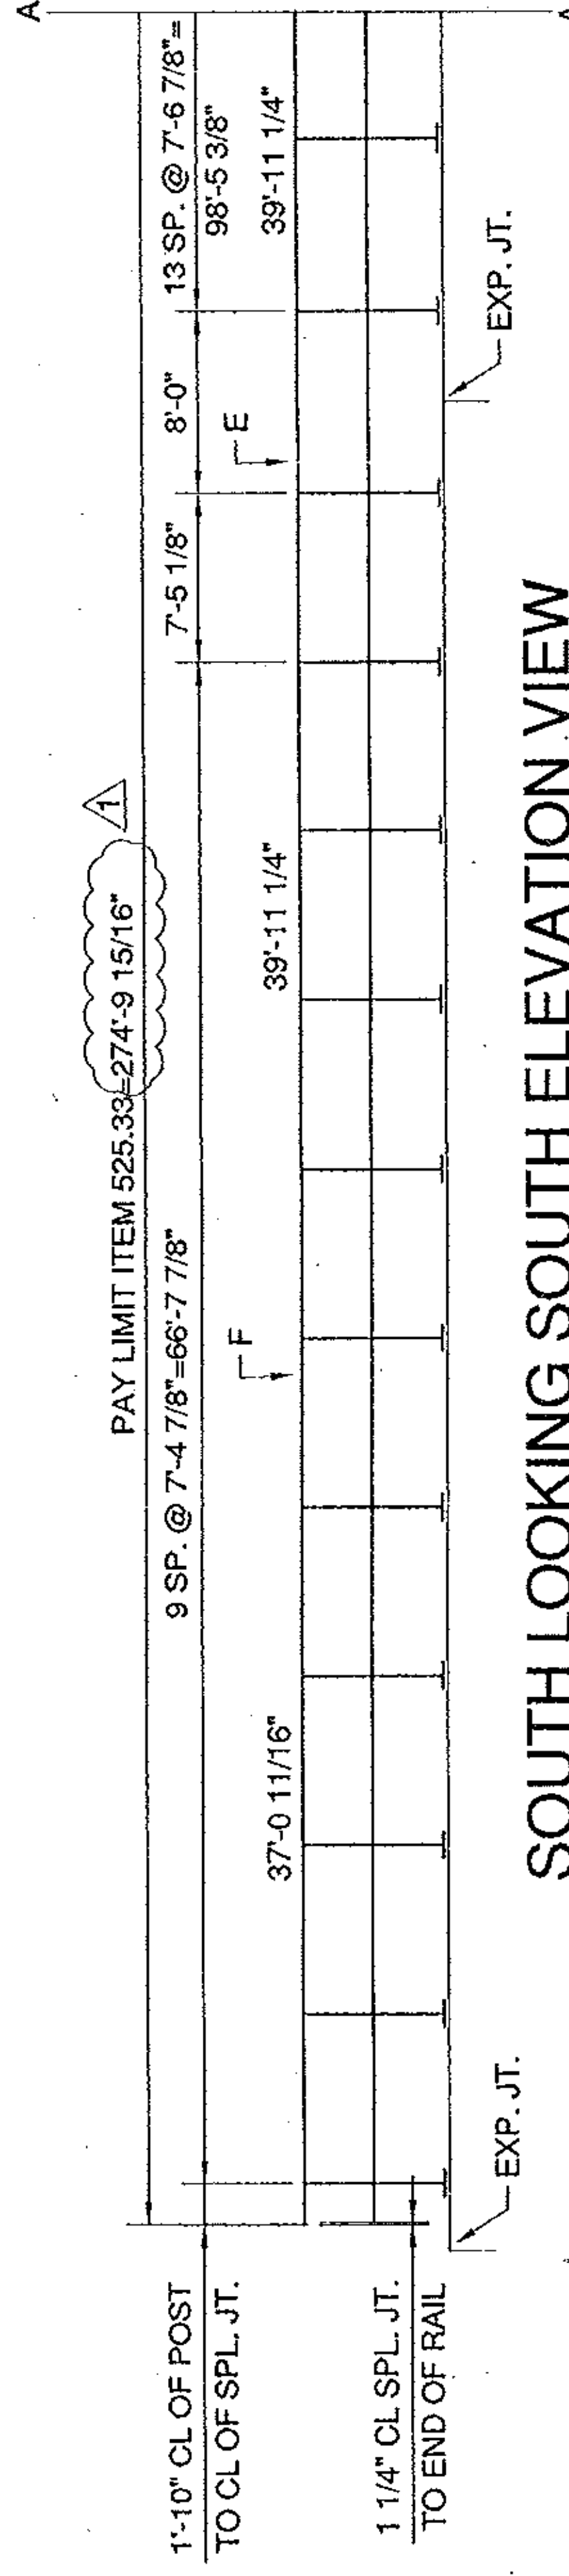


PAY LIMIT ITEM 525.33-274-9 15/16"

**SOUTH LOOKING SOUTH ELEVATION VIEW  
(2 RAIL POSTS W/ANCHORAGE)**


AS2

KEY  
F=3/4" FXD. SPL. JT.  
E=2 1/2" EXP. SPL. JT.

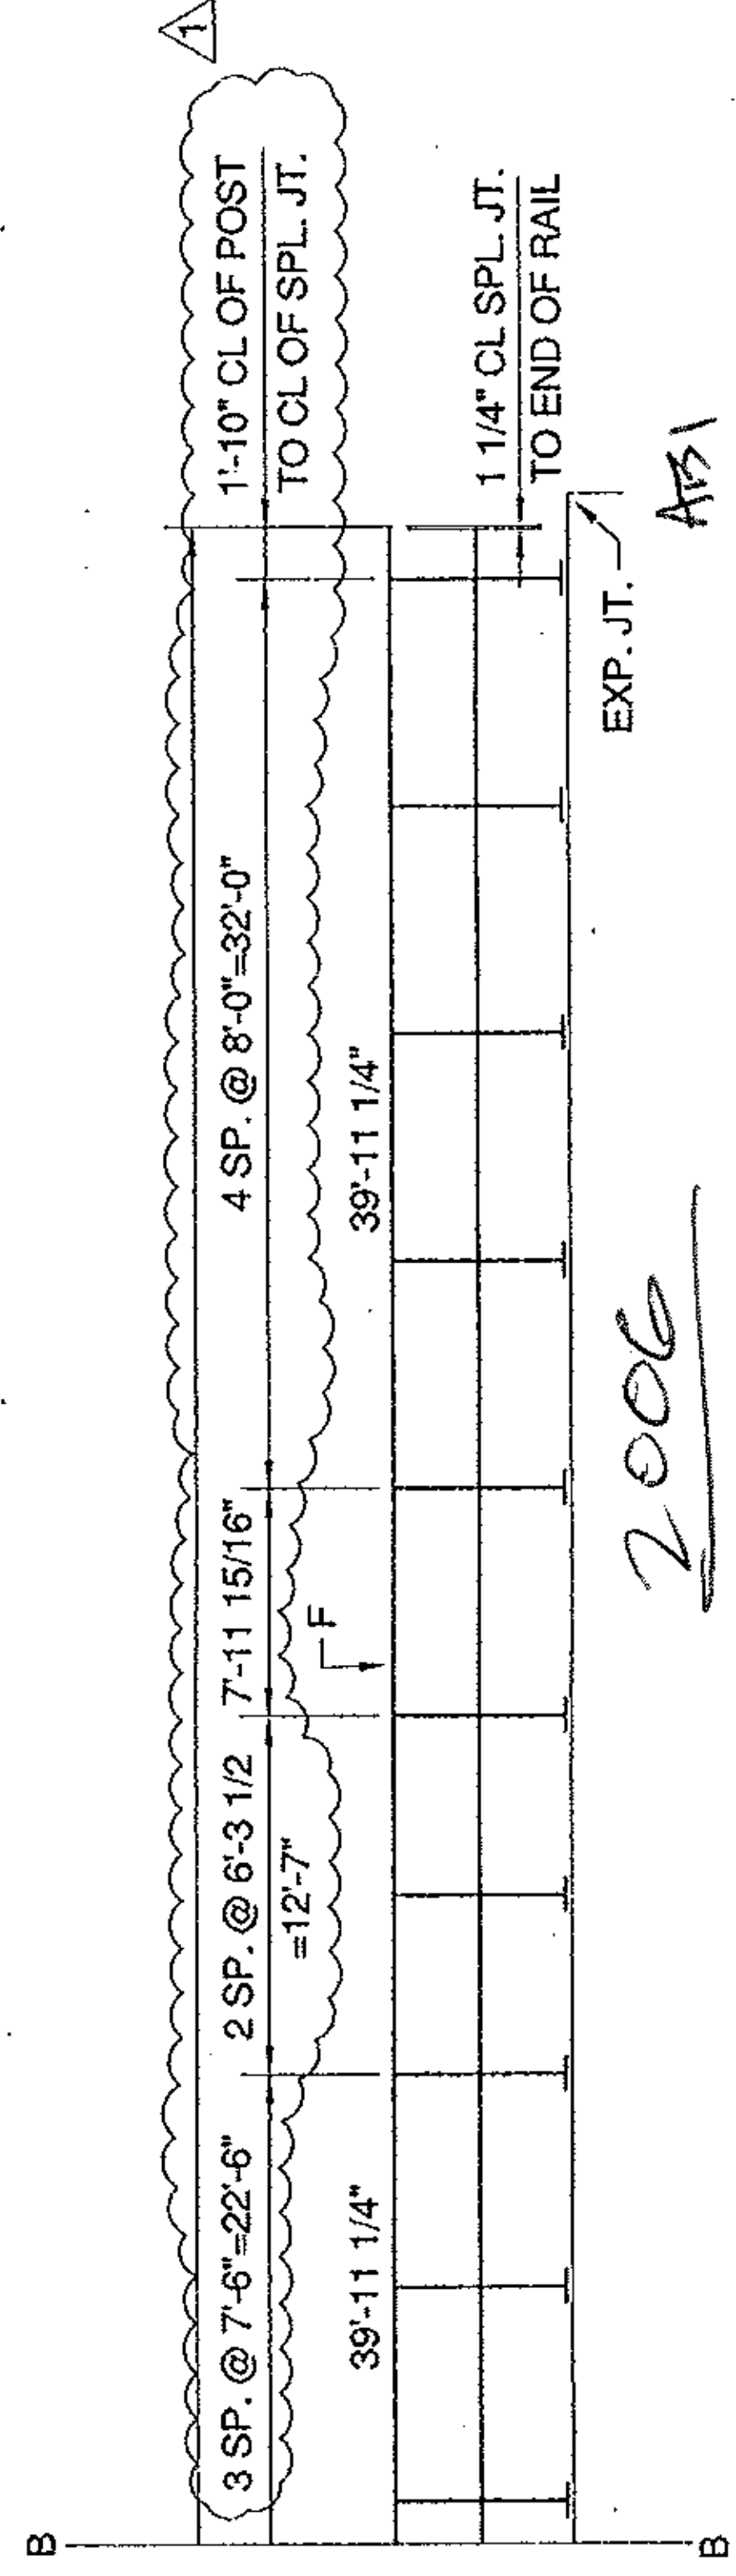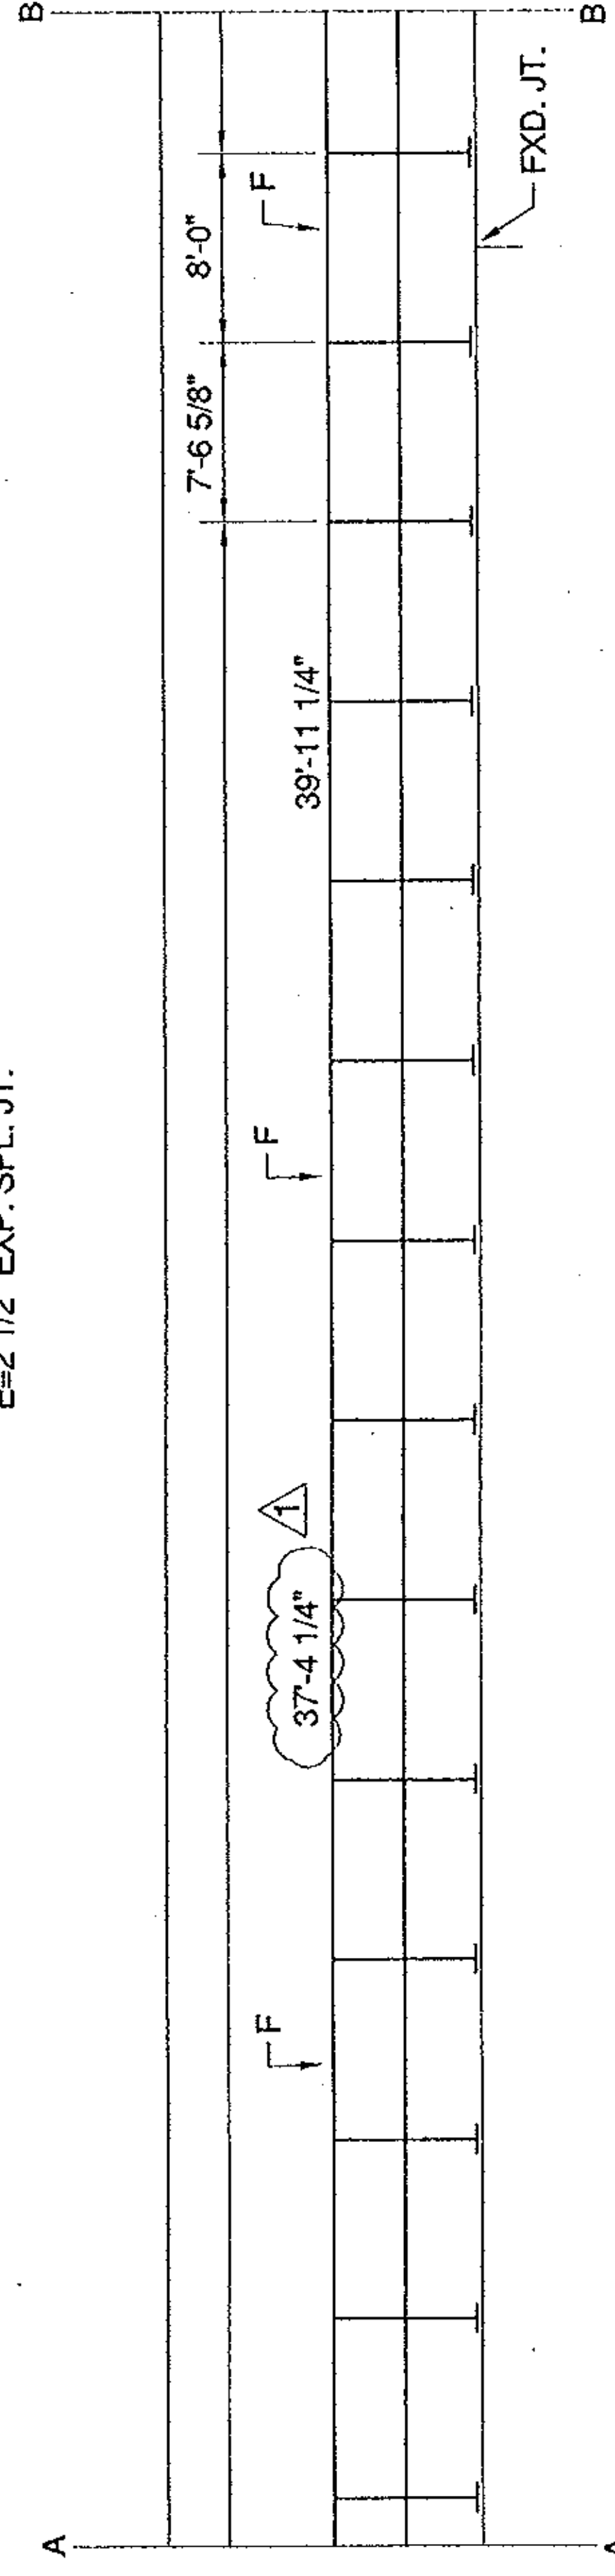

2006



AS1

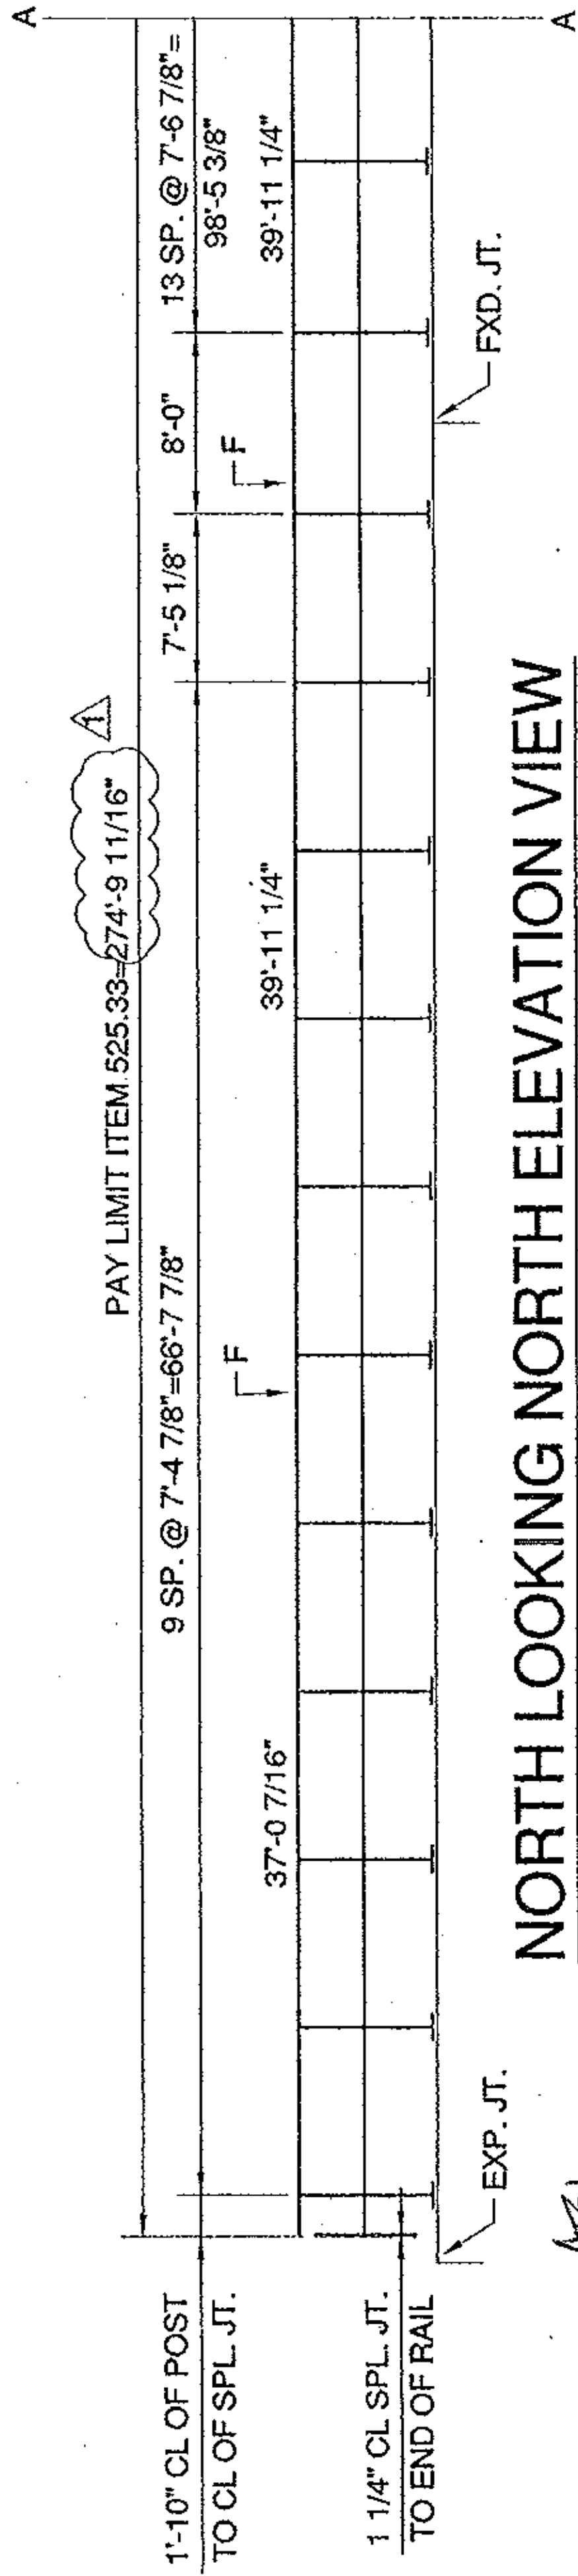

**NORTH LOOKING NORTH ELEVATION VIEW  
(2 RAIL POSTS W/ANCHORAGE)**


AB1

KEY  
 F=3/4" FXD. SPL. JT.  
 E=2 1/2" EXP. SPL. JT.

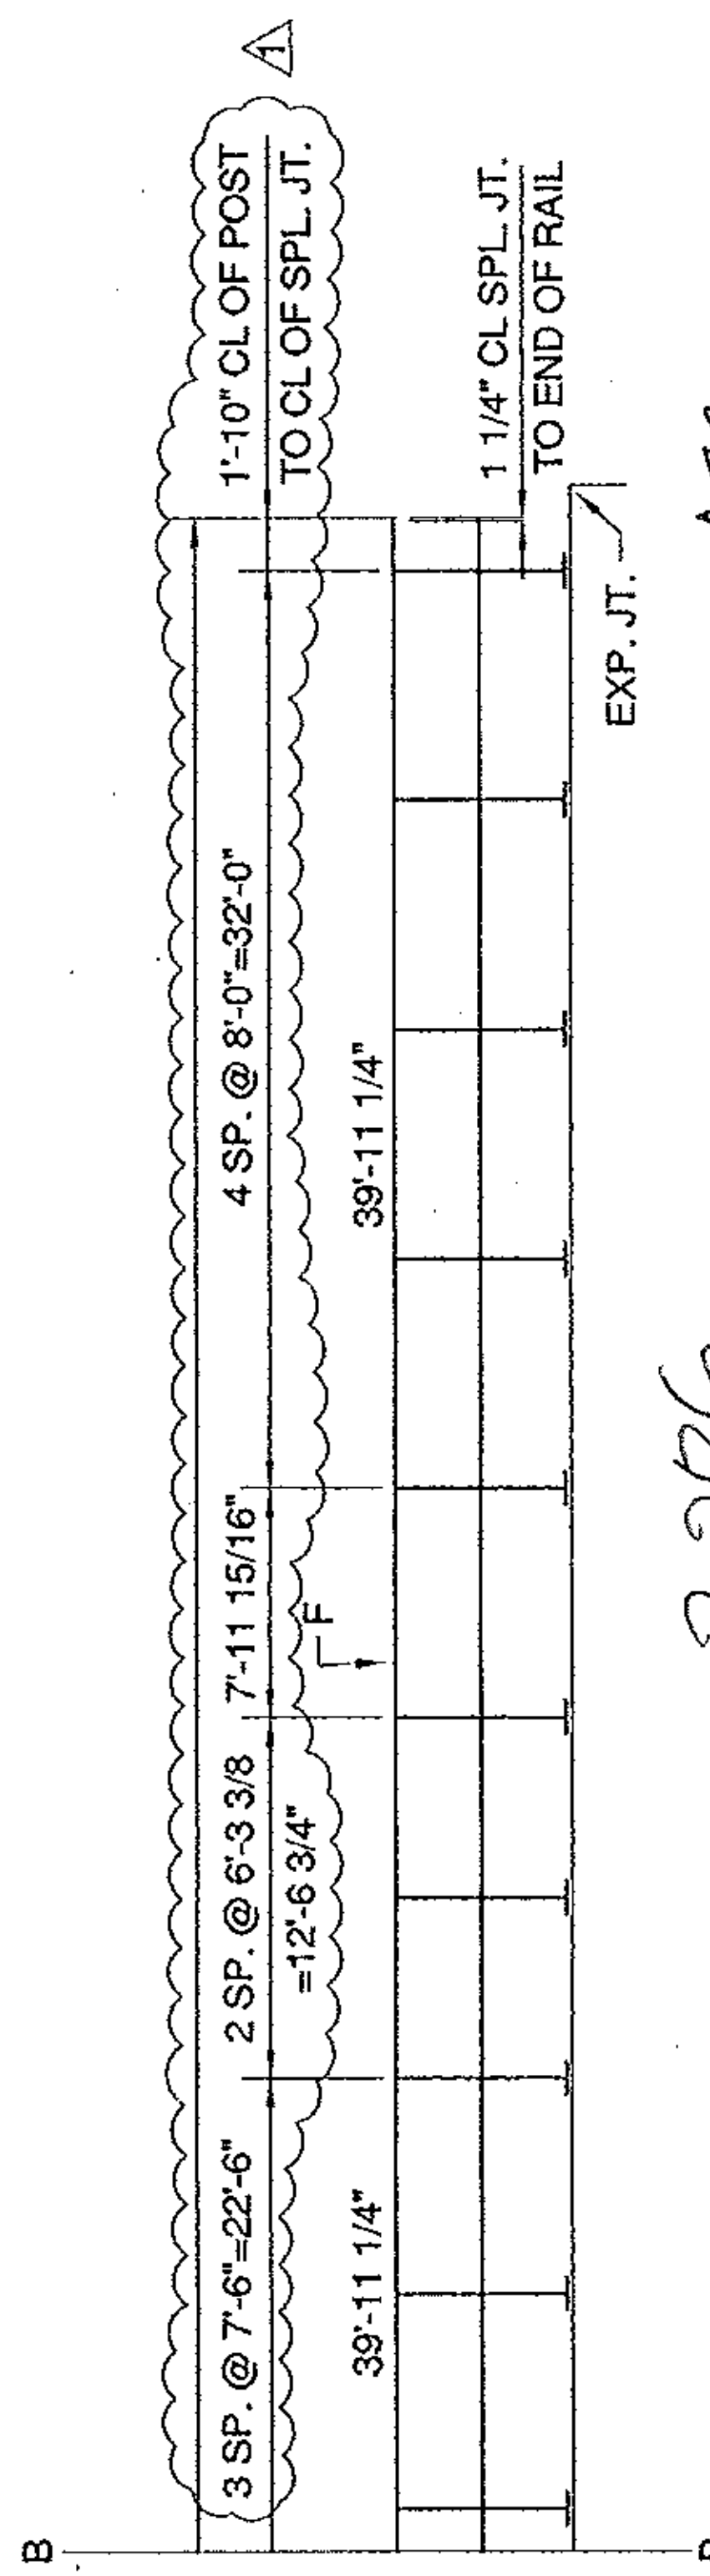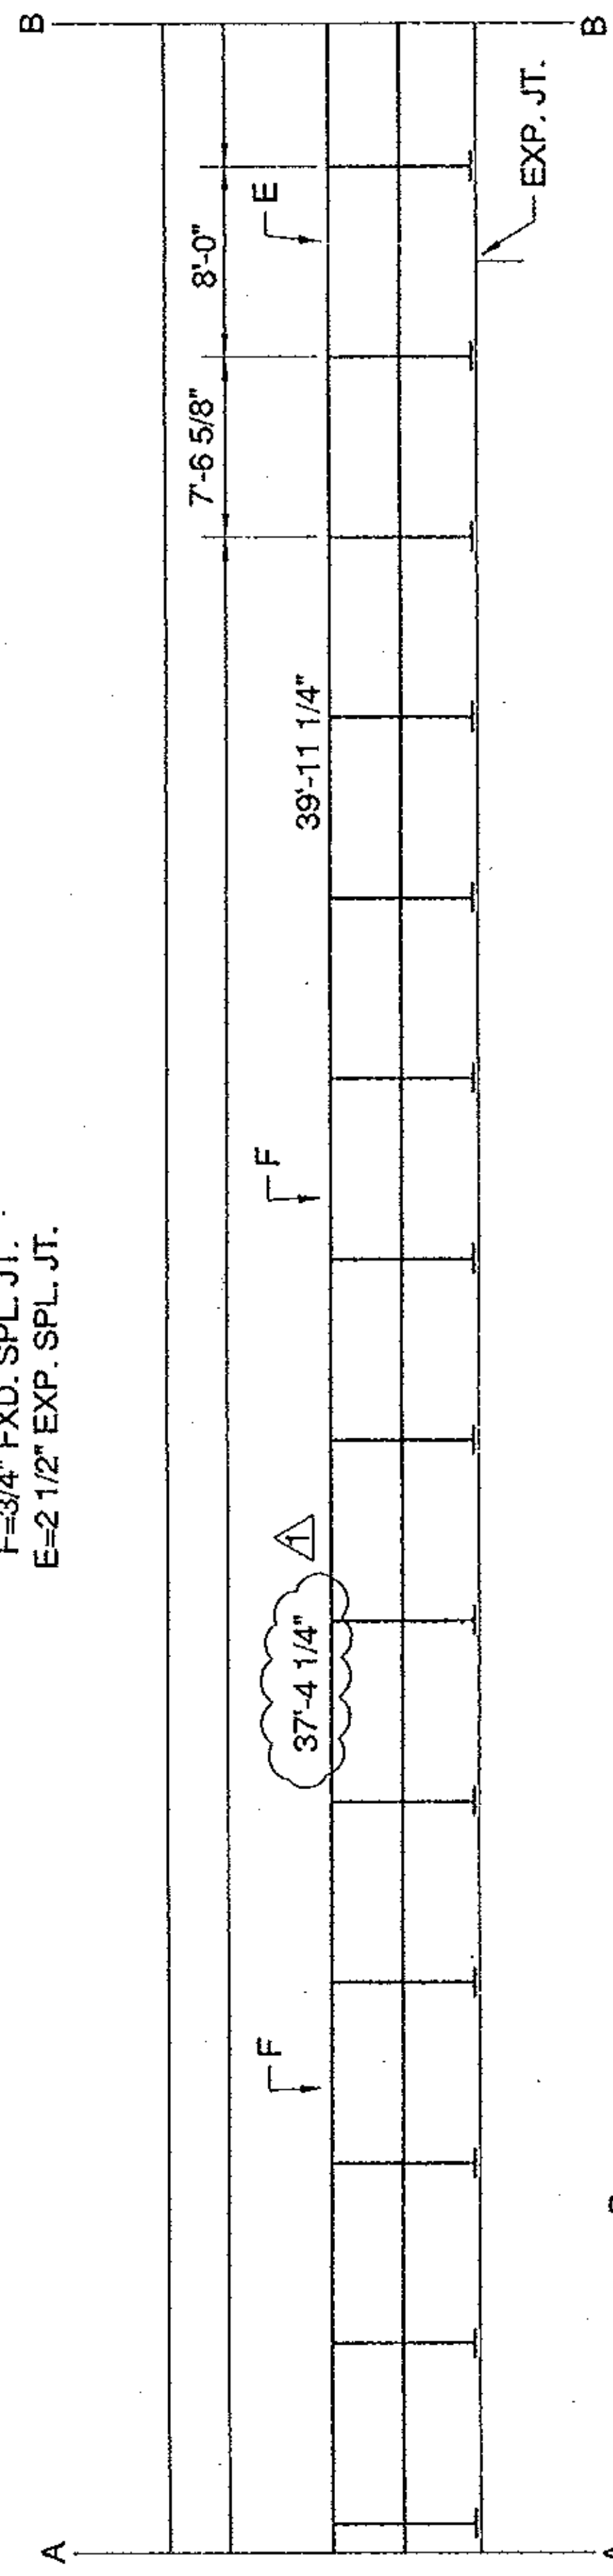

2006

AB2

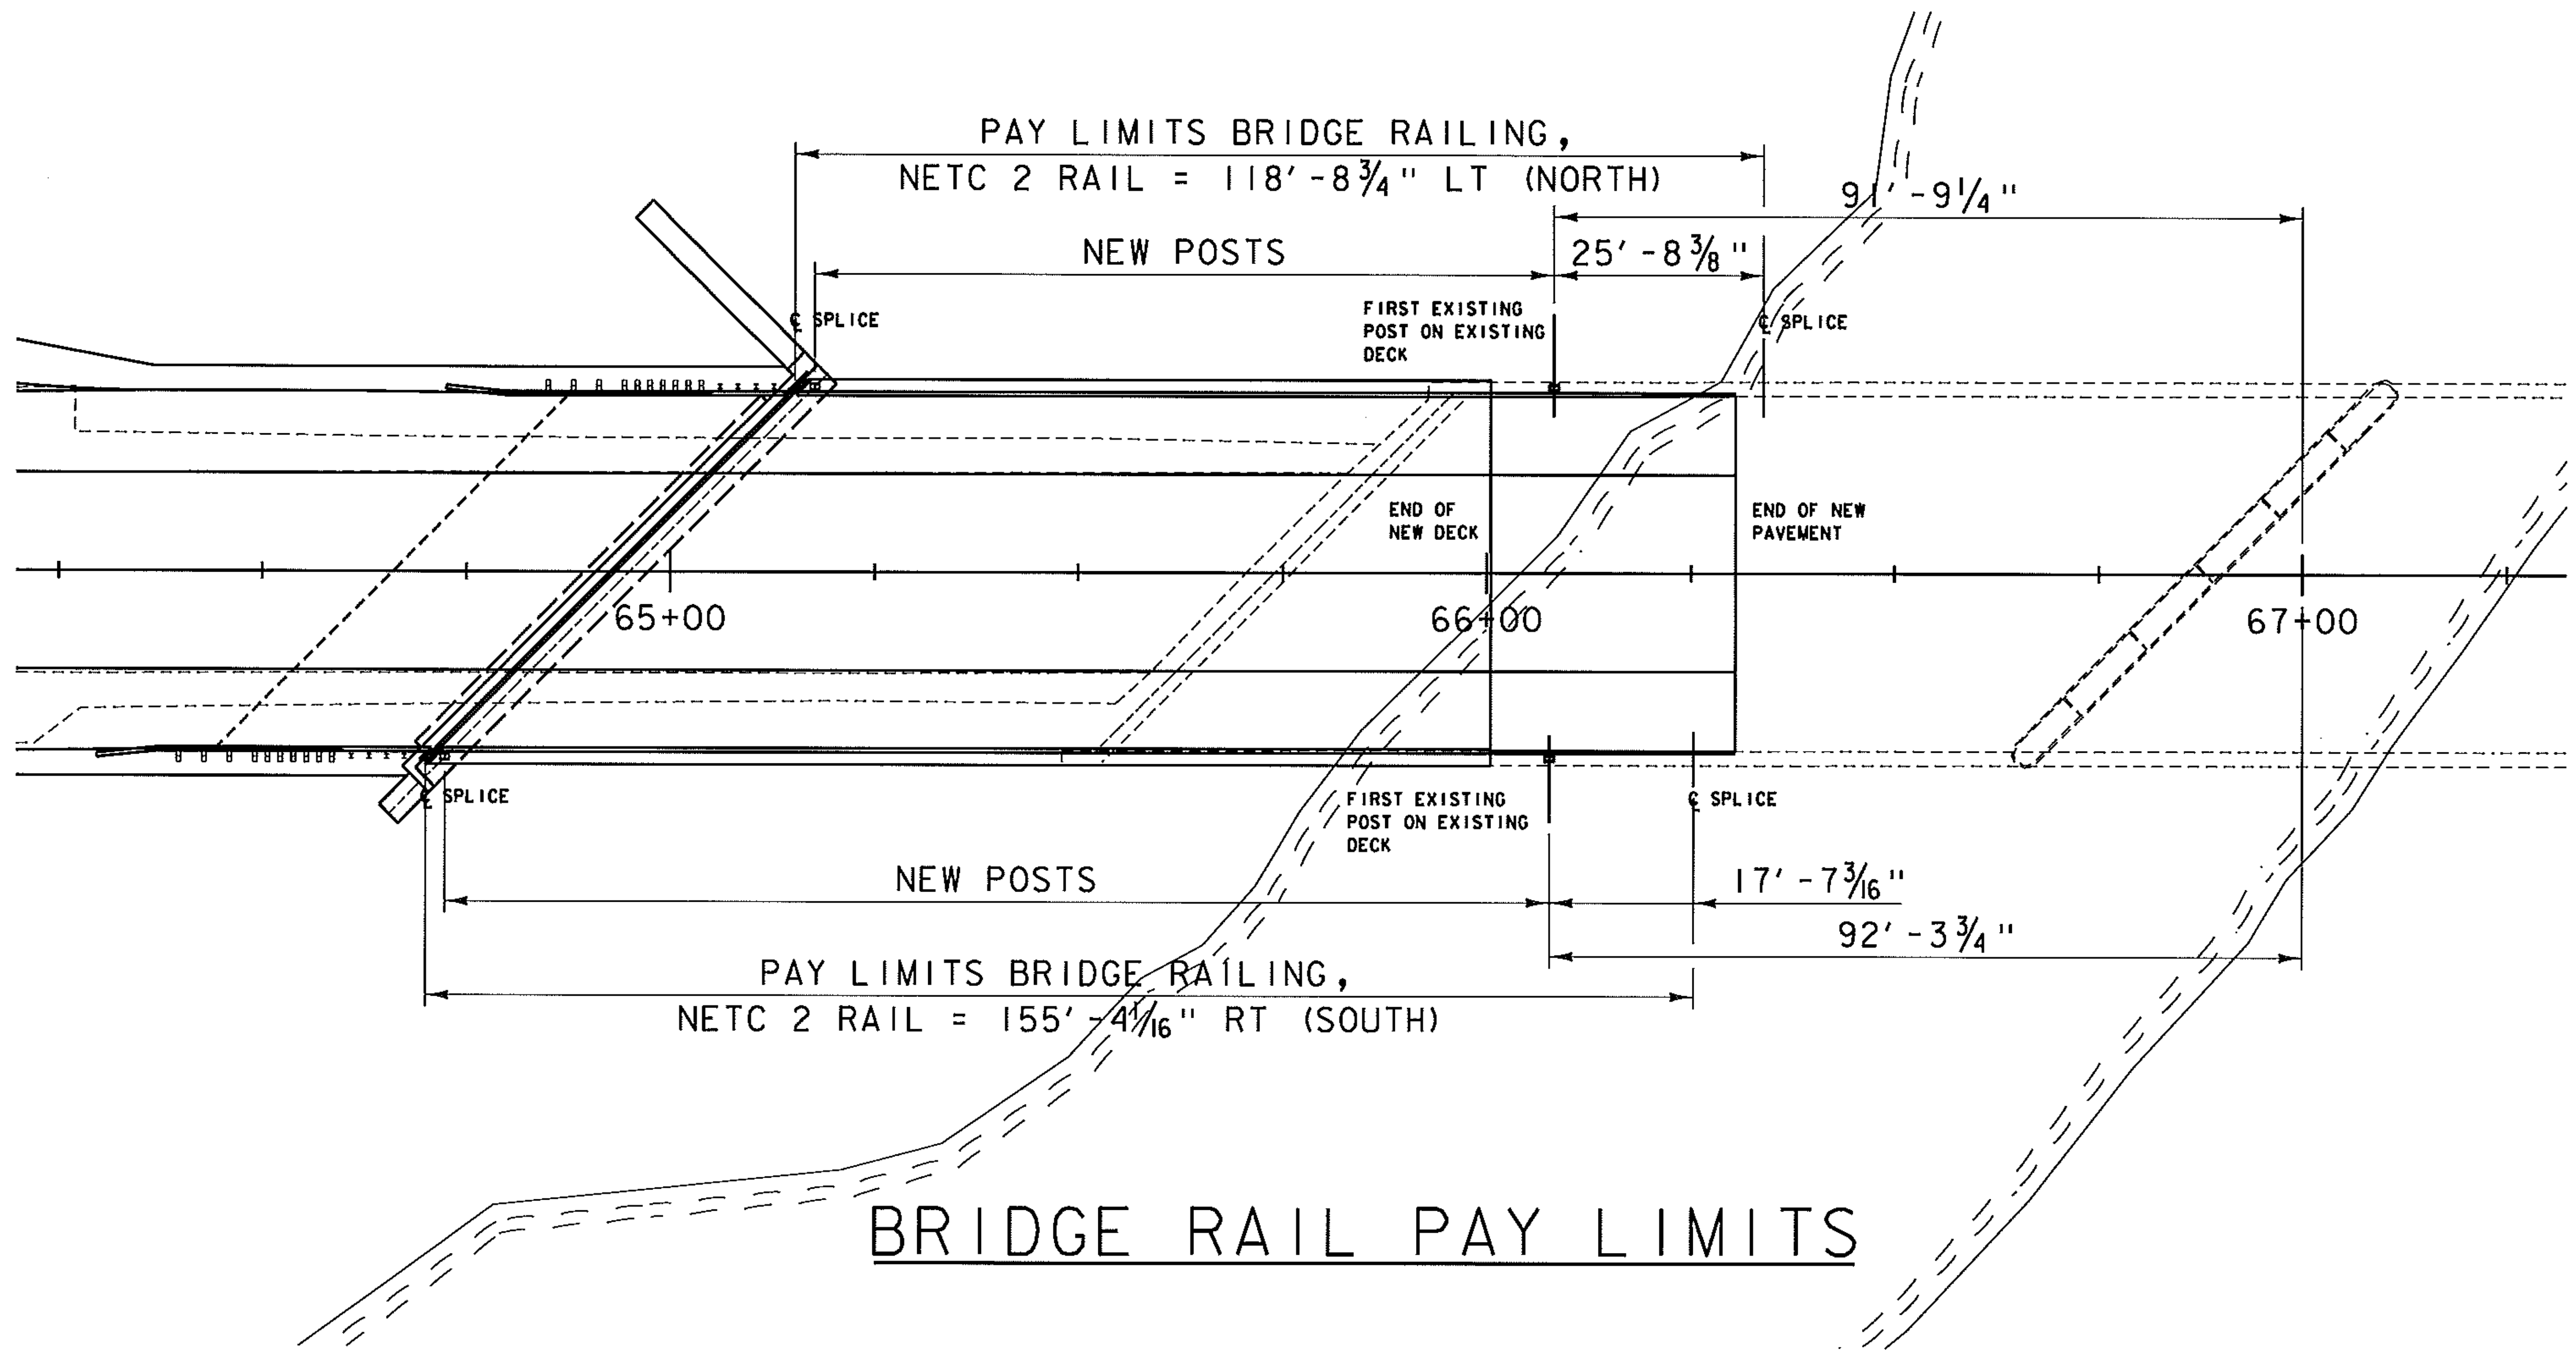

BRIDGE RAIL PAY LIMITS

State of Vermont  
Program Development  
One National Life Drive  
Montpelier, VT 05633-5001  
www.aot.state.vt.us

[phone] 802-828-2621  
[fax] 802-828-3566  
[ttd] 800-253-0191

January 30, 2013

Structal Bridges  
386 River Road  
Claremont, NH 03743

Project Name: Woodford Project #: ER BHF 010-1(44)

Structure Identification: VT 9 Over the Roaring Branch of the Walloomsac River

The following structural steel details for the revised cross frames at Abutment No. 1 for the above project (Vendor's Job #UN04260), have been reviewed.

Sheets E104, 115, 116, 117 and 118 are approved "as noted". (Please make appropriate changes as indicated on the "as noted" drawing and submit a new "\*.pdf" for our use in the record plans for this project.)

You must provide notice to our fabrication inspector Jeff Clark as to the date fabrication represented by these drawings will begin. Jeff may be contacted by phone at (802)828-0044 or email at [jeff.clark@state.vt.us](mailto:jeff.clark@state.vt.us).


Sincerely,



Carolyn W. Carlson, PE  
Project Manager

Attachments


cc:  Resident Engineer Ron Lemaire -w/prints  
 T. Buck Construction, Inc. - w/prints  
 Shop Inspector - Jeff Clark w/prints  
 Materials & Research Section (C&IA Unit) - Letter only  
 Construction Division - Letter only  
 CWC

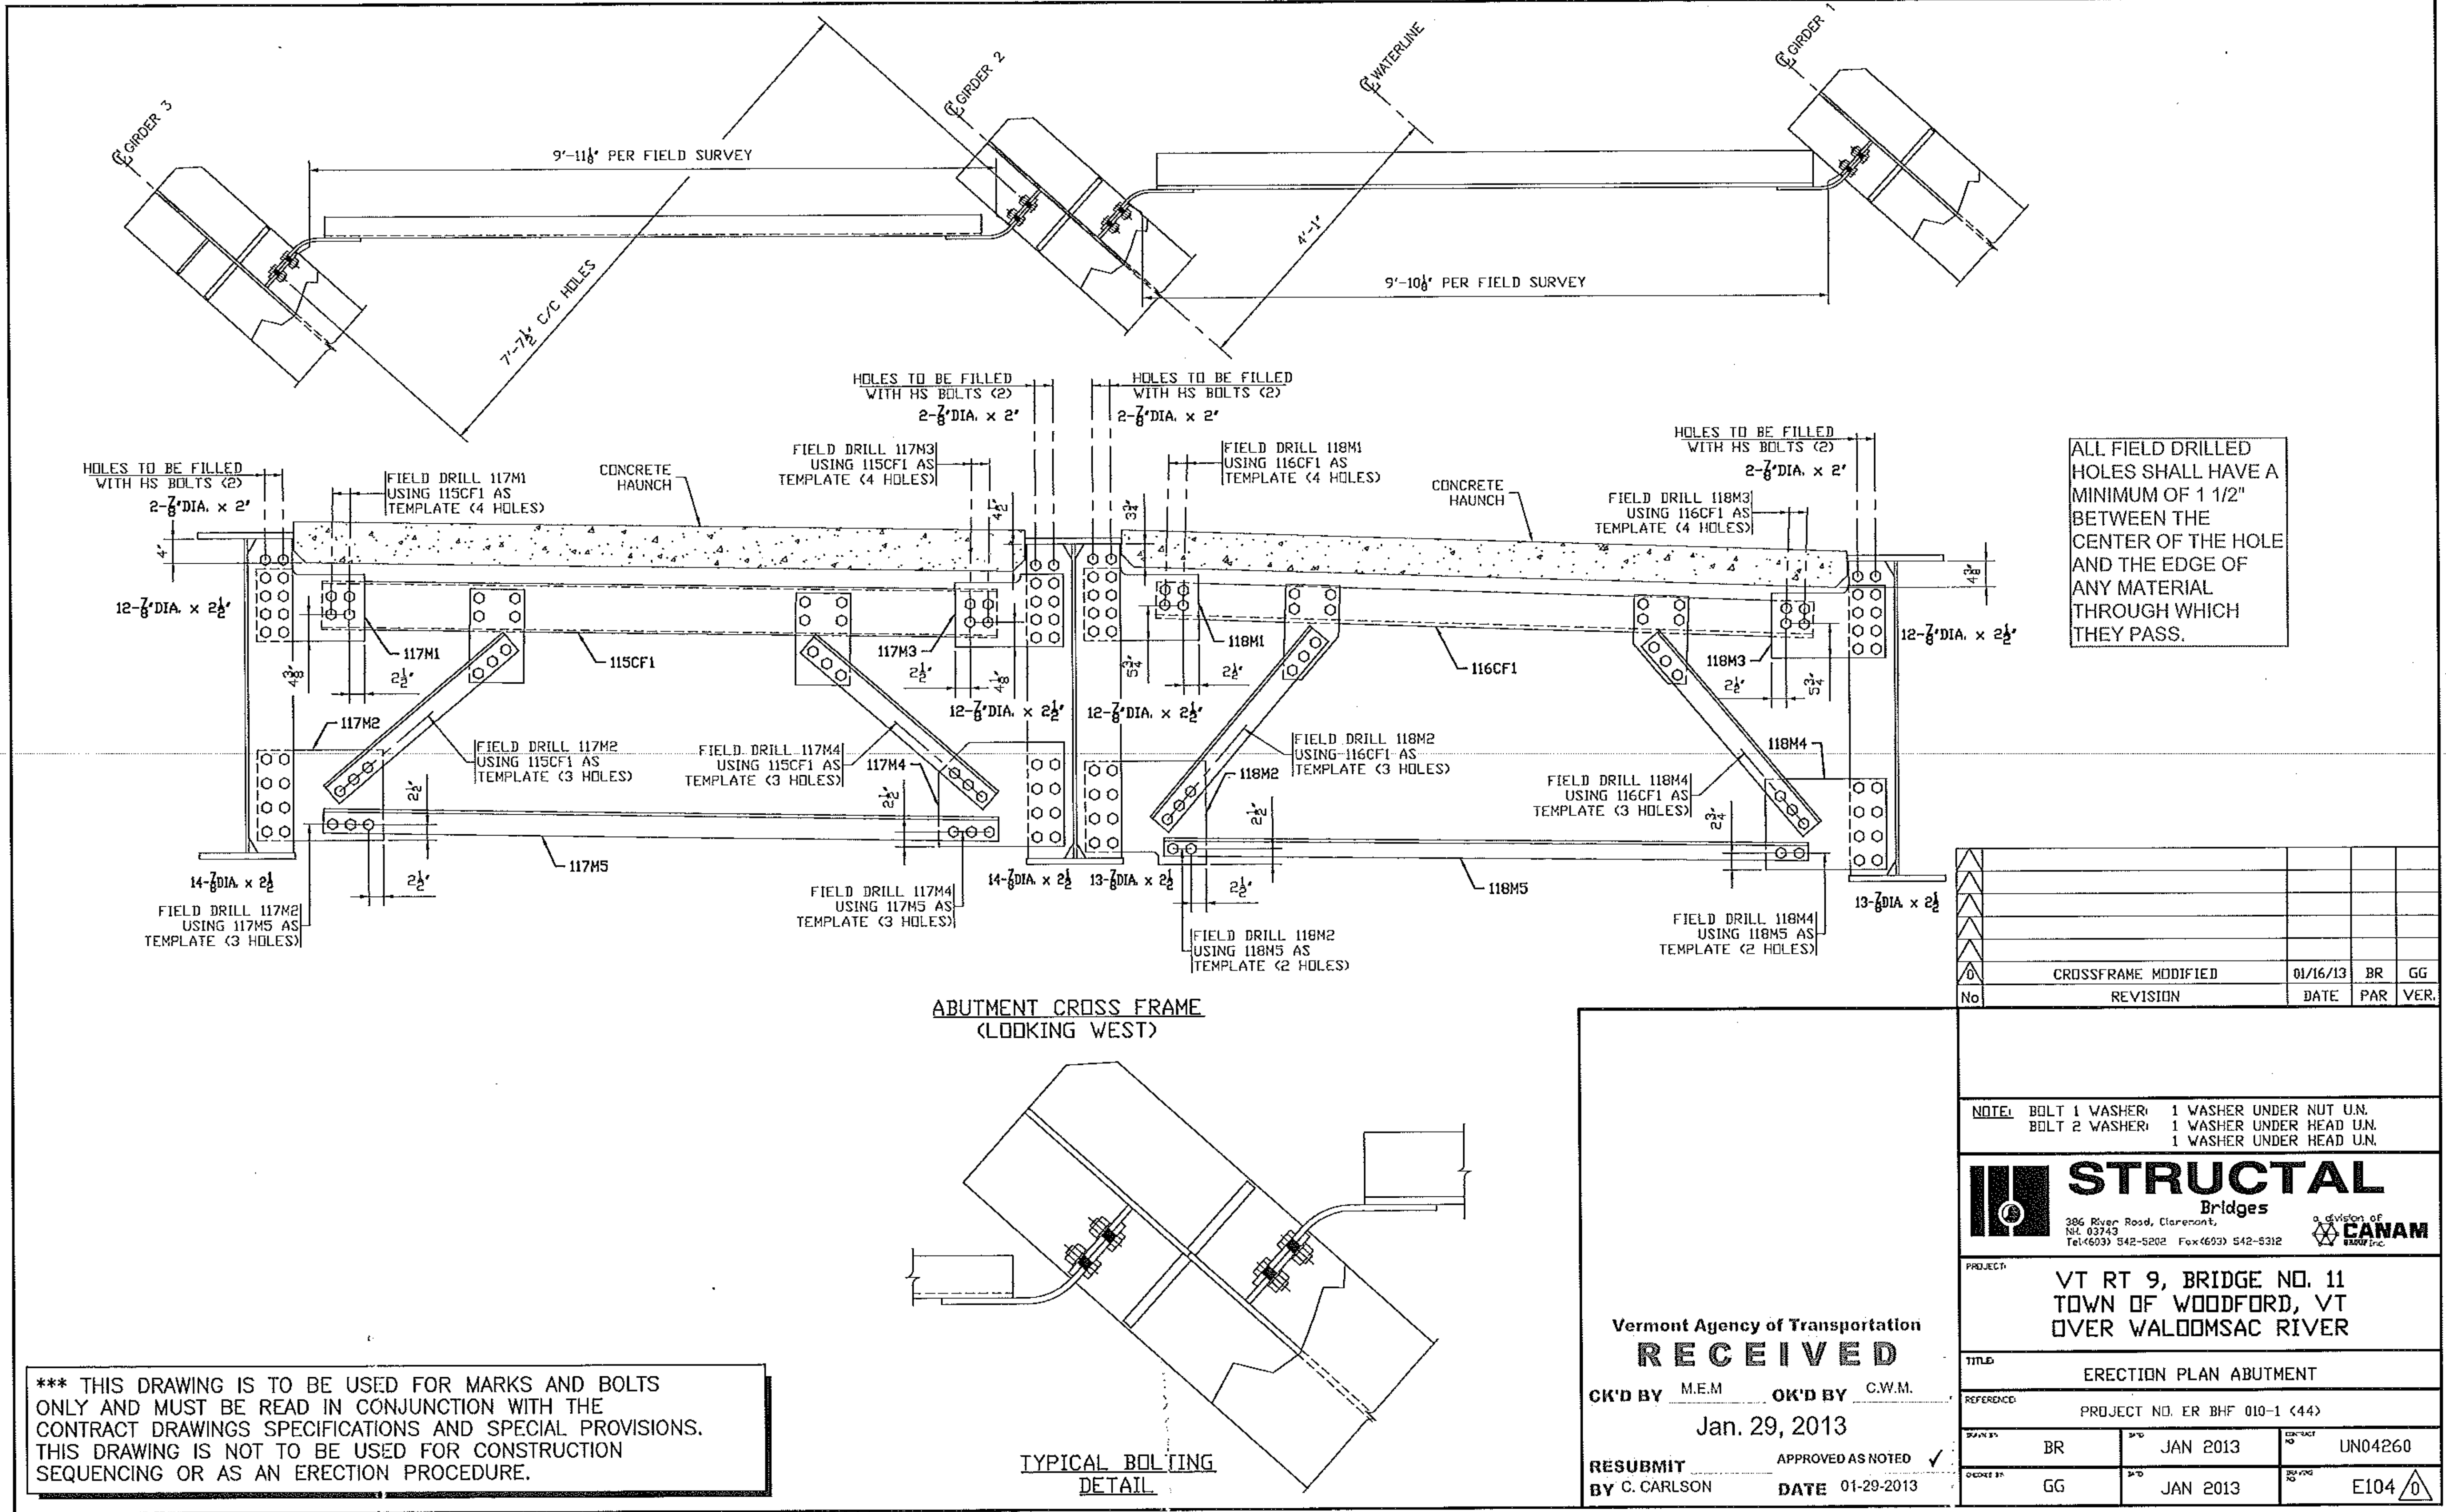

ALL FIELD DRILLED HOLES SHALL HAVE A MINIMUM OF 1 1/2" BETWEEN THE CENTER OF THE HOLE AND THE EDGE OF ANY MATERIAL THROUGH WHICH THEY PASS.

No	REVISION	DATE	PAR	VER.
1	CROSSFRAME MODIFIED	01/16/13	BR	GG

ABUTMENT CROSS FRAME (LOOKING WEST)

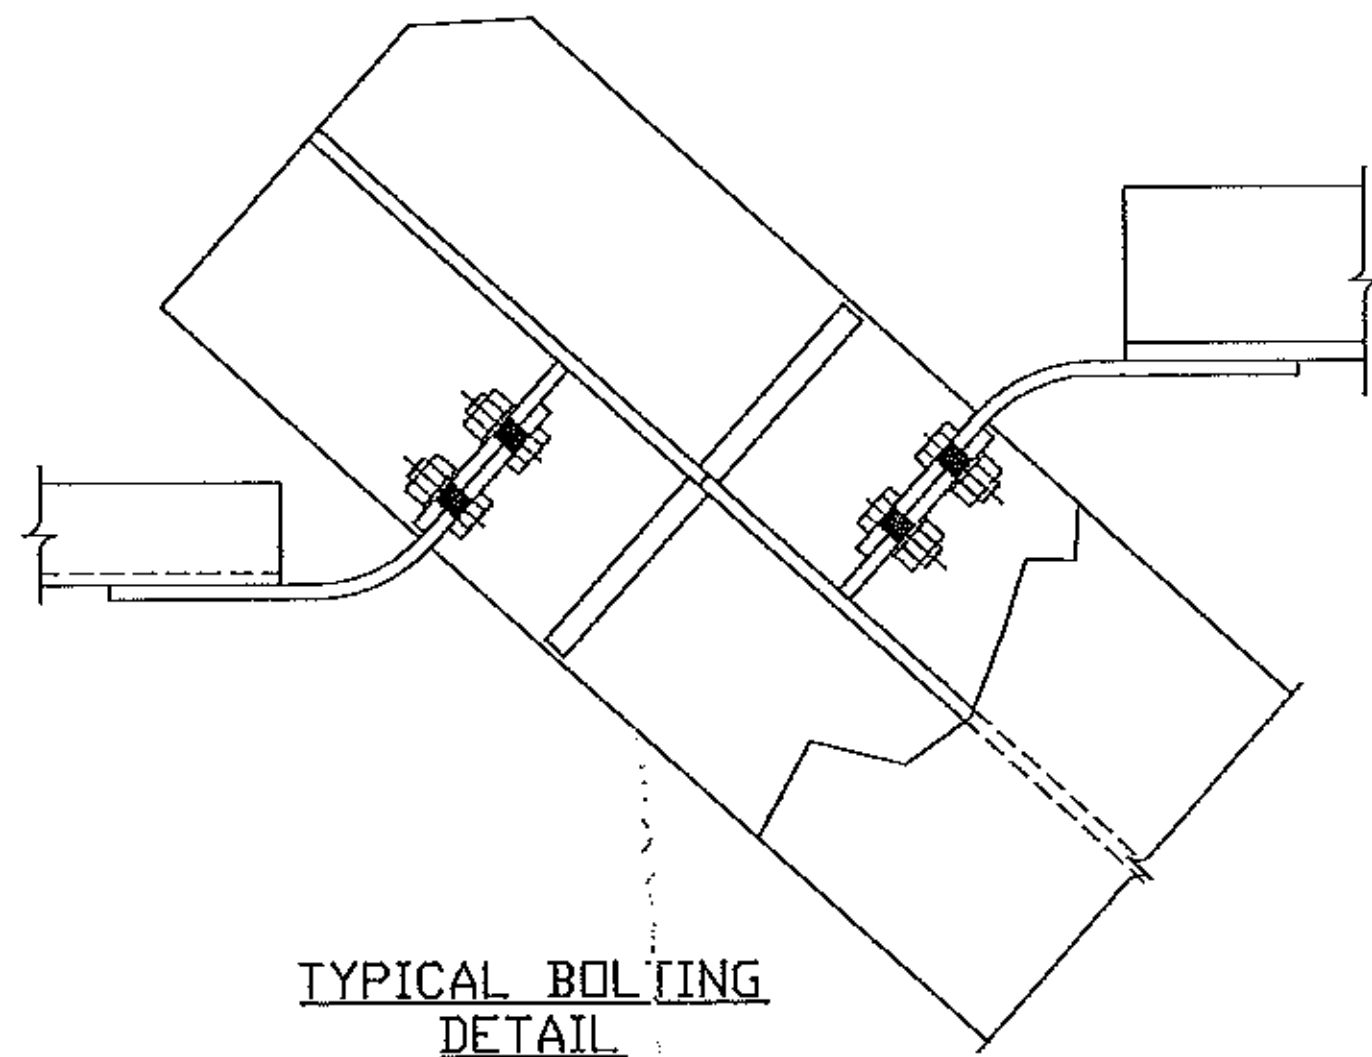

\*\*\* THIS DRAWING IS TO BE USED FOR MARKS AND BOLTS ONLY AND MUST BE READ IN CONJUNCTION WITH THE CONTRACT DRAWINGS SPECIFICATIONS AND SPECIAL PROVISIONS. THIS DRAWING IS NOT TO BE USED FOR CONSTRUCTION SEQUENCING OR AS AN ERECTION PROCEDURE.

Vermont Agency of Transportation  
**RECEIVED**  
 CK'D BY M.E.M. OK'D BY C.W.M.  
 Jan. 29, 2013  
 RESUBMIT APPROVED AS NOTED ✓  
 BY C. CARLSON DATE 01-29-2013

NOTE: BOLT 1 WASHER: 1 WASHER UNDER NUT U.N.  
 BOLT 2 WASHER: 1 WASHER UNDER HEAD U.N.  
 1 WASHER UNDER HEAD U.N.




PROJECT: VT RT 9, BRIDGE NO. 11 TOWN OF WOODFORD, VT OVER WALDOMSAC RIVER


TITLE: ERECTION PLAN ABUTMENT

REFERENCE: PROJECT NO. ER BHF 010-1 (44)


DATE	BY	DATE	BY	NO.	NO.
JAN 2013	BR	JAN 2013	GG	UN04260	
JAN 2013	GG	JAN 2013		E104	

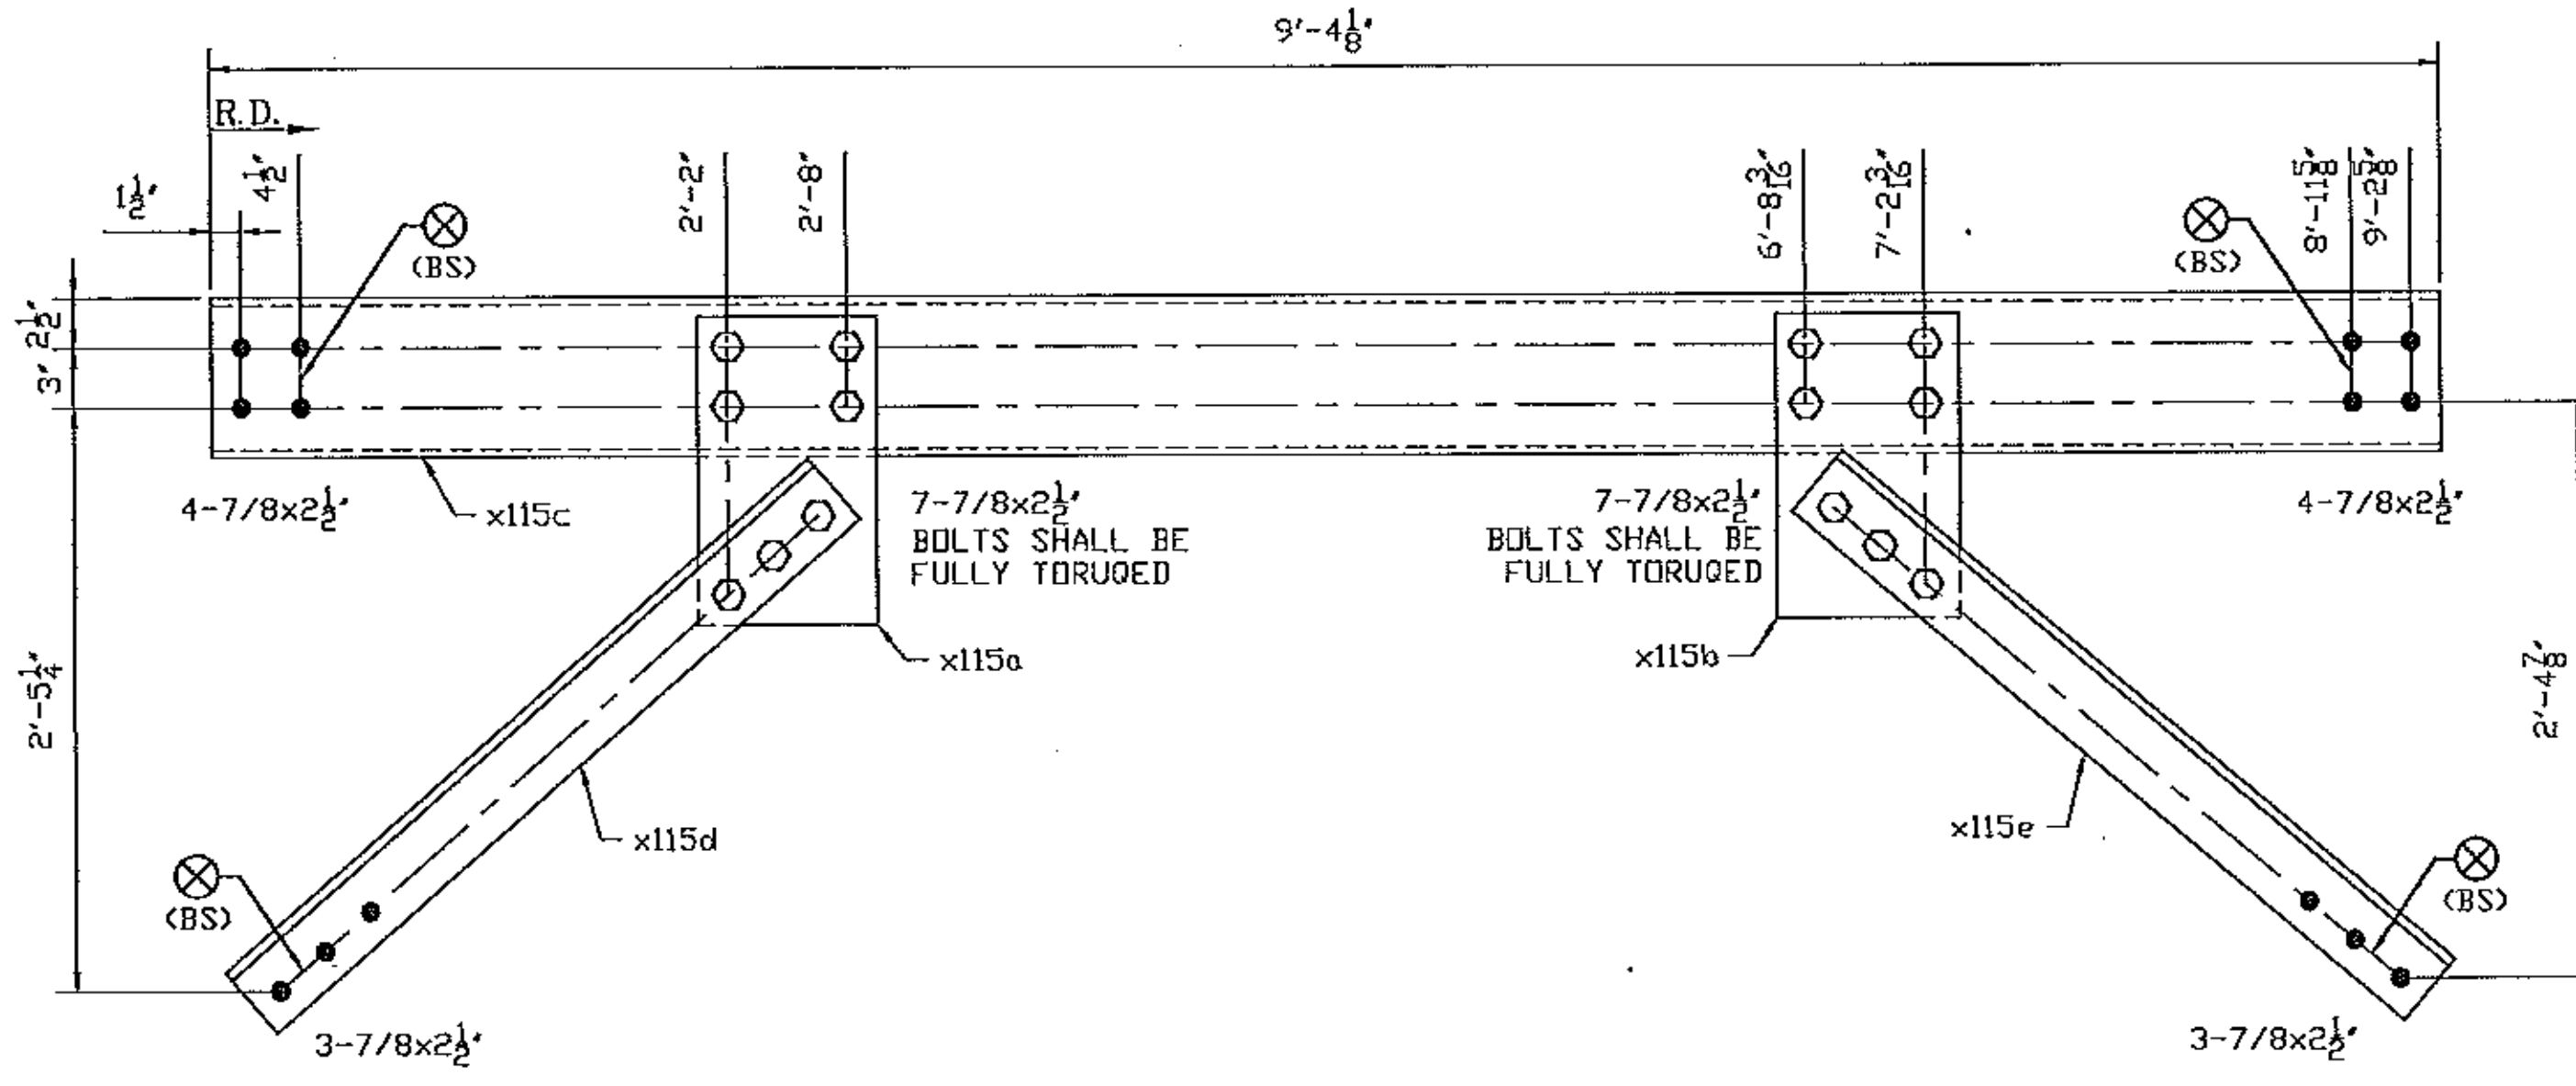


ONE - CROSS FRAME 115CF1  
PAINTED

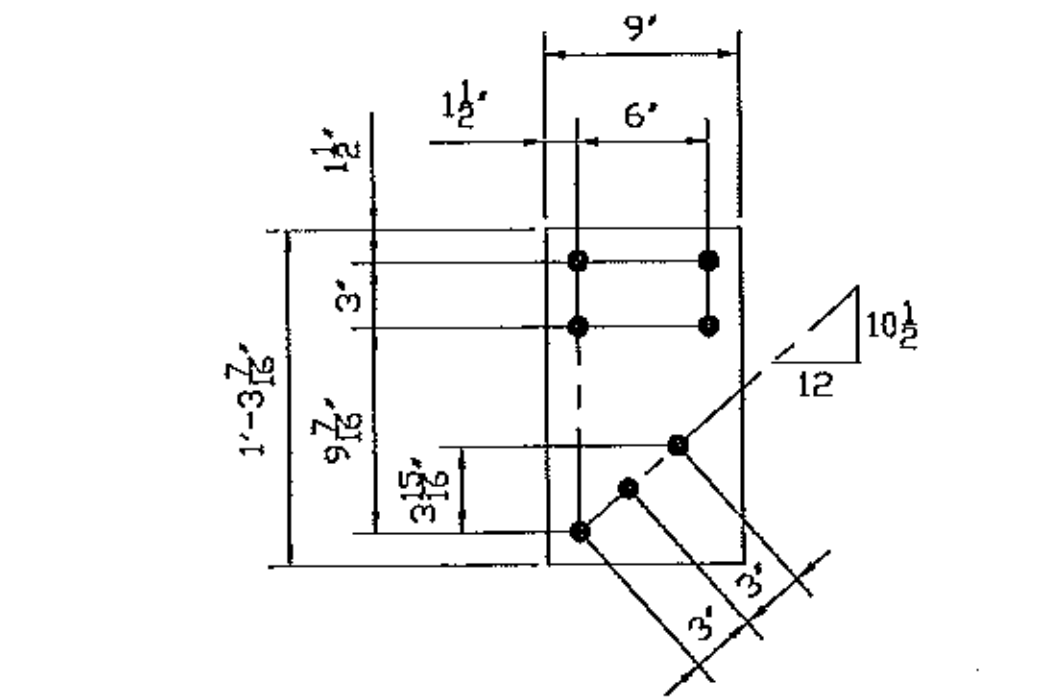


PL1/2x9x1-3 7/16 - x115a

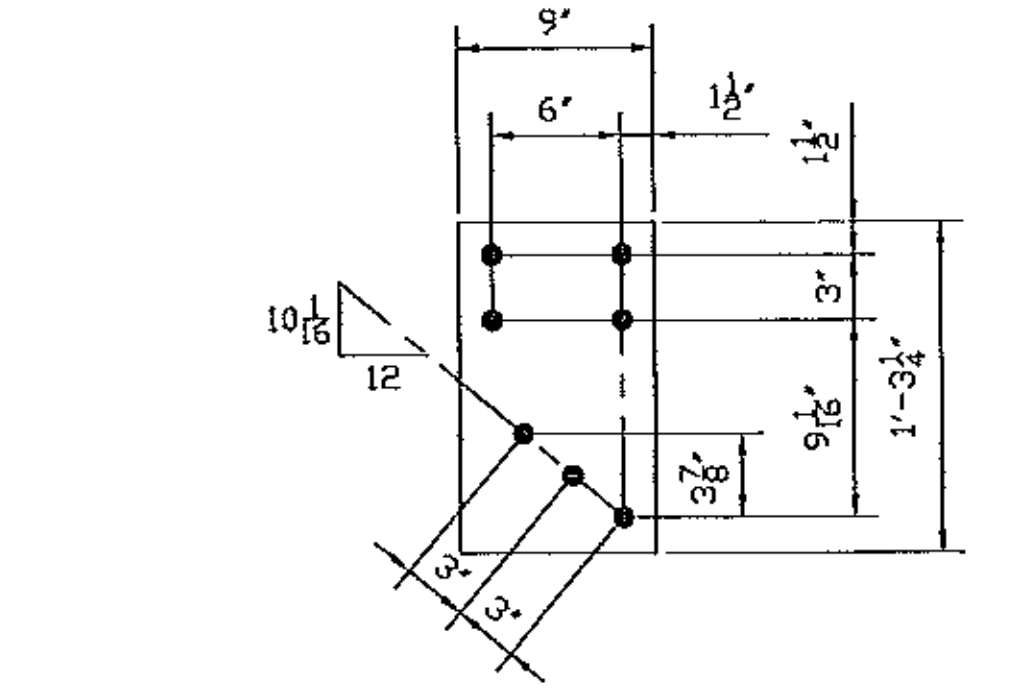

PL1/2x9x1-3 1/4 - x115b

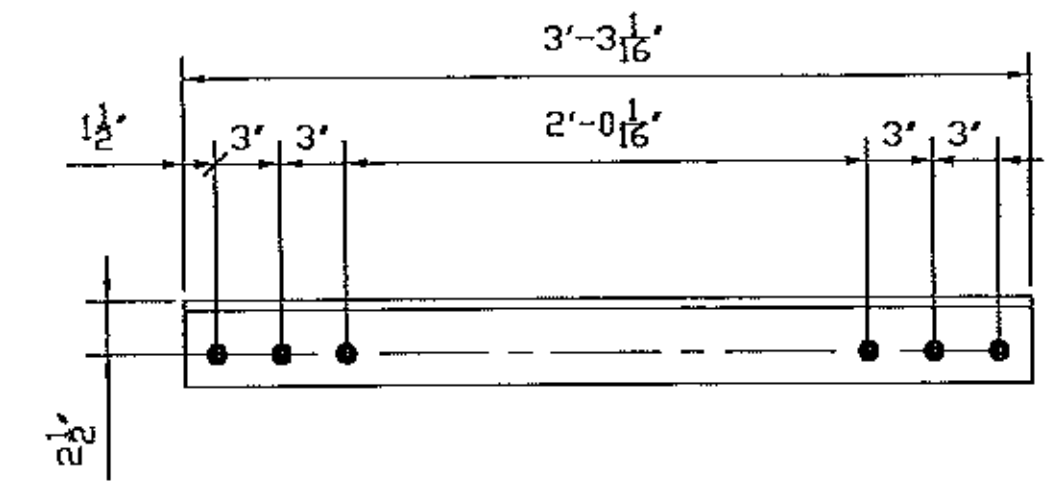


L4x4x1/2x3-3 1/16 - x115d

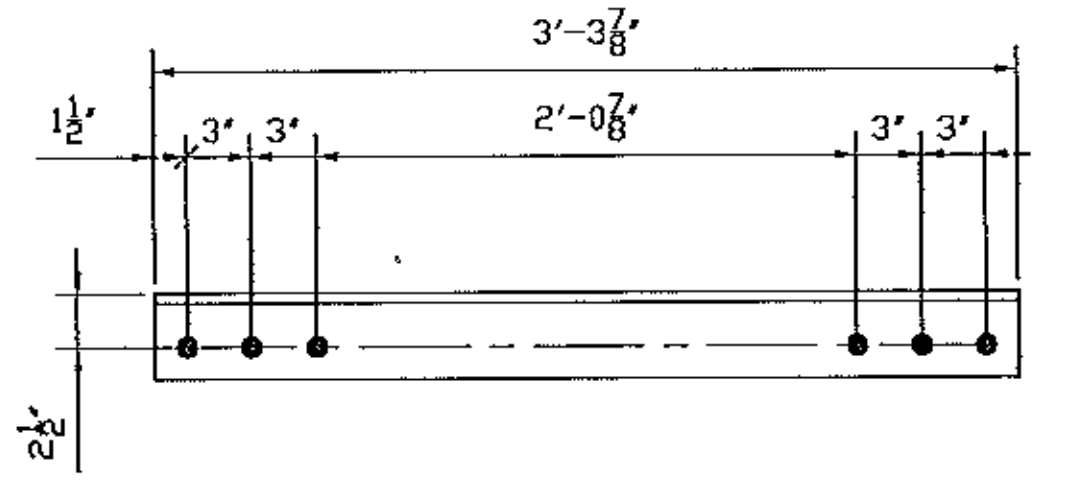

L4x4x1/2x3-3 7/8 - x115e

GENERAL NOTES: SEE GN100  
HOLES: 15/16 (UN.)  
CLEANING AND PAINTING: SEE SHEET P100 AND P101

PRIMER ONLY, NO PAINT  
BOTH SIDES 75 mm DIA AROUND HOLE  
WHERE NOTED WITH THIS SYMBOL

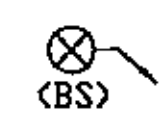

337

BILL OF MATERIAL									
Mark	Qty.	Description	SU	Length	Remark	ABM	Total Weight (lbs)	Seq	Qty /Seq
115CF1	ONE	CROSS FRAME	Grd						
115CF1	1	CROSS FRAME		9-4 1/8	PAINT				
x115a	1	PL1/2x9	A70950W	1- 3 7/16		104-5	20		
x115b	1	PL1/2x9	A70950W	1- 3 1/4		104-5	19		
x115c	1	MC8x22.8	A70950W	9-4 1/8		104-1	213		
x115d	1	L4x4x1/2	A70950W	3-3 1/16		104-3	42		
x115e	1	L4x4x1/2	A70950W	3-3 7/8		104-3	43		
78S212	14	.7/8 Dia A325 TYP3		2 1/2	IFL WASH				
78F212	14	.7/8 Dia A325 TYP3		2 1/2	IFL WASH				

Vermont Agency of Transportation  
**RECEIVED**  
CK'D BY M.E.M. OK'D BY C.W.M.  
Jan. 29, 2013  
RESUBMIT APPROVED AS NOTED ✓  
BY C. CARLSON DATE 01-29-2013

No	REVISION	DATE	PAR	VER.
	CROSSFRAME MODIFIED	01/16/13	BR	GG
	CROSSFRAME MODIFIED	09/17/12	BR	GG
	FOR SHOP	08/03/12	SM	GG
	FOR APPROVAL	07/06/12	BR	EG

NOTE: BOLT 1 WASHER: 1 WASHER UNDER NUT U.N.  
BOLT 2 WASHER: 1 WASHER UNDER HEAD U.N.  
1 WASHER UNDER HEAD U.N.


**STRUCTAL**  
Bridges  
386 River Road, Claremont, NH 03743  
Tel: (603) 542-5202 Fax: (603) 542-5312  
A Division of **CANAM** BRIDGE INC.

PROJECT: VT RT 9, BRIDGE NO. 11  
TOWN OF WOODFORD, VT  
OVER WALDOOMSAC RIVER


TITLE: ABUTMENT CROSS FRAME

REFERENCE: PROJECT NO. ER BHF 010-1 (44)


DESIGNED BY: BR	DATE: JULY 2012	CONTRACT NO: UN04260
CHECKED BY: GG	DATE: JULY 2012	115

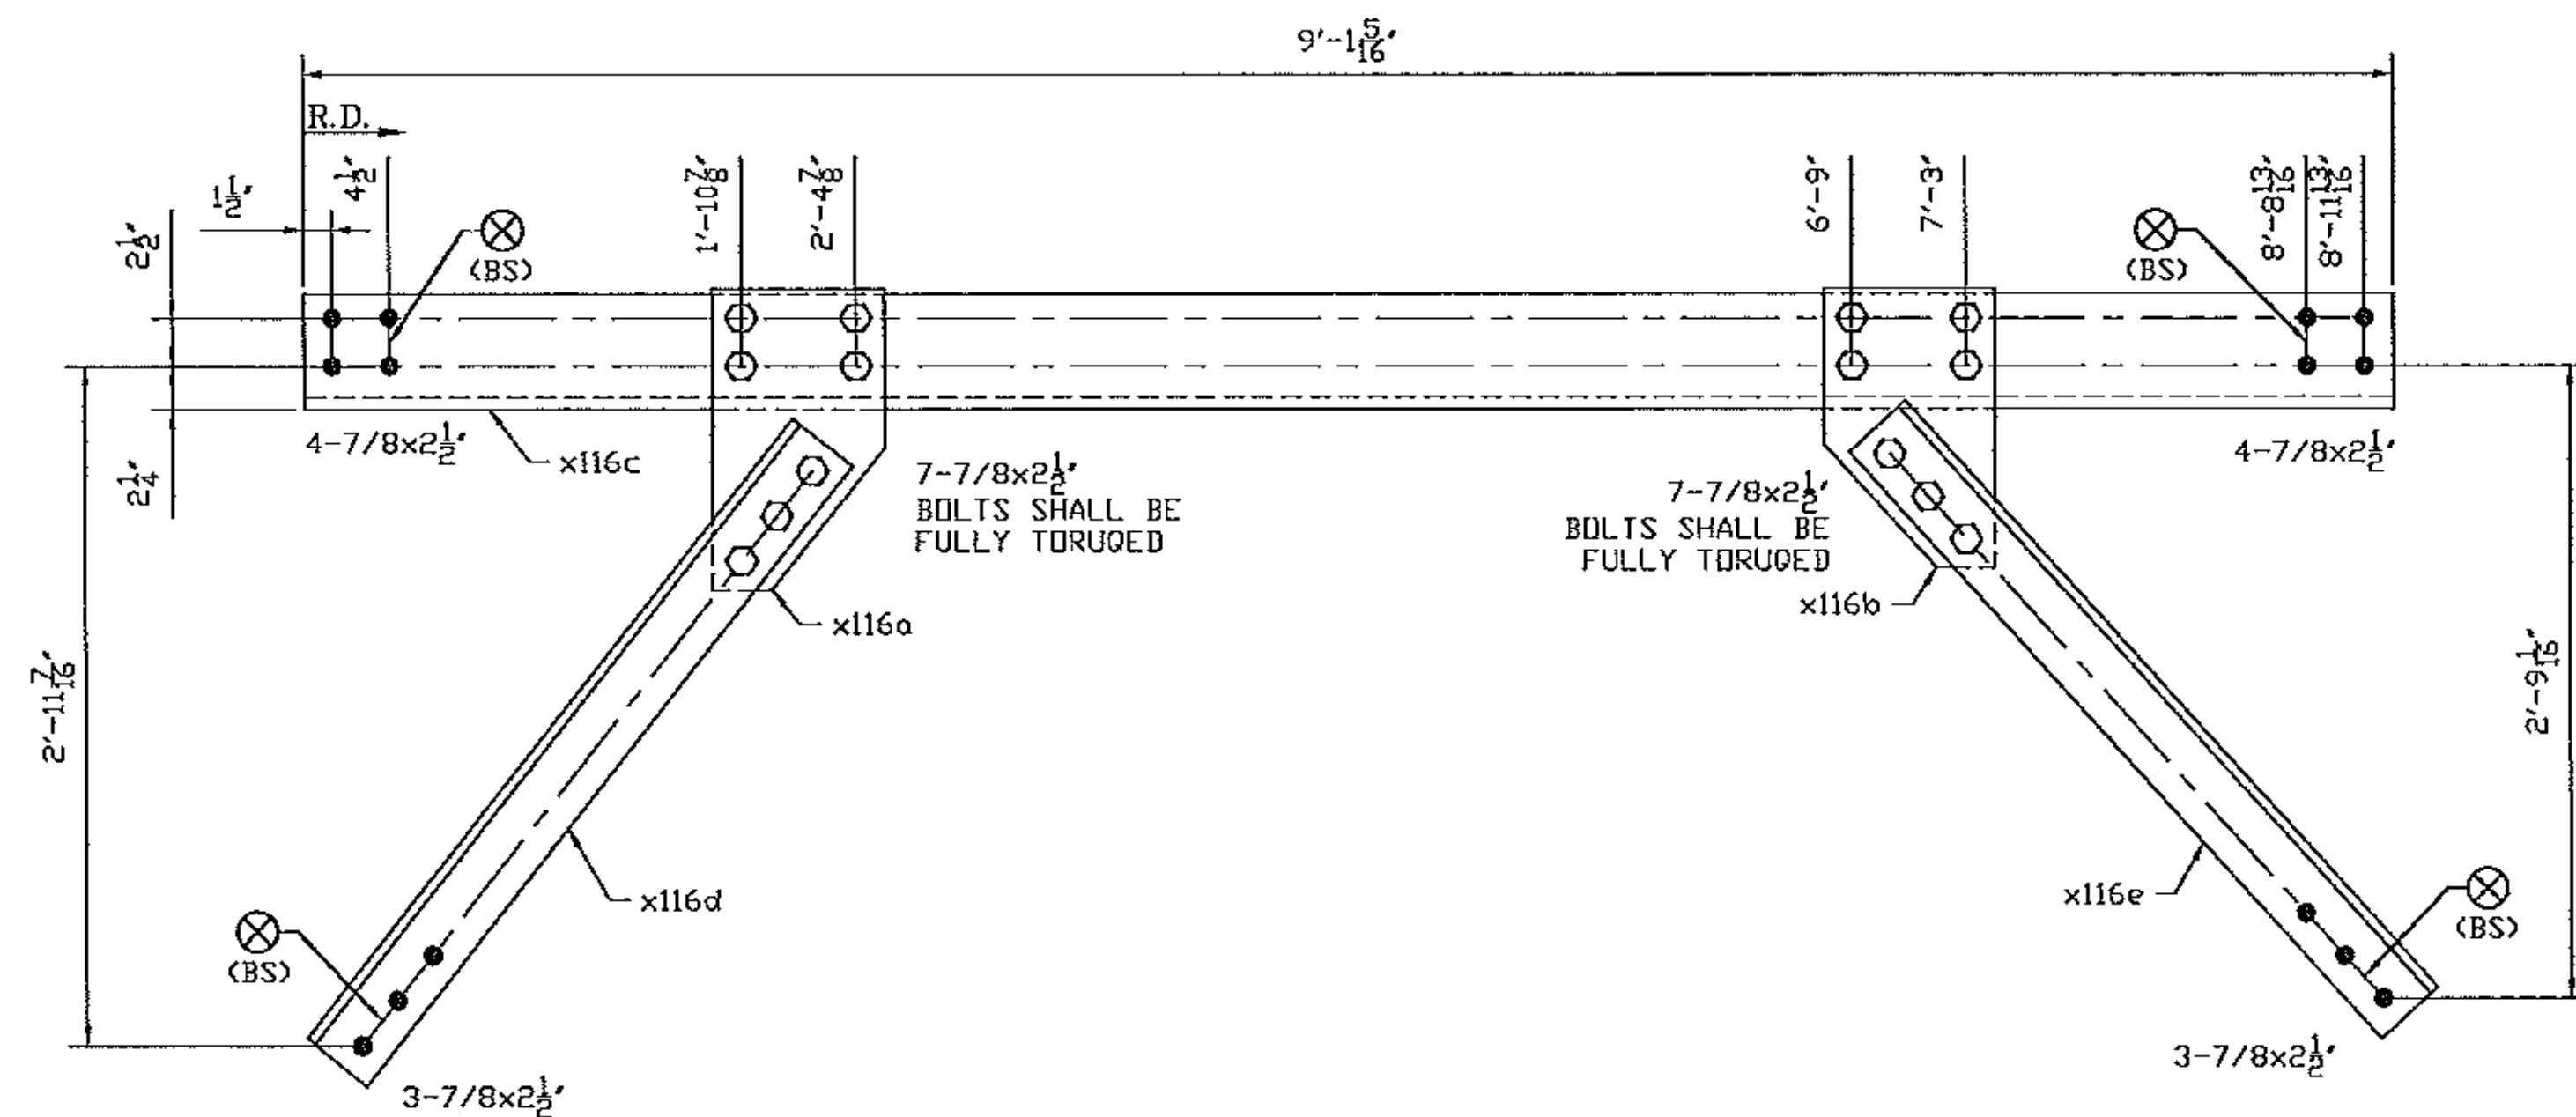


ONE - CROSS FRAME 116CF1  
PAINTED

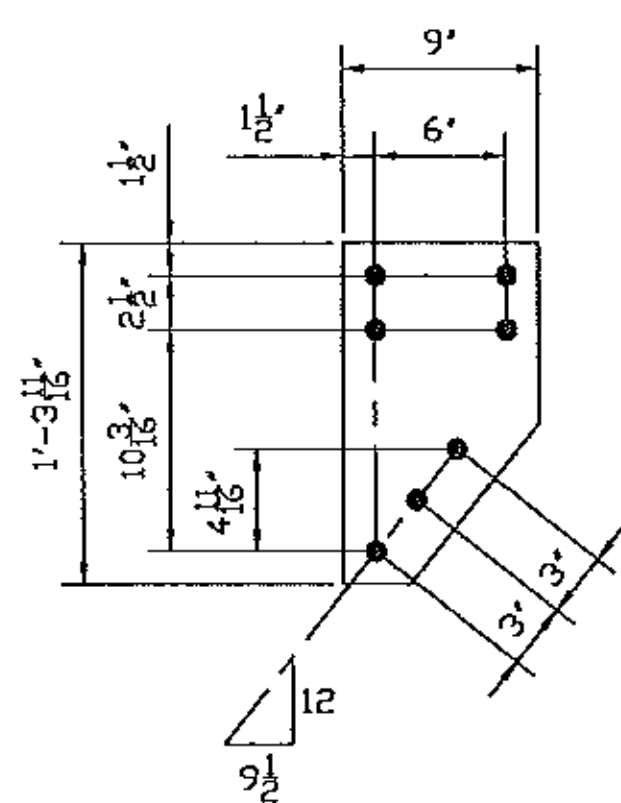


PL1/2x9x1-3 11/16 - x116a

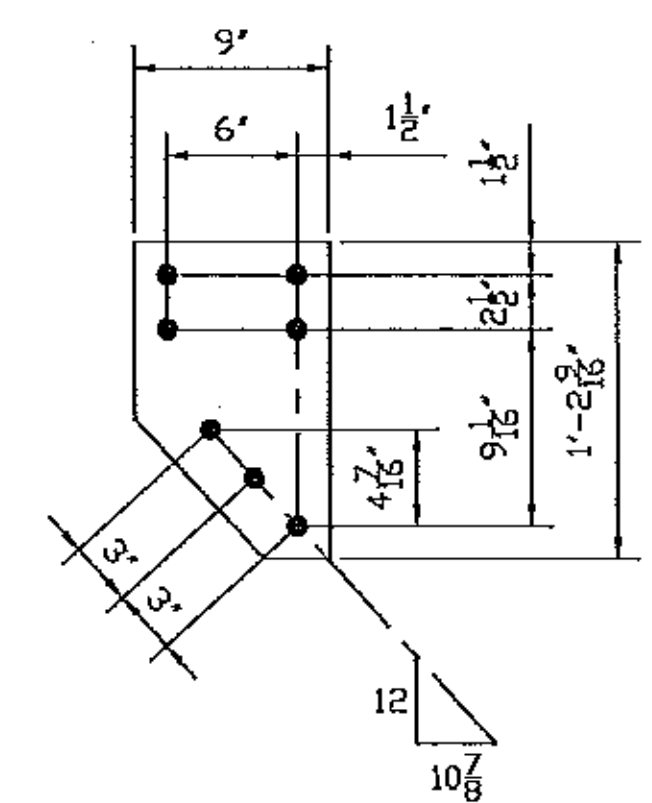

PL1/2x9x1-2 9/16 - x116b

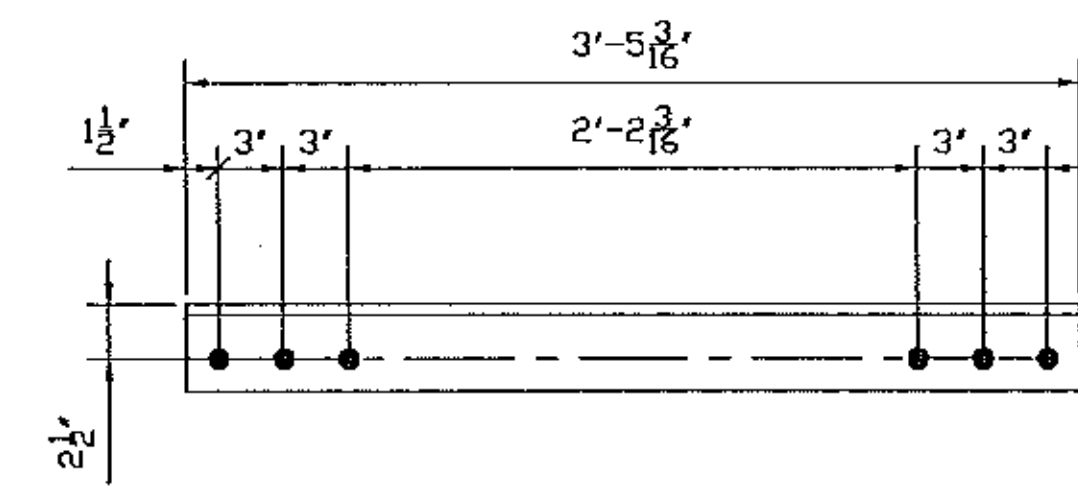

L4x4x1/2x3-5 3/16 - x116d

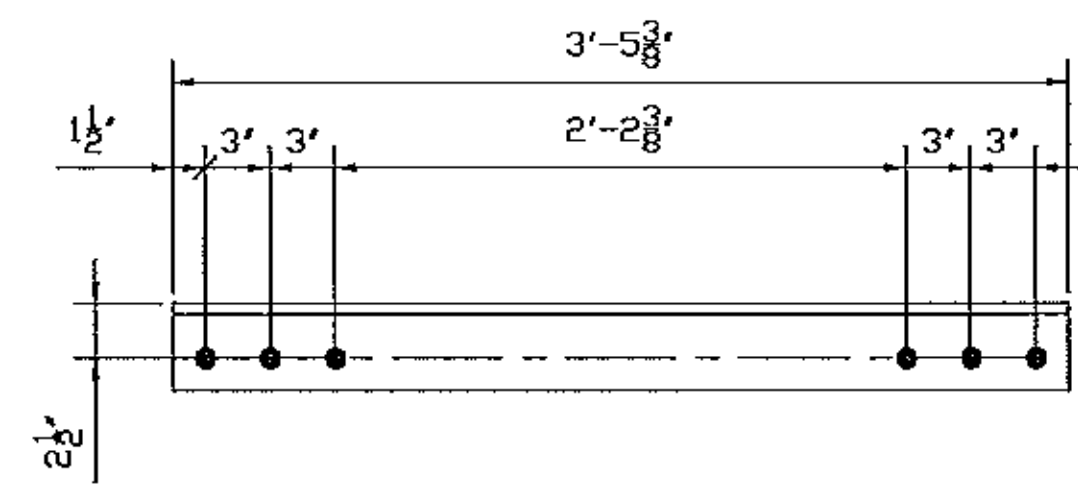

L4x4x1/2x3-5 3/8 - x116e

PRIMER ONLY, NO PAINT  
BOTH SIDES 75 mm DIA AROUND HOLE  
WHERE NOTED WITH THIS SYMBOL

GENERAL NOTES: SEE GN100  
HOLES: 15/16 (UN.)  
CLEANING AND PAINTING: SEE SHEET P100 AND P101

No	REVISION	DATE	PAR	VER.
1	CROSSFRAME MODIFIED	01/16/13	BR	GG
2	CROSSFRAME MODIFIED	09/17/12	BR	GG
3	FOR SHOP	08/03/12	SM	GG
4	FOR APPROVAL	07/06/12	BR	EG

NOTE: BOLT 1 WASHER: 1 WASHER UNDER NUT U.N.  
BOLT 2 WASHER: 1 WASHER UNDER HEAD U.N.  
1 WASHER UNDER HEAD U.N.

BILL OF MATERIAL									
Mark	Qty.	Description	SU	Length	Remark	ABM	Total (lb)	Seq	Qty
			Grd				Weight		/Seq
116CF1	ONE	CROSS FRAME							
116CF1	1	CROSS FRAME		9-1 5/16	PAINT				
x116a	1	PL1/2x9	A70950W	1-3 11/16		103-5	20		
x116b	1	PL1/2x9	A70950W	1-2 9/16		103-5	19		
x116c	1	L6x6x5/8	A70950W	9-1 5/16		103-1	220		
x116d	1	L4x4x1/2	A70950W	3-5 3/16		103-3	44		
x116e	1	L4x4x1/2	A70950W	3-5 3/8		103-3	44		
78S212	14	.7/8 Dia A325 TYP3		2 1/2	1FL WASH				
FB		FIELD BOLTS							
78F212	14	.7/8 Dia A325 TYP3		2 1/2	1FL WASH				

Vermont Agency of Transportation  
**RECEIVED**  
CK'D BY M.E.M OK'D BY C.W.M.  
Jan. 29, 2013  
RESUBMIT APPROVED AS NOTED ✓  
BY C. CARLSON DATE 01-29-2013


**STRUCTAL**  
Bridges  
386 River Road, Claremont, NH 03743  
Tel: (603) 542-5202 Fax: (603) 542-5312

PROJECT: VT RT 9, BRIDGE NO. 11  
TOWN OF WOODFORD, VT  
OVER WALDOMSAC RIVER


TITLE: ABUTMENT CROSS FRAME

REFERENCE: PROJECT NO. ER BHF 010-1 (44)


DESIGNED BY: BR	DATE: JULY 2012	PROJECT NO: UN04260
CHECKED BY: GG	DATE: JULY 2012	SCALE: 116

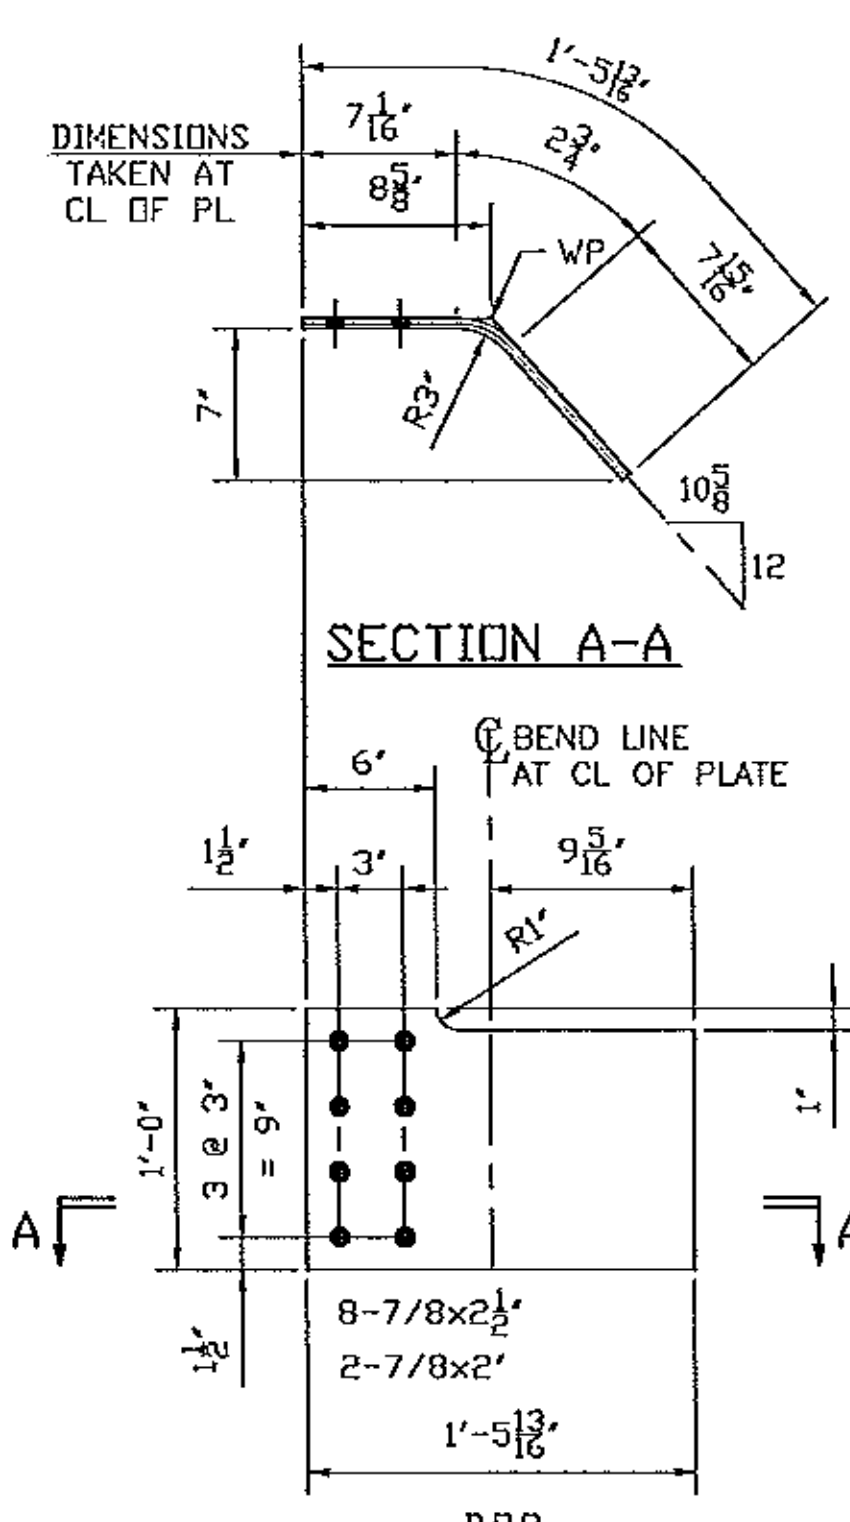


ONE - GUSSET 117M1  
PRIMED  
(DEVELOPED)

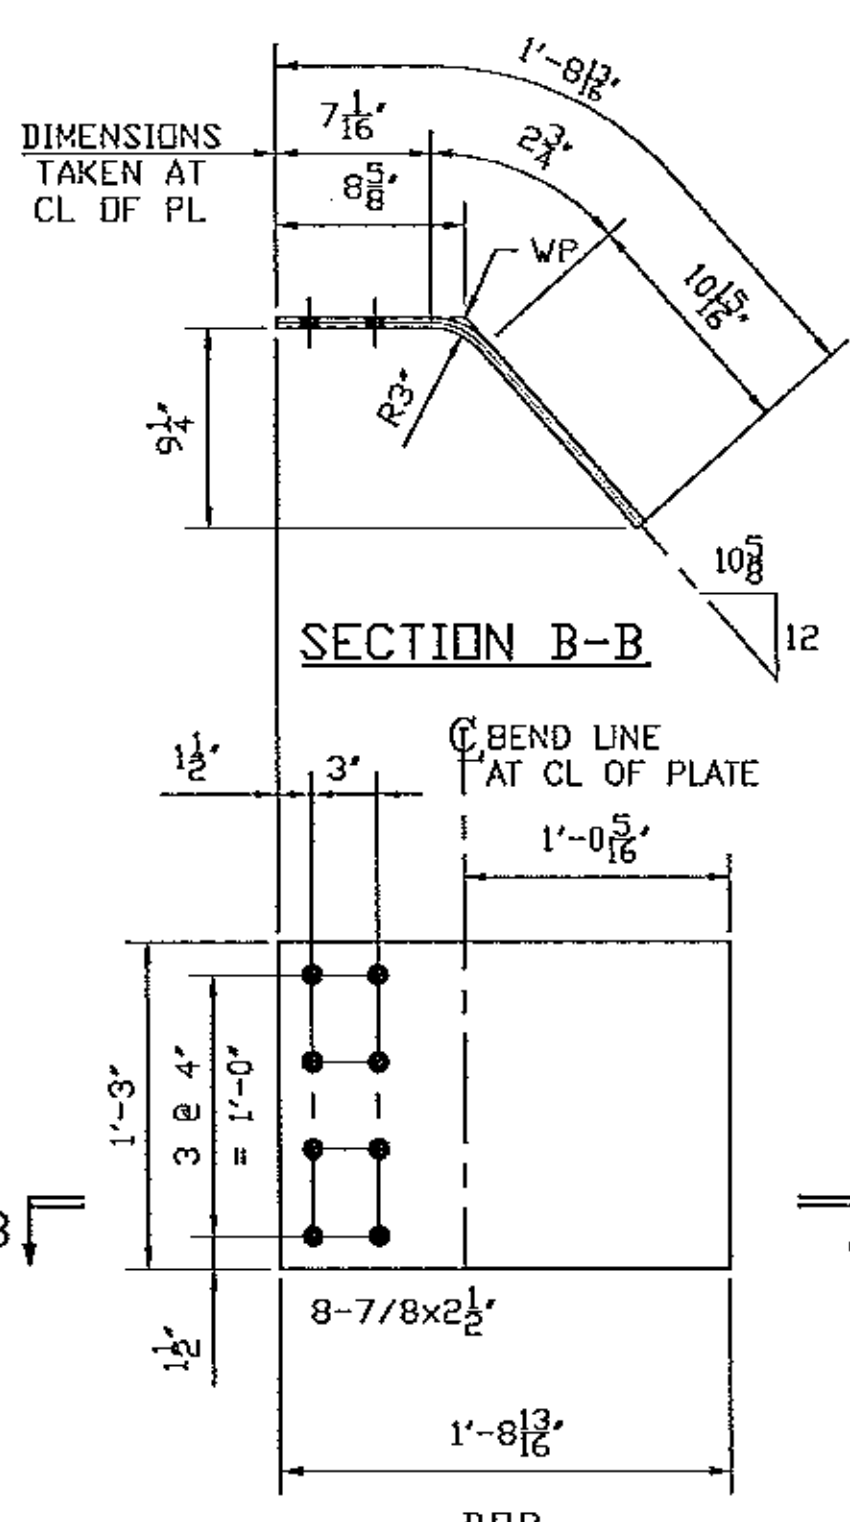


ONE - GUSSET 117M2  
PRIMED  
(DEVELOPED)

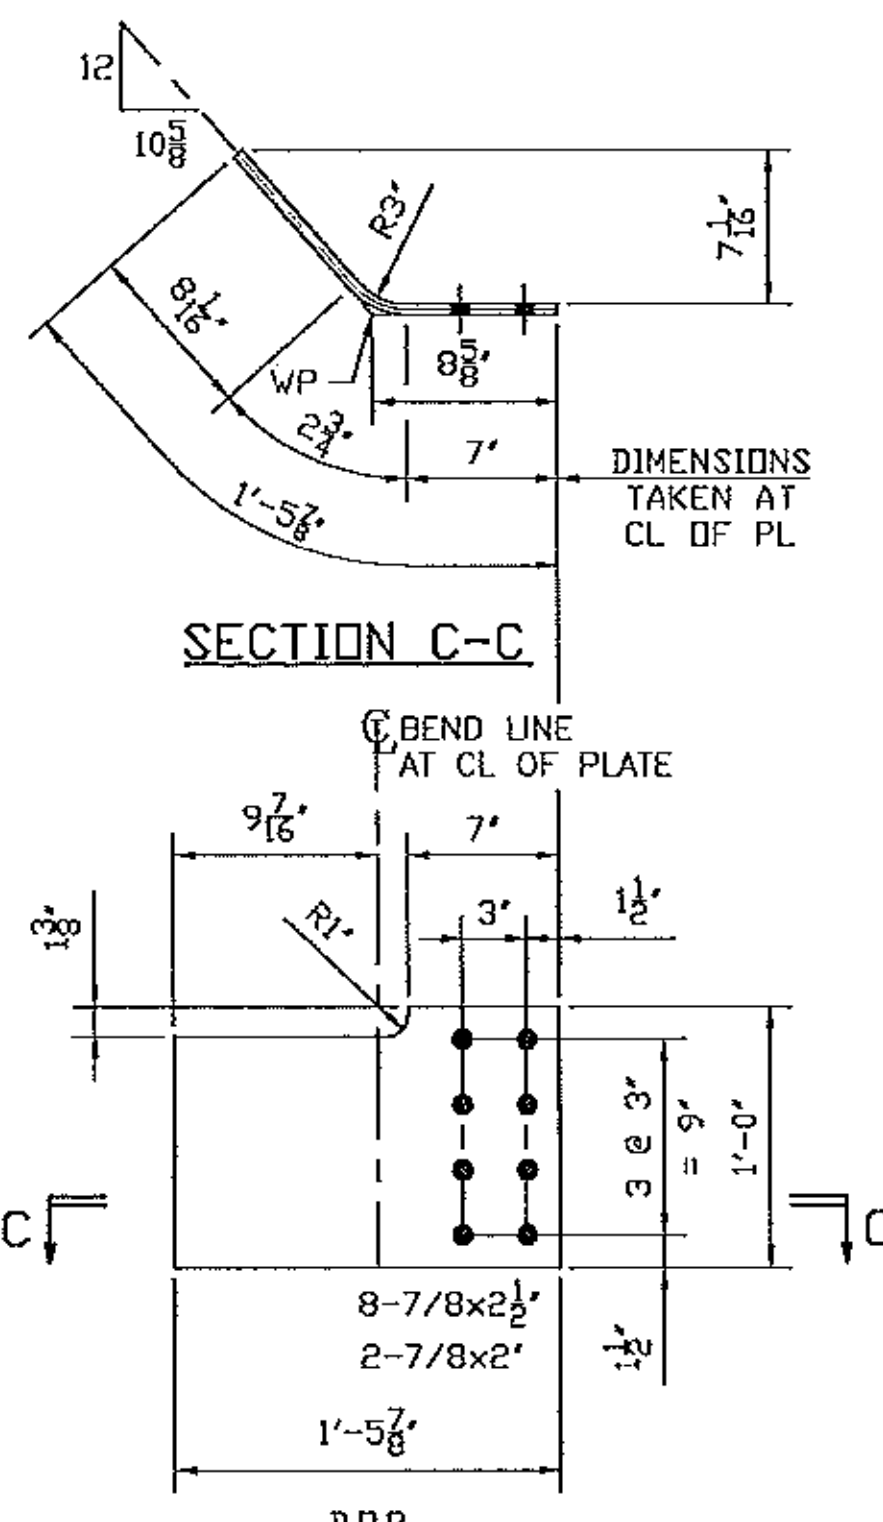

ONE - GUSSET 117M3  
PRIMED  
(DEVELOPED)

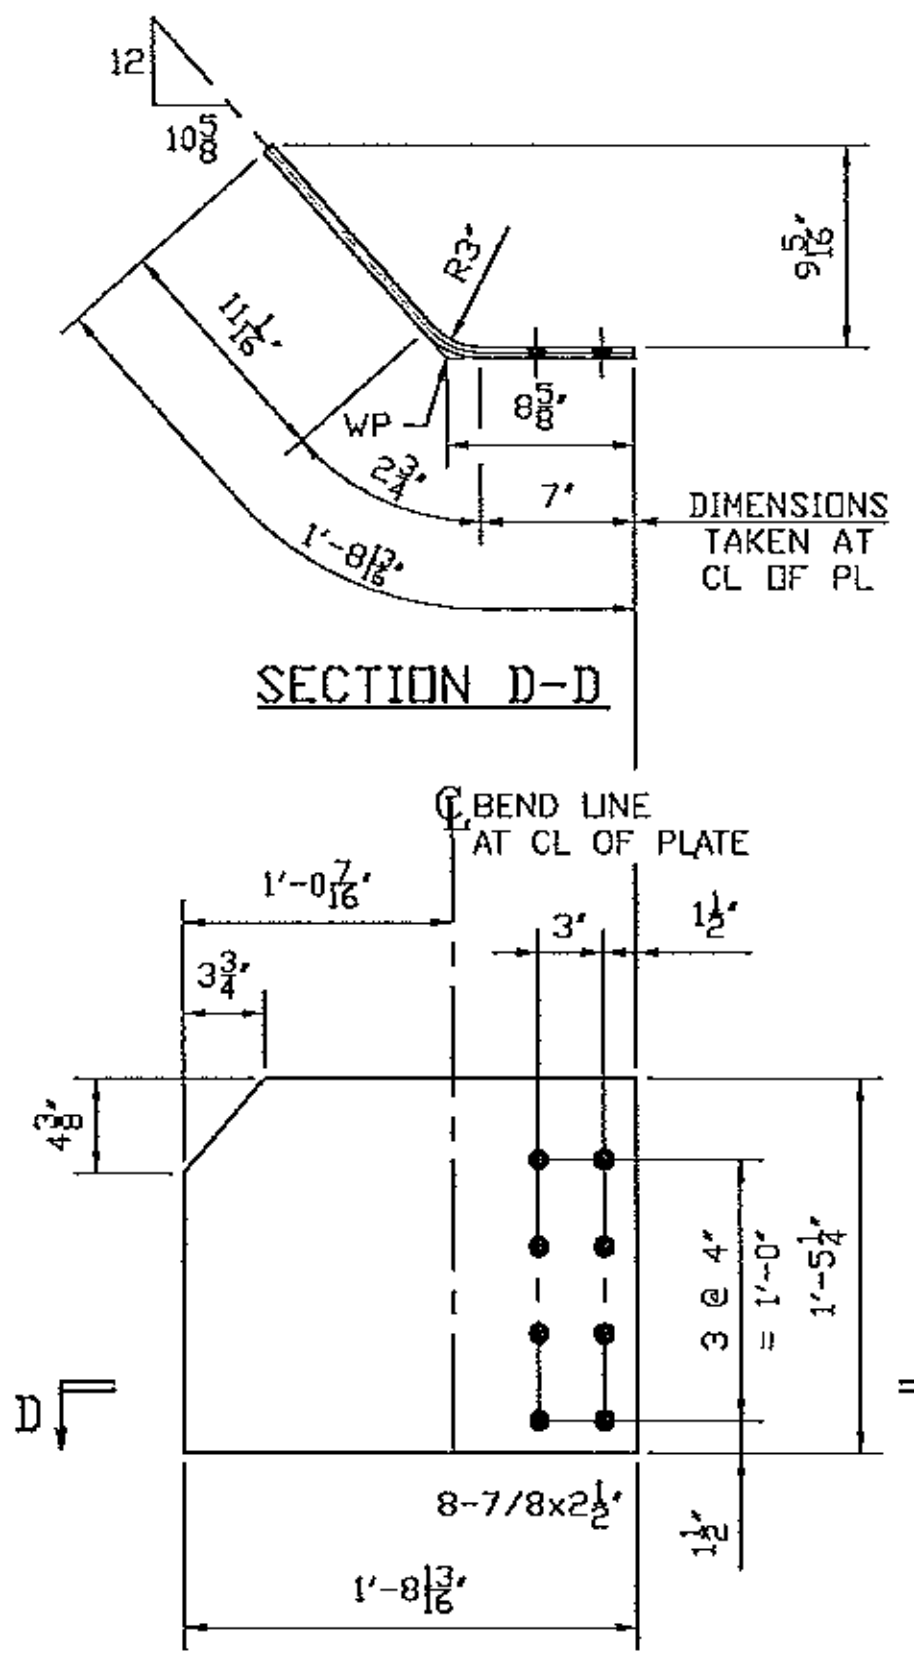

ONE - GUSSET 117M4  
PRIMED  
(DEVELOPED)

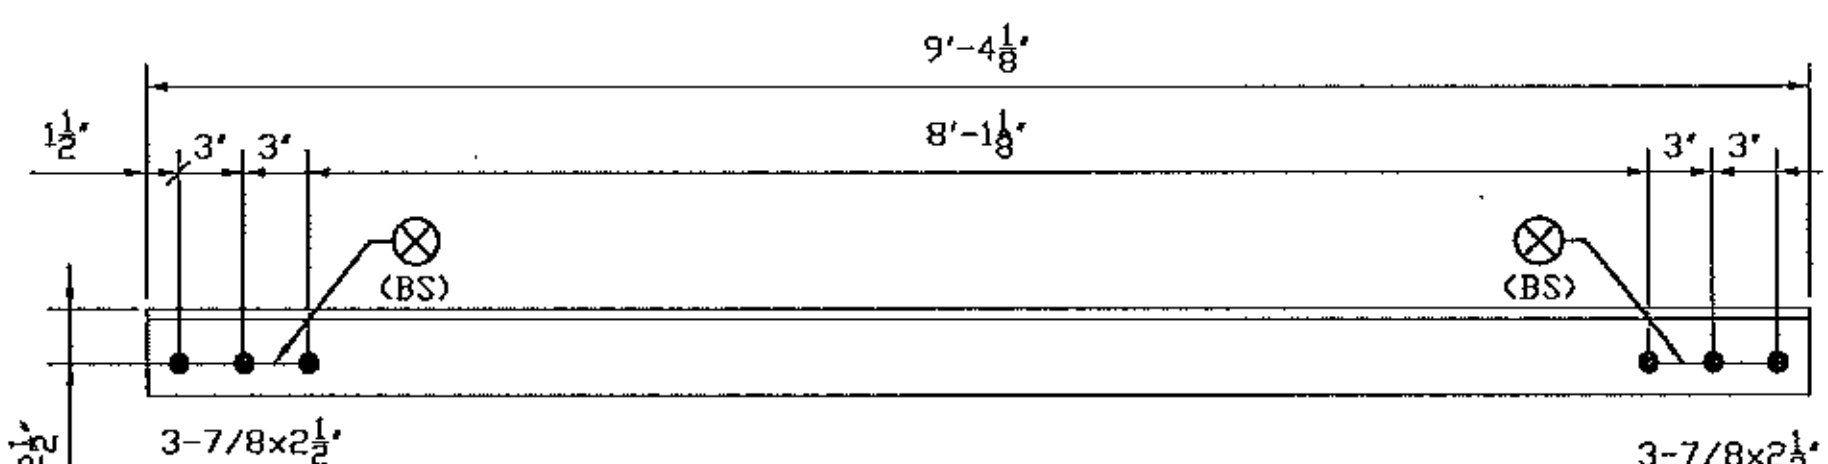

ONE - ANGLE 117M5  
PAINTED

GENERAL NOTES: SEE GN100  
HOLES: 15/16 (U.N.)  
CLEANING AND PAINTING: SEE SHEET P100 AND P101

No	REVISION	DATE	PAR	VER.
0	CROSSFRAME MODIFIED	01/16/13	BR	GG

PRIMER ONLY, NO PAINT BOTH SIDES 75 MM DIA AROUND HOLE WHERE NOTED WITH THIS SYMBOL  
(BS)

BILL OF MATERIAL									
Mark	Qty.	Description	SU	Length	Remark	ABM	Total (lbs)	Seq	Qty
			Grd				Weight		/Seq
▲ 117M1	ONE	GUSSET				30	30	1	1
▲ 117M1	1	PL1/2x12	A70950W	1-5 13/16	PRIMER	104-4			
▲ FB		FIELD_BOLTS							
▲ 78F2	2	.7/8 Dia A325 TYP3		2	1FL WASH				
▲ 78F212	8	.7/8 Dia A325 TYP3		2	1/2 1FL WASH				
▲ 117M2	ONE	GUSSET				44	44	1	1
▲ 117M2	1	PL1/2x15	A70950W	1-8 13/16	PRIMER	104-4			
▲ FB		FIELD_BOLTS							
▲ 78F212	8	.7/8 Dia A325 TYP3		2	1/2 1FL WASH				
▲ 117M3	ONE	GUSSET				30	30	1	1
▲ 117M3	1	PL1/2x12	A70950W	1-5 7/8	PRIMER	104-4			
▲ FB		FIELD_BOLTS							
▲ 78F2	2	.7/8 Dia A325 TYP3		2	1FL WASH				
▲ 78F212	8	.7/8 Dia A325 TYP3		2	1/2 1FL WASH				

BILL OF MATERIAL									
Mark	Qty.	Description	SU	Length	Remark	ABM	Total (lbs)	Seq	Qty
			Grd				Weight		/Seq
▲ 117M4	ONE	GUSSET				44	44	1	1
▲ 117M4	1	PL1/2x15	A70950W	1-8 13/16	PRIMER	104-4			
▲ FB		FIELD_BOLTS							
▲ 78F212	8	.7/8 Dia A325 TYP3		2	1/2 1FL WASH				
▲ 117M5	1	ANGLE				120	120	1	1
▲ 117M5	1	L4x4x1/2	A70950W	9-4 1/8	PAINT	104-2			
▲ FB		FIELD_BOLTS							
▲ 78F212	6	.7/8 Dia A325 TYP3		2	1/2 1FL WASH				

Vermont Agency of Transportation  
**RECEIVED**  
CK'D BY M.E.M. OK'D BY C.W.M.  
Jan. 29, 2013  
RESUBMIT APPROVED AS NOTED  
BY C. CARLSON DATE 01-29-2013

NOTE: BOLT 1 WASHER: 1 WASHER UNDER NUT U.N.  
BOLT 2 WASHER: 1 WASHER UNDER HEAD U.N.  
1 WASHER UNDER HEAD U.N.






**STRUCTAL**  
Bridges  
286 River Road, Claremont, NH 03743  
Tel: (603) 542-5202 Fax: (603) 542-5312  
a division of CANAM INC.

PROJECT: VT RT 9, BRIDGE NO. 11  
TOWN OF WOODFORD, VT  
OVER WALDOMSAC RIVER

TITLE: ABUTMENT CROSS FRAME

REFERENCE: PROJECT NO. ER BHF 010-1 (44)

BY: BR	DATE: JAN 2013	CONTRACT NO: UN04260
BY: GG	DATE: JAN 2013	117

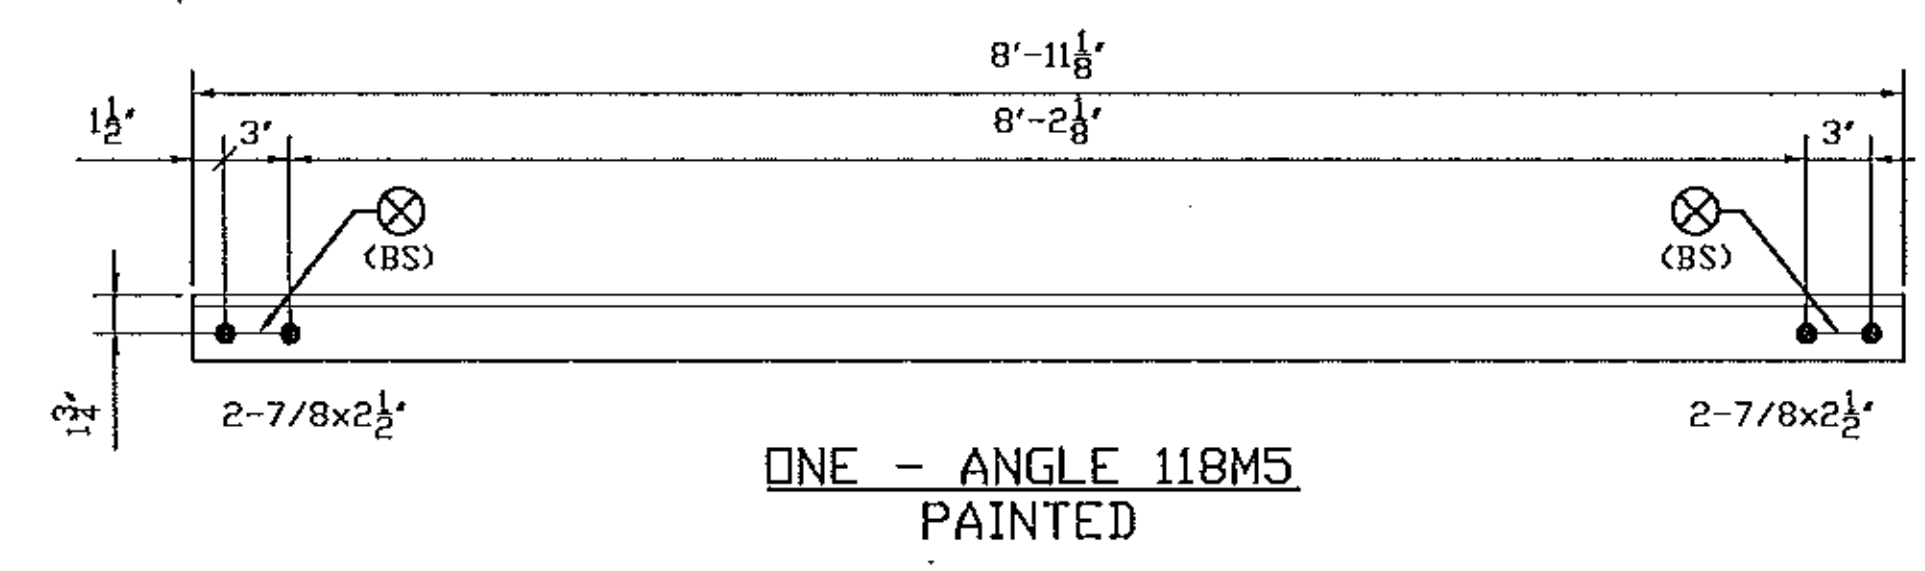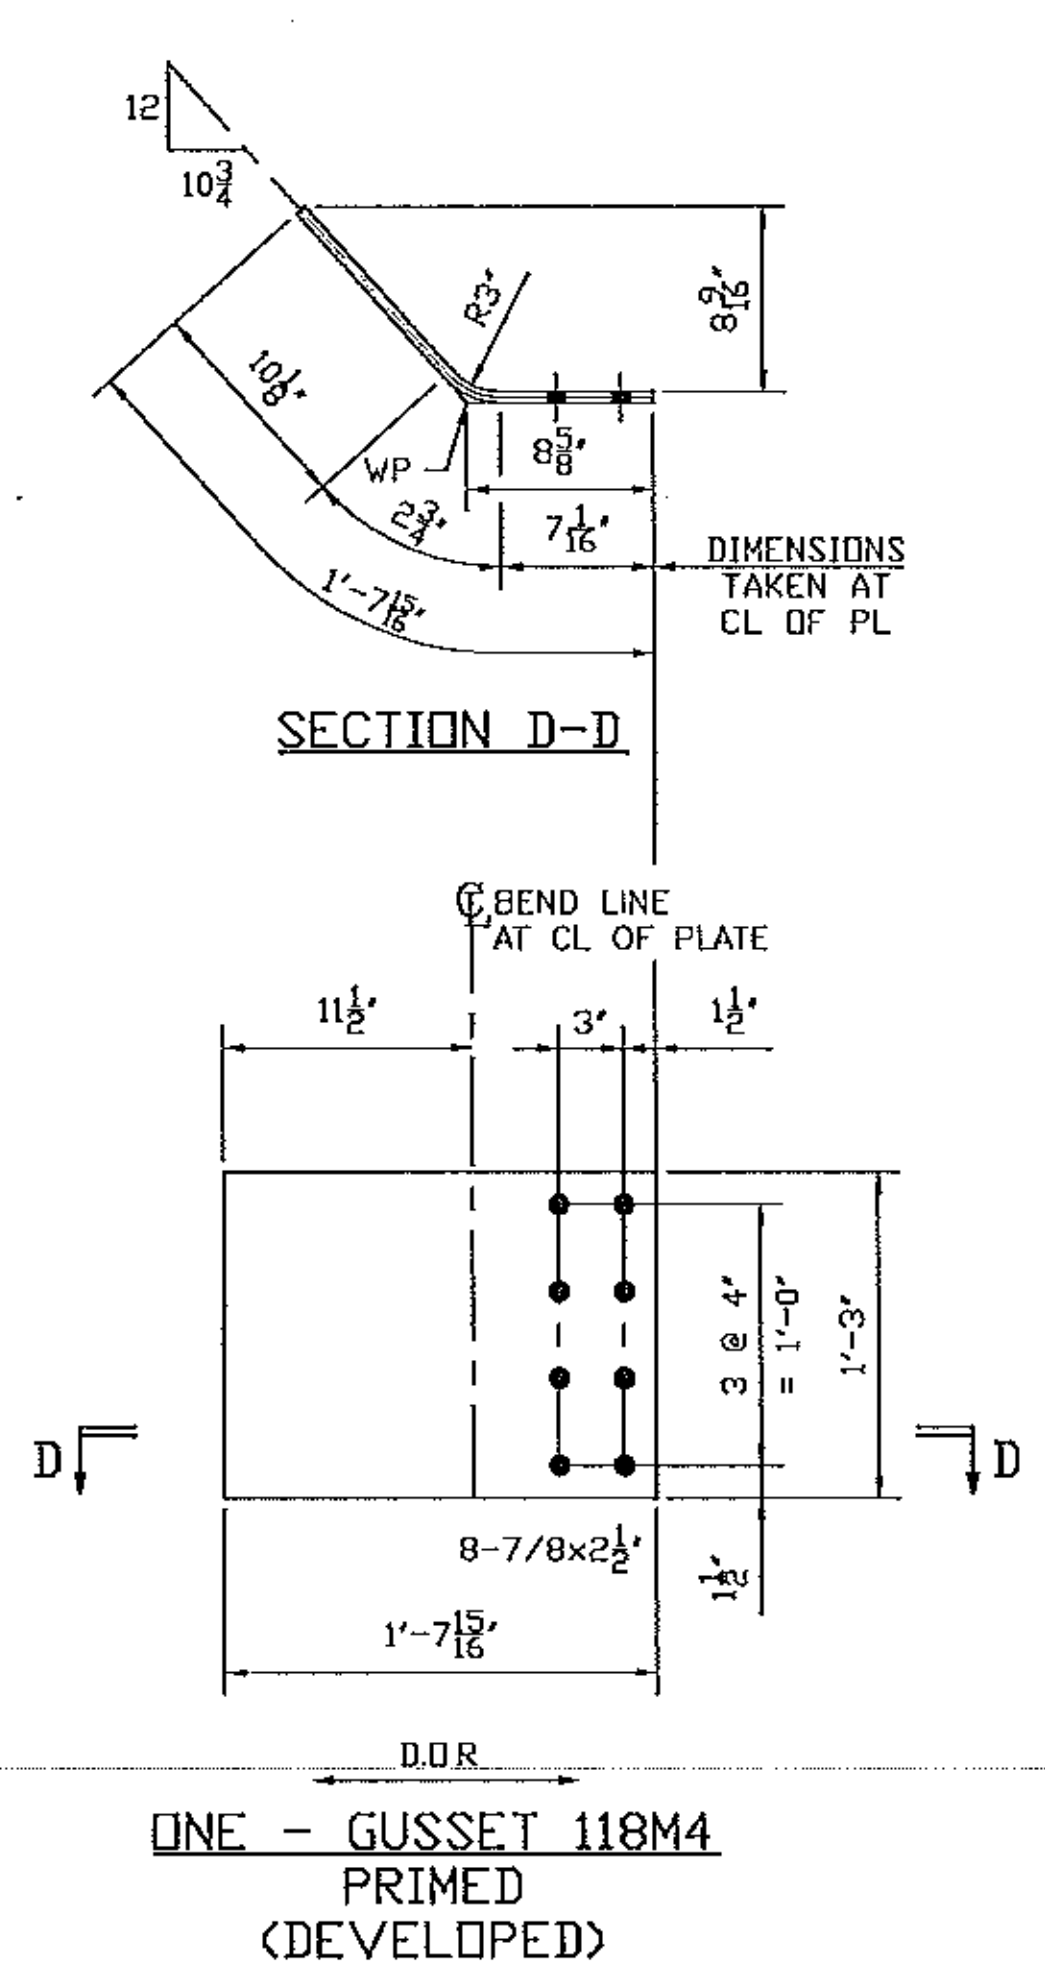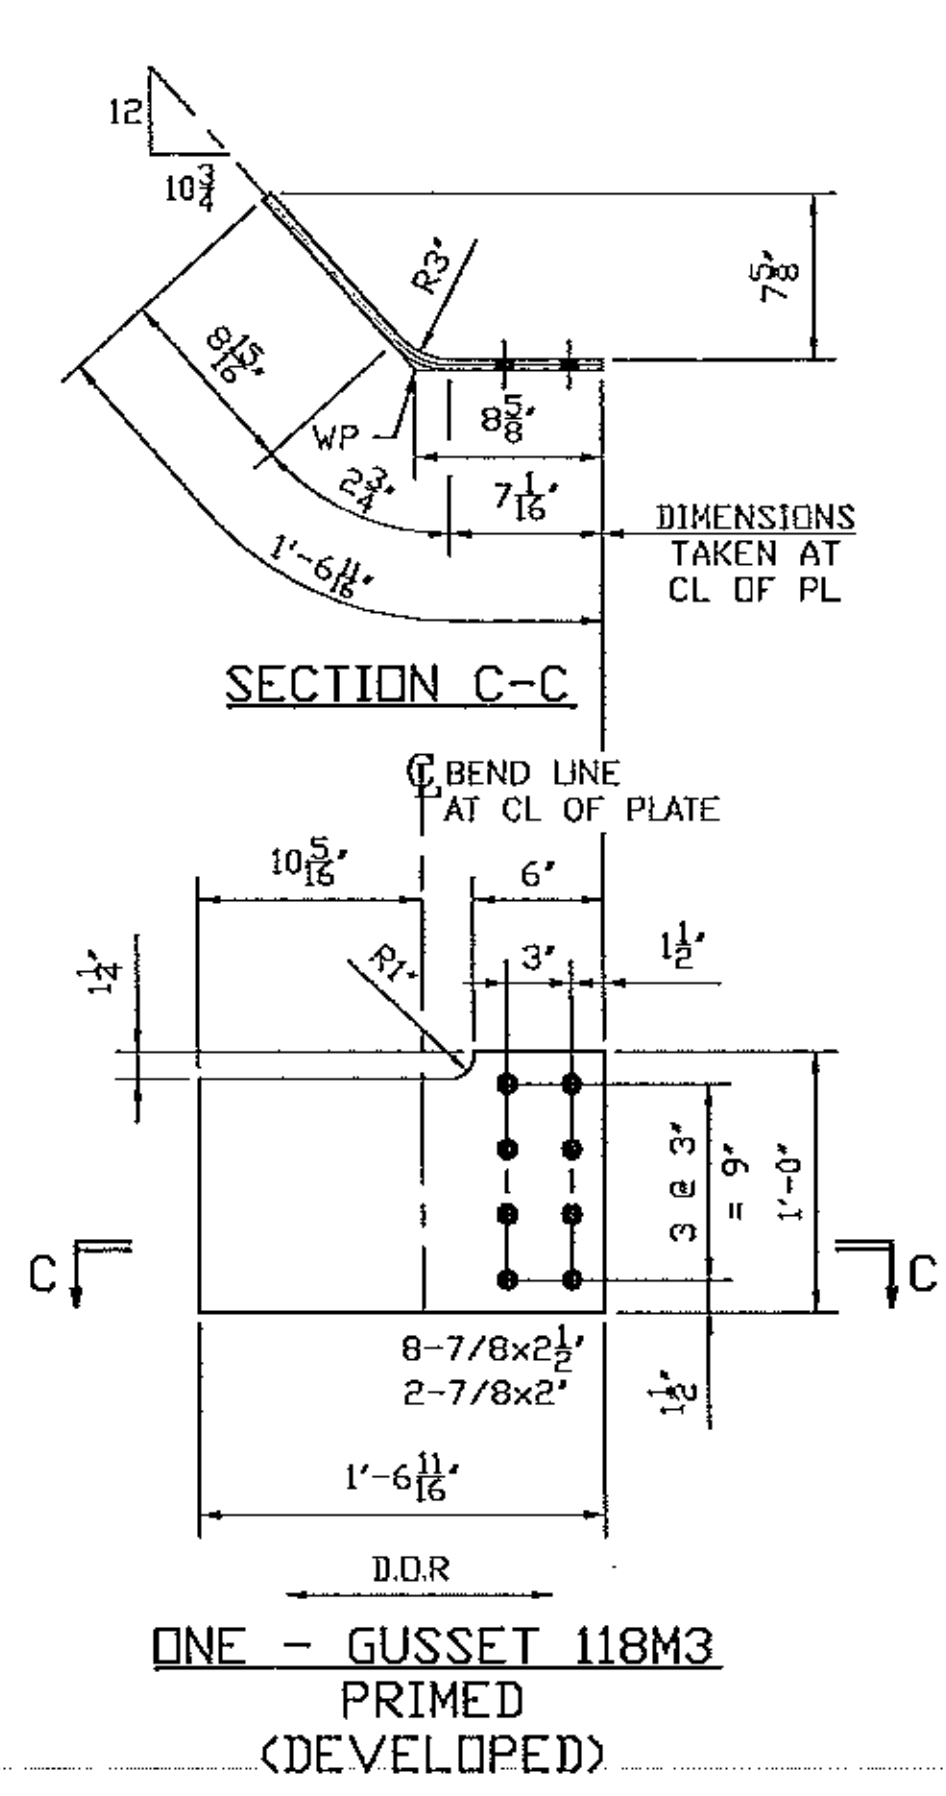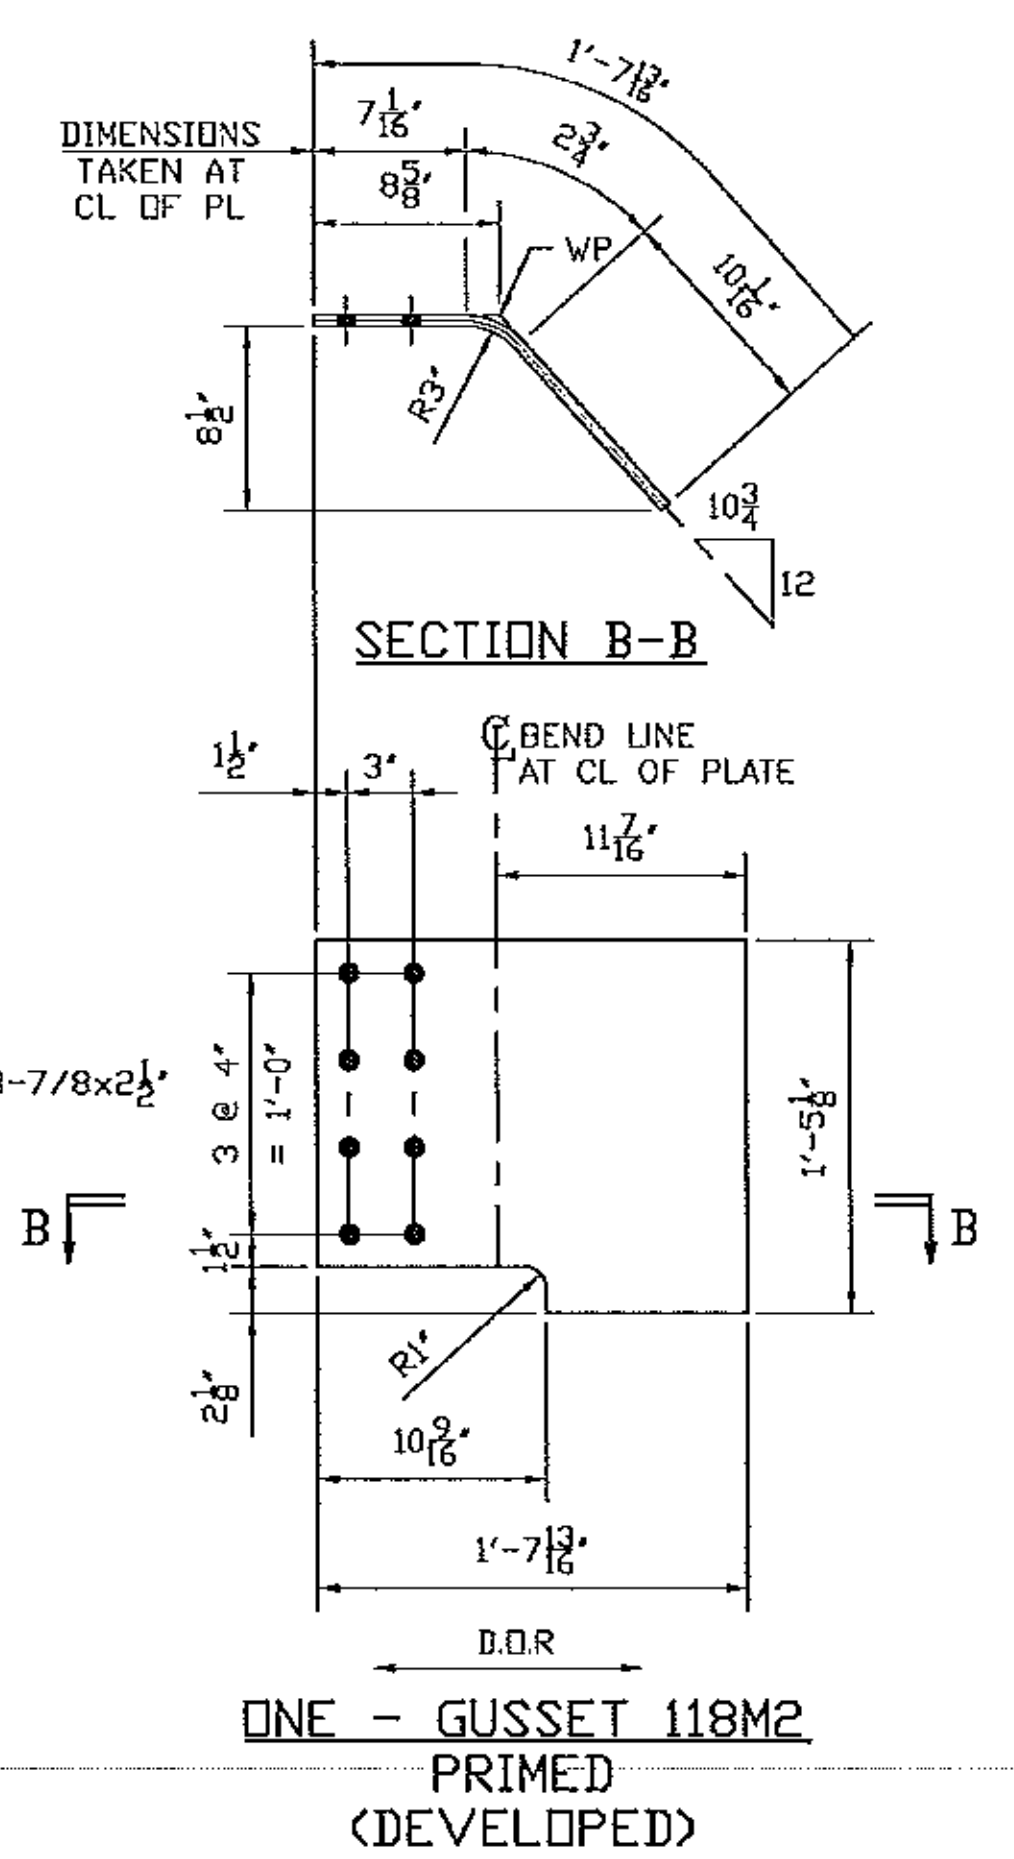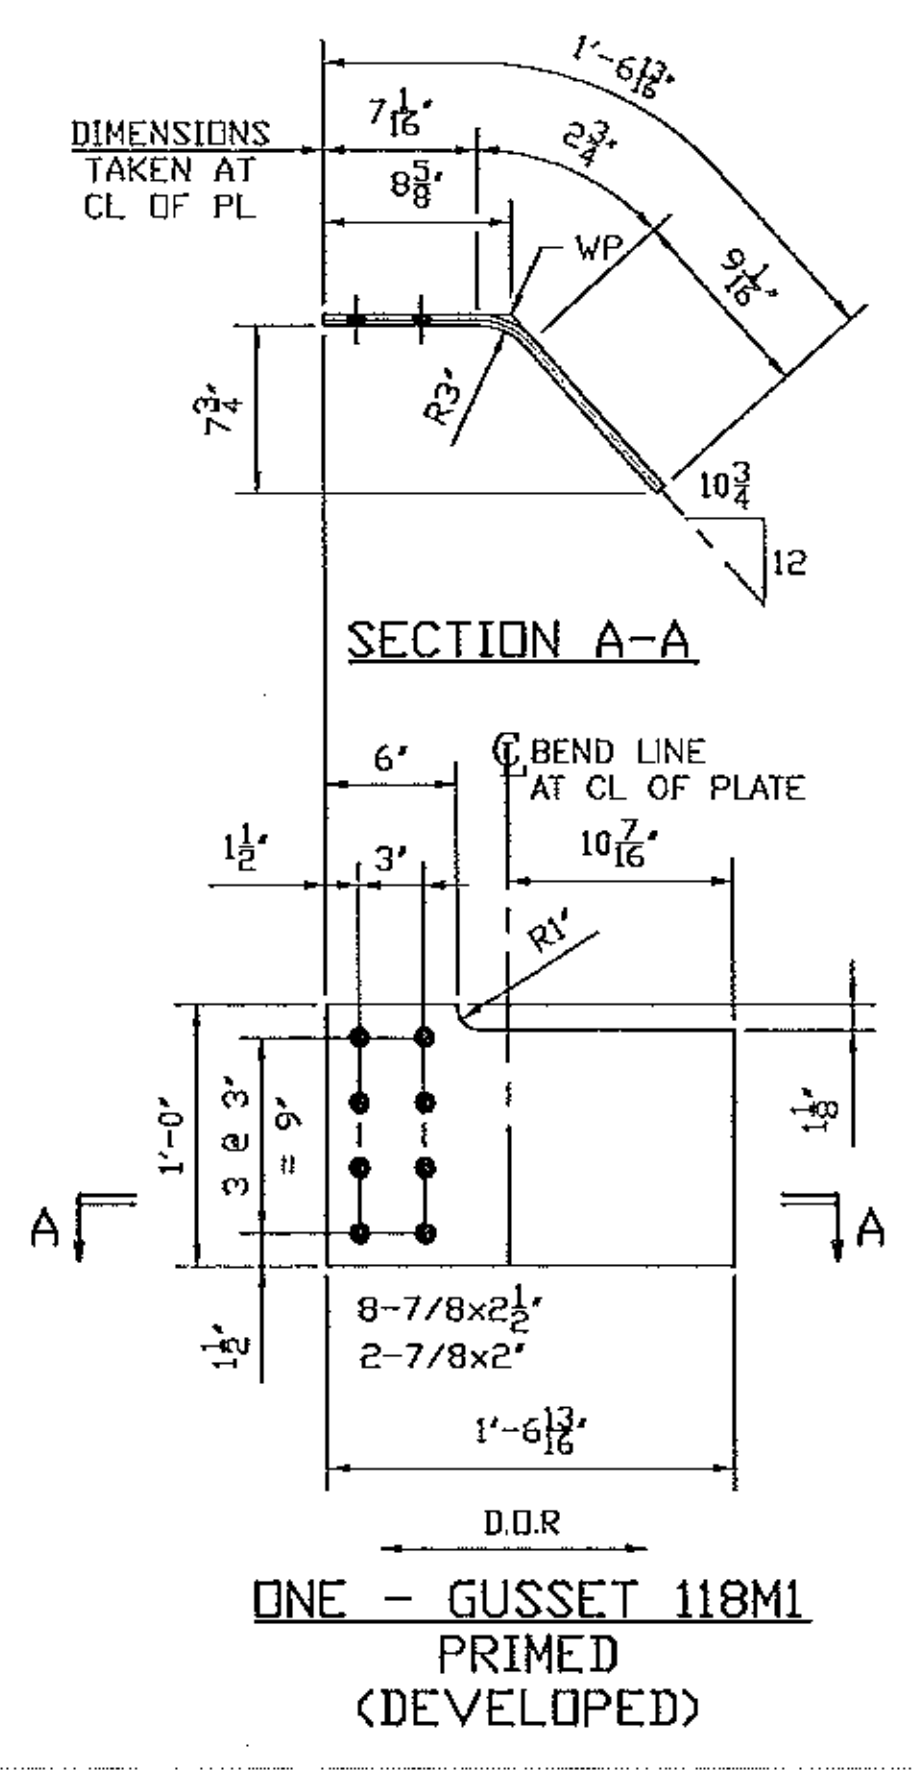

GENERAL NOTES: SEE GN100  
 HOLES: 15/16 (U.N.)  
 CLEANING AND PAINTING: SEE SHEET P100 AND P101

No	REVISION	DATE	PAR	VER.
1	CROSSFRAME MODIFIED	01/16/13	BR	GG

Mark	Qty.	Description	SIU Grd	Length	Remark	ABM	Total (lbs) Weight	Seq	Qty /Seq
117M1	ONE	GUSSET				32	48	1	1
117M1	1	PL1/2x12	A70950W	1-6 13/16	PRIMER	103-4	32		
FB		FIELD_BOLTS							
78F2	2	.7/8 Dia A325 TYP3		2 1/2	1FL WASH				
78F212	8	.7/8 Dia A325 TYP3		2 1/2	1FL WASH				
117M2	ONE	GUSSET				48	54	1	1
117M2	1	PL1/2x17 1/8	A70950W	1-7 13/16	PRIMER	103-4	48		
FB		FIELD_BOLTS							
78F212	8	.7/8 Dia A325 TYP3		2 1/2	1FL WASH				
117M3	ONE	GUSSET				32	48	1	1
117M3	1	PL1/2x12	A70950W	1-6 11/16	PRIMER	103-4	32		
FB		FIELD_BOLTS							
78F2	2	.7/8 Dia A325 TYP3		2 1/2	1FL WASH				
78F212	8	.7/8 Dia A325 TYP3		2 1/2	1FL WASH				

Mark	Qty.	Description	SIU Grd	Length	Remark	ABM	Total (lbs) Weight	Seq	Qty /Seq
117M4	ONE	GUSSET				42	48	1	1
117M4	1	PL1/2x15	A70950W	1-7 15/16	PRIMER	103-4	42		
FB		FIELD_BOLTS							
78F212	8	.7/8 Dia A325 TYP3		2 1/2	1FL WASH				
118M5	1	CROSS FRAME				84	84	1	1
118M5	1	L3x3x1/2	A70950W	8-11 1/8	PAINT	103-2	84		
FB		FIELD_BOLTS							
78F212	4	.7/8 Dia A325 TYP3		2 1/2	1FL WASH				

Vermont Agency of Transportation  
**RECEIVED**  
 CK'D BY M.E.M. OK'D BY C.W.M.  
 Jan. 29, 2013  
 RESUBMIT APPROVED AS NOTED ✓  
 BY C. CARLSON DATE 01-29-2013

NOTE: BOLT 1 WASHER: 1 WASHER UNDER NUT U.N.  
 BOLT 2 WASHER: 1 WASHER UNDER HEAD U.N.  
 1 WASHER UNDER HEAD U.N.

**STRUCTAL**  
 Bridges  
 386 River Road, Claremont, NH 03743  
 Tel: (603) 542-5202 Fax: (603) 542-5312

PROJECT: VT RT 9, BRIDGE NO. 11 TOWN OF WOODFORD, VT OVER WALDOOMSAC RIVER

TITLE: ABUTMENT CROSS FRAME

REFERENCE: PROJECT NO. ER BHF 010-1 (44)

DESIGNED BY: BR	DATE: JAN 2013	CONTRACT NO: UN04260
CHECKED BY: GG	DATE: JAN 2013	SCALE: 118

State of Vermont  
Program Development  
One National Life Drive  
Montpelier, VT 05633-5001  
www.aot.state.vt.us

Agency of Transportation

[phone] 802-828-2621  
[fax] 802-828-3566  
[ttd] 800-253-0191

July 27, 2012

Structal Bridges  
386 River Road  
Claremont, NH 03743

Project Name: Woodford Project #: ER BHF 010-1(44)

Structure Identification: VT 9 Over the Roaring Branch of the Walloomsac River

The following structural steel details item 506.13, "Structural Steel, Plate Girder" for the above project (Vendor's Job #UN042601), transmitted by T. Buck Construction, Inc. and received by our office on Monday, July 9, 2012, have been reviewed and are being returned herewith.

Sheets 101-1, 102-1, 103-1, 104-1, 105-1, 106-1, E100-E103, GN100, P100, P101, X102 and the welding procedures are approved.

Sheet 101-2, 101-3, 102-2, 102-3, 103-2, 103-3, 104-2, 104-3, 105-2, 105-3, 106-2, 106-3, 107-116, and X101 are approved "as noted". (Please make appropriate changes as indicated on the "as noted" drawing and submit a new "\*.pdf" for our use in the record plans for this project.)

You must provide notice to our fabrication inspector Jeff Clark as to the date fabrication represented by these drawings will begin. Jeff may be contacted by phone at (802)828-0044 or email at [jeff.clark@state.vt.us](mailto:jeff.clark@state.vt.us). That notice must be received at least seven days prior to that date, as per Specification 506.03. Any material fabricated prior to the notification date is subject to rejection without further cause.

Sincerely,

Carolyn W. Carlson, PE  
Project Manager

Attachments

cc: [X] Resident Engineer Ron Lemaire -w/prints  
[X] T. Buck Construction, Inc. – w/prints  
[X] Shop Inspector - Jeff Clark w/prints  
[X] Materials & Research Section (C&IA Unit) – Letter only  
[X] F.R. Lafayette – w/prints  
[X] Construction Division - Letter only  
[X] CWC



Contractor/Organization: STRUCTAL, Div. Canam  
Welding process(es): FCAW  
Type: Semi Auto or Auto

WPS : FC-1001  
Revision: 0 Date: 06/25/2012 By: Tyler Gaunt  
Authorized by: *Tyler Gaunt* Date: 06/25/2012  
Supporting PQR: PQR-FC-50W-50W-3G-WM23

**JOINT DESIGN USED**  
Backing: N/A Mat'l: N/A  
Root Opening: N/A Rf Dim.: N/A  
Groove Angle: N/A Radius (J, U): N/A  
Backgouging: N/A Method: N/A  
Root Treatment: Grind or Blast to Bare Metal

**POSITION**  
Position of Groove: N/A Fillet: 3F  
Vertical progression : Vertical UP

**BASE METALS**  
Material Spec: A709 Type or Grade: Gr.36, 50, 50W  
Size of Groove: N/A Size of fillet: 5/16"

**ELECTRICAL CHARACTERISTICS**  
Transfer mode: N/A Current: DCEP  
ESO: 3/4" +/- 1/8" Other: N/A

**FILLER METALS**  
AWS Spec.: A5.20 AWS Class.: 81T1-Ni1C H8  
Manufacturer Trade Name: ESAB 810X-Ni1

**TECHNIQUE**  
Stringer or Weave Bead: STRINGER  
Single or multiple pass: Single  
Nb of Electrodes: 1  
Electrode spacing :  
Longitudinal: N/A, Lateral: N/A, Angle: varies  
Interpass Cleaning: REMOVE ALL CONTAMINANTS

**SHIELDING**  
Flux: N/A Mfg Trade Name: N/A  
Dew Point: -40° F Cup size: N/A  
Gas composition: 100% CO<sub>2</sub> Flow Rate: 40 CFH minimum

**PREHEAT - Maximum interpass : N/A**

**POSTWELD HEAT TREATMENT**  
Temperature: N/A Holding Time: N/A  
Heating/Cooling rate: N/A

MINIMUM PREHEAT & INTERPASS TEMPERATURE		
Thickness of thickest part at point of welding	FCM Application	Non FCM Application
t ≤ 3/4 (in.)	150 °F	50 °F
3/4 < t ≤ 1-1/2 (in.)	250 °F	70 °F
1-1/2 < t ≤ 2-1/2 (in.)	325 °F	150 °F
2-1/2 > t (in.)	350 °F	225 °F

**HEAT INPUT**  
Min. Heat Input: 26.4 kJ/in Max. Heat input: 45.9 kJ/in

- Note1: For Fillet Welding on Secondary members  
Note2: For Stiffener to Flange fillet welds on Main Members  
Note3: For Fillet Welding of Drip Bars

(S)	PASS	ELECT. SIZE	WELDING CURRENT		TRAVEL SPEED (IN/MIN)	JOINT DETAIL
			AMPS	VOLTS		
5/16"	1	1/16"	200-239	24-25	5 - 7	
1/4"	1	1/16"	200-239	24-25	5-7	

THIS PROCEDURE MAY VARY DUE TO FABRICATION SEQUENCE, FIT-UP, PASS SIZE, ETC. WITHIN THE LIMITATION OF VARIABLES GIVEN IN SECTION 5 OF AWS D1.5:2010.

CK'D \_\_\_\_\_  
VTrans Received *JW*  
OK'D BY \_\_\_\_\_

JUL 11 2012

Contractor/Organization: STRUCTAL, Div. Canam  
Welding process(es): FCAW  
Type: Semi Auto or Auto

WPS : FC-1002  
Revision: 0 Date: 06/25/2012 By: Tyler Gaunt  
Authorized by: *Tyler Gaunt* Date: 06/25/2012  
Supporting PQR: PQR-FC-50W-50W-1G-WM23

**JOINT DESIGN USED**  
Backing: N/A Mat'l: N/A  
Root Opening: N/A Rf Dim.: N/A  
Groove Angle: N/A Radius (J, U): N/A  
Backgouging: N/A Method: N/A  
Root Treatment: Grind or Blast to Bare Metal

**POSITION**  
Position of Groove: N/A Fillet: 1F or 2F  
Vertical progression : Vertical UP

**BASE METALS**  
Material Spec: A709 Type or Grade: Gr.36, 50, 50W  
Size of Groove: N/A Size of fillet: 5/16"

**ELECTRICAL CHARACTERISTICS**  
Transfer mode: N/A Current: DCEP  
ESO: 3/4" +/- 1/4" Other: N/A

**FILLER METALS**  
AWS Spec.: A5.20 AWS Class.: 81T1-Ni1C H8  
Manufacturer Trade Name: ESAB 810X-Ni1

**TECHNIQUE**  
Stringer or Weave Bead: STRINGER  
Single or multiple pass: Single  
Nb of Electrodes: 1  
Electrode spacing :  
Longitudinal: N/A, Lateral: N/A, Angle: varies  
Interpass Cleaning: REMOVE ALL CONTAMINANTS

**SHIELDING**  
Flux: N/A Mfg Trade Name: N/A  
Dew Point: -40° F Cup size: N/A  
Gas composition: 100% CO<sub>2</sub> Flow Rate: 40 CFH minimum

**PREHEAT – Maximum interpass : N/A**

**POSTWELD HEAT TREATMENT**  
Temperature: N/A Holding Time: N/A  
Heating/Cooling rate: N/A

MINIMUM PREHEAT & INTERPASS TEMPERATURE		
Thickness of thickest part at point of welding	FCM Application	Non FCM Application
t ≤ 3/4 (in.)	150 °F	50 °F
3/4 < t ≤ 1-1/2 (in.)	250 °F	70 °F
1-1/2 < t ≤ 2-1/2 (in.)	325 °F	150 °F
2-1/2 > t (in.)	350 °F	225 °F

**HEAT INPUT**  
Min. Heat Input: 27.3 kJ/in Max. Heat input: 45.4 kJ/in

- Note1: For Fillet Welding on Secondary members  
Note2: For Stiffener to Flange fillet welds on Main Members  
Note3: For Fillet Welding of Drip Bars

(S)	PASS	ELECT. SIZE	WELDING CURRENT		TRAVEL SPEED (IN/MIN)	JOINT DETAIL
			AMPS	VOLTS		
5/16"	1	1/16"	300-325	28-30	13-14	
1/4"	1	1/16"	200-239	28-30	13-14	

THIS PROCEDURE MAY VARY DUE TO FABRICATION SEQUENCE, FIT-UP, PASS SIZE; ETC. WITHIN THE LIMITATION OF VARIABLES GIVEN IN SECTION 5 OF AWS D1.5:2010.

VTrans  
Received  
CK'D BY: *JWC*

JUL 11 2012

Contractor/Organization: STRUCTAL, Div. Canam  
Welding process(es): SAW  
Type: Semi Auto or Auto

WPS : S-1001  
Revision: 0 Date: 06/25/2012 By: Tyler Gaunt  
Authorized by: *Tyler Gaunt* Date: 06/25/2012  
Supporting PQR: PQR Ortho 1G DCEN

**JOINT DESIGN USED**  
Backing: N/A Mat'l: N/A  
Root Opening: N/A Rf Dim.: N/A  
Groove Angle: N/A Radius (J, U): N/A  
Backgouging: N/A Method: N/A  
Root Treatment: Grind or Blast to Bare Metal

**POSITION**  
Position of Groove: N/A Fillet: 1F or 2F  
Vertical progression : N/A

**BASE METALS**  
Material Spec: A709 Type or Grade: Gr.36, 50, Gr.50W  
Size of Groove: N/A Size of fillet: 5/16"

**ELECTRICAL CHARACTERISTICS**  
Transfer mode: N/A Current: DCEN  
ESO: 1-1/4" +/- 1/4" Other: N/A

**FILLER METALS**  
AWS Spec.: A5.17 AWS Class.: EM12K-H8  
Manufacturer Trade Name: ESAB Spoolarc 81

**TECHNIQUE**  
Stringer or Weave Bead: STRINGER  
Single or multiple pass: Single  
Nb of Electrodes: 1  
Electrode spacing :  
Longitudinal: N/A, Lateral: N/A, Angle: varies  
Interpass Cleaning: REMOVE ALL CONTAMINANTS

**SHIELDING**  
Flux: ESAB Mfg Trade Name: OK 10.71  
Electrode Flux (Class): F7A5 Cup size: N/A  
Gas composition: N/A Flow Rate: N/A

**PREHEAT - Maximum interpass : N/A**

**POSTWELD HEAT TREATMENT**  
Temperature: N/A Holding Time: N/A  
Heating/Cooling rate: N/A

MINIMUM PREHEAT & INTERPASS TEMPERATURE		
Thickness of thickest part at point of welding	FCM Application	Non FCM Application
t ≤ 3/4 (in.)	150 °F	50 °F
3/4 < t ≤ 1-1/2 (in.)	250 °F	70 °F
1-1/2 < t ≤ 2-1/2 (in.)	325 °F	150 °F
2-1/2 > t (in.)	350 °F	225 °F




**HEAT INPUT**  
Min. Heat Input: 36.7 kJ/in Max. Heat input: 56.9 kJ/in

- Note1: For Fillet Welding on Main members  
Note2: For Fillet Welding on Secondary members  
Note3: Web to Flange fillet welds and stiffener to web fillet welds on main members shall be an automatic process

(S)	PASS	ELECT. SIZE	WELDING CURRENT		TRAVEL SPEED (IN/MIN)	JOINT DETAIL 1F or 2F (2F shown)
			AMPS	VOLTS		
5/16"	1	1/8"	590-630	32-34	24 - 25	
5/16"	1	3/32"	590-630	32-34	24 - 25	
<p>CRD _____ V trans received OK'D BY: <i>Jwc</i></p> <p>JUL 11 2012</p> <p>Resubmit BY: _____ APPROVED DATE: <i>7/25/12</i></p>						

THIS PROCEDURE MAY VARY DUE TO FABRICATION SEQUENCE, FIT-UP, PASS SIZE, ETC. WITHIN THE LIMITATION OF VARIABLES GIVEN IN SECTION 5 OF AWS D1.5:2010.



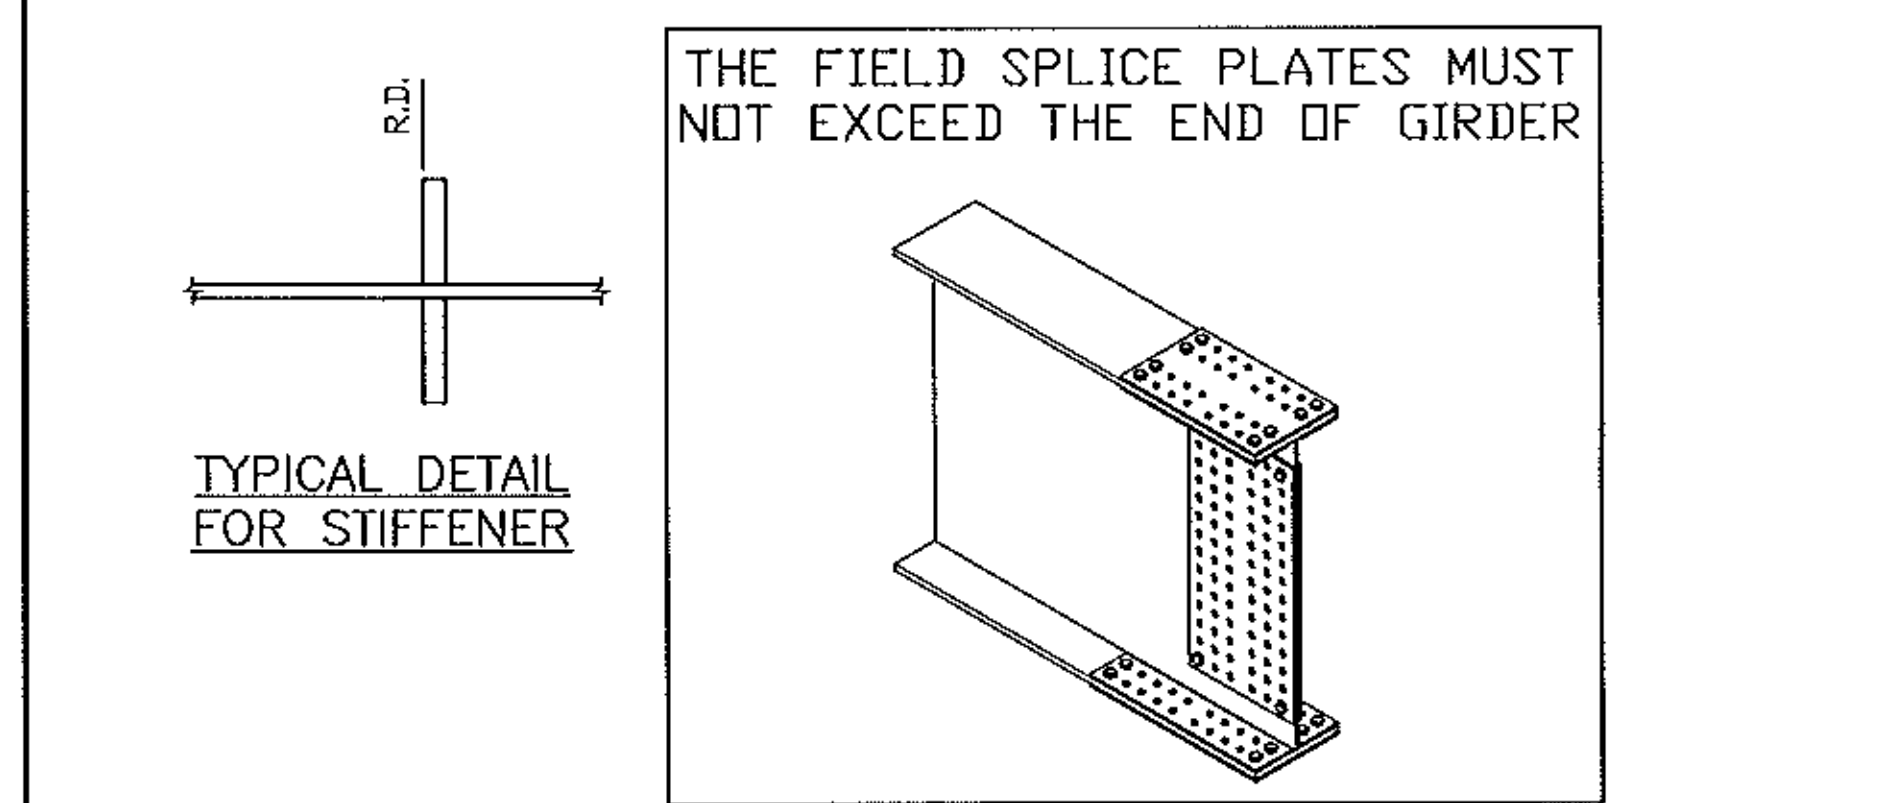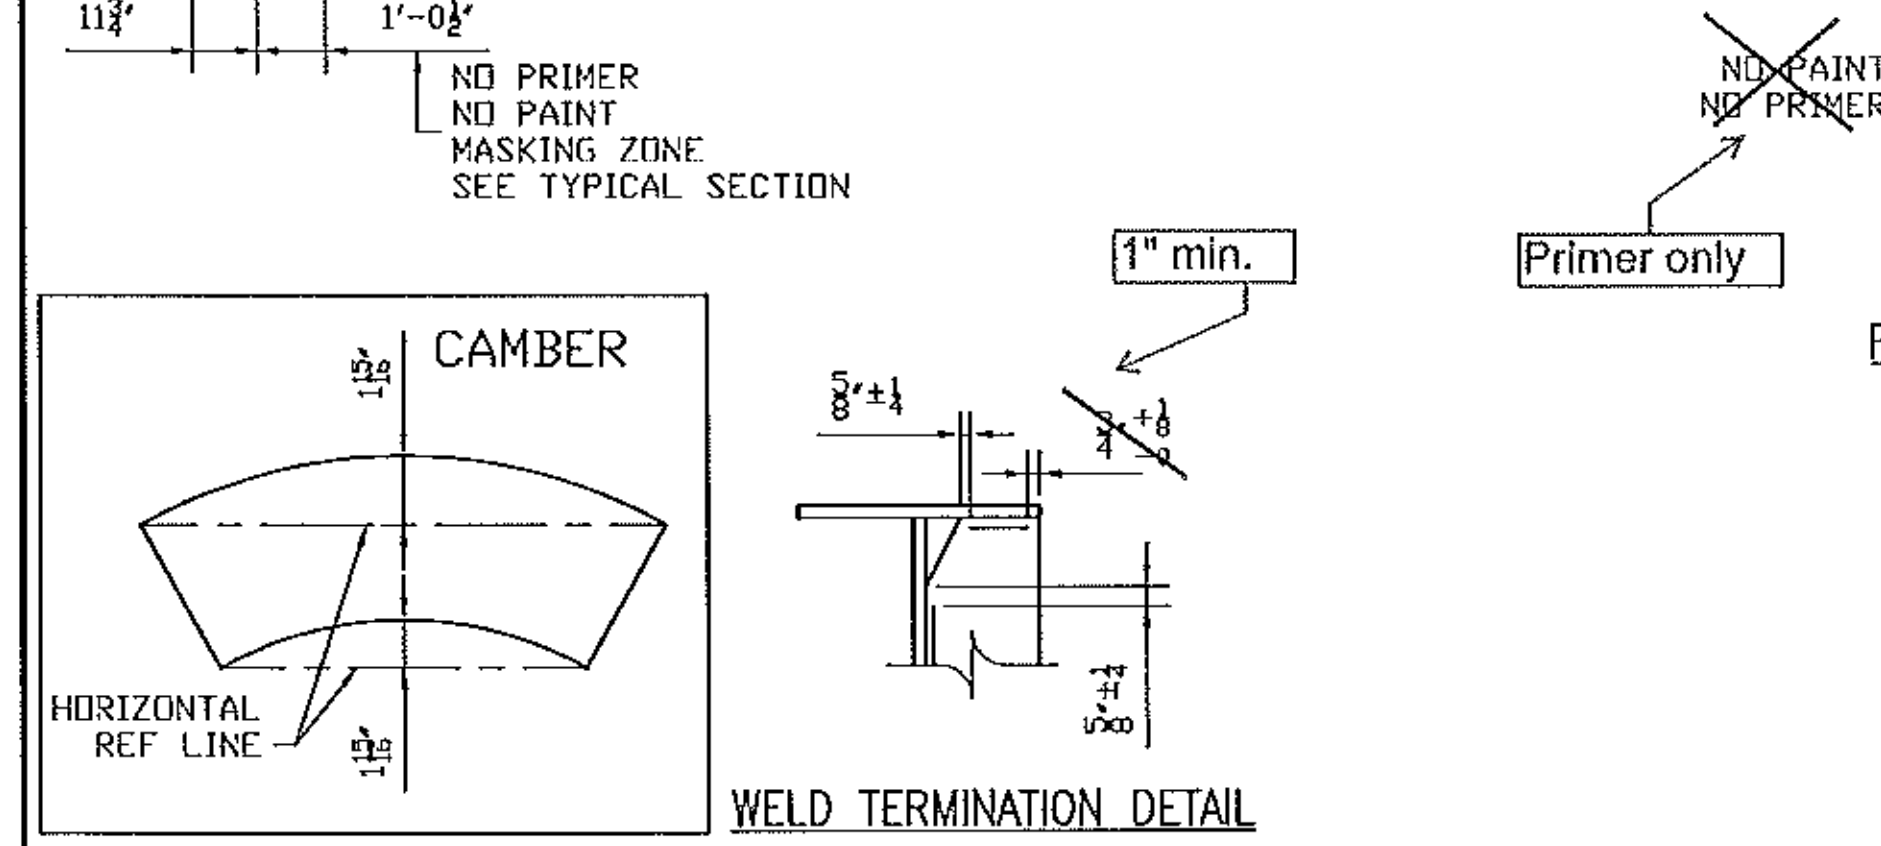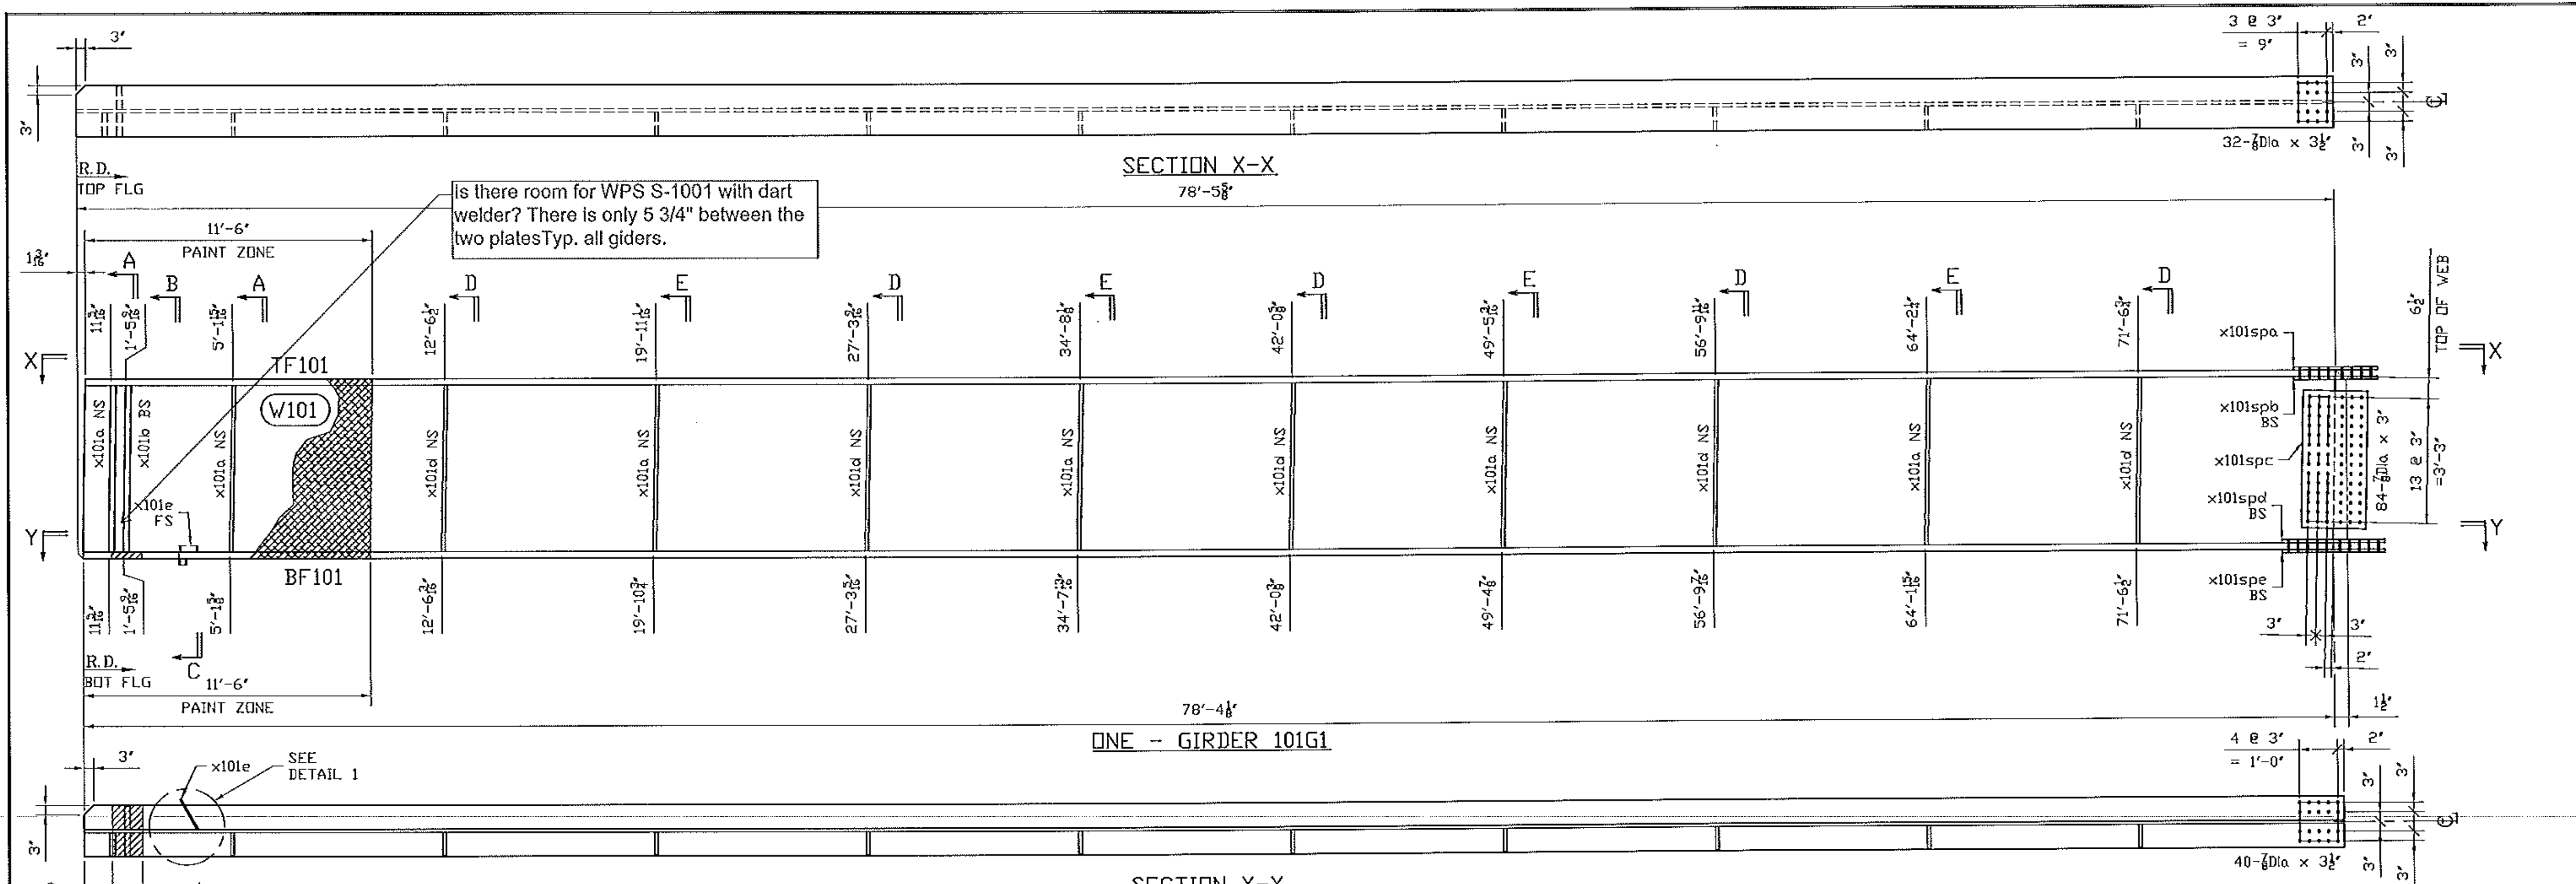

**BILL OF MATERIAL**

Mark	Qty.	Description	SU	Length	Remark	ABM	Total	Seq	Qty
			Grd				Weight		/Seq
101G1	ONE	GIRDER				16628	16753	H	1
101G1	1	GIRDER		78-5 5/8					
TF101	1	PL1x16	A70950WT2	78-4 7/16		100-1	4267		
W101	1	PL1/2x52	A70950WT2	78-5 5/8		100-2	6942		
BF101	1	PL1x16	A70950WT2	78-4 1/8		100-1	4265		
x101a	6	PL1/2x7 1/2	A70950WT2	4-4		101-2/3	332		
x101b	2	PL7/8x7 1/2	A70950WT2	4-4 NB		101-1	194		
x101d	5	PL1/2x7 1/2	A70950WT2	4-4		101-3	276		
x101e	1	PL1/4x3 1/8	A70950WT2	11		101-4	2		
x101spa	1	PL1/2x16	A70950WT2	2-2 1/4		102-1	60		
x101spb	2	PL1/2x7	A70950WT2	2-2 1/4		102-2	52		
x101spc	2	PL1/2x43	A70950WT2	8 1/4		102-3	101		
x101spd	2	PL1/2x7	A70950WT2	2-8 1/4		102-4	64		
x101spe	1	PL1/2x16	A70950WT2	2-8 1/4		102-5	73		
FB		FIELD BOLTS							
78F3	84	.7/8 Dia A325 TYP3			3 1/8 IFL WASH		67		
78F312	72	.7/8 Dia A325 TYP3			3 1/2 IFL WASH		78		


**GENERAL NOTES:** SEE GNI00  
**HOLES:** 15/16 (U.N.)  
**CLEANING AND PAINTING:** SEE SHEET P100 AND P101

See standard specification 506.24(a)(9), no payment will be made for bolts, nuts, washers, they are considered to be incidental


**Vermont Agency of Transportation**  
**RECEIVED**  
 CK'D BY M.E.M. OK'D BY C.W.M.  
 July 09, 2012  
 RESUBMIT APPROVED AS NOTED  
 BY C. CARLSON DATE 07-27-2012

FOR APPROVAL	07/06/12	BR	EG
REVISION	DATE	PAR	VER.
NOTE: BOLT 1 WASHER: 1 WASHER UNDER NUT U.N. BOLT 2 WASHER: 1 WASHER UNDER HEAD U.N. 1 WASHER UNDER HEAD U.N.			
<b>STRUCTURAL</b> Bridges 385 River Road, Clarendon, VT 05743 Tel: (802) 542-5282 Fax: (802) 542-5312			
PROJECT: VT RT 9, BRIDGE NO. 11 TOWN OF WOODFORD, VT OVER WALDOOMSAC RIVER			
TITLE: GIRDER 101G1			
REFERENCED: PROJECT NO. ER BHF 010-1 (44)			
DATE: BR	DATE: JULY 2012	CONTRACT NO: UN04260	
DATE: GG	DATE: JULY 2012	REVISED BY: 101-2	



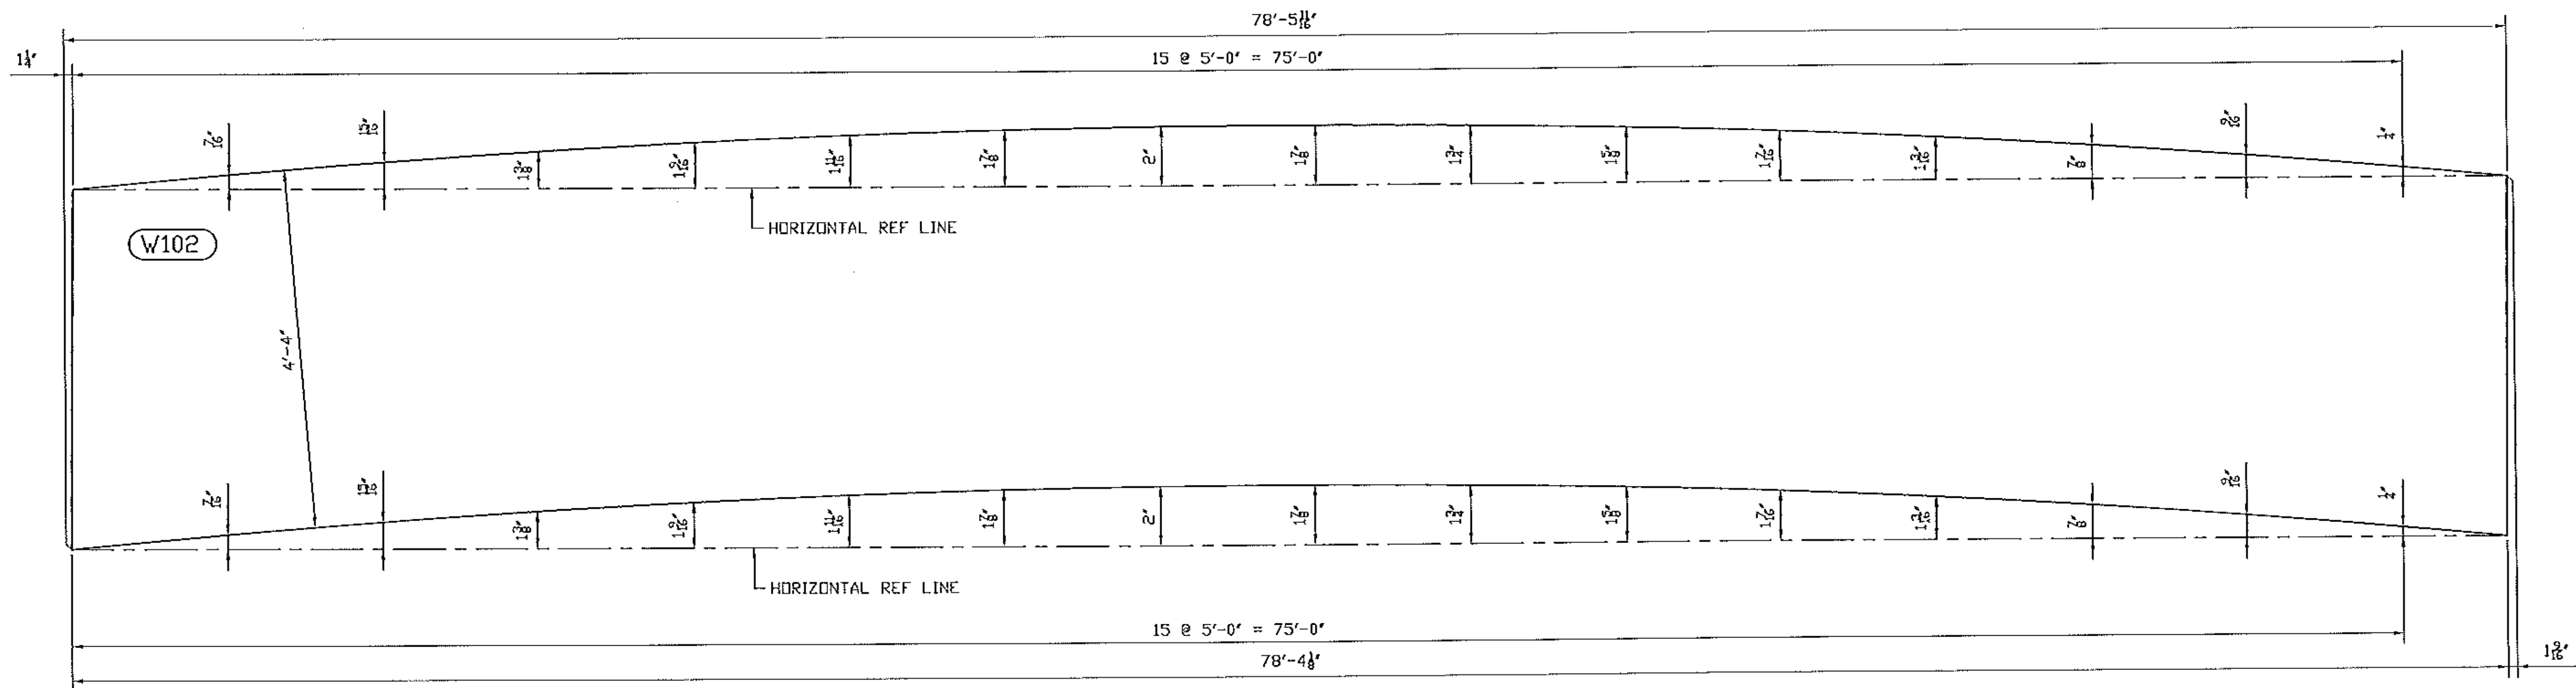

ONE WEB PLATE W102  
W102 = PL 1/2"

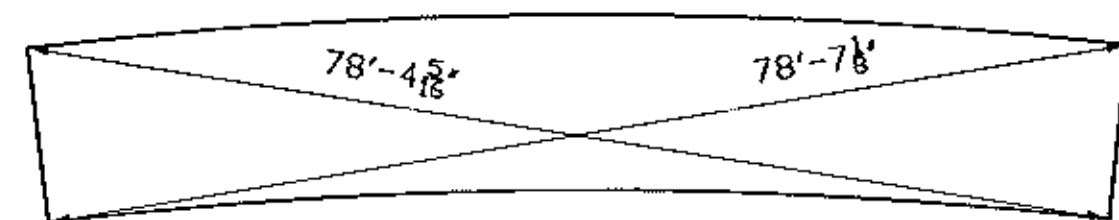

GENERAL NOTES: SEE GN100

No	REVISION	DATE	PAR	VER.
	FOR APPROVAL	07/06/12	BR	EG

NOTE: BOLT 1 WASHER: 1 WASHER UNDER NUT U.N.  
BOLT 2 WASHER: 1 WASHER UNDER HEAD U.N.  
1 WASHER UNDER HEAD U.N.

**STRUCTURAL**  
Bridges  
395 River Road, Claremont,  
NH 03743  
Tel: (603) 542-5202 Fax: (603) 542-5312

a division of  
**CANAM**  
Steel Inc.

PROJECT: VT RT 9, BRIDGE NO. 11  
TOWN OF WOODFORD, VT  
OVER WALDOMSAC RIVER

TITLE: GIRDER 102G1

REFERENCE: PROJECT NO. ER BHF 010-1 (44)



REV. BY	DATE	CONTRACT NO.
BR	JULY 2012	UN04260
GG	JULY 2012	102-1 A

Vermont Agency of Transportation  
**RECEIVED**

CK'D BY M.E.M. OK'D BY C.W.M.

July 09, 2012

RESUBMIT APPROVED ✓  
BY C. CARLSON DATE 07-27-2012

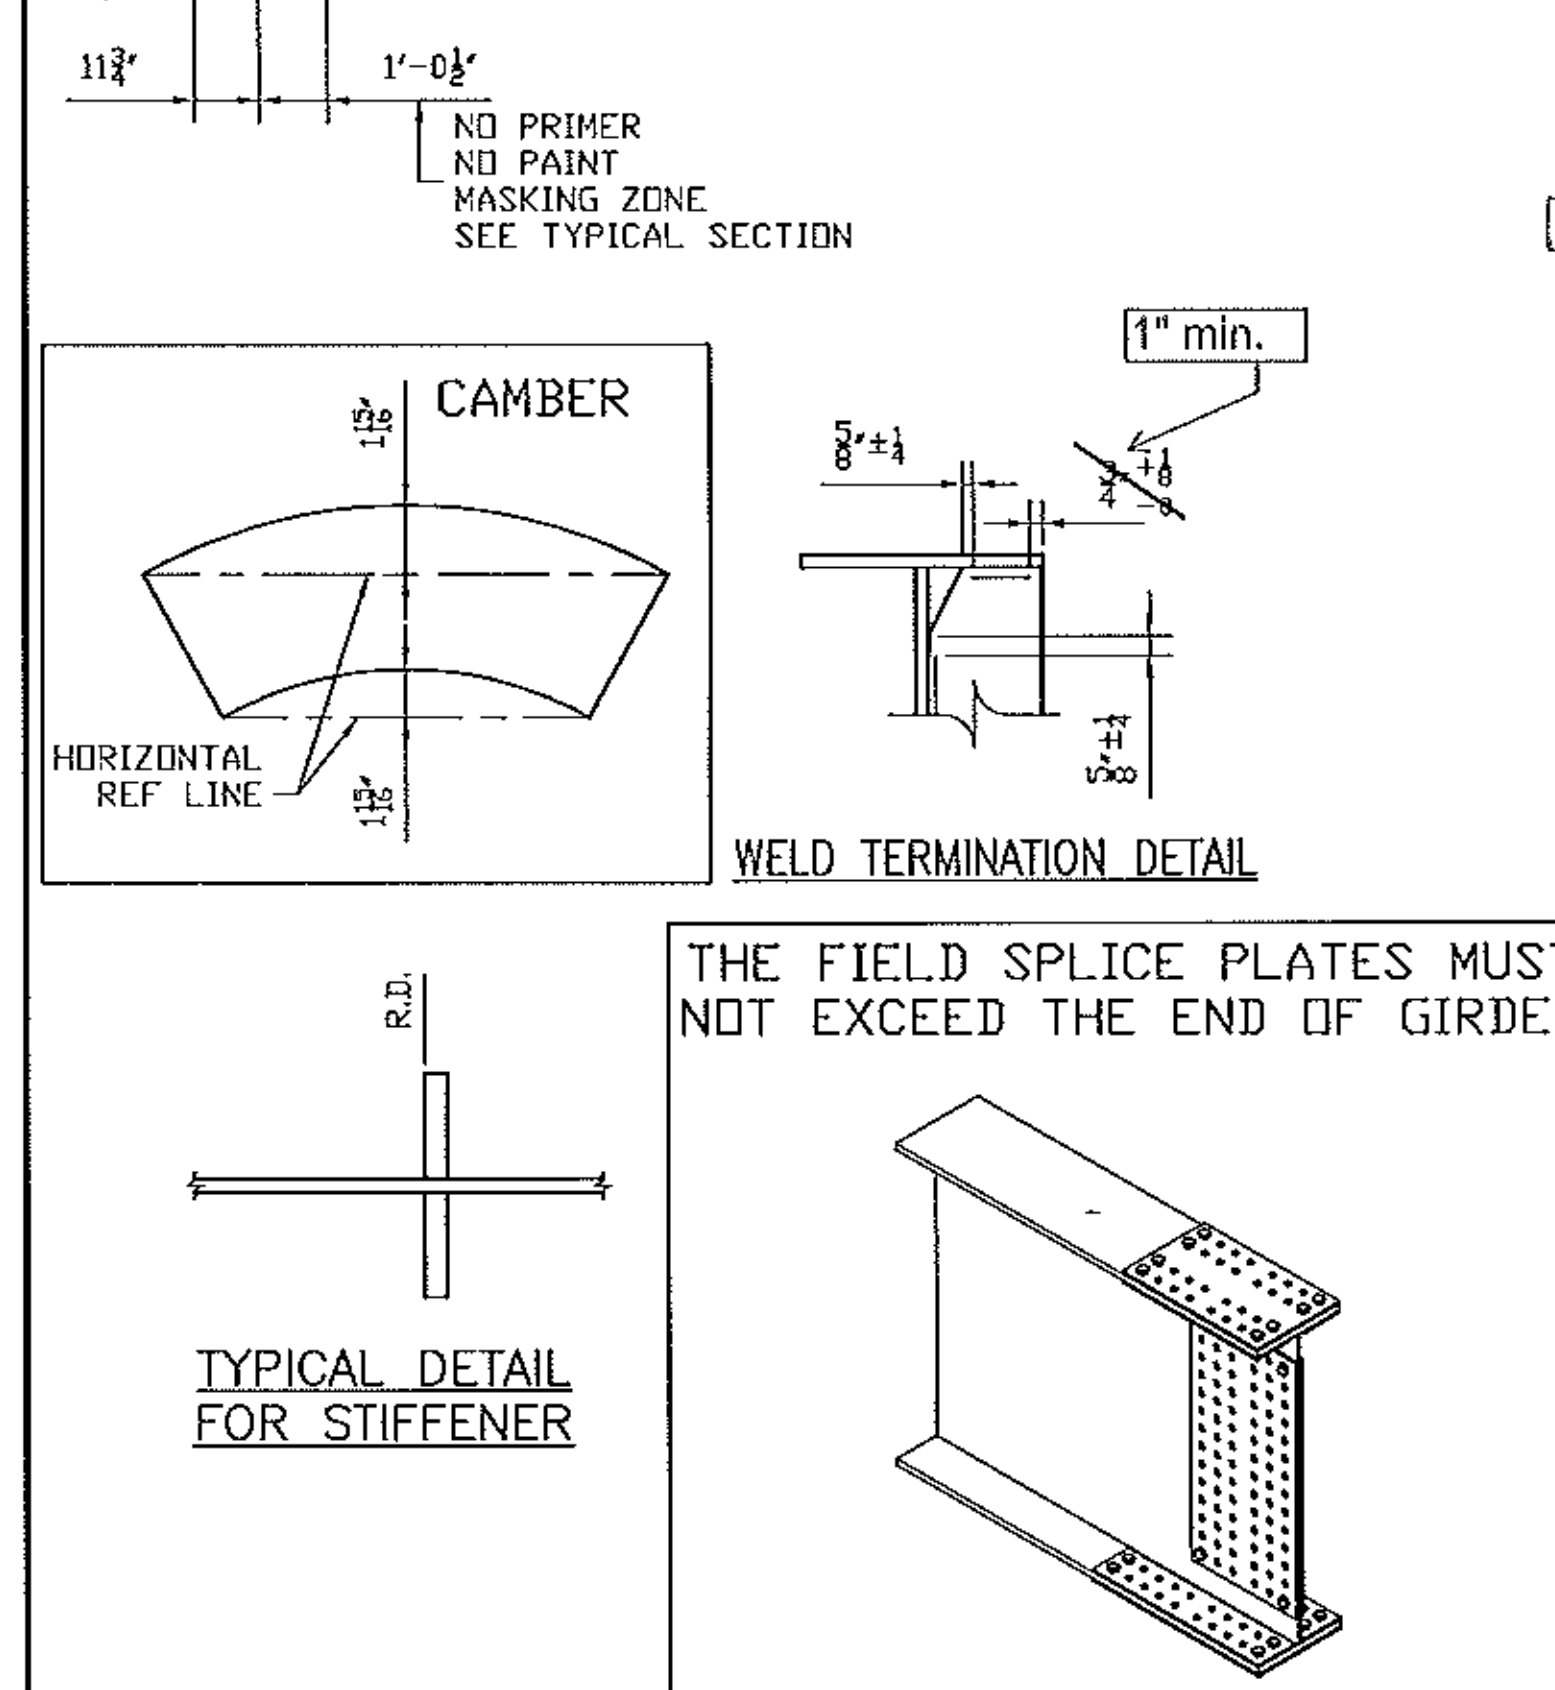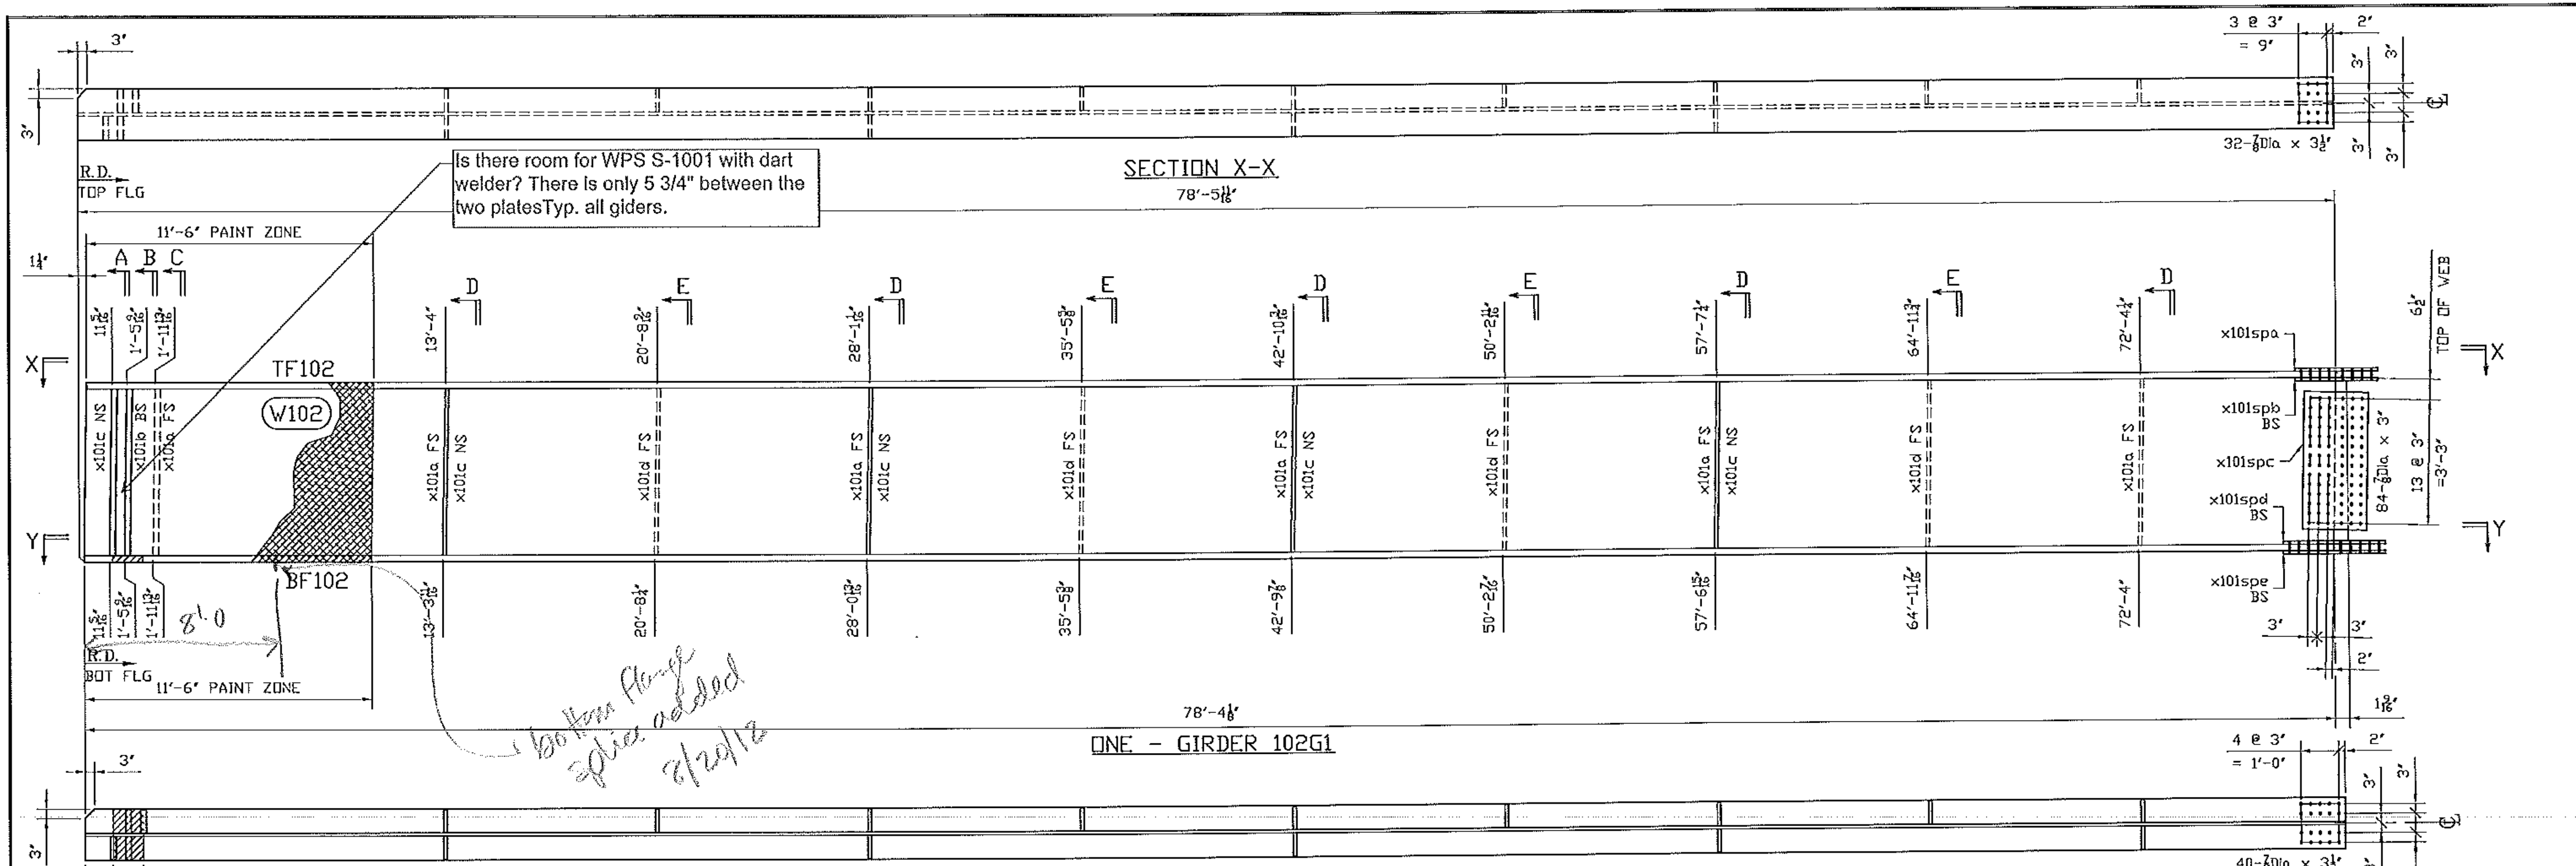

**BILL OF MATERIAL**

Mark	Qty.	Description	Stl	Length	Remark	ABM	Total Weight	Seq	Qty /Seq
102G1	ONE	GIRDER	Grd			16848	16973	1	
102G1	1	GIRDER		78-5 11/16					
TF102	1	PL1x16	A70950WT2	78-4 7/16		100-1	4267		
W102	1	PL1/2x52	A70950WT2	78-5 11/16		100-2	6943		
BF102	1	PL1x16	A70950WT2	78-4 1/8		100-1	4265		
x101a	6	PL1/2x7 1/2	A70950WT2	4-4		101-2	332		
x101b	2	PL1/8x7 1/2	A70950WT2	4-4 MB		101-1	194		
x101c	5	PL1/2x7 1/2	A70950WT2	4-4		101-2/3	276		
x101d	4	PL1/2x7 1/2	A70950WT2	4-4		101-3	221		
x101spa	1	PL1/2x16	A70950WT2	2-2 1/4		102-1	60		
x101spb	2	PL1/2x7	A70950WT2	2-2 1/4		102-2	52		
x101spc	2	PL1/2x43	A70950WT2	8 1/4		102-3	101		
x101spd	2	PL1/2x7	A70950WT2	2-8 1/4		102-4	64		
x101spe	1	PL1/2x16	A70950WT2	2-8 1/4		102-5	73		
FB		FIELD BOLTS							
78F3	84	.7/8 Dia A325 TYP3		3	1FL WASH		67		
78F312	72	.7/8 Dia A325 TYP3		3 1/2	1FL WASH		58		

FOR APPROVAL	07/06/12	BR	EG
REVISION	DATE	PAR	VER.

NOTE: BOLT 1 WASHER: 1 WASHER UNDER NUT U.N.  
BOLT 2 WASHER: 1 WASHER UNDER HEAD U.N.  
1 WASHER UNDER HEAD U.N.

**STRUCTURAL**  
Bridges  
386 River Road, Claremont,  
NH 03743  
Tel:(603) 542-5202 Fax:(603) 542-5312

PROJECT: VT RT 9, BRIDGE NO. 11  
TOWN OF WOODFORD, VT  
OVER WALDOOMSAC RIVER

TITLE: GIRDER 102G1

REFERENCE: PROJECT NO. ER BHF 010-1 (44)

BR	JULY 2012	UN04260
GG	JULY 2012	102-2




**Vermont Agency of Transportation**  
**RECEIVED**

CK'D BY M.E.M. OK'D BY C.W.M.  
July 09, 2012

RESUBMIT APPROVED AS NOTED  
BY C. CARLSON DATE 07-27-2012





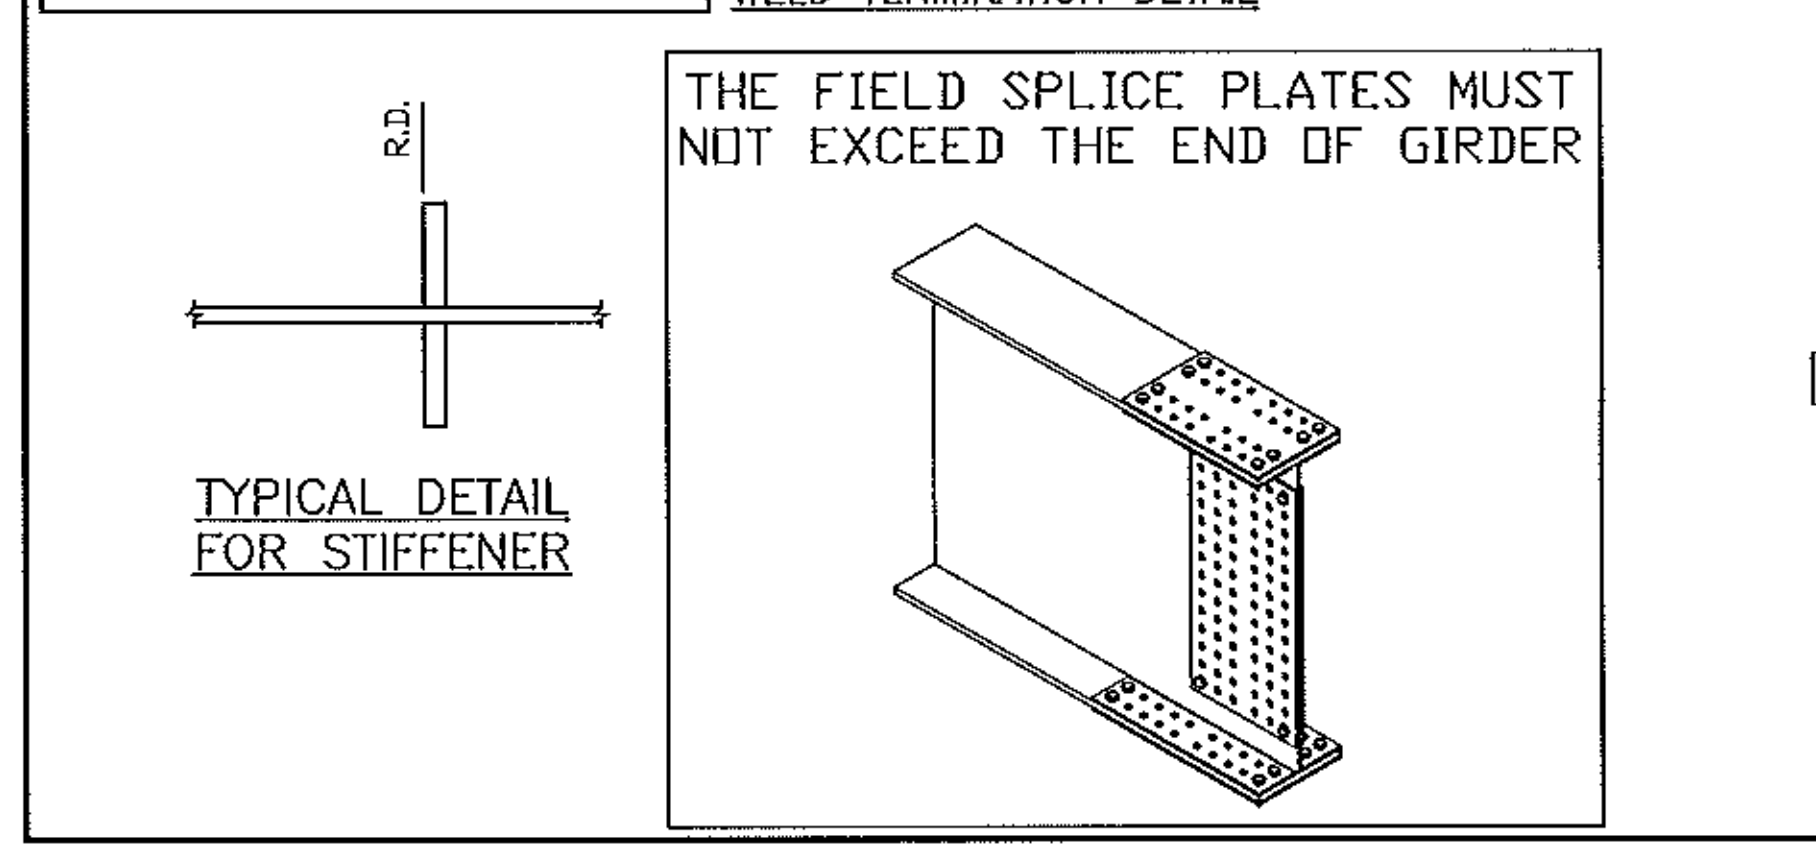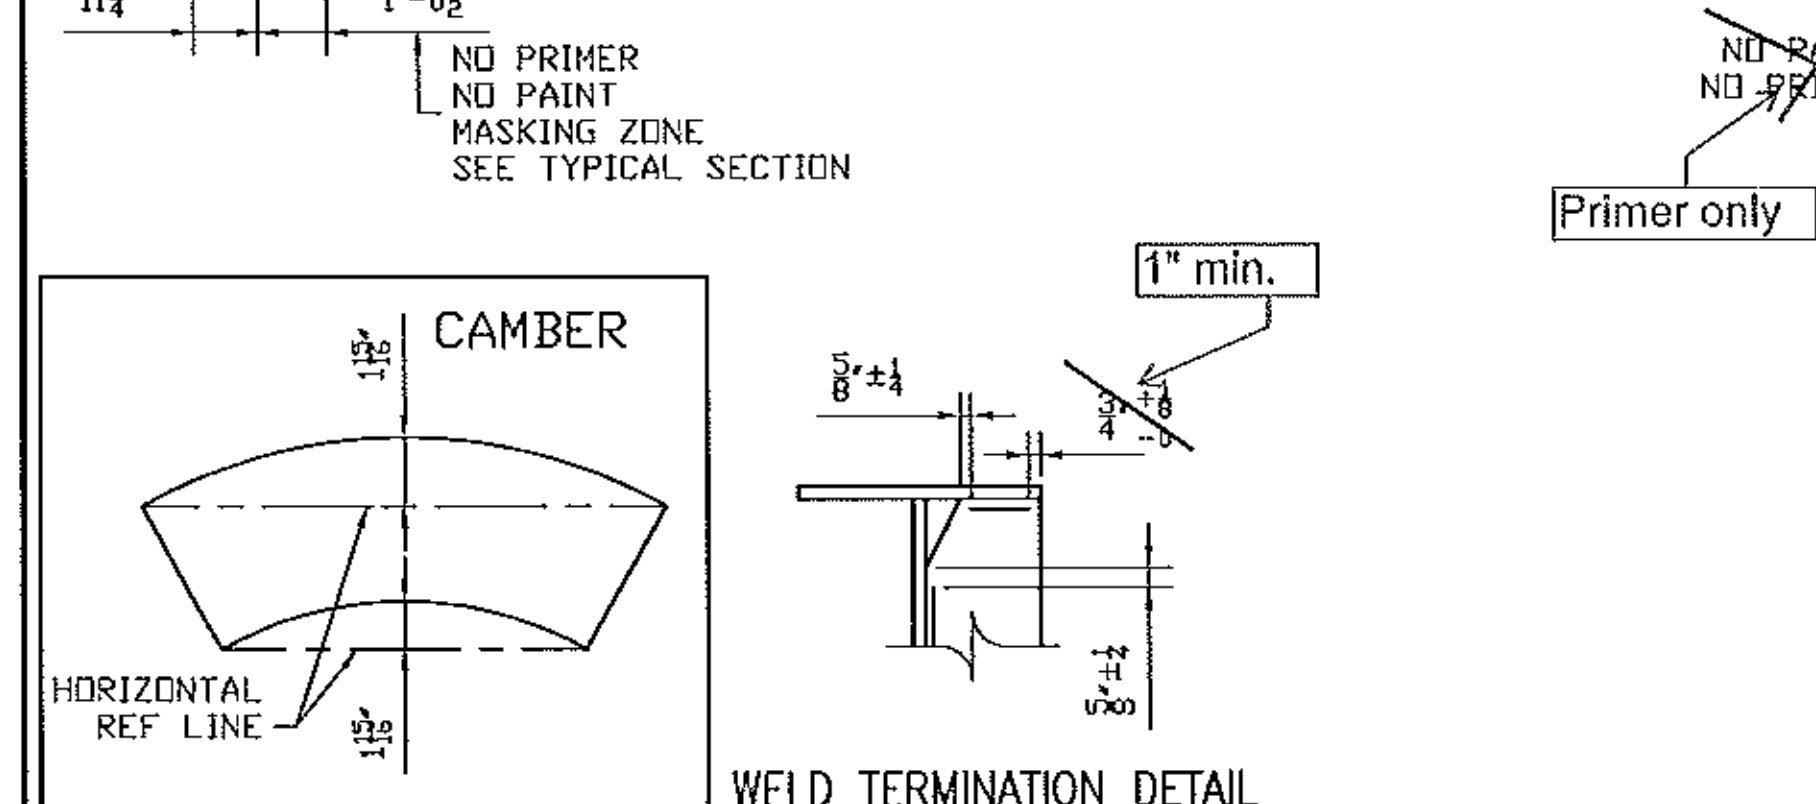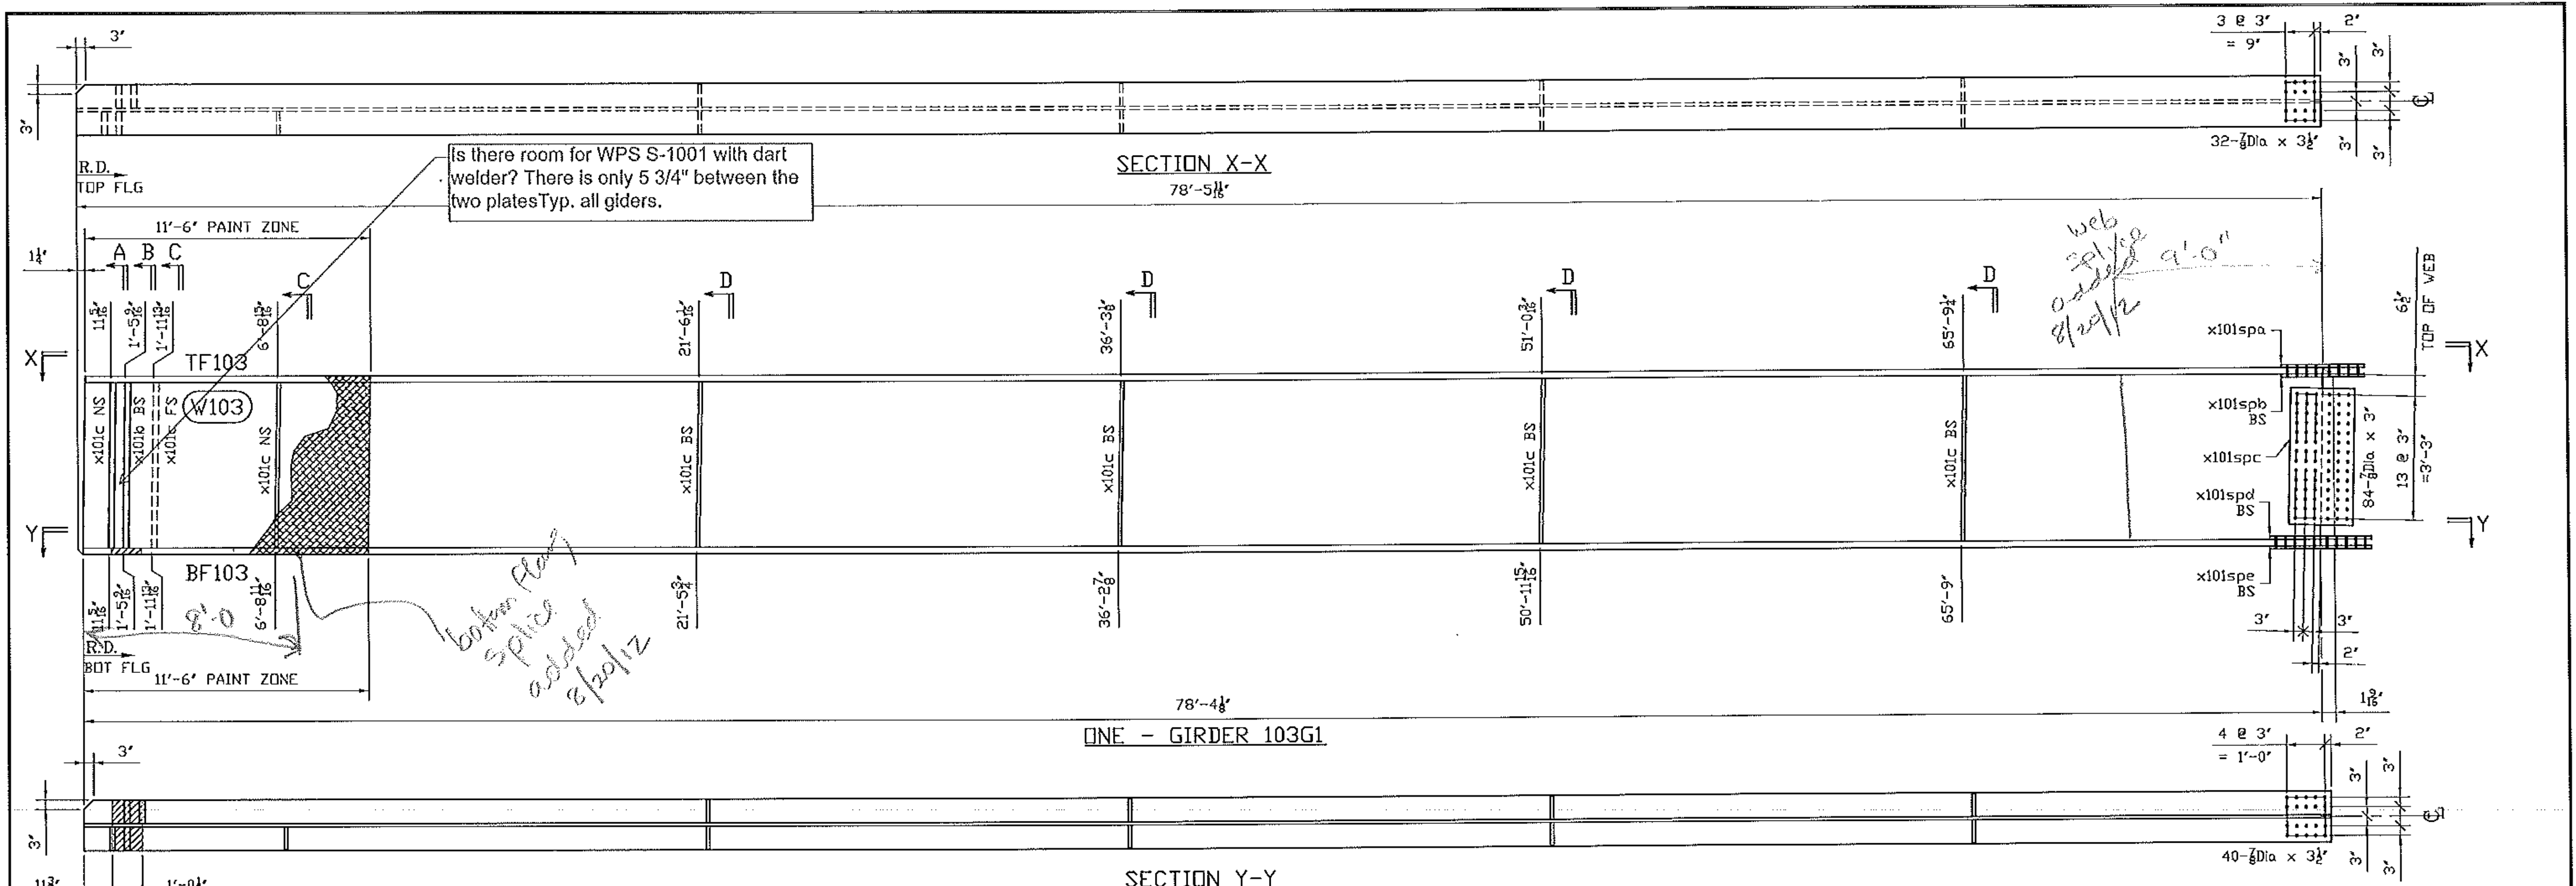

**BILL OF MATERIAL**

Mark	Qty.	Description	SH	Length	Remark	ABM	Total Weight	Seq	Qty
			Grd						/Seq
103G1	ONE	GIRDER				16629	16809	1	1
103G1	1	GIRDER		78-5 11/16					
TF103	1	PL1x16	A70950WT2	78-4 7/16		100-1	4267		
W103	1	PL1/2x52	A70950WT2	78-5 11/16		100-2	6943		
BF103	1	PL1x16	A70950WT2	78-4 3/16		100-1	4266		
x101b	2	PL7/8x7 1/2	A70950WT2	4-4 WB		101-1	194		
x101c	12	PL1/2x7 1/2	A70950WT2	4-4		101-2/3	664		
x101spa	2	PL1/2x16	A70950WT2	2-2 1/4		102-1	52		
x101spb	2	PL1/2x7	A70950WT2	2-2 1/4		102-2	52		
x101spc	2	PL1/2x43	A70950WT2	8 1/4		102-3	101		
x101spd	2	PL1/2x7	A70950WT2	2-8 1/4		102-4	64		
x101spe	1	PL1/2x16	A70950WT2	2-8 1/4		102-5	73		
FB		FIELD BOLTS							
78F3	84	.7/8 Dia A325 TYP3		3	1FL WASH		67		
78F312	72	.7/8 Dia A325 TYP3		3 1/2	1FL WASH		58		

**GENERAL NOTES:** SEE GN100  
**HOLES:** 15/16 (UN.)  
**CLEANING AND PAINTING:** SEE SHEET P100 AND P101

See standard specification 506.24(a)(9), no payment will be made for bolts, nuts, washers, they are considered to be incidental

**Vermont Agency of Transportation**  
**RECEIVED**  
 CK'D BY M.E.M. OK'D BY C.W.M.  
 July 09, 2012  
 RESUBMIT APPROVED AS NOTED  
 BY C. CARLSON DATE 07-27-2012

No.	REVISION	DATE	PAR	EG	VER.
		07/06/12	BR	EG	

**NOTE:** BOLT 1 WASHER: 1 WASHER UNDER NUT U.N.  
 BOLT 2 WASHER: 1 WASHER UNDER HEAD U.N.  
 1 WASHER UNDER HEAD U.N.

**STRUCTURAL Bridges**  
 385 River Road, Claremont, NH 03743  
 Tel: (603) 542-5202 Fax: (603) 542-5312

**PROJECT:** VT RT 9, BRIDGE NO. 11 TOWN OF WOODFORD, VT OVER WALDOOMSAC RIVER

**TITLE:** GIRDER 103G1


**REFERENCE:** PROJECT NO. ER BHF 010-1 (44)

DATE	BY	DATE	BY	DATE	BY
BR	JULY 2012	UN04260			
GG	JULY 2012	103-2 A			

BF 103  
 BF 102  
 web 9'









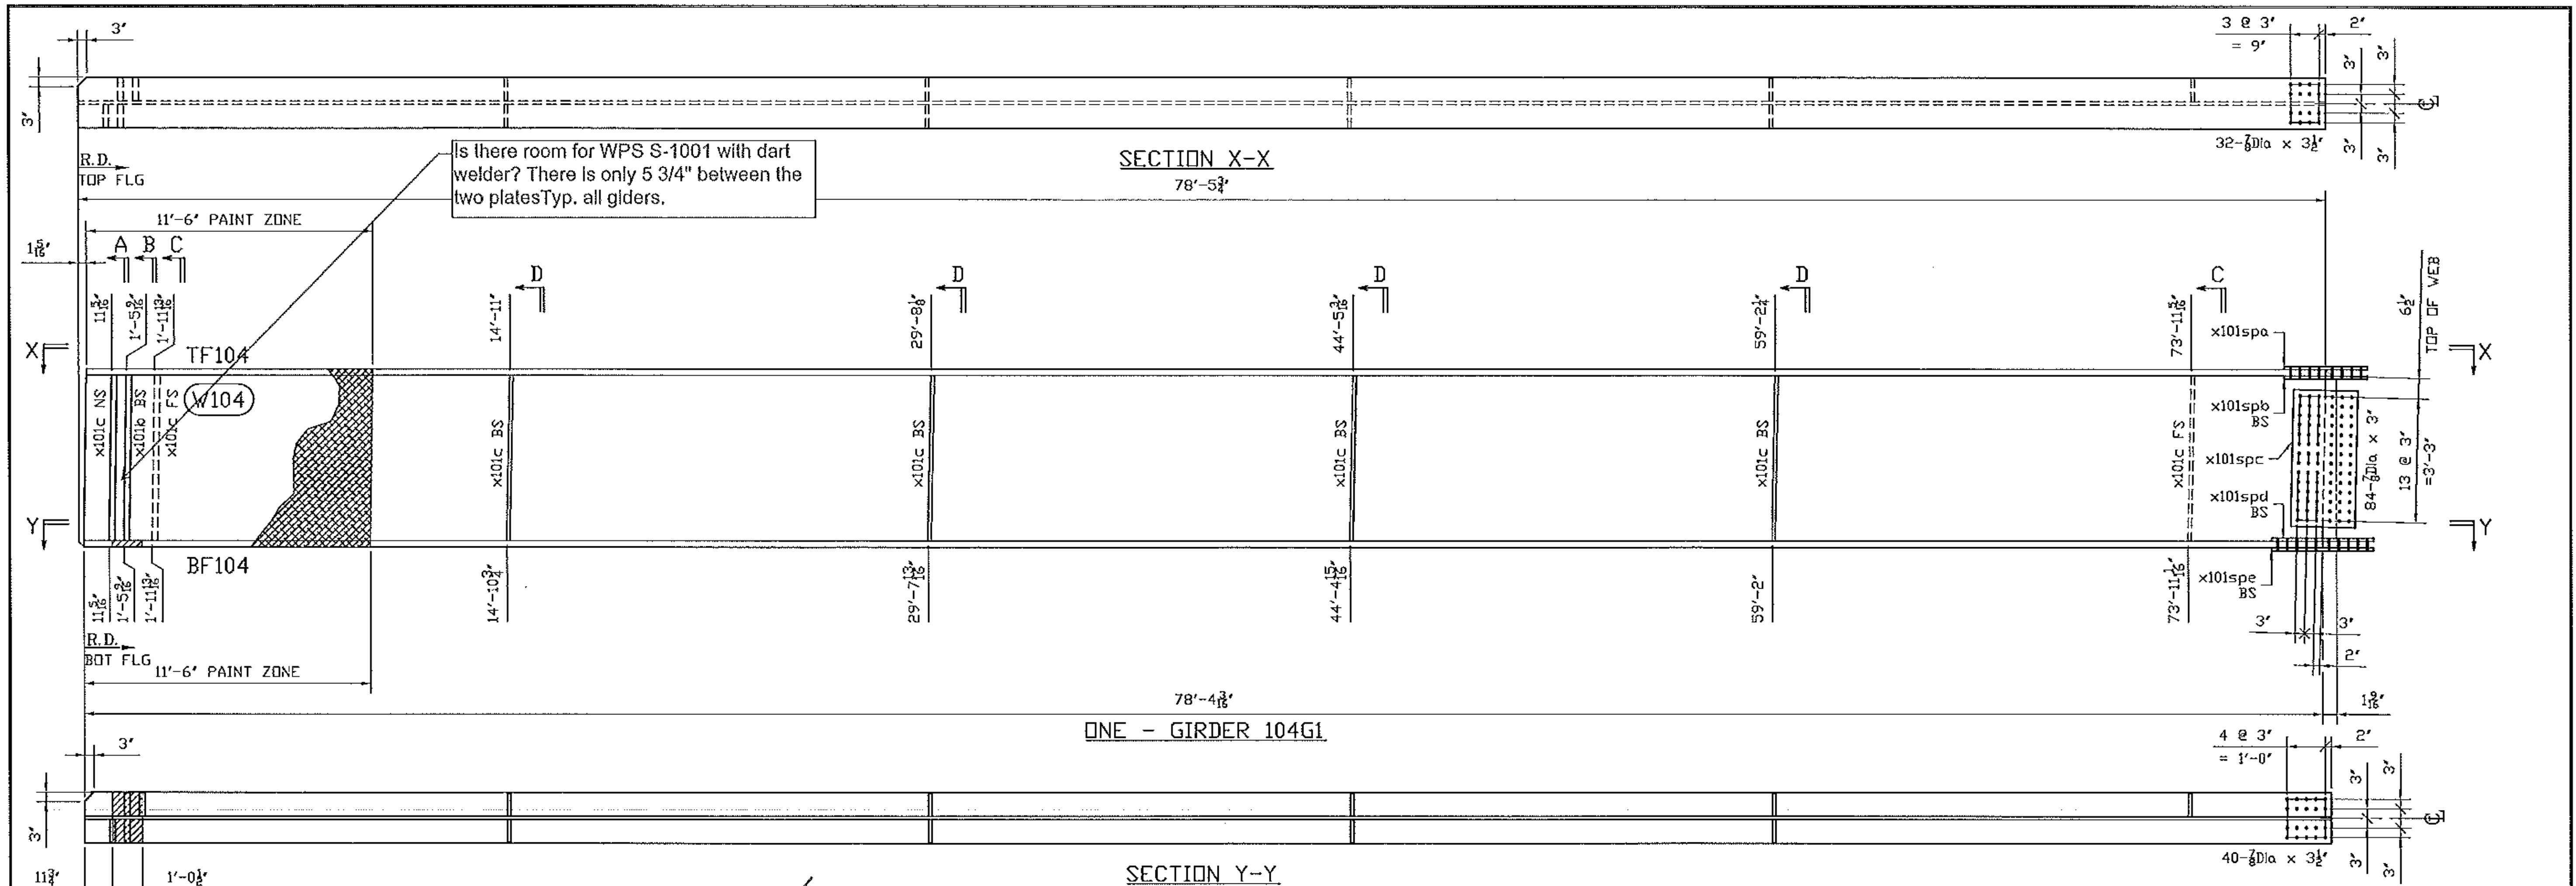

Is there room for WPS S-1001 with dart welder? There is only 5 3/4" between the two plates Typ. all girders.

NO PRIMER  
NO PAINT  
MASKING ZONE  
SEE TYPICAL SECTION

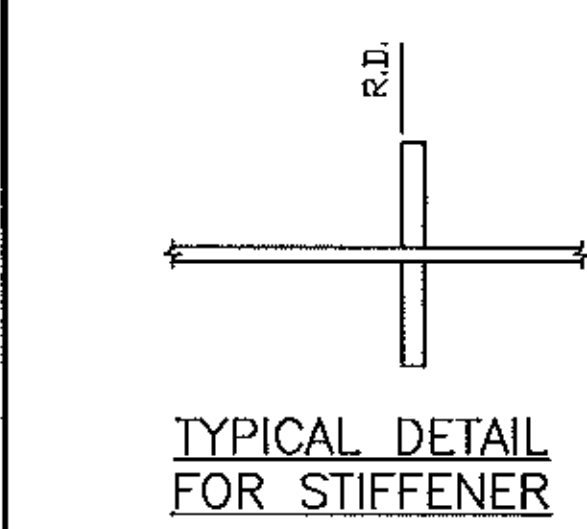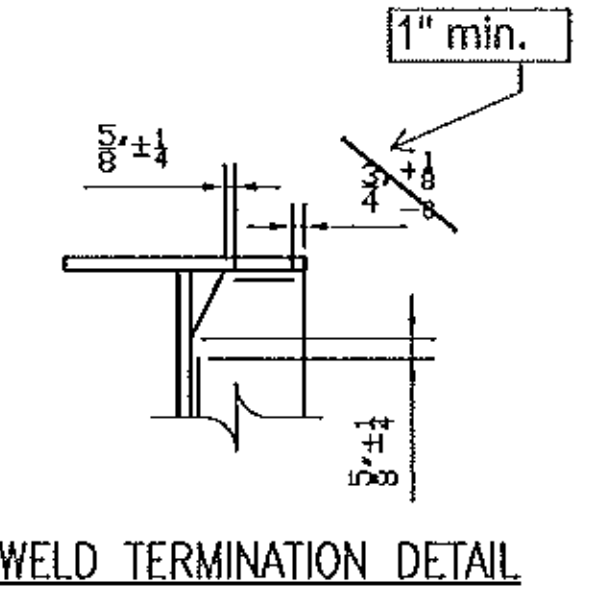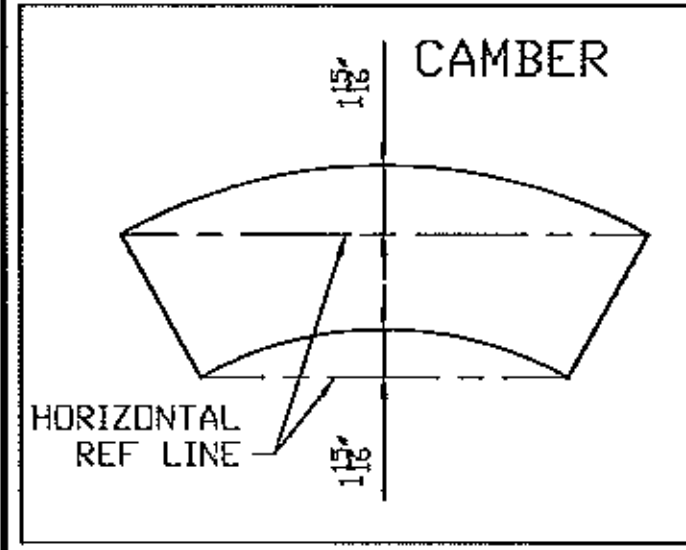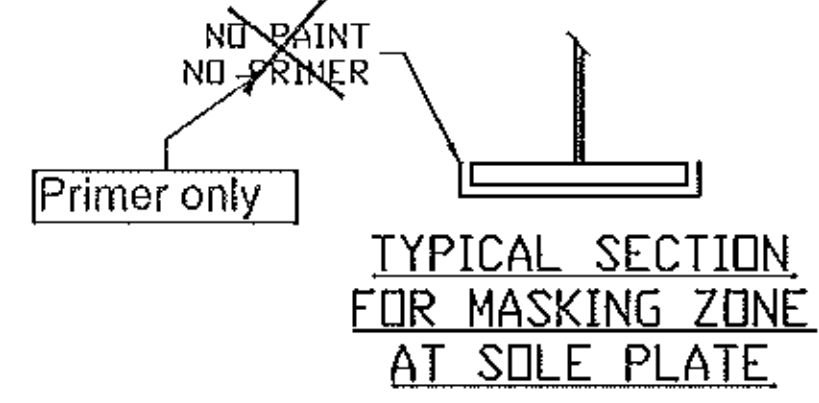

THE FIELD SPLICE PLATES MUST NOT EXCEED THE END OF GIRDER

GENERAL NOTES: SEE GNI00  
HOLES: 15/16 (U.N.)  
CLEANING AND PAINTING: SEE SHEET P100 AND P101

See standard specification 506.24(a)(9), no payment will be made for bolts, nuts, washers, they are considered to be incidental

BILL OF MATERIAL									
Mark	Qty.	Description	SU	Length	Remark	ABM	Total	Seq	Qty
			Grd				Weight		/Seq
104G1	ONE	GIRDER				16628	16753	1	1
104G1	1	GIRDER		78-5 3/4					
TF104	1	PL1x16	A70950#12	78-4 7/16		100-1	4267		
W104	1	PL1/2x52	A70950#12	78-5 3/4		100-2	6943		
BF104	1	PL1x16	A70950#12	78-4 3/16		100-1	4266		
x101b	2	PL7/8x7 1/2	A70950#12	4-4 WB		101-1	194		
x101g	11	PL1/2x7 1/2	A70950#12	4-4		101-2/3	608		
x101spa	1	PL1/2x16	A70950#12	2-2 1/4		102-1	60		
x101spb	2	PL1/2x7	A70950#12	2-2 1/4		102-2	52		
x101spc	2	PL1/2x43	A70950#12	8 1/4		102-3	101		
x101spd	2	PL1/2x7	A70950#12	2-8 1/4		102-4	64		
x101spe	1	PL1/2x16	A70950#12	2-8 1/4		102-5	73		
FB		FIELD BOLTS							
78F3	84	.7/8 Dia A325 TYP3		3 1/2	1FL WASH		67		
78F312	72	.7/8 Dia A325 TYP3		3 1/2	1FL WASH		58		

Vermont Agency of Transportation  
**RECEIVED**  
CK'D BY M.E.M. OK'D BY C.W.M.  
July 09, 2012  
RESUBMIT APPROVED AS NOTED  
BY C. CARLSON DATE 07-27-2012

No	REVISION	DATE	PAR	VER.
	FOR APPROVAL	07/06/12	BR	EG

NOTE: BOLT 1 WASHER: 1 WASHER UNDER NUT U.N.  
BOLT 2 WASHER: 1 WASHER UNDER HEAD U.N.  
1 WASHER UNDER HEAD U.N.




PROJECT: VT RT 9, BRIDGE NO. 11  
TOWN OF WOODFORD, VT  
OVER WALDOOMSAC RIVER


TITLE: GIRDER 104G1

REFERENCE: PROJECT NO. ER BHF 010-1 (44)


DATE	BY	DATE	BY	DATE	BY
BR	JULY 2012	UN04260			
GG	JULY 2012	104-2			

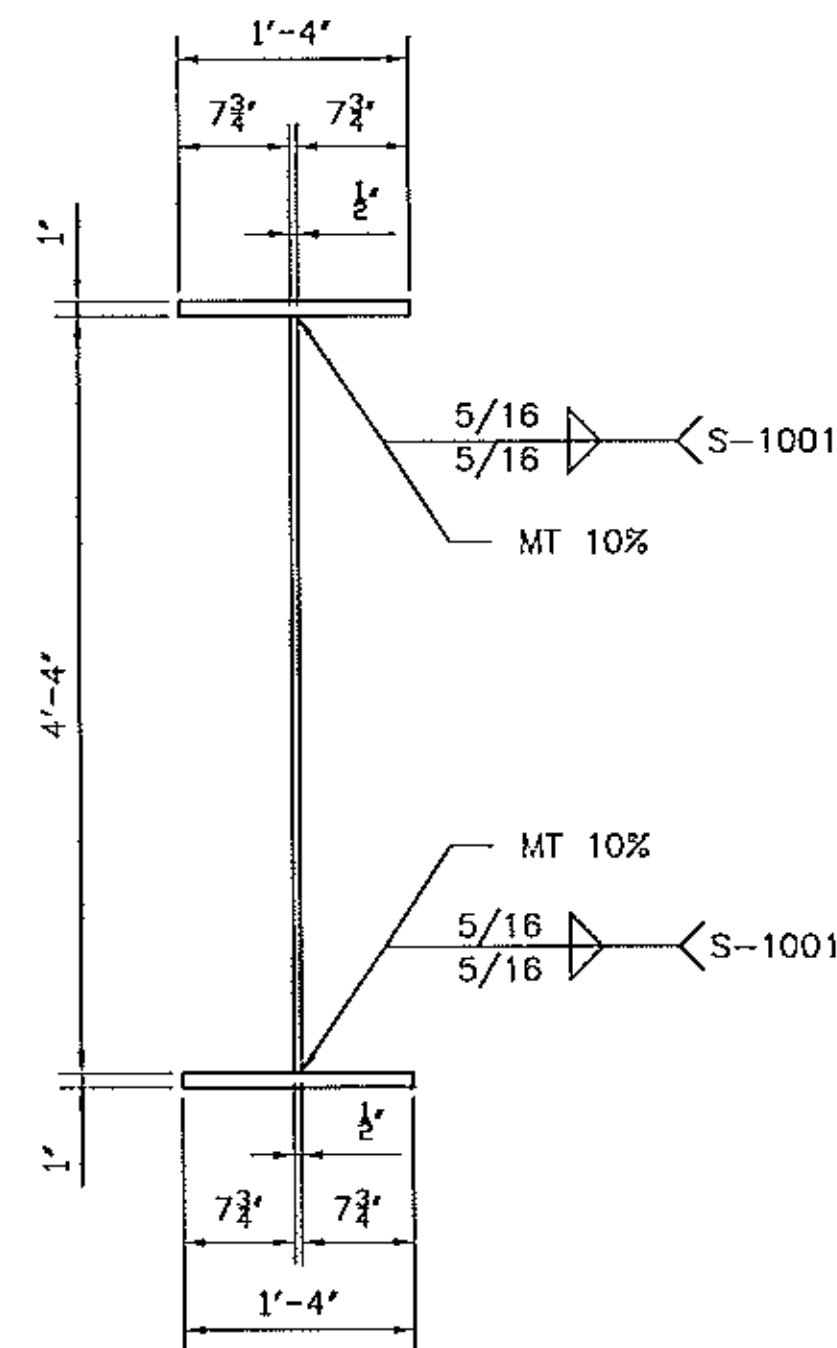


TYPICAL SECTION

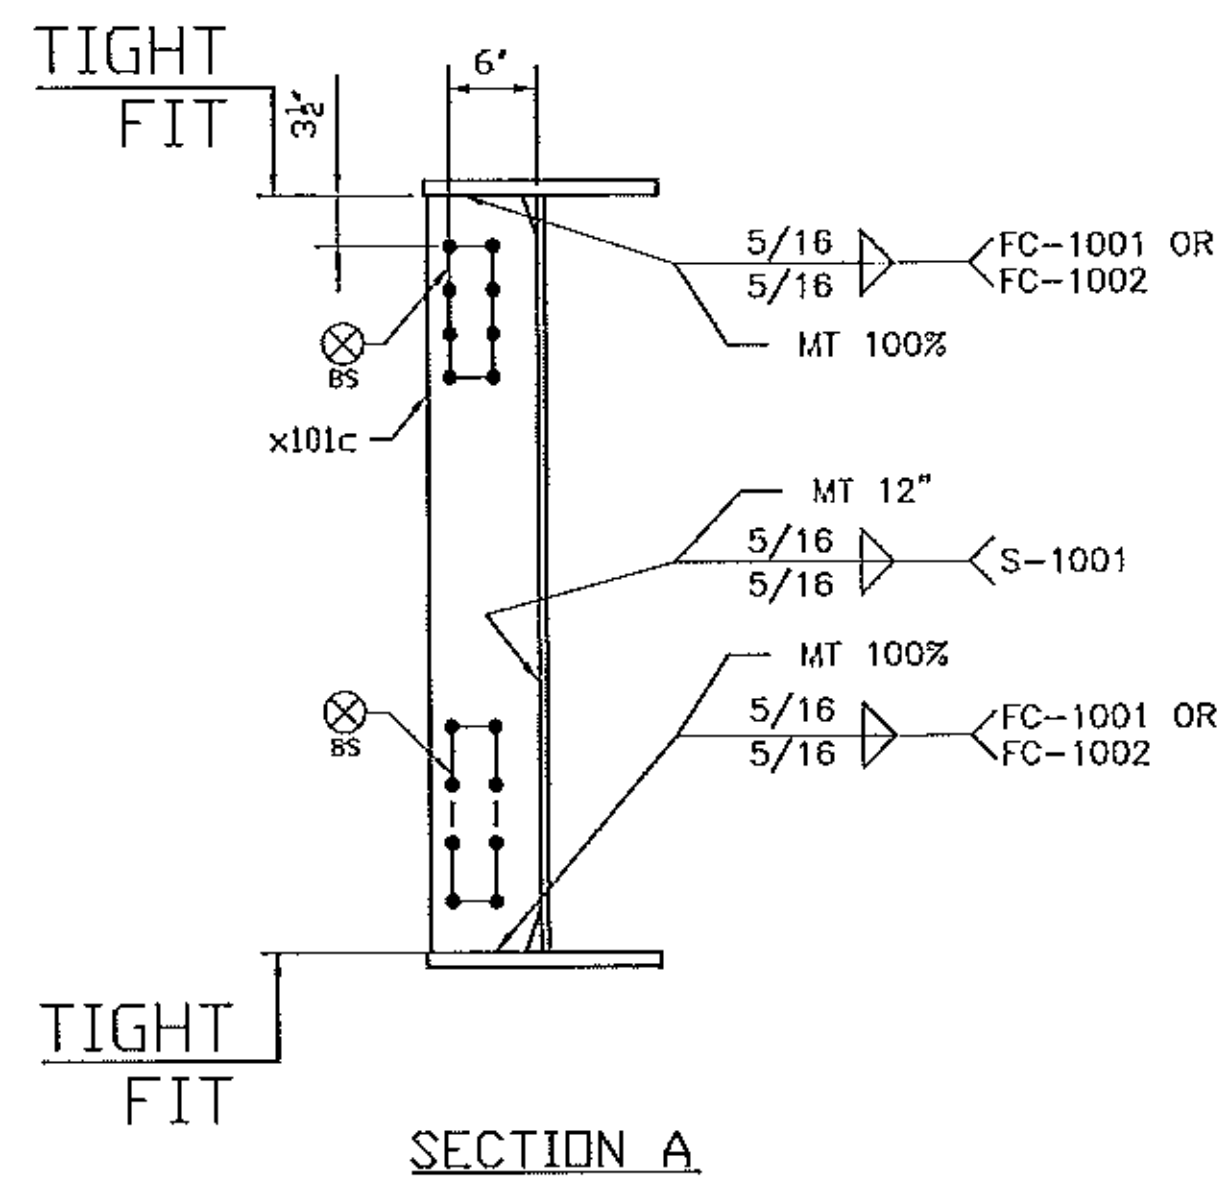


SECTION A

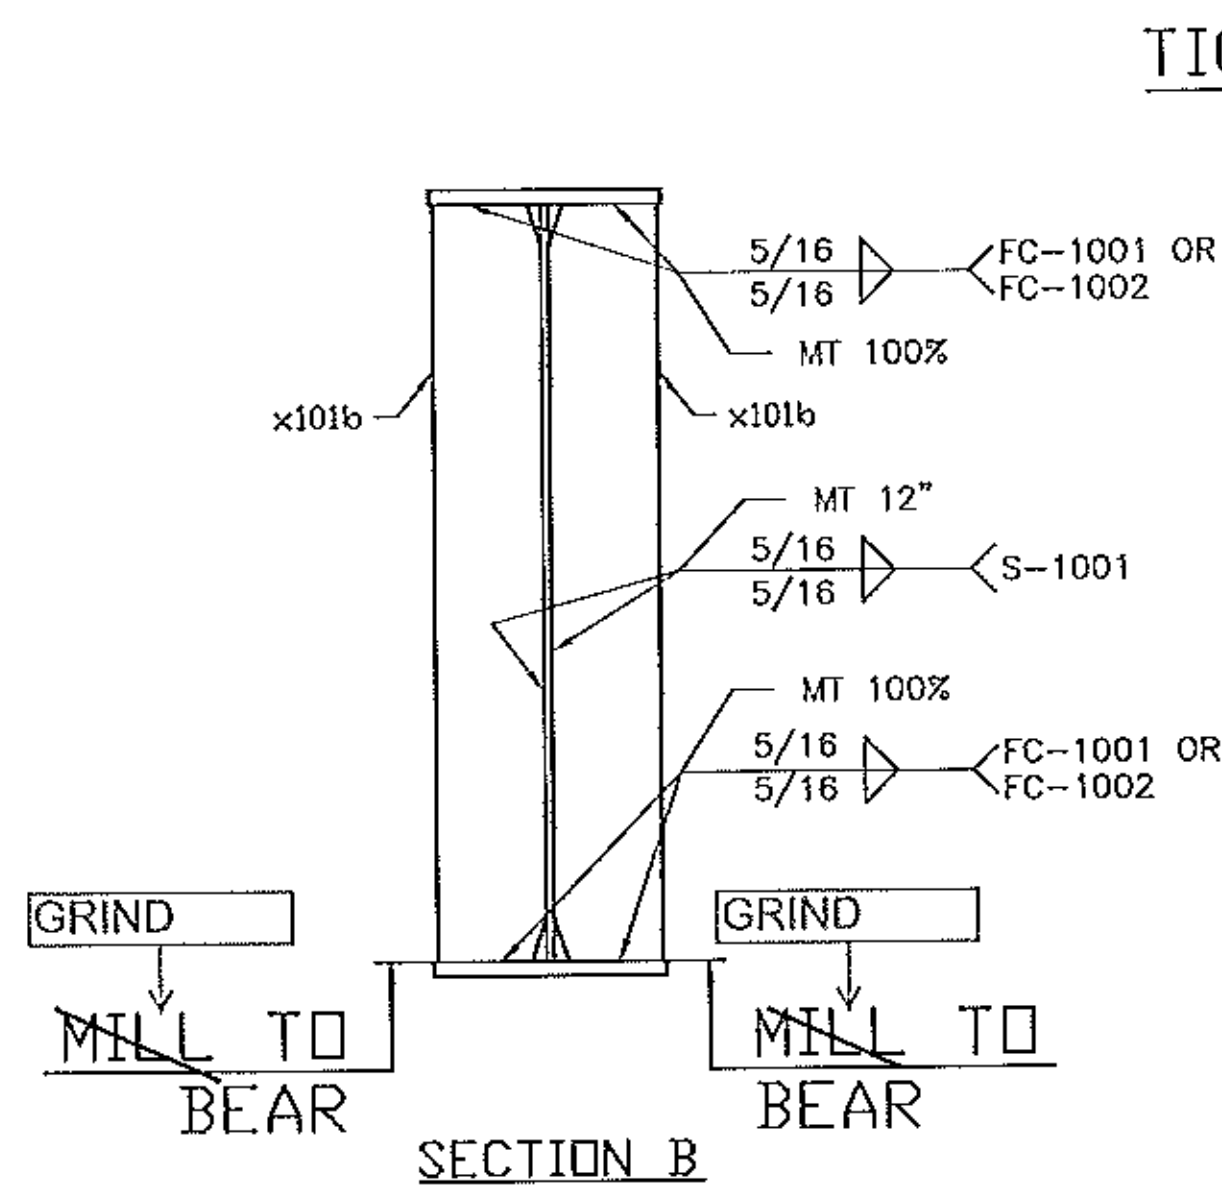

SECTION B

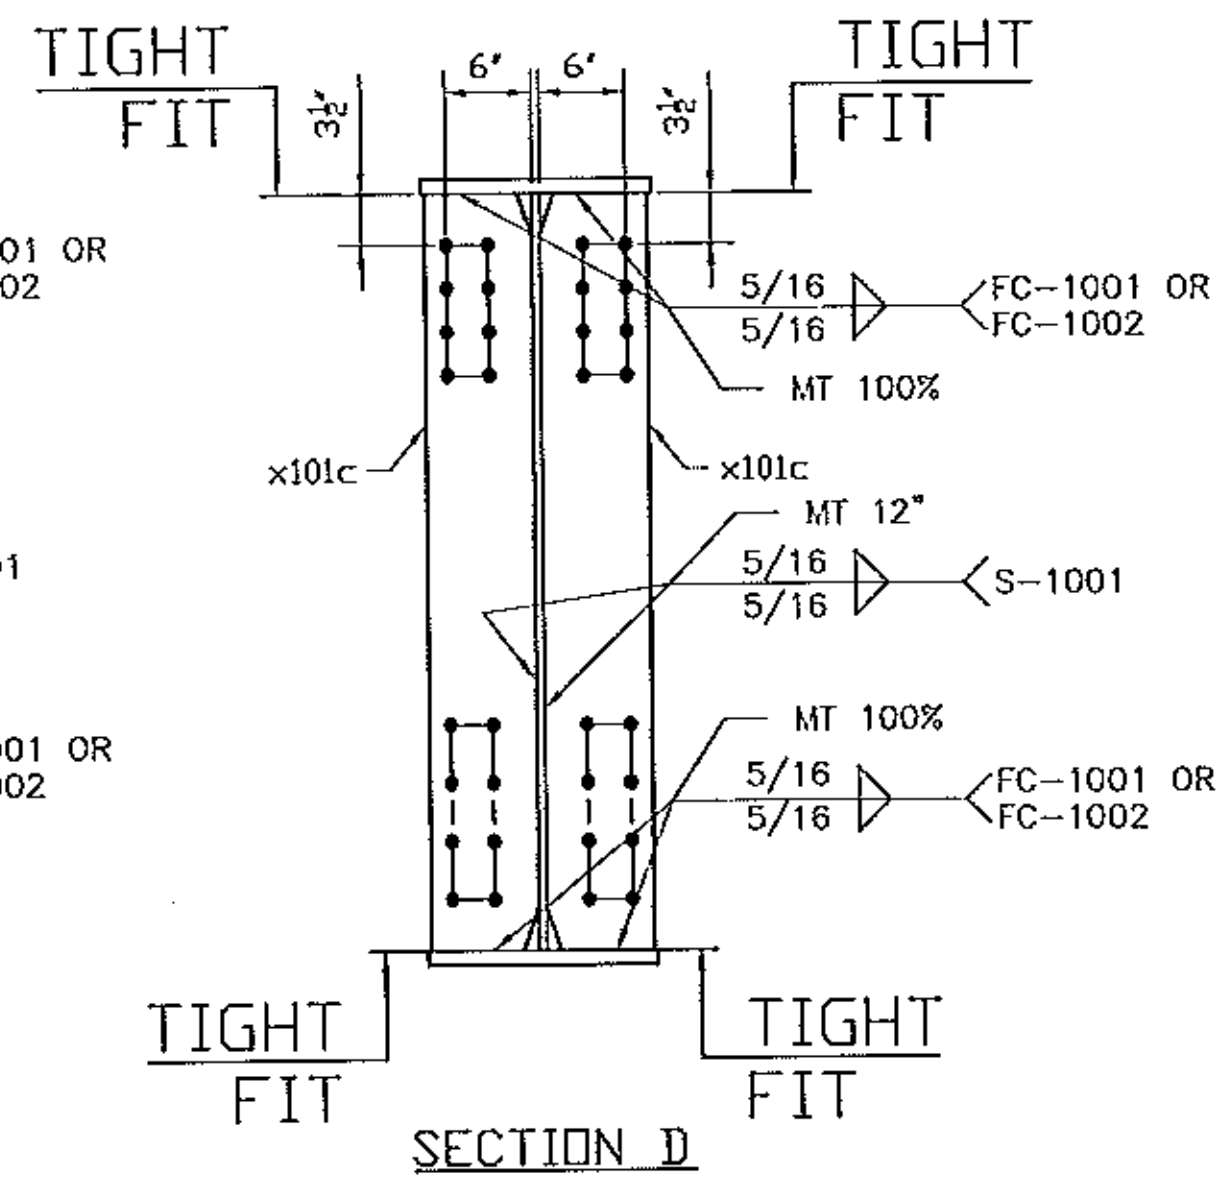

SECTION D

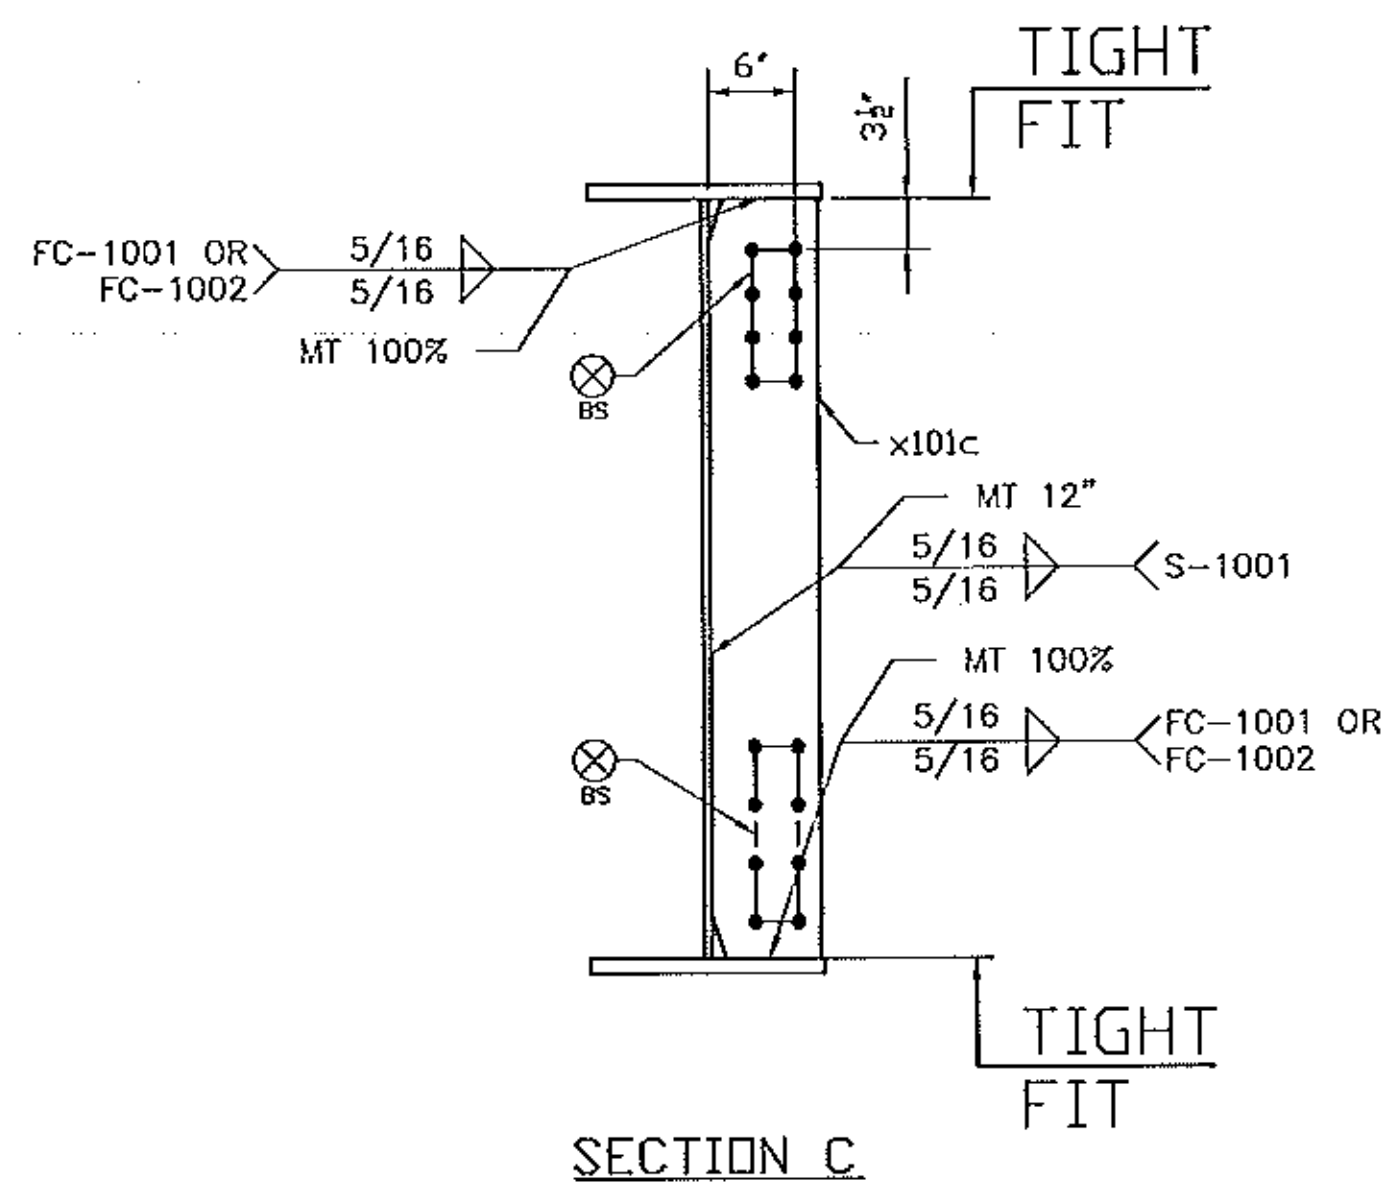

SECTION C

GENERAL NOTES: SEE GN100  
 HOLES: 15/16 (U.N.)  
 CLEANING AND PAINTING: SEE SHEET P100 AND P101

No.	REVISION	DATE	PAR	VER.
1	FOR APPROVAL	07/06/12	BR	EG


PRIMER ONLY, NO PAINT  
 BOTH SIDES 75 mm DIA AROUND HOLE  
 WHERE NOTED WITH THIS SYMBOL

(BS)

Vermont Agency of Transportation  
**RECEIVED**  
 CK'D BY M.E.M. OK'D BY C.W.M.  
 July 09, 2012  
 RESUBMIT APPROVED AS NOTED  
 BY C. CARLSON DATE 07-27-2012





NOTE: BOLT 1 WASHER: 1 WASHER UNDER NUT U.N. BOLT 2 WASHER: 1 WASHER UNDER HEAD U.N. 1 WASHER UNDER HEAD U.N.			
 386 River Road, Claremont, NH 03743 Tel: (603) 542-5202 Fax: (603) 542-5312			
PROJECT: VT RT 9, BRIDGE NO. 11 TOWN OF WOODFORD, VT OVER WALDOMSAC RIVER			
TITLE: GIRDER 104G1			
REFERENCE: PROJECT NO. ER BHF 010-1 (44)			
WORK BY: BR	DATE: JULY 2012	CONTRACT NO: UN04260	
CHECKED BY: GG	DATE: JULY 2012	REVISED BY: 104-3	A



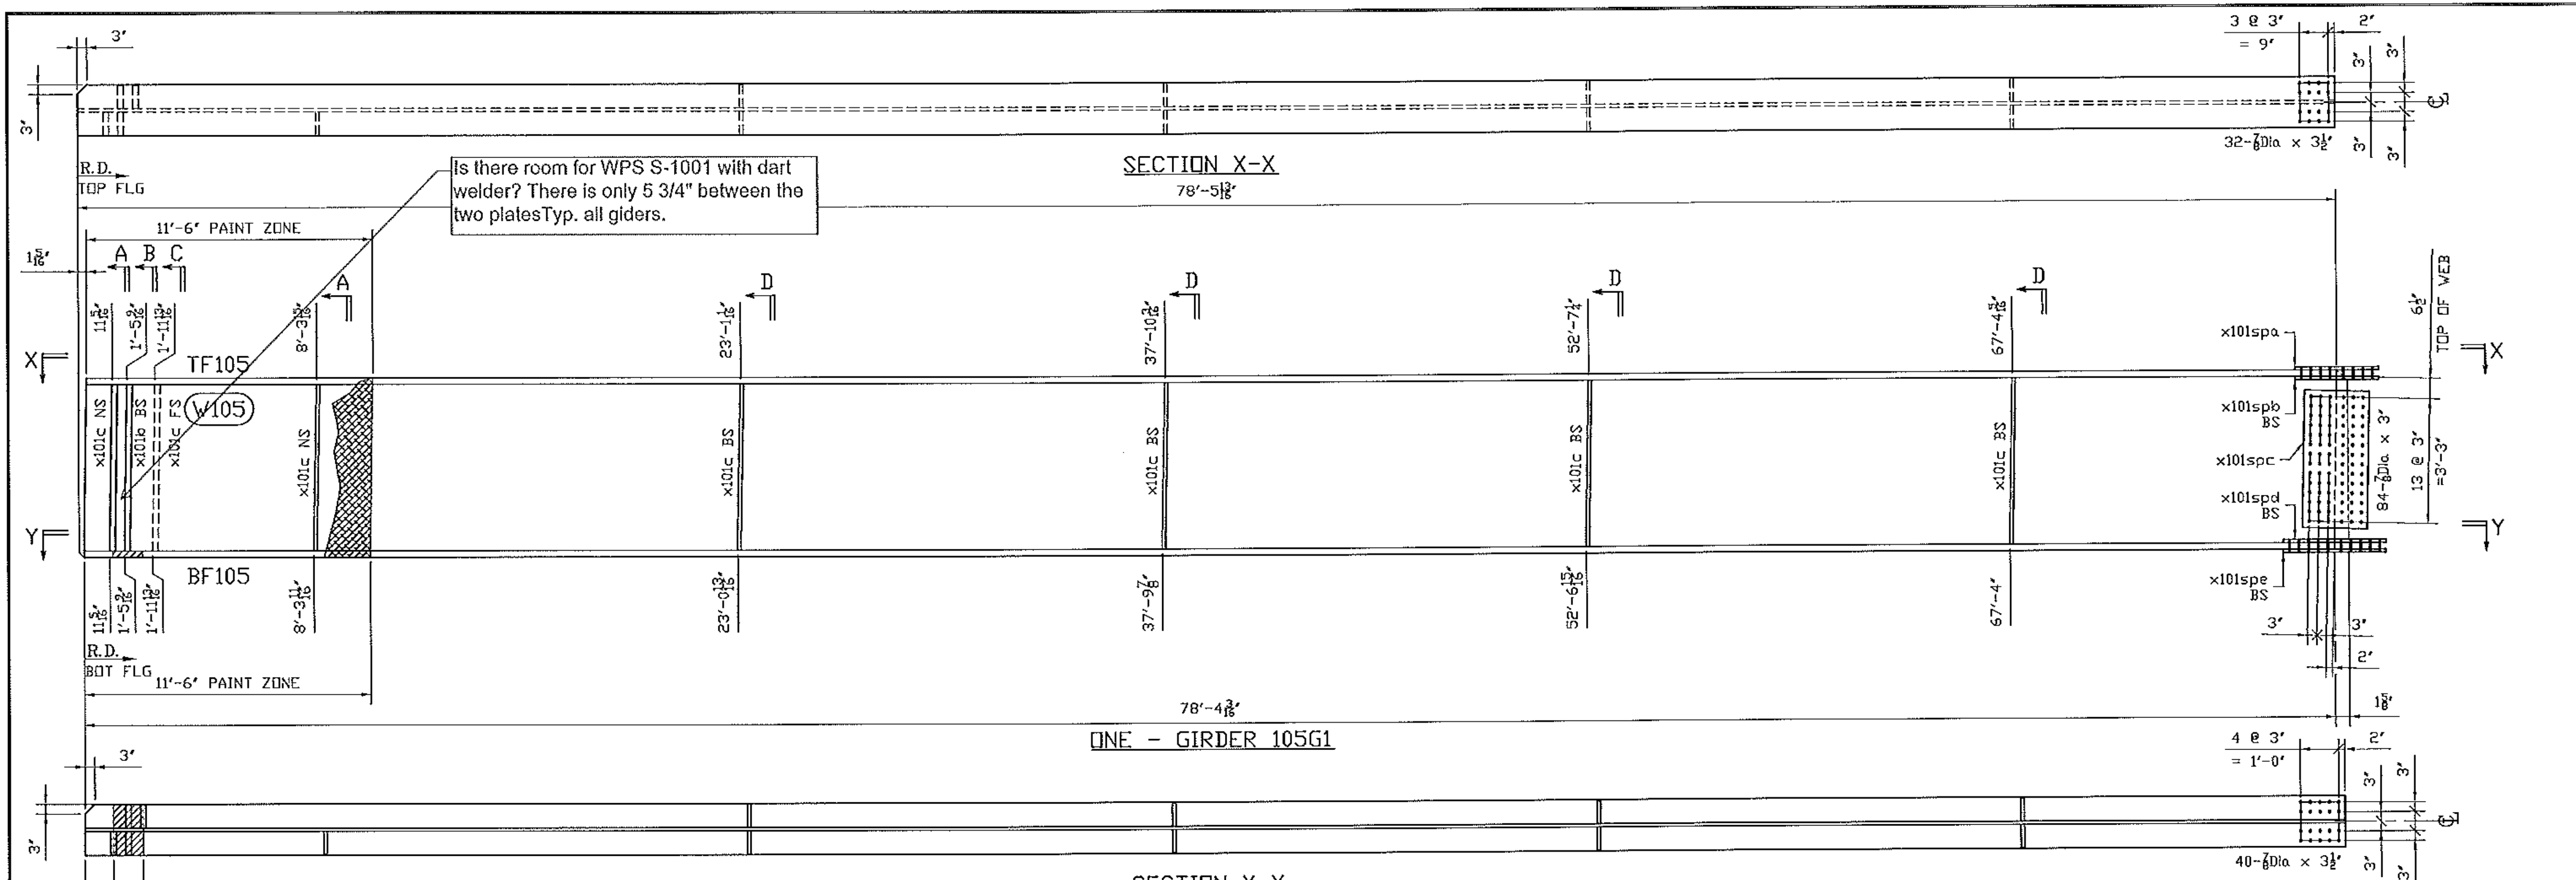

Is there room for WPS S-1001 with dart welder? There is only 5 3/4\"/>

NO PRIMER  
NO PAINT  
MASKING ZONE  
SEE TYPICAL SECTION

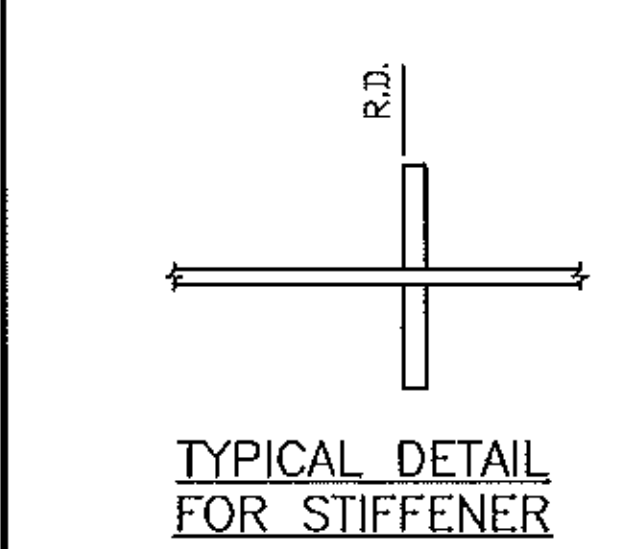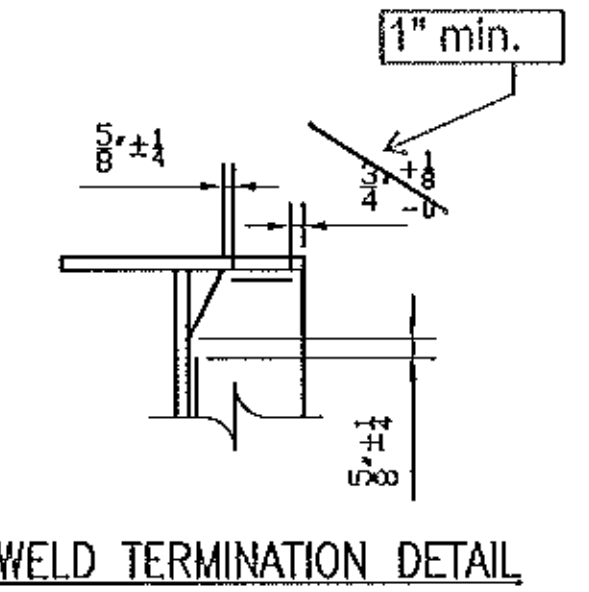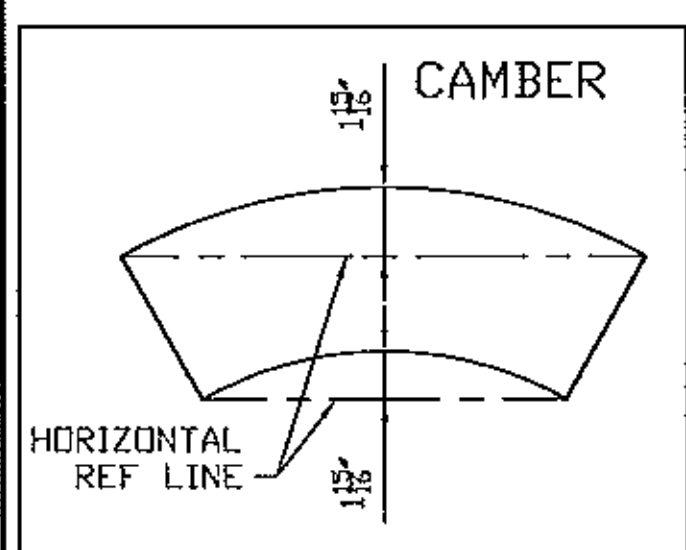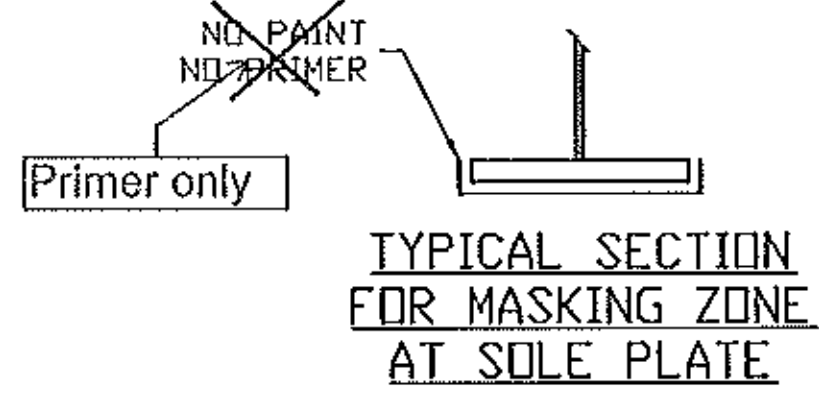

THE FIELD SPLICE PLATES MUST NOT EXCEED THE END OF GIRDER

GENERAL NOTES: SEE GN100  
HOLES: 15/16 (U.N.)  
CLEANING AND PAINTING: SEE SHEET P100 AND P101

See standard specification 506.24(a)(9), no payment will be made for bolts, nuts, washers, they are considered to be incidental

BILL OF MATERIAL									
Mark	Qty.	Description	SI	Length	Remark	ABM	Total Weight	Seq	Qty /Seq
105G1	ONE	GIRDER				16629	16699	1	1
105G1	1	.GIRDER	Grd	78-5 13/16					
TF105	1	PL1x16	A70950WT2	78-4 1/2		100-1	4267		
W105	1	PL1/2x52	A70950WT2	78-5 13/16		100-2	6944		
BF105	1	PL1x16	A70950WT2	78-4 3/16		100-1	4266		
x101b	2	PL7/8x7 1/2	A70950WT2	4-4	WB	101-1	154		
x101c	10	PL1/2x7 1/2	A70950WT2	4-4		101-2/3	553		
x101spa	1	PL1/2x16	A70950WT2	2-2 1/4		102-1	69		
x101spb	2	PL1/2x7	A70950WT2	2-2 1/4		102-2	52		
x101spc	2	PL1/2x43	A70950WT2	8 1/4		102-3	101		
x101spd	2	PL1/2x7	A70950WT2	2-8 1/4		102-4	64		
x101spe	1	PL1/2x16	A70950WT2	2-8 1/4		102-5	73		
FB		FIELD BOLTS							
78F3	84	.7/8 Dia A325 TYP3			3 1FL WASH				
78F312	72	.7/8 Dia A325 TYP3			3 1/2 1FL WASH				

608  
Vermont Agency of Transportation  
**RECEIVED**  
CK'D BY M.E.M. OK'D BY C.W.M.  
July 09, 2012  
RESUBMIT APPROVED AS NOTED  
BY C. CARLSON DATE 07-27-2012

No	REVISION	DATE	PAR	VER.
		07/06/12	BR	EG

NOTE: BOLT 1 WASHER: 1 WASHER UNDER NUT U.N.  
BOLT 2 WASHER: 1 WASHER UNDER HEAD U.N.  
1 WASHER UNDER HEAD U.N.



PROJECT: VT RT 9, BRIDGE NO. 11  
TOWN OF WOODFORD, VT  
OVER WALDOOMSAC RIVER


TITLE: GIRDER 105G1

REFERENCES: PROJECT NO. ER BHF 010-1 (44)

DATE	BY	DATE	BY	CONTRACT NO.	REVISED TO
JULY 2012	BR	JULY 2012	GG	UN04260	105-2 A










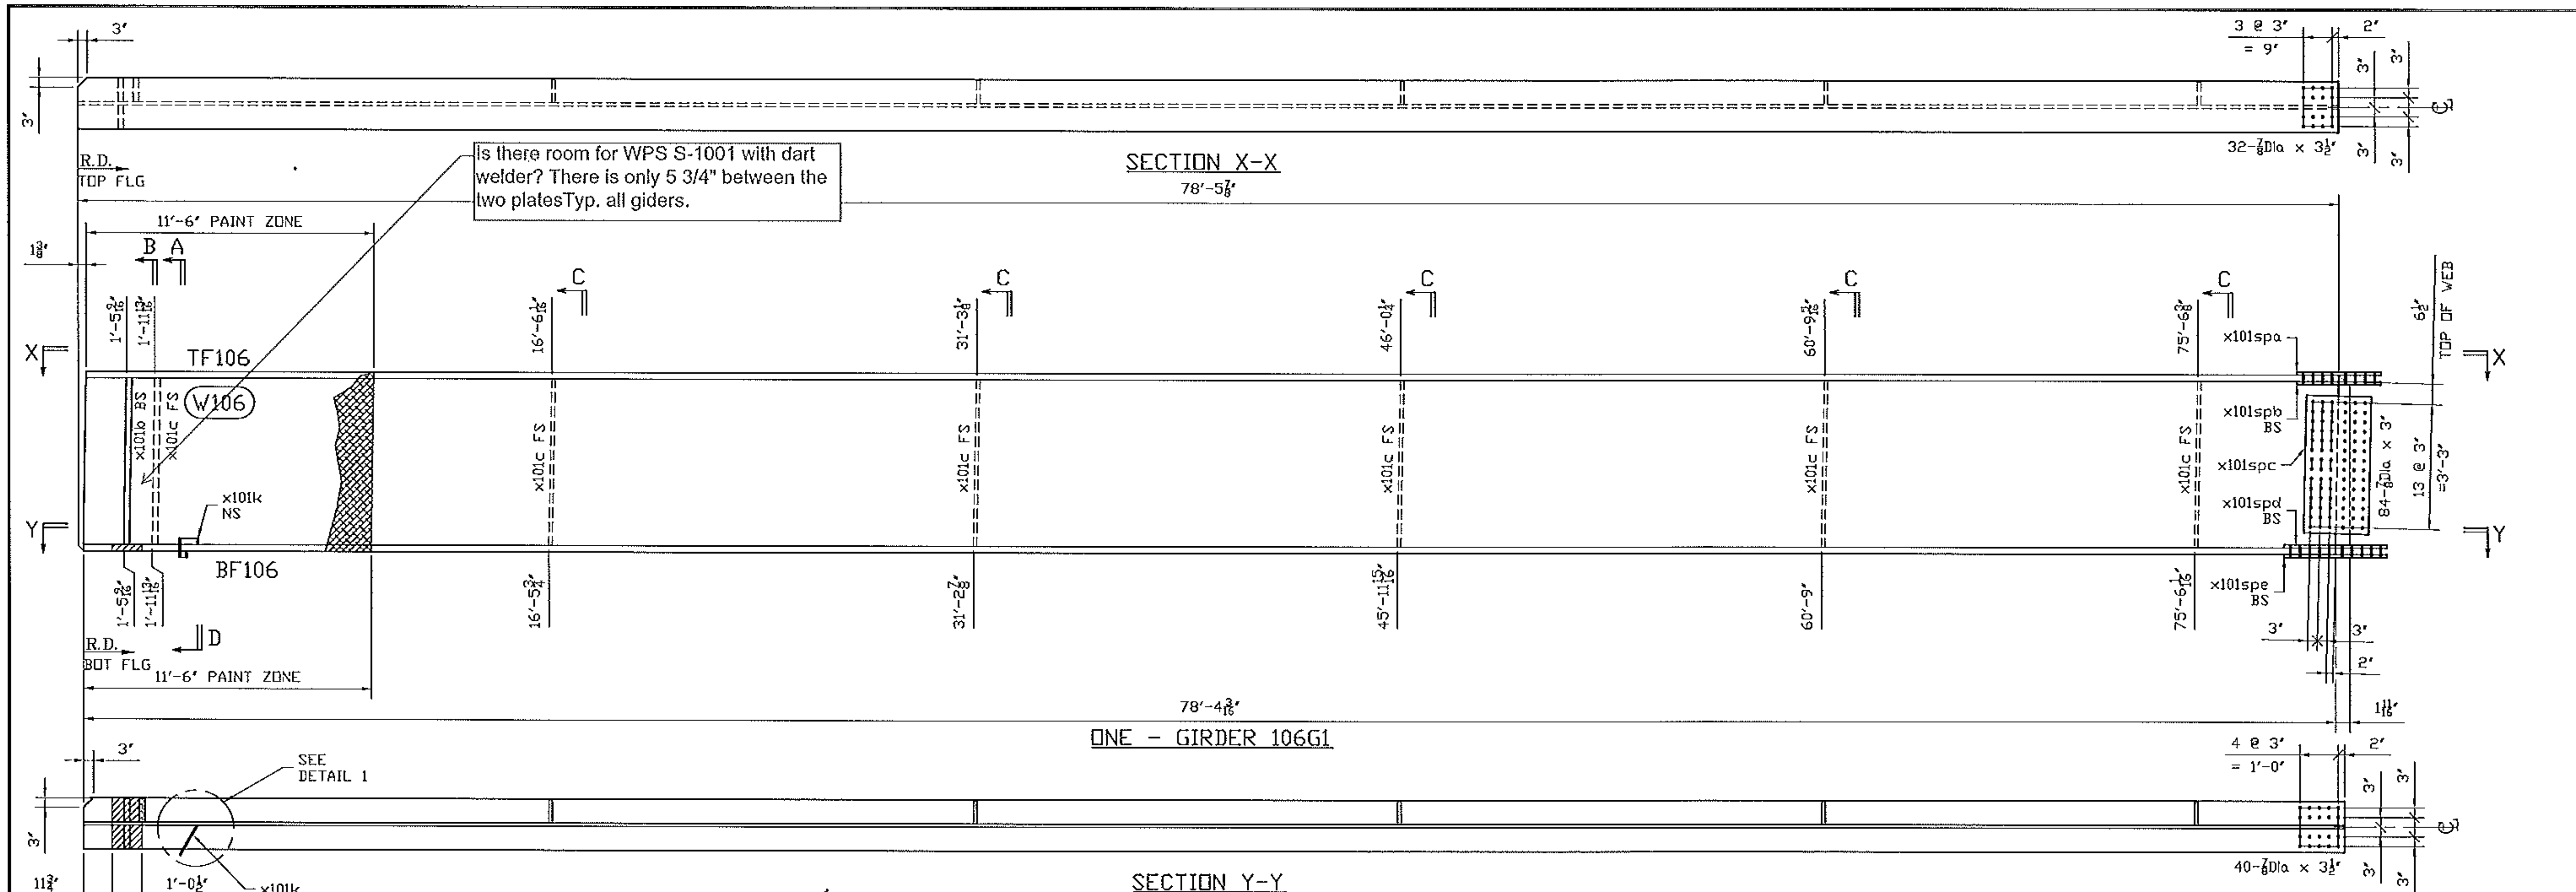

Is there room for WPS S-1001 with dart welder? There is only 5 3/4" between the two plates Typ. all girders.

NO PRIMER  
NO PAINT  
MASKING ZONE  
SEE TYPICAL SECTION

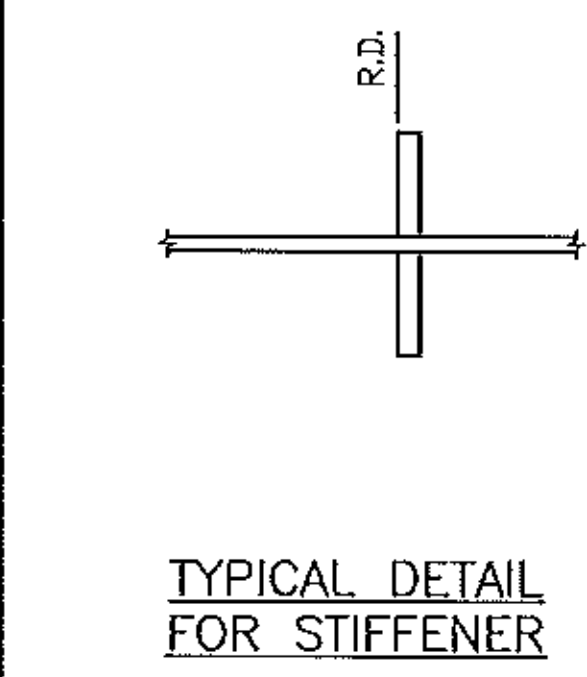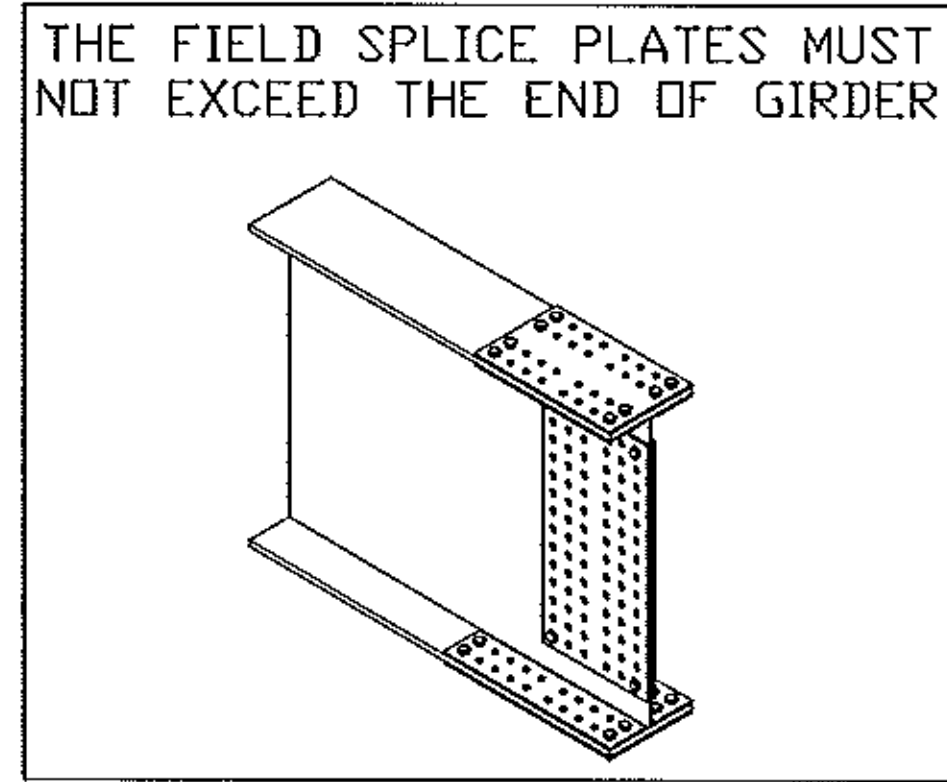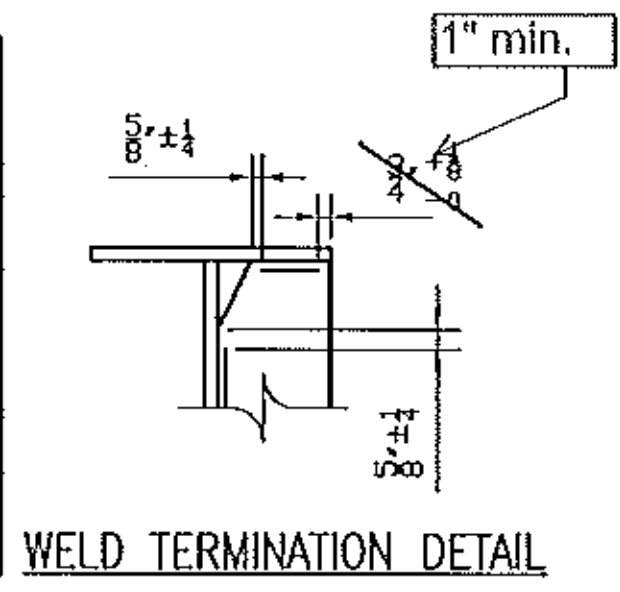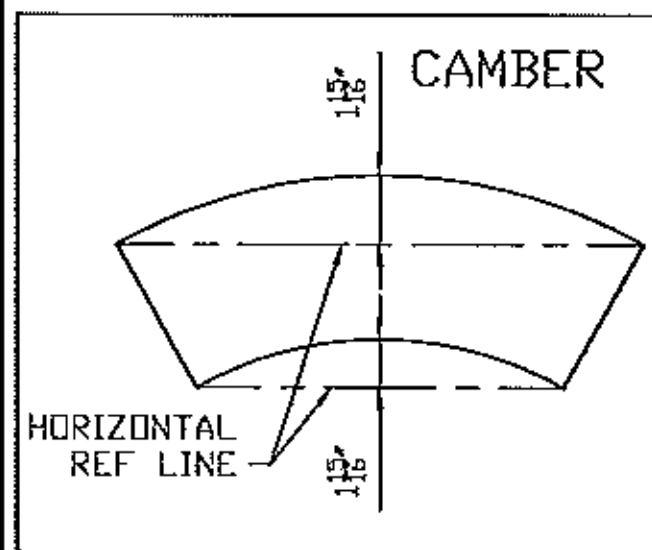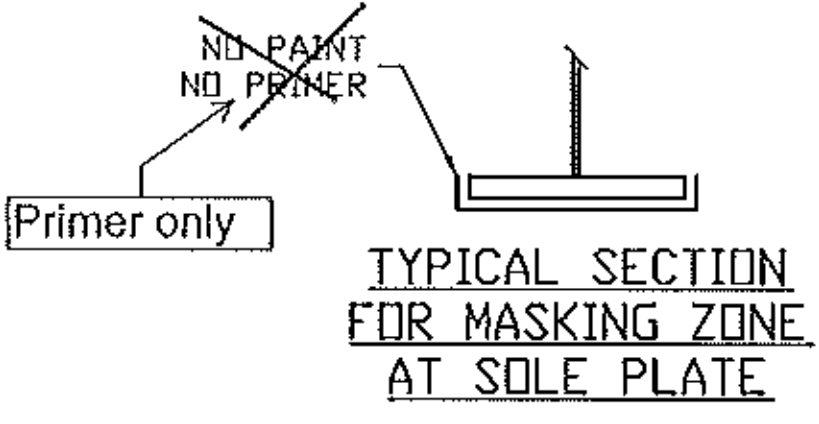

GENERAL NOTES: SEE GN100  
HOLES: 15/16 (U.N.)  
CLEANING AND PAINTING: SEE SHEET P100 AND P101

See standard specification 506.24(a)(9), no payment will be made for bolts, nuts, washers, they are considered to be incidental

BILL OF MATERIAL

Work	Qty.	Description	Std	Length	Remark	ABM	Total	Seq	Qty
			Grd				Weight		/Seq
106G1	ONE	GIRDER				16355	16480		1
106G1	1	GIRDER		78-5 7/8					
TF106	1	PL1x16	A70950WT2	78-4 1/2		100-1	4267		
W106	1	PL1/2x52	A70950WT2	78-5 7/8		100-2	6944		
BF106	1	PL1x16	A70950WT2	78-4 3/16		100-1	4266		
x101b	2	PL7/8x7 1/2	A70950WT2	4-4	WB	101-1	194		
x101c	6	PL1/2x7 1/2	A70950WT2	4-4		101-2/3	332		
x101k	1	PL1/4x3 1/8	A70950WT2	11		101-4	2		
x101spa	1	PL1/2x16	A70950WT2	2-2 1/4		102-1	60		
x101spb	2	PL1/2x7	A70950WT2	2-2 1/4		102-2	52		
x101spc	2	PL1/2x43	A70950WT2	8 1/4		102-3	101		
x101spd	2	PL1/2x7	A70950WT2	2-8 1/4		102-4	64		
x101spe	1	PL1/2x16	A70950WT2	2-8 1/4		102-5	73		
FB		FIELD BOLTS							
78F3	84	.7/8 Dia A325 TYP3			3 1FL WASH		67		
78F312	72	.7/8 Dia A325 TYP3			3 1/2 1FL WASH		58		

Vermont Agency of Transportation  
**RECEIVED**  
CK'D BY M.E.M. OK'D BY C.W.M.  
July 09, 2012  
RESUBMIT APPROVED AS NOTED  
BY C. CARLSON DATE 07-27-2012

No	FOR APPROVAL	DATE	PAR	VER.
		07/06/12	BR	EG
	REVISION			

NOTE: BOLT 1 WASHER: 1 WASHER UNDER NUT U.N.  
BOLT 2 WASHER: 1 WASHER UNDER HEAD U.N.  
1 WASHER UNDER HEAD U.N.


386 River Road, Claremont, NH 03743  
Tel:(603) 542-5202 Fax:(603) 542-5312

PROJECT: VT RT 9, BRIDGE NO. 11  
TOWN OF WOODFORD, VT  
OVER WALDOOMSAC RIVER


TITLE: GIRDER 106G1

REFERENCE: PROJECT NO. ER BHF 010-1 (44)


BY: BR	DATE: JULY 2012	CONTACT NO: UN04260
DESIGN: GG	DATE: JULY 2012	REVISION: 106-2 A

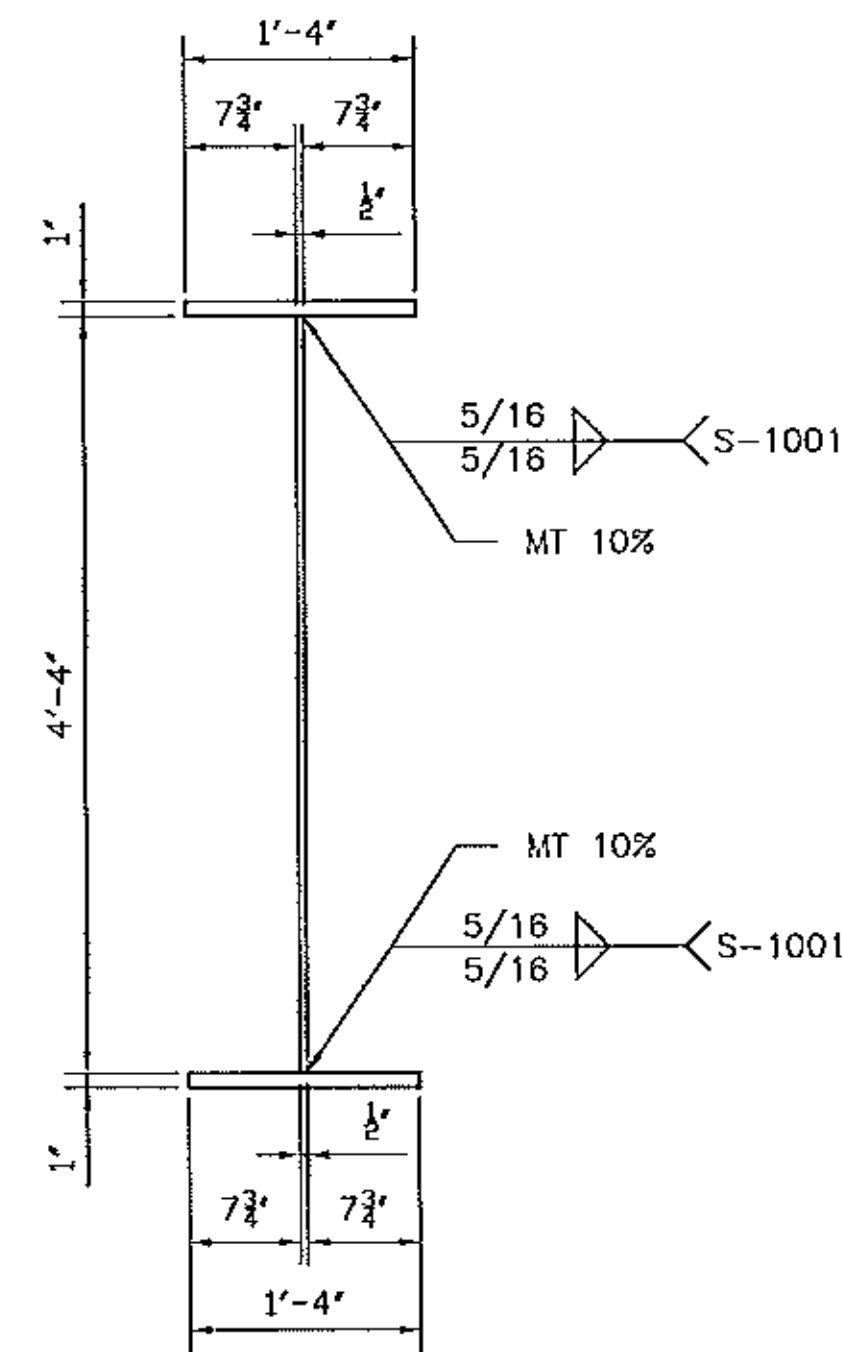


TYPICAL SECTION

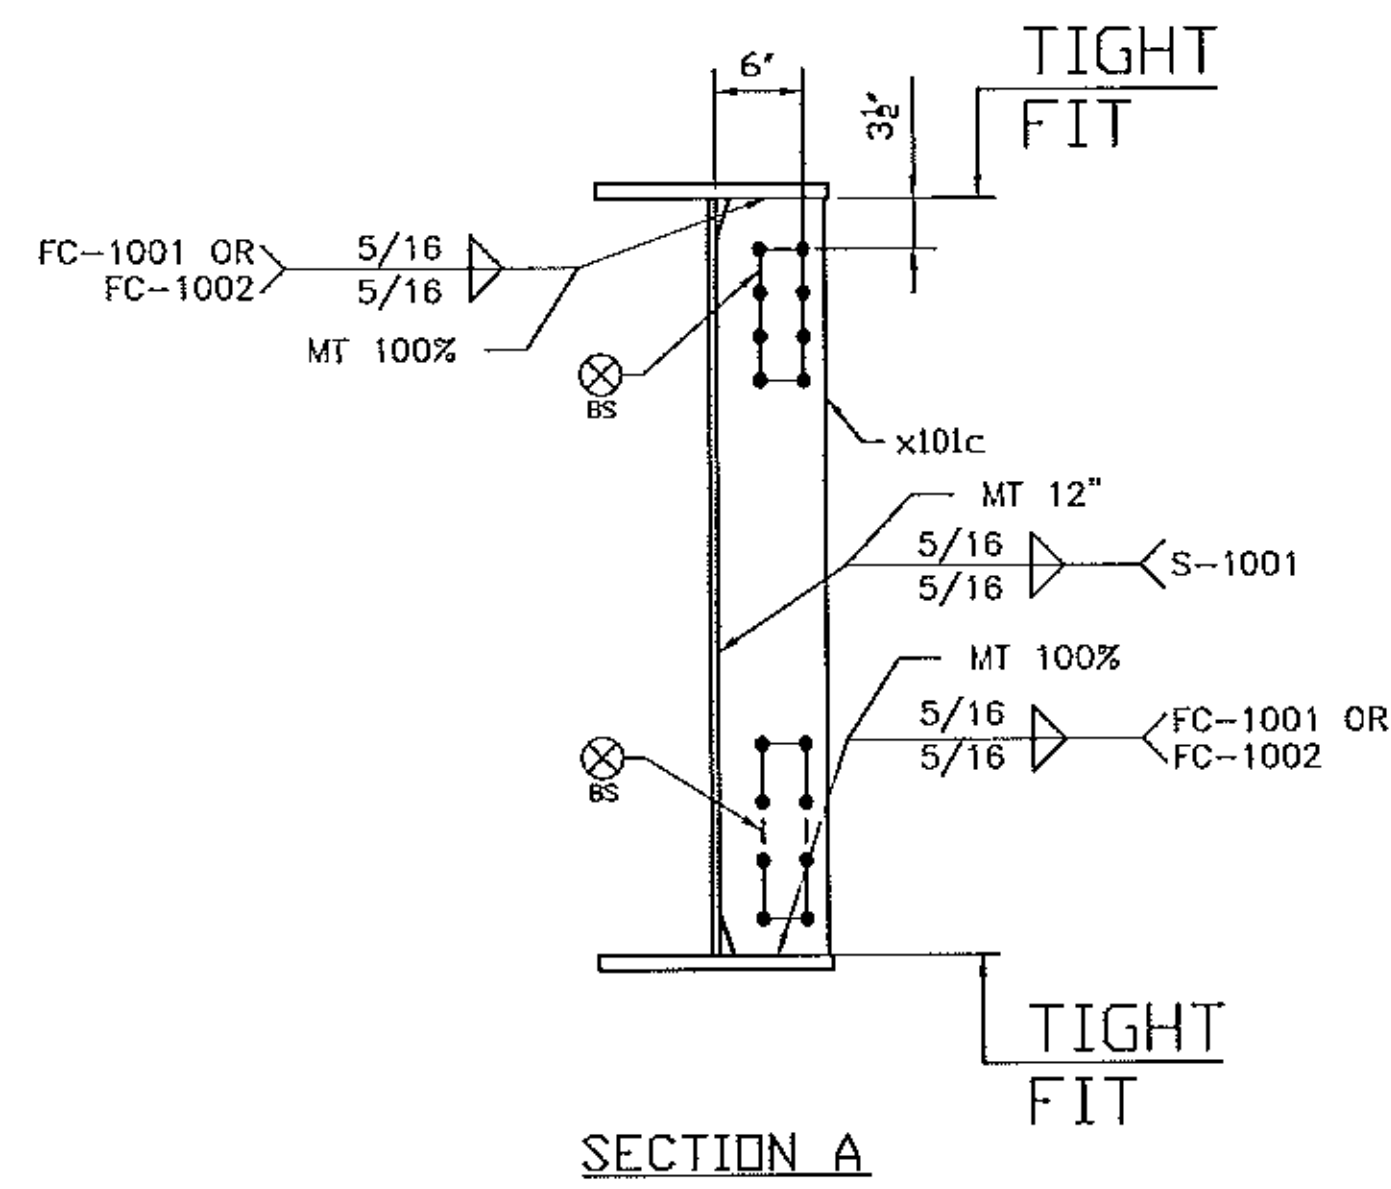

SECTION A

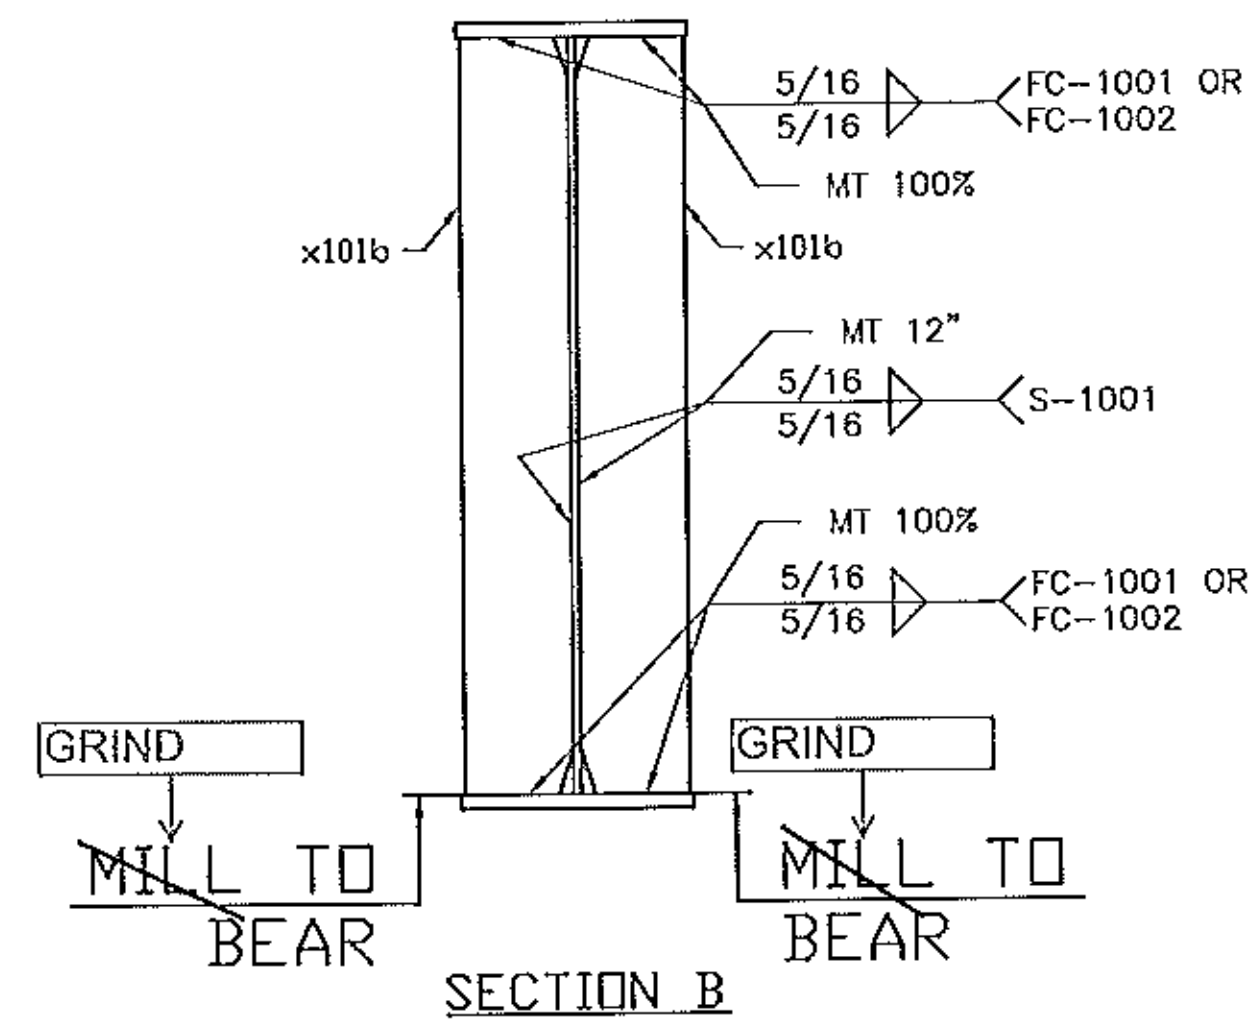


SECTION B

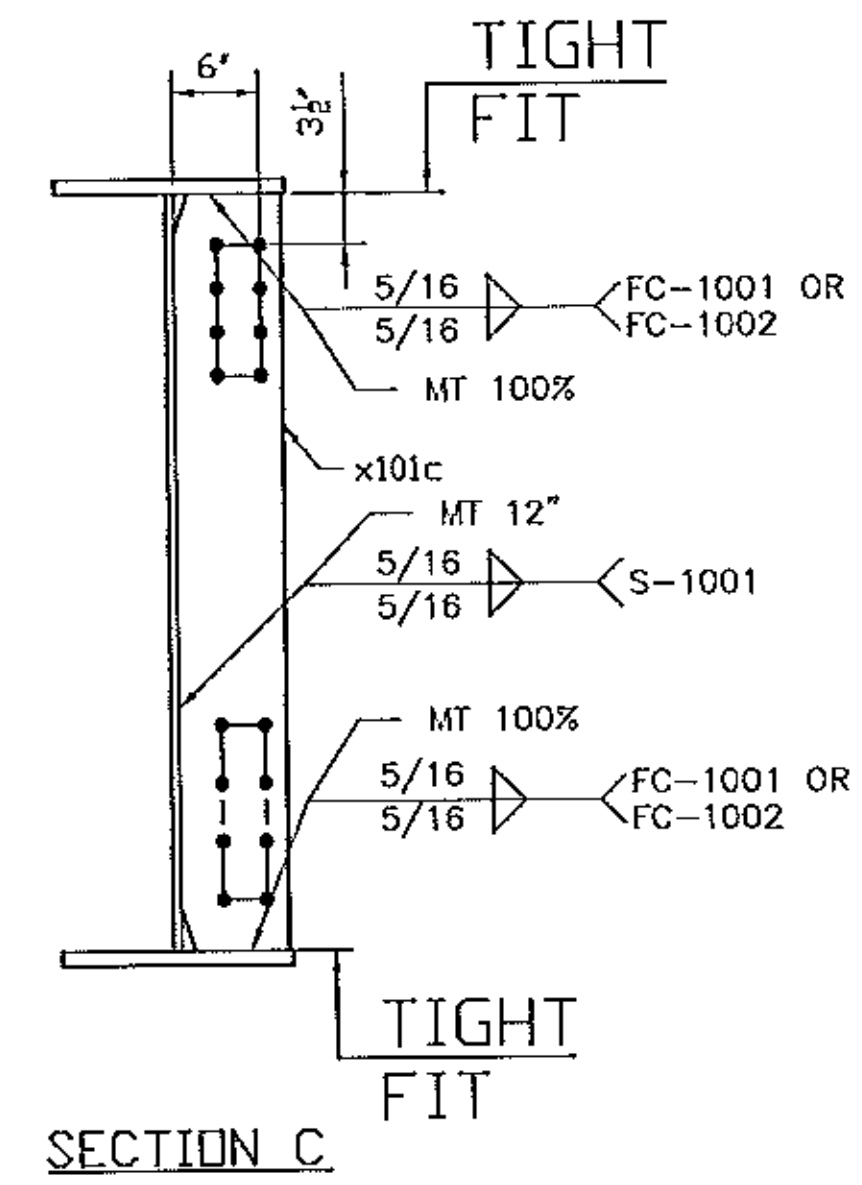


SECTION C

GENERAL NOTES: SEE GN100  
 HOLES: 15/16 (U.N.)  
 CLEANING AND PAINTING: SEE SHEET P100 AND P101

No	REVISION	DATE	PAR	VER.
1	FDR APPROVAL	07/06/12	BR	EG

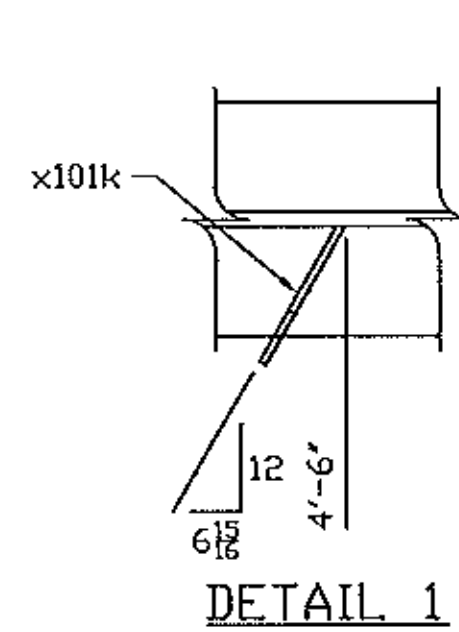


DETAIL 1

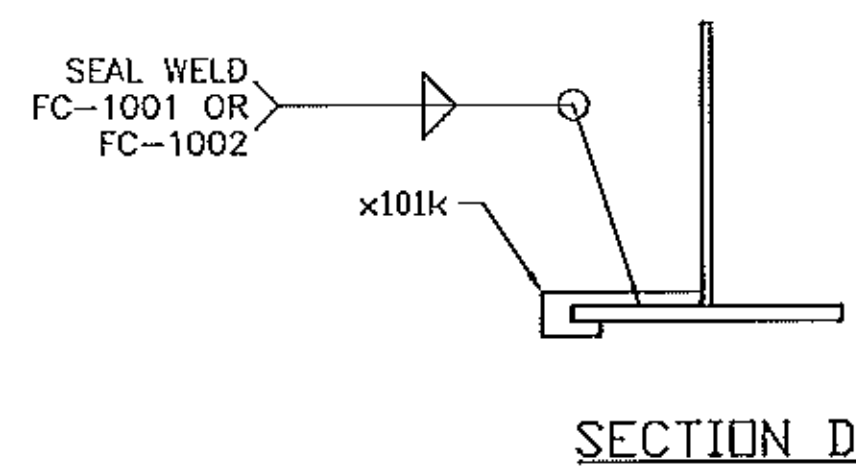

SECTION D

PRIMER ONLY, NO PAINT  
 BOTH SIDES 75 mm DIA AROUND HOLE  
 WHERE NOTED WITH THIS SYMBOL

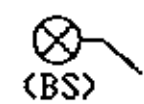

Vermont Agency of Transportation

**RECEIVED**

CK'D BY M.E.M. OK'D BY C.W.M.

July 09, 2012

RESUBMIT APPROVED AS NOTED  
 BY C. CARLSON DATE 07-27-2012

NOTE: BOLT 1 WASHER: 1 WASHER UNDER NUT U.N.  
 BOLT 2 WASHER: 1 WASHER UNDER HEAD U.N.  
 1 WASHER UNDER HEAD U.N.

**STRUCTURAL**  
 Bridges  
 386 River Road, Clarendon,  
 VT 05743  
 Tel: (802) 542-5202 Fax: (802) 542-5312

a division of  
**CANAM**  
 BRIDGE


PROJECT: VT RT 9, BRIDGE NO. 11  
 TOWN OF WOODFORD, VT  
 OVER WALDOMSAC RIVER

TITLE: GIRDER 106G1


REFERENCED: PROJECT NO. ER BHF 010-1 (44)

REV BY	DATE	CONTRACT NO.
BR	JULY 2012	UN04260
GG	JULY 2012	106-3 A



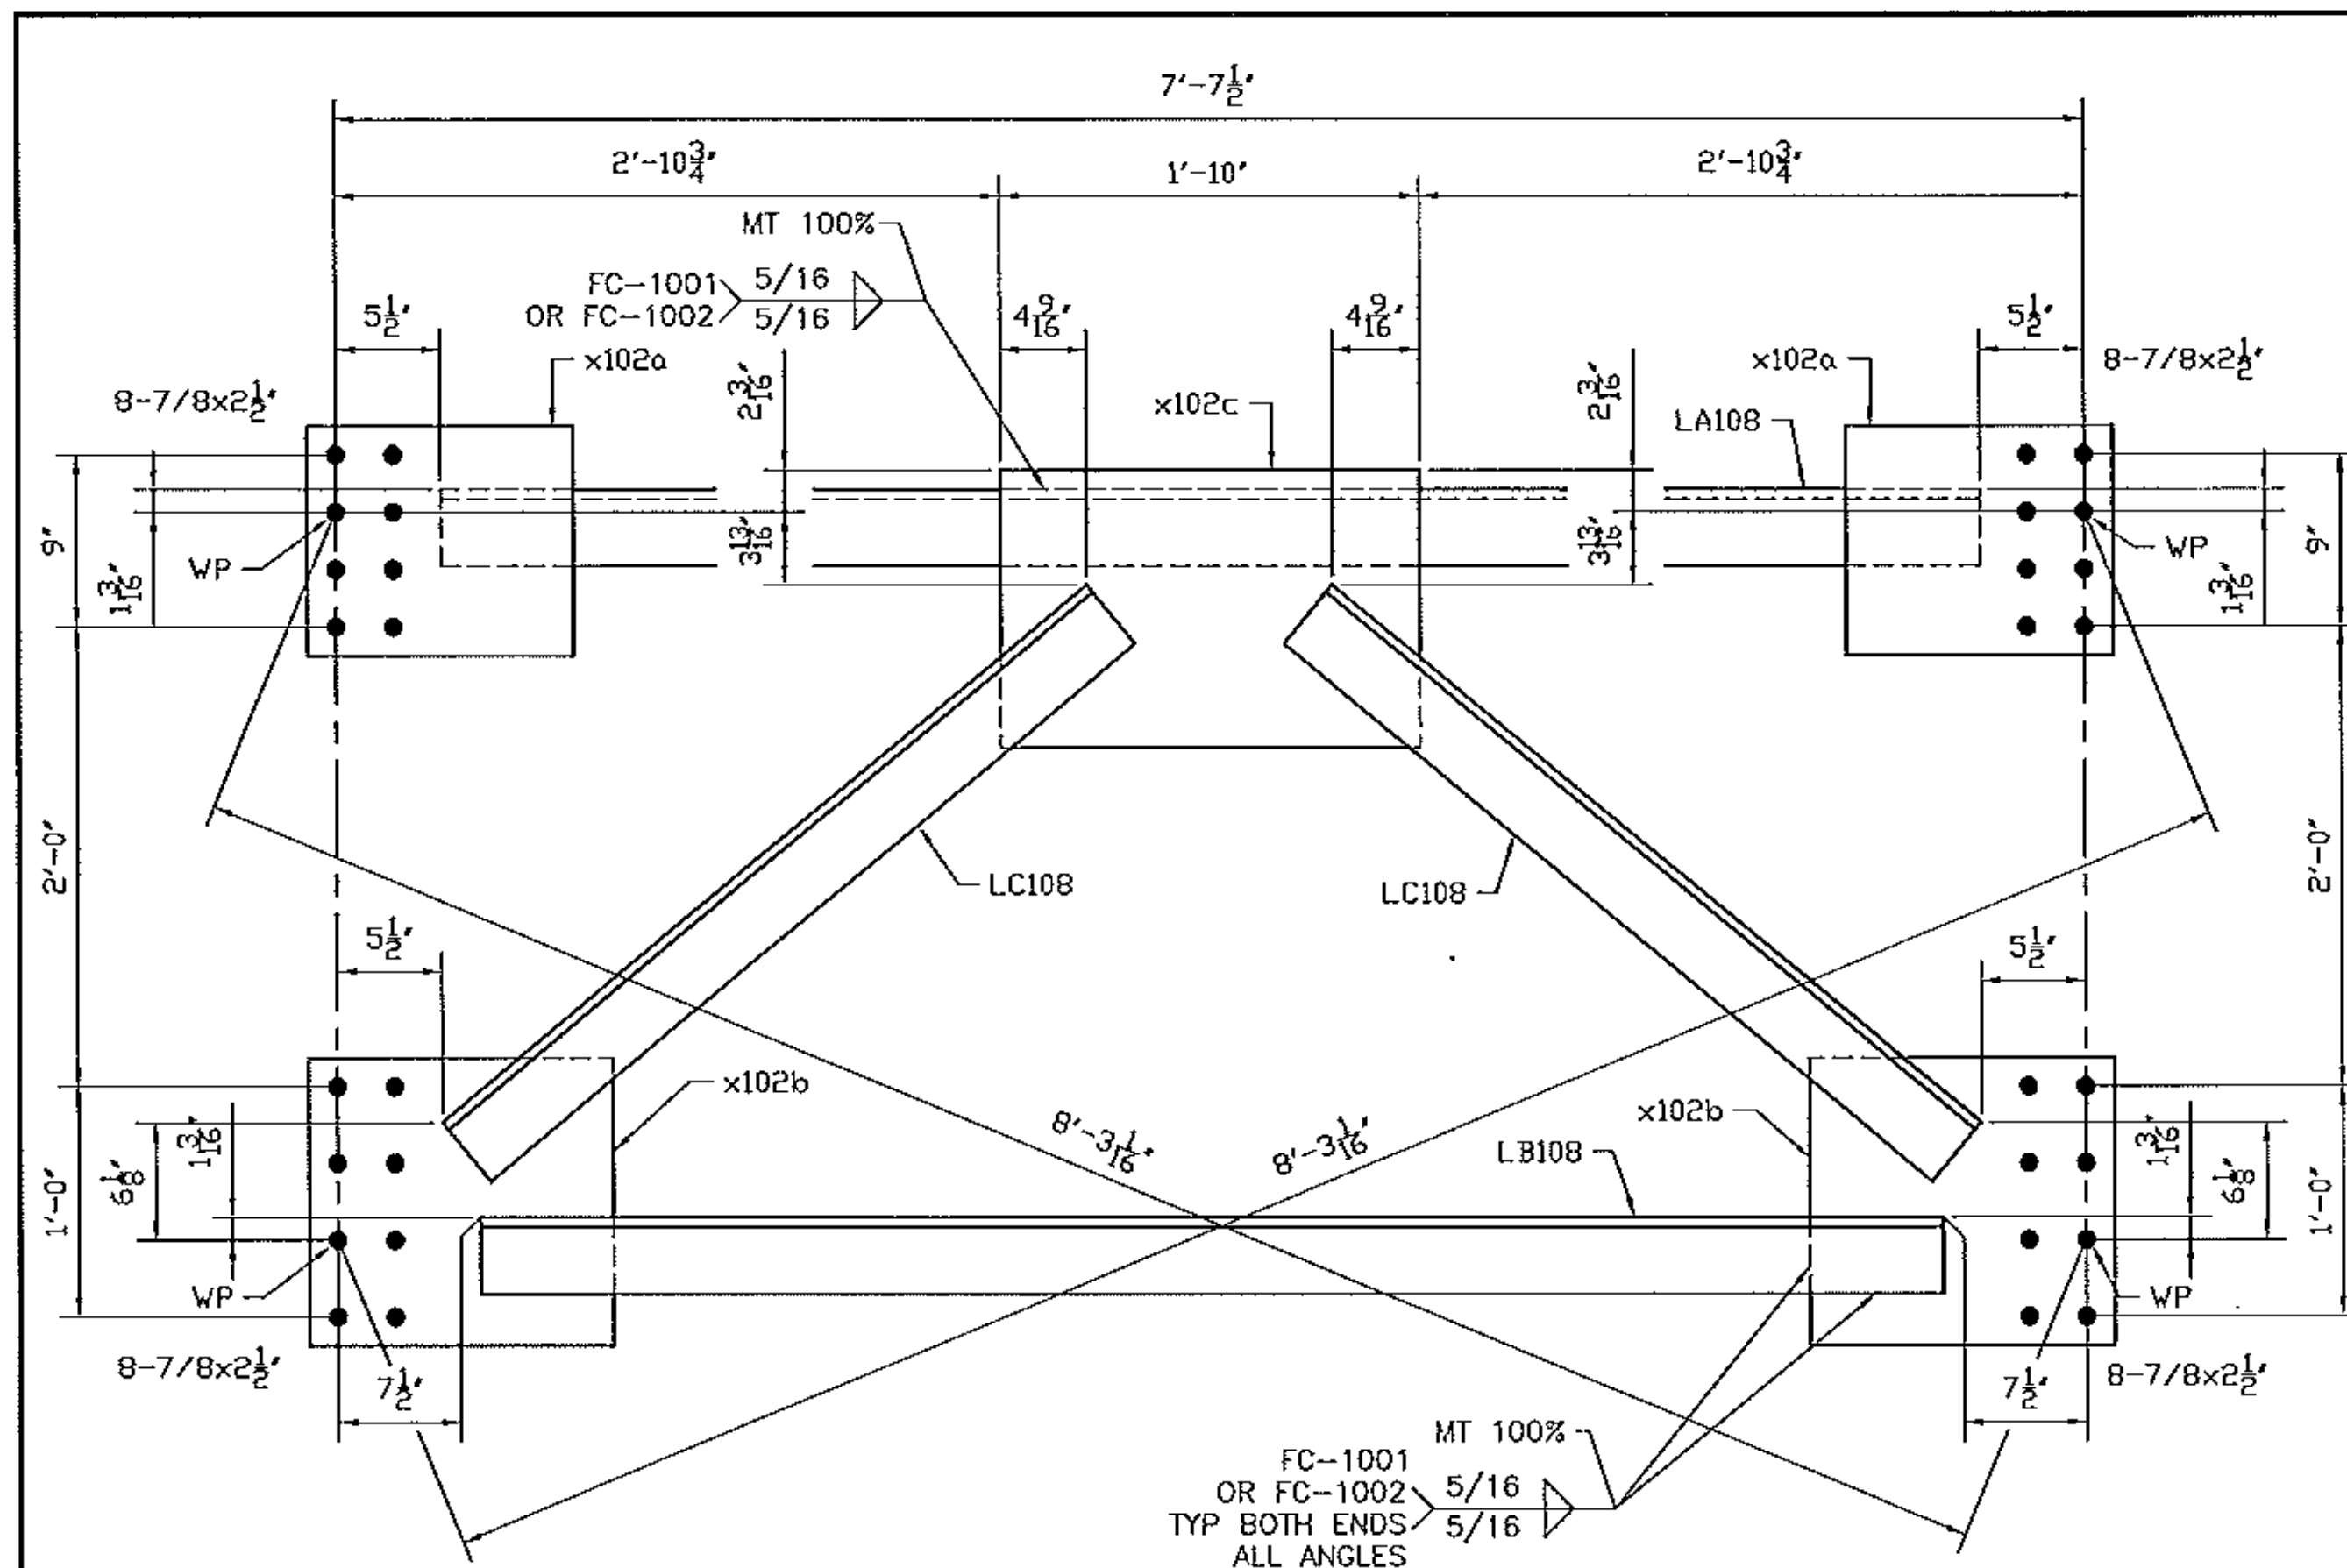

4 - CROSS FRAME 108CF1

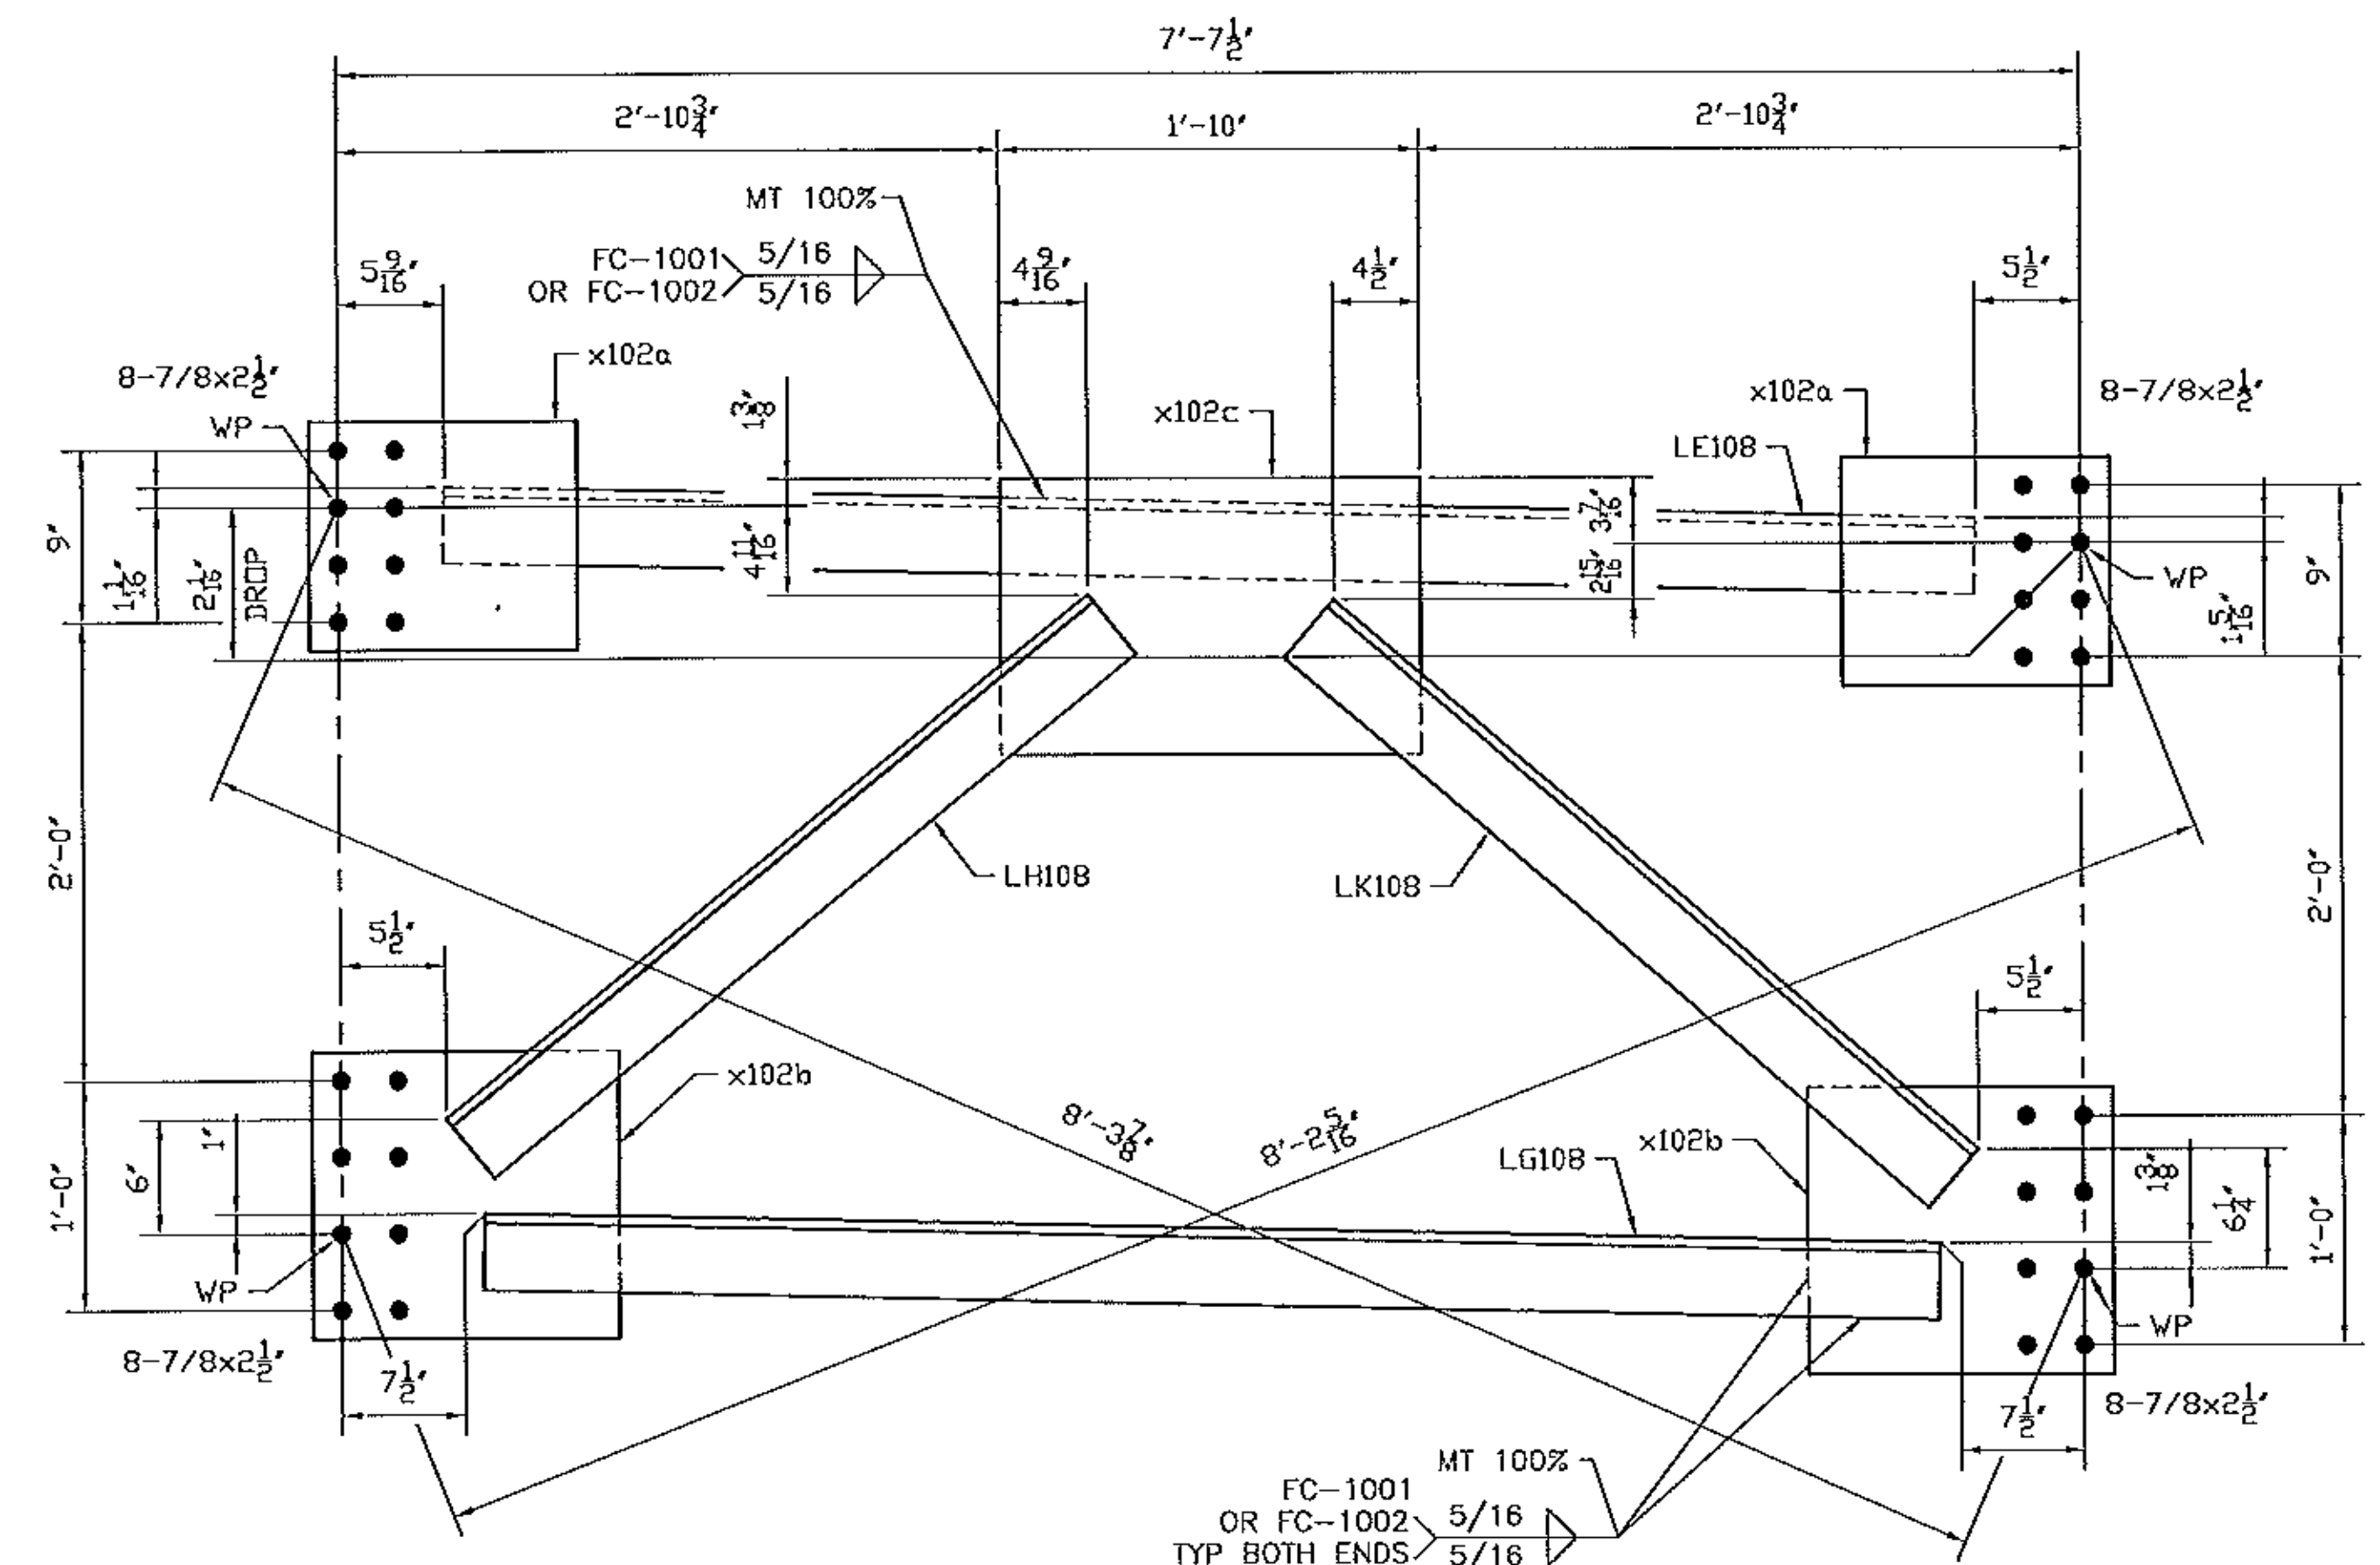

4 - CROSS FRAME 108CF2

BILL OF MATERIAL

Mark	Qty.	Description	SI	Length	Remark	ABM	Total Weight	Seq	Qty
108CF1	4	CROSS FRAME	Grd			1688	1789	1	4
108CF1	4	CROSS FRAME		7-10 1/2					
LA108	4	L4x4x1/2	A70950W	6-8 1/2		106-2	343		
LB108	4	L4x4x1/2	A70950W	6-4 1/2		106-2	326		
LC108	8	L4x4x1/2	A70950W	3-7 15/16		106-4	375		
x102a	8	PL1/2x12	A70950W	1-2		106-6	191		
x102b	8	PL1/2x15	A70950W	1-4		106-6	272		
x102c	4	PL1/2x14 1/2	A70950W	1-10		106-8	181		
FB		FIELD_BOLTS							
78F212	128	7/8 Dia A325 TYP3		2 1/2	1FL WASH				
108CF2	4	CROSS FRAME				1688	1790	1	4
108CF2	4	CROSS FRAME		7-10 1/2					
LE108	4	L4x4x1/2	A70950W	6-8 7/16		106-2	343		
LG108	4	L4x4x1/2	A70950W	6-4 1/2		106-2	326		
LH108	4	L4x4x1/2	A70950W	3-7 1/2		106-4	186		
LK108	4	L4x4x1/2	A70950W	3-8 3/8		106-4	189		
x102a	8	PL1/2x12	A70950W	1-2		106-6	191		
x102b	8	PL1/2x15	A70950W	1-4		106-6	272		
x102c	4	PL1/2x14 1/2	A70950W	1-10		106-8	181		
FB		FIELD_BOLTS							
78F212	128	7/8 Dia A325 TYP3		2 1/2	1FL WASH				

GENERAL NOTES: SEE GN100

HOLES: 15/16 (UN.)

CLEANING AND PAINTING: SEE SHEET P100

See standard specification 506.24(a)(9), no payment will be made for bolts, nuts, washers, they are considered to be incidental

Vermont Agency of Transportation  
**RECEIVED**

CK'D BY M.E.M. OK'D BY C.W.M.

July 09, 2012

RESUBMIT APPROVED AS NOTED  
BY C. CARLSON DATE 07-27-2012

No	REVISION	DATE	PAR	VER.
		07/06/12	BR	EG

NOTE: BOLT 1 WASHER: 1 WASHER UNDER NUT U.N.  
BOLT 2 WASHER: 1 WASHER UNDER HEAD U.N.  
1 WASHER UNDER HEAD U.N.




PROJECT: VT RT 9, BRIDGE NO. 11  
TOWN OF WOODFORD, VT  
OVER WALDOOMSAC RIVER





TITLE: CROSS FRAME

REFERENCE: PROJECT NO. ER BHF 010-1 (44)

DATE	BY	DATE	BY	DATE	BY
	BR	JULY 2012			UN04260
	GG	JULY 2012			108 A

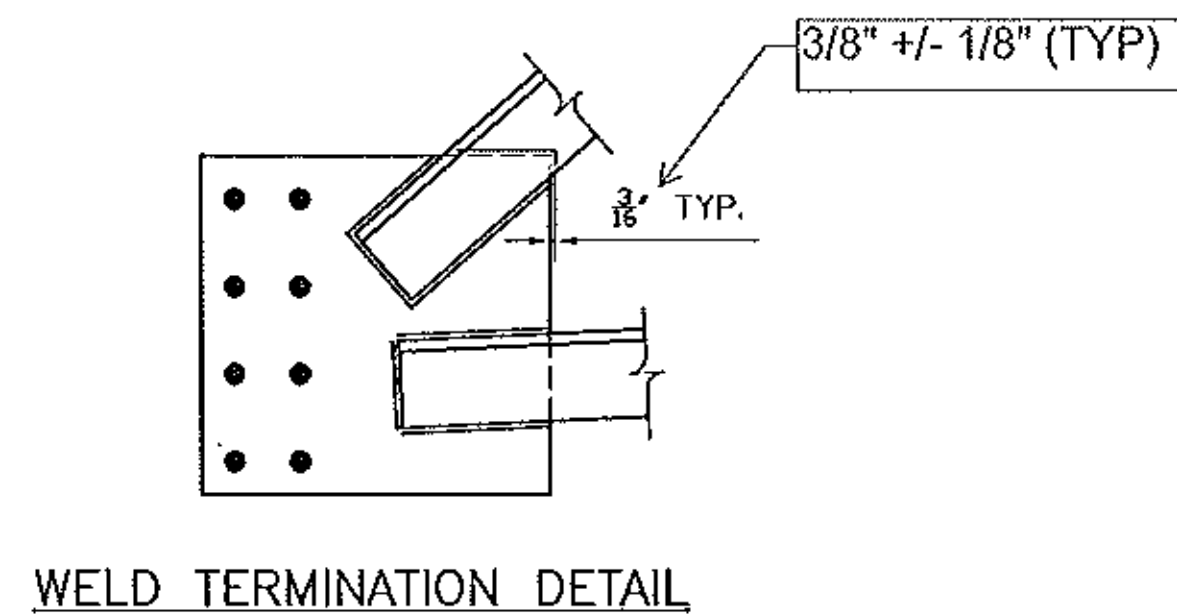

WELD TERMINATION DETAIL

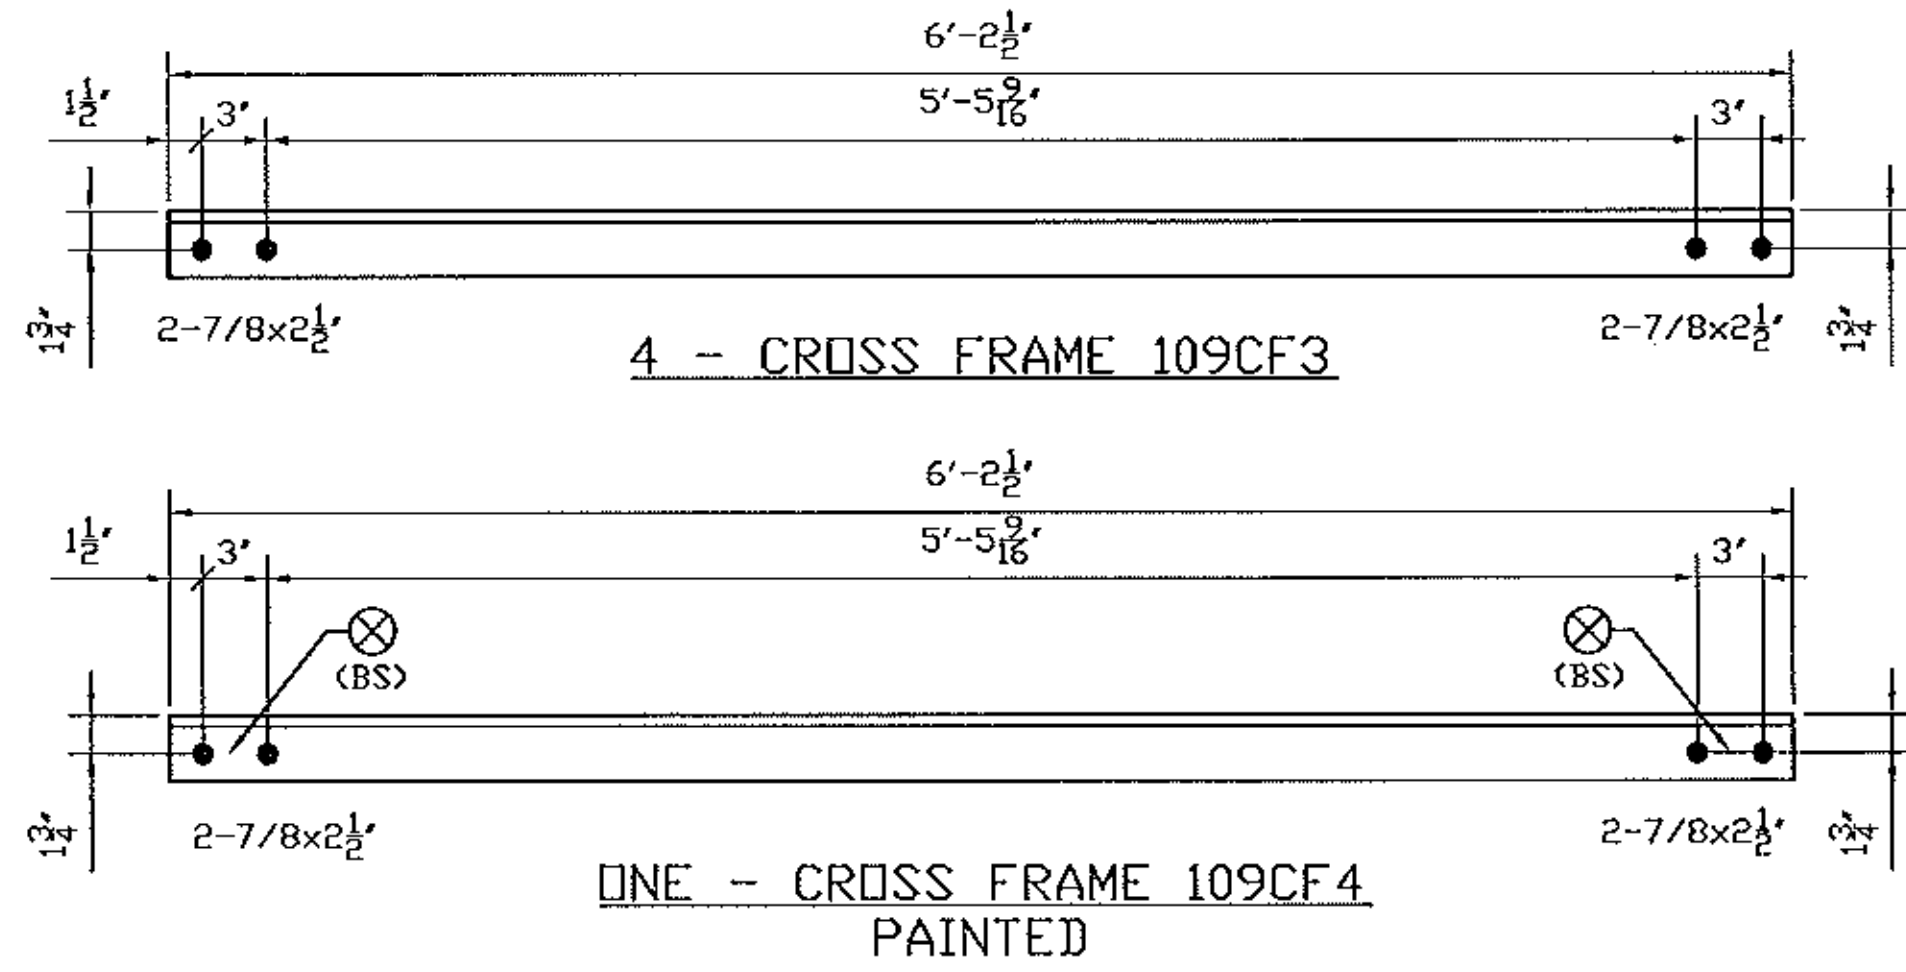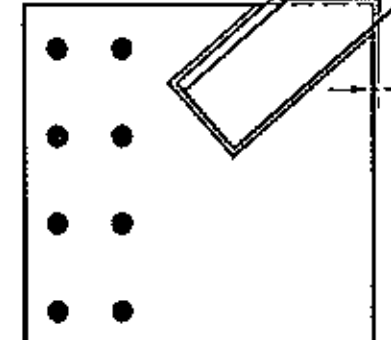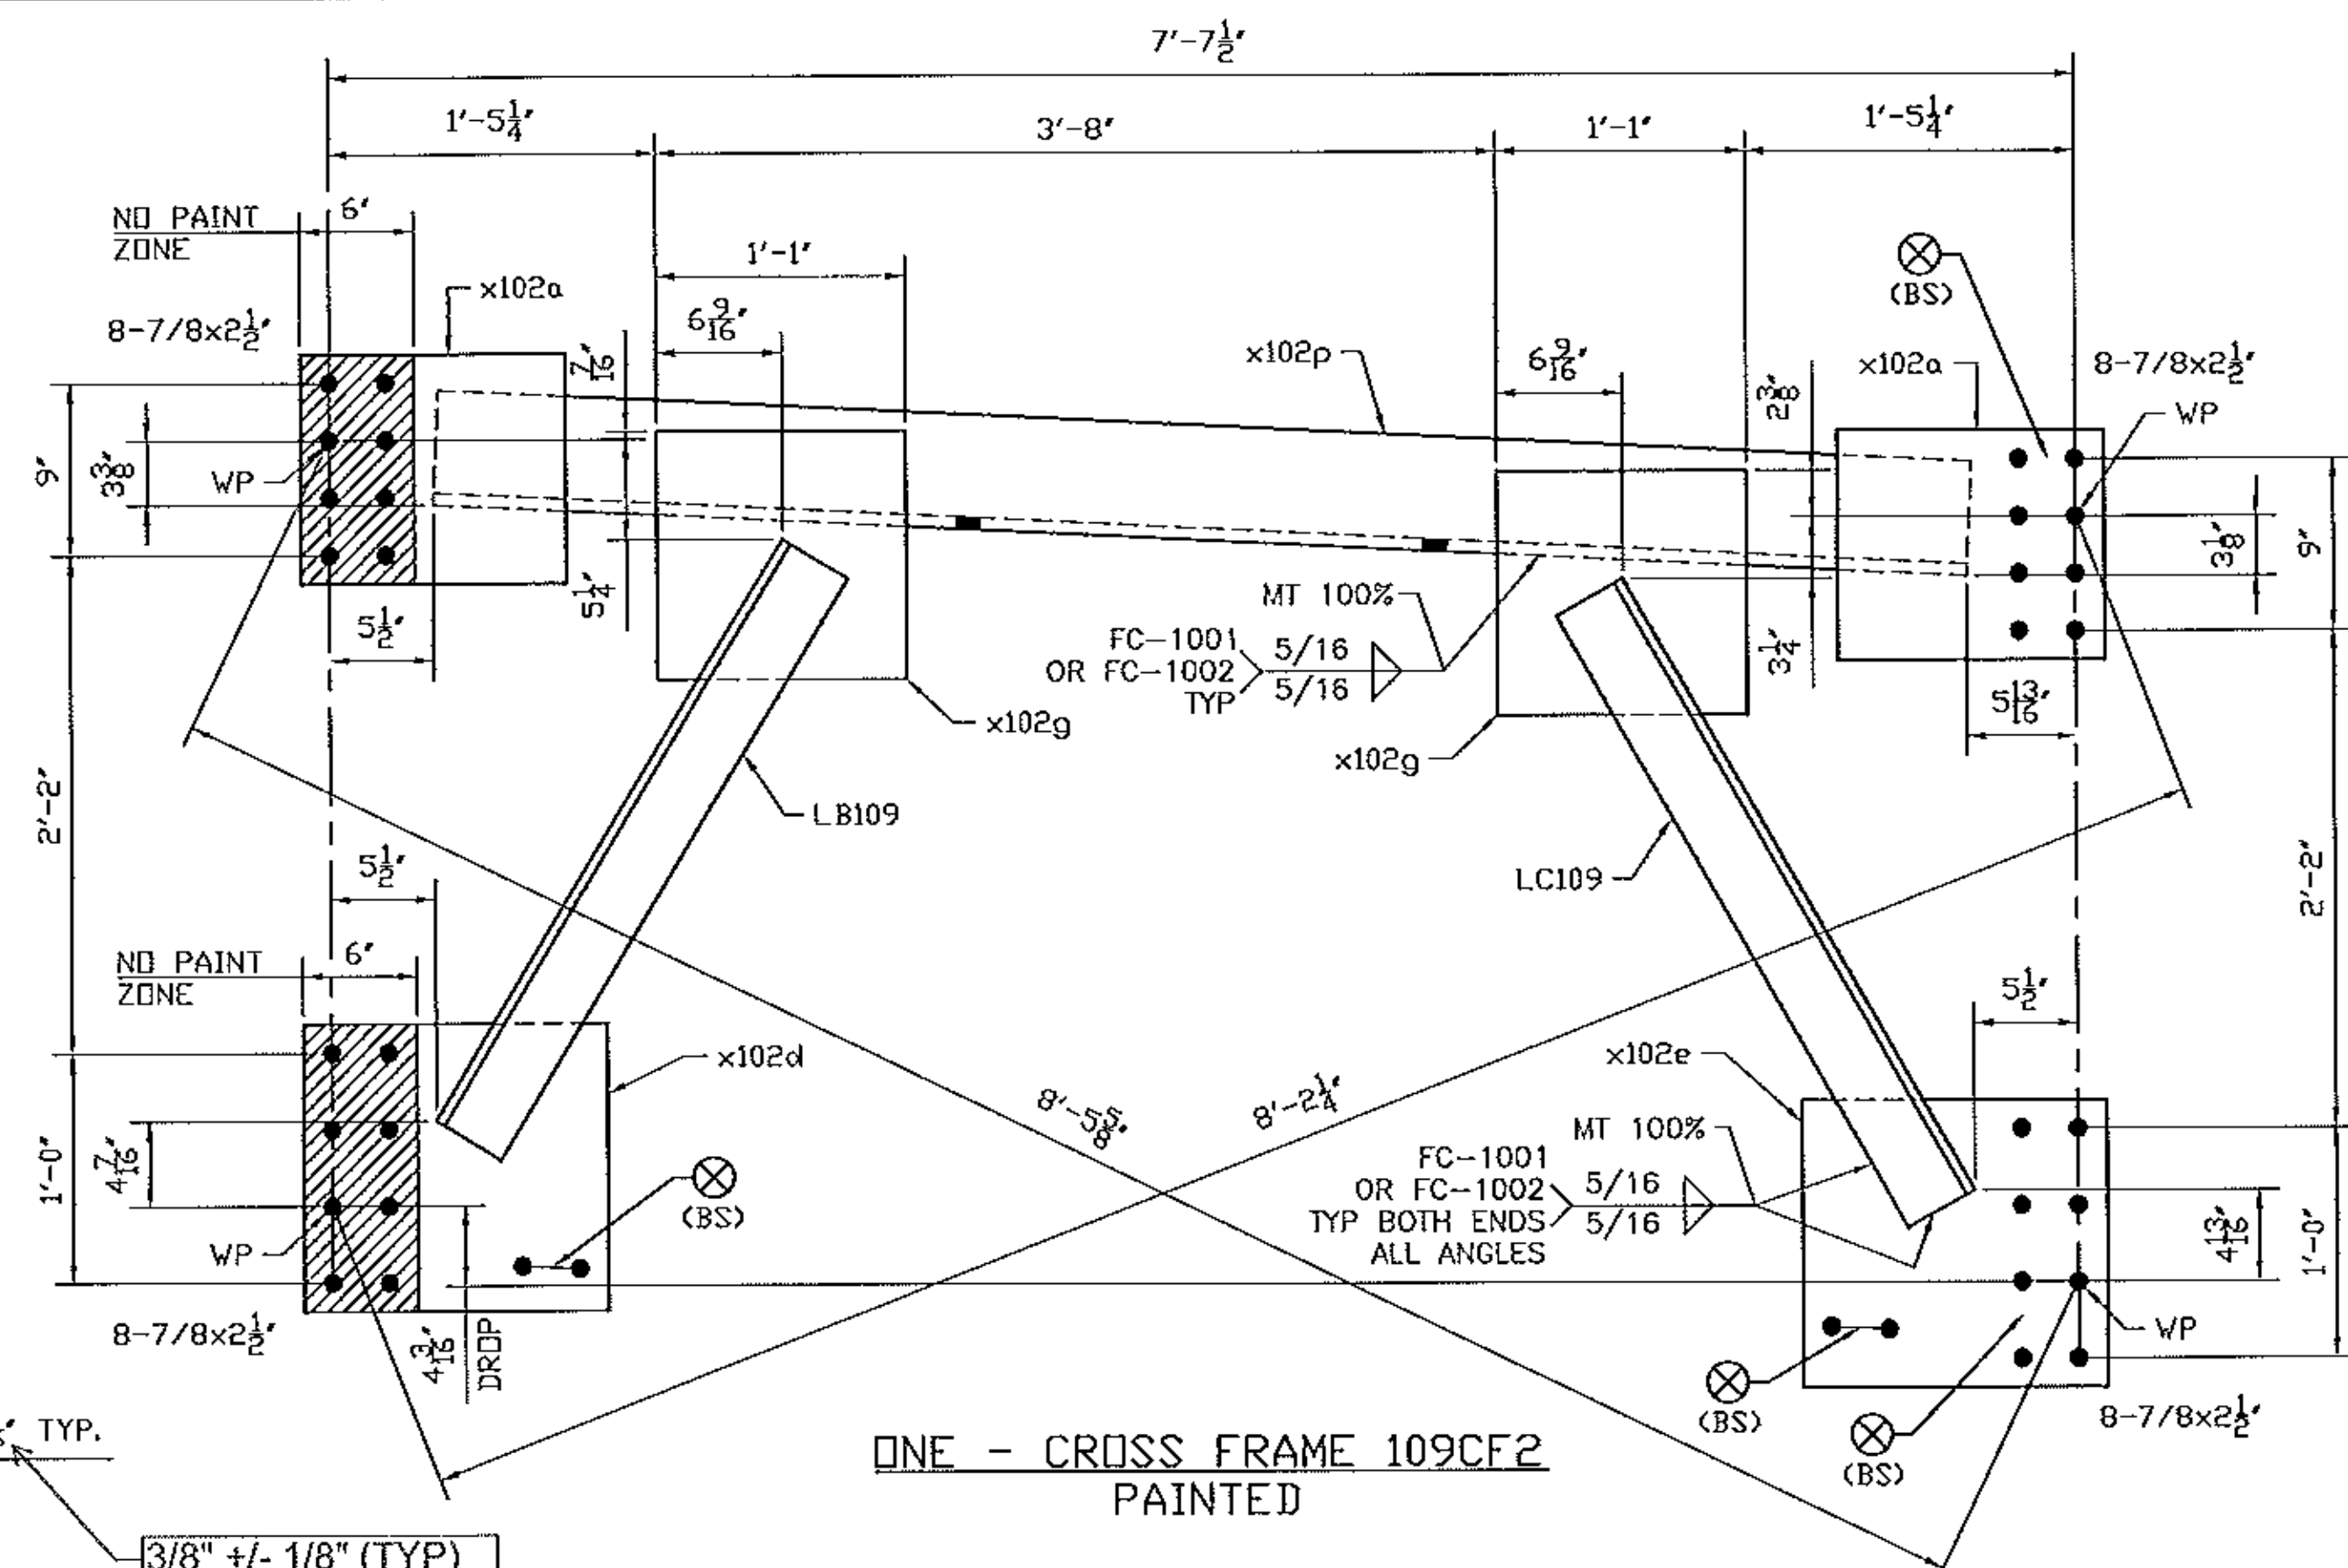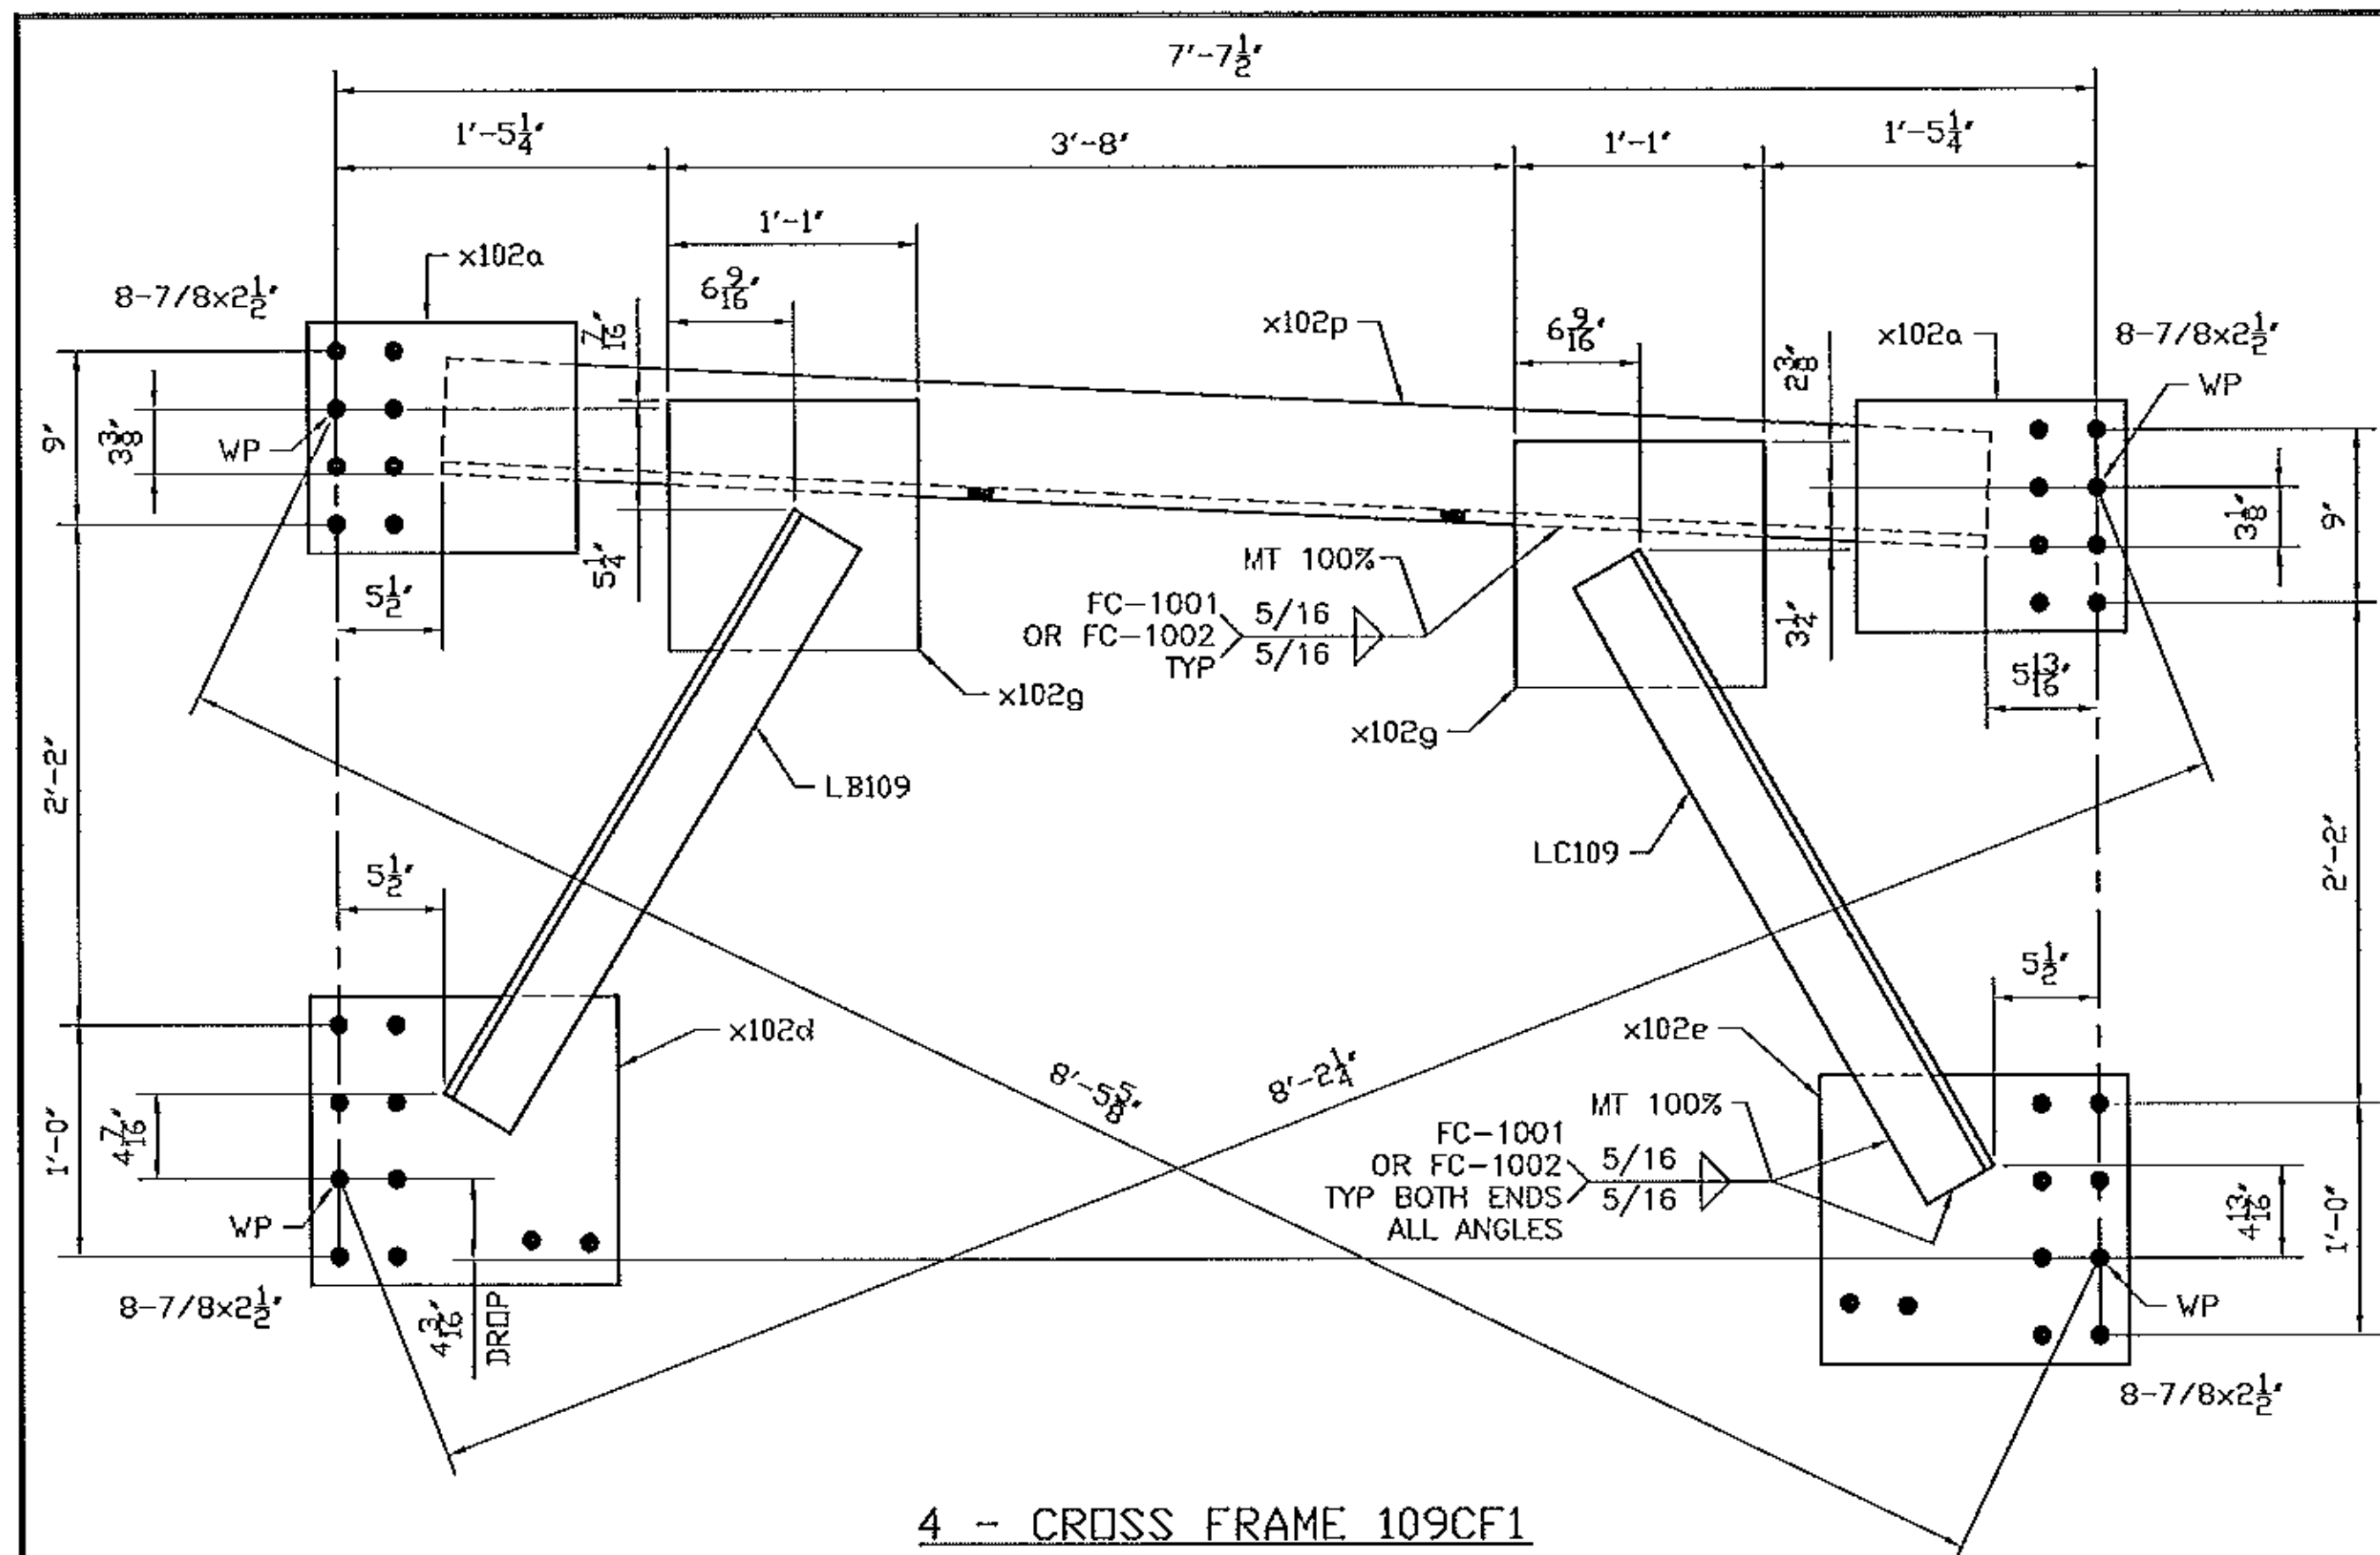

WELD TERMINATION DETAIL

BILL OF MATERIAL

Mark	Qty.	Description	Stl	Length	Remark	ABM	Total Weight	Seq	Qty /Seq
109CF1	4	CROSS FRAME	Grd			1611	1713	1	4
109CF1	4	CROSS FRAME		7-10 1/2					
LB109	4	L4x4x1/2	A70950W	2-11 3/8		105-6	151		
LC109	4	L4x4x1/2	A70950W	3-0 13/16		105-6	157		
x102a	8	PL1/2x12	A70950W	1-2		105-8	191		
x102d	4	PL1/2x15	A70950W	1-4		105-8	136		
x102e	4	PL1/2x15	A70950W	1-4		105-8	136		
x102g	8	PL1/2x13	A70950W	1-1		105-10	192		
x102p	4	L6x6x5/8	A70950W	6-8 5/16		105-2	648		
FB		FIELD_BOLTS							
78F212	128	.7/8 Dia A325 TYP3		2 1/2	1FL WASH				
109CF1	ONE	CROSS FRAME				403	429	1	1
109CF1	1	CROSS FRAME		7-10 1/2	PAINT				
LB109	1	L4x4x1/2	A70950W	2-11 3/8		105-5	38		
LC109	1	L4x4x1/2	A70950W	3-0 13/16		105-5	39		
x102a	2	PL1/2x12	A70950W	1-2		105-7	48		
x102d	1	PL1/2x15	A70950W	1-4		105-7	34		
x102e	1	PL1/2x15	A70950W	1-4		105-7	34		
x102g	2	PL1/2x13	A70950W	1-1		105-9	48		
x102p	1	L6x6x5/8	A70950W	6-8 5/16		162	648		
FB		FIELD_BOLTS							
78F212	32	.7/8 Dia A325 TYP3		2 1/2	1FL WASH				

GENERAL NOTES: SEE GN100  
 HOLES: 15/16 (U.N.)  
 CLEANING AND PAINTING: SEE SHEET P100 AND P101

See standard specification 506.24(a)(9), no payment will be made for bolts, nuts, washers, they are considered to be incidental

No	FOR APPROVAL	DATE	BR	EG
		07/06/12		
	REVISION		PAR	VER.

NOTE: BOLT 1 WASHER: 1 WASHER UNDER NUT U.N.  
 BOLT 2 WASHER: 1 WASHER UNDER HEAD U.N.  
 1 WASHER UNDER HEAD U.N.



PROJECT: VT RT 9, BRIDGE NO. 11  
 TOWN OF WOODFORD, VT  
 OVER WALDOOMSAC RIVER

TITLE: CROSS FRAME AT WATERLINE

REFERENCE: PROJECT NO. ER BHF 010-1 (44)

DESIGNED BY	DATE	CHECKED BY	DATE	CONTRACT NO.	REVISED BY	DATE
BR	JULY 2012	GG	JULY 2012	UN04260		
						109 A


Mark	Qty.	Description	Stl	Length	Remark	ABM	Total Weight	Seq	Qty /Seq
109CF3	4	CROSS FRAME	Grd				246	1	4
109CF3	4	L3x3x1/2	A70950W	6-2 1/2		105-4	233		
FB		FIELD_BOLTS							
78F212	16	.7/8 Dia A325 TYP3		2 1/2	1FL WASH		13		
109CF4	ONE	CROSS FRAME					61	1	1
109CF4	1	L3x3x1/2	A70950W	6-2 1/2	PAINT	105-3	58		
FB		FIELD_BOLTS							
78F212	4	.7/8 Dia A325 TYP3		2 1/2	1FL WASH		3		

Vermont Agency of Transportation  
**RECEIVED**


CK'D BY M.E.M. OK'D BY C.W.M.

July 09, 2012


RESUBMIT APPROVED AS NOTED  
 BY C. CARLSON DATE 07-27-2012

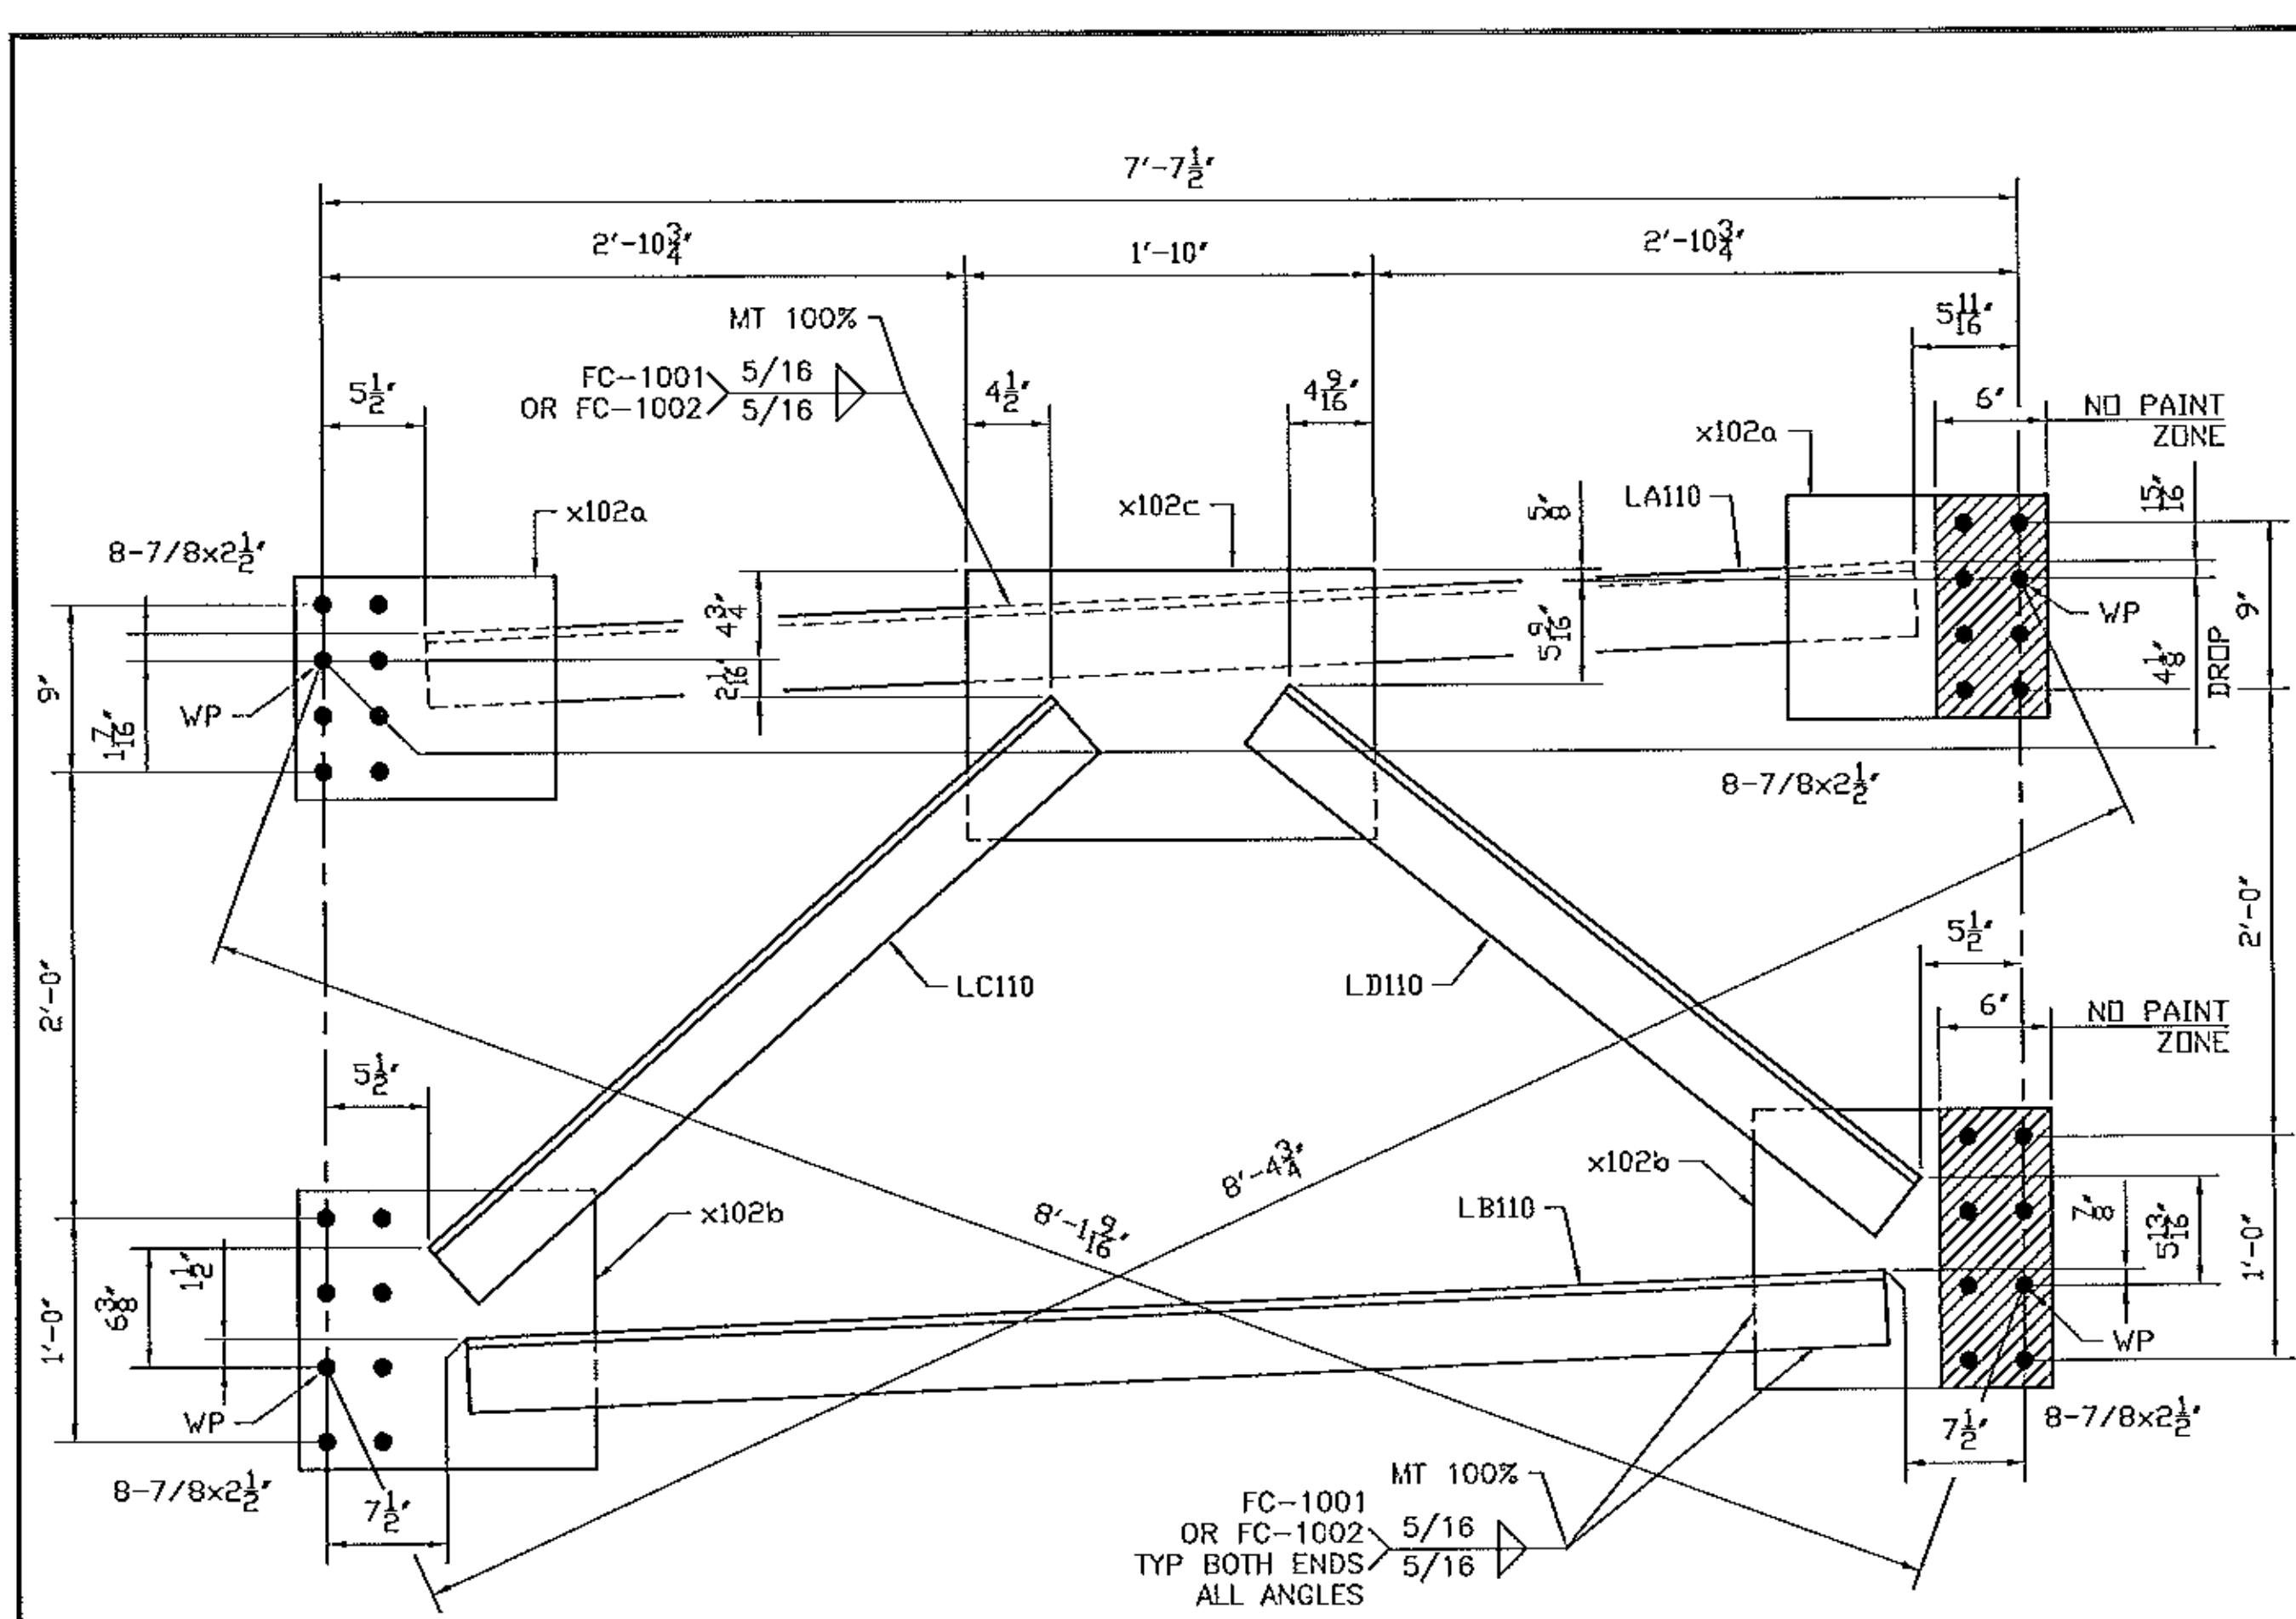

ONE - CROSS FRAME 110CF1  
PAINTED

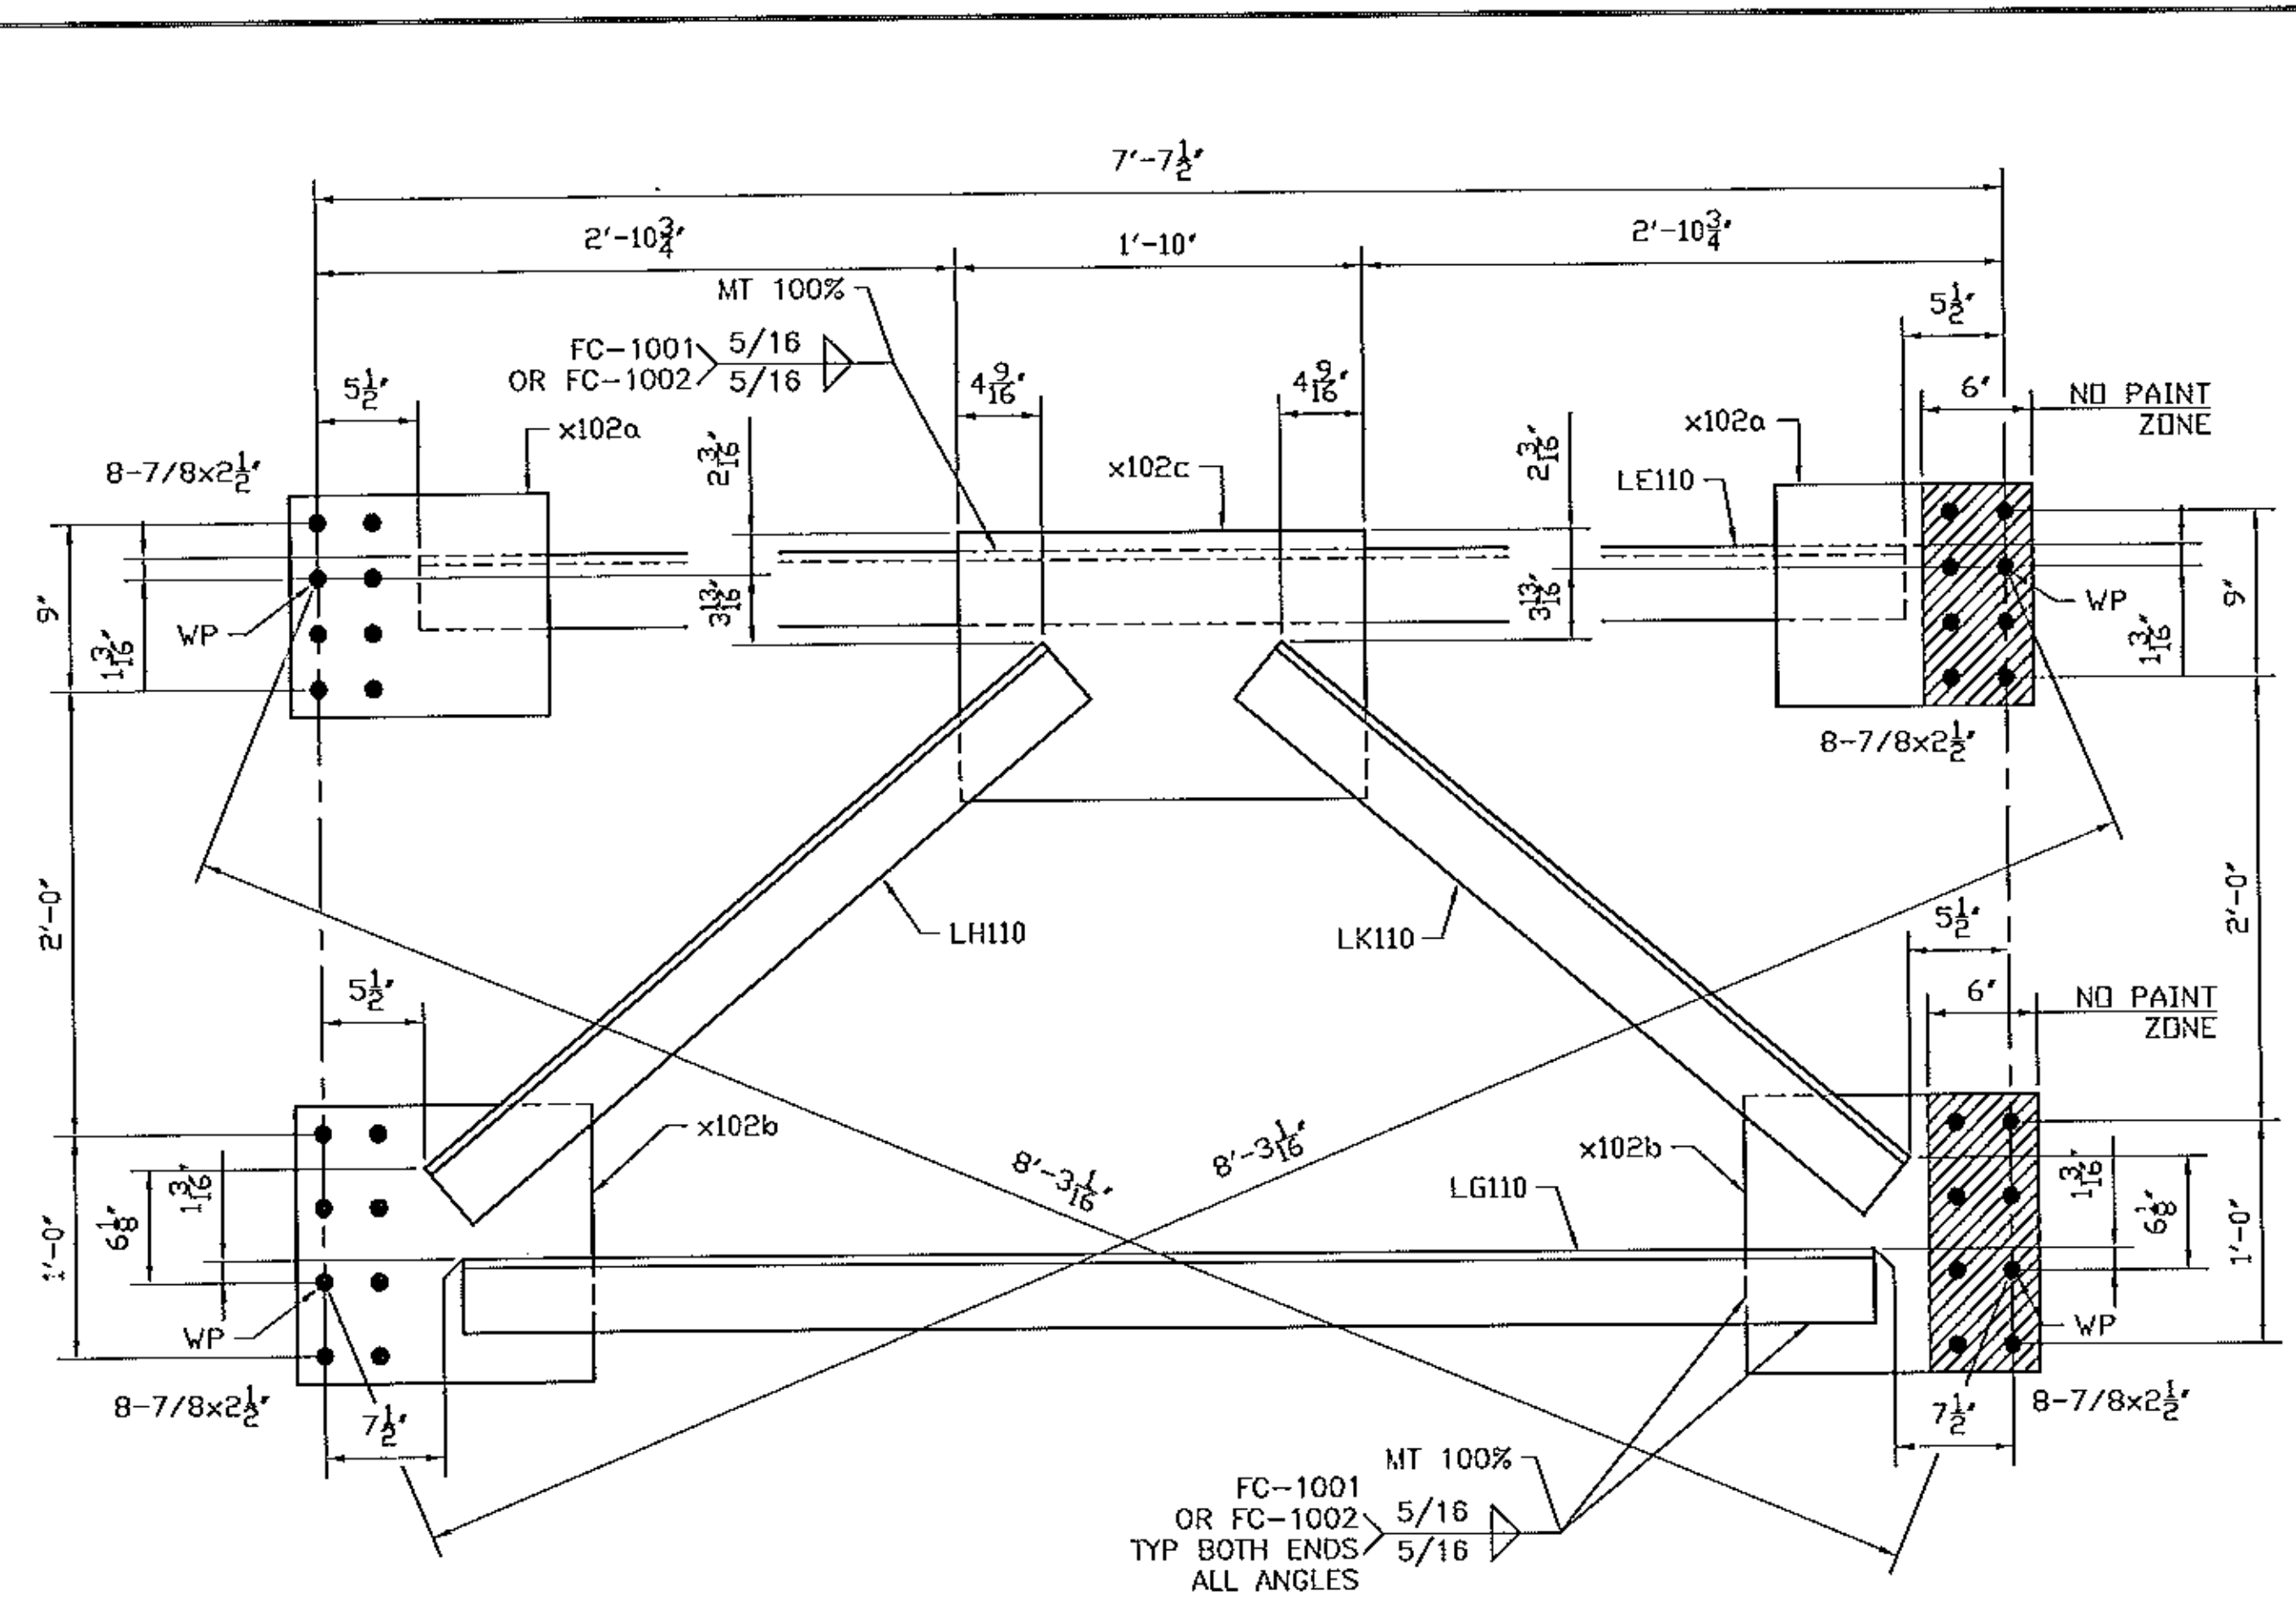

ONE - CROSS FRAME 110CF2  
PAINTED

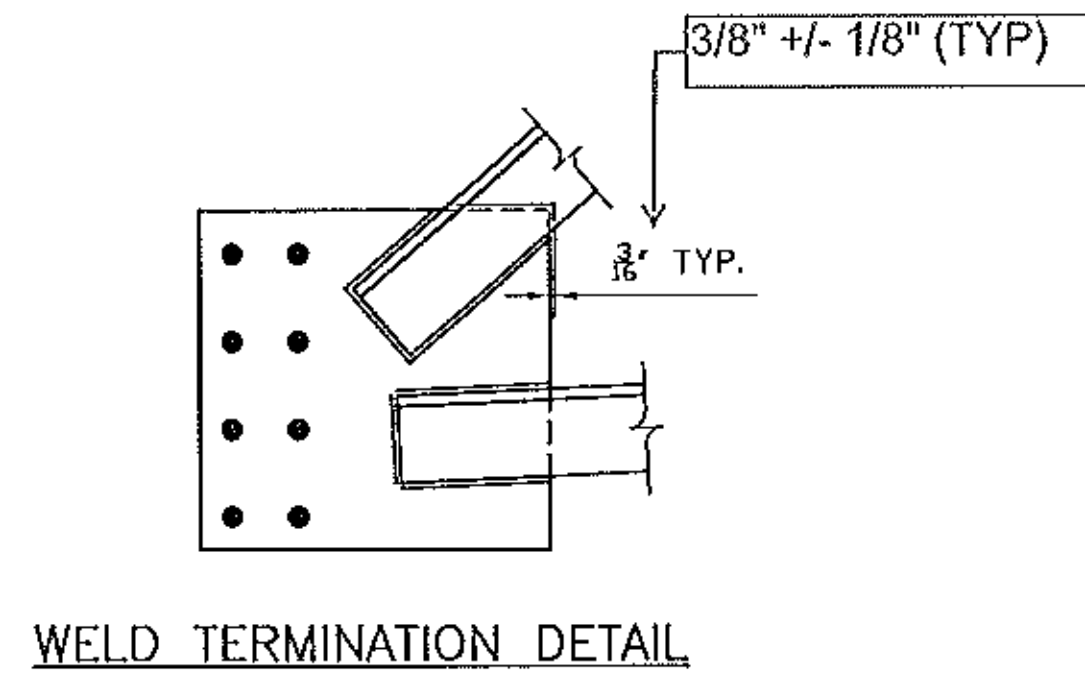

BILL OF MATERIAL									
Mark	Qty.	Description	SI	Length	Remark	ABM	Total	Seq	Qty
			Grd				Weight		/Seq
▲ 110CF1	ONE	CROSS FRAME				423	449	1	
▲ 110CF2	ONE	CROSS FRAME				423	449	1	
▲ LA110	1	L4x4x1/2	A70950W	6-8 3/8		105-1	86		
▲ LB110	1	L4x4x1/2	A70950W	6-4 9/16		105-5	82		
▲ LC110	1	L4x4x1/2	A70950W	3-8 7/8		105-5	48		
▲ LD110	1	L4x4x1/2	A70950W	3-7		105-7	46		
▲ x102a	2	PL1/2x12	A70950W	1-2		105-7	48		
▲ x102b	2	PL1/2x15	A70950W	1-4		105-7	68		
▲ x102c	1	PL1/2x14 1/2	A70950W	1-10		105-9	45		
▲ FB		FIELD BOLTS							
▲ 78F212	32	.7/8 Dia A325 TYP3		2 1/2	1FL WASH				
▲ LE110	1	L4x4x1/2	A70950W	6-8 1/2		105-1	86		
▲ LG110	1	L4x4x1/2	A70950W	6-4 1/2		105-5	82		
▲ LH110	1	L4x4x1/2	A70950W	3-7 15/16		105-5	47		
▲ LK110	1	L4x4x1/2	A70950W	3-7 15/16		105-7	47		
▲ x102a	2	PL1/2x12	A70950W	1-2		105-7	48		
▲ x102b	2	PL1/2x15	A70950W	1-4		105-7	68		
▲ x102c	1	PL1/2x14 1/2	A70950W	1-10		105-9	45		
▲ FB		FIELD BOLTS							
▲ 78F212	32	.7/8 Dia A325 TYP3		2 1/2	1FL WASH				

GENERAL NOTES: SEE GN100  
HOLES: 15/16 (U.N.)  
CLEANING AND PAINTING: SEE SHEET P100 AND P101

See standard specification 506.24(a)(9), no payment will be made for bolts, nuts, washers, they are considered to be incidental

Vermont Agency of Transportation  
**RECEIVED**  
CK'D BY M.E.M. OK'D BY C.W.M.  
July 09, 2012  
RESUBMIT APPROVED AS NOTED  
BY C. CARLSON DATE 07-27-2012

FOR APPROVAL	07/06/12	BR	EG
REVISION	DATE	PAR	VER.

NOTE: BOLT 1 WASHER: 1 WASHER UNDER NUT U.N.  
BOLT 2 WASHER: 1 WASHER UNDER HEAD U.N.  
1 WASHER UNDER HEAD U.N.






PROJECT: VT RT 9, BRIDGE NO. 11  
TOWN OF WOODFORD, VT  
OVER WALDOMSAC RIVER

TITLE: CROSS FRAME

REFERENCE: PROJECT NO. ER BHF 010-1 (44)

DESIGN BY: BR	DATE: JULY 2012	CONTRACT NO: UN04260
DRAWN BY: GG	DATE: JULY 2012	REVISION NO: 110 A



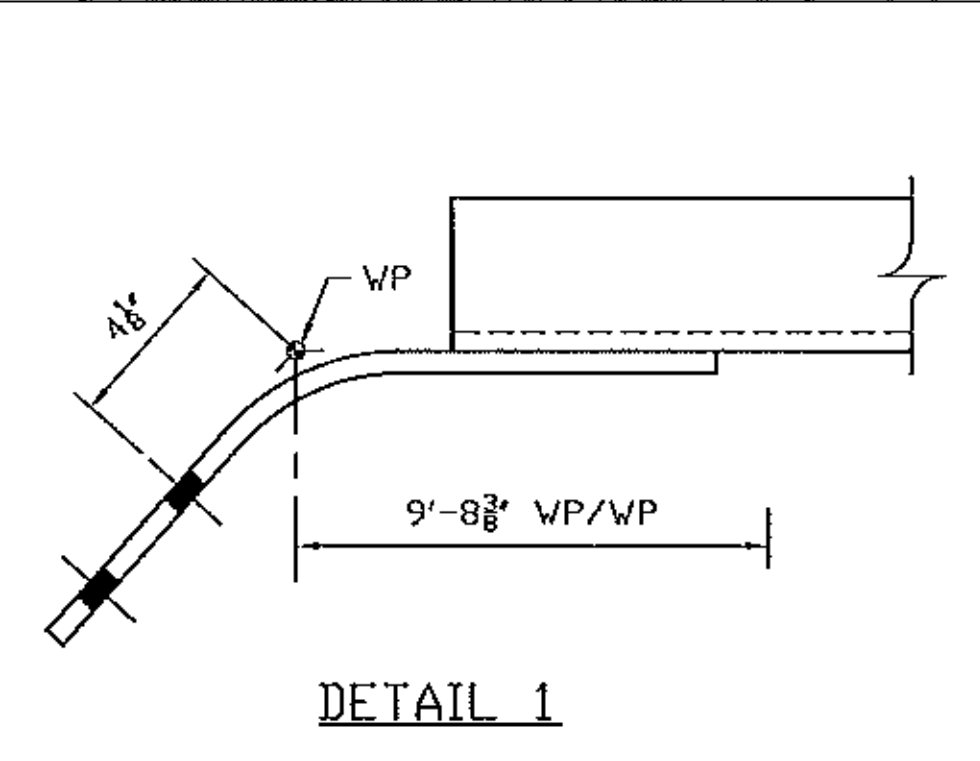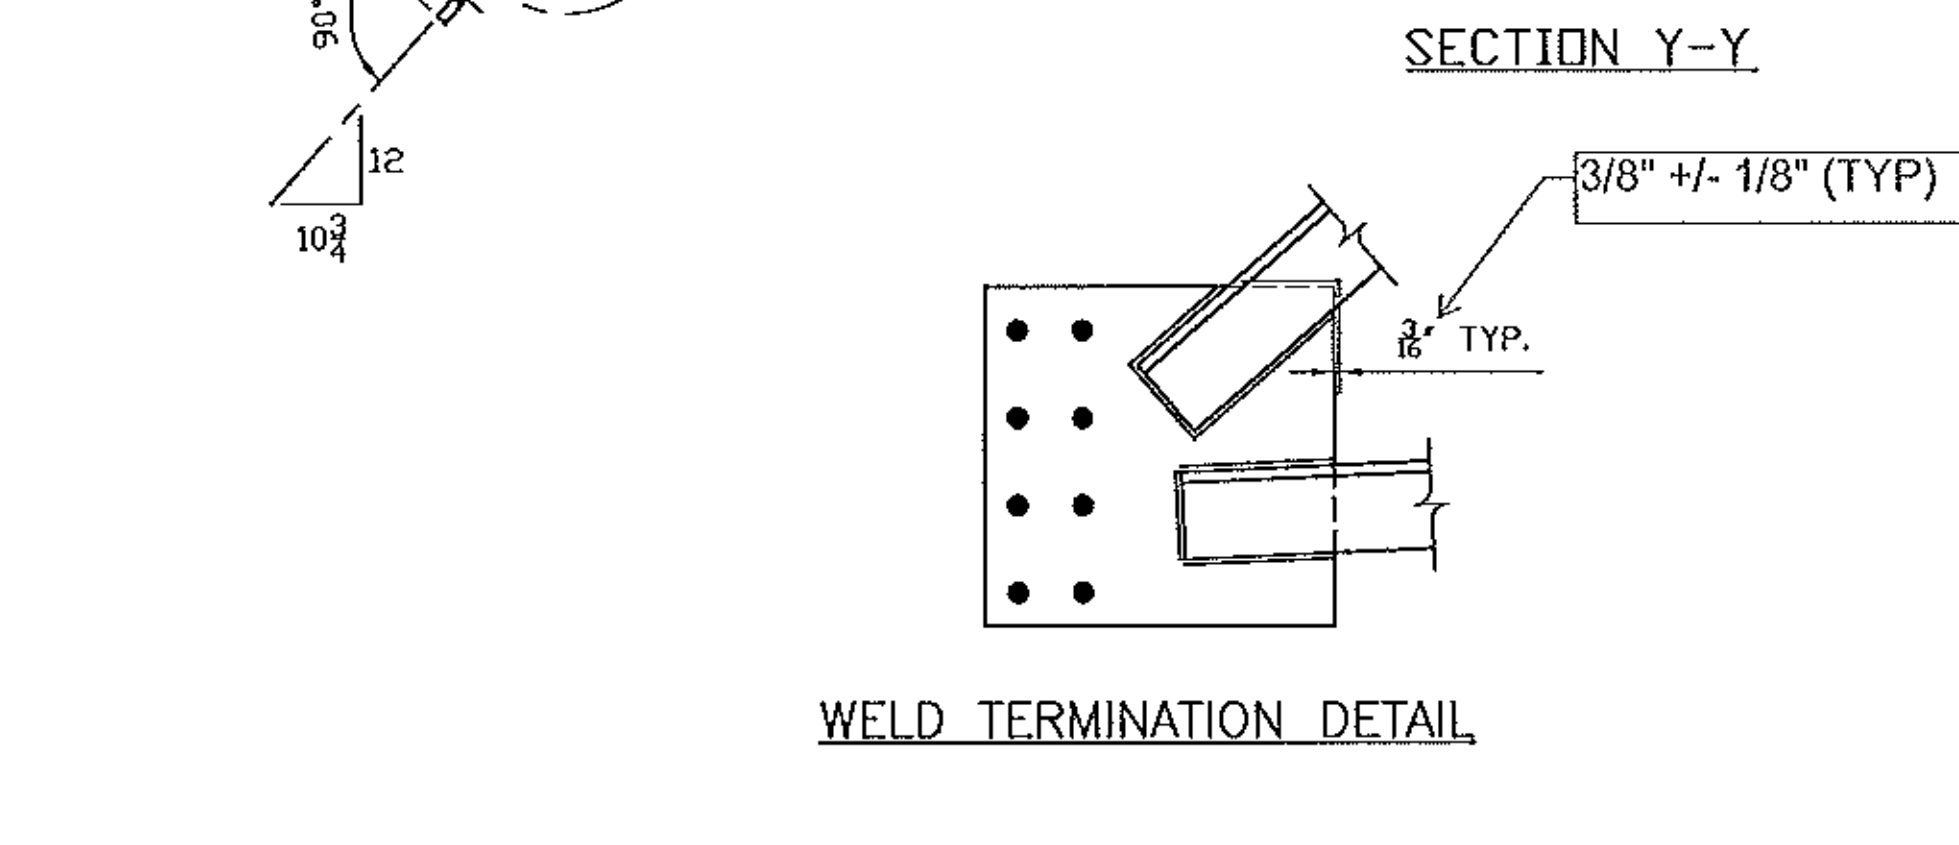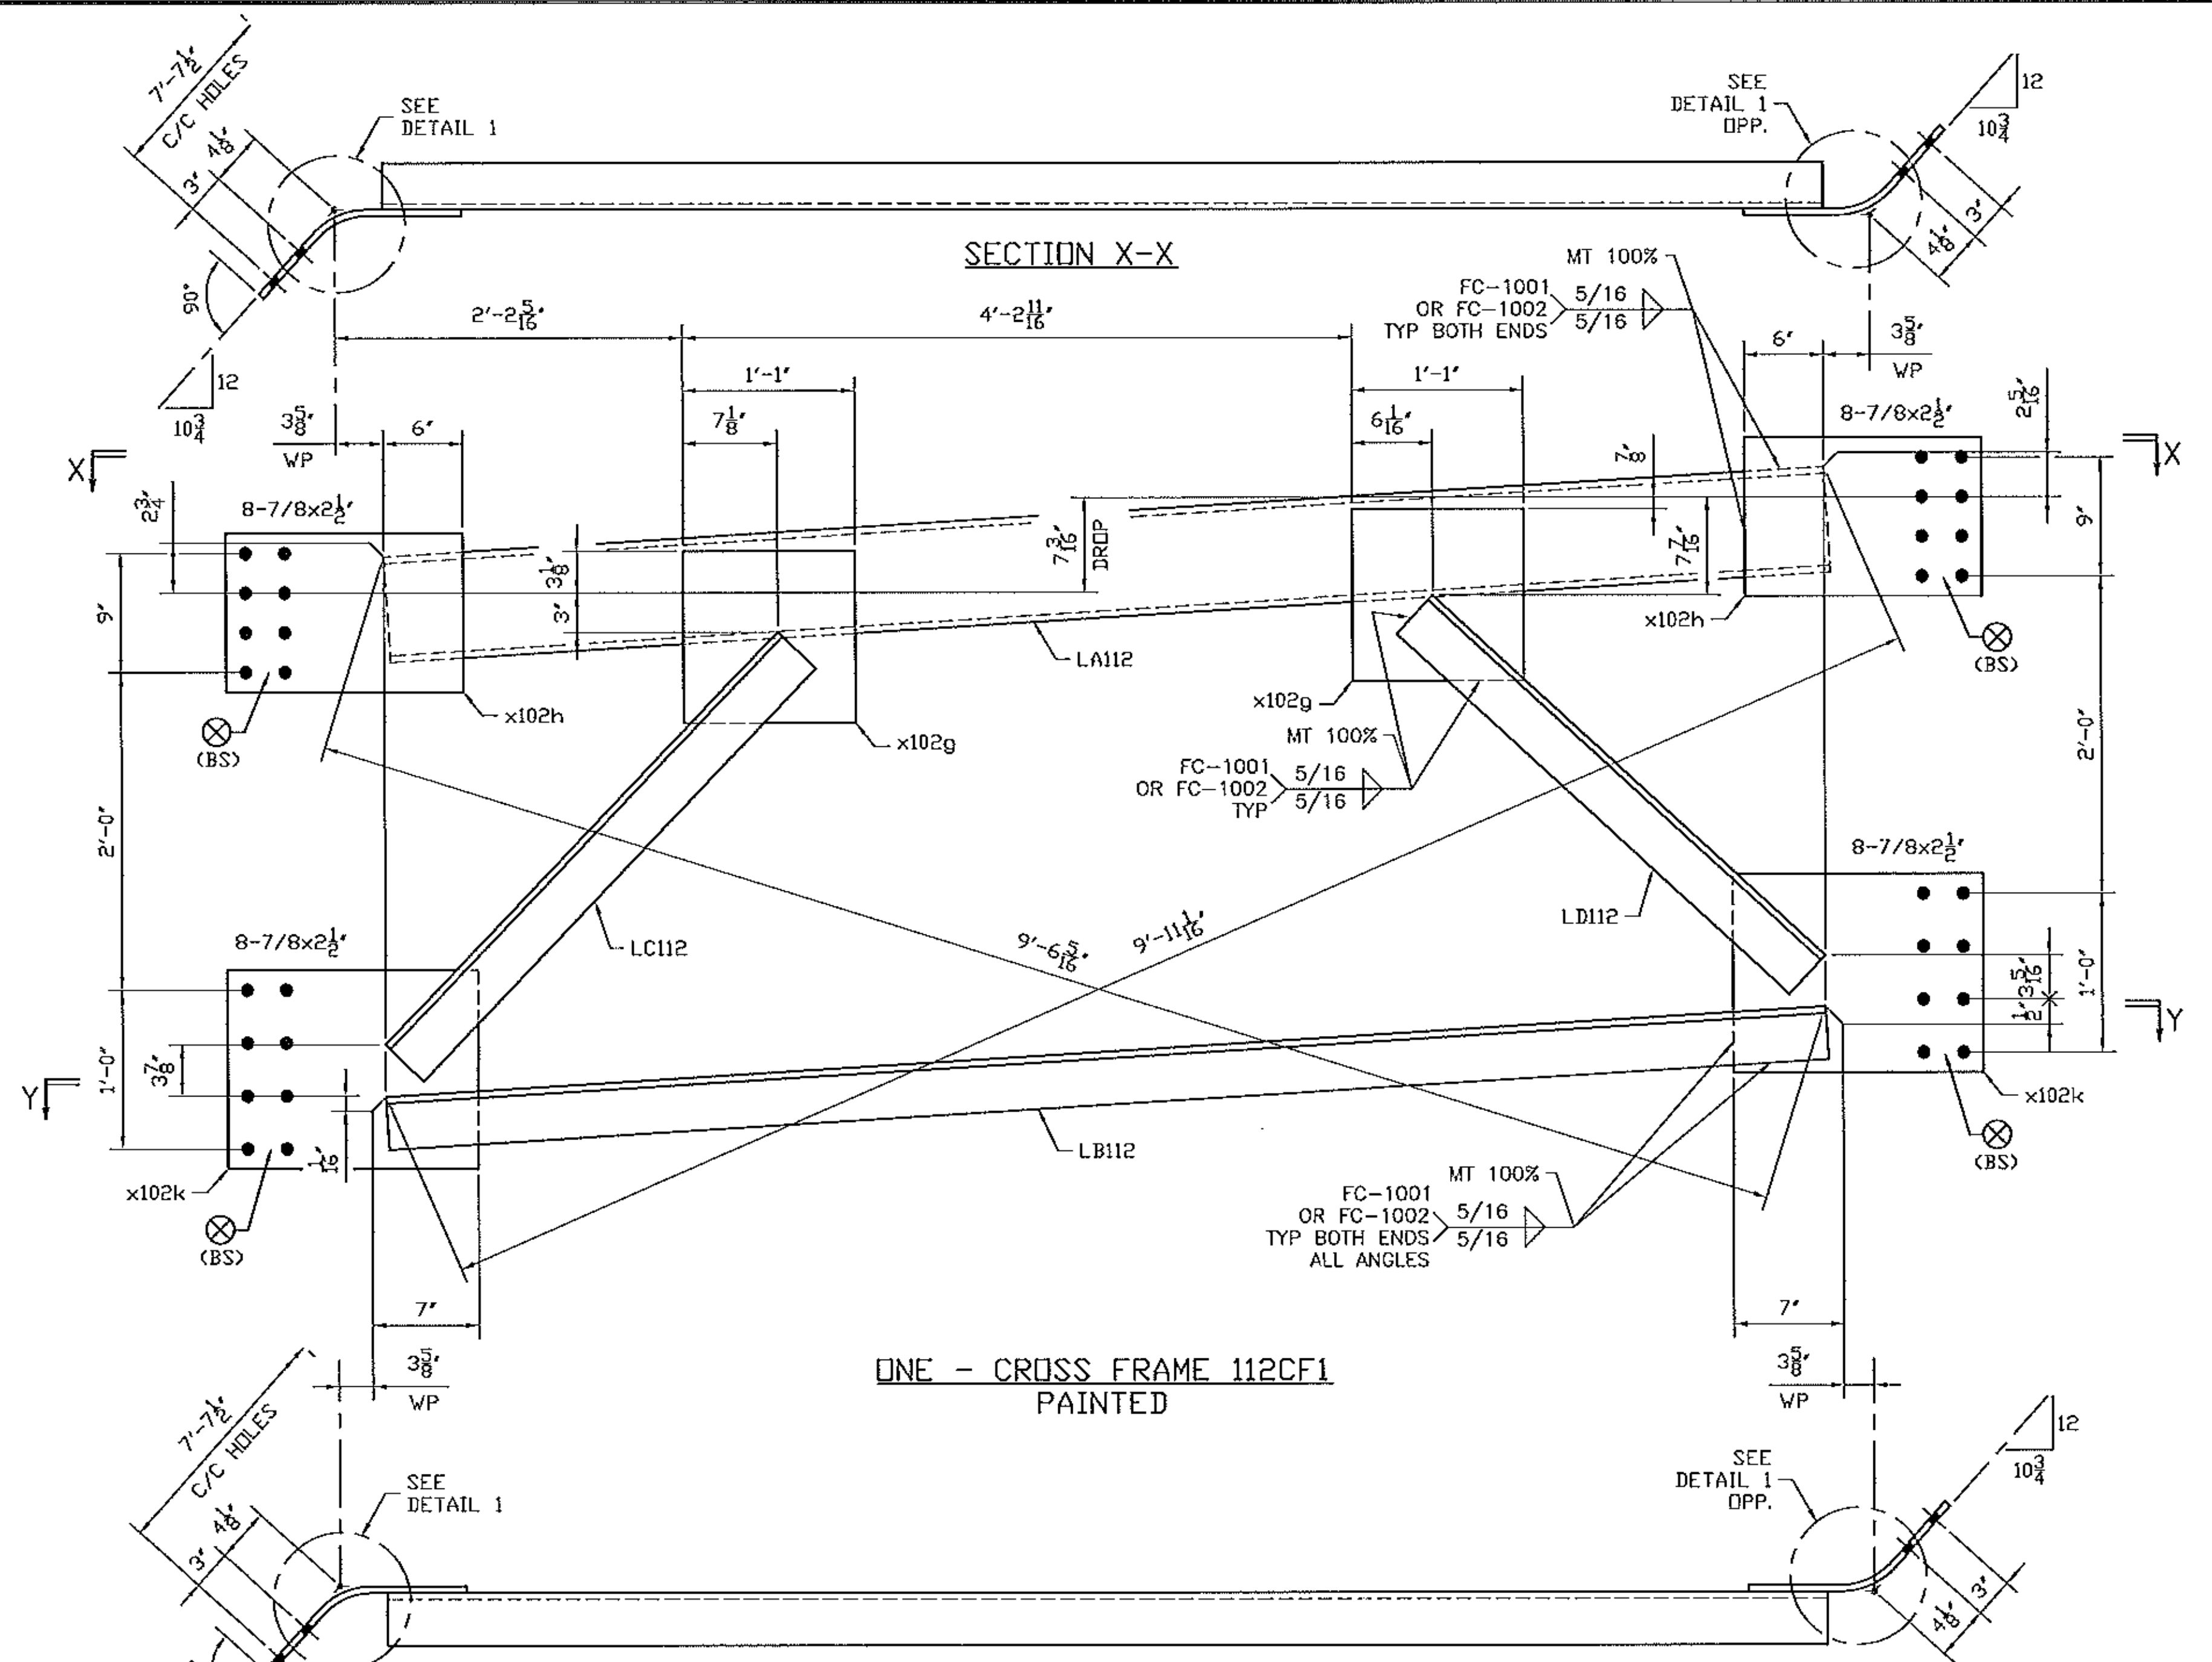

ONE - CROSS FRAME 112CF1  
PAINTED

GENERAL NOTES: SEE GN100  
HOLES: 15/16 (U.N.)  
CLEANING AND PAINTING: SEE SHEET P100 AND P101

See standard specification 506.24(a)(9), no payment will be made for bolts, nuts, washers, they are considered to be incidental

BILL OF MATERIAL									
Mark	Qty.	Description	SI	Length	Remark	ABM	Total Weight	Seq	Qty /Seq
▲ 112CF1	ONE	CROSS FRAME				602	628	1	1
▲ 112CF1	1	CROSS FRAME		10-7 7/8	PAINT				
▲ LA112	1	MC8x22.8	A70950W	9-1 3/8		104-1	208		
▲ LB112	1	L4x4x1/2	A70950W	9-1 3/8		104-2	117		
▲ LC112	1	L4x4x1/2	A70950W	3-7 3/16		104-3	46		
▲ LD112	1	L4x4x1/2	A70950W	3-4 1/4		104-3	43		
▲ x102g	2	PL1/2x13	A70950W	1-1		104-5	48		
▲ x102h	2	PL1/2x12	A70950W	1-5 3/4	BENT	104-4	60		
▲ x102k	2	PL1/2x15	A70950W	1-6 3/4	BENT	104-4	80		
▲ FB		FIELD BOLTS							
▲ 78F212	32	7/8 Dia A325 TYP3		2 1/2	1FL WASH				

Vermont Agency of Transportation  
**RECEIVED**  
CK'D BY M.E.M. OK'D BY C.W.M.  
July 09, 2012  
RESUBMIT APPROVED AS NOTED  
BY C. CARLSON DATE 07-27-2012

No	FOR APPROVAL REVISION	DATE	BR	EG

NOTE: BOLT 1 WASHER: 1 WASHER UNDER NUT U.N.  
BOLT 2 WASHER: 1 WASHER UNDER HEAD U.N.  
1 WASHER UNDER HEAD U.N.





**STRUCTAL**  
Bridges  
366 River Road, Claremont, NH 03743  
Tel (603) 542-5202 Fax (603) 542-5312  
a division of CANAM

PROJECT: VT RT 9, BRIDGE NO. 11  
TOWN OF WOODFORD, VT  
OVER WALDOOMSAC RIVER

TITLE: ABUTMENT CROSS FRAME

REFERENCE: PROJECT NO. ER BHF 010-1 (44)

REVISED BY	DATE	CONTRACT NO.
BR	JULY 2012	UN04260
GG	JULY 2012	112/A

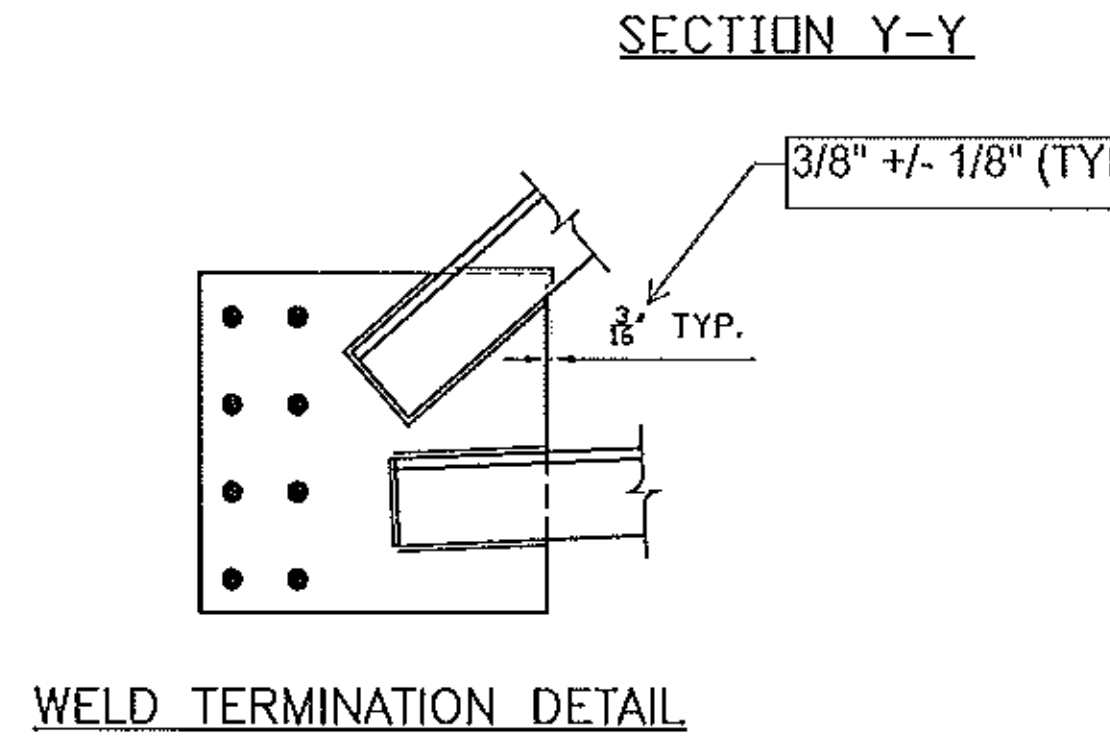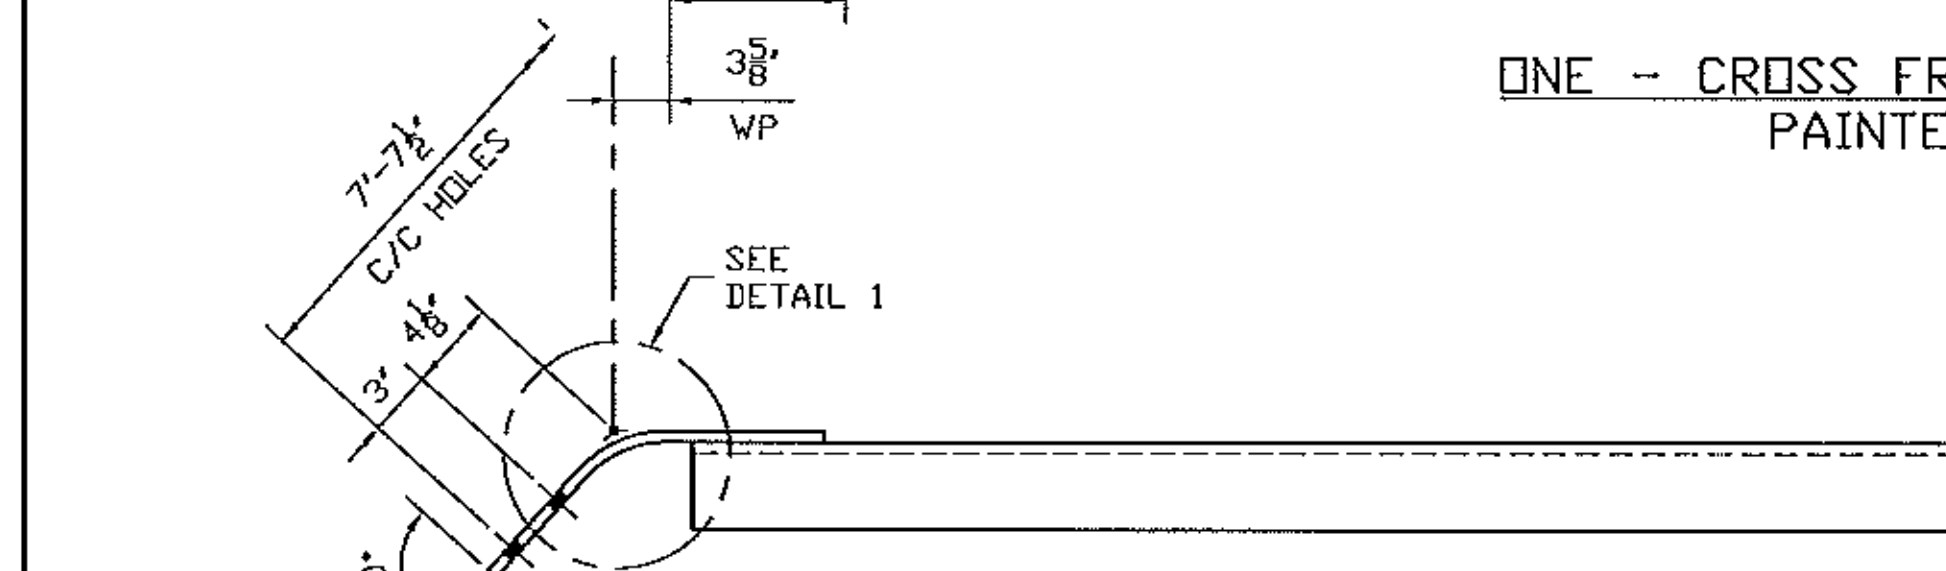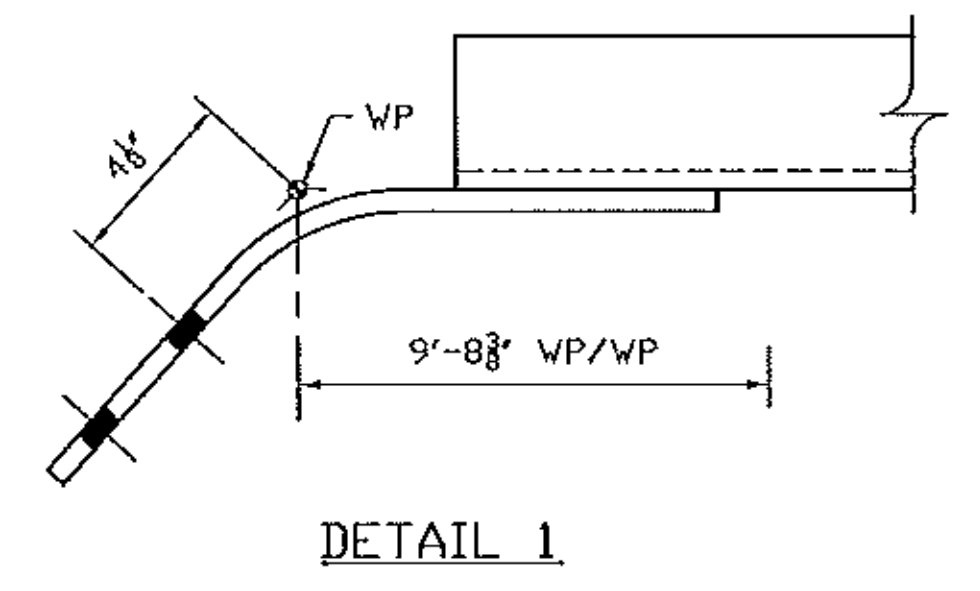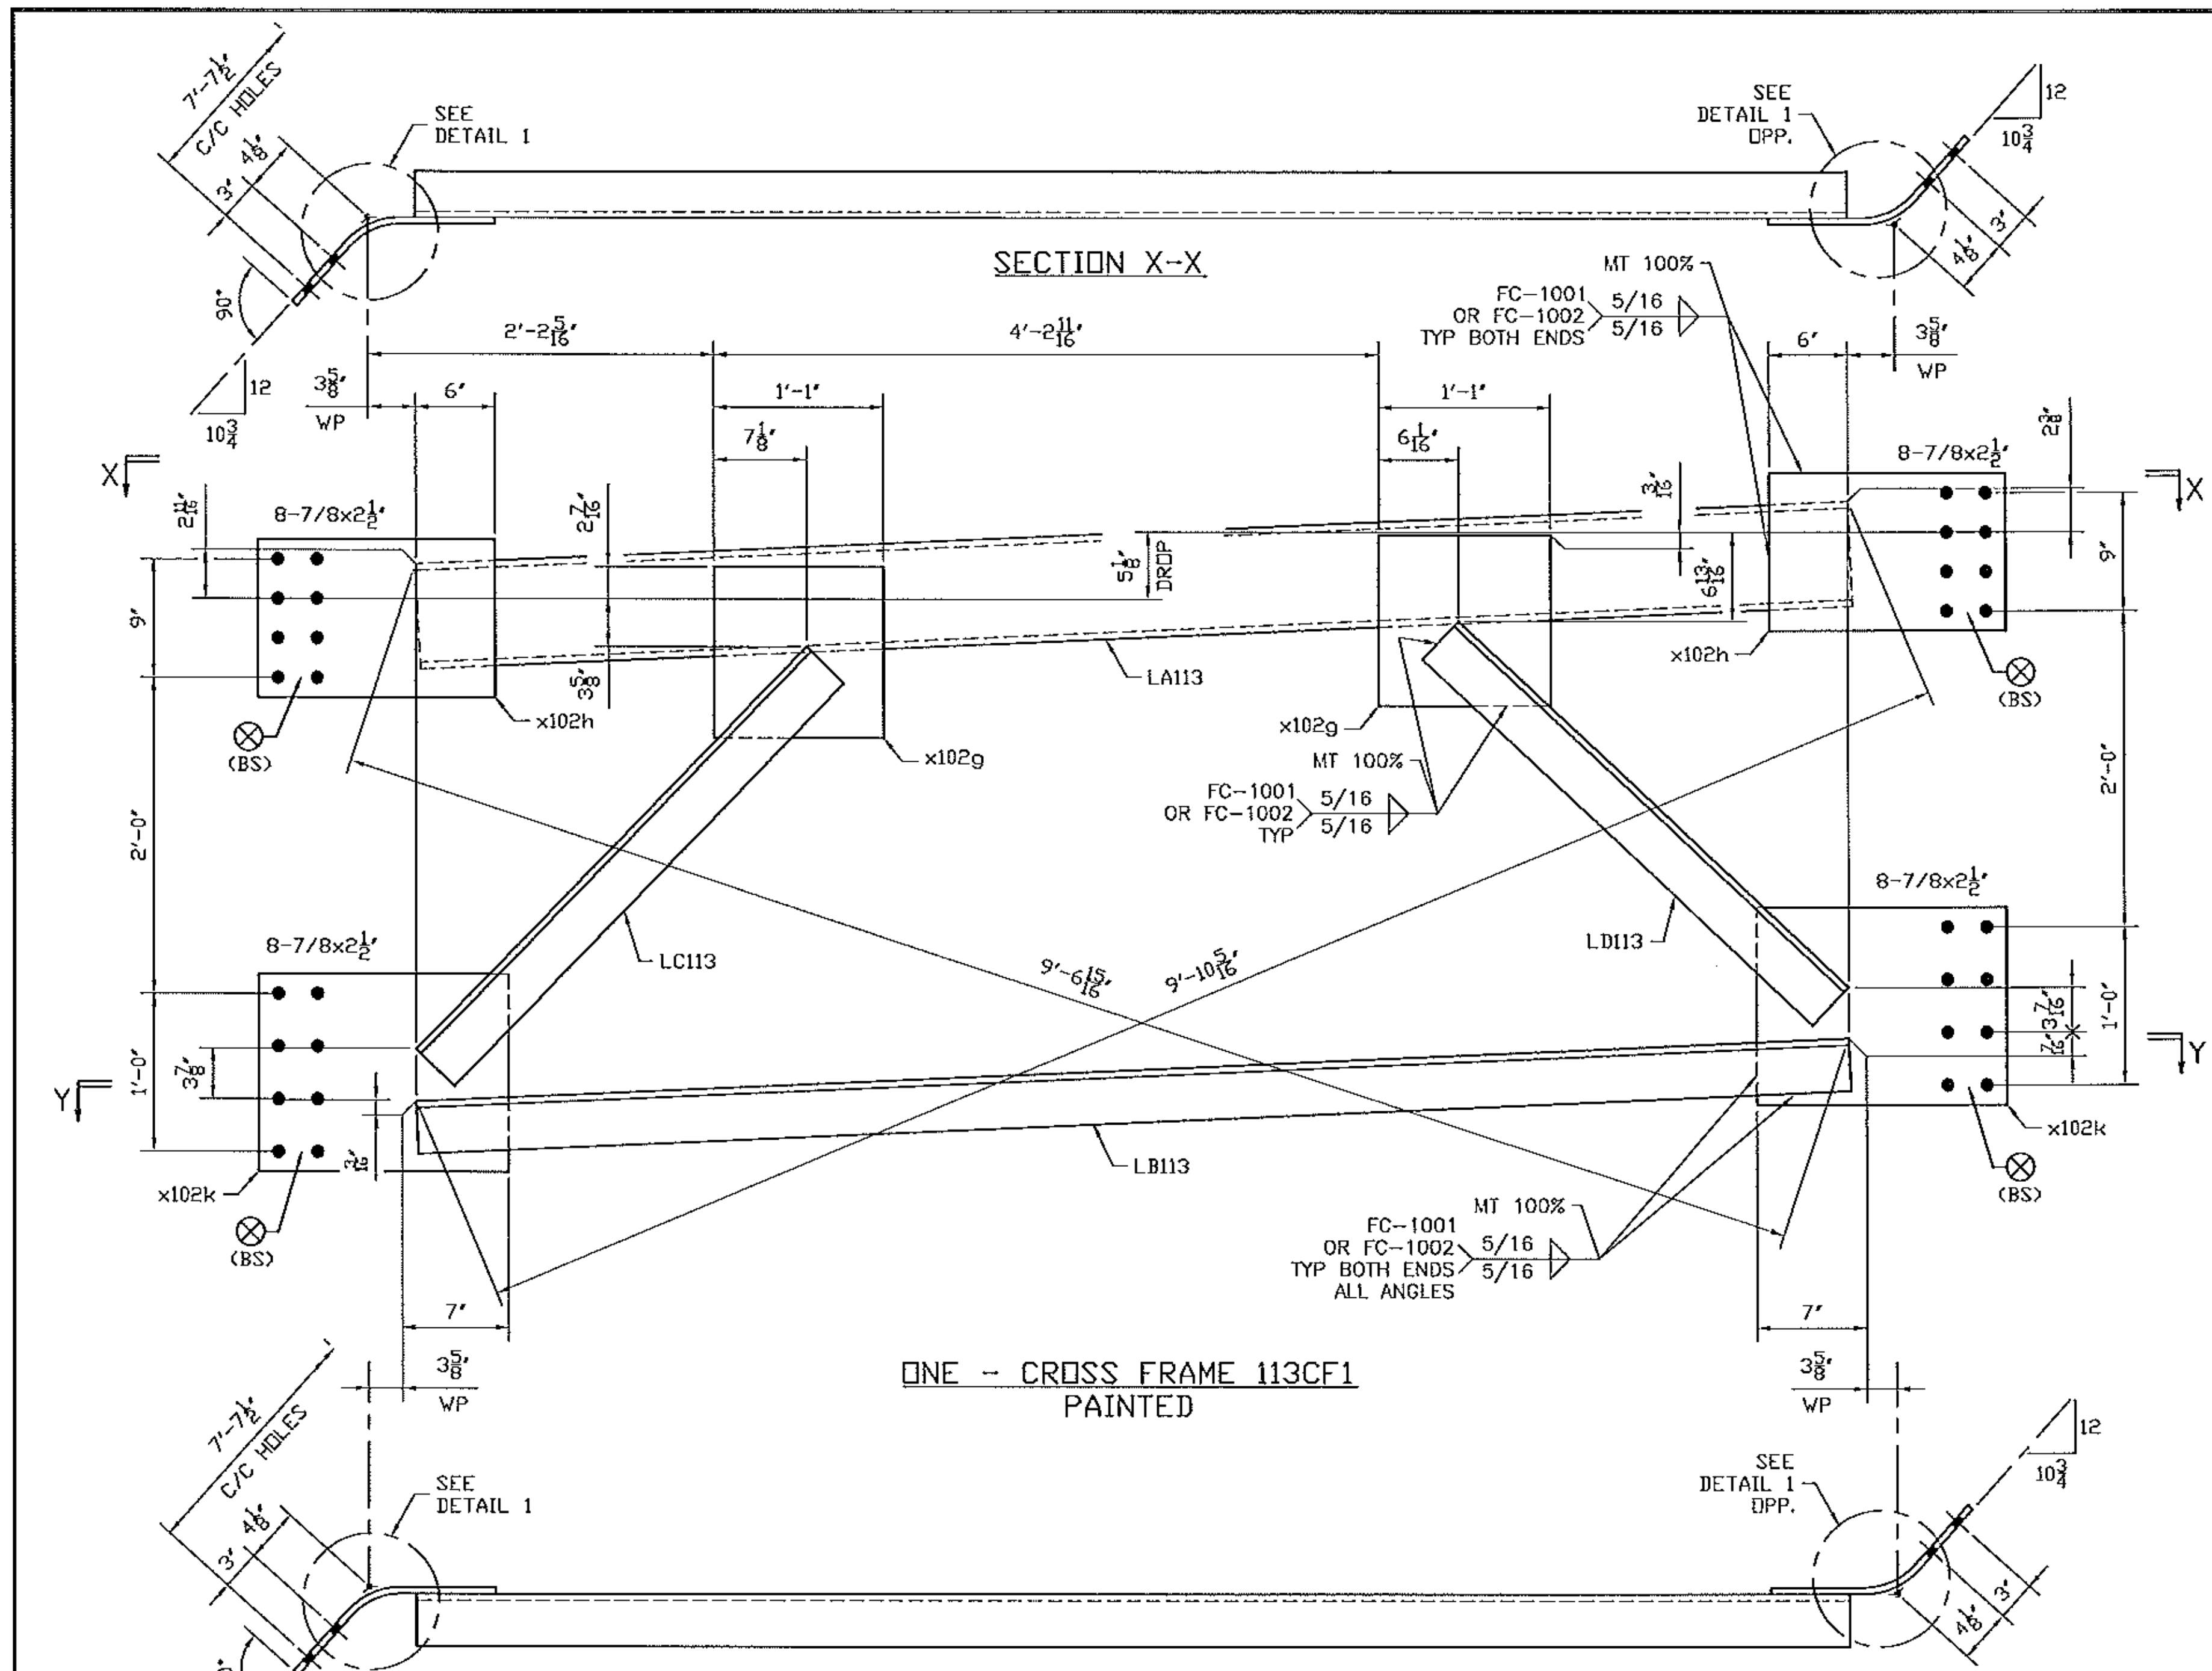

GENERAL NOTES: SEE GN100  
 HOLES: 15/16 (U.N.)  
 CLEANING AND PAINTING: SEE SHEET P100 AND P101

See standard specification 506.24(a)(9), no payment will be made for bolts, nuts, washers, they are considered to be incidental

BILL OF MATERIAL									
Mark	Qty.	Description	Std	Length	Remark	ABM	Total	Seq	Qty
			Grd				Weight		/Seq
▲	ONE	CROSS FRAME				602	628	1	
▲	1	CROSS FRAME		10-7 7/8	PAINT				
▲	1	MC8x22.8	A70950W	9-1 1/4		104-1	208		
▲	1	L4x4x1/2	A70950W	9-1 1/4		104-2	117		
▲	1	L4x4x1/2	A70950W	3-6 3/4		104-3	46		
▲	1	L4x4x1/2	A70950W	3-4 5/8		104-3	43		
▲	2	PL1/2x13	A70950W	1-1		104-5	48		
▲	2	PL1/2x12	A70950W	1-5 3/4	BENT	104-4	60		
▲	2	PL1/2x15	A70950W	1-6 3/4	BENT	104-4	80		
▲		FIELD BOLTS							
▲	32	.7/8 Dia A325 TYP3		2 1/2	1FL WASH				

No	REVISION	DATE	PAR	VER.
		07/06/12	BR	EG

NOTE: BOLT 1 WASHER: 1 WASHER UNDER NUT U.N.  
 BOLT 2 WASHER: 1 WASHER UNDER HEAD U.N.  
 1 WASHER UNDER HEAD U.N.

**STRUCTAL**  
 Bridges  
 386 River Road, Clarendon, VT 05743  
 Tel: (603) 542-5202 Fax: (603) 542-5312  
 a division of CANAM


PROJECT: VT RT 9, BRIDGE NO. 11  
 TOWN OF WOODFORD, VT  
 OVER WALDOMSAC RIVER

TITLE: ABUTMENT CROSS FRAME

REFERENCE: PROJECT NO. ER BHF 010-1 (44)

NOV. BY	DATE	CONTRACT NO.
BR	JULY 2012	UN04260
DESIGNED BY	DATE	REVISION
GG	JULY 2012	113 A

Vermont Agency of Transportation  
**RECEIVED**  
 CK'D BY M.E.M. OK'D BY C.W.M.  
 July 09, 2012  
 RESUBMIT APPROVED AS NOTED  
 BY C. CARLSON DATE 07-27-2012

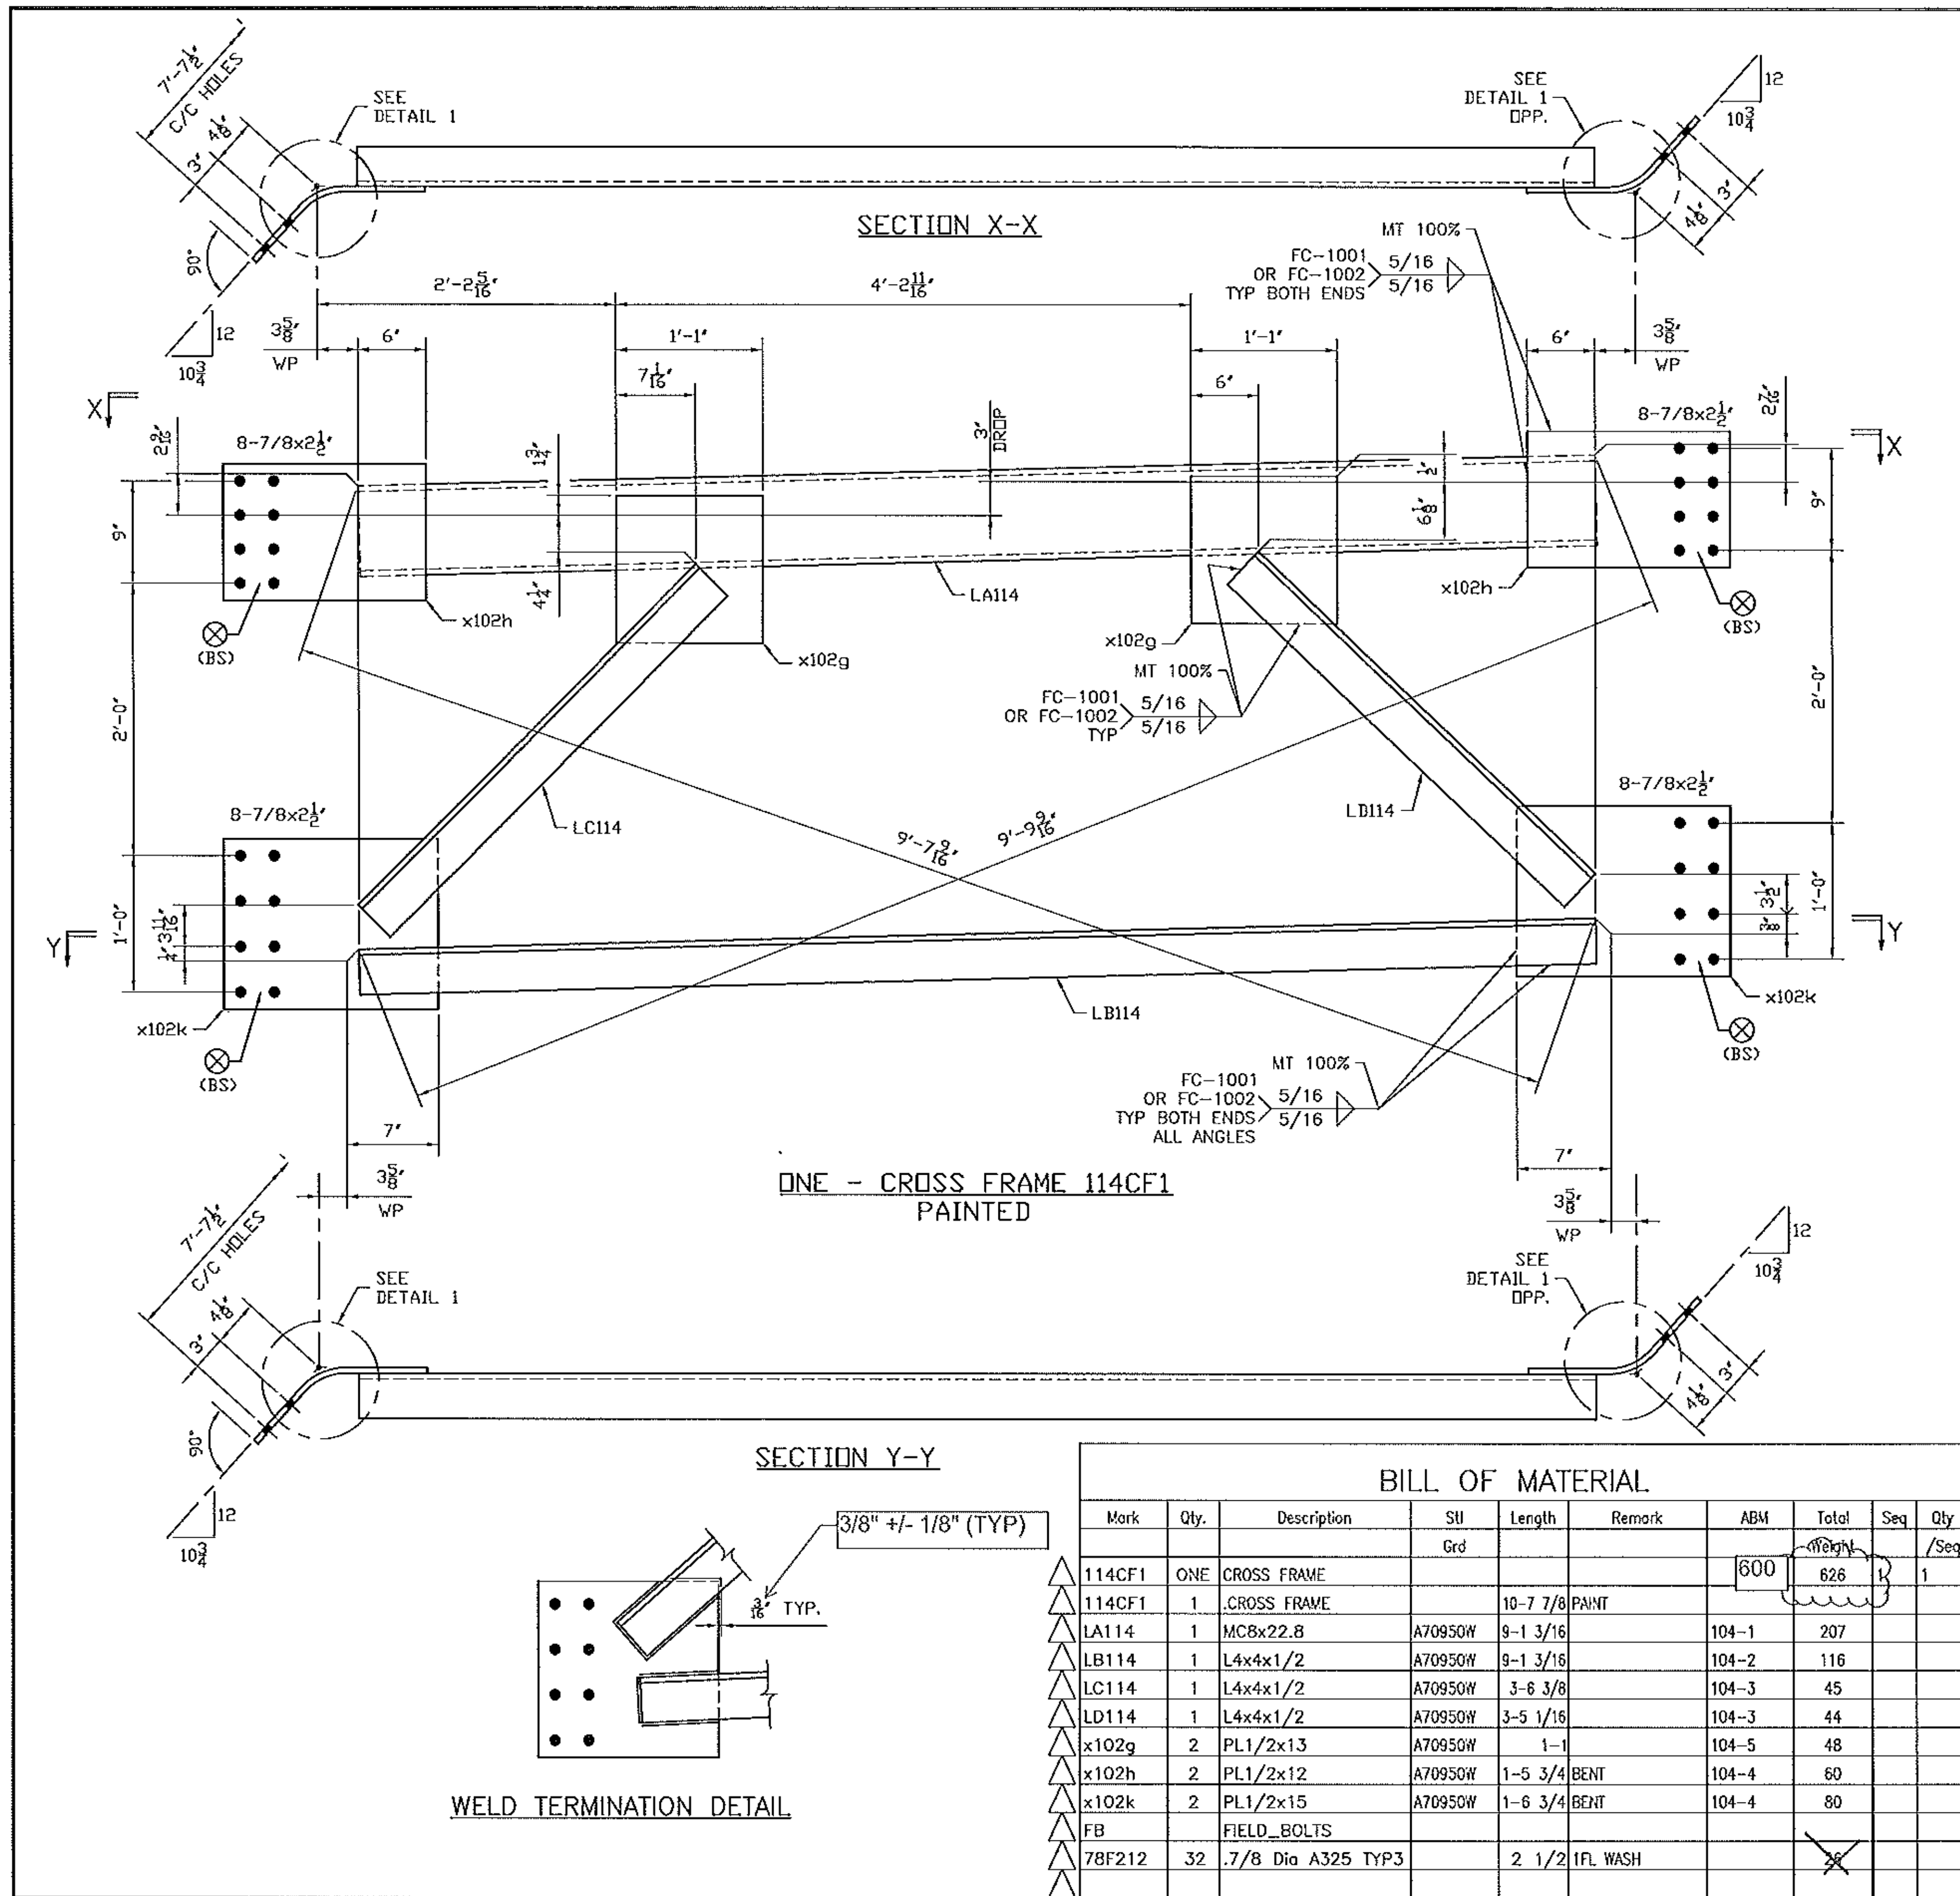

GENERAL NOTES: SEE GN100  
 HOLES: 15/16 (UN)  
 CLEANING AND PAINTING SEE SHEET P100 AND P101

See standard specification 506.24(a)(9), no payment will be made for bolts, nuts, washers, they are considered to be incidental

BILL OF MATERIAL

Mark	Qty.	Description	SI	Length	Remark	ABM	Total	Seq	Qty
114CF1	ONE	CROSS FRAME	Grd			600	626		1
114CF1	1	CROSS FRAME		10-7 7/8	PAINT				
LA114	1	MC8x22.8	A70950W	9-1 3/16		104-1	207		
LB114	1	L4x4x1/2	A70950W	9-1 3/16		104-2	116		
LC114	1	L4x4x1/2	A70950W	3-6 3/8		104-3	45		
LD114	1	L4x4x1/2	A70950W	3-5 1/16		104-3	44		
x102g	2	PL1/2x13	A70950W	1-1		104-5	48		
x102h	2	PL1/2x12	A70950W	1-5 3/4	BENT	104-4	60		
x102k	2	PL1/2x15	A70950W	1-6 3/4	BENT	104-4	80		
FB		FIELD BOLTS							
78F212	32	.7/8 Dia A325 TYP3		2 1/2	IFL WASH				

No	REVISION	DATE	PAR	VER.

NOTE: BOLT 1 WASHER: 1 WASHER UNDER NUT U.N.  
 BOLT 2 WASHER: 1 WASHER UNDER HEAD U.N.  
 1 WASHER UNDER HEAD U.N.

**STRUCTAL**  
 Bridges  
 386 River Road, Claremont,  
 NH 03743  
 Tel: (603) 542-5202 Fax: (603) 542-5312  
 a division of **CANAM**




PROJECT: VT RT 9, BRIDGE NO. 11  
 TOWN OF WOODFORD, VT  
 OVER WALDOOMSAC RIVER

TITLE: ABUTMENT CROSS FRAME

REFERENCE: PROJECT NO. ER BHF 010-1 (44)

DATE	BY	DATE	BY	PROJECT NO.
	BR	JULY 2012		UN04260
	GG	JULY 2012		114 A

Vermont Agency of Transportation  
**RECEIVED**  
 CK'D BY M.E.M. OK'D BY C.W.M.  
 July 09, 2012  
 RESUBMIT APPROVED AS NOTED  
 BY C. CARLSON DATE 07-27-2012

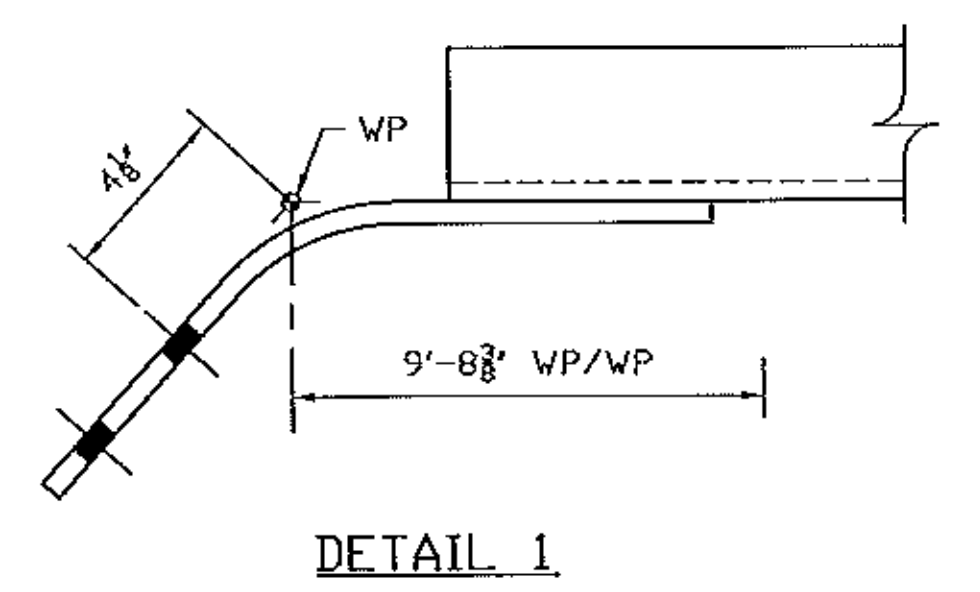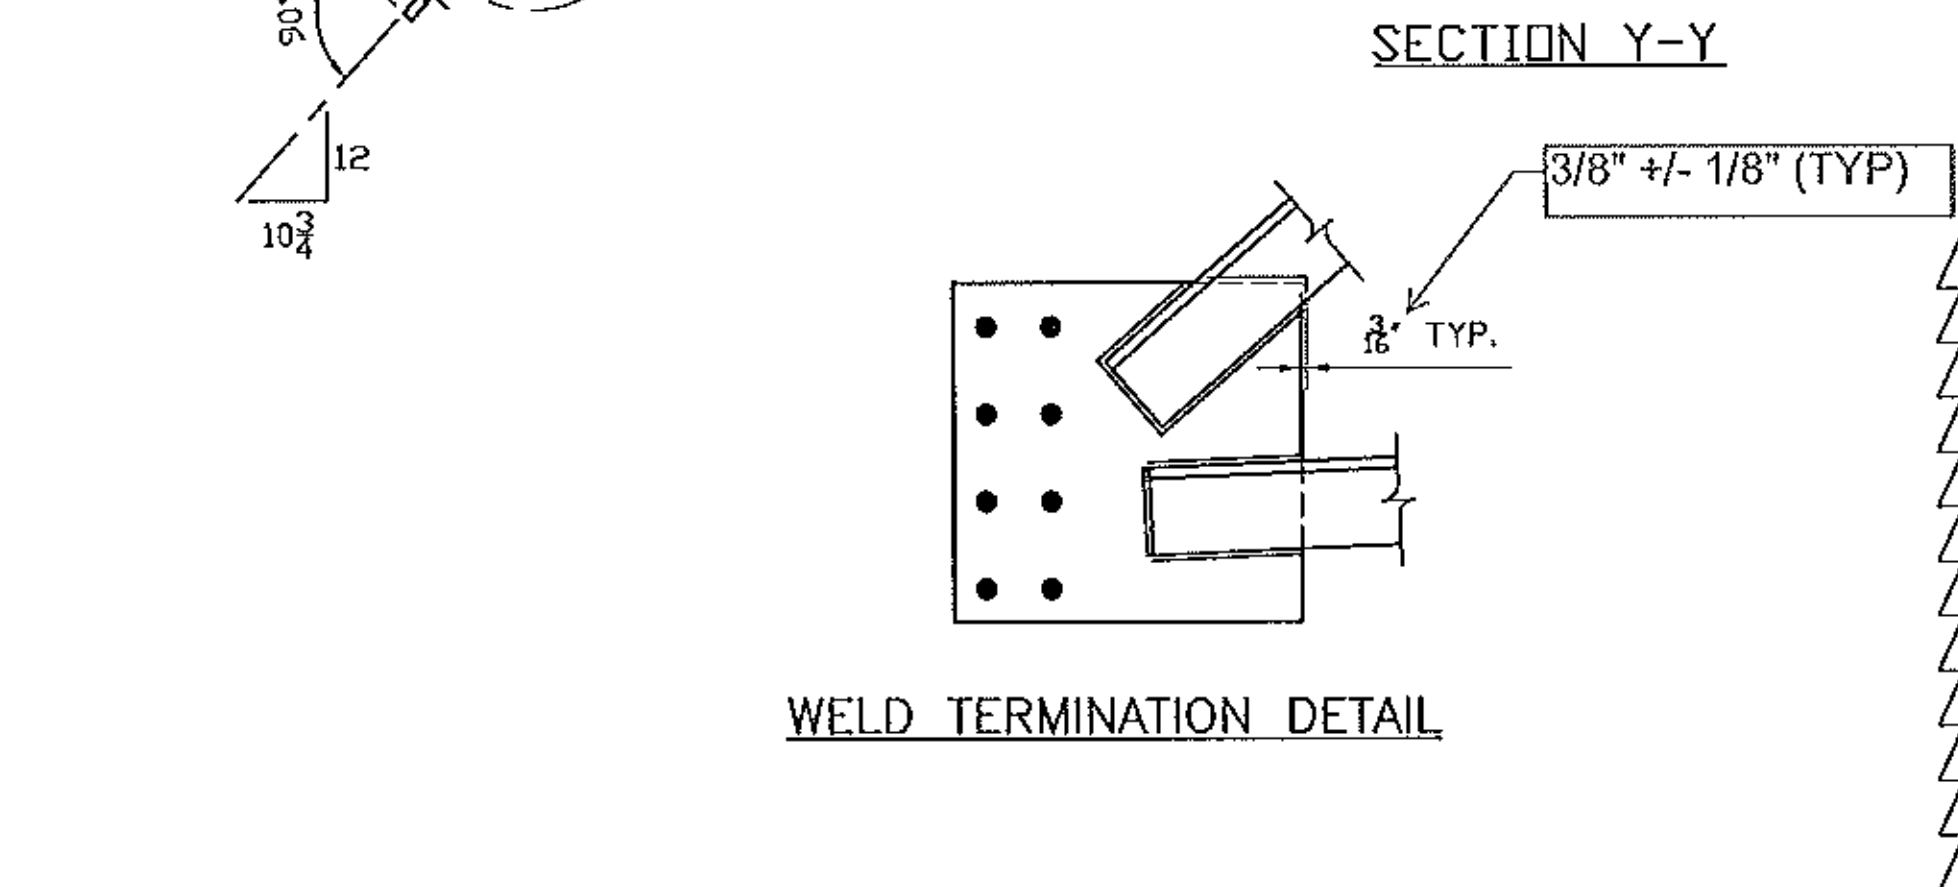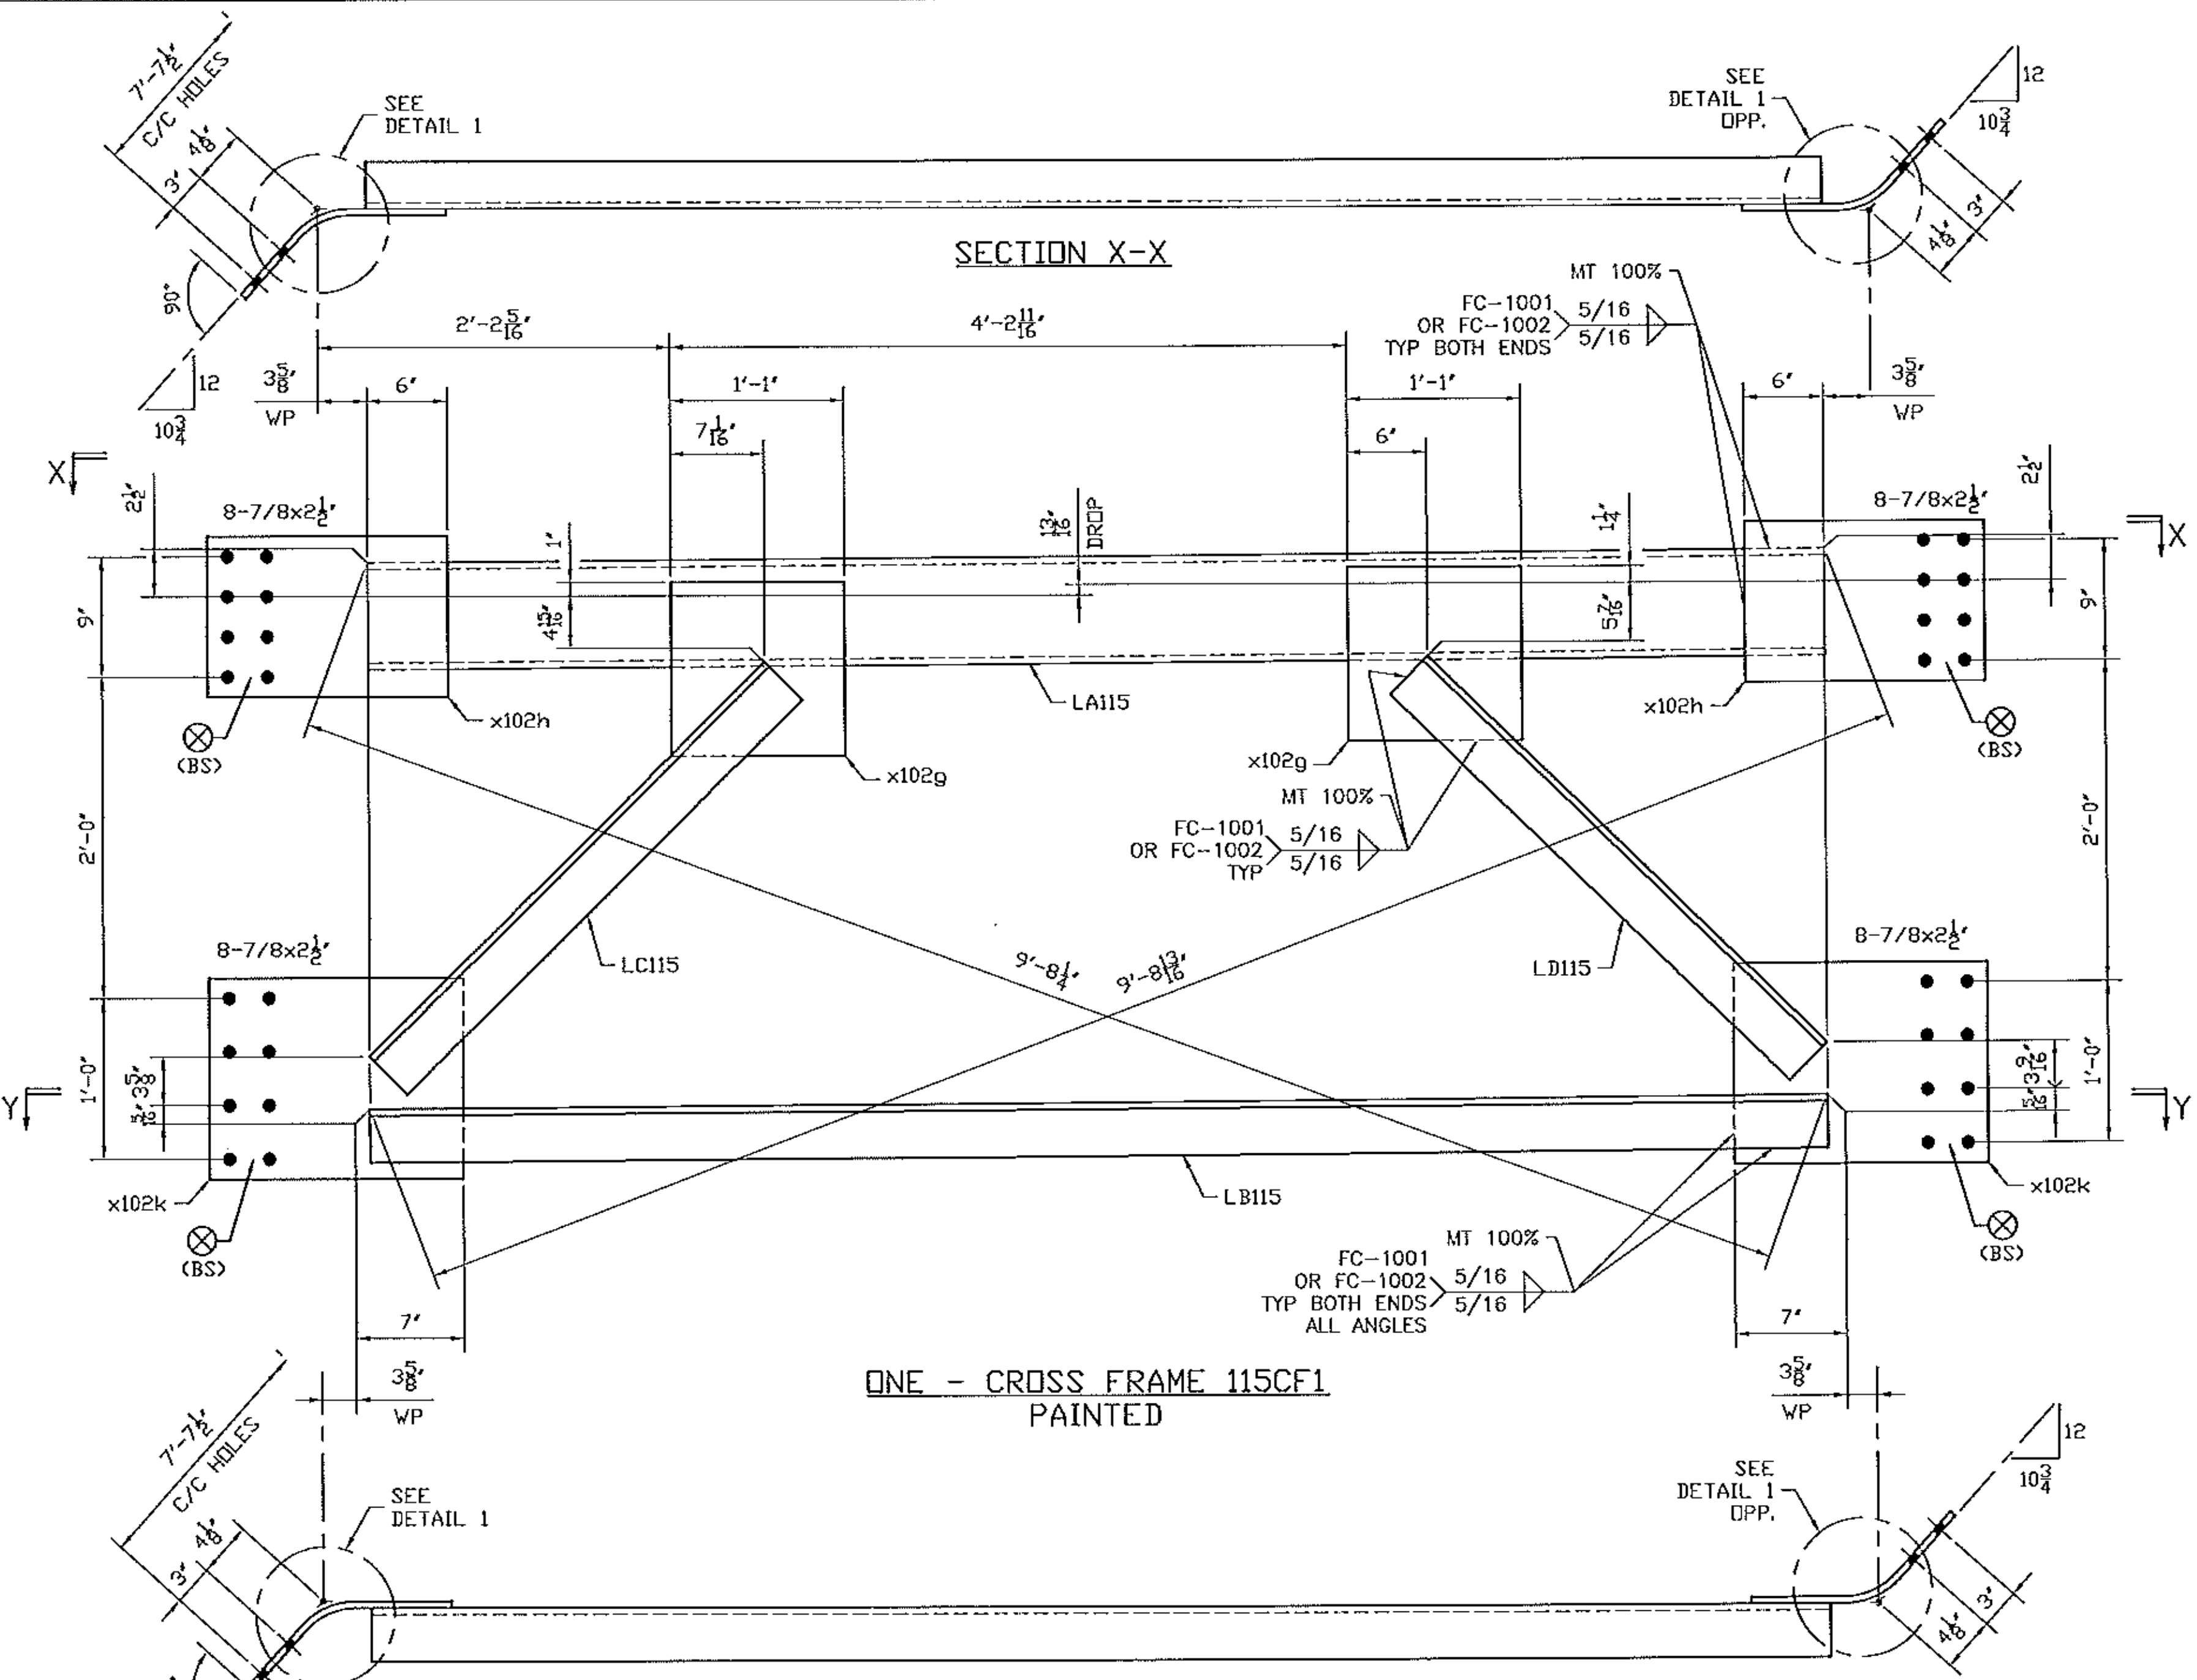

ONE - CROSS FRAME 115CF1  
PAINTED

GENERAL NOTES: SEE GN100  
HOLES: 15/16 (UN.)  
CLEANING AND PAINTING: SEE SHEET P100 AND P101

See standard specification 506.24(a)(9), no payment will be made for bolts, nuts, washers, they are considered to be incidental

BILL OF MATERIAL

Mark	Qty.	Description	SU	Length	Remark	ABM	Total	Seq	Qty
			Grd				Weight		/Seq
▲ 115CF1	ONE	CROSS FRAME				600	626	1	
▲ 115CF1	1	CROSS FRAME		10-7 7/8	PAINT				
▲ LA115	1	MC8x22.8	A70950W	9-1 1/8		104-1	207		
▲ LB115	1	L4x4x1/2	A70950W	9-1 1/8		104-2	116		
▲ LC115	1	L4x4x1/2	A70950W	3-5 13/16		104-3	45		
▲ LD115	1	L4x4x1/2	A70950W	3-5 1/2		104-3	44		
▲ x102g	2	PL1/2x13	A70950W	1-1		104-5	48		
▲ x102h	2	PL1/2x12	A70950W	1-5 3/4	BENT	104-4	60		
▲ x102k	2	PL1/2x15	A70950W	1-6 3/4	BENT	104-4	80		
▲ FB		FIELD BOLTS							
▲ 78F212	32	.7/8 Dia A325 TYP3		2 1/2	1FL WASH				

Vermont Agency of Transportation  
**RECEIVED**  
CK'D BY M.E.M. OK'D BY C.W.M.  
July 09, 2012  
RESUBMIT APPROVED AS NOTED  
BY C. CARLSON DATE 07-27-2012

No.	FOR APPROVAL	DATE	PAR	EG
	REVISION			

NOTE: BOLT 1 WASHER: 1 WASHER UNDER NUT U.N.  
BOLT 2 WASHER: 1 WASHER UNDER HEAD U.N.  
1 WASHER UNDER HEAD U.N.



**STRUCTAL**  
Bridges  
386 River Road, Clarendon, VT 05743  
Tel: (603) 542-5202 Fax: (603) 542-5312  
a division of CANAM

PROJECT: VT RT 9, BRIDGE NO. 11  
TOWN OF WOODFORD, VT  
OVER WALOOMSAC RIVER

TITLE: ABUTMENT CROSS FRAME


REFERENCE: PROJECT NO. ER BHF 010-1 (44)

NO. BY	DATE	NO. BY	DATE	NO. BY	DATE
BR	JULY 2012	GG	JULY 2012		
CONTRACT NO.	UN04260	REVISION NO.	115		

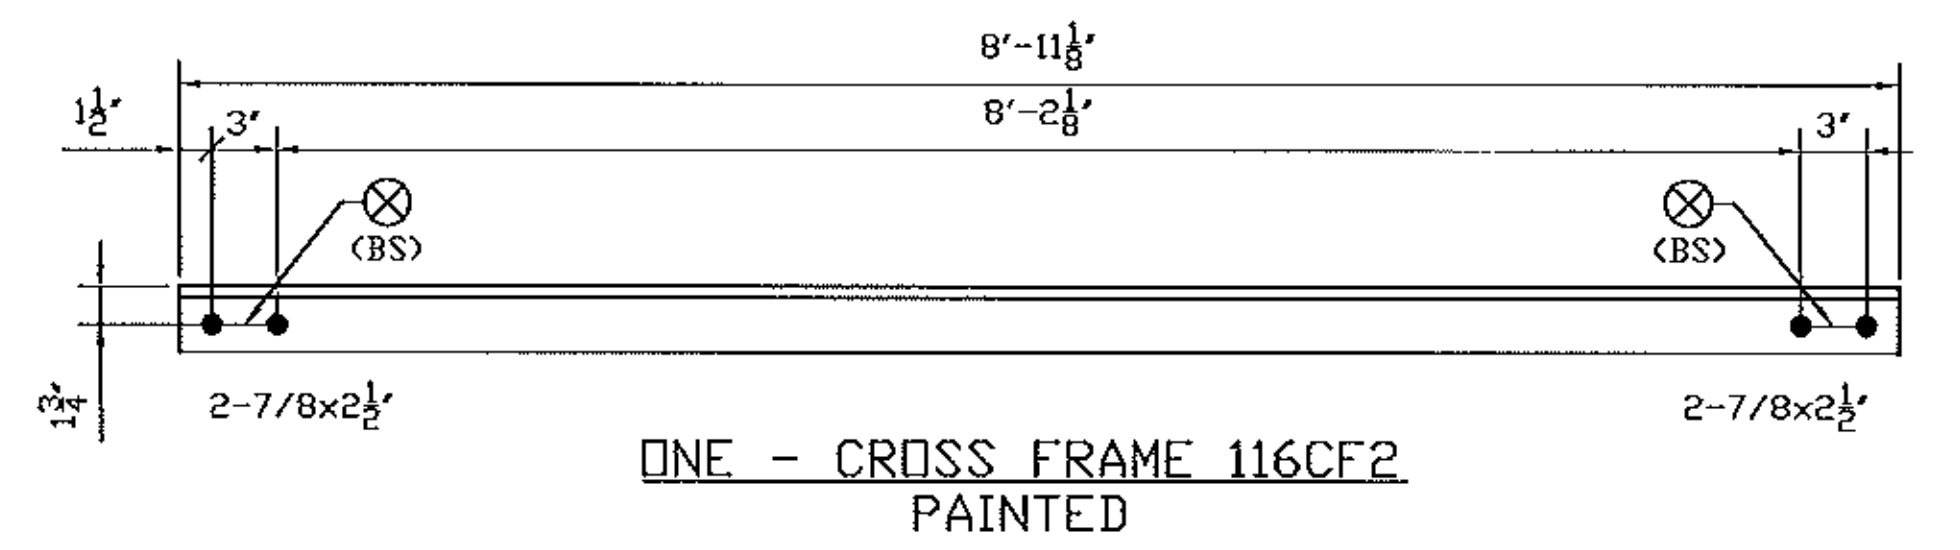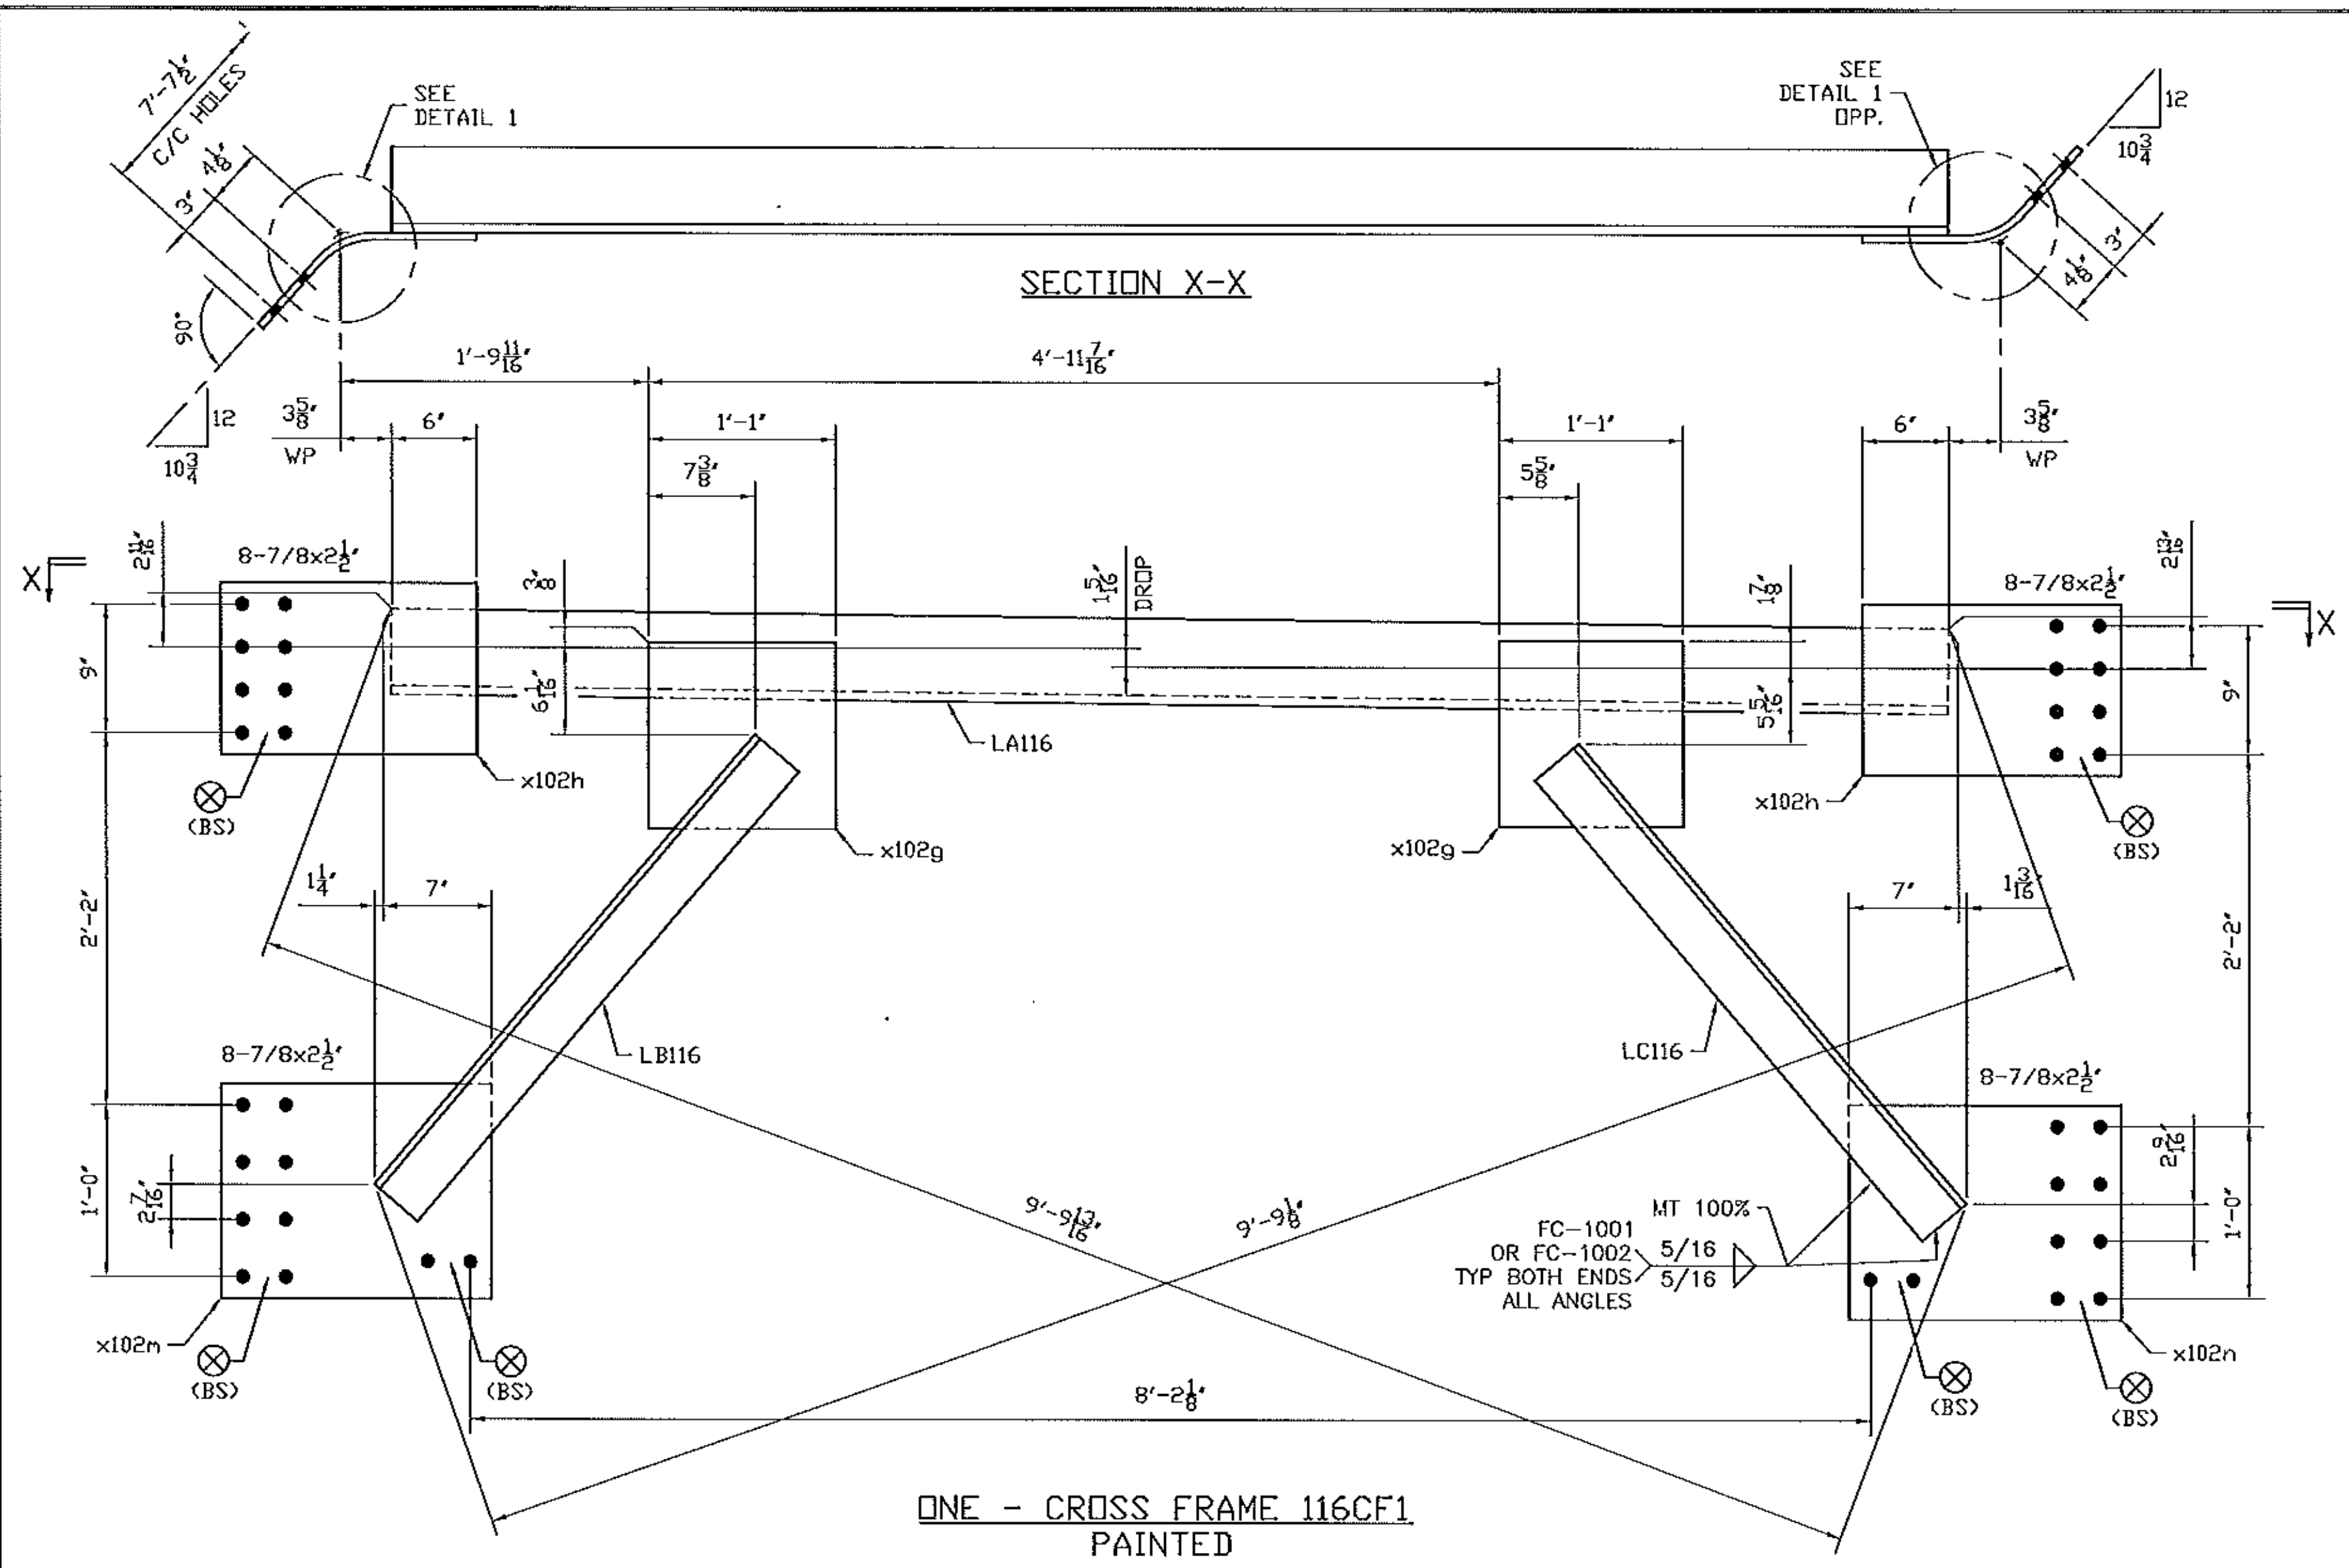

GENERAL NOTES: SEE GN100  
 HOLES: 15/16 (U.N.)  
 CLEANING AND PAINTING: SEE SHEET P100 AND P101

No	REVISION	DATE	PAR	VER.

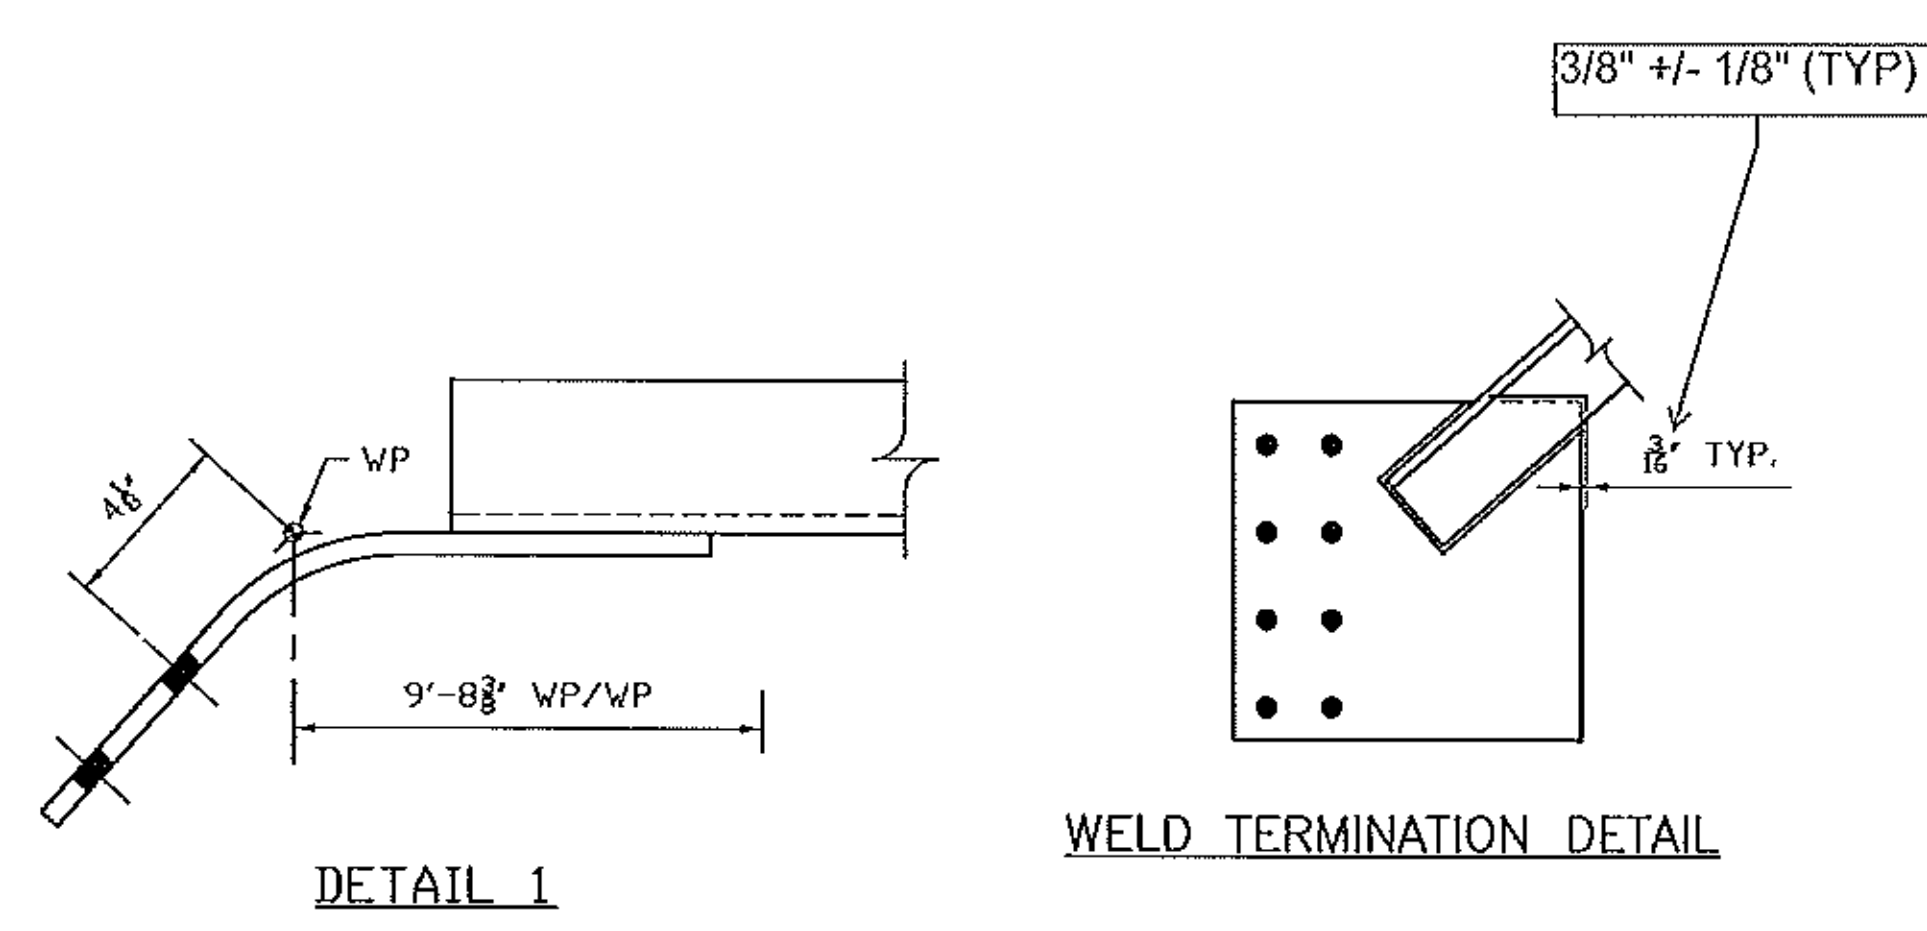

BILL OF MATERIAL										
Mark	Qty.	Description	SI	Length	Remark	ABM	Total	Seq	Qty	
			Grd				Weight		/Seq	
116CF1	ONE	CROSS FRAME					497	523	1	
116CF1	1	CROSS FRAME		10-7 7/8	PAINT					
LA116	1	L6x6x5/8	A70950W	9-1 1/8		103-1	220			
LB116	1	L4x4x1/2	A70950W	3-5 1/4		103-3	44			
LC116	1	L4x4x1/2	A70950W	3-6 1/16		103-3	45			
x102g	2	PL1/2x13	A70950W	1-1		103-5	48			
x102h	2	PL1/2x12	A70950W	1-5 3/4	BENT	103-4	60			
x102m	1	PL1/2x15	A70950W	1-6 3/4	BENT	103-4	40			
x102n	1	PL1/2x15	A70950W	1-6 3/4	BENT	103-4	40			
FB		FIELD BOLTS								
78F212	32	.7/8 Dia A325 TYP3		2 1/2	1FL WASH					
116CF2	1	CROSS FRAME					84	87	1	
116CF2	1	L3x3x1/2	A70950W	8-11 1/8	PAINT	103-2	84			
FB		FIELD BOLTS								
78F212	4	.7/8 Dia A325 TYP3		2 1/2	1FL WASH					

See standard specification 506.24(a)(9), no payment will be made for bolts, nuts, washers, they are considered to be incidental

Vermont Agency of Transportation  
**RECEIVED**  
 CK'D BY M.E.M. OK'D BY C.W.M.  
 July 09, 2012  
 RESUBMIT APPROVED AS NOTED  
 BY C. CARLSON DATE 07-27-2012

NOTE: BOLT 1 WASHER: 1 WASHER UNDER NUT U.N.  
 BOLT 2 WASHER: 1 WASHER UNDER HEAD U.N.  
 1 WASHER UNDER HEAD U.N.



PROJECT: VT RT 9, BRIDGE NO. 11  
 TOWN OF WOODFORD, VT  
 OVER WALDOMSAC RIVER

TITLE: ABUTMENT CROSS FRAME

REFERENCE: PROJECT NO. ER BHF 010-1 (44)

DATE	BY	DATE	BY	DATE	BY
BR	JULY 2012	UN04260			
GG	JULY 2012	116			


















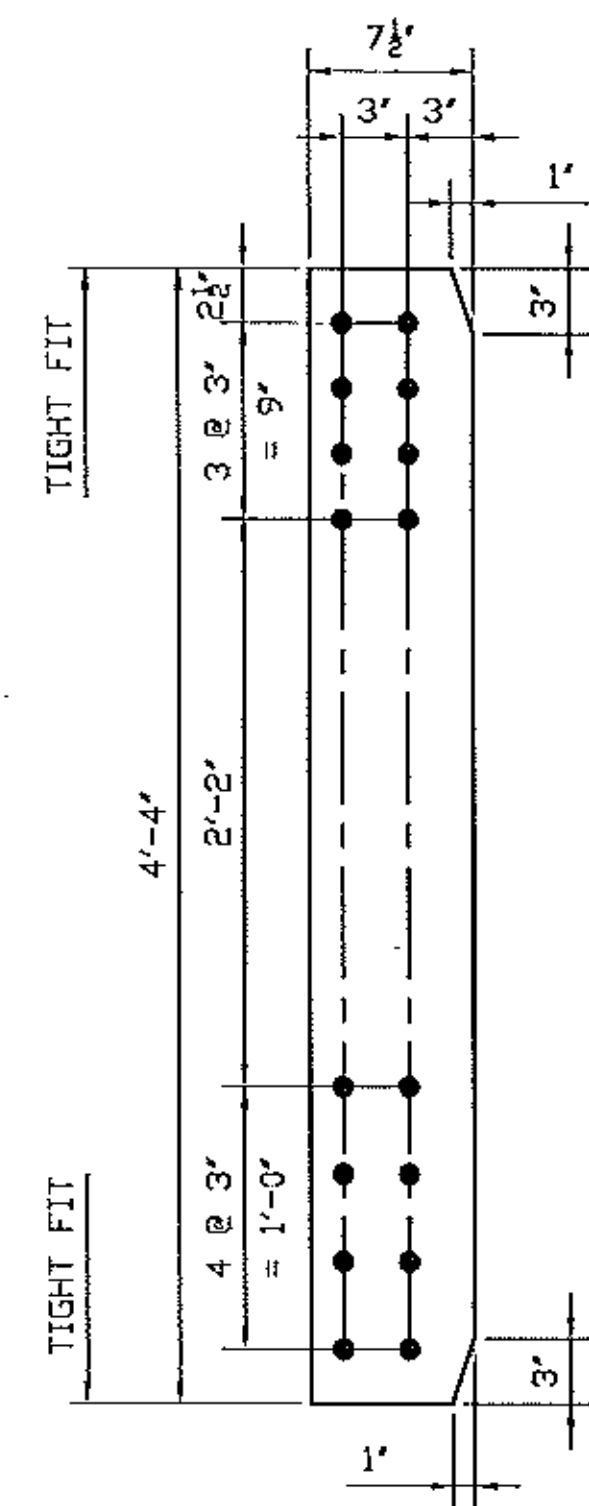


PL1/2x7 1/2x4-4 - x101a

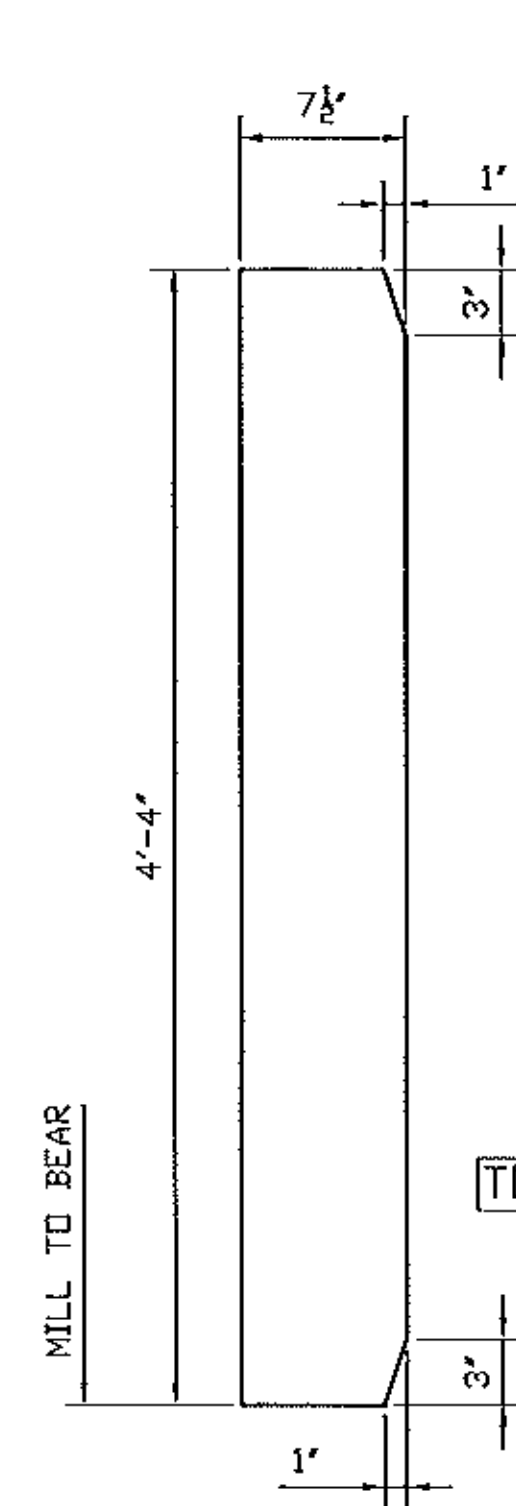


PL7/8x7 1/2x4-4 - x101b

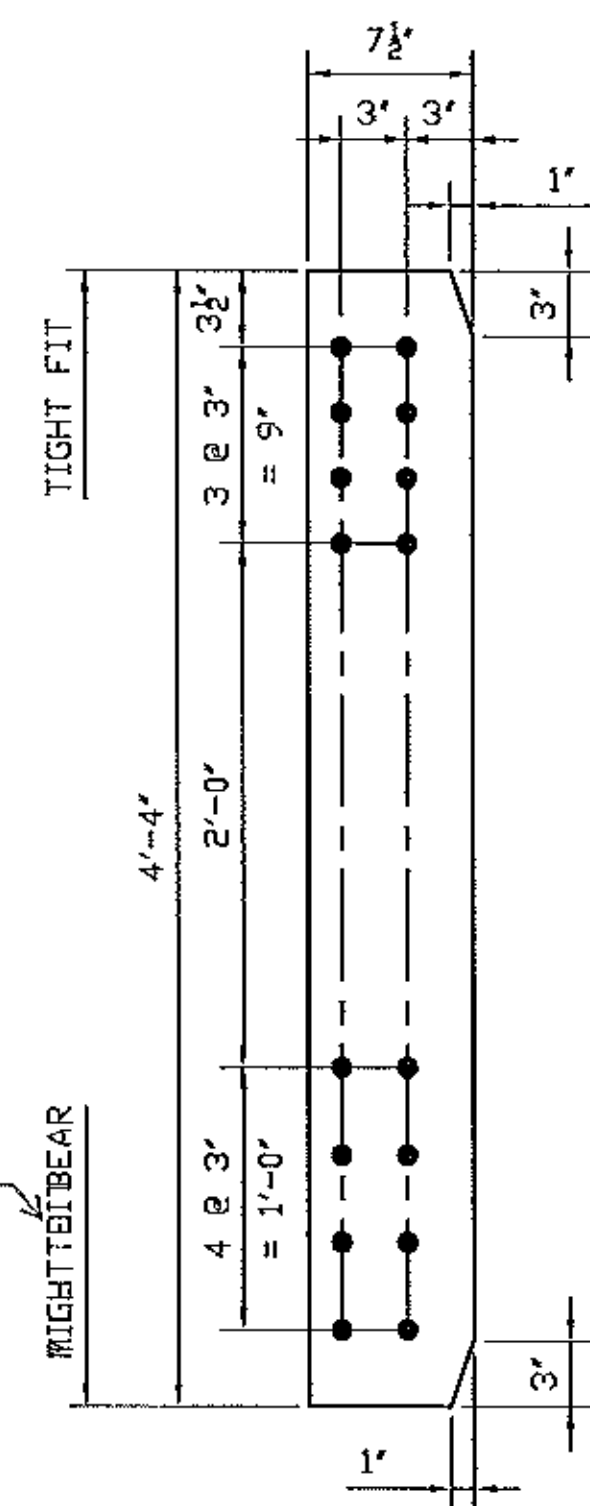


PL1/2x7 1/2x4-4 - x101c

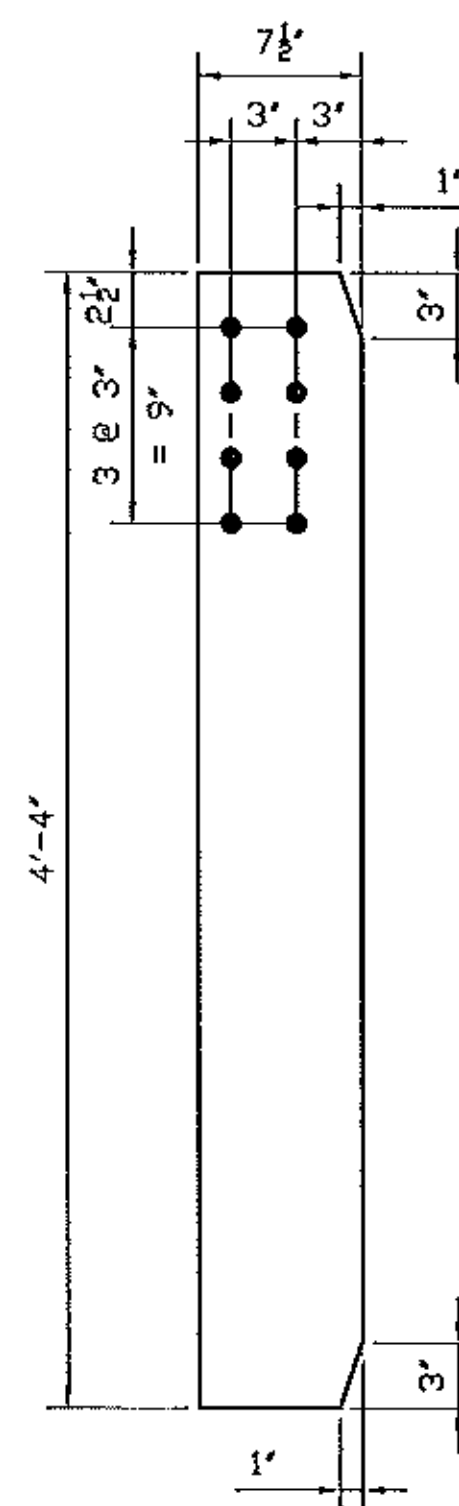

PL1/2x7 1/2x4-4 - x101d

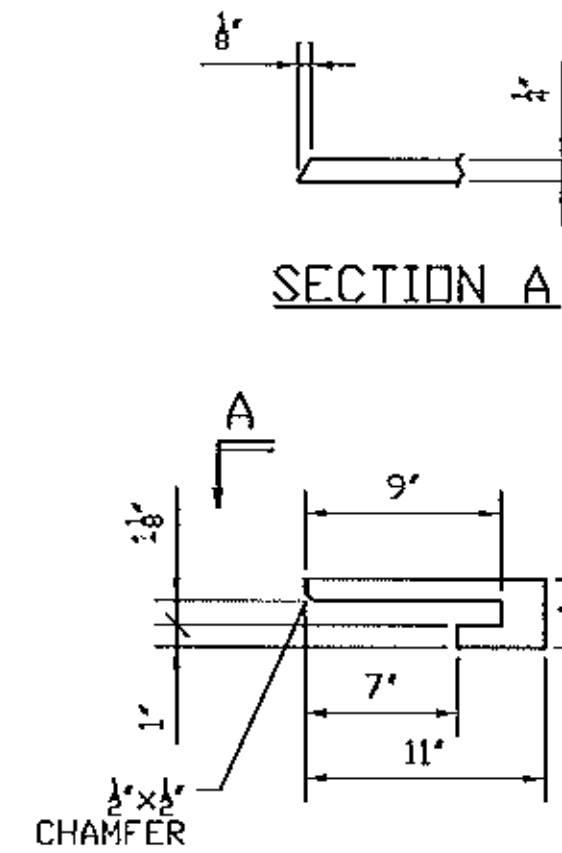


PL1/4x3 1/8x11 - x101e

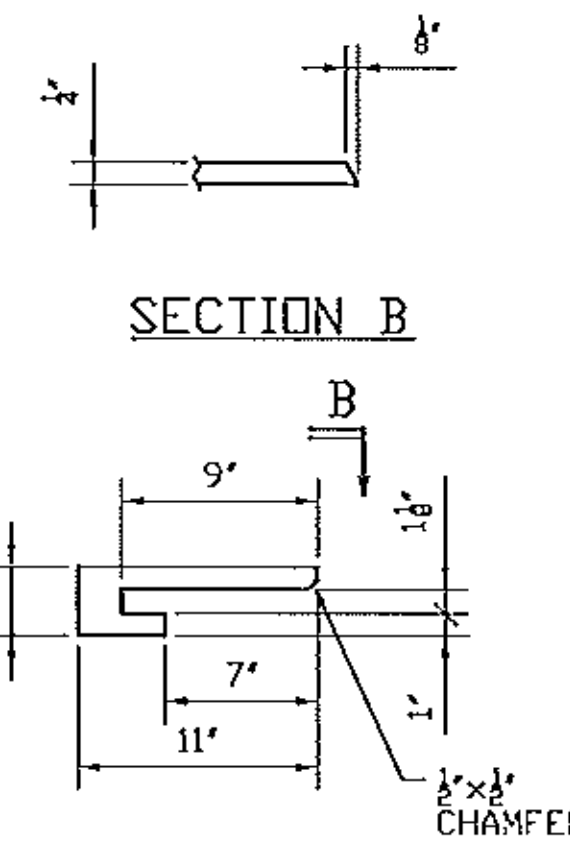


PL1/4x3 1/8x11 - x101k


GENERAL NOTES: SEE GN100  
 HOLES: 15/16 (U.N.)  
 CLEANING AND PAINTING: SEE SHEET P100 AND P101

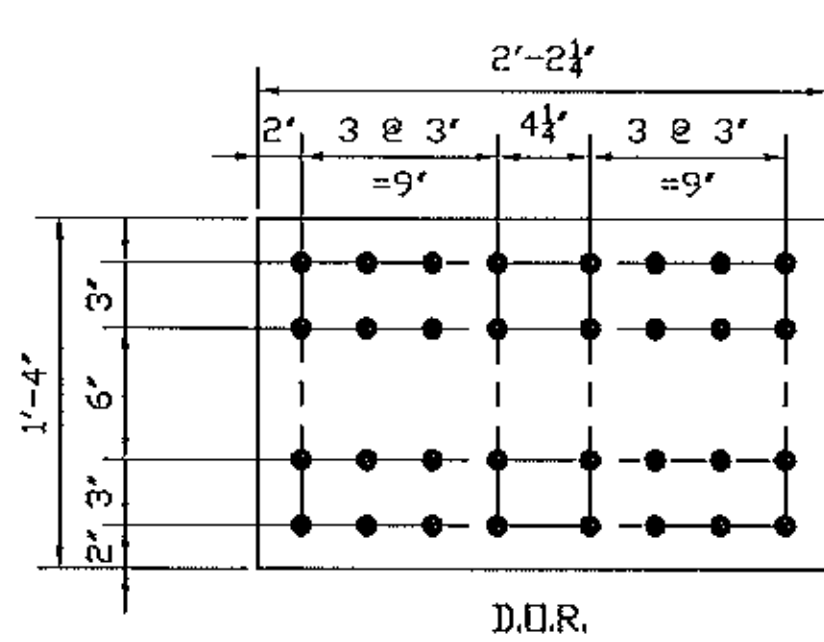


PL1/2x16x2-2 1/4 - x101spa

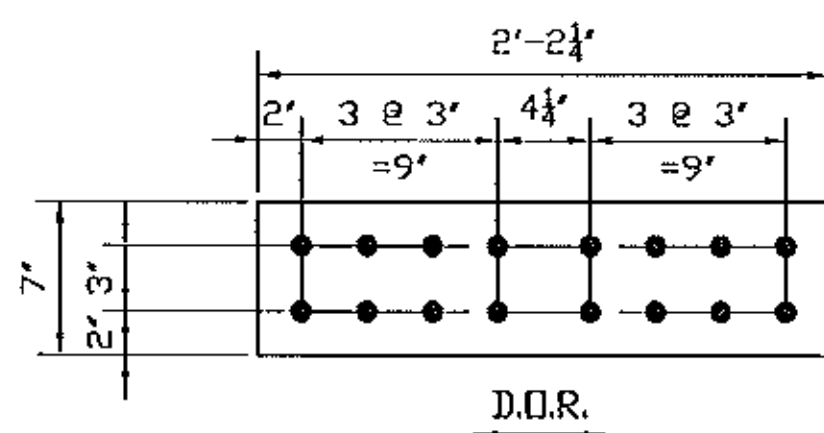


PL1/2x7x2-2 1/4 - x101spb

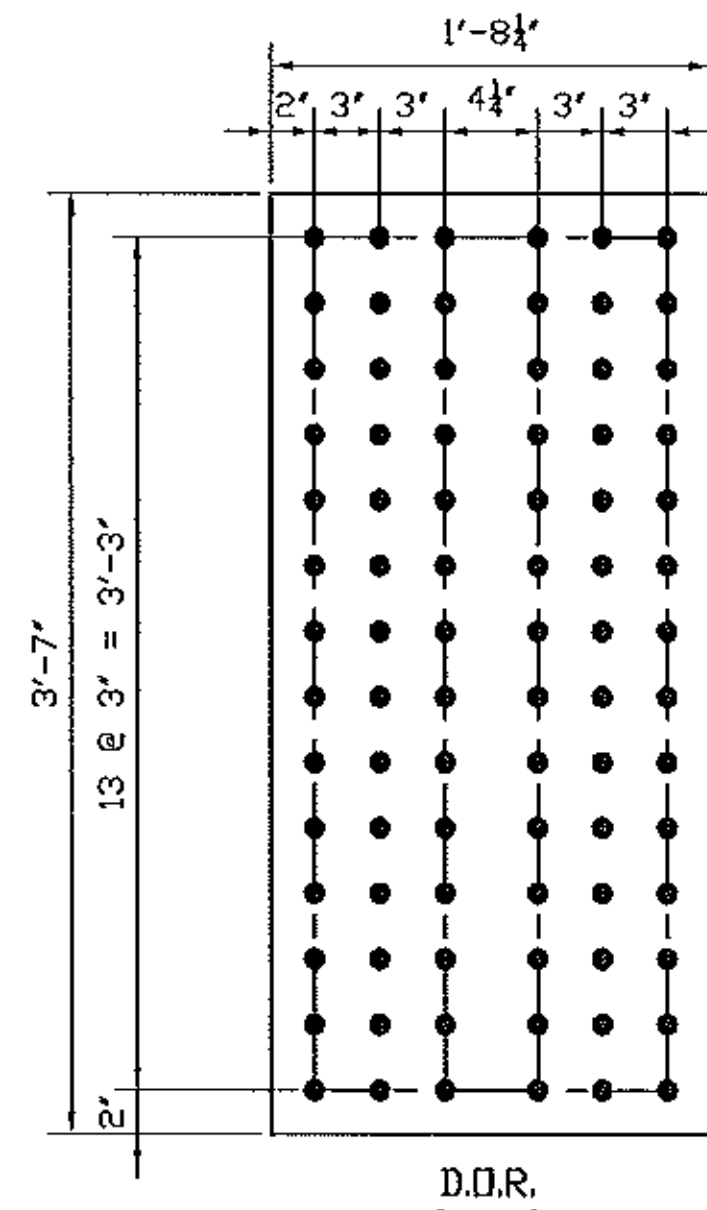

PL1/2x43x1-8 1/4 - x101spc

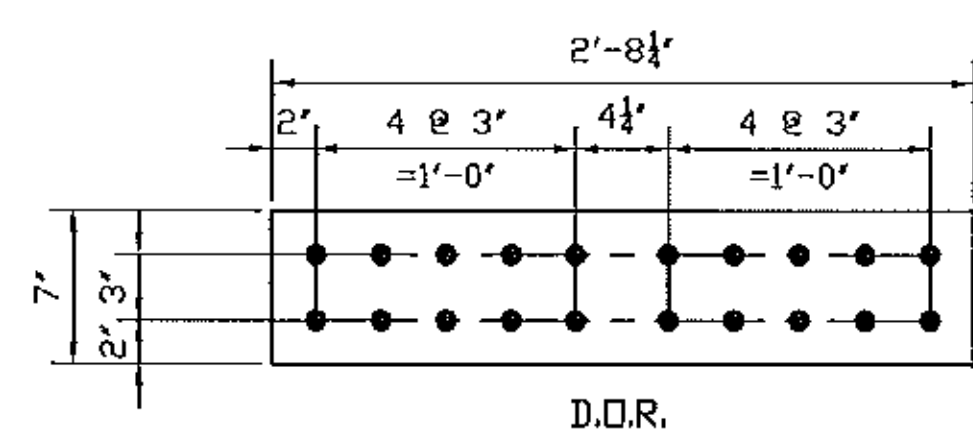

PL1/2x7x2-8 1/4 - x101spd

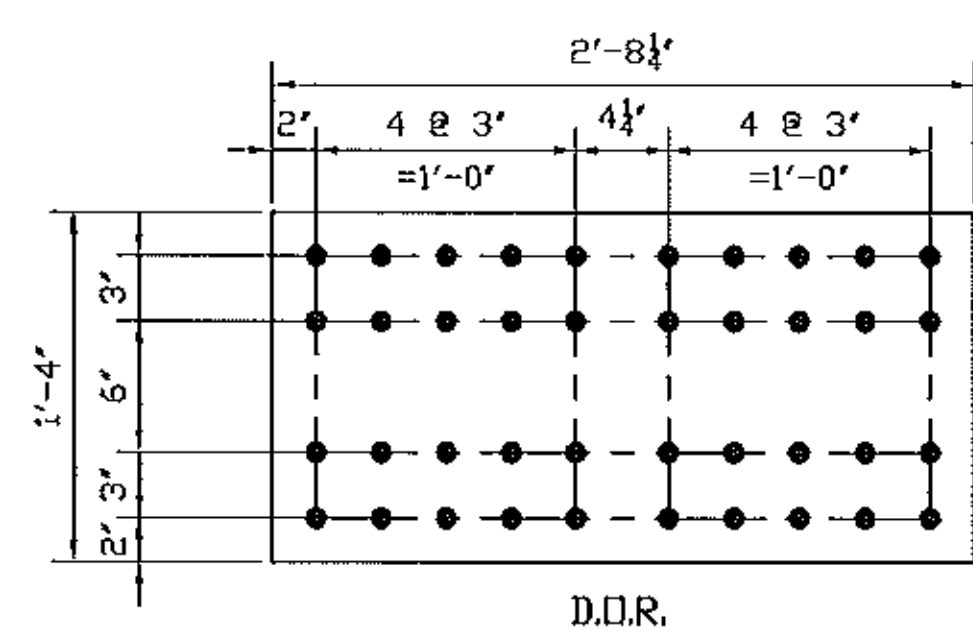

PL1/2x16x2-8 1/4 - x101spe

No	REVISION	DATE	PAR	VER.

NOTE: BOLT 1 WASHER: 1 WASHER UNDER NUT U.N.  
 BOLT 2 WASHER: 1 WASHER UNDER HEAD U.N.  
 1 WASHER UNDER HEAD U.N.




PROJECT: VT RT 9, BRIDGE NO. 11  
 TOWN OF WOODFORD, VT  
 OVER WALDOMSAC RIVER

TITLE: GIRDER DETAILS


REFERENCE: PROJECT NO. ER BHF 010-1 (44)

DESIGNED BY	DATE	APPROVED BY	DATE	CONTRACT NO.	REVISED BY	DATE
BR	JULY 2012	GG	JULY 2012	UN04260		
GG	JULY 2012				X101	


Vermont Agency of Transportation  
**RECEIVED**  
 CK'D BY M.E.M. OK'D BY C.W.M.  
 July 09, 2012  
 RESUBMIT APPROVED AS NOTED  
 BY C. CARLSON DATE 07-27-2012

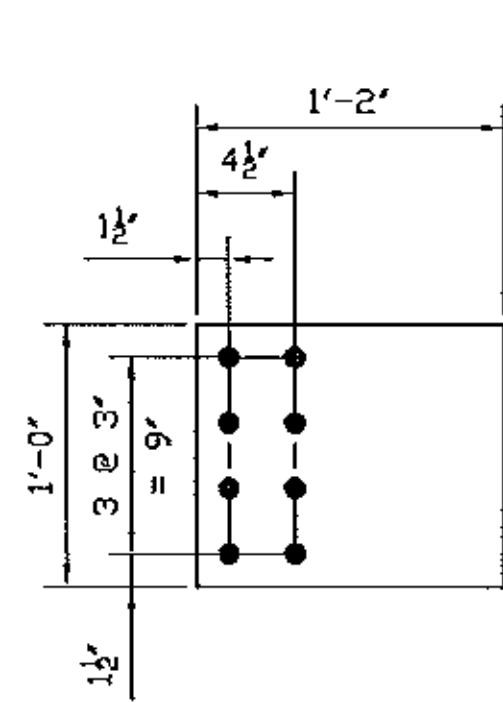


PL1/2x12x1-2 - x102a

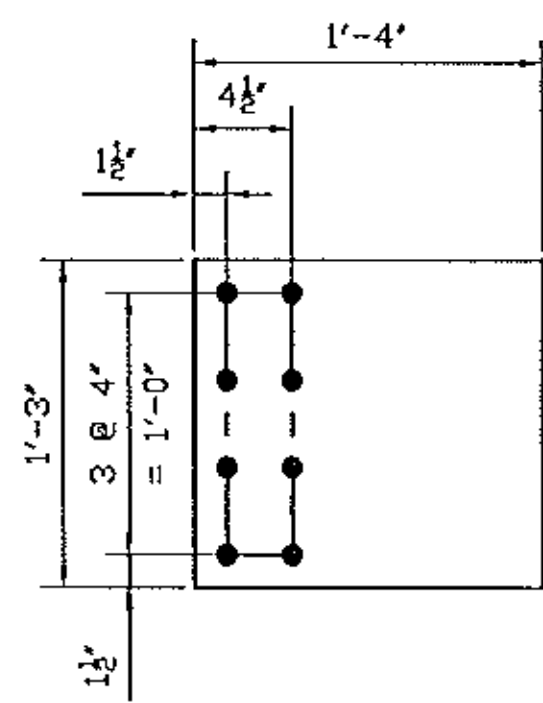


PL1/2x15x1-4 - x102b

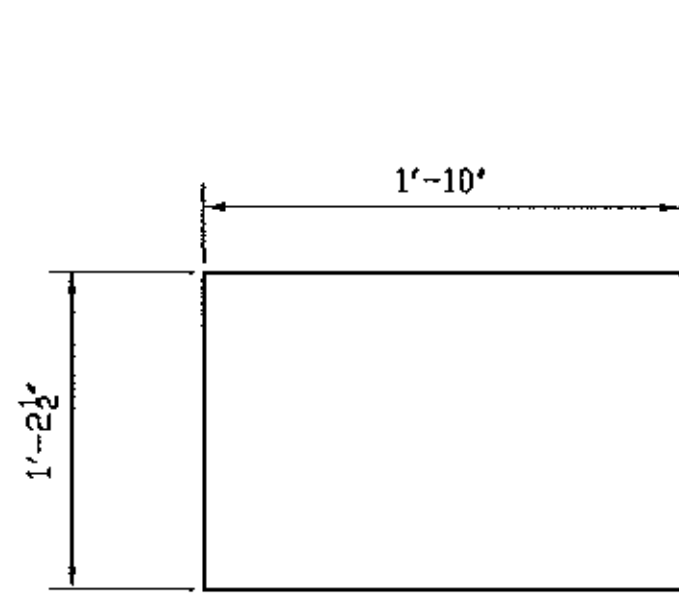


PL1/2x14 1/2x1-10 - x102c

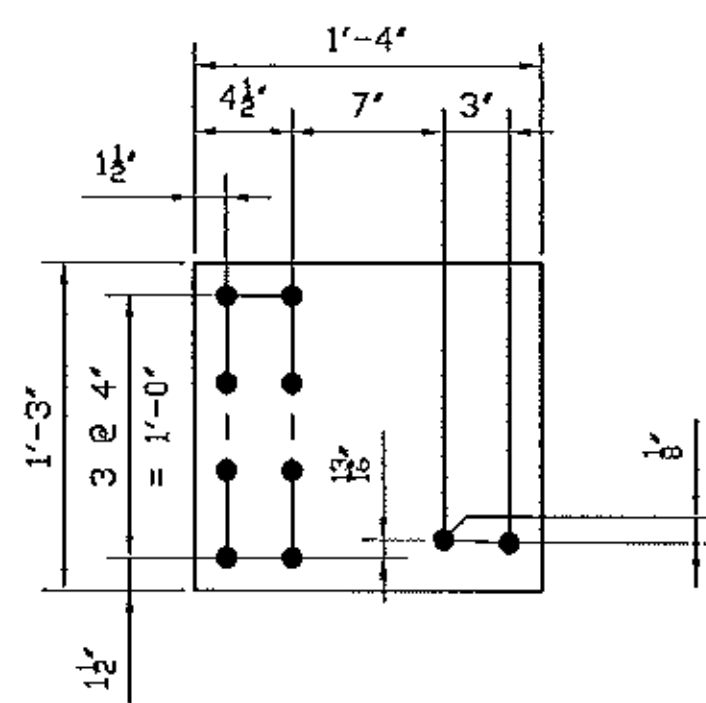


PL1/2x15x1-4 - x102d

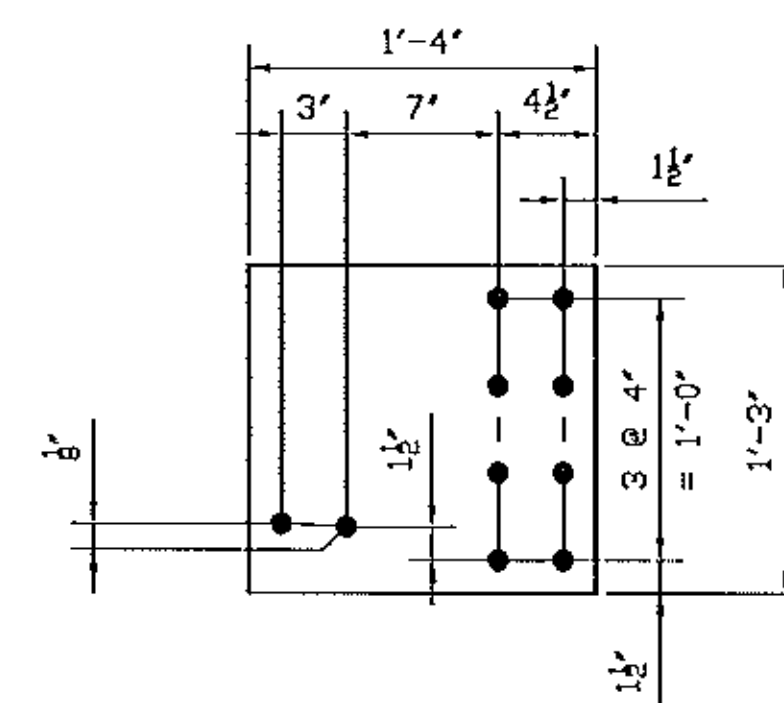

PL1/2x15x1-4 - x102e

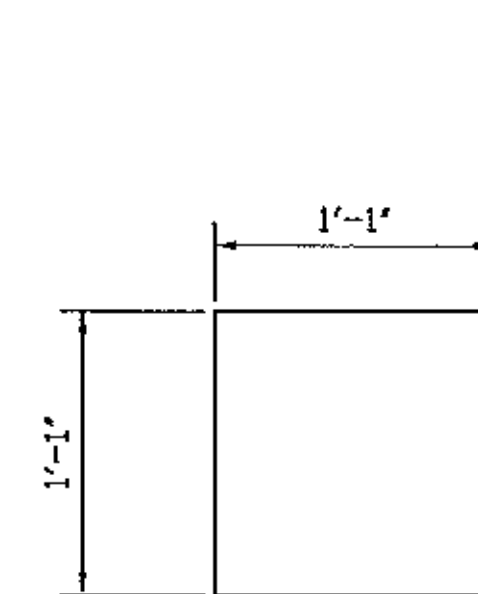


PL1/2x13x1-1 - x102g

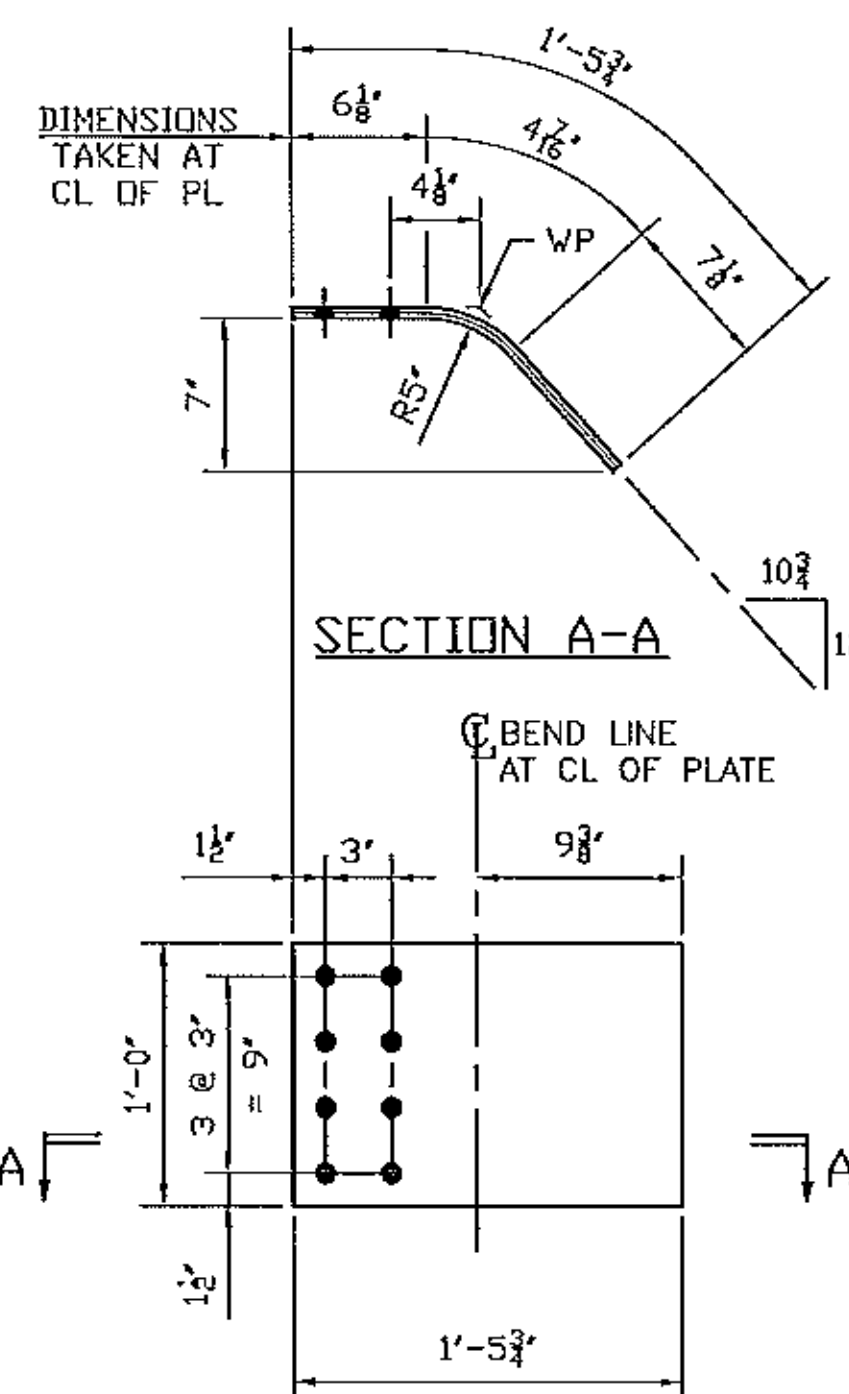

PL1/2x12x1-5 3/4 - x102h

(DEVELOPED)


D.O.R

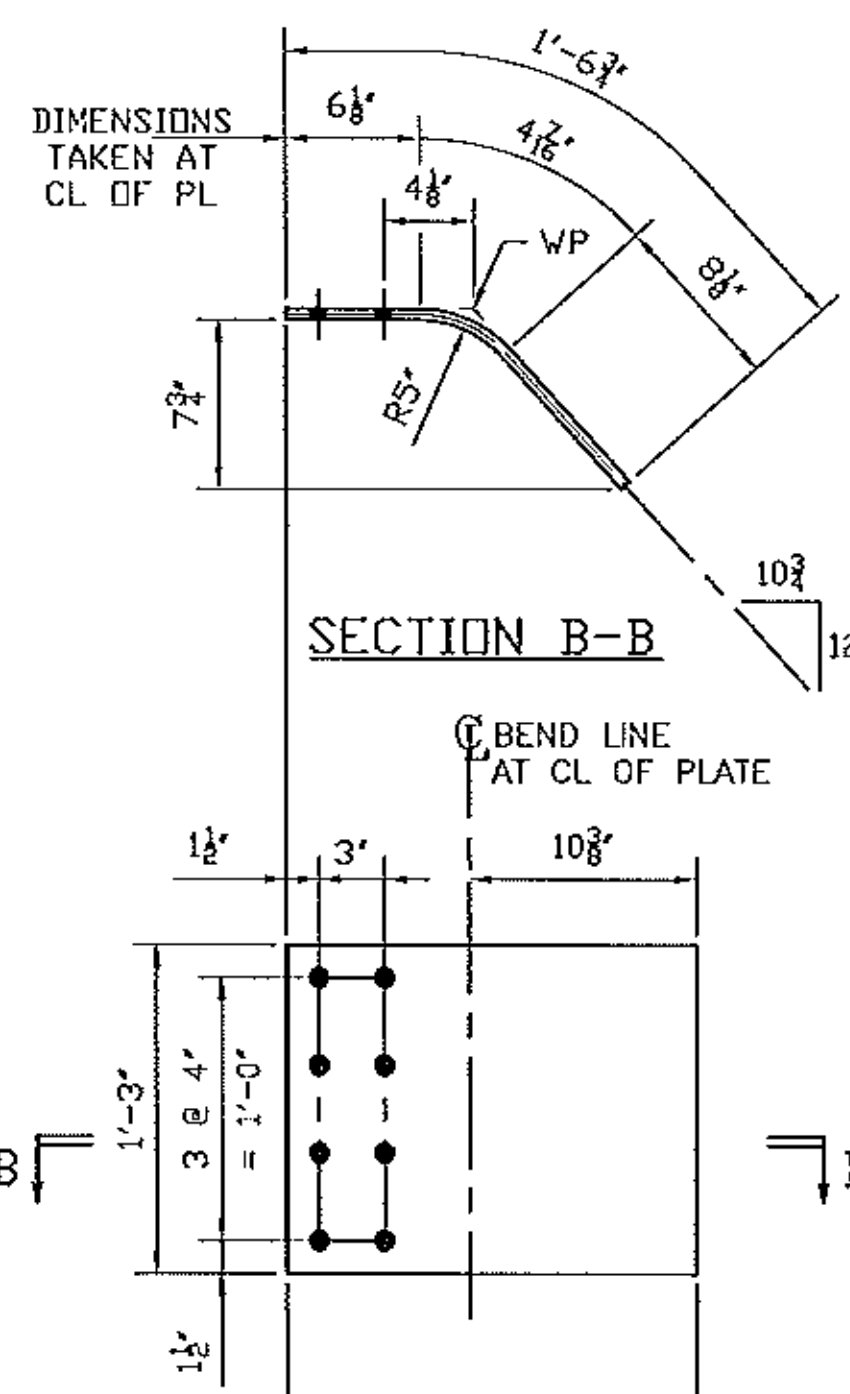

PL1/2x15x1-6 3/4 - x102k

(DEVELOPED)


D.O.R

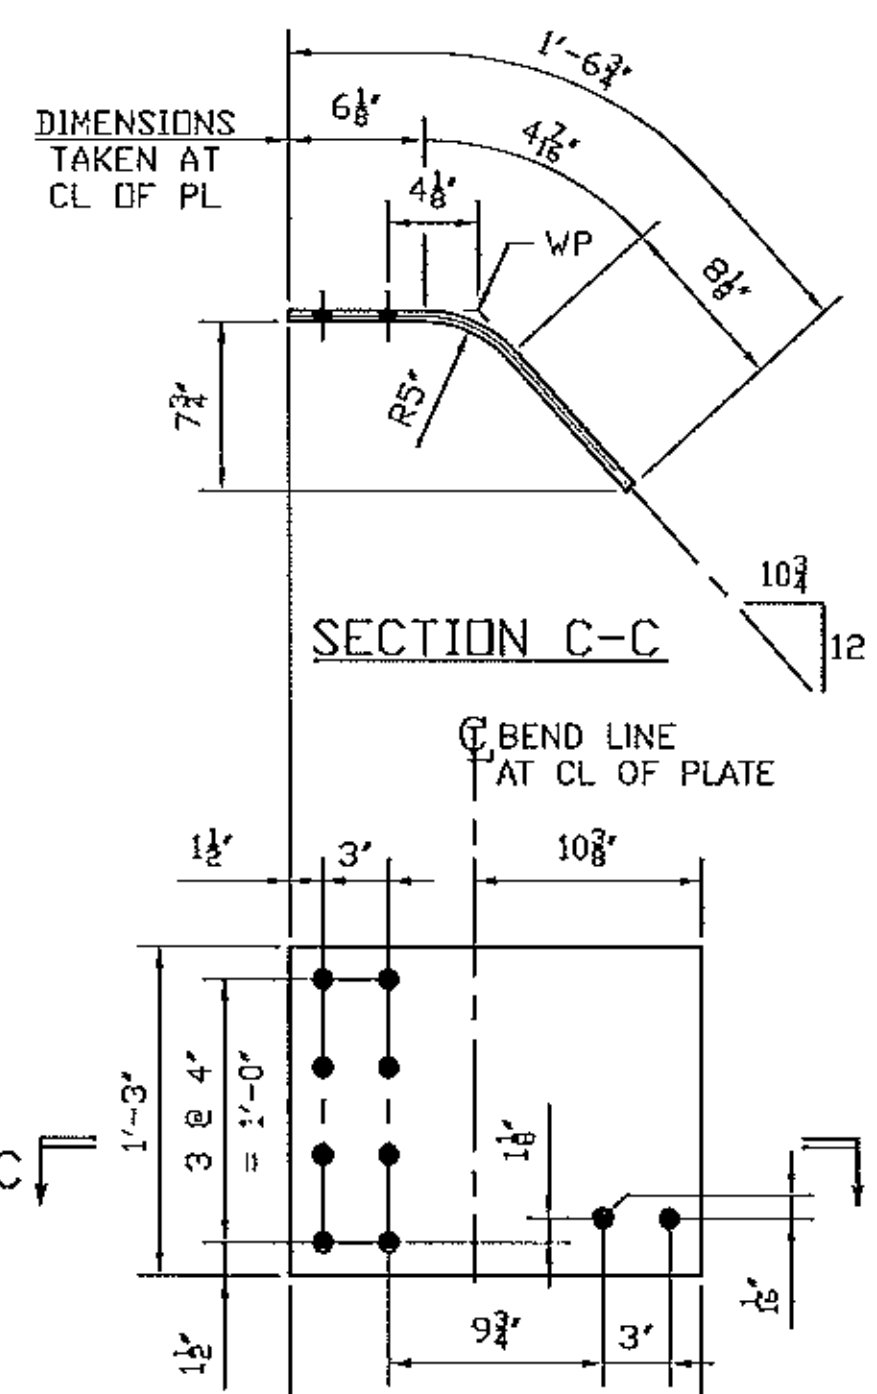

PL1/2x15x1-6 3/4 - x102m

(DEVELOPED)

D.O.R

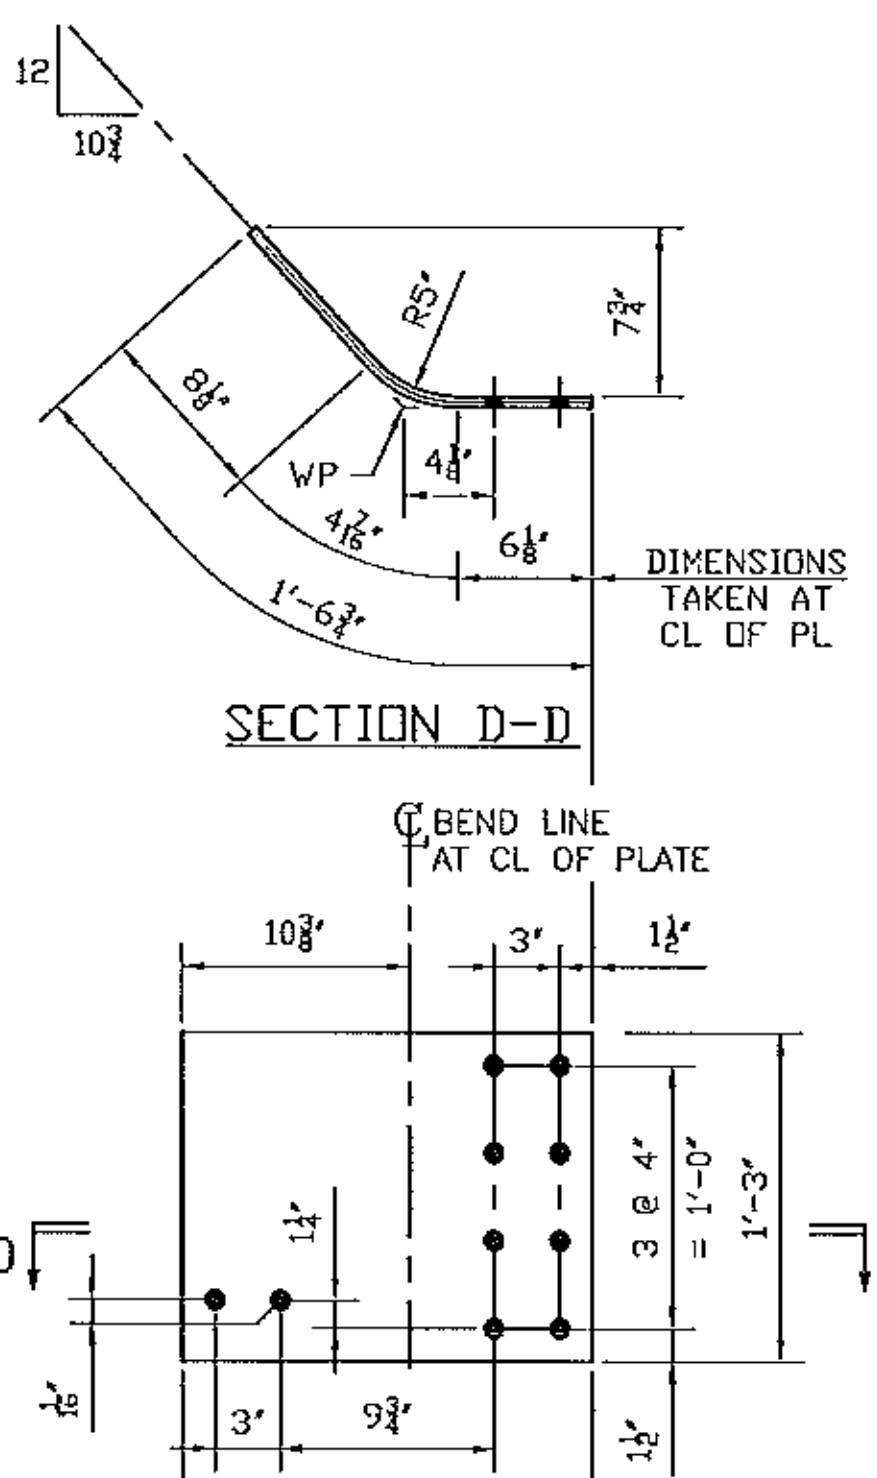

PL1/2x15x1-6 3/4 - x102n

(DEVELOPED)

D.O.R

GENERAL NOTES: SEE GN100  
 HOLES: 15/16 (U.N.)  
 CLEANING AND PAINTING: SEE SHEET P100 AND P101

No	FOR APPROVAL	07/06/12	BR	EG
	REVISION	DATE	PAR	VER.

NOTE: BOLT 1 WASHER: 1 WASHER UNDER NUT U.N.  
 BOLT 2 WASHER: 1 WASHER UNDER HEAD U.N.  
 1 WASHER UNDER HEAD U.N.




PROJECT: VT RT 9, BRIDGE NO. 11  
 TOWN OF WOODFORD, VT  
 OVER WALDOMSAC RIVER

TITLE: CROSSFRAME DETAILS

REFERENCE: PROJECT NO. ER BHF 010-1 (44)

DESIGN BY	BR	DATE	JULY 2012	CONTRACT NO.	UN04260
CHECKED BY	GG	DATE	JULY 2012	ISSUE NO.	X102 A

Vermont Agency of Transportation  
**RECEIVED**  
 CK'D BY M.E.M OK'D BY C.W.M.  
 July 09, 2012  
 RESUBMIT APPROVED  
 BY C. CARLSON DATE 07-27-2012

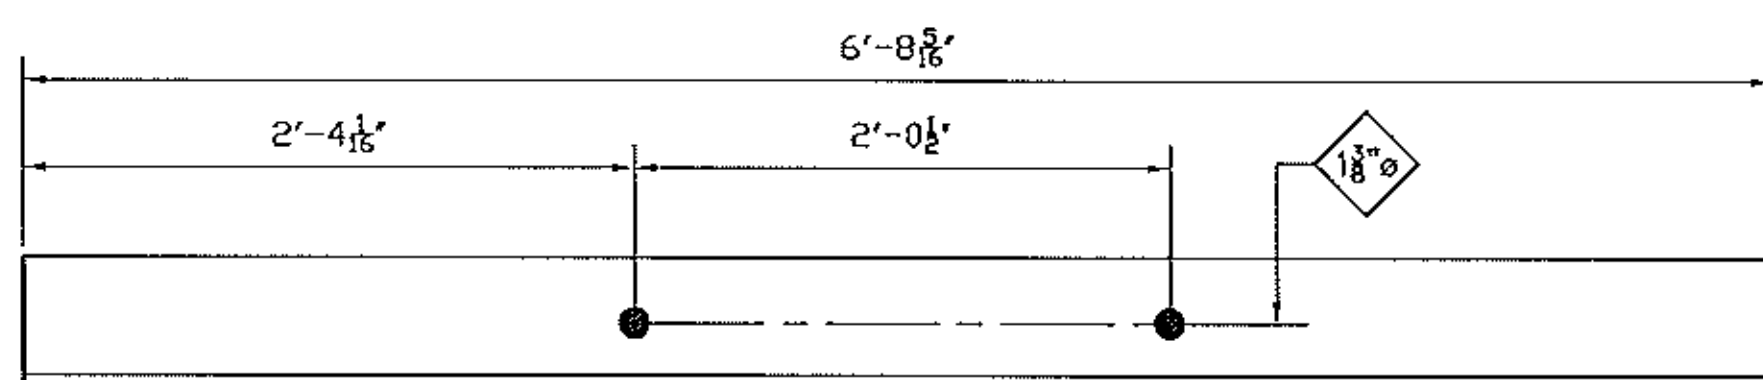

L6x6x5/8x6-8 15/16 - x102p

State of Vermont  
PDD/Structures Design Section  
National Life Building – Drawer 33  
Montpelier, VT 05633-5001  
www.aot.state.vt.us

Agency of Transportation

[phone] 802-828-2621  
[fax] 802-828-3566  
[ttd] 800-253-0191

August 13, 2012

ARC Enterprises, INC.  
P.O. Box 120  
Kingfield, Maine 04947

Project Name: Woodford Project #: ER BHF 010-1(44)

Structure Identification: VT 9 Over the Roaring Branch of the Walloomsac River

The following Downspout details [**Paid for under Item # 506.55, “Structural Steel, Plate Girder”**] for the above project (Vendor’s Job # 12-324) transmitted via Brian Emmons of T. Buck Construction, Inc. on August 22, 2012 have been reviewed and are being returned herewith.

Sheet: 1 of 2 is **approved [X]**

Sheets: 2 of 2 and the Welding Procedures are **approved “as noted”**.

Please make appropriate changes as indicated on these “as noted” or “approved” drawings and submit white prints for our use in the record plans for this project.

You must provide notice to our fabrication inspector, Jeff Clark, as to the date fabrication represented by these drawings will begin. Jeff must receive and acknowledge your notice at least seven days prior to that date, as per Specification 506.03. You may contact Jeff by phone at (802)828-0044 or email at [jeff.clark@state.vt.us](mailto:jeff.clark@state.vt.us). Any material fabricated prior to the notification date is subject to rejection without further cause.

Sincerely,



Carolyn W. Carlson, PE  
Structures Project Manager

Attachments

cc: [X] Resident Engineer Ron Lemaire – w/prints  
[X] T. Buck Construction, Inc. – w/prints  
[X] Shop Inspector - Jeff Clark – w/prints  
[X] Materials and Research (C&IA) – letter only  
[X] Construction – letter only  
[X] CWC





WELDING PROCEDURE SPECIFICATION (WPS) YES ( X )  
 PREQUALIFIED  X  QUALIFIED BY TESTING \_\_\_\_\_  
 or PROCEDURE QUALIFICATION RECORD (PQR) YES ( )

Company Name ARC Ent. Inc. Identification # ARC WPS 7M2  
 Welding Process(es) GMAW Revision 5 Date 8/3/2012 By SVH  
 Supporting PQR No.(s) \_\_\_\_\_ Authorized by STEVE HOWARD Date 8/3/2012  
 Type - Manual  Semi - Automatic   
 Machine  Automatic


D 1.1

<b>JOINT DESIGN USED</b> Type <u>B-U4b-GF</u> Single <input checked="" type="checkbox"/> Double Weld <input type="checkbox"/> Backing <input type="checkbox"/> NO Backing Material _____ Root Opening <u>0 - 1/8"</u> Root Face Dimension <u>0 - 1/8"</u> Groove Angle <u>45 Degrees</u> Radius (J-U) _____ Back Gouging Method _____		<b>POSITION</b> Position of Groove <u>1G 2G</u> Fillet _____ Vertical Progression <input type="checkbox"/>	
<b>BASE METALS</b> Material Spec <u>A709 A500</u> Type or Grade <u>36 50</u> Thickness _____ Groove U _____ Fillet _____ Diameter ( Pipe ) _____		<b>ELECTRICAL CHARACTERISTICS</b> Transfer Mode (FCAW) _____ Short Circuiting <input type="checkbox"/> Globular <input type="checkbox"/> Spray <input checked="" type="checkbox"/> Current: AC <input type="checkbox"/> DCEP <input checked="" type="checkbox"/> DCEN <input type="checkbox"/> Pulsed <input type="checkbox"/> OTHER: _____	
<b>FILLER METALS</b> Lincoln L-56 AWS Specification <u>A5.18</u> AWS Classification <u>ER70S-6</u>		<b>TECHNIQUE</b> Stringer or Weave Bead <u>stringer</u> Multi-pass or Single Pass (per side) <u>multi</u> Number of Electrodes <u>one</u> Electrode Spacing _____ Longitudinal _____ Lateral _____ Angle _____	
<b>SHIELDING</b> Flux _____ Gas <u>AR-2</u> Composition <u>argon 98 oxygen 2</u> Electrode - Flux (Glass) _____ Flow Rate <u>25 - 40</u> Gas Cup Size <u>5/8</u>		Contact Tube to Work Distance <u>5/8 - 3/4"</u> Peening _____ Interpass Cleaning: <u>brush or grind</u>	
		<b>POSTWELD HEAT TREATMENT</b> Temp _____ Time _____	

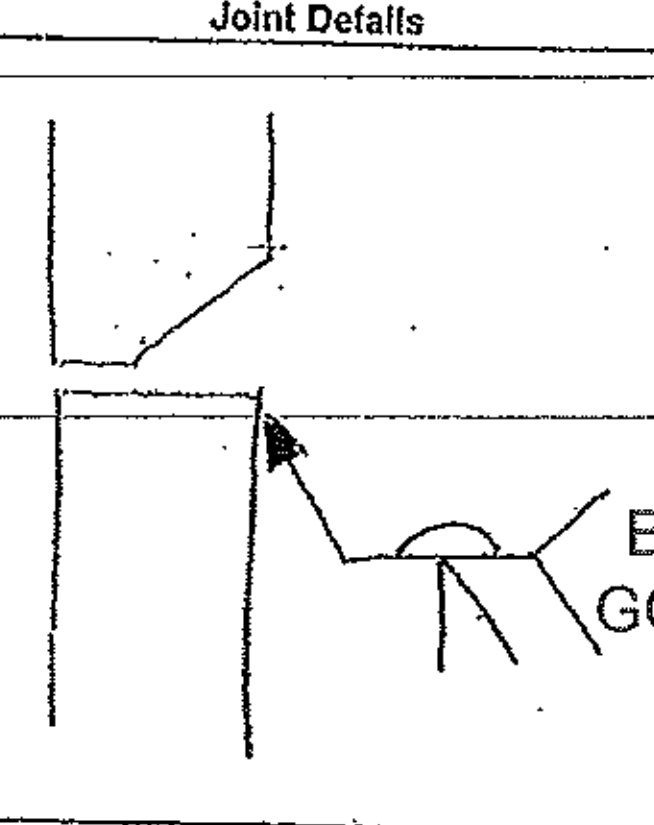
WELDING PROCEDURE								
Pass or Weld Layer(s)	S	Filler Metals		Current		Volts	Travel Speed	Joint Details
		Class	Diameter	Type & Polarity	Amps or Wire Feed Speed			
1-3		ER70S-6	.035"	DCEP	180-220	25-27	6-7 ipm	 BACK GOUGE
Vermont Agency of Transportation <b>RECEIVED</b> OK'D BY J. CLARK OK'D BY _____ 08/21/2012 RESUBMIT APPROVED AS NOTED BY C. CARLSON DATE 08/29/2012								

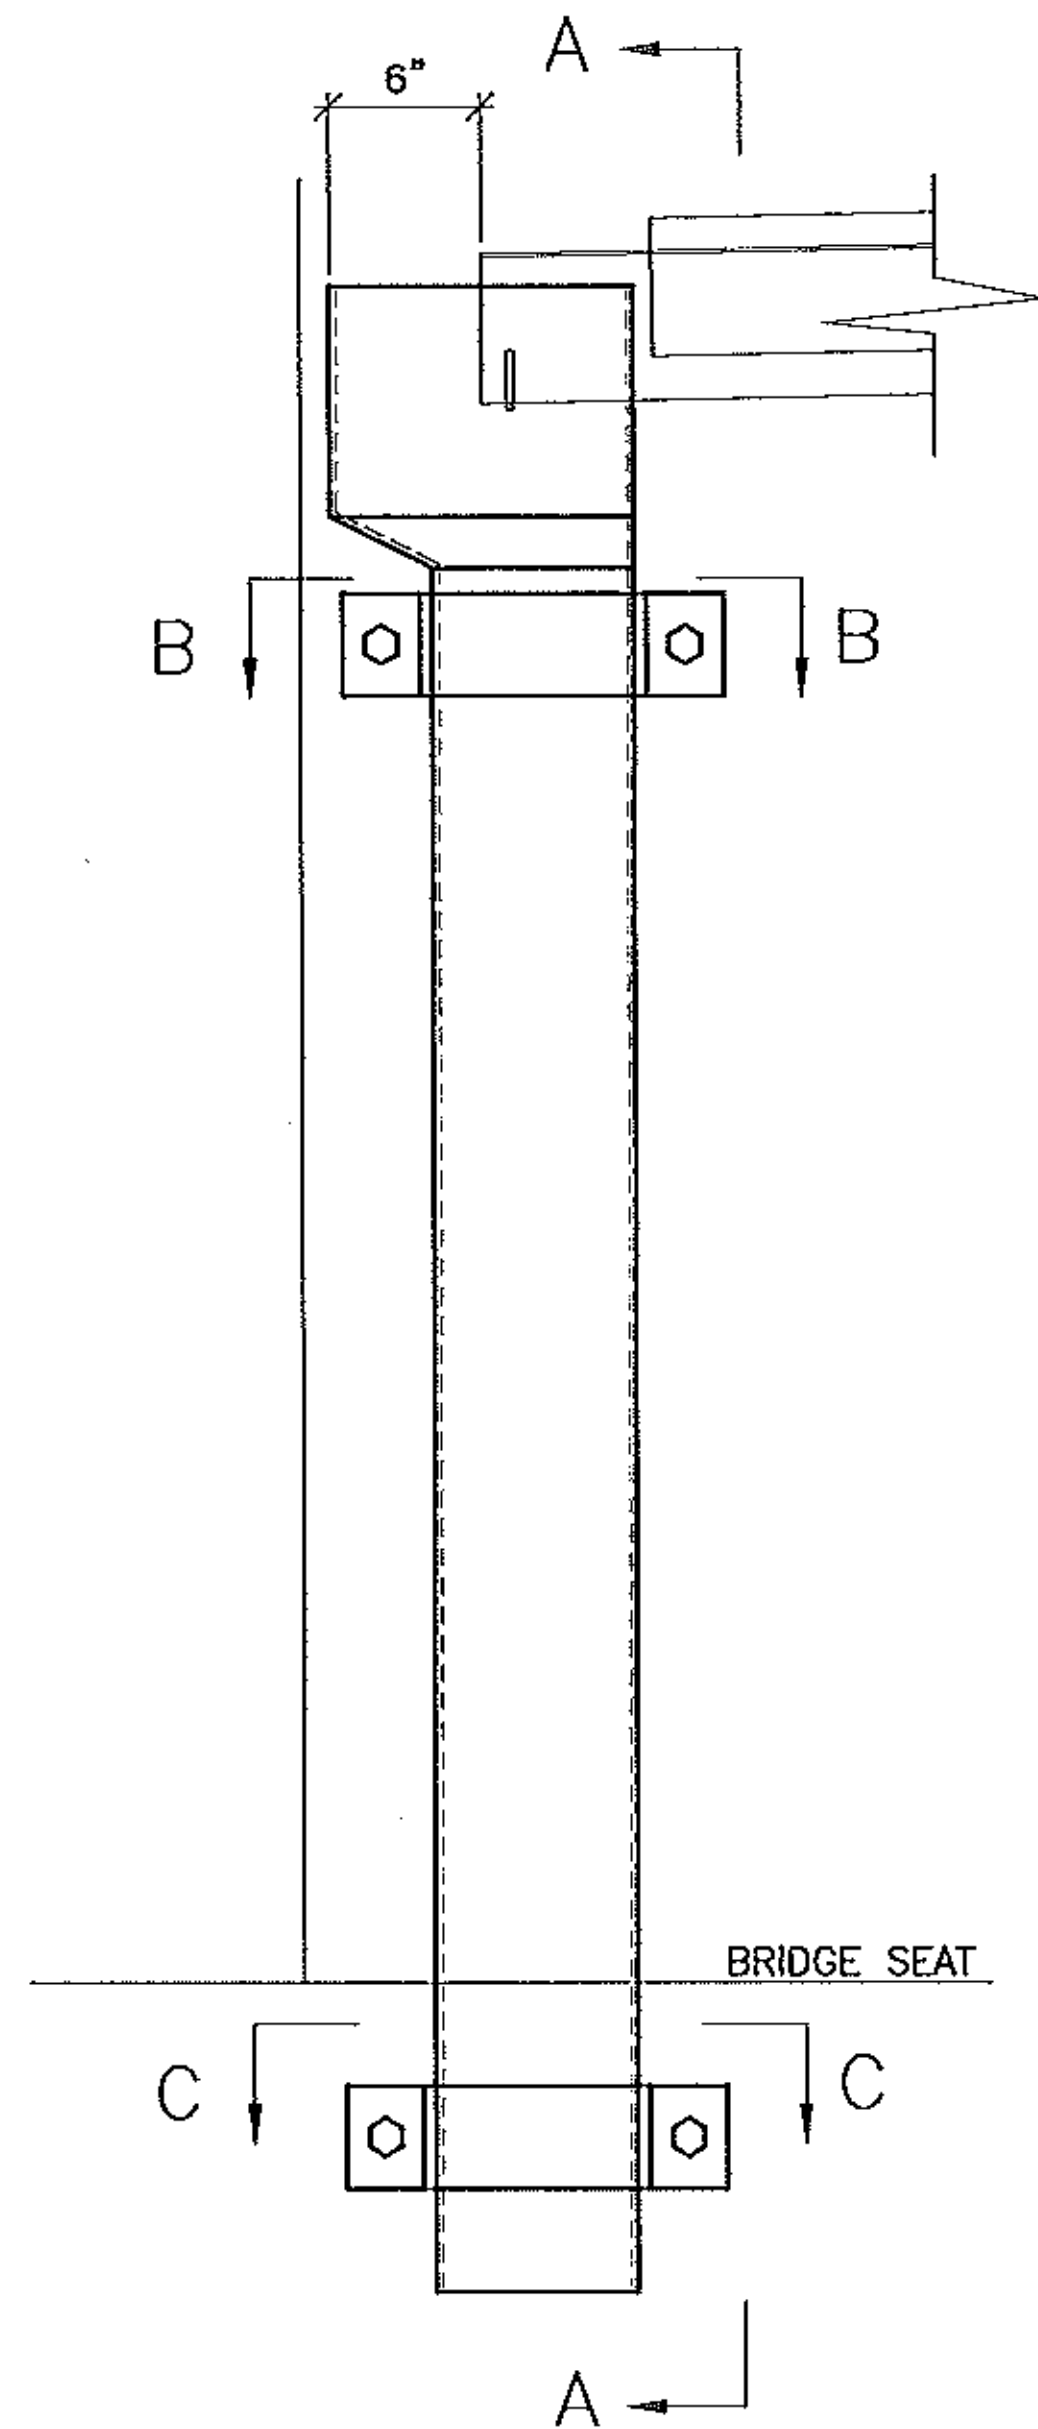


**DOWNSPOUT SIDE ELEVATION**  
(ONE LOCATION AS SHOWN, ONE LOCATION OPP. HAND)

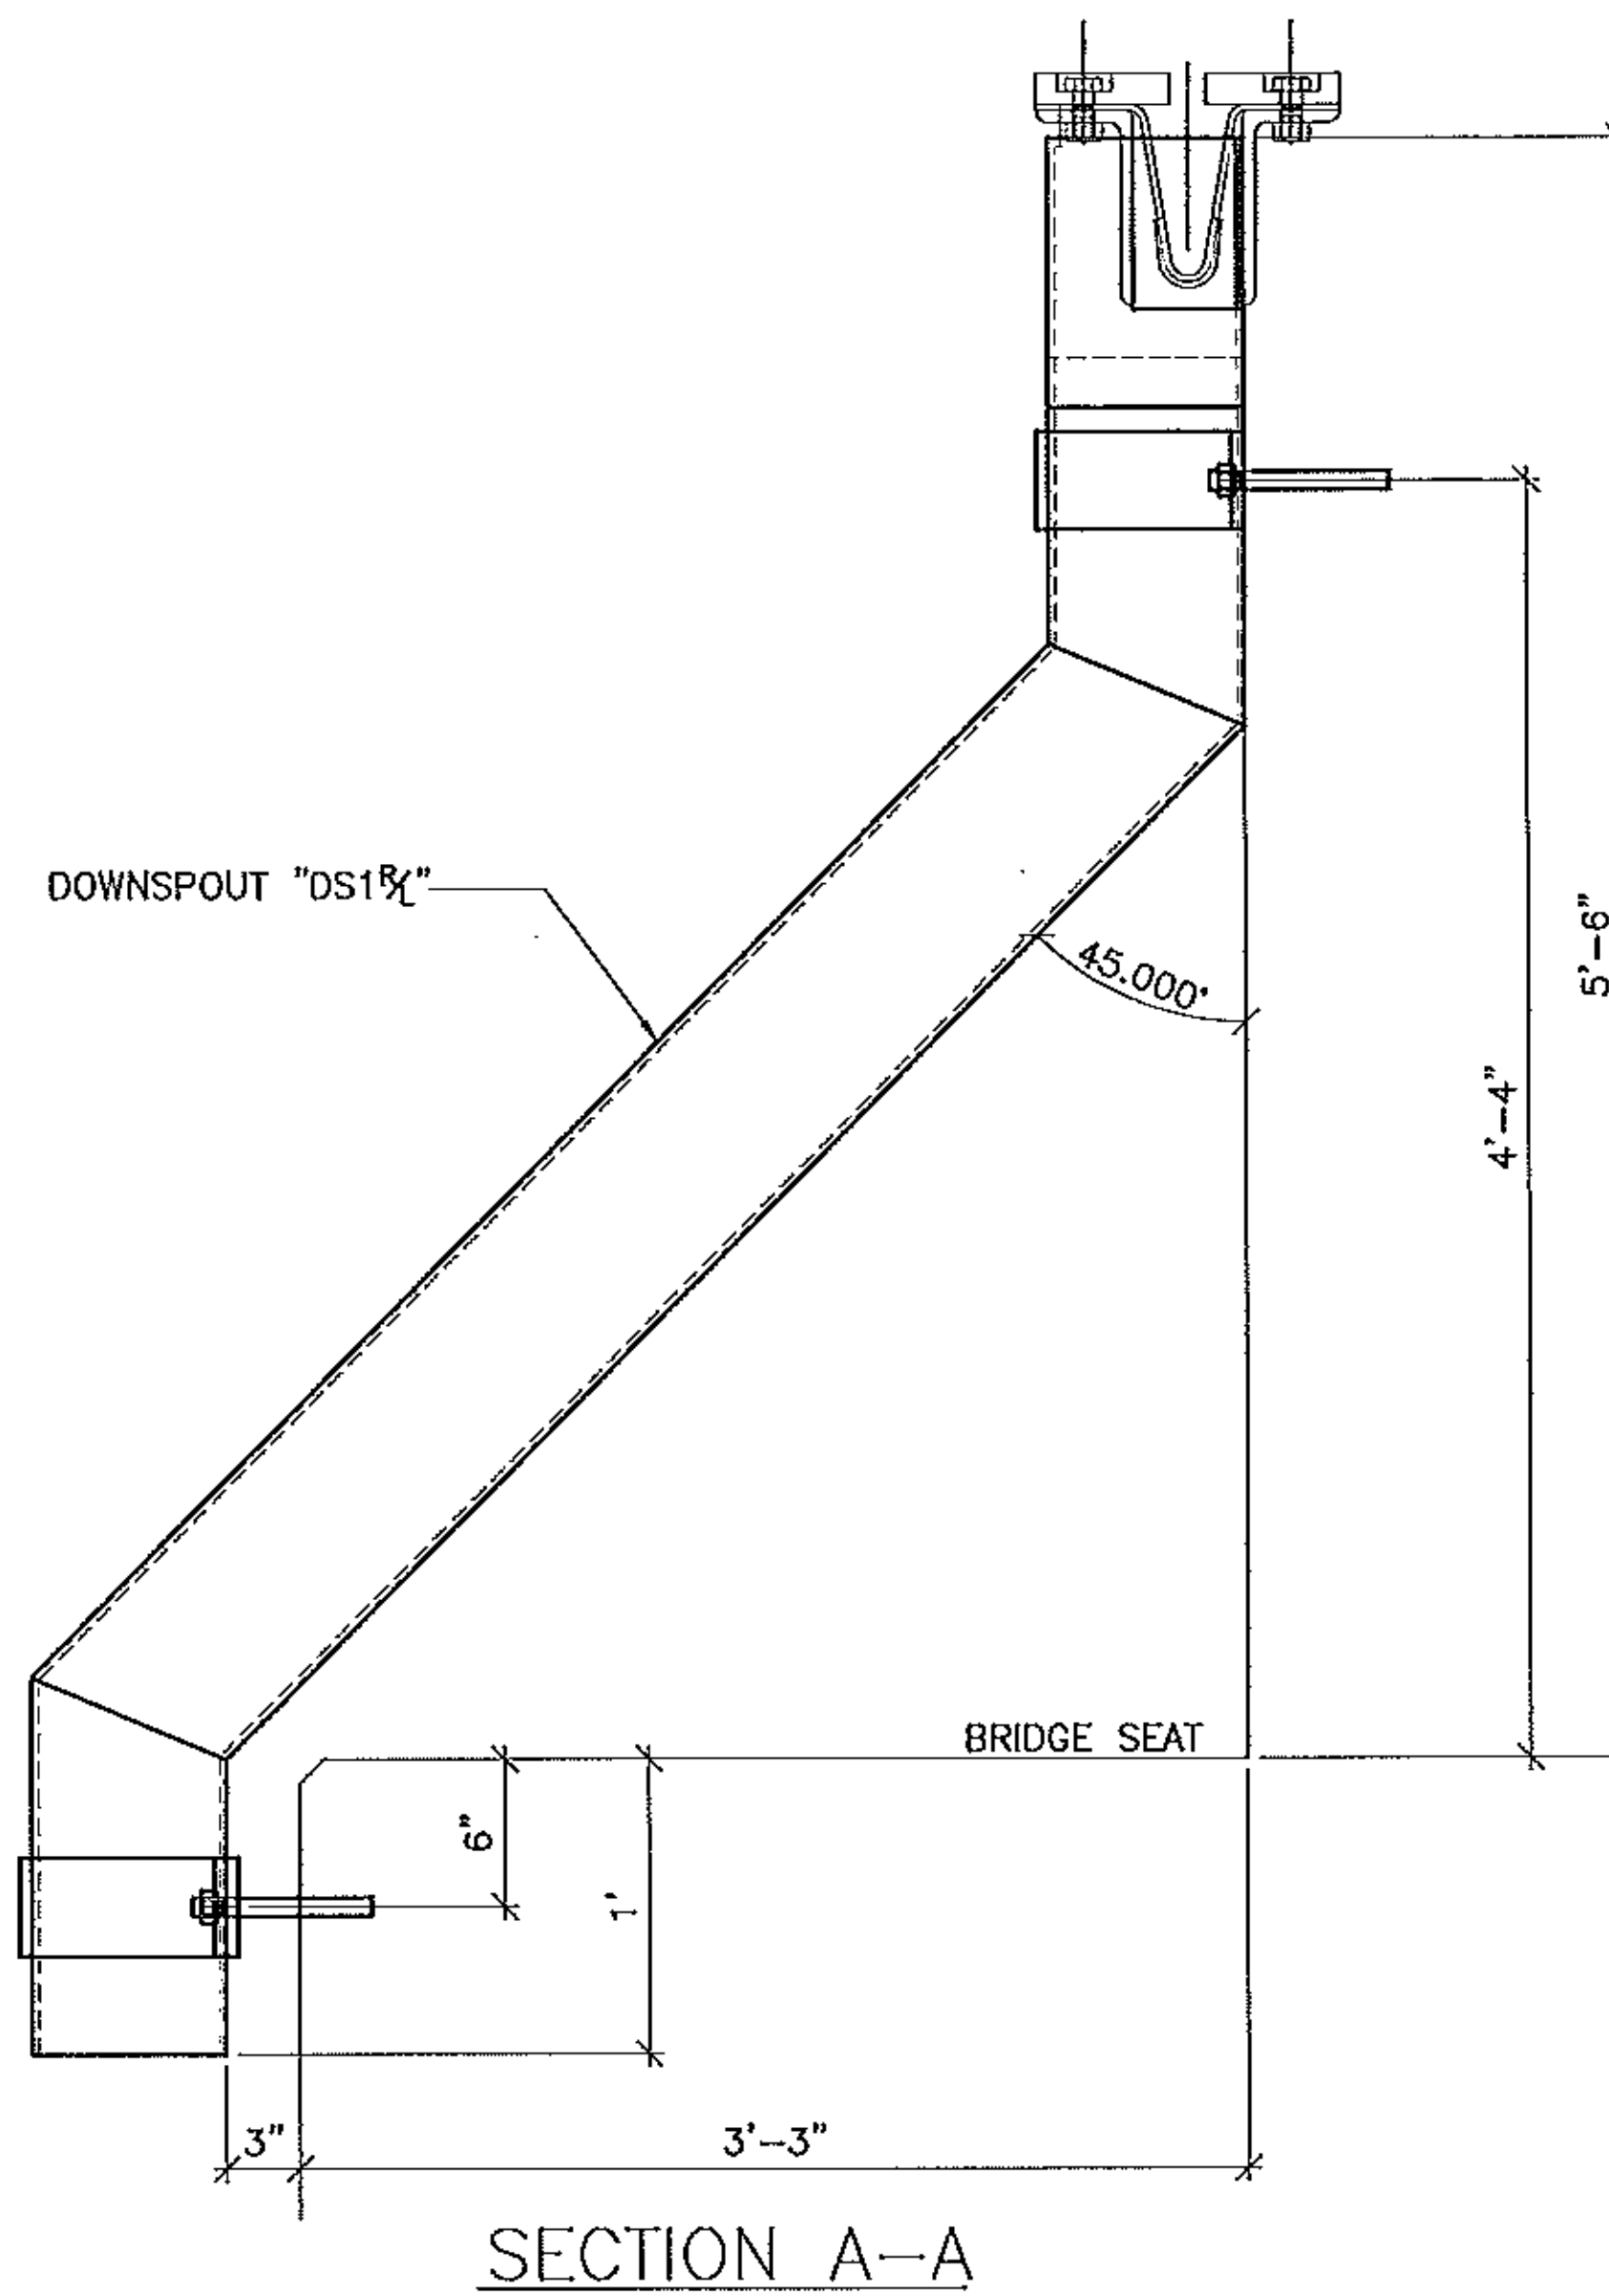

**SECTION A-A**

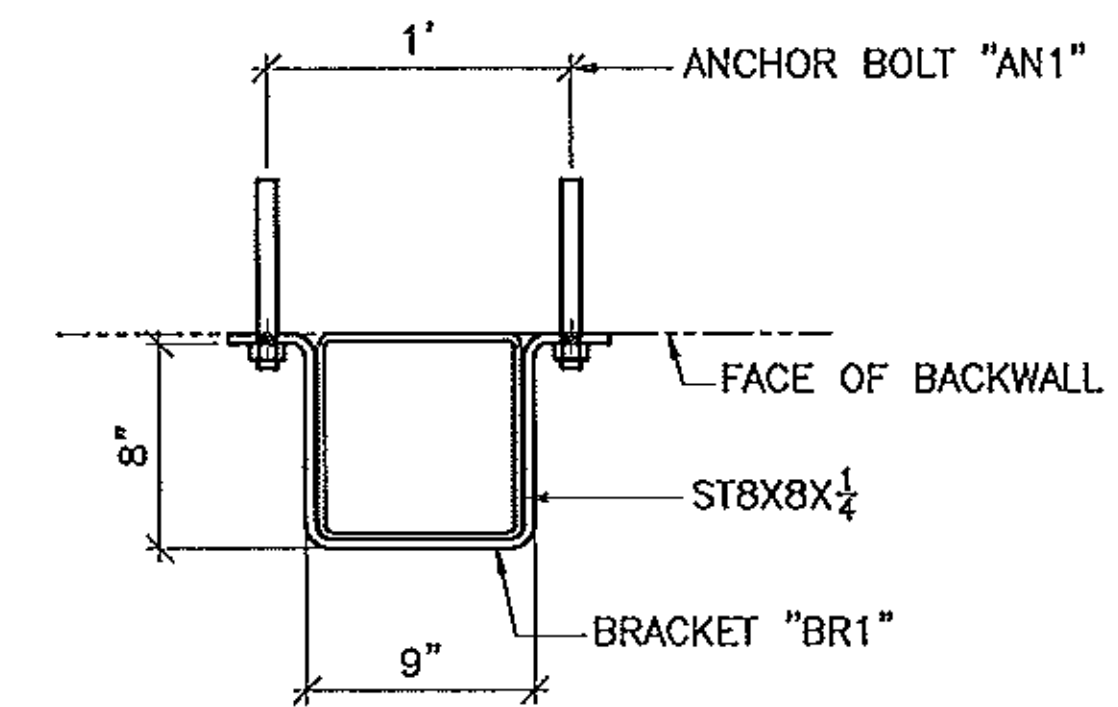

**SECTION B-B**

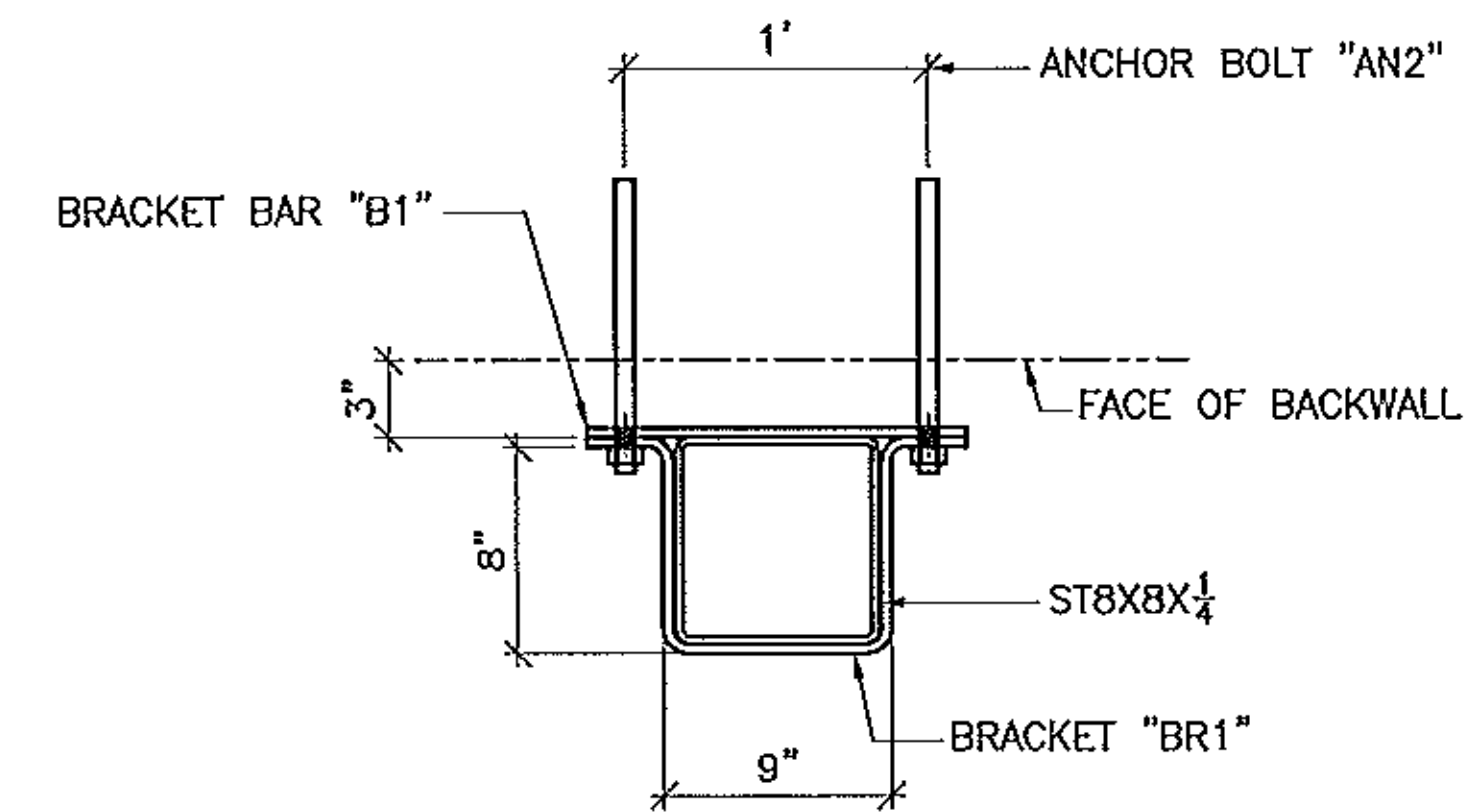

**SECTION C-C**


SEE DWG. 2 FOR DETAILS & B.O.M.


Vermont Agency of Transportation  
**RECEIVED**

CK'D BY MEM OK'D BY GFR


08/21/2012

RESUBMIT APPROVED X  
BY C. CARLSON DATE 08/29/2012


FINISH	HOT DIPPED GALVANIZED				
MATERIAL	AASHTO M270 GR. 36/ASTM A500 GR.B				
HOLES	AS NOTED				
ELECTRODES	PER W.P.S.				
WELDS	AS NOTED				
SURFACE PREP	SSPC-SP8				
		NO	DATE	DESCRIPTION	BY
REVISIONS					
 <b>ARC</b> ENTERPRISES, INC.		<b>ADVANCED RESOURCES &amp; CONST.</b> <b>ENTERPRISES, INCORPORATED</b> P.O. BOX 120 KINGFIELD, ME. 04947 PHONE: (207) 265-2646 - FAX: (207) 265-4054			
DRAFTER	JWC	DOWNSPOUT ERECTION DETAILS			PROJECT NO.
DATE	7/29/12	VERMONT AGENCY OF TRANSPORTATION, TOWN OF WOODFORD ABUTMENT #1 VI JOINT			OR REF 00-1(4)
CHECKED	MTD	G.C. T BUCK CONSTRUCTION, INC.			DWG. NO.
JOB	12-324				1

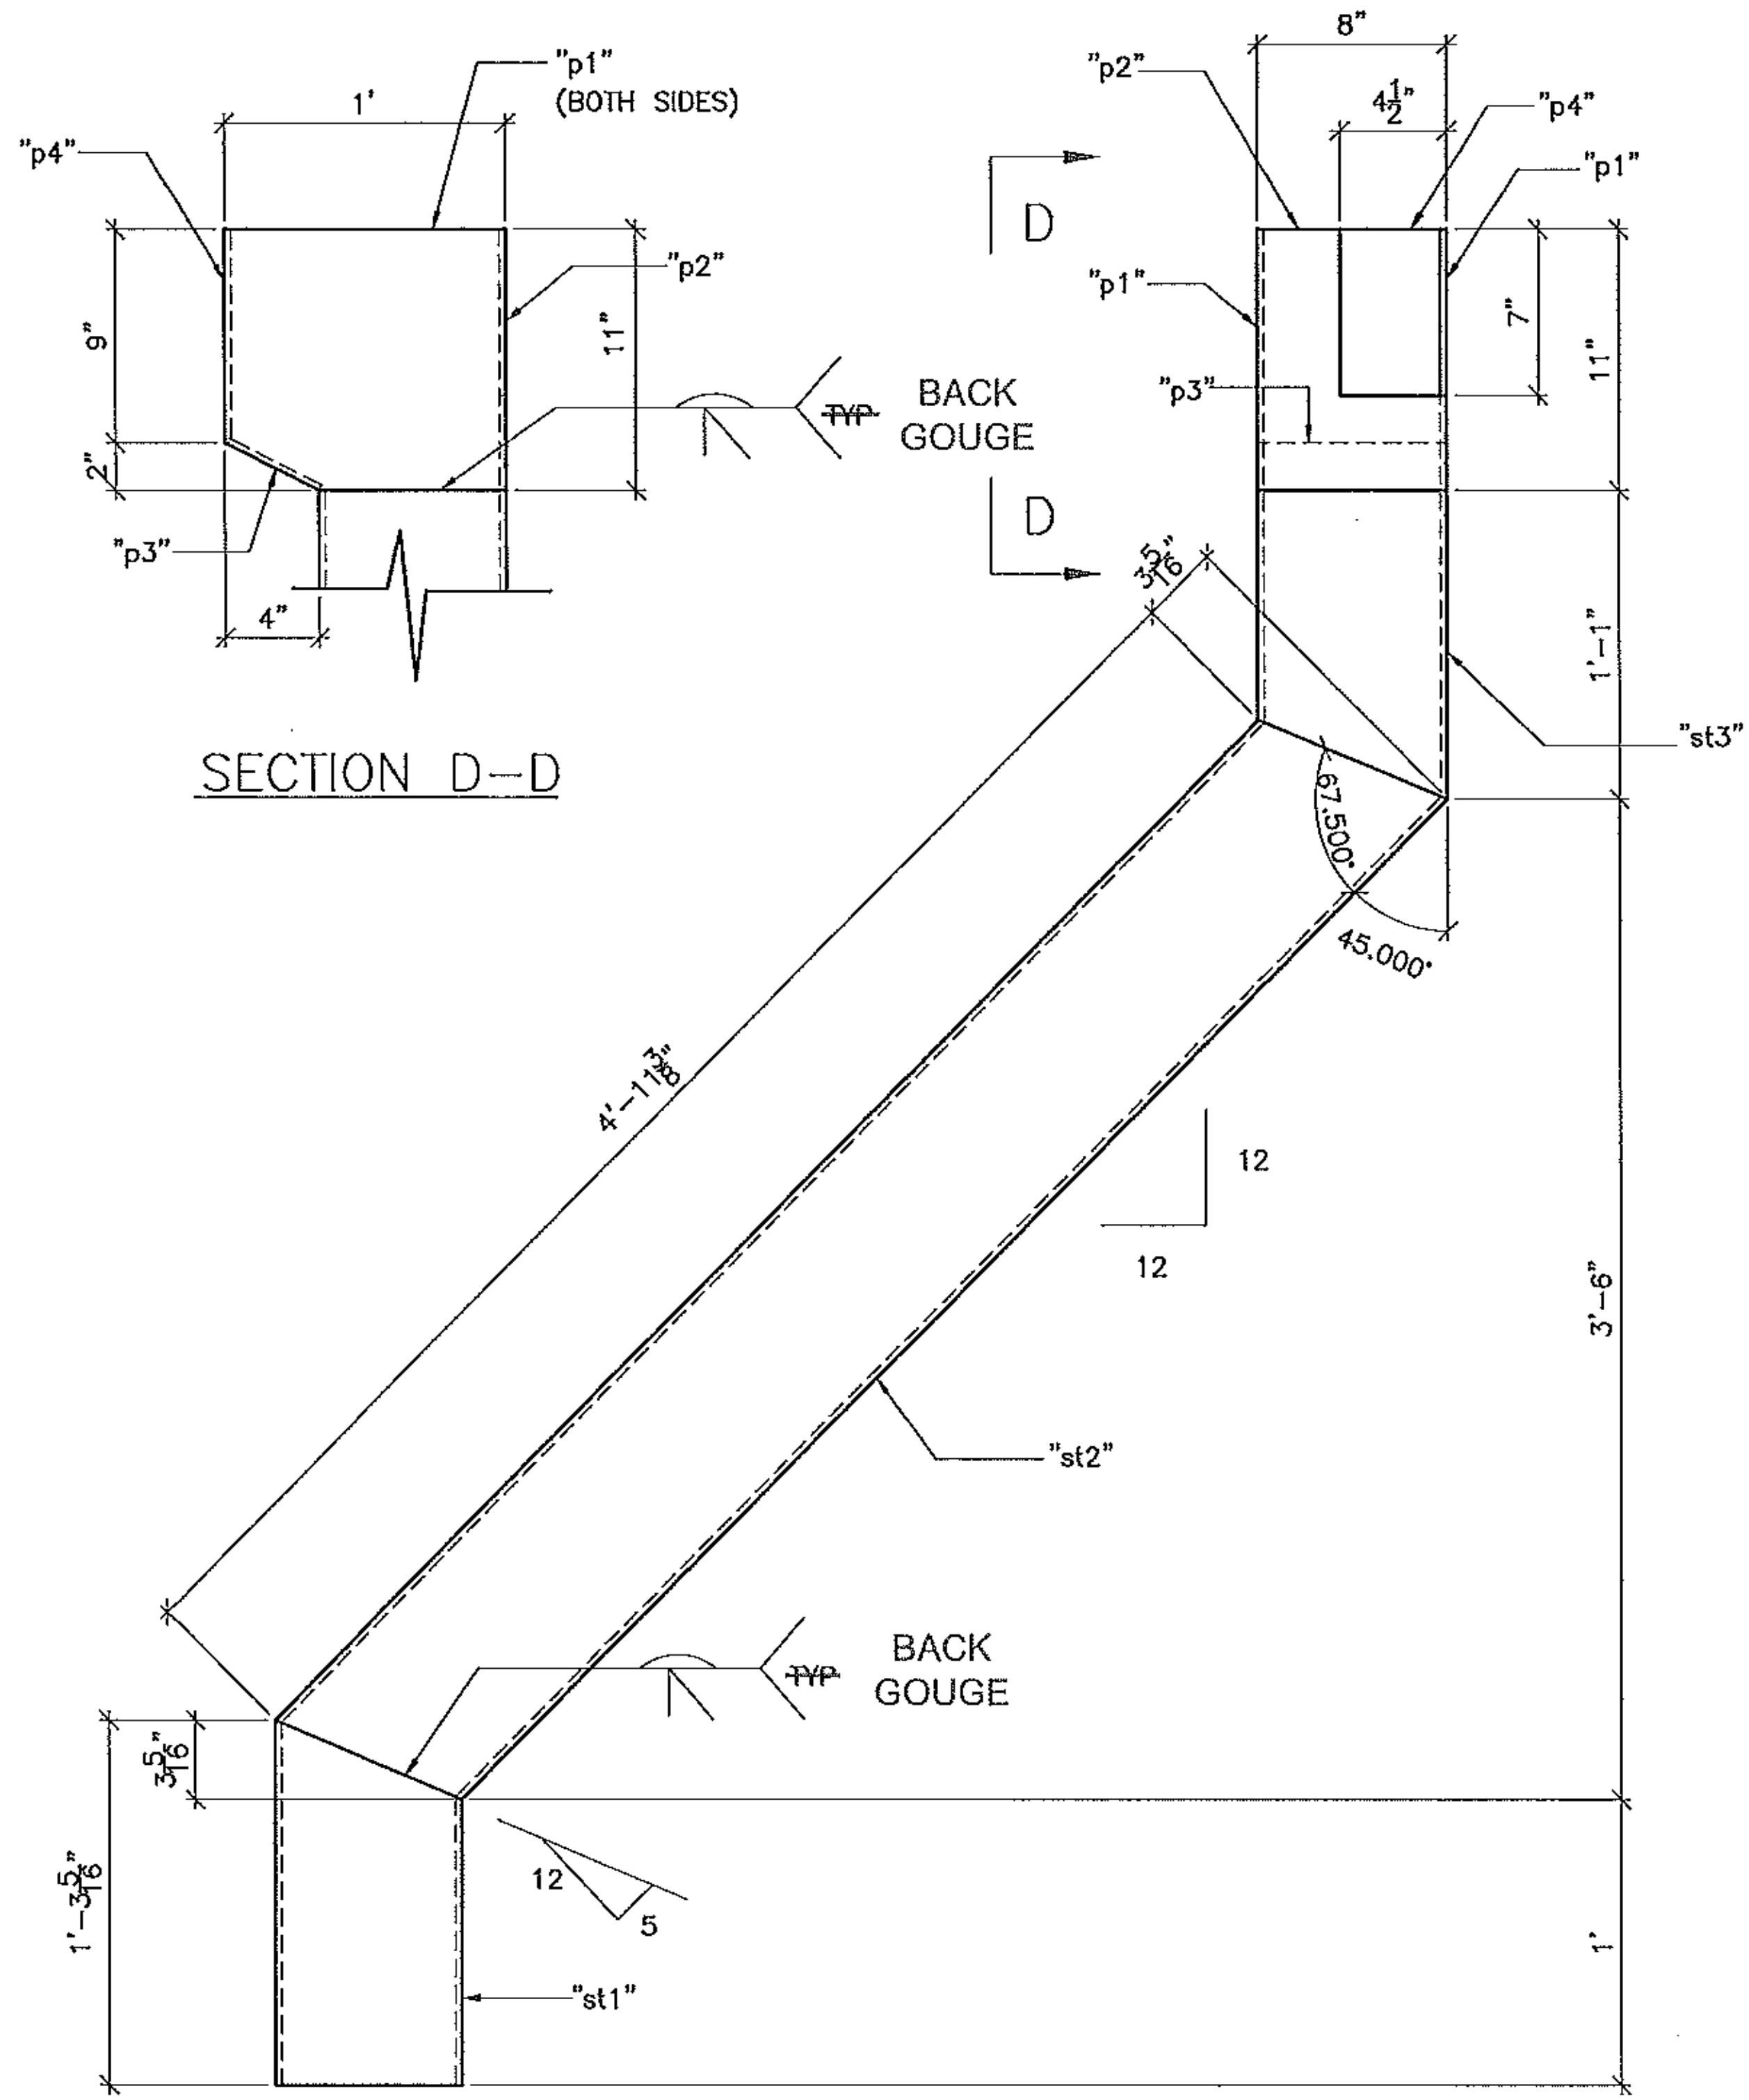

ONE REQ'D, DOWNSPOUT "DS1<sup>R</sup>", AS SHOWN  
 ONE REQ'D, DOWNSPOUT "DS1<sup>L</sup>", OPP. HAND

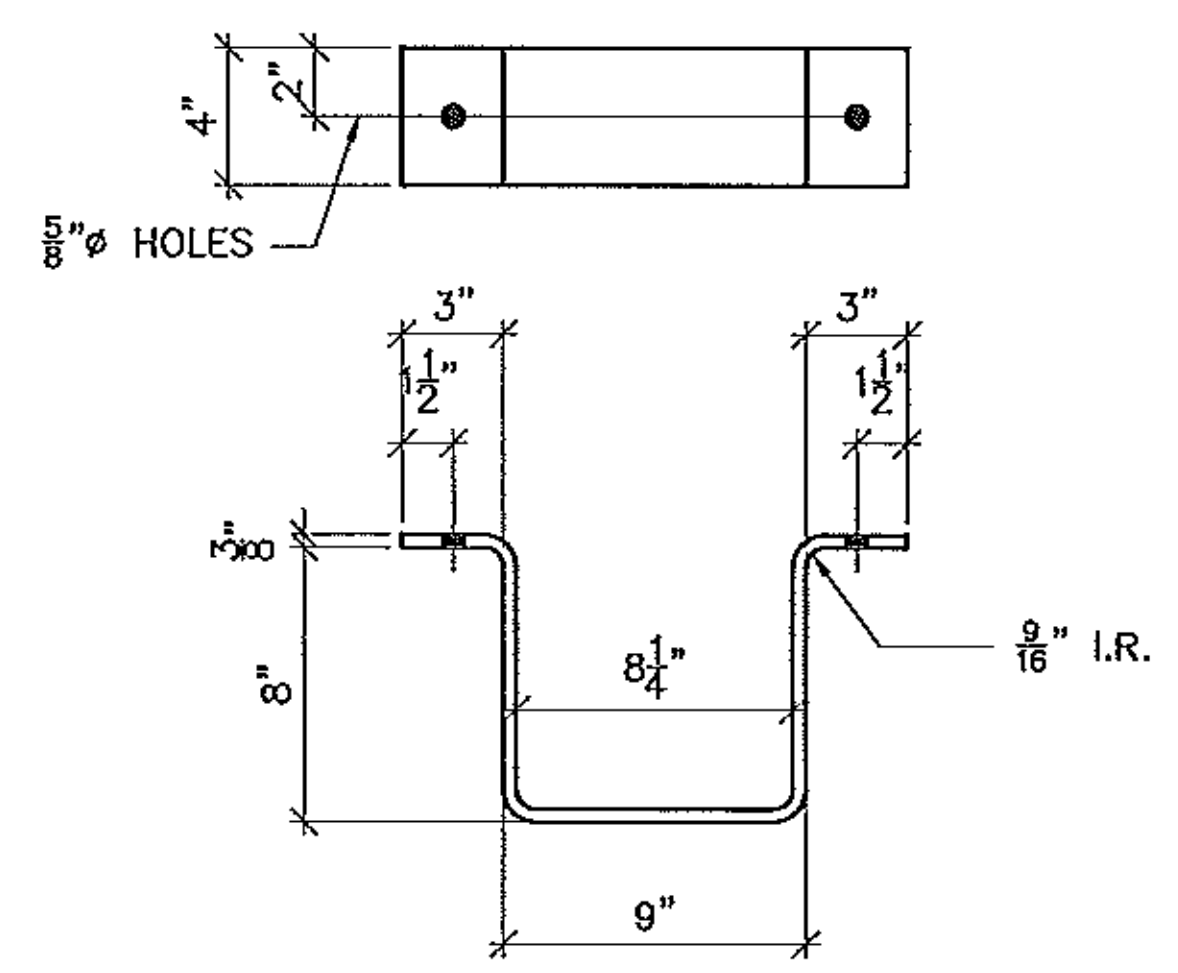

4 REQ'D, 3/8" BRACKET MARK "BR1"

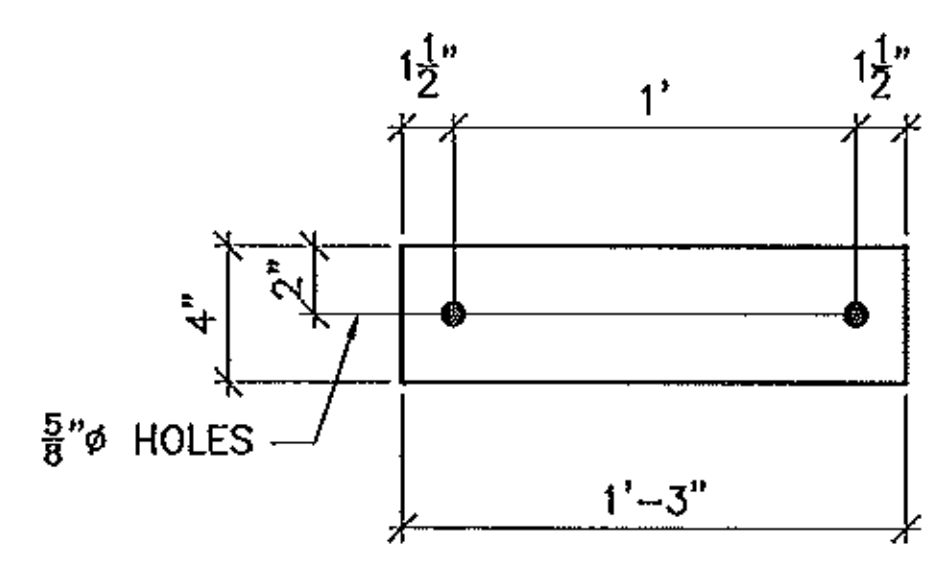

2 REQ'D, 3/8" BRACKET BAR MARK "B1"

**BILL OF MATERIAL**

SHIP	SHIP MARK	NO. PCS.	PIECE MARK	DESCRIPTION	LENGTH	REMARKS	WT.
2	DST1			DOWNSPOUT			
		2	st1	TS 8X8X 1/2	1'-3 5/8	ASTM A500	59
		2	st2	TS 8X8X 1/2	8'-2 1/8	ASTM A500	257
		2	st3	TS 8X8X 1/2	1'-1	ASTM A500	49
		4	p1	R 1/2X11	1'-0		36
		2	p2	R 1/2X7	0'-11		8
		2	p3	R 1/2X7	0'-4 5/8		5
		2	p4	R 1/2X7	0'-8 1/2		9
4	BR1			R 3/8X4	2'-8		51
2	B1			R 3/8X4	1'-3		13
4	AN1			1/2" ANCHOR BOLT	0'-8	W/N&W	
4	AN2			1/2" ANCHOR BOLT	1'-0	W/N&W	

Vermont Agency of Transportation  
**RECEIVED**

CHK'D BY MEM OK'D BY GFR  
 08/21/2012

RESUBMIT APPROVED AS NOTED  
 BY C. CARLSON DATE 08/29/2012

FINISH	HOT DIPPED GALVANIZED		
MATERIAL	AASHTO M270 GR. 36/ASTM A500 GR.B		
HOLES	AS NOTED		
ELECTRODES	PER W.P.S.		
WELDS	AS NOTED		
SURFACE PREP	SSPC-SP8	8/21/12	PER APPROVAL JAC
		NO DATE DESCRIPTION	BY



ADVANCED RESOURCES & CONST.  
 ENTERPRISES, INCORPORATED  
 P.O. BOX 120 KINGFIELD, ME. 04947  
 PHONE: (207) 265-2646 - FAX: (207) 265-4054

DRAFTER	JAC	DOWNSPOUT DETAILS	PROJECT NO.
DATE	7/28/12	VERMONT AGENCY OF TRANSPORTATION, TOWN OF WOODFORD	OR BIF 010-(4)
CHECKED	MTD	ADJUTMENT #1 VT JOINT	DWG. NO.
JOB	12-324	G.C. T BUCK CONSTRUCTION, INC.	2

State of Vermont  
Program Development  
One National Life Drive  
Montpelier, VT 05633-5001  
www.aot.state.vt.us

[phone] 802-828-2621  
[fax] 802-828-3566  
[ttd] 800-253-0191

Agency of Transportation

July 2, 2012

The D.S. Brown Company  
300 E. Cherry Street  
North Baltimore, Ohio 45872

Project Name: Woodford Project #: ER BHF 010-1(44)

Structure Identification: VT 9 Over the Roaring Branch of the Walloomsac River

The following bearing devices details for the above project (Vendor's Job #36775, transmitted by T. Buck Construction, Inc. and received by our office on Monday, June 25, 2012, have been reviewed and are being returned herewith.

Sheet 1 of 2 and the welding procedures are approved.


Sheet 2 of 2 is approved "as noted". (Please make appropriate changes as indicated on the "as noted" drawing and submit a new "\*.pdf" for our use in the record plans for this project.)

Also, the following is our response to the RFI that was submitted:

1. The natural rubber and the shear modulus range are fine.
2. The 16 GA internal shims are fine for the 1/16" thick internal shims shown on our plans.
3. The AASHTO M251-06 testing is required for this project.

You must provide notice to our fabrication inspector Jeff Clark as to the date fabrication represented by these drawings will begin. Jeff may be contacted by phone at (802)828-0044 or email at [jeff.clark@state.vt.us](mailto:jeff.clark@state.vt.us). That notice must be received at least seven days prior to that date, as per Specification 506.03. Any material fabricated prior to the notification date is subject to rejection without further cause.

Sincerely,

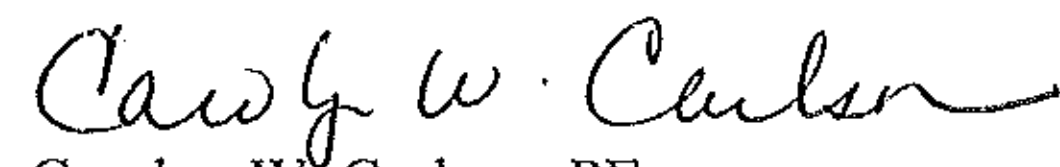

Carolyn W. Carlson, PE  
Project Manager

Attachments

cc:  Resident Engineer Ron Lemaire -w/prints  
 T. Buck Construction, Inc. - w/prints  
 Shop Inspector - Jeff Clark w/prints  
 Materials & Research Section (C&IA Unit) - Letter only  
 Construction Division - Letter only  
 CWC



DS Brown Company  
 300 East Cherry Street  
 North Baltimore, OH 45872  
 (419) 257-3561  
 (419) 257-0332 [Engineering Fax #]



**Request for Information**

Date Sent: 06-22-12

Response Requested by: ASAP

DS Brown RFI #: 36775-1104-RF1  
 (File name format: DS Brown Project # - Product Code - RFI# or #####-###-RFI#)

Contractor:	T Buck Construction
To:	Brian Emmons
Project Description:	Vt. Rt. 9, Principal Arterial
Project #:	ER-BHF 010-1(44)
Fax #:	
DS Brown Project #:	36775-1104
Reply to:	Erica Kelley
E-mail Address:	ekelley@dsbrown.com
Subject:	Elastomeric bearings

**Shop Drawing Status:**

- Able to Proceed
- Able to Proceed BUT requested information needed prior to drawing submittal
- ON HOLD** until receipt of requested information

**Please provide the following items:**

- Special Provisions
- Field Measurements (sketch provided—please complete)
- Structural Steel Drawings
- "As Built" Shop Drawings
- Finish Details
  - Federal Color Number
  - Paint System
- Contract Document Clarification (explanation provided below)
- Other (explanation provided below)

**Explanation:** 1) The contract plans specify the elastomer to be Grade 4 Neoprene. DS Brown does not have a compound for a neoprene grade 4 material. If a grade 4 material is needed, then the bearing will need to be supplied as natural rubber. Also, note our 60 durometer Grade 4 natural rubber has a shear modulus range of 136-184 PSI. Please verify that natural rubber and this shear modulus are acceptable.

2) Please note that thin steel is only available in gauge thickness. We will use 16 GA internal shims for the 1/16" shown. 16 GA is 0.60" thick. If you require this to be increased the next available GA is 14 GA which is 0.075" thick.

3) Please verify that Testing to AASHTO M251-06 is required.

OK

0.06 OK

1/16" = 0.0625"  
 14 GA = 0.075"  
 16 GA = 0.060"



# Production Joint Welding Procedure Specification (D1.5-08)

Procedure No: A-(MC)GF-01 Date Issued: 9-28-04 Revision No: 02 Rev. Date: 9-15-09


Contractor (Fabricator) D. S. Brown Company Prepared by: Brad Streefer, Quality Assurance Manager

1. Non-Fracture Critical  Fracture Critical  WPS Expiration Date: 8-11-14
2. Qualified in accordance with: AWS D1.5- 2008 (5.13)  
 Referenced PQR No(s). PQR-(MC)GMAW-03(09) , ,  
 Referenced FWST No(s). PQR-(MC)GMAW-FWST-01A(09) , PQR-(MC)GMAW-FWST-01B(09) , ,
3. Material specification(s) ASTM A709 Gr. 36, 50, 50W
4. Material Thickness (es) Unlimited
5. Welding process GMAW
6. Manual  , machine  , or semiautomatic
7. Position(s) of welding 1F, 2F
8. Filler metal specification AWS A5.18
9. Filler metal class and brand name E70C-6M Corex Metal-Core Maxim
10. Flux class & brand N/A , Type N/A
11. Shielding gas 75% Ar / 25% CO2 Flow rate 45 CFH
12. Single pass  Or multiple pass
13. Single arc  Or multiple arc
14. Welding Current DCEP
15. Polarity Reverse
16. Welding progression stringers
17. Root treatment Clean to bright sound metal or per AWS D1.5 (3.2.1 & 3.11)
18. Postheat treatment N/A
19. Calculated Heat Input (KJ/In) Min 34.77 KJ/in Max 49.65 KJ/in
20. Electrode extension (electrical stickout) 3/4"

For DOT Approval

VTrans Received OK'd BY JWC  
 JUN 26 2012  
 Resubmit APPROVED BY [Signature] DATE 7/19/12

Weld size (In)	Pass No(s)	Electrode Size (In)	Welding Process Variables		Travel Speed (IPM)
			AMPS/WFS*	VOLTS	
**1/4"	1	.052"	270-307	27.9-31	11.5-13
5/16"	1	.052"	270-307	27.9-31	11.5-13
3/8"	1-3	.052"	270-307	27.9-31	11.5-13
7/16"	2-4	.052"	270-307	27.9-31	11.5-13
1/2"	4-6	.052"	270-307	27.9-31	11.5-13
5/8"	5-7	.052"	270-307	27.9-31	11.5-13
3/4"	6-8	.052"	270-307	27.9-31	11.5-13

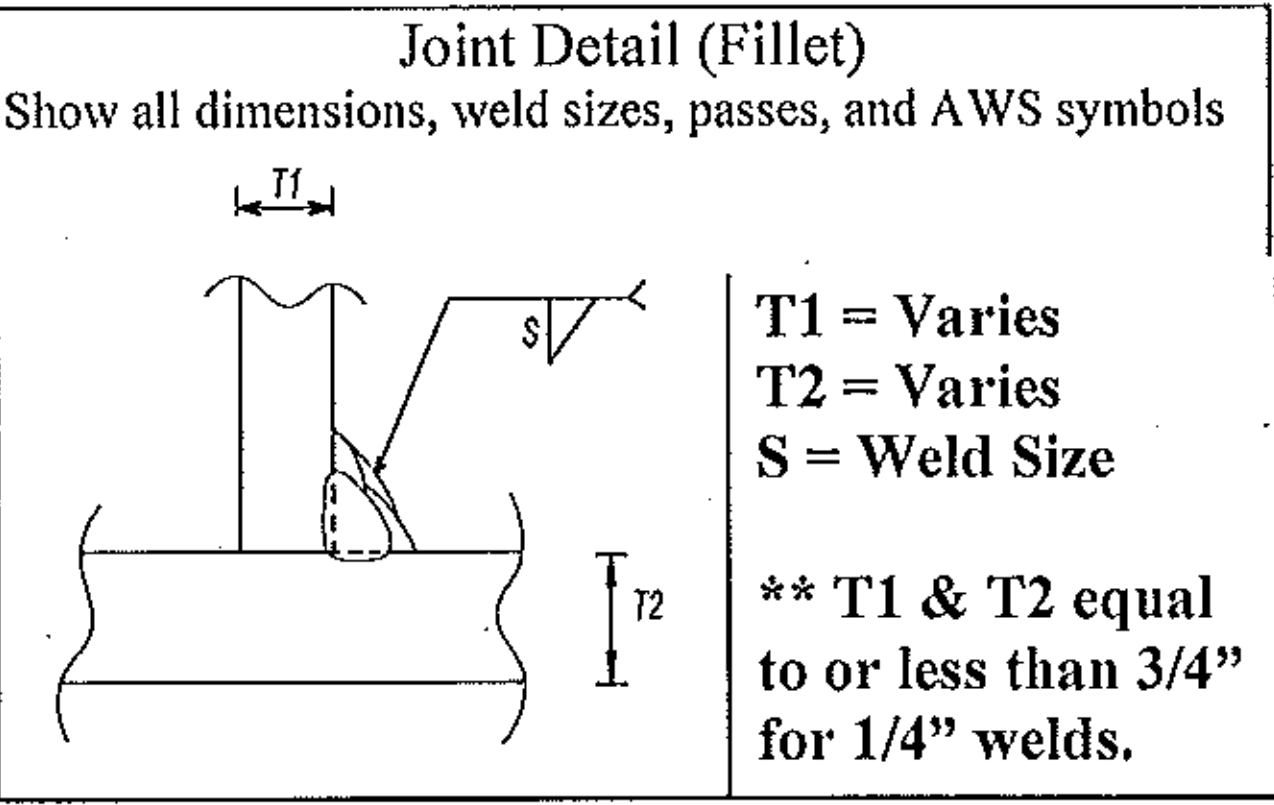

\* Wire feed speed may be used along with amperage (include chart)

Prepared By: [Signature] DSB QA Manager

Project: \_\_\_\_\_

DSB Job: 36775-1104-VT

Base Metal Thickness range	Minimum Preheat (°F)	Max Preheat & Interpass (°F)
≤ 3/4"	50°F	450°F
>3/4" to ≤1.5"	70°F	450°F
>1.5" to ≤2.5"	150°F	450°F
>2.5"	225°F	450°F

Note: When this procedure is used for A709Gr50W materials, it shall be limited to 5/16" single pass or material be coated.



# Production Joint Welding Procedure Specification (D1.5-08)

Procedure No: B-FF-01 Date Issued: 3-28-08 Revision No: 01 Rev. Date: 11-11-09


Contractor (Fabricator) D. S. Brown Company Prepared by: Brad Streefer, Quality Assurance Manager

1. Non-Fracture Critical  Fracture Critical  WPS Expiration Date: 3-6-13
2. Qualified in accordance with: AWS D1.5- 2008 (5.13)  
 Referenced PQR No(s). PQR-FCAW-01-(08)  
 Referenced FWST No(s). PQR-FCAW-FWST-01A(08) , PQR-FCAW-FWST-01B(08)
3. Material specification(s) ASTM A709 Gr. 36, 50, 50W
4. Material Thickness (es) Unlimited
5. Welding process FCAW
6. Manual  , machine  , or semiautomatic
7. Position(s) of welding 1F, 2F
8. Filler metal specification AWS A5.20
9. Filler metal class and brand name E71T-1CH8 (UltraCore71C)
10. Flux class & brand N/A , Type N/A
11. Shielding gas. 100% CO2 Flow rate 45 CFH
12. Single pass  Or multiple pass
13. Single arc  Or multiple arc
14. Welding Current DCEP
15. Polarity Reverse
16. Welding progression stringers
17. Root treatment Clean to bright sound metal or per AWS D1.5 (3.2.1 & 3.11)
18. Postheat treatment N/A
19. Calculated Heat Input (KJ/In) Min 32.2 KJ/in Max 45.8 KJ/in
20. Electrode extension (electrical stickout) 3/4"

For DOT Approval

VITANS  
 Received  
 OK'd BY: JWC  
 JUN 26 2012  
 Resubmit  
 BY: \_\_\_\_\_  
 APPROVED  
 DATE: 7/2/12

Weld size (In)	Pass No(s)	Electrode Size (In)	Welding Process Variables		Travel Speed (IPM)
			AMPS/WFS*	VOLTS	
**1/4"	1	1/16"	257-295	26.1-29.5	11.4-12.5
5/16"	1	1/16"	257-295	26.1-29.5	11.4-12.5
3/8"	2-3	1/16"	257-295	26.1-29.5	11.4-12.5
7/16"	3-5	1/16"	257-295	26.1-29.5	11.4-12.5
1/2"	4-6	1/16"	257-295	26.1-29.5	11.4-12.5
5/8"	5-7	1/16"	257-295	26.1-29.5	11.4-12.5
3/4"	6-8	1/16"	257-295	26.1-29.5	11.4-12.5

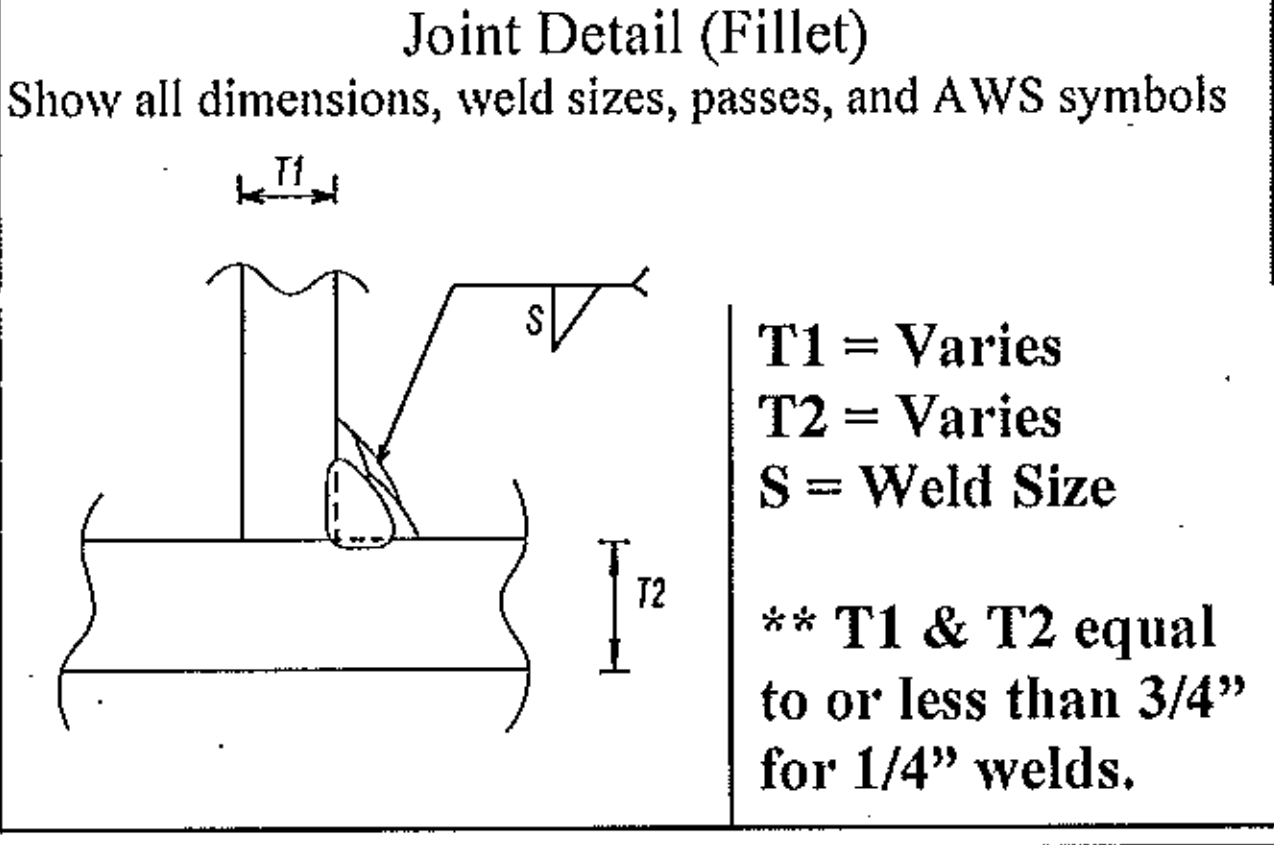

\* Wire feed speed may be used along with amperage (include chart)

Prepared By: [Signature] DSB QA Manager

Project: \_\_\_\_\_

DSB Job: 36775-1104-VT

Base Metal Thickness range	Minimum Preheat (°F)	Max Preheat & Interpass (°F)
≤ 3/4"	50°F	450°F
>3/4" to ≤1.5"	70°F	450°F
>1.5" to ≤2.5"	150°F	450°F
>2.5"	225°F	450°F


Note: When this procedure is used for A709Gr50W materials, it shall be limited to 5/16" single pass or material be coated.

**GENERAL NOTES:**

- PAD AND MATERIALS SHALL CONFORM TO STATE OF VERMONT, AGENCY OF TRANSPORTATION STANDARD SPECIFICATIONS FOR CONSTRUCTION, DATED 2006 AND THE LATEST REVISIONS, AND THE AASHTO LRFD BRIDGE DESIGN SPECIFICATIONS, FOURTH EDITION, DATED 2007, AND ITS LATEST REVISIONS, CONTRACT PLANS, AND THE SPECIAL PROVISIONS. GENERAL SHOP PRACTICES, STRUCTURAL FABRICATION, WELDING AND ASSEMBLY SHALL BE GOVERNED BY AWS/AASHTO/AWS D1.5 BRIDGE WELDING CODE.
- THESE SHOP DRAWINGS ARE PREPARED IN ACCORDANCE WITH THE CONTRACT PLANS AND SPECIFICATIONS. THE D.S. BROWN COMPANY DOES NOT ACCEPT LIABILITY FOR THE DESIGN OF THE PRODUCTS DETAILED IN THESE SHOP DRAWINGS.
- THE D.S. BROWN COMPANY TO SUPPLY ONLY THE PARTS SHOWN ON THESE DRAWINGS.
- ALL STEEL SHALL BE PRODUCED IN THE UNITED STATES OF AMERICA.
- THE BEARING SHALL BE SUBJECT TO RANDOM IN-HOUSE ELASTOMER TESTING AND IN-HOUSE PROOF LOAD TESTING IN ACCORDANCE WITH AASHTO DIVISION I, SECTION 14 (METHOD "A") AND AASHTO DIVISION II, SECTION 18.
- THE TEMPERATURE OF THE STEEL ADJACENT TO THE ELASTOMER SHALL NOT EXCEED 93°C (200°F). TEMPERATURE SHALL BE CONTROLLED BY THE USE OF A TEMPERATURE INDICATING CRAYON OR OTHER DEVICES APPROVED BY THE ENGINEERS.
- ALL CORNERS AND EDGES OF STEEL PLATES SHALL BE GROUND TO A 0.063" RADIUS.
- ALL STRUCTURAL STEEL SURFACES TO BE METALIZED SHALL BE CLEANED IN ACCORDANCE WITH SSPC-SP5.
- ALL SPECIFIED STEEL TO BE ZINC METALIZED IN ACCORDANCE WITH AWS C 2.18 SPECIFICATIONS TO A MINIMUM THICKNESS OF 6 MILS. THE COATING SHALL CONSIST OF 99.9% PURE ZINC (MINIMUM PURITY). THE METALIZATION SHALL OCCUR AFTER THE VULCANIZATION PROCESS. THE FIRST COATING SHALL BE APPLIED WITHIN ONE HOUR OF BLAST CLEANING AND THE SURFACE MUST BE COMPLETELY COATED TO THE SPECIFIC THICKNESS WITHIN TWO HOURS OF BLASTING. EXTERIOR SURFACES SHALL BE SEALED WITH CARBOUNE SEALER "RUSTABOND" WITH A MINIMUM DRY FILM THICKNESS 2 MILS. SEE COATING LIMITS FOR LOCATIONS. REPAIR DAMAGED METALIZATION PER ASTM A780.
- TESTING SHALL BE IN ACCORDANCE WITH AASHTO M251.

TOLERANCE TABLE	
DESCRIPTION	TOLERANCE
OVERALL VERTICAL DIMENSION	+ 1/8", -0
ELASTOMERIC BEARING DESIGN THICKNESS > 1.250"	+ 1/4", -0
ELASTOMERIC BEARING PLAN ≤ 36"	+ 1/4", -0
ELASTOMERIC COVER TOP & BOTTOM	+ 1/8", -0
ELASTOMERIC COVER SIDES	+ 1/8", -0
THICKNESS OF INDIVIDUAL LAYERS OF ELASTOMER (LAMINATED BEARINGS ONLY) AT ANY POINT WITHIN THE BEARING	± 1/8"
VARIATION FROM A PLANE PARALLEL TO THE THEORETICAL SURFACE (AS DETERMINED BY MEASUREMENTS AT THE EDGE OF THE BEARINGS)	
TOP	0.005 RAD
SIDES	± 1/4"
POSITION OF EXPOSED CONNECTION MEMBERS	± 1/8"
EDGE COVER OF EMBEDDED LAMINATES OF CONNECTION MEMBERS	+ 1/8", -0
SIZE OF HOLES, SLOTS, OR INSERTS	± 1/8"
POSITION OF HOLES, SLOTS, OR INSERTS	± 1/8"
MASONRY PL. PLAN DIMENSIONS	± 1/4"
MASONRY PL. UNDERSIDE SURFACE FLATNESS	CLASS C
MASONRY PL. UPSIDE SURFACE FLATNESS	CLASS A
MASONRY PL. THICKNESS	± 1/16"
HOLE & SIZE LOCATION	± 1/16"
SOLE PL. PLAN DIMENSIONS	± 1/16"
SOLE PL. UNDERSIDE SURFACE FLATNESS	CLASS A
SOLE PL. UPSIDE SURFACE FLATNESS	CLASS C
SOLE PL. BEVEL SLOPE	± 0.002 RAD
SOLE PL. THICKNESS	± 1/16"
MASONRY & SOLE PLATE SURFACE FINISH (BEARING SIDE)	125 RMS

FLATNESS TOLERANCE	
CLASS	X NOM. DIM.
A	0.001
B	0.002
C	0.005

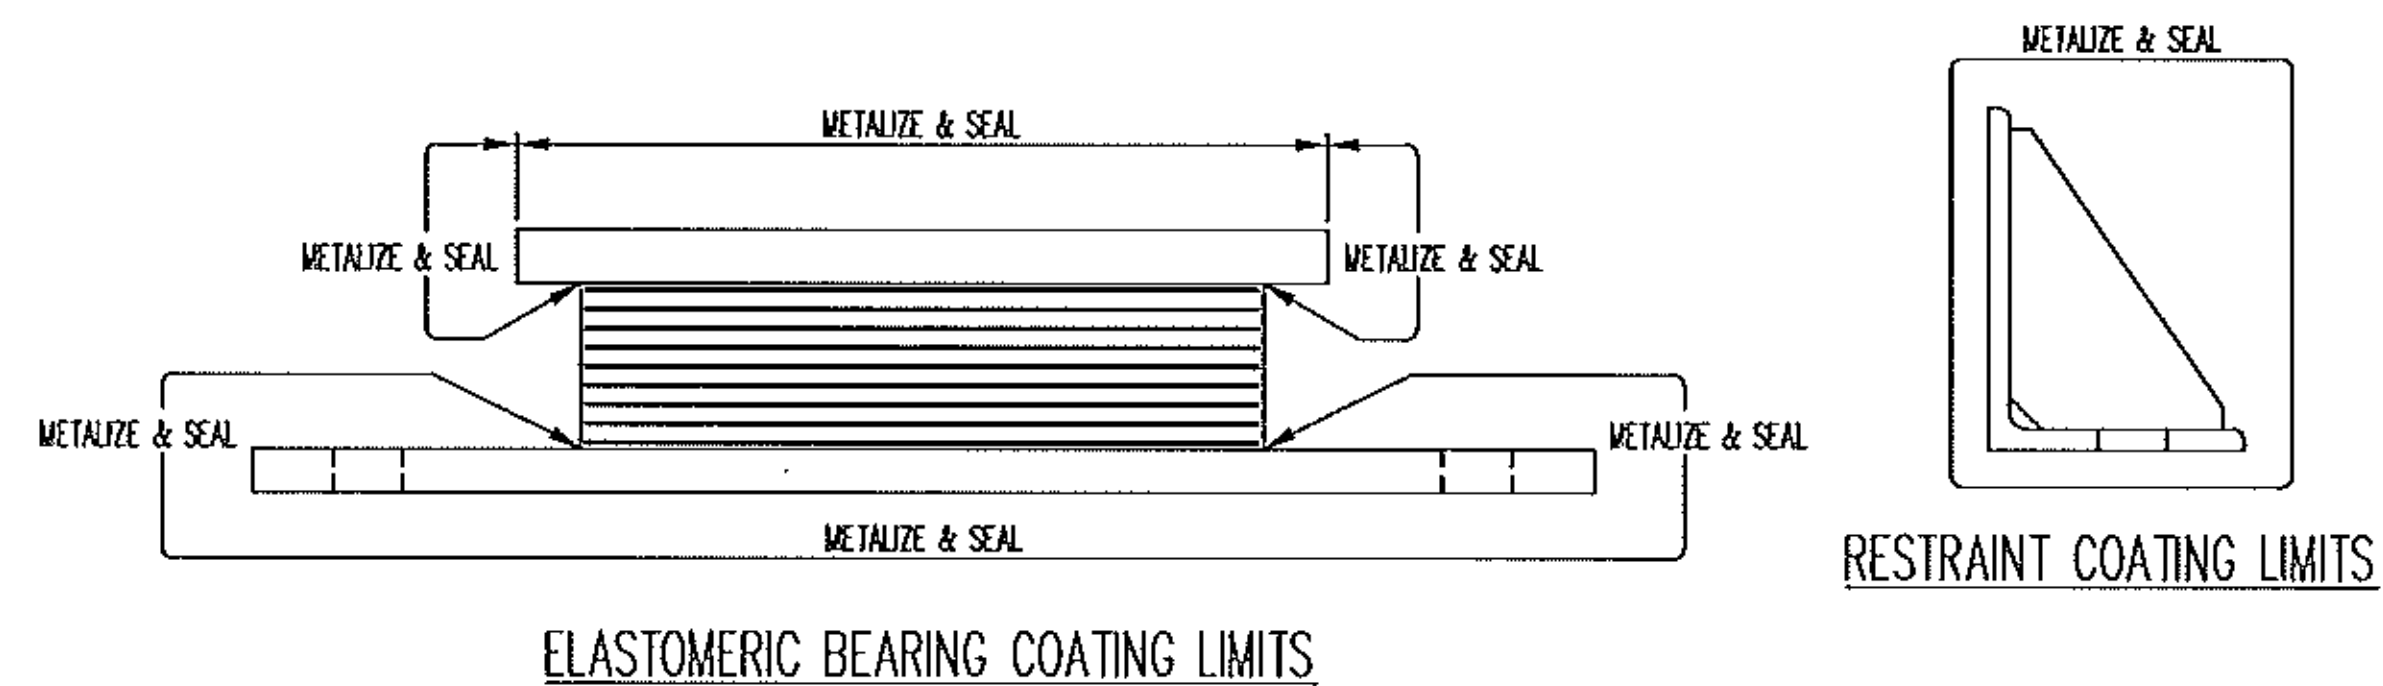

Vermont Agency of Transportation  
**RECEIVED**  
 CK'D BY CAM OK'D BY GFR  
 06/22/2012  
 RESUBMIT APPROVED X  
 BY C. CARLSON DATE 06/29/2012

**D.S. BROWN**  
 THE D.S. BROWN COMPANY  
 300 E. CHERRY STREET  
 NORTH BALTIMORE, OHIO 45872  
 419.257.3561  
 FAX: 419.257.0332  
 WWW.DSBROWN.COM

REV.	DESCRIPTION	DATE	DET. CKD.
	LOCATION — VT RT 9, PRINCIPAL ARTERIAL		
	BRIDGE — 11		
	PROJECT — ER BHF 010-(44)		
	DESIGNER — VT AGENCY OF TRANSPORTATION		
	CUSTOMER — T BUCK CONSTRUCTION, INC.		
	GENERAL NOTES AND COATING LIMITS		
	BENNINGTON CO., VT		

SCALE	PLUM PER SP	CHANG BY	DATE	QUANTITY
N.T.S.	SP	EAK	6/12	
PROJECT NUMBER	PRODUCT CODE	ISSUE	SHEET	
36775	1104	1	GN1	



State of Vermont  
Program Development  
One National Life Drive  
Montpelier, VT 05633-5001  
[www.aot.state.vt.us](http://www.aot.state.vt.us)

Agency of Transportation

[phone] 802-828-2621  
[fax] 802-828-3566  
[ttd] 800-253-0191

September 11, 2012

Watson Bowman Acme Corporation  
95 Pineview Drive  
Amherst, NY 14228

Project Name: Woodford Project #: ER BHF 010-1(44)

Structure Identification: VT 9 Over the Roaring Branch of the Walloomsac River

This letter is an update to the letter provided to you dated September 5, 2012. The following **bridge expansion joint details item 516.11, "Bridge Expansion Joint, Vermont"** for the above project (Vendor's Job #143833), transmitted by T. Buck Construction, Inc. and received by our office on Tuesday, August 21, 2012, have been updated with some additional changes needed.

**Sheets 5 and the welding procedures are approved.**

**Sheets 1, 2, 3 and 4 of are approved "as noted". (Please make appropriate changes as indicated on the "as noted" drawing and submit a new "\*.pdf" for our use in the record plans for this project.)**

The updated drawings were emailed to you via the contractor. As a reminder, you must provide notice to our fabrication inspector Jeff Clark as to the date fabrication represented by these drawings will begin. Jeff may be contacted by phone at (802)828-0044 or email at [jeff.clark@state.vt.us](mailto:jeff.clark@state.vt.us). That notice must be received at least seven days prior to that date, as per Specification 506.03. Any material fabricated prior to the notification date is subject to rejection without further cause.

Sincerely,



Carolyn W. Carlson, PE  
Project Manager

Attachments

cc:  Resident Engineer Ron Lemaire -w/updated prints  
 T. Buck Construction, Inc. – w/updated prints  
 Shop Inspector - Jeff Clark w/updated prints  
 Materials & Research Section (C&IA Unit) – Letter only  
 Construction Division - Letter only  
 CWC

State of Vermont  
Program Development  
One National Life Drive  
Montpelier, VT 05633-5001  
www.aot.state.vt.us

[phone] 802-828-2621  
[fax] 802-828-3566  
[ttd] 800-253-0191

Agency of Transportation

September 5, 2012

Watson Bowman Acme Corporation  
95 Pineview Drive  
Amherst, NY 14228

Project Name: Woodford Project #: ER BHF 010-1(44)

Structure Identification: VT 9 Over the Roaring Branch of the Walloomsac River


The following bridge expansion joint details item 516.11, "Bridge Expansion Joint, Vermont" for the above project (Vendor's Job #143833), transmitted by T. Buck Construction, Inc. and received by our office on Tuesday, August 21, 2012, have been reviewed and are being returned herewith.

Sheets 4, 5 and the welding procedures are approved.

Sheets 1, 2, 3 of are approved "as noted". (Please make appropriate changes as indicated on the "as noted" drawing and submit a new "\*.pdf" for our use in the record plans for this project.)

You must provide notice to our fabrication inspector Jeff Clark as to the date fabrication represented by these drawings will begin. Jeff may be contacted by phone at (802)828-0044 or email at [jeff.clark@state.vt.us](mailto:jeff.clark@state.vt.us). That notice must be received at least seven days prior to that date, as per Specification 506.03. Any material fabricated prior to the notification date is subject to rejection without further cause.

Sincerely,

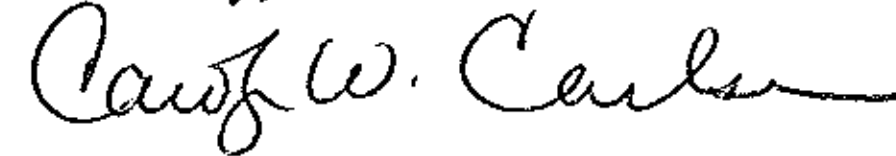

Carolyn W. Carlson, PE  
Project Manager

Attachments

cc: [X] Resident Engineer Ron Lemaire -w/prints  
[X] T. Buck Construction, Inc. - w/prints  
[X] Shop Inspector - Jeff Clark w/prints  
[X] Materials & Research Section (C&IA Unit) - Letter only  
[X] Construction Division - Letter only  
[X] CWC



**AWS D1.5  
WELDING PROCEDURE SPECIFICATION**

MATERIAL SPECIFICATION:	ASTM: A709 Gr 250, 345, & 345W (painted); A36, A572, A588 (painted) (ref. AWS D1.5:2002, sect. 1.2 & 5.4)
WELDING PROCESS:	GMAW
MANUAL OR MACHINE:	Semi-Automatic
POSITION OF WELDING:	Flat, Horizontal
FILLER METAL SPECIFICATION:	A5.18
FILLER METAL CLASSIFICATION:	BR70S-6
FILLER METAL MANUFACTURER:	HOBART BR-6
SHIELDING GAS: Ar - 98%; O <sub>2</sub> - 2%	DEW POINT: -40°F min. FLOW RATE: 37 - 49 CFH
SINGLE OR MULTIPLE PASS:	Single
SINGLE OR MULTIPLE ARC:	Single ELECTRODE STICKOUT: 3/4" ± 1/4"
WELDING CURRENT:	DCMP
WELDING PROGRESSION:	Forward
ROOT TREATMENT:	Surfaces shall be smooth and uniform, and free of discontiguities, loose or thick scale, slag, rust, moisture, grease/oil, and other foreign material. (ref. AWS D1.5:2002, 3.2.1)
PREHEAT AND INTERPASS TEMP.	Minimum: ≤ 3/4" = 50°F; over 3/4" to 1-1/2" = 70°F; over 1-1/2" to 2-1/2" = 150°F; over 2-1/2" = 225°F. Maximum: 450°F
POSTHEAT TREATMENT:	N/A

**WELDING PROCEDURE**

Weld Size (in)	Electrode Size	Welding Current		Travel Speed (in/min)	Depth of Prep. (in)	Joint Detail C-P2-G
		Amps	Volts			
3/16"	.045	265-280	27.5-30	10.0 - 11.0	265-280	
1/4"	.045	265-280	27.5-30	10.0 - 11.0	265-280	
5/16"	.045	265-280	27.5-30	10.0 - 11.0	265-280	
R=0	α = 60°	T <sub>1</sub> = 1/4" min	T <sub>2</sub> = Unbeveled	t = 1/8" min, S = 1/3" min		

\*\*\* This procedure may vary within the limitations identified in AWS D1.5:2008 "Bridge Welding Code", \*\*\*

PROCEDURE NO: GMAW-06 REVISION NO.: 0-2010  
 QUALIFYING PQR: WBA - GMAW 2010-A PQR REQUAL DATE: 11/09/16  
 MANUFACTURER: Watson Doyman Acme Corp. AUTHORIZED BY: [Signature]  
Gregory D. Ross - Quality Control Manager

Trans Received  
 CRD BY: JWC

GREGORY D. ROSS  
 CWI 0801/211  
 QC1 EXP 07/01/11



APR 17 2012

Approved by: [Signature]  
 DATE: 4/25/12

**AWD D1.5**  
**WELDING PROCEDURE SPECIFICATION**

MATERIAL SPECIFICATION:	ASTM: A709 Gr. 250, 345, & 345W (painted); A36, A572, A588 (painted) (ref. AWS D1.5:2002, sect. 1.2 & 5.4)
WELDING PROCESS:	GMAW
MANUAL OR MACHINE:	Semi-Automatic
POSITION OF WELDING:	Flat Horizontal
FILLER METAL SPECIFICATION:	A5.18
FILLER METAL CLASSIFICATION:	BR708-C
FILLER METAL MANUFACTURER:	HOBART BR-C
SHIELDING GAS: Ar - 98%, O <sub>2</sub> - 2%	DEW POINT: -40°F min. FLOW RATE: 37 - 49 CFH
SINGLE OR MULTIPLE PASS:	Multiple
SINGLE OR MULTIPLE ARC:	Single ELECTRODE STICKOUT: 3/4" ± 1/4"
WELDING CURRENT:	DCBP
WELDING PROGRESSION:	Forward
ROOT TREATMENT:	Surfaces shall be smooth and uniform, and free of discontinuities, loose or thick scale, slag, rust, moisture, grease/oil, and other foreign material. (ref. AWS D1.5:2002, 3.2.1)
PREHEAT AND INTERPASS TEMP.:	Minimum: ≤ 3/4" = 50°F; over 3/4" to 1-1/2" = 70°F; over 1-1/2" to 2-1/2" = 150°F; over 2-1/2" = 225°F Maximum: 450°F
POSTHEAT TREATMENT:	N/A

**WELDING PROCEDURE**

Weld Size - # of Passes	Electrode Size	Welding Current		Travel Speed "/Min	Joint Detail B-3-Q
		Amps	Volts		
All	.045	265-280	27.5-30	10.0-11.0	
T <sub>1</sub> = 1/2" min T <sub>2</sub> = 1/8" min α = 60° R = 0 S <sub>1</sub> + S <sub>2</sub> = 1/32"					

\*\*\* This procedure may vary within the limitations identified in AWS D1.5:2003 "Welding Code" \*\*\*

PROCEDURE NO.:	GMAW-07	REVISION NO.:	0-2010
QUALIFYING PQR:	WBA - GMAW 2010 -A	PQR REQUAL DATE:	11/09/15
MANUFACTURER:	Watson Boyman Acme Corp.	AUTHORIZED BY:	<i>[Signature]</i> Gregory Ross - Quality Control Manager

Trans Received  
CRO BY: *[Signature]*

GREGORY ROSS  
CWI 08070211  
QC1 EXP 07/01/11



APR 17 2012

Resubmit APPROVED  
BY: DATE: 4/25/12

**AWS D1.5**  
**WELDING PROCEDURE SPECIFICATION**

MATERIAL SPECIFICATION:	ASTM: A709 Gr. 250, 345 & 345W (painted); A36, A572, A588(painted) (ref. AWS D1.5:2002 sect. 3.2 & 3.4)
WELDING PROCESS:	GMAW
MANUAL OR MACHINE:	Semi-Automatic
POSITION OF WELDING:	Flat & Horizontal
FILLER METAL SPECIFICATION:	A5.18
FILLER METAL CLASSIFICATION:	ER70S-6
FILLER METAL MANUFACTURER:	HOBART ER-6
SHIELDING GAS: Ar - 98% O <sub>2</sub> - 2%	DRY POINT: -40°F min. FLOW RATE: 37-49 GPH
SINGLE OR MULTIPLE PASS:	Single (S) or Multiple (S)
SINGLE OR MULTIPLE ARC:	Single ELECTRODE STICKOUT: 3/4" ± 1/4"
WELDING CURRENT:	DCBP
WELDING PROGRESSION:	Forward
ROOT TREATMENT:	Surfaces shall be smooth and uniform, and free of discontinuities, loose or thick scale, slag, rust, moisture, grease/oil, and other foreign material. (ref. AWS D1.5:2002, 3.2.1)
PREHEAT AND INTERPASS TEMP.:	Minimum ≤ 3/4" = 50°F; over 3/4" to 1-1/2" = 70°F; over 1-1/2" to 2-1/2" = 150°F; over 2-1/2" = 225°F Maximum 450°F
POSTHEAT TREATMENT:	N/A

**WELDING PROCEDURE**

Weld Size	Electrode Size	Welding Current		Travel Speed, in/min	Joint Detail Fillet
		Amps	Volts		
≤ 5/16 (S)	.045	265-280	27.5-30	10.0 - 11.0	
≥ 5/16 (S)	.045	265-280	27.5-30	10.0 - 11.0	

\*\*\* This procedure may vary within the limitations identified in AWS D1.5:2008 "Bridge Welding Code", \*\*\*

PROCEDURE NO: GMAW-11 REVISION NO: 0-2010

QUALIFYING PQR: WBA - GMAW-2010 & GMAW-CS-2007 Fillet PQR REQUL DATE: 11/09/13

MANUFACTURER: Watson Bowman Acme Corp. AUTHORIZED BY: [Signature]  
Gregory V. Ross - Quality Control Manager

Received  
OK'D BY: [Signature]


**WATSON**  
GREGORY ROSS  
CWI 08070211  
QC1 EXP 07/01/11

APR 17 2012



Resubmit BY: [Signature] APPROVED DATE: 4/25/12

WOODFORD  
EK REF 010-1(44)  
GRY 9-7-12

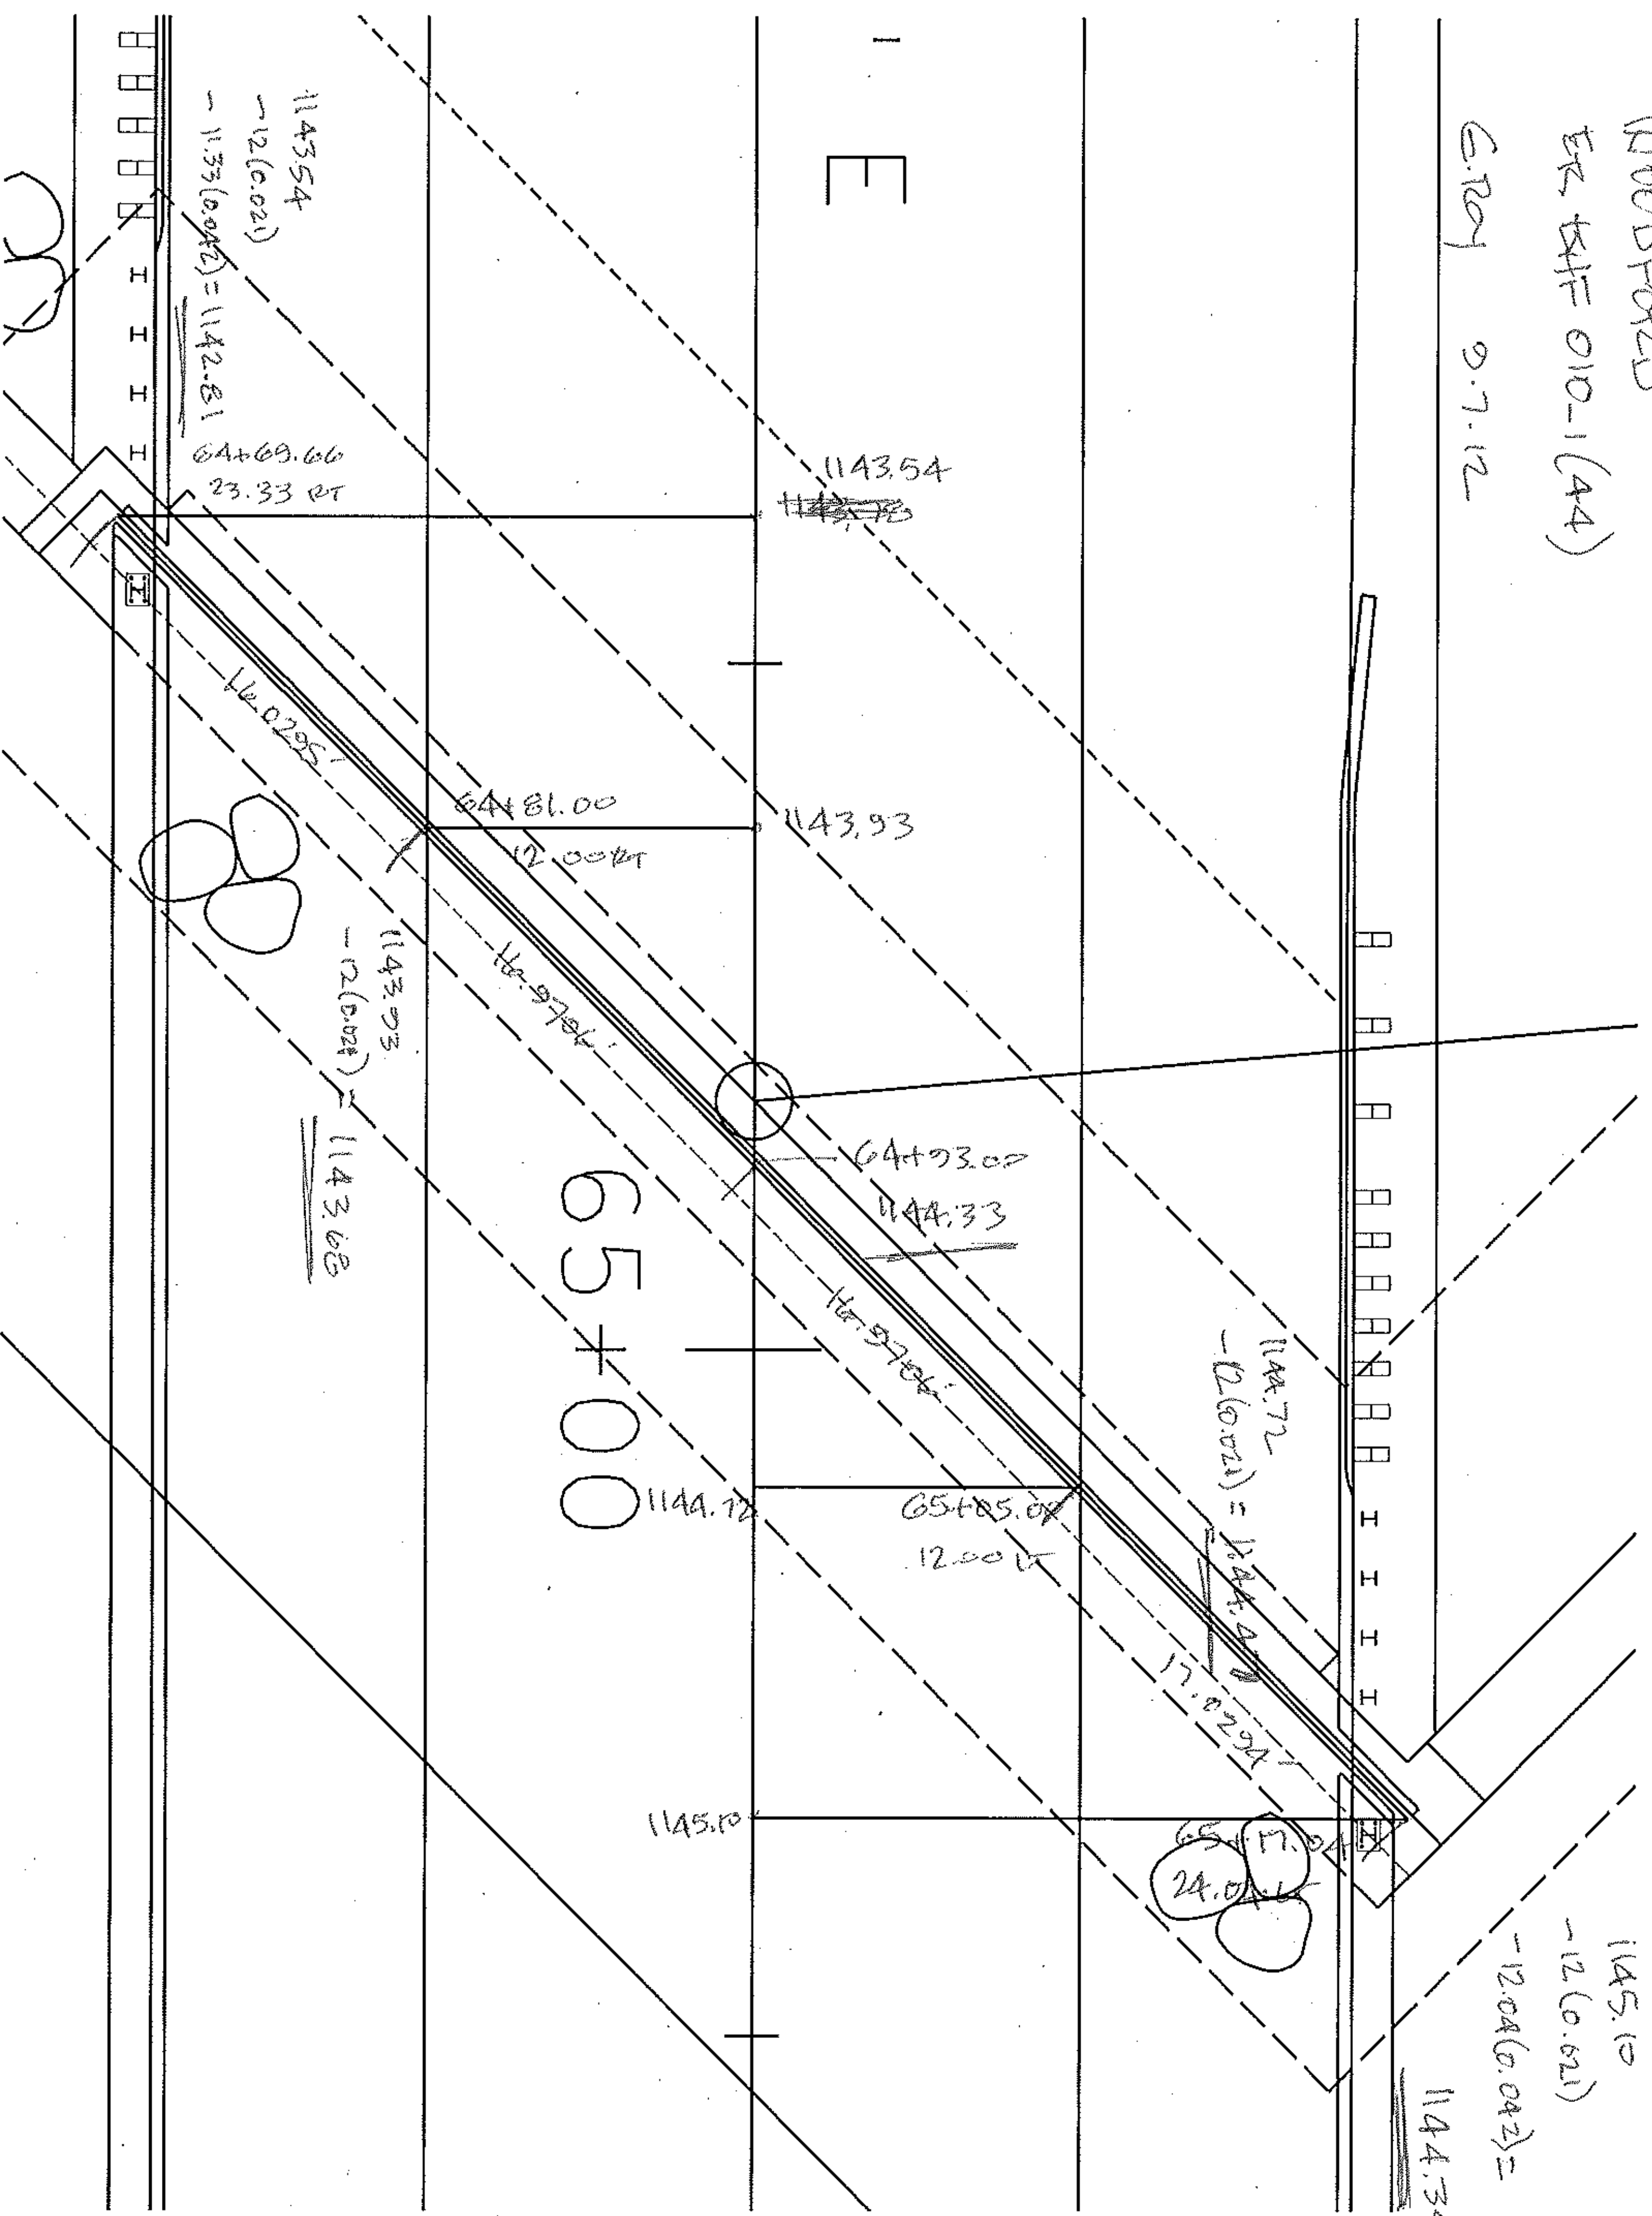

**GENERAL NOTES**

**1.0 GENERAL**

1.1 THE CONTRACTOR MUST VERIFY ALL DIMENSIONS PRIOR TO FABRICATION TO ENSURE ACCURACY OF THE EXPANSION JOINT.

DIMENSIONS VERIFIED: \_\_\_\_\_

1.2 ALL WORK SHALL COMPLY WITH THE VERMONT AGENCY OF TRANSPORTATION'S STANDARD SPECIFICATIONS FOR CONSTRUCTION DATED 2011, AND ITS LATEST REVISIONS AND THE AASHTO STANDARD SPECIFICATIONS FOR HIGHWAY BRIDGES, SIXTEENTH EDITION AND ITS LATEST REVISIONS, EXCEPT AS NOTED HEREIN.

1.3 ALL DIMENSIONS ARE IN INCHES UNLESS OTHERWISE NOTED.

1.4 IN CASE OF DIFFERENCE ON THE CONTRACT PLANS BETWEEN SCALE DIMENSIONS AND FIGURES, THE FIGURES SHALL BE FOLLOWED.

**2.0 STANDARD SPECIFICATION CRITERIA**

**3.0 SPECIAL PROVISION CRITERIA**

**4.0 MATERIALS**

4.1 ALL STRUCTURAL AND PERMANENT MATERIALS SHALL BE OF DOMESTIC ORIGIN, AND MATERIAL CERTIFICATION STATING ALL SUCH MATERIALS ARE "MELTED AND MANUFACTURED" IN THE UNITED STATES OF AMERICA SHALL BE SUBMITTED.

4.2 STEEL BARS, PLATES AND SHAPES SHALL CONFORM TO ASTM A 36.

4.3 STRUCTURAL USE AND GENERAL USE BOLTS, NUTS AND WASHERS SHALL CONFORM TO THE REQUIREMENTS OF ASTM A-325. BOLTS, NUTS AND WASHERS SHALL CONFORM TO THE REQUIREMENTS OF ASTM A-325, A-563 AND F-436 RESPECTIVELY. SCREWS SHALL CONFORM TO THE REQUIREMENTS OF ASTM F-835.

4.4 THE FABRIC TROUGH SHALL BE ONE CONTINUOUS FABRIC PIECE FOR THE FULL LENGTH OF THE EXPANSION JOINT.

4.5 THE CONCRETE ANCHOR STUDS SHALL BE IN ACCORDANCE WITH ASTM A-108.

**5.0 INSPECTION REQUIREMENTS**

5.1 IN HOUSE SHOP INSPECTION BY A REPRESENTATIVE OF VERMONT AGENCY OF TRANSPORTATION INDEPENDENT OF WATSON BOWMAN ACME CORP.'S QUALITY CONTROL INSPECTOR IS REQUIRED.

5.2 QUALITY CONTROL INSPECTION

5.2.1 DURING FABRICATION OF THE EXPANSION JOINT, WATSON BOWMAN ACME SHALL PROVIDE FULL TIME QUALITY CONTROL INSPECTION TO INSURE THAT THE MATERIALS AND WORKMANSHIP MEET OR EXCEED THE MINIMUM REQUIREMENTS OF THE CONTRACT.

**6.0 FABRICATION**

6.1 FABRICATION SHALL BE IN ACCORDANCE WITH WATSON BOWMAN ACME'S QUALITY CONTROL MANUAL AND MANUFACTURING TOLERANCE.

6.2 ALL WELDING SHALL BE IN ACCORDANCE WITH AWS D1.5 WELDING SPECIFICATIONS.

6.3 ALL WELDING SHALL BE EXECUTED USING GMAW PROCESSES. SEAL WELD ALL CONNECTIONS WHERE POSSIBLE PRIOR TO GALVANIZING.

6.4 STUDS SHALL BE INSPECTED VISUALLY AND SHALL BE GIVEN A LIGHT BLOW WITH A HAMMER. ANY STUD WHICH DOES NOT HAVE A COMPLETE END WELD OR DOES NOT EMIT A RINGING SOUND WHEN STRUCK WITH A LIGHT BLOW WITH A HAMMER SHALL BE REPLACED.

6.5 STUDS SHALL NOT BE LOCATED MORE THAN 1" FROM THE LOCATION SHOWN ON THESE SHOP DRAWINGS.

6.6 THE FABRIC TROUGH SHALL BE THOROUGHLY CLEANED AND FLUSHED AFTER PAVING OPERATION. A DRIP BEAD OD 1/4" x 7" PREFORMED FABRIC MATERIAL SHALL BE CEMENTED TO THE BOTTOM OF THE FABRIC TROUGH USING AN ADHESIVE APPROVED BY THE MANUFACTURER. THE DRIP BEAD SHALL BE APPLIED 1" FROM THE DOWNSPOUT END OF THE TROUGH.

6.7 THE EXPANSION JOINT OPENING SHALL BE PRESET BY THE MANUFACTURER, TO THE DIMENSION SHOWN AT 45°F. FINAL ADJUSTMENTS SHALL BE MADE IN THE FIELD BY THE CONTRACTOR AT THE DIRECTION OF THE ENGINEER IN CHARGE, PRIOR TO FINAL CONCRETE PLACEMENT.

6.8 STUDS MAY BE BENT TO AN ANGLE OF 30° TO AVOID INTERFERENCE WITH DECK REINFORCEMENT, OR TO PROVIDE PROPER CONCRETE COVER.

6.9 AFTER FABRICATION, BUT BEFORE SHIPPING, STRAIGHTEN STEEL SHAPES SO THAT THEY ARE FREE FROM WARP, TWIST AND SWEEP.

6.10 FOR PAYMENT PURPOSES THE LENGTH OF THE JOINT PAID FOR WILL BE THE NUMBER OF LINEAR METERS OF JOINT SYSTEM INSTALLED, MEASURED HORIZONTALLY AND VERTICALLY ALONG THE CENTERLINE OF THE JOINT SYSTEM BETWEEN THE OUTER LIMITS OF THE BRIDGE FASCIA UNLESS OTHERWISE SHOWN ON THE PLANS.

**7.0 COATINGS**

7.1 THE EXPANSION JOINT ASSEMBLY, INCLUDING THE SUPPORT ANGLES, SHALL BE GALVANIZED. IN ACCORDANCE WITH ASTM A-123. THE WELDED EMBEDMENT PLATE WITH STUDS AND FIELD WELDED 1" DIA THREADED STUDS SHALL NOT BE GALVANIZED.

7.2 REPAIR DAMAGED HOT-DIP GALVANIZING ACCORDING TO AASHTO M-111. REPAIRED AREAS TO BE "COLD GALVANIZED". PRODUCT SHALL BE 82% ZINC DUST AND HAVE A DRY FILM THICKNESS EQUAL TO OR GREATER THAN THE ORIGINAL GALVANIZING. AEROSOL CANS SHALL NOT BE USED.

7.3 PRIOR TO GALVANIZING, ALL CORNERS AND EDGES OF STEEL PLATES, SHAPES, ETC., SHALL BE GROUND TO A 1.6mm (5/64") RADIUS.

The 1 1/4" x 5 1/2" bars shall be furnished in eight pieces, four pieces per side. The maximum length of any one piece shall not exceed 17'-1 3/8"

Either the 33 foot or the 34 foot section of joint shall be assembled prior to shipping, with the fabric trough included.

Vermont Agency of Transportation

**RECEIVED**

CK'D BY M.E.M. OK'D BY C.W.M.


Aug. 21, 2012

RESUBMIT APPROVED AS NOTED

BY C. CARLSON DATE 09-05-2012

STATE: VERMONT  
 COUNTY: BENNINGTON  
 PROJECT NO.: ER BHF 010-1(44)  
 REFERENCE NO.: XXXXXXXXX  
 DISTRICT: XXX ROUTE: XXX  
 WBA PRODUCT NO.: EMB143833AA

G:\Engineer\WBA Projects\143833-T Buck-Woodford ER BHF\030-Drawings\B3008501.dwg, 8/21/2012 11:11:36 AM

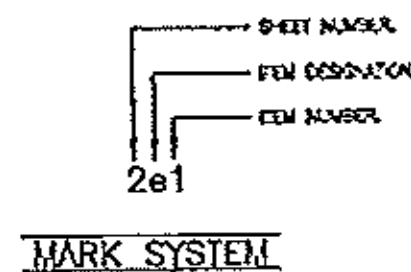

DRAWING ACTION:


NO.	DESCRIPTION	DATE

Information provided herein, including but not limited to, any drawing, design, photograph, graphic, or a description of a material or process, is the property of Watson Bowman Acme Corporation ("Company"). Reproduction, translation, or reduction to any electronic medium or machine readable form, in whole or part, is strictly prohibited, except for the express purpose for which it has been furnished, without prior written consent of Company. All Material's contained herein are provided by Company for information purposes only. Company reserves the right to amend or withdraw any information contained in this Material's without notice. All intellectual or other rights by Company, whether verbal or written, concerning products, or the use of products in specific situations ("Advice") is given by Company and is used at the User's own risk.

PROJECT: WOODFORD  
 VT RT 9 BRIDGE NO. 11 OVER ROARING  
 BRANCH OF THE WALLOOMSAC RIVER  
 WABO PLATE JOINT W/NEOPRENE TROUGH DETAILS

DESIGNED BY KF	DATE 8-14-12
CHECKED BY JFW	DATE 8-14-12
SCALE NTS	WBA JOB NO. 143833
SHEET NO. 1 OF 5	DESIGN NO. B-30085

G:\Engineer\WBA Projects\143833-T Buck-Woodford ER BHF\030-Drawings\B3008502.dwg, 8/21/2012 11:11:23 AM

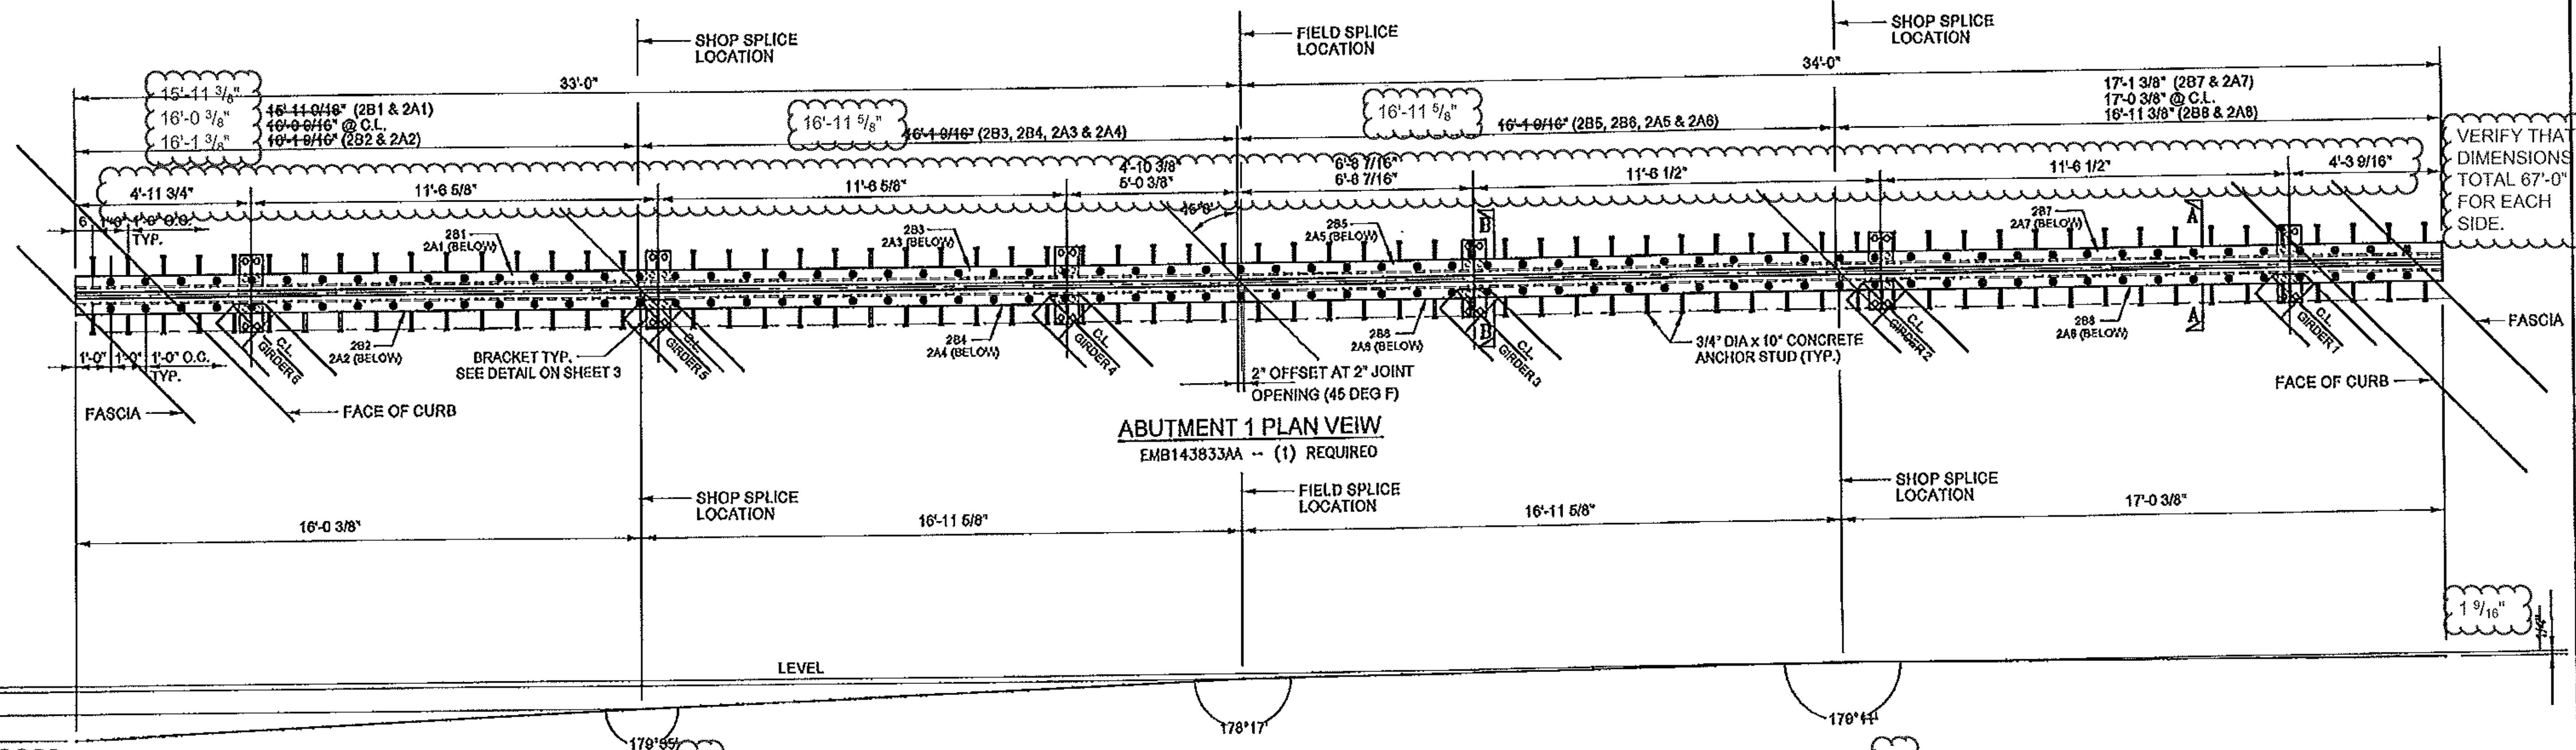


VERIFY THAT DIMENSIONS TOTAL 67'-0" FOR EACH SIDE.

Bar to be supplied in four pieces per side of joint. Maximum length of each piece of bar 17'-1 3/8".

BAR 1 1/4" x 5 1/2" W / 7/8" DIA HOLES @ 1'-0" O.C COUNTERBORED 2 1/4" DIA x 3/4" DEEP. FILL WITH HOT PURED JOINT SEALANT IN ACCORDANCE WITH SUBSECTION 707.04. SEALANT SUPPLIED BY CONTRACTOR.

3/4" DIA x 2 1/2" HEAVY HEX BOLT @ 1'-0" O.C (AASHTO M164 TYPE 1, GALV.) COAT BOLT AND HEX NUT THREADS WITH "NEVER SEIZE" GREASE TYP. NEVER SEIZE SUPPLIED BY CONTRACTOR.

applied during shop assembly of one section of the joint

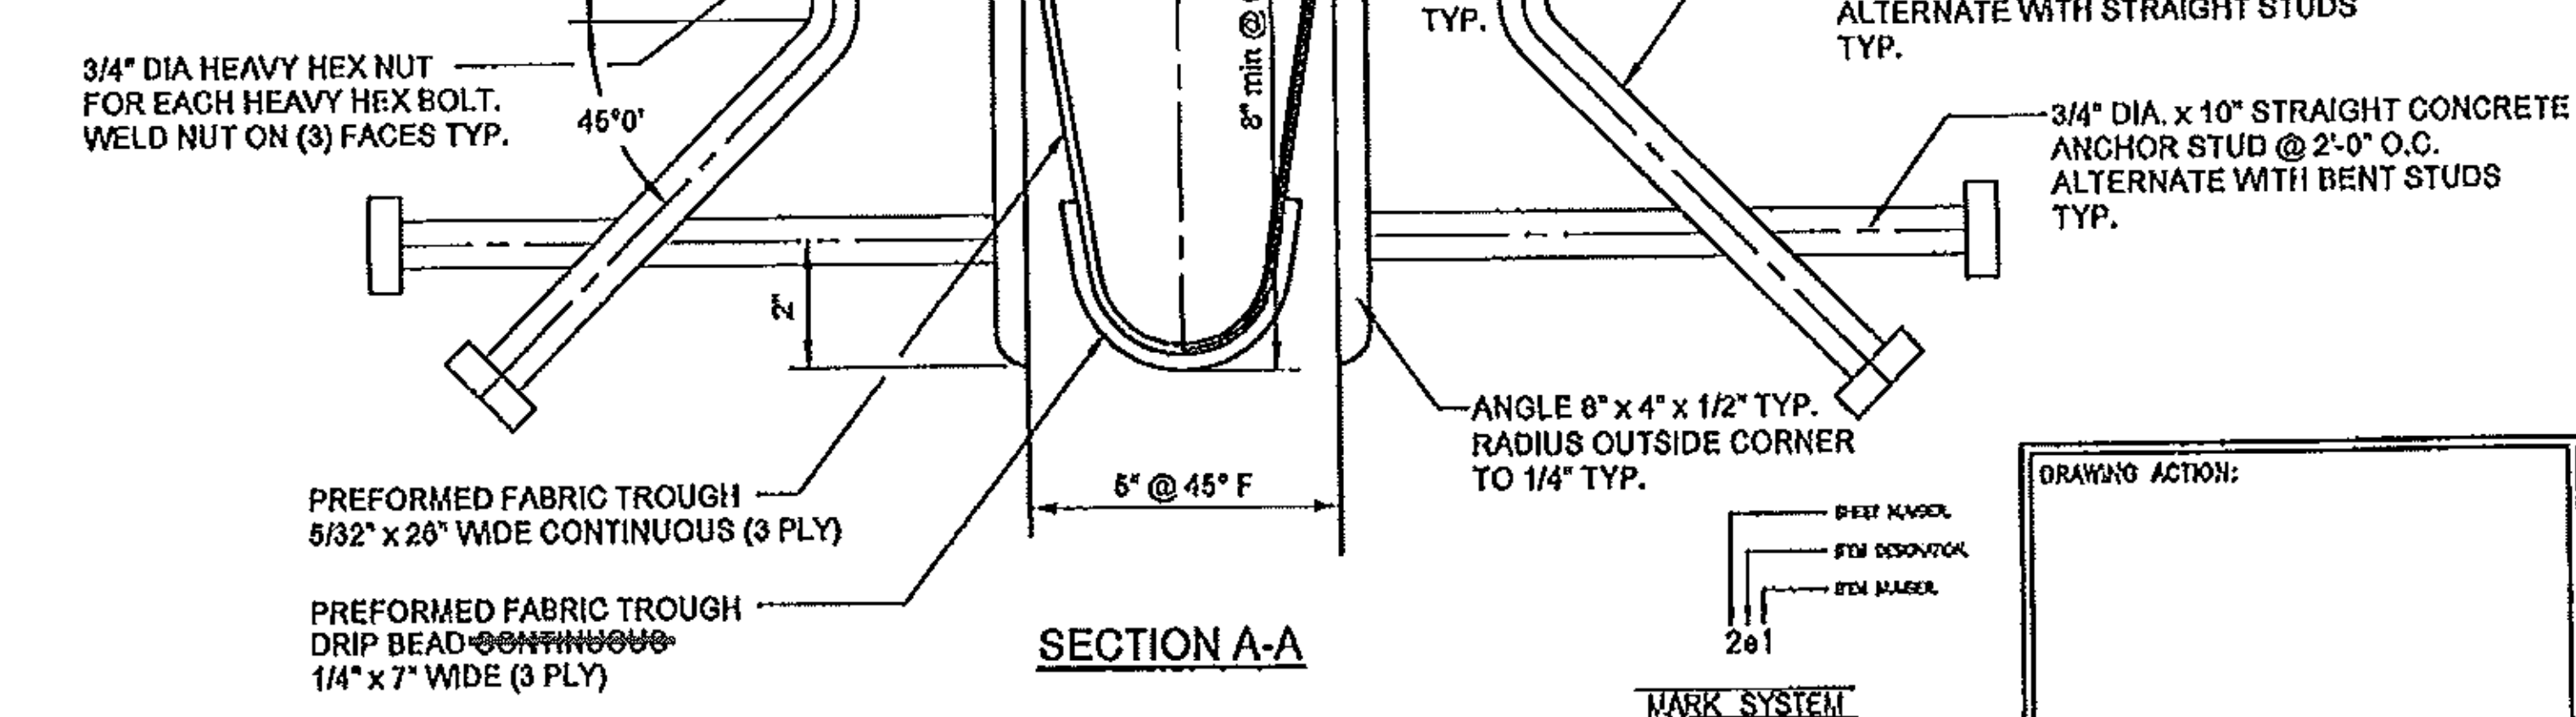

**ABUTMENT 1 EXPANSION JOINT PROFILE**  
ALL DIMENSIONS SHOWN ARE TAKEN ALONG THE CENTERLINE OF THE EXPANSION JOINT

TEMP.	"A" DIST.
0 DEG F	2 3/8"
15 DEG F	2 1/4"
30 DEG F	2 1/8"
45 DEG F	2"
60 DEG F	1 7/8"
75 DEG F	1 3/4"
90 DEG F	1 5/8"
105 DEG F	1 1/2"

Vermont Agency of Transportation  
**RECEIVED**

CK'D BY M.E.M. OK'D BY C.W.M.  
08/21/2012

RESUBMIT APPROVED AS NOTED  
BY C. CARLSON DATE 09/07/2012

~~Vermont Agency of Transportation  
**RECEIVED**~~

~~CK'D BY M.E.M. OK'D BY C.W.M.  
Aug. 21, 2012~~

~~RESUBMIT APPROVED AS NOTED  
BY C. CARLSON DATE 09-05-2012~~

STATE: VERMONT  
 COUNTY: BENNINGTON  
 PROJECT NO.: ER BHF 010-1(44)  
 REFERENCE NO.: XXXXXXXXX  
 DISTRICT: XXX ROUTE: XXX  
 WBA PRODUCT NO.: EMB143833AA

DRAWING ACTION:

NO.	DESCRIPTION	DATE

Information provided herein, including but not limited to, any drawing, design, photograph, or other data, is the property of Watson Bowman Acme Corporation ("Company"). Reproduction, transmission, or reduction to any electronic medium or machine-readable form, in whole or part, is strictly prohibited, except for the express purpose for which it has been furnished, without prior written consent of Company. All Materials contained herein are provided by Company for information purposes only. Company reserves the right to amend or withdraw any information contained in the Materials without notice. All Intellectual or other rights by Company, whether verbal or written, concerning products, or the use of products in specific situations ("Advice") is given by Company and is used at the User's own risk.







**Watson Bowman Acme**  
WATSON BOWMAN ACME CORPORATION  
85 FREDERICK DRIVE, SUITE 200, WOODFORD, VT 05793 TEL: (810) 631-7255 FAX: (810) 631-9229

**D-BASF**  
The Duroc Company

PROJECT: **WOODFORD VT RT 9 BRIDGE NO. 11 OVER ROARING BRANCH OF THE WALLOONSAC RIVER WABO PLATE JOINT W/NEOPRENE TROUGH DETAILS**

DATE	BY
8-14-12	JFW
8-14-12	KF
143833	NTS
2 OF 5	

G:\Engineer\WBA Projects\143833-T Buck-Woodford ER BHF 050-Drawings\BSC08503.dwg, 8/21/2012 11:11:09 AM

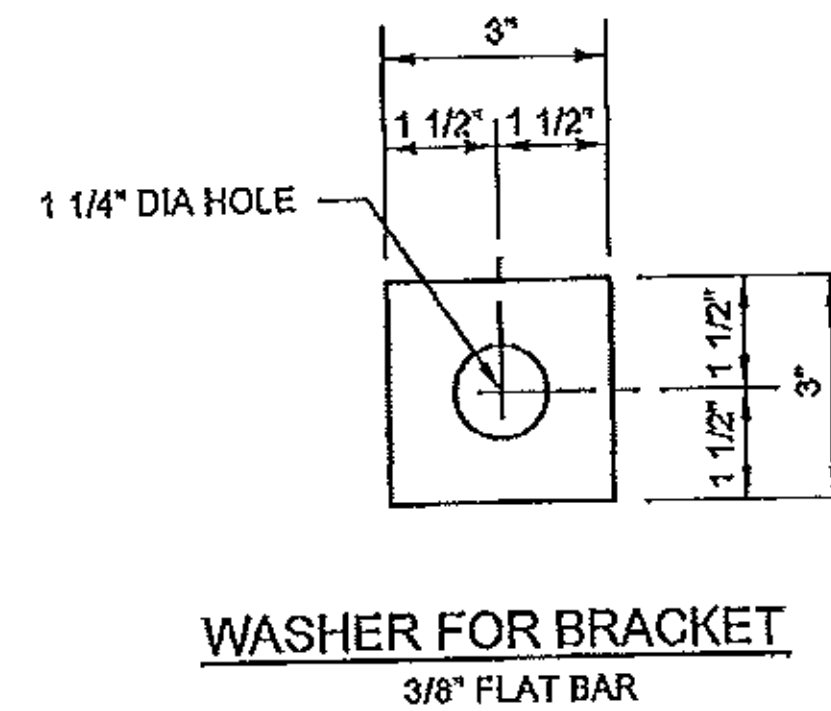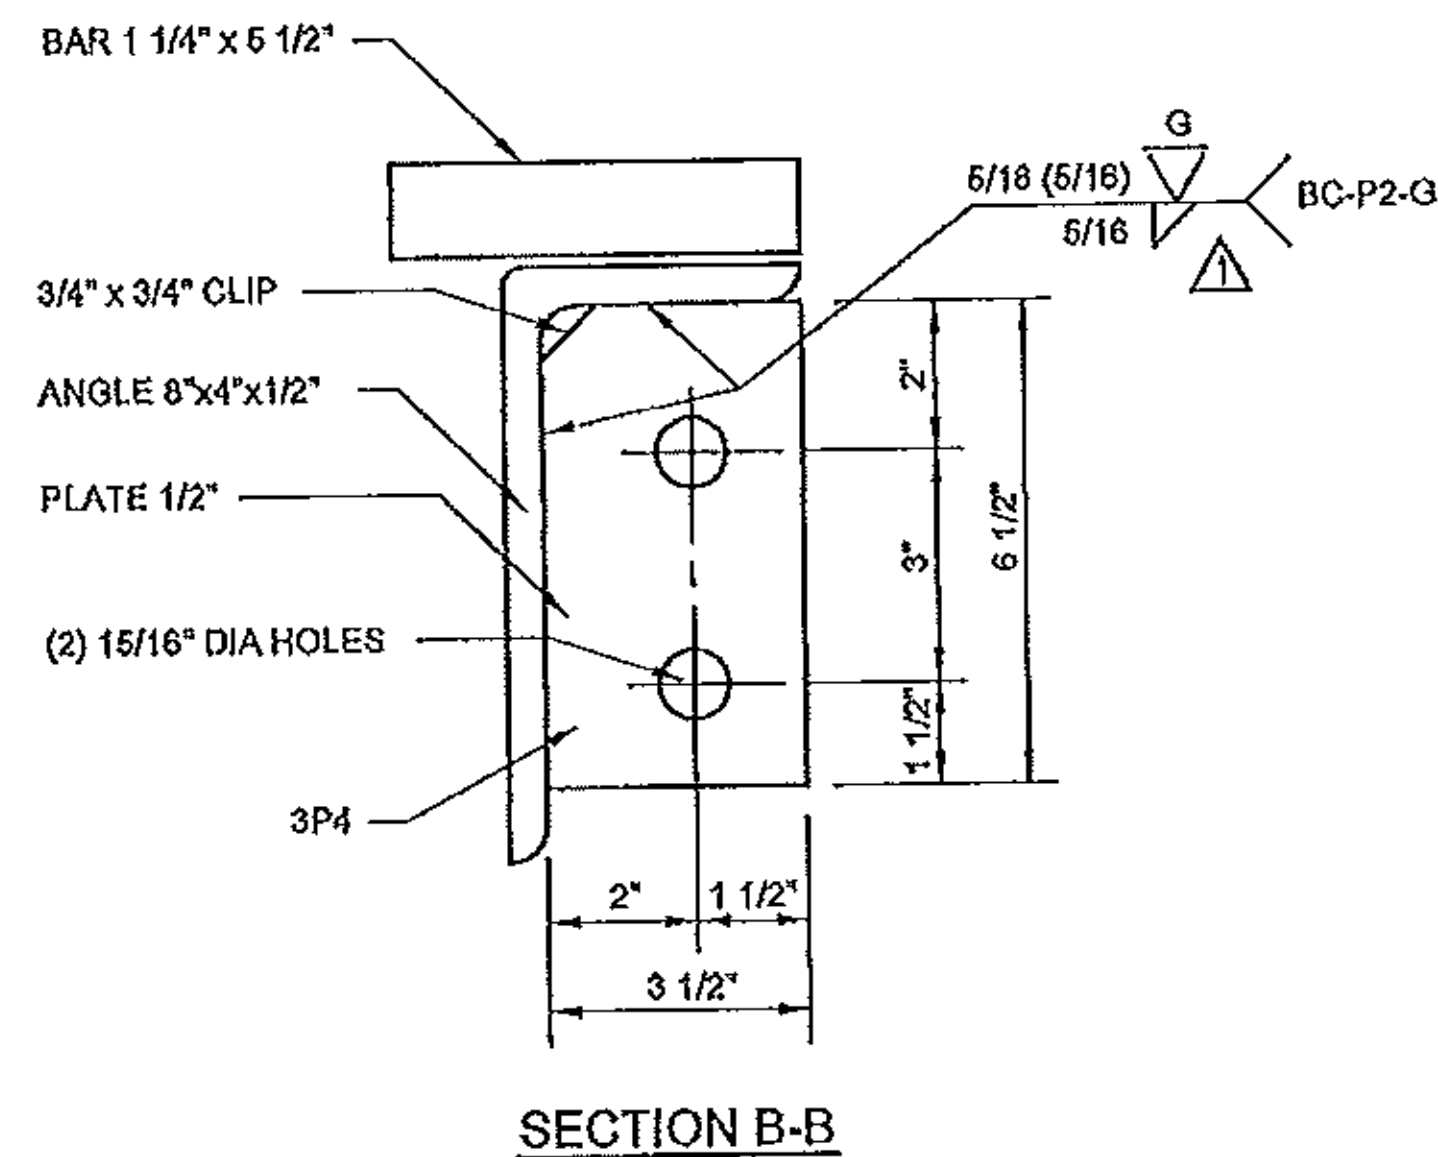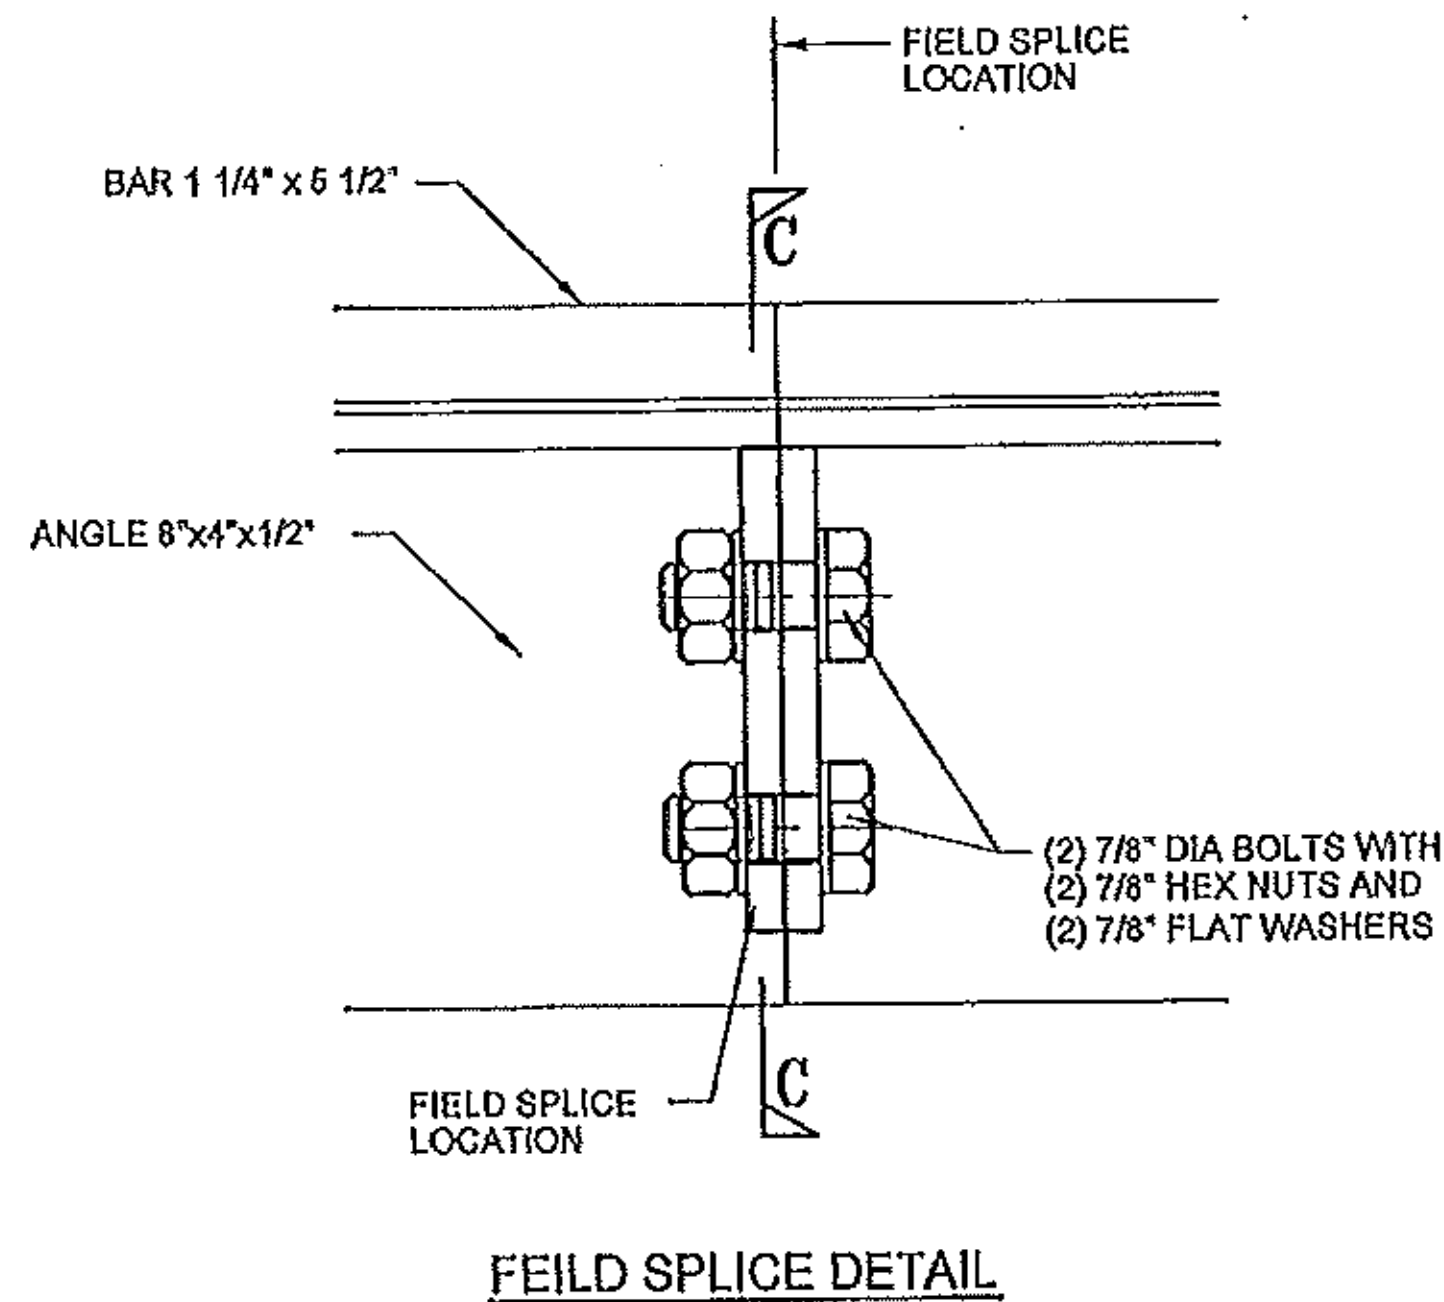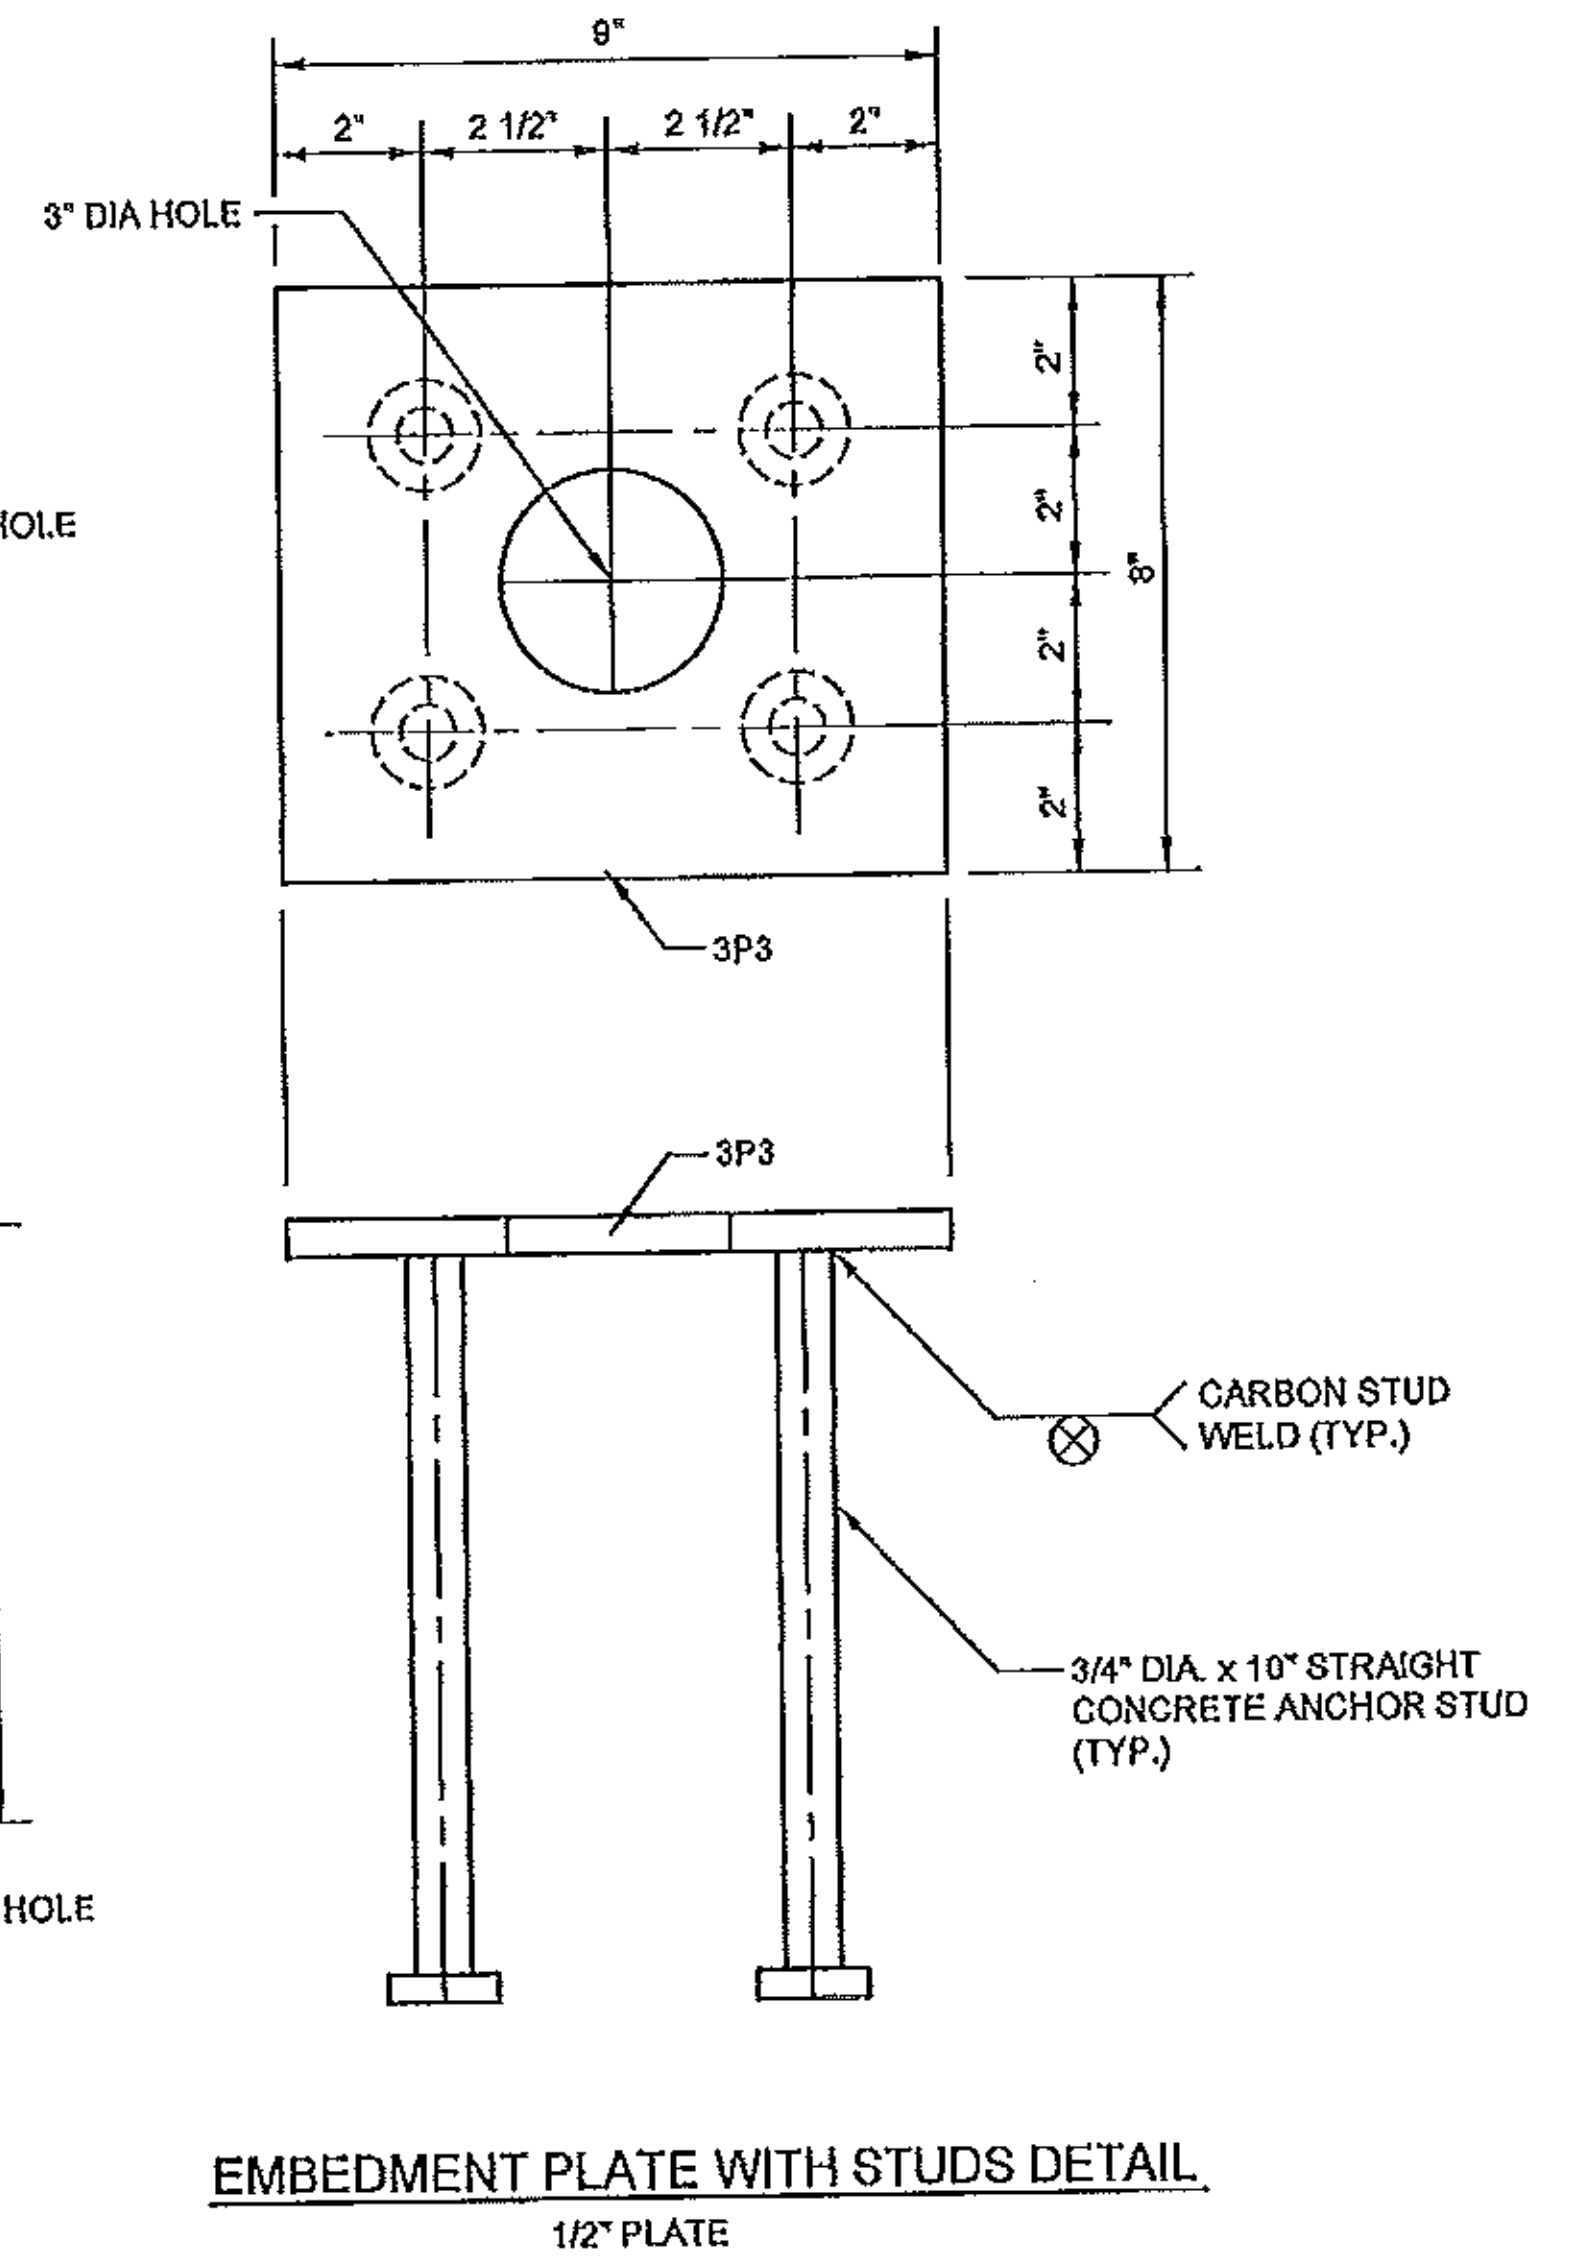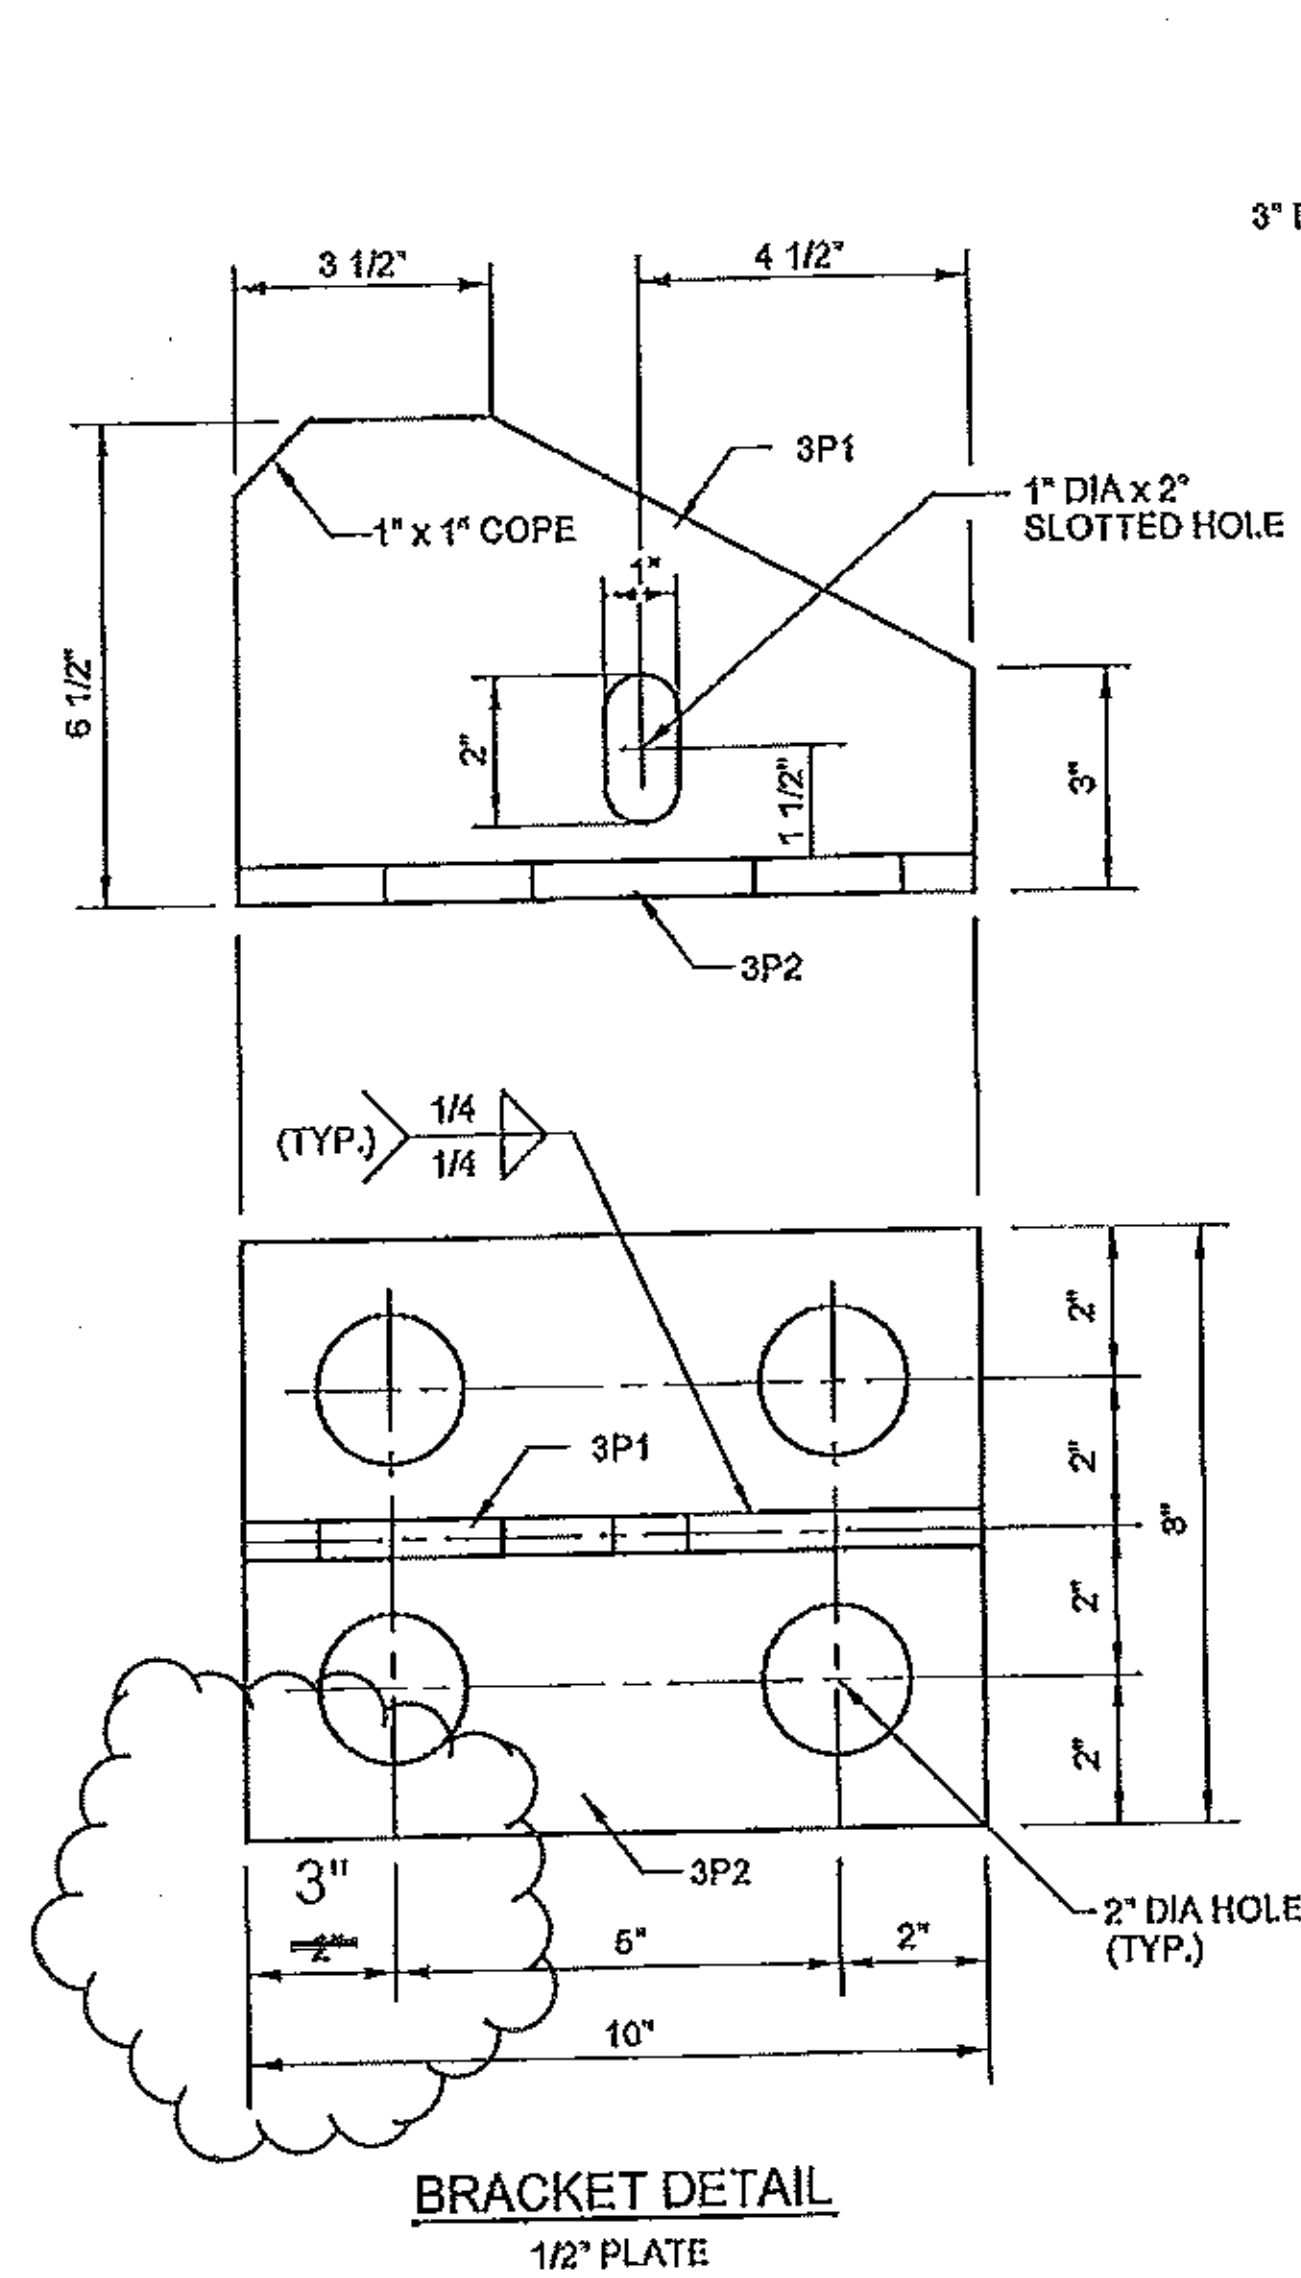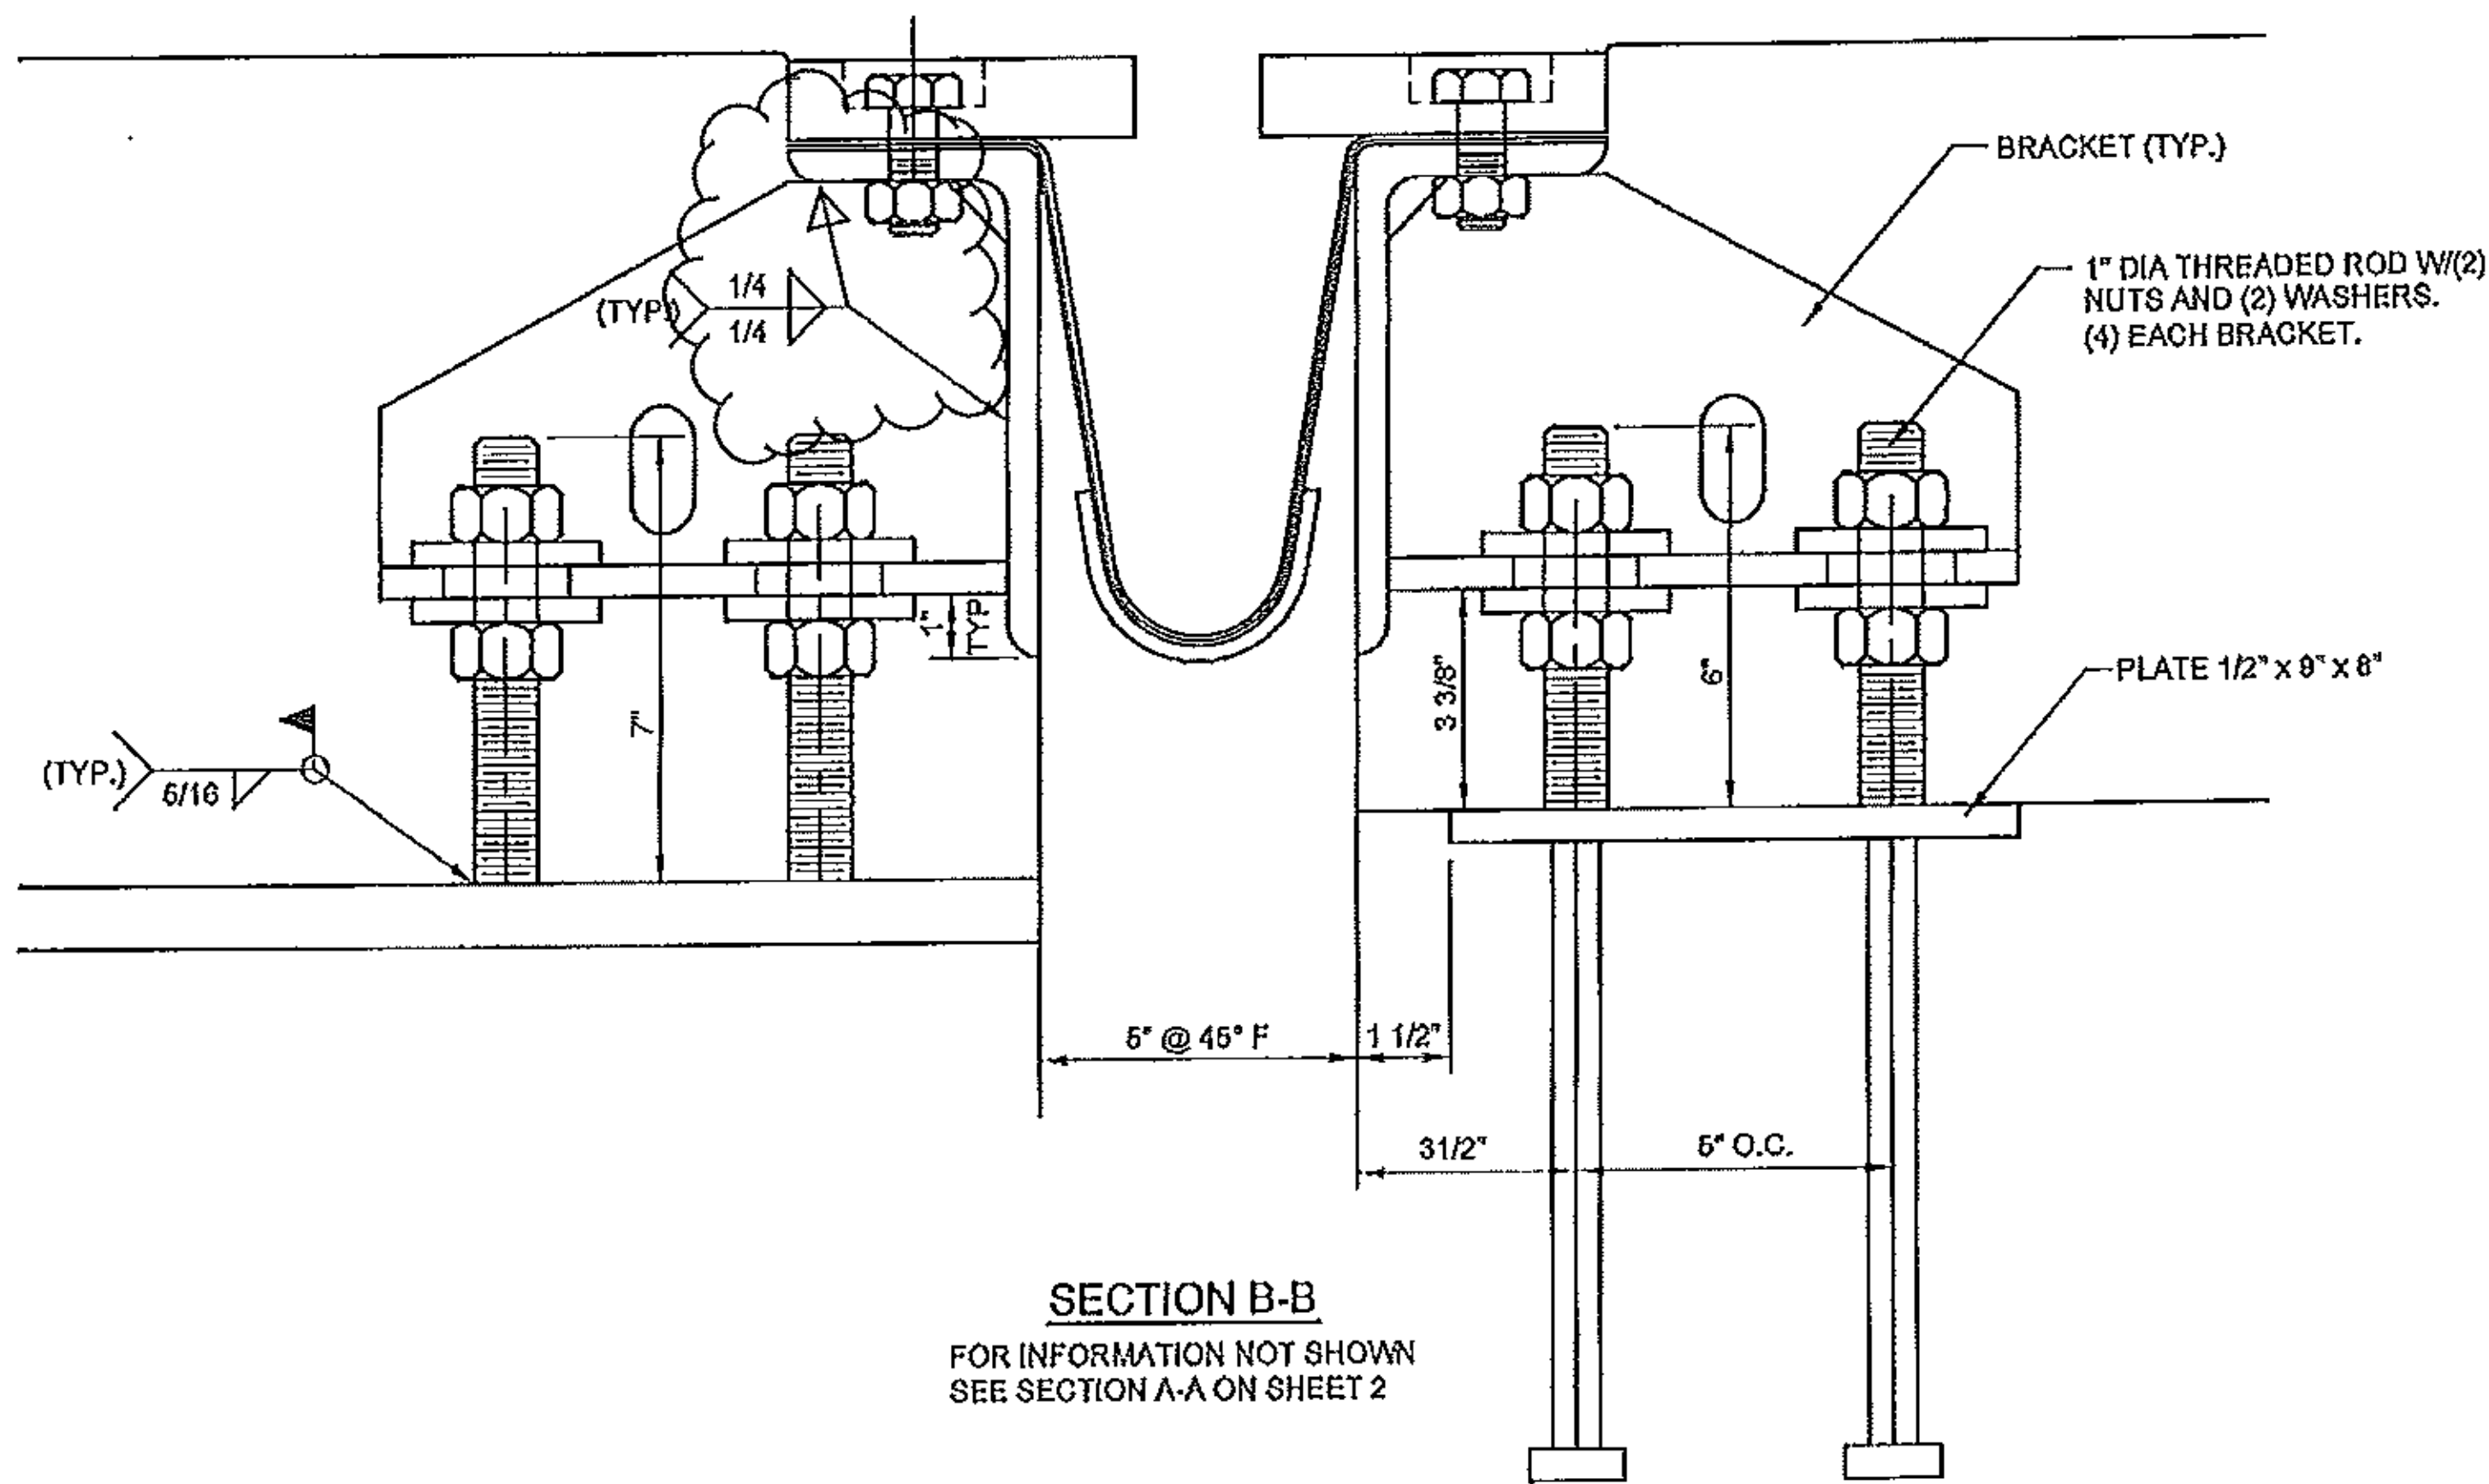

Vermont Agency of Transportation


**RECEIVED**

CK'D BY M.E.M. OK'D BY C.W.M.

Aug. 21, 2012

RESUBMIT APPROVED AS NOTED  
BY C. CARLSON DATE 09-05-2012

STATE: VERMONT  
COUNTY: BENNINGTON  
PROJECT NO.: ER BHF 010-1(44)  
REFERENCE NO.: XXXXXXXXXX  
DISTRICT: XXX ROUTE: XXX  
WBA PRODUCT NO.: EMB143833AA

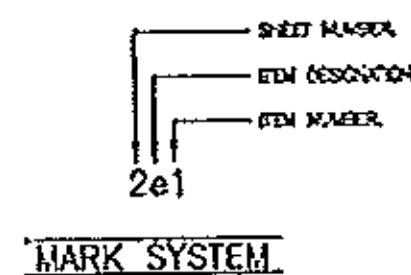

DRAWING ACTION:	
2e1	REVISED WELD DETAIL

NO.	DESCRIPTION	DATE	BY
1	REVISED WELD DETAIL	8-21-12	JFW

**Watson Bowman Acme**  
The Original Company


PROJECT: WOODFORD  
VT RT 9 BRIDGE NO. 11 OVER ROARING  
BRANCH OF THE WALLOOMSAC RIVER  
WABO PLATE JOINT W/NEOPRENE TROUGH DETAILS

DESIGNED BY	JFW	DATE	8-14-12
CHECKED BY	KF	DATE	8-14-12
SCALE	NTS	WBA JOB NO.	143833
SHEET NO.	3 OF 5	DISTRICT NO.	B-30085

G:\Engineer\WBA Projects\143833-T Buck-Woodford ER BHF\030-Drawings\B3008504.dwg, 8/21/2012 11:12:04 AM

\*\* DESIGN LENGTH = 67'-0"  
SHIP AT 69'-0". CONTRACTOR SHALL  
FIELD TRIM TO INSURE AN ACCURATE  
FIT.  
\*\* 69'-0"

TROUGH SHALL EXTEND 6"  
BEYOND THE STEEL BARS.  
TROUGH LENGTH IS THEREFORE  
68'-0". FIRST SLOTTED HOLE  
WILL BE 1'-6" FROM END OF TROUGH.

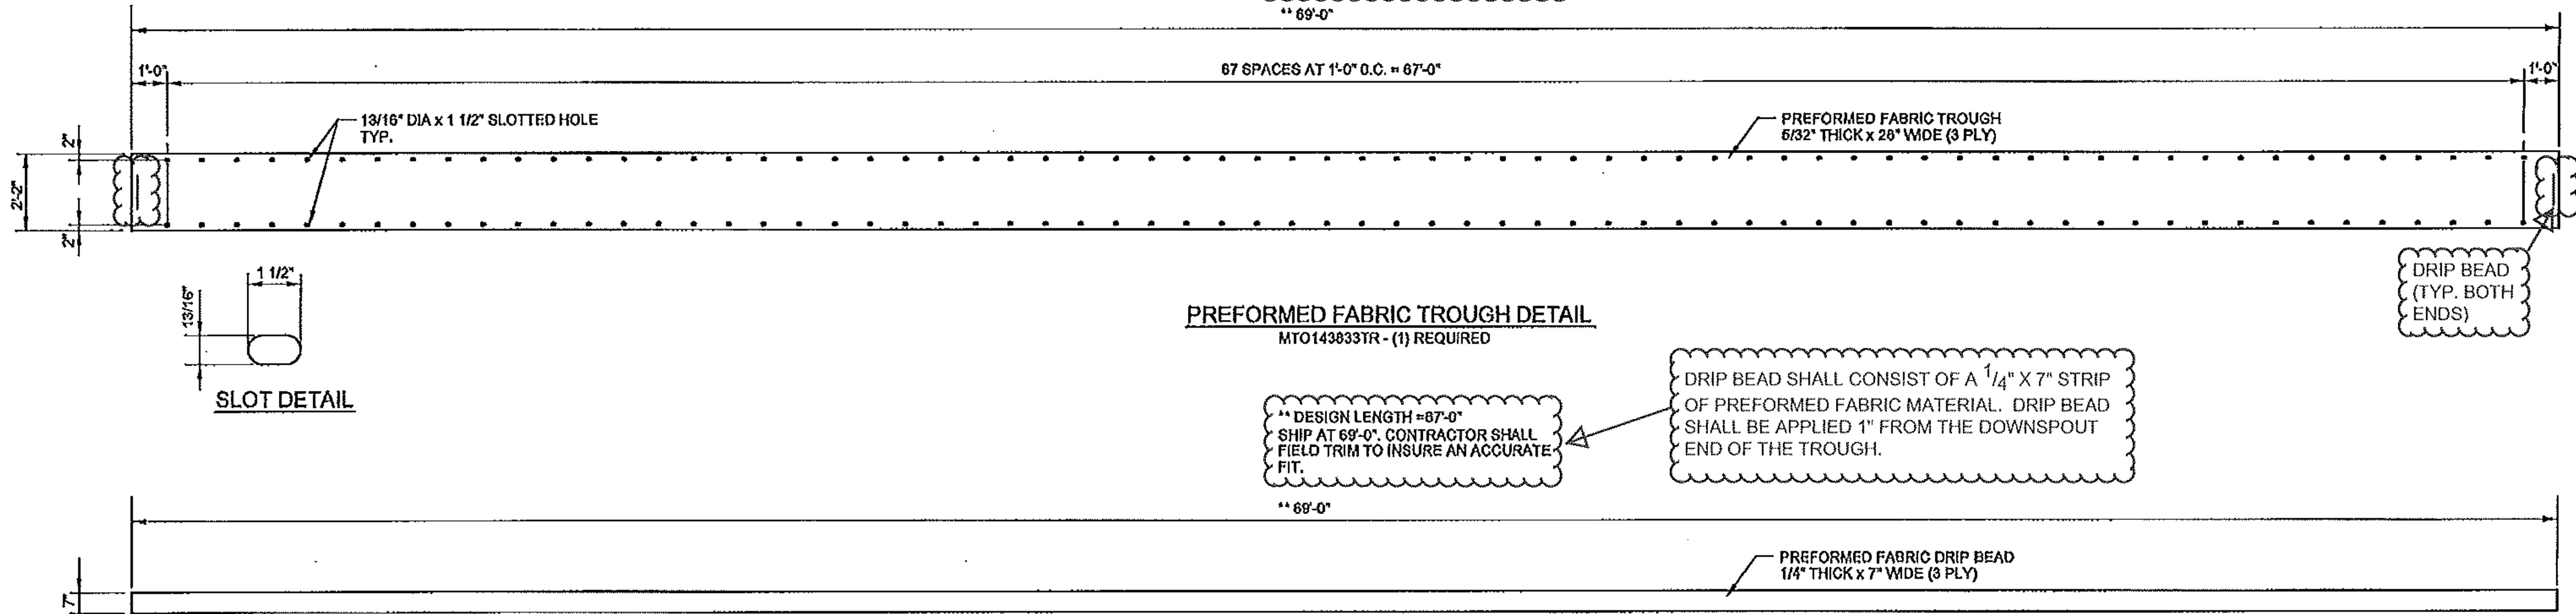

**PREFORMED FABRIC TROUGH DETAIL**  
MTO143833TR - (1) REQUIRED

\*\* DESIGN LENGTH = 67'-0"  
SHIP AT 69'-0". CONTRACTOR SHALL  
FIELD TRIM TO INSURE AN ACCURATE  
FIT.  
\*\* 69'-0"


DRIP BEAD SHALL CONSIST OF A 1/4" X 7" STRIP  
OF PREFORMED FABRIC MATERIAL. DRIP BEAD  
SHALL BE APPLIED 1" FROM THE DOWNSPOUT  
END OF THE TROUGH.

**PREFORMED DRIP BEAD DETAIL**  
MTO143833DB - (1) REQUIRED




**SHOP WELD**  $\Delta$   
1 1/4" x 5" BAR

**SHOP WELD**  $\Delta$   
8" x 4" x 1/2" ANGLE

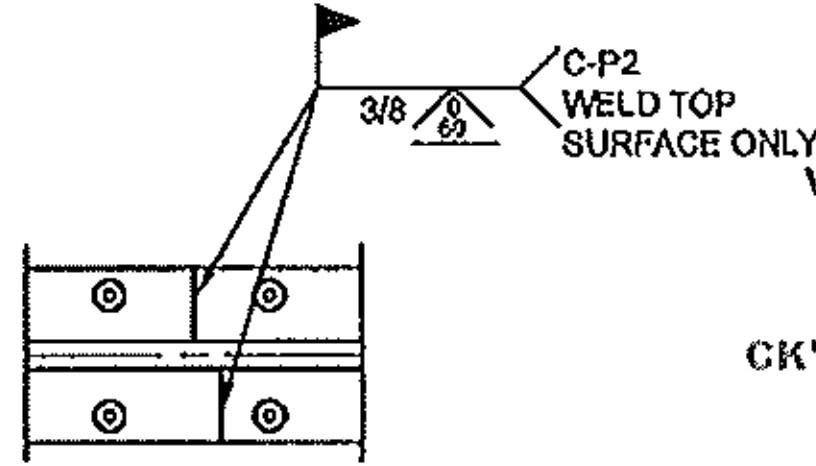


**FIELD WELD**  $\Delta$   
1 1/4" x 5" BAR


- NOTE: 1. SHIPPING CLAMPS SHALL BE SPACED 1'-0" FROM  
END OF JOINT AND 4'-0" O.C. THEREAFTER.
2. THE CONTRACTOR IS TO REMOVE THE SHIPPING CLAMPS  
WHEN THE JOINT IS SET. CONTRACTOR SHALL TOUCH  
UP ANY DAMAGED GALVANIZING.
3. EACH SHIPPING CLAMP ASSEMBLY SHALL INCLUDED.  
1 - ANGLE (4A1) 3" x 3" x 1/2"  
2 - 3/4"  $\phi$  x 3 1/2" LG FULLY THREADED BOLT  
2 - 3/4" WASHER

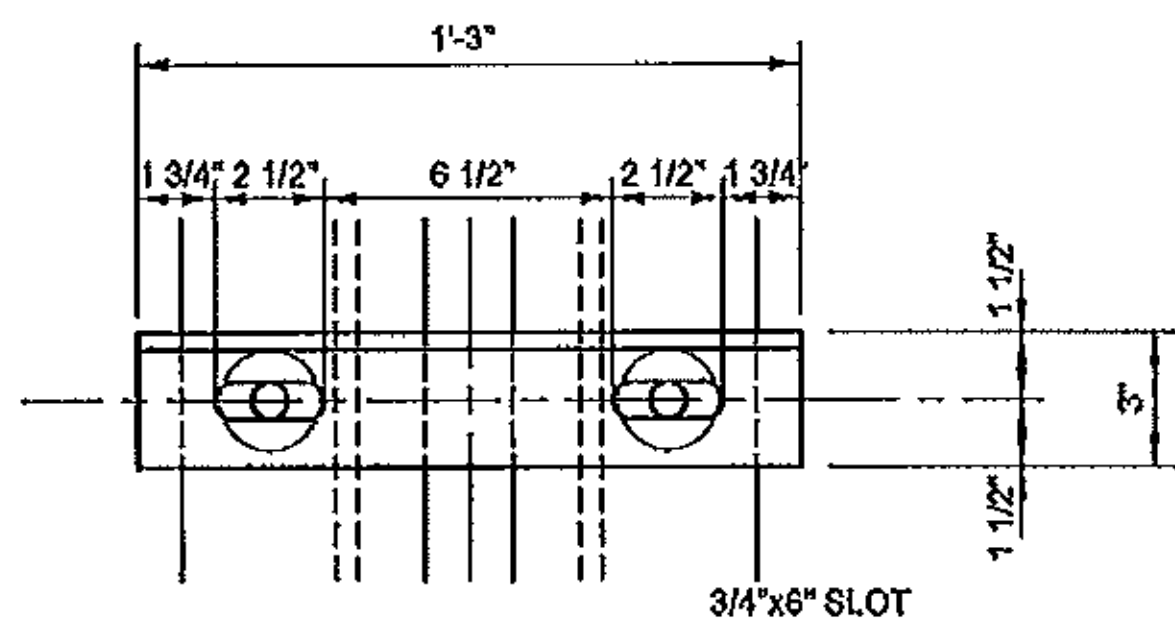

DETAIL - ANGLE (4A1)

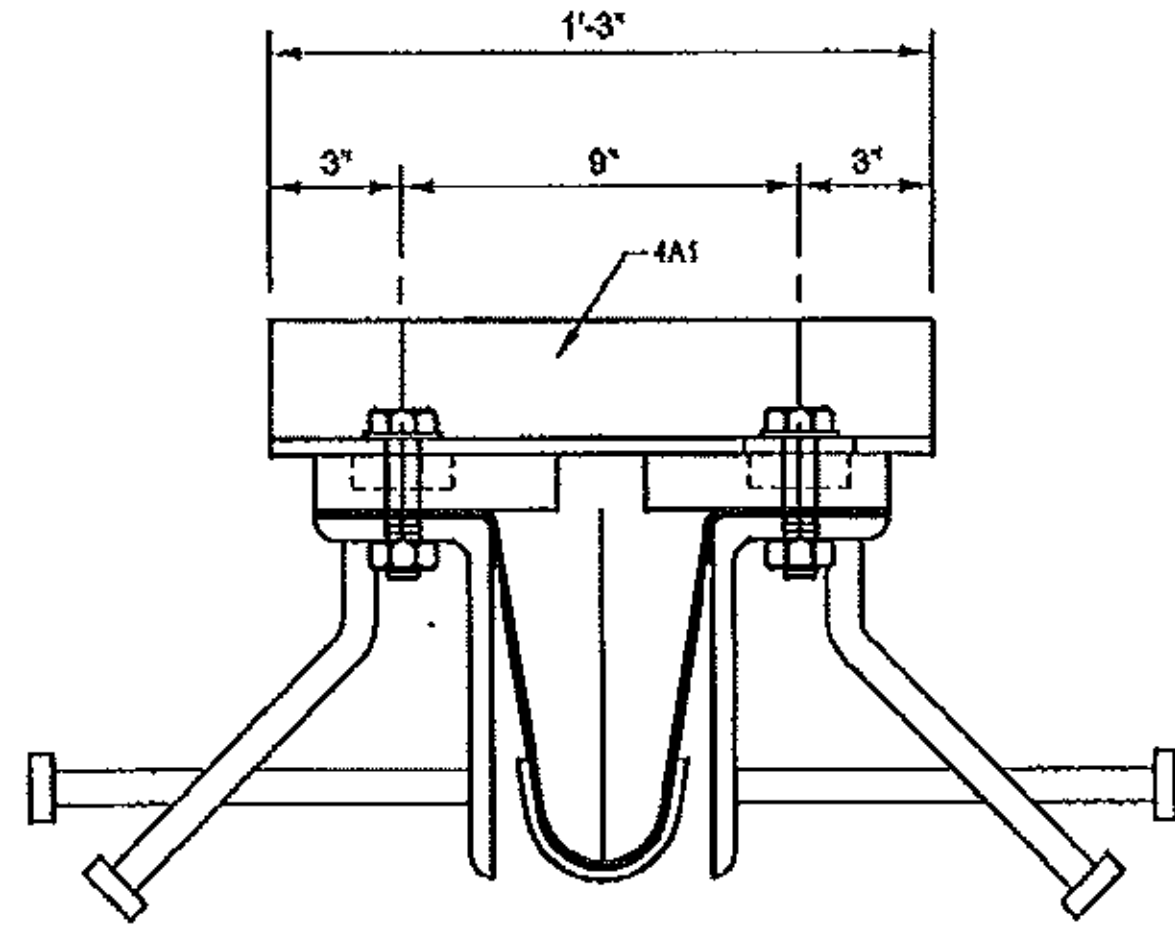

SHIPPING CLAMP  
ASSEMBLY  
THIS IS A TEMPORARY  
DEVICE

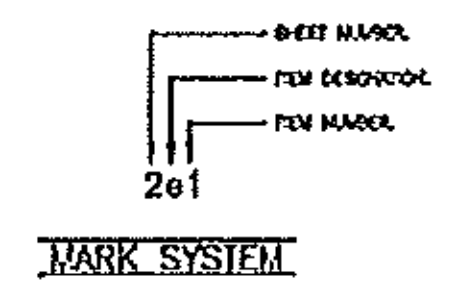

MARK SYSTEM

Vermont Agency of Transportation  
**RECEIVED**

CK'D BY M.E.M. OK'D BY C.W.M.  
08/21/2012  
RESUBMIT APPROVED AS NOTED  
BY C. CARLSON DATE 09/07/2012

~~Vermont Agency of Transportation  
**RECEIVED**  
CK'D BY M.E.M. OK'D BY C.W.M.  
Aug. 21, 2012  
RESUBMIT APPROVED   
BY C. CARLSON DATE Sept. 05, 2012  
STATE: VERMONT  
COUNTY: BENNINGTON  
PROJECT NO.: ER BHF 010-1(44)  
REFERENCE NO.: XXXXXXXXXX  
DISTRICT: XXX ROUTE: XXX  
WBA PRODUCT NO.: EMB143833AA~~

DRAWING ACTION:		DATE	BY
$\Delta$	ADDED WELD DETAILS	8-21-2012	JFW

 WATSON BOWMAN ACME CORPORATION 14 PROCTOR DRIVE, ALBANY, N.Y. 12211 TEL: (518) 881-7556 FAX: (518) 881-7527		DESIGNED BY JFW DATE 8-14-12
 The Chemical Company		CHECKED BY KF DATE 8-14-12
PROJECT: WOODFORD VT RT 9 BRIDGE NO. 11 OVER ROARING BRANCH OF THE WALLOOMSAC RIVER WABO PLATE JOINT W/NEOPRENE TROUGH DETAILS		SCALE NTS SHEET NO. 4 OF 5

G:\Engineer\WBA Projects\143833-T Buck-Woodford ER BHF\030-Drawings\B3008505.dwg, 8/21/2012 11:11:49 AM

LV	PART NO.	QTY	UM	DESCRIPTION	MATERIAL	REV.
0	EMB143833AA	1.00	EA	WABO PLATE EXP. JOINT; ABUTMENT 1; 67.0 LF (X)	JOINT IS GALVANIZED	
					SHIPPING LENGTH = 34 LF +/-	
1	NTS143833FB	135.00	FT	FLAT BAR 1 1/4" x 5 1/2"	A-36	
1	4170	135.00	FT	ANGLE 8" x 4" x 1/2"	A-36	
1	4782	68.00	EA	CONC ANC STUDS 3/4" DIA x 10" STRAIGHT	A-108	
1	4840	66.00	EA	CONC ANC STUDS 3/4" DIA x 10" BENT	A-108	
1	NTS143833BT	98.00	EA	3/4" DIA x 2 1/2" HEAVY HEX BOLT	AASHTO M164, TYPE 1 GALVANIZED	
1	NTS143833NT	132.00	EA	3/4" DIA HEAVY HEX NUT	ASTM A-563 GALVANIZED	
1	2830	150.00	EA	BEDDING TAPE	BUTYL RUBBER TAPE	
1	5308	34.00	EA	3/4" DIA x 3 1/2" HEX BOLT FULLY THREADED	FOR SHIPPING CLAMP	
1	7602	34.00	EA	3/4" DIA FLAT WASHER	FOR SHIPPING CLAMP	
1	EMB143833AA01	17.00	EA	SHIPPING CLAMP 3" x 3" x 3/8" x 1'-3" (4A1)		
2	3891	1.26	FT	ANGLE 3" x 3" x 3/8"	A-36	
1	EMB143833AA02	12.00	EA	SUPPORT BRACKET		
2	4640	20.00	LB	PLATE 1/2"	A-36	
1	EMB143833AA02	4.00	EA	FIELD SPLICE PLATE		
2	6021	0.55	FT	FLAT BAR 1/2" x 3 1/2"	A-36	

LV	PART NO.	QTY	UM	DESCRIPTION	MATERIAL	REV.
0	EMB143833EB	1.00	EA	EMBEDMENT PLATE WITH STUDS (X)	UNCOATED	
1	3580	10.25	LB	PLATE 1/2" (3P3)	A-36	
1	4782	4.00	EA	CONC ANC STUDS 3/4" DIA x 10" STRAIGHT	A-108	

LV	PART NO.	QTY	UM	DESCRIPTION	MATERIAL	REV.
0	EMB143833SW	1.00	EA	SQUARE WASHER FOR SUPPORT BRACKET	GALVANIZED	
1	6011	0.34	FT	FLAT BAR 1/2" x 3"	A-36	

LV	PART NO.	QTY	UM	DESCRIPTION	MATERIAL	REV.
0	EMB143833TRI	1.00	EA	THREADED ROD 1" DIA x 6" LONG	UNCOATED	
1	7170	0.51	FT	1" DIA THREADED ROD		

LV	PART NO.	QTY	UM	DESCRIPTION	MATERIAL	REV.
0	EMB143833TR2	1.00	EA	THREADED ROD 1" DIA x 7" LONG	UNCOATED	
1	7170	0.59	FT	1" DIA THREADED ROD		

LV	PART NO.	QTY	UM	DESCRIPTION	MATERIAL	REV.
0	NTS143833AA	1.00	EA	PREFORMED FABRIC TROUGH 5/32" x 2'-2" x 60'-0" (THREE PLY) NEOPRENE		


LV	PART NO.	QTY	UM	DESCRIPTION	MATERIAL	REV.
0	NTS143833AB	2 1.00	EA	PREFORMED FABRIC DRIP EDGE 1/4" x 7" x 60'-0" (THREE PLY) NEOPRENE		

LV	PART NO.	QTY	UM	DESCRIPTION	MATERIAL	REV.
0	EMB143833PS	1.00	EA	PARTS FOR SHIPPING (V)		
1	NTS143833BT	34.00	EA	3/4" DIA x 2 1/2" HEAVY HEX BOLT	AASHTO M164, TYPE 1 GALVANIZED	
1	NTS143833BL	4.00	EA	7/8" DIA x 2" HEAVY HEX BOLT	AASHTO M164, TYPE 1 GALVANIZED	
1	NTS143833NL	4.00	EA	7/8" DIA HEAVY HEX NUT	ASTM A-563 GALVANIZED	
1	7591	8.00	EA	7/8" DIA FLAT WASHER	ASTM F-436 GALVANIZED	
1	7967	96.00	EA	1" DIA HEAVY HEX NUT (A)	ASTM A-563 GALVANIZED	
1	XXXX			ADHESIVE FOR DRIP EDGE		

Vermont Agency of Transportation  
**RECEIVED**

CK'D BY M.E.M. OK'D BY C.W.M.  
Aug. 21, 2012  
RESUBMIT APPROVED ✓  
BY C. CARLSON DATE Sept. 05, 2012

STATE: VERMONT  
COUNTY: BENNINGTON  
PROJECT NO.: ER BHF 010-1(44)  
REFERENCE NO.: XXXXXXXXX  
DISTRICT: XXX ROUTE: XXX  
WBA PRODUCT NO.: EMB143833AA

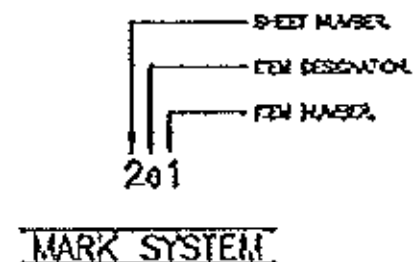

DRAWING ACTION:

NO.	DATE	BY	DESCRIPTION
1			
2			
3			



PROJECT: WOODFORD  
VT RT 9 BRIDGE NO. 11 OVER ROARING  
BRANCH OF THE WALLOOMSAC RIVER  
WABO PLATE JOINT W/NEOPRENE TROUGH DETAILS

DESIGNED BY	DATE
JFW	8-14-12
CHECKED BY	DATE
KF	8-14-12
SCALE	WBA JOB NO.
NTS	143833
SHEET NO.	DRAWING NO.
5 OF 5	B-30085

# TOUCH UP PAINT ON BEAMS

(INCIDENTAL TO ITEM 900.645-SPECIAL PROVISION-QC/QA CLEANING AND PAINTING STRUCTURAL COMPONENTS)

## Surface Preparation

- Surfaces not to be coated shall be identified and protected for the duration of cleaning and coating operations. We will be using tape/plastic as needed to protect areas not to be painted.
- Inspect surfaces for residual chlorides and sulfates which might impair service life of coatings due to osmotic blistering
- Decontaminate if indicated according to NACE 6G186 guidelines. Decontamination is not anticipated.
- Staging of work area as required for coating work.
- Surface preparation per SSPC SP1.
  1. **Solvent Cleaning SSPC-SP1 Definition:**

Solvents such as water, mineral spirits, xylol, toluol etc., are used to remove solvent-soluble foreign matter from the surface of ferrous metals. Rags and solvents must be replenished frequently to avoid spreading the contaminant rather than removing it. Low-pressure (1500 - 4000 psi) high volume (3 - 5 gal/min.) water washing with appropriate cleaning chemicals is a recognized "solvent cleaning" method. All surfaces should be should be cleaned per this specification prior to using hand tools or blast equipment.
- Identify flaws (chips), with indelible ink pen surface preparation per SSPC SP3 power tool clean grind "holidays" to feather out 1" from flaw. Apply repair product.
  1. **Power Tool Cleaning SSPC-SP3 (SSI-St3) Definition:**

A mechanical method of surface preparation widely used in industry and involving the use of power sanders or wire brushes, power chipping hammers, abrasive grinding wheels, needle guns etc. Although usually more effective than hand tool cleaning, it is not considered adequate for use under severe exposure conditions or for immersion applications.

### Coating Application

- Apply Sherwin Williams paint as originally specified to areas as required by manufacturer or as directed by the resident.
- Connections that are noted on the approved shop drawings as "primer only" will receive mid coat and top coat only.
- See attached cut sheets for Sherwin Williams material data sheets.

PAINT MANUFACTURER:  
SHERWIN WILLIAMS

PRODUCT SYSTEM:

-PRIMER COAT: ZINC CLAD III HS 100, ORGANIC ZINC RICH EPOXY PRIMER, 3-5 MILS DFT

-INTERMEDIATE COAT: MACROPOXY 646-100, FAST CURE EPOXY, 5-10 MILS DFT

-TOP COAT: ACROLON 218 HS, ACRYLIC POLYURETHANE, 3-6 MILS DFT

-TOP COAT COLOR: FEDERAL STANDARD 595 COLOR NO. 20059 BROWN.

IMAGE OF NOTE ON APPROVED SHOP DRAWINGS

### Coating Quality Control

- Log in lot numbers of all products to be used in coating application
- Record critical environmental conditions as required at least one time per shift
  - a. Relative humidity (as needed)
  - b. Surface temperature
  - c. Dew Point (as needed)
  - d. Ambient air temperature
- Record coating start time and stop time for each phase of work. This is to assure the proper overcoat windows are maintained.



**Protective  
&  
Marine  
Coatings**

# ZINC CLAD® III HS 100 ORGANIC ZINC-RICH EPOXY PRIMER

PART A  
PART B  
PART F

B69A110  
B69V110  
B69D11

BASE  
HARDENER  
ZINC DUST

Revised 2/12

## PRODUCT INFORMATION

6.10

### PRODUCT DESCRIPTION

ZINC CLAD III HS 100 is a three-component, polyamide epoxy, zinc-rich coating. It has a low VOC level and contains 90.3% by weight of zinc dust pigment in its dried film.

- Meets Class B requirements for Slip Coefficient and Creep Resistance
- Provides cathodic protection
- Damaged film exhibits "self-healing" properties
- Fast Recoat Time
- HAPS Free
- Outstanding application properties

### PRODUCT CHARACTERISTICS

**Finish:** Flat  
**Color:** Gray-green  
**Volume Solids:** 60% ± 2%, mixed  
**Weight Solids:** 88% ± 2%, mixed  
**VOC (EPA Method 24):** Unreduced: <100 g/L; 0.71 lb/gal mixed  
**Zinc Content in Dry Film:** 90.3% by weight  
**Mix Ratio:** 3 components, premeasured  
 3.25 gallons (12.3L) total

#### Recommended Spreading Rate per coat:

	Minimum	Maximum
Wet mils (microns)	5.0 (125)	8.0 (200)
Dry mils (microns)	3.0 (75)	5.0 (125)
~Coverage sq ft/gal (m <sup>2</sup> /L)	190 (4.6)	320 (7.8)
Theoretical coverage sq ft/gal (m <sup>2</sup> /L) @ 1 mil / 25 microns dft	960 (23.5)	

*NOTE: Brush or roll application may require multiple coats to achieve maximum film thickness and uniformity of appearance.*

#### Drying Schedule @ 5.0 mils wet (125 microns):

	@ 40°F/4.5°C	@ 77°F/25°C 50% RH	@ 120°F/49°C
To touch:	45 minutes	30 minutes	10 minutes
To handle:	2 hours	1 hour	30 minutes
To recoat*:			
minimum:	4 hours	2 hours	1 hour
maximum:	1 year	1 year	1 year
To cure:	10 days	7 days	5 days
<i>Drying time is temperature, humidity, and film thickness dependent.</i>			
<i>*NOTE: Film must be free of solvent, hard and firm. When rubbed with the face of a coin or knife the film should polish but not flake or chip.</i>			
Pot Life:	6 hours	4 hours	2 hours
Sweat-in-Time:	1 hour	30 minutes	15 minutes

**Shelf Life:** Parts A, B, & F: 24 months, unopened  
Store indoors at 40°F (4.5°C) to 100°F (38°C)  
**Flash Point:** 60°F (16°C), PMCC, mixed  
**Reducer/Clean Up:** R7K111 or R6K10

### RECOMMENDED USES

For use over properly prepared blasted steel.

- Fabrication Shops
- Bridge and Highway Structures
- Stadiums and Sports Complexes
- Drilling Rigs
- Piping
- Refineries
- Barges and Ships
- Wind Towers - onshore and offshore
- Shop or Field Applications
- Not recommended for immersion service.

### PERFORMANCE CHARACTERISTICS

**Substrate\*:** Steel  
**Surface Preparation\*:** SSPC-SP10/NACE 2  
**System Tested\*:**  
 1 ct. Zinc Clad III HS @ 5.0 mils (125 microns) dft  
 1 ct. Macropoxy 646 @ 5.0-10.0 mils (125-250 microns) dft  
 1 ct. Acrolon 218 HS @ 5.0 mils (125 microns) dft  
 \*unless otherwise noted below

Test Name	Test Method	Results
Adhesion	ASTM D4541	975 psi
Corrosion Weathering	ASTM D5894, 13 cycles, 2016 hours	Rating 10 per ASTM D610 for rusting; Rating 10 per ASTM D714 for blistering
Dry Heat Resistance (zinc only)	ASTM D2485	300°F (149°C)
Moisture Condensation Resistance	ASTM D4585, 100°F, 4000 hours	Rating 10 per ASTM D610 for rusting; Rating 10 per ASTM D714 for blistering
Pencil Hardness (zinc only)	ASTM D3363	2H
Salt Fog Resistance	ASTM B117, 4500 hours	Rating 10 per ASTM D610 for rusting; Rating 10 per ASTM D714 for blistering
Slip Coefficient* (zinc only)	AISC Specifications for Structural Joints using ASTM A325 or ASTM A490 Bolts	Class B, 0.51

Complies with ISO 12944-5 C5I and C5M requirements.

\*Refer to Slip Certification document



**Protective  
&  
Marine  
Coatings**

# ZINC CLAD® III HS 100 ORGANIC ZINC-RICH EPOXY PRIMER

PART A	B69A110	BASE
PART B	B69V110	HARDENER
PART F	B69D11	ZINC DUST

## PRODUCT INFORMATION 6.10

### RECOMMENDED SYSTEMS

	Dry Film Thickness / ct.	
	Mils	(Microns)
<b>Steel, polyurethane topcoat:</b>		
1 ct. Zinc Clad III HS 100	3.0-5.0	(75-125)
1-2 cts. Acrolon 218 HS	3.0-6.0	(75-150)
<b>Steel, catalyzed epoxy topcoat:</b>		
1 ct. Zinc Clad III HS 100	3.0-5.0	(75-125)
1-2 cts. Macropoxy 646	5.0-10.0	(125-250)
<b>Steel, catalyzed epoxy topcoat:</b>		
1 ct. Zinc Clad III HS 100	3.0-5.0	(75-125)
1-2 cts. Tile-Clad HS	2.5-4.0	(63-100)
<b>Steel, acrylic topcoat:</b>		
1 ct. Zinc Clad III HS 100	3.0-5.0	(75-125)
2 cts. DTM Acrylic Coating	2.5-4.0	(63-100)
or		
1 ct. Fast Clad HB Acrylic	5.0-8.0	(125-200)
<b>Steel, water based epoxy topcoat:</b>		
1 ct. Zinc Clad III HS 100	3.0-5.0	(75-125)
2 cts. Waterbased Tile-Clad Epoxy	2.0-4.0	(50-100)
<b>Steel, water-based urethane topcoat:</b>		
1 ct. Zinc Clad III HS 100	3.0-5.0	(75-125)
1 ct. Waterbased Tile-Clad Epoxy	2.0-4.0	(50-100)
1-2 cts. Hydrogloss	2.0-4.0	(50-100)

The systems listed above are representative of the product's use, other systems may be appropriate.

### DISCLAIMER

The information and recommendations set forth in this Product Data Sheet are based upon tests conducted by or on behalf of The Sherwin-Williams Company. Such information and recommendations set forth herein are subject to change and pertain to the product offered at the time of publication. Consult your Sherwin-Williams representative to obtain the most recent Product Data Information and Application Bulletin.

### SURFACE PREPARATION

Surface must be clean, dry, and in sound condition. Remove all oil, dust, grease, dirt, loose rust, and other foreign material to ensure adequate adhesion.

Refer to product Application Bulletin for detailed surface preparation information.

Minimum recommended surface preparation:

Iron & Steel:	SSPC-SP6/NACE 3, 2 mil (50 micron) profile
Galvanizing:	SSPC-SP7
Weathered Zinc Rich Primer:	Clean, dry, sound

#### Surface Preparation Standards

Condition of Surface	ISO 8501-1 BS7079:A1	Swedish Std. SIS055900	SSPC	NACE
White Metal	Sa 3	Sa 3	SP 5	1
Near White Metal	Sa 2.5	Sa 2.5	SP 10	2
Commercial Blast	Sa 2	Sa 2	SP 6	3
Brush-Off Blast	Sa 1	Sa 1	SP 7	4
Hand Tool Cleaning	C St 2	C St 2	SP 2	-
Pitted & Rusty	D St 2	D St 2	SP 2	-
Rusty	C St 3	C St 3	SP 3	-
Power Tool Cleaning	Pitted & Rusty	D St 3	D St 3	SP 3

### TINTING

Do not tint.

### APPLICATION CONDITIONS

Temperature: 40°F (4.5°C) minimum, 120°F (49°C) maximum (air, surface, and material)  
At least 5°F (2.8°C) above dew point

Relative humidity: 85% maximum

Refer to product Application Bulletin for detailed application information.

### ORDERING INFORMATION

Packaging: 3.25 gallons (12.3L) mixed  
Part A 1 gallon (3.78L)  
Part B 1 gallon (3.78L)  
Part F 73 lb (33.1 Kg) Zinc Dust

Weight: 28.65 ± 0.2 lb/gal ; 3.44 Kg/L, mixed

### SAFETY PRECAUTIONS

Refer to the MSDS sheet before use.

Published technical data and instructions are subject to change without notice. Contact your Sherwin-Williams representative for additional technical data and instructions.

### WARRANTY

The Sherwin-Williams Company warrants our products to be free of manufacturing defects in accord with applicable Sherwin-Williams quality control procedures. Liability for products proven defective, if any, is limited to replacement of the defective product or the refund of the purchase price paid for the defective product as determined by Sherwin-Williams. NO OTHER WARRANTY OR GUARANTEE OF ANY KIND IS MADE BY SHERWIN-WILLIAMS, EXPRESSED OR IMPLIED, STATUTORY, BY OPERATION OF LAW OR OTHERWISE, INCLUDING MERCHANTABILITY AND FITNESS FOR A PARTICULAR PURPOSE.



Protective  
&  
Marine  
Coatings

# ZINC CLAD® III HS 100 ORGANIC ZINC-RICH EPOXY PRIMER

PART A B69A110 BASE  
PART B B69V110 HARDENER  
PART F B69D11 ZINC DUST

Revised 2/12

## APPLICATION BULLETIN

6.10

### SURFACE PREPARATIONS

Surface must be clean, dry, and in sound condition. Remove all oil, dust, grease, dirt, loose rust, and other foreign material to ensure adequate adhesion.

Zinc rich coatings require direct contact between the zinc pigment in the coating and the metal substrate for optimum performance.

#### Iron & Steel (atmospheric service)

Remove all oil and grease from surface by Solvent Cleaning per SSPC-SP1. Minimum surface preparation is Commercial Blast Cleaning per SSPC-SP6/NACE 3. For better performance, use Near White Metal Blast Cleaning per SSPC-SP10/NACE 2. Blast clean all surfaces using a sharp, angular abrasive for optimum surface profile (2 mils / 50 microns). Coat any bare steel the same day as it is cleaned or before flash rusting occurs.

#### Galvanized Steel

Allow to weather a minimum of six months prior to coating. Solvent Clean per SSPC-SP1 (recommended solvent is VM&P Naphtha). When weathering is not possible, or the surface has been treated with chromates or silicates, first Solvent Clean per SSPC-SP1 and apply a test patch. Allow paint to dry at least one week before testing adhesion. If adhesion is poor, brush blasting per SSPC-SP7 is necessary to remove these treatments. Rusty galvanizing requires a minimum of Hand Tool Cleaning per SSPC-SP2, prime the area the same day as cleaned or before flash rusting occurs.

#### Weathered Zinc-Rich Primer

Remove zinc salts by either high pressure water washing and scrubbing with stiff bristle brush or sweep blast followed by water flush. Allow to dry.

**Note:** If blast cleaning with steel media is used, an appropriate amount of steel grit blast media may be incorporated into the work mix to render a dense, angular 1.5-3.0 mil (38-75 micron) surface profile, per Keane-Tator Surface Profile Comparator. A profile up to 4 mils (100 microns) is acceptable, however, coating must be applied to achieve a minimum of 3 mils (75 microns) dft. This method may result in improved adhesion and performance.

#### Surface Preparation Standards

Condition of Surface	ISO 8501-1 BS7079:A1	Swedish Std. SIS055900	SSPC	NACE
White Metal	Sa 3	Sa 3	SP 5	1
Near White Metal	Sa 2.5	Sa 2.5	SP 10	2
Commercial Blast	Sa 2	Sa 2	SP 6	3
Brush-Off Blast	Sa 1	Sa 1	SP 7	4
Hand Tool Cleaning	C St 2	C St 2	SP 2	-
Pitted & Rusted	D St 2	D St 2	SP 2	-
Rusted	C St 3	C St 3	SP 3	-
Power Tool Cleaning	Pitted & Rusted D St 3	D St 3	SP 3	-

### APPLICATION CONDITIONS

Temperature: 40°F (4.5°C) minimum, 120°F (49°C) maximum  
(air, surface, and material)  
At least 5°F (2.8°C) above dew point

Relative humidity: 85% maximum

### APPLICATION EQUIPMENT

The following is a guide. Changes in pressures and tip sizes may be needed for proper spray characteristics. Always purge spray equipment before use with listed reducer. Any reduction must be compliant with existing VOC regulations and compatible with the existing environmental and application conditions.

Reducer/Clean Up.....R7K111 or R6K10

#### Airless Spray

(use Teflon packings and continuous agitation)  
Pressure.....2000 - 2300 psi  
Hose.....3/8" ID  
Tip......019"  
Filter.....none  
Reduction.....As needed up to 10% by volume

#### Conventional Spray

(continuous agitation required)  
Gun.....Binks 95  
Fluid Nozzle.....68  
Air Nozzle.....68P  
Atomization Pressure.....50 psi  
Fluid Pressure.....10 - 20 psi  
Reduction.....As needed up to 10% by volume

Keep pressure pot at level of applicator to avoid blocking of fluid line due to weight of material. Blow back coating in fluid line at intermittent shutdowns, but continue agitation at pressure pot.

#### Brush

Brush.....Small areas only; natural bristle  
Reduction.....Not recommended

If specific application equipment is not listed above, equivalent equipment may be substituted.



Protective  
&  
Marine  
Coatings

# ZINC CLAD® III HS 100 ORGANIC ZINC-RICH EPOXY PRIMER

PART A  
PART B  
PART F

B69A110  
B69V110  
B69D11

BASE  
HARDENER  
ZINC DUST

## APPLICATION BULLETIN

6.10

### APPLICATION PROCEDURES

Surface preparation must be completed as indicated.

Zinc Clad III HS 100 comes in 3 premeasured containers which when mixed provides 3.25 gallons (12.3L) of ready-to-apply material.

#### Mixing Instructions:

Mix contents of component A and B thoroughly with a low speed power agitator. Make certain no pigment remains on the bottom of the can. Then combine 1 part by volume of Part A with 1 part by volume of Part B, then add Part F (73 lb zinc dust). Thoroughly agitate the mixture with power agitation. After mixing, pour through a 30-60 mesh screen. Allow the material to sweat-in as indicated. Re-stir before using.

If reducer solvent is used, add only after components have been thoroughly mixed, after sweat-in. Continuous agitation of mixture during application is required, otherwise zinc dust will quickly settle out.

Apply paint at the recommended film thickness and spreading rate as indicated below:

#### Recommended Spreading Rate per coat:

	Minimum	Maximum
Wet mils (microns)	5.0 (125)	8.0 (200)
Dry mils (microns)	3.0 (75)	5.0 (125)
~Coverage sq ft/gal (m <sup>2</sup> /L)	190 (4.6)	320 (7.8)
Theoretical coverage sq ft/gal (m <sup>2</sup> /L) @ 1 mil / 25 microns dft	960 (23.5)	

NOTE: Brush or roll application may require multiple coats to achieve maximum film thickness and uniformity of appearance.

#### Drying Schedule @ 5.0 mils wet (125 microns):

	@ 40°F/4.5°C	@ 77°F/25°C 50% RH	@ 120°F/49°C
To touch:	45 minutes	30 minutes	10 minutes
To handle:	2 hours	1 hour	30 minutes
To recoat*:			
minimum:	4 hours	2 hours	1 hour
maximum:	1 year	1 year	1 year
To cure:	10 days	7 days	5 days

Drying time is temperature, humidity, and film thickness dependent.

\*NOTE: Film must be free of solvent, hard and firm. When rubbed with the face of a coin or knife the film should polish but not flake or chip.

Pot Life:	6 hours	4 hours	2 hours
Sweat-in-Time:	1 hour	30 minutes	15 minutes

Application of coating above maximum or below minimum recommended spreading rate may adversely affect coating performance.

### CLEAN UP INSTRUCTIONS

Clean spills and splatters immediately with R7K111 or R6K10. Clean tools immediately after use with R7K111 or R6K10. Follow manufacturer's safety recommendations when using any solvent.

### DISCLAIMER

The information and recommendations set forth in this Product Data Sheet are based upon tests conducted by or on behalf of The Sherwin-Williams Company. Such information and recommendations set forth herein are subject to change and pertain to the product offered at the time of publication. Consult your Sherwin-Williams representative to obtain the most recent Product Data Information and Application Bulletin.

### PERFORMANCE TIPS

Stripe coat all crevices, welds, and sharp angles to prevent early failure in these areas.

When using spray application, use a 50% overlap with each pass of the gun to avoid holidays, bare areas, and pinholes. If necessary, cross spray at a right angle.

Spreading rates are calculated on volume solids and do not include an application loss factor due to surface profile, roughness or porosity of the surface, skill and technique of the applicator, method of application, various surface irregularities, material lost during mixing, spillage, overthinning, climatic conditions, and excessive film build.

Excessive reduction of material can affect film build, appearance, and performance.

Do not mix previously catalyzed material with new.

Do not apply the material beyond recommended pot life.

In order to avoid blockage of spray equipment, clean equipment before use or before periods of extended downtime with R7K111 or R6K10.

Keep pressure pot at level of applicator to avoid blocking of fluid line due to weight of material. Blow back coating in fluid line at intermittent shutdowns, but continue agitation at pressure pot.

Application above recommended film thickness may result in mud cracking.

Refer to Product Information sheet for additional performance characteristics and properties.

### SAFETY PRECAUTIONS

Refer to the MSDS sheet before use.

Published technical data and instructions are subject to change without notice. Contact your Sherwin-Williams representative for additional technical data and instructions.

### WARRANTY

The Sherwin-Williams Company warrants our products to be free of manufacturing defects in accord with applicable Sherwin-Williams quality control procedures. Liability for products proven defective, if any, is limited to replacement of the defective product or the refund of the purchase price paid for the defective product as determined by Sherwin-Williams. NO OTHER WARRANTY OR GUARANTEE OF ANY KIND IS MADE BY SHERWIN-WILLIAMS, EXPRESSED OR IMPLIED, STATUTORY, BY OPERATION OF LAW OR OTHERWISE, INCLUDING MERCHANTABILITY AND FITNESS FOR A PARTICULAR PURPOSE.



Protective  
&  
Marine  
Coatings

# MACROPOXY® 646-100 FAST CURE EPOXY

PART A  
PART B

B58-620  
B58V620

SERIES  
HARDENER

Revised 5/11

## PRODUCT INFORMATION

4.52

### PRODUCT DESCRIPTION

MACROPOXY 646-100 FAST CURE EPOXY is a high solids, less than 100 g/L VOC, high build, fast drying, polyamide epoxy designed to protect steel and concrete in industrial exposures. Ideal for maintenance painting and fabrication shop applications. The high solids content ensures adequate protection of sharp edges, corners, and welds. This product can be applied directly to marginally prepared steel surfaces.

- Low VOC, <100 g/L
- Low odor
- Outstanding application properties
- Chemical resistant
- Abrasion resistant

### PRODUCT CHARACTERISTICS

**Finish:** Semi-Gloss  
**Color:** Mill White and a wide range of colors available through tinting  
**Volume Solids:** 73% ± 2%, mixed  
 Mill White  
**Weight Solids:** 83% ± 2%, mixed  
 Mill White  
**VOC (EPA Method 24):** Unreduced: <100 g/L; .83 lb/gal  
 mixed Reduced 10%: <100 g/L; .83 lb/gal  
**Mix Ratio:** 1:1 by volume

#### Recommended Spreading Rate per coat:

	Minimum	Maximum
Wet mils (microns)	7.0 (175)	13.5 (338)
Dry mils (microns)	5.0* (125)	10.0* (250)*
~Coverage sq ft/gal (m <sup>2</sup> /L)	116 (2.8)	232 (5.7)
Theoretical coverage sq ft/gal (m <sup>2</sup> /L) @ 1 mil / 25 microns dft	1168 (28.6)	

NOTE: Brush or roll application may require multiple coats to achieve maximum film thickness and uniformity of appearance.

\*See Recommended Systems on reverse side. See Performance Tips section also.

#### Drying Schedule @ 7.0 mils wet (175 microns):

	@ 40°F/4.5°C	@ 77°F/25°C 50% RH	@ 100°F/38°C
To touch:	4-5 hours	2 hours	1.5 hours
To handle:	48 hours	8 hours	4.5 hours
To recoat:			
minimum:	48 hours	8 hours	4.5 hours
maximum:	1 year	1 year	1 year
Cure for			
service:	10 days	7 days	4 days
immersion:	14 days	7 days	4 days
Pot Life:	10 hours	4 hours	2 hours
Sweat-in-time:	30 minutes	30 minutes	15 minutes

If maximum recoat time is exceeded, abrade surface before recoating.

Drying time is temperature, humidity, and film thickness dependent.

Pot Life: 10 hours 4 hours 2 hours  
 Sweat-in-time: 30 minutes 30 minutes 15 minutes

**Shelf Life:** 36 months, unopened  
 Store indoors at 40°F (4.5°C) to 100°F (38°C).  
**Flash Point:** 61°F (16°C), PMCC, mixed  
**Reducer/Clean Up:** Reducer R7K111 or Oxsol 100

### RECOMMENDED USES

- Marine applications
- Fabrication shops
- Pulp and paper mills
- Power plants
- Offshore platforms
- Refineries
- Chemical plants
- Tank exteriors
- Water treatment plants
- Mill White is acceptable for immersion use for salt water and fresh water
- Not acceptable for potable water
- Suitable for use in USDA inspected facilities
- Conforms to AWWA D102 OCS #5

### PERFORMANCE CHARACTERISTICS

**Substrate\*:** Steel  
**Surface Preparation\*:** SSPC-SP10/NACE 2  
**System Tested\*:**  
 1 ct. Macropoxy 646-100 Fast Cure @ 6.0 mils (150 microns) dft  
 \*unless otherwise noted below

Test Name	Test Method	Results
Abrasion Resistance	ASTM D4060, CS17 wheel, 1000 cycles, 1 kg load	84 mg loss
Accelerated Weathering - QUV <sup>1</sup>	ASTM D4587, QUV-A, 12,000 hours	Passes
Adhesion	ASTM D4541	1,037 psi
Corrosion Weathering <sup>1</sup>	ASTM D5894, 36 cycles, 12,000 hours	Rating 10 per ASTM D714 for blistering; Rating 9 per ASTM D610 for rusting
Direct Impact Resistance	ASTM D2794	30 in. lb.
Dry Heat Resistance	ASTM D2485	250°F (121°C)
Exterior Durability	1 year at 45° South	Excellent, chalks
Flexibility	ASTM D522, 180° blend, 3/4" mandrel	Passes
Immersion	1 year fresh and salt water	Passes, no rusting, blistering, or loss of adhesion
Pencil Hardness	ASTM D3363	3H
Salt Fog Resistance <sup>1</sup>	ASTM B117, 6,500 hours	Rating 10 per ASTM D610 for rusting; Rating 9 per ASTM D1654 for corrosion
Water Vapor Permeance	ASTM D1653, Method B	1.16 grains/day

Epoxy coatings may darken or discolor following application and curing.

#### Footnotes:

<sup>1</sup> Zinc Clad II Plus Primer



**Protective  
&  
Marine  
Coatings**

# MACROPOXY® 646-100 FAST CURE EPOXY

PART A  
PART B

B58-620  
B58V620

SERIES  
HARDENER

## PRODUCT INFORMATION

4.52

### RECOMMENDED SYSTEMS

	Dry Film Thickness / ct.	
	Mils	(Microns)
<b>Immersion and atmospheric:</b>		
<b>Steel:</b>		
2 cts. Macropoxy 646-100	5.0-10.0	(125-250)
<b>Concrete/Masonry, smooth:</b>		
2 cts. Macropoxy 646-100	5.0-10.0	(125-250)
<b>Concrete Block:</b>		
1 ct. Kem Cati-Coat HS Epoxy Filler/Sealer as needed to fill voids and provide a continuous substrate.	10.0-20.0	(250-500)
2 cts. Macropoxy 646-100	5.0-10.0	(125-250)
<b>Atmospheric:</b>		
<b>*Steel:</b>		
(Shop applied system, new construction, AWWA D102, can also be used at 3 mils (75 microns) dft when used as an intermediate coat as part of a multi-coat system)		
1 ct. Macropoxy 646-100 Fast Cure Epoxy	3.0-6.0	(75-150)
1-2 cts. of recommended topcoat		
<b>Steel:</b>		
1 ct. Recoatable Epoxy Primer	4.0-6.0	(100-150)
2 cts. Macropoxy 646-100	5.0-10.0	(125-250)
<b>Steel:</b>		
1 ct. Macropoxy 646-100	4.0-6.0	
1-2 cts. Acrolon 218 Polyurethane or Hi-Solids Polyurethane or SherThane 2K Urethane	3.0-6.0 3.0-5.0 2.0-4.0	(75-150) (75-125) (50-100)
<b>Steel:</b>		
2 cts. Macropoxy 646-100	5.0-10.0	(125-250)
1-2 cts. Tile-Clad HS Epoxy	2.5-4.0	(63-100)
<b>Steel:</b>		
1 ct. Zinc Clad II Plus	3.0-6.0	(75-150)
1 ct. Macropoxy 646-100	5.0-10.0	(125-250)
1-2 cts. Acrolon 218 Polyurethane	3.0-6.0	(75-150)
<b>Steel:</b>		
1 ct. Zinc Clad III HS or Zinc Clad IV	3.0-5.0 3.0-5.0	(75-125) (75-125)
1 ct. Macropoxy 646-100	5.0-10.0	(125-250)
1-2 cts. Hi-Solids Polyurethane-100	3.0-6.0	(75-150)
<b>Aluminum:</b>		
2 cts. Macropoxy 646-100	5.0-10.0	(125-250)
<b>Galvanizing:</b>		
2 cts. Macropoxy 646-100	5.0-10.0	(125-250)

The systems listed above are representative of the product's use, other systems may be appropriate.

### DISCLAIMER

The information and recommendations set forth in this Product Data Sheet are based upon tests conducted by or on behalf of The Sherwin-Williams Company. Such information and recommendations set forth herein are subject to change and pertain to the product offered at the time of publication. Consult your Sherwin-Williams representative to obtain the most recent Product Data Information and Application Bulletin.

### SURFACE PREPARATION

Surface must be clean, dry, and in sound condition. Remove all oil, dust, grease, dirt, loose rust, and other foreign material to ensure adequate adhesion.

Refer to product Application Bulletin for detailed surface preparation information.

Minimum recommended surface preparation:

Iron & Steel				
Atmospheric:	SSPC-SP2/3			
Immersion:	SSPC-SP10/NACE 2, 2-3 mil (50-75 micron) profile			
Aluminum:	SSPC-SP1			
Galvanizing:	SSPC-SP1			
Concrete & Masonry				
Atmospheric:	SSPC-SP13/NACE 6, or ICRI No. 310.2, CSP 1-3			
Immersion:	SSPC-SP13/NACE 6-4.3.1 or 4.3.2, or ICRI No. 310.2, CSP 1-3			

### Surface Preparation Standards

Condition of Surface	ISO 8501-1 BS7079:A1	Swedish Std. SIS055900	SSPC	NACE
White Metal	Sa 3	Sa 3	SP 5	1
Near White Metal	Sa 2.5	Sa 2.5	SP 10	2
Commercial Blast	Sa 2	Sa 2	SP 6	3
Brush-Off Blast	Sa 1	Sa 1	SP 7	4
Hand Tool Cleaning	R St 2	C St 2	SP 2	-
Pitted & Rusted	D St 2	D St 2	SP 3	-
Rusted	C St 3	D St 3	SP 3	-
Power Tool Cleaning	P St 3	D St 3	SP 3	-

### TINTING

Tint Part A with Maxitones at 150% strength. Five minutes minimum mixing on a mechanical shaker is required for complete mixing of color.

Tinting is not recommended for immersion service.

### APPLICATION CONDITIONS

Temperature:	40°F (4.5°C) minimum, 140°F (60°C) maximum (air, surface, and material)
Relative humidity:	At least 5°F (2.8°C) above dew point 85% maximum

Refer to product Application Bulletin for detailed application information.

### ORDERING INFORMATION

Packaging:	
Part A:	1 gallon (3.78L) and 5 gallon (18.9L) containers
Part B:	1 gallon (3.78L) and 5 gallon (18.9L) containers
Weight:	13.24 ± 0.2 lb/gal ; 1.6 Kg/L mixed, may vary by color

### SAFETY PRECAUTIONS

Refer to the MSDS sheet before use.

Published technical data and instructions are subject to change without notice. Contact your Sherwin-Williams representative for additional technical data and instructions.

### WARRANTY

The Sherwin-Williams Company warrants our products to be free of manufacturing defects in accord with applicable Sherwin-Williams quality control procedures. Liability for products proven defective, if any, is limited to replacement of the defective product or the refund of the purchase price paid for the defective product as determined by Sherwin-Williams. NO OTHER WARRANTY OR GUARANTEE OF ANY KIND IS MADE BY SHERWIN-WILLIAMS, EXPRESSED OR IMPLIED, STATUTORY, BY OPERATION OF LAW OR OTHERWISE, INCLUDING MERCHANTABILITY AND FITNESS FOR A PARTICULAR PURPOSE.



**Protective  
&  
Marine  
Coatings**

# MACROPOXY® 646-100 FAST CURE EPOXY

PART A  
PART B

B58-620  
B58V620

SERIES  
HARDENER

Revised 5/11

## APPLICATION BULLETIN

4.52

### SURFACE PREPARATIONS

Surface must be clean, dry, and in sound condition. Remove all oil, dust, grease, dirt, loose rust, and other foreign material to ensure adequate adhesion.

#### Iron & Steel, Atmospheric Service:

Minimum surface preparation is Hand Tool Clean per SSPC-SP2. Remove all oil and grease from surface by Solvent Cleaning per SSPC-SP1. For better performance, use Commercial Blast Cleaning per SSPC-SP6/NACE 3, blast clean all surfaces using a sharp, angular abrasive for optimum surface profile (2 mils / 50 microns). Prime any bare steel within 8 hours or before flash rusting occurs.

#### Iron & Steel, Immersion Service:

Remove all oil and grease from surface by Solvent Cleaning per SSPC-SP1. Minimum surface preparation is Near White Metal Blast Cleaning per SSPC-SP10/NACE 2. Blast clean all surfaces using a sharp, angular abrasive for optimum surface profile (2-3 mils / 50-75 microns). Remove all weld spatter and round all sharp edges by grinding. Prime any bare steel the same day as it is cleaned.

#### Aluminum

Remove all oil, grease, dirt, oxide and other foreign material by Solvent Cleaning per SSPC-SP1.

#### Galvanized Steel

Allow to weather a minimum of six months prior to coating. Solvent Clean per SSPC-SP1 (recommended solvent is VM&P Naphtha). When weathering is not possible, or the surface has been treated with chromates or silicates, first Solvent Clean per SSPC-SP1 and apply a test patch. Allow paint to dry at least one week before testing adhesion. If adhesion is poor, brush blasting per SSPC-SP7 is necessary to remove these treatments. Rusty galvanizing requires a minimum of Hand Tool Cleaning per SSPC-SP2, prime the area the same day as cleaned.

#### Concrete and Masonry

For surface preparation, refer to SSPC-SP13/NACE 6, or ICRI No. 310.2, CSP 1-3. Surfaces should be thoroughly clean and dry. Concrete and mortar must be cured at least 28 days @ 75°F (24°C). Remove all loose mortar and foreign material. Surface must be free of laitance, concrete dust, dirt, form release agents, moisture curing membranes, loose cement and hardeners. Fill bug holes, air pockets and other voids with Steel-Seam FT910.

#### Concrete, Immersion Service:

For surface preparation, refer to SSPC-SP13/NACE 6, Section 4.3.1 or 1.3.2 or ICRI No. 310.2, CSP 1-3.

#### Follow the standard methods listed below when applicable:

ASTM D4258 Standard Practice for Cleaning Concrete.  
ASTM D4259 Standard Practice for Abrading Concrete.  
ASTM D4260 Standard Practice for Etching Concrete.  
ASTM F1869 Standard Test Method for Measuring Moisture Vapor Emission Rate of Concrete.  
SSPC-SP 13/Nace 6 Surface Preparation of Concrete.  
ICRI No. 310.2 Concrete Surface Preparation.

#### Previously Painted Surfaces

If in sound condition, clean the surface of all foreign material. Smooth, hard or glossy coatings and surfaces should be dulled by abrading the surface. Apply a test area, allowing paint to dry one week before testing adhesion. If adhesion is poor, or if this product attacks the previous finish, removal of the previous coating may be necessary. If paint is peeling or badly weathered, clean surface to sound substrate and treat as a new surface as above.

#### Surface Preparation Standards

Condition of Surface	ISO 8501-1 BS7079:A1	Swedish Std. SIS055900	SSPC	NACE
White Metal	Sa 3	Sa 3	SP 5	1
Near White Metal	Sa 2.5	Sa 2.5	SP 10	2
Commercial Blast	Sa 2	Sa 2	SP 6	3
Brush-Off Blast	Sa 1	Sa 1	SP 7	4
Hand Tool Cleaning	C St 2	C St 2	SP 2	-
Pitted & Rusty	D St 2	D St 2	SP 2	-
Rusty	C St 3	C St 3	SP 3	-
Power Tool Cleaning	Pitted & Rusty	D St 3	SP 3	-

### APPLICATION CONDITIONS

Temperature: 40°F (4.5°C) minimum, 140°F (60°C) maximum  
(air, surface, and material)  
At least 5°F (2.8°C) above dew point

Relative humidity: 85% maximum

### APPLICATION EQUIPMENT

The following is a guide. Changes in pressures and tip sizes may be needed for proper spray characteristics. Always purge spray equipment before use with listed reducer. Any reduction must be compliant with existing VOC regulations and compatible with the existing environmental and application conditions.

Reducer/Clean Up .....Reducer R7K111 or Oxsol 100

#### Airless Spray

Pump.....30:1  
Pressure.....2800 - 3000 psi  
Hose.....1/4" ID  
Tip .....0.017" - .023"  
Filter .....60 mesh  
Reduction.....As needed up to 10% by volume

#### Conventional Spray

Gun .....DeVilbiss MBC-510  
Fluid Tip .....E  
Air Nozzle.....704  
Atomization Pressure.....60-65 psi  
Fluid Pressure.....10-20 psi  
Reduction.....As needed up to 10% by volume  
Requires oil and moisture separators


#### Brush

Brush.....Nylon/Polyester or Natural Bristle  
Reduction.....Not recommended

#### Roller

Cover .....3/8" woven with solvent resistant core  
Reduction.....Not recommended

If specific application equipment is not listed above, equivalent equipment may be substituted.

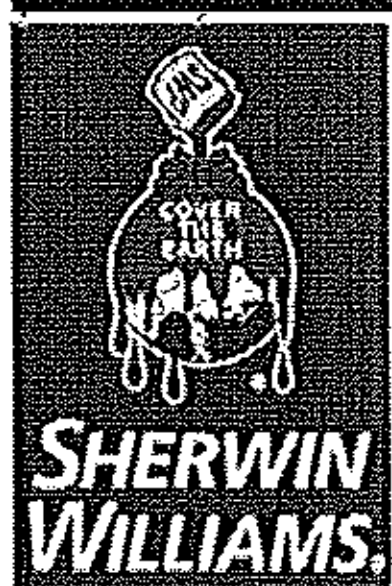

Protective  
&  
Marine  
Coatings

# MACROPOXY® 646-100 FAST CURE EPOXY

PART A  
PART B

B58-620  
B58V620

SERIES  
HARDENER

## APPLICATION BULLETIN

4.52

### APPLICATION PROCEDURES

Surface preparation must be completed as indicated.

Mix contents of each component thoroughly with low speed power agitation. Make certain no pigment remains on the bottom of the can. Then combine one part by volume of Part A with one part by volume of Part B. Thoroughly agitate the mixture with power agitation. Allow the material to sweat-in as indicated prior to application. Re-stir before using.

If reducer solvent is used, add only after both components have been thoroughly mixed, after sweat-in.

Apply paint at the recommended film thickness and spreading rate as indicated below:

#### Recommended Spreading Rate per coat:

	Minimum	Maximum
Wet mils (microns)	7.0 (175)	13.5 (338)
Dry mils (microns)	5.0* (125)	10.0* (250)*
~Coverage sq ft/gal (m <sup>2</sup> /L)	116 (2.8)	232 (5.7)
Theoretical coverage sq ft/gal (m <sup>2</sup> /L) @ 1 mil / 25 microns dft	1168 (28.6)	

NOTE: Brush or roll application may require multiple coats to achieve maximum film thickness and uniformity of appearance.

\*See Recommended Systems on reverse side. See Performance Tips section also.

#### Drying Schedule @ 7.0 mils wet (175 microns):

	@ 40°F/4.5°C	@ 77°F/25°C 50% RH	@ 100°F/38°C
To touch:	4-5 hours	2 hours	1.5 hours
To handle:	48 hours	8 hours	4.5 hours
To recoat:			
minimum:	48 hours	8 hours	4.5 hours
maximum:	1 year	1 year	1 year
Cure for			
service:	10 days	7 days	4 days
immersion:	14 days	7 days	4 days
Pot Life:	10 hours	4 hours	2 hours
Sweat-in-time:	30 minutes	30 minutes	15 minutes

If maximum recoat time is exceeded, abrade surface before recoating. Drying time is temperature, humidity, and film thickness dependent.

Application of coating above maximum or below minimum recommended spreading rate may adversely affect coating performance.

### CLEAN UP INSTRUCTIONS

Clean spills and spatters immediately with Reducer R7K111 or Oxsol 100. Clean tools immediately after use with Reducer R7K111 or Oxsol 100. Follow manufacturer's safety recommendations when using any solvent.

### DISCLAIMER

The information and recommendations set forth in this Product Data Sheet are based upon tests conducted by or on behalf of The Sherwin-Williams Company. Such information and recommendations set forth herein are subject to change and pertain to the product offered at the time of publication. Consult your Sherwin-Williams representative to obtain the most recent Product Data Information and Application Bulletin.

### PERFORMANCE TIPS

Stripe coat all crevices, welds, and sharp angles to prevent early failure in these areas.

When using spray application, use a 50% overlap with each pass of the gun to avoid holidays, bare areas, and pinholes. If necessary, cross spray at a right angle.

Spreading rates are calculated on volume solids and do not include an application loss factor due to surface profile, roughness or porosity of the surface, skill and technique of the applicator, method of application, various surface irregularities, material lost during mixing, spillage, overthinning, climatic conditions, and excessive film build.

Excessive reduction of material can affect film build, appearance, and adhesion.

Do not mix previously catalyzed material with new.

Do not apply the material beyond recommended pot life.

In order to avoid blockage of spray equipment, clean equipment before use or before periods of extended downtime with Reducer R7K111 or Oxsol 100.

Insufficient ventilation, incomplete mixing, miscatalyzation, and external heaters may cause premature yellowing.

Excessive film build, poor ventilation, and cool temperatures may cause solvent entrapment and premature coating failure.

Tinting is not recommended for immersion service.

Use only Mil White for immersion service.

Quik-Kick Epoxy Accelerator is acceptable for use. See data page 4.99 for details.

Application of coating above maximum or below minimum recommended spreading rate may adversely affect coating performance.

**For Immersion Service:** (if required) Holiday test in accordance with ASTM D5162 for steel, or ASTM D4787 for concrete.

When coating over aluminum and galvanizing, recommended dft is 2-4 mils (50-100 microns).

Acceptable for Concrete Floors.

Refer to Product Information sheet for additional performance characteristics and properties.

### SAFETY PRECAUTIONS

Refer to the MSDS sheet before use.

Published technical data and instructions are subject to change without notice. Contact your Sherwin-Williams representative for additional technical data and instructions.

### WARRANTY

The Sherwin-Williams Company warrants our products to be free of manufacturing defects in accord with applicable Sherwin-Williams quality control procedures. Liability for products proven defective, if any, is limited to replacement of the defective product or the refund of the purchase price paid for the defective product as determined by Sherwin-Williams. NO OTHER WARRANTY OR GUARANTEE OF ANY KIND IS MADE BY SHERWIN-WILLIAMS, EXPRESSED OR IMPLIED, STATUTORY, BY OPERATION OF LAW OR OTHERWISE, INCLUDING MERCHANTABILITY AND FITNESS FOR A PARTICULAR PURPOSE.



**Protective  
&  
Marine  
Coatings**

# ACROLON™ 218 HS ACRYLIC POLYURETHANE

PART A B65-600 GLOSS SERIES  
 PART A B65-650 SEMI-GLOSS SERIES  
 PART B B65V600 HARDENER

Revised 4/12

## PRODUCT INFORMATION

5.22

### PRODUCT DESCRIPTION

ACROLON 218 HS is a low VOC, polyester modified, aliphatic, acrylic polyurethane formulated specifically for in-shop applications. Also suitable for industrial applications. A fast drying, urethane that provides color and gloss retention for exterior exposure.

- Can be used directly over organic zinc rich primers (epoxy zinc primer and moisture cure urethane zinc primer)
- Color and gloss retention for exterior exposure
- Fast dry
- Outstanding application properties

### PRODUCT CHARACTERISTICS

**Finish:** Gloss or Semi-Gloss  
**Color:** Wide range of colors available  
**Volume Solids:** 65% ± 2%, mixed, may vary by color  
**Weight Solids:** 78% ± 2%, mixed, may vary by color  
**VOC (EPA Method 24):** Unreduced: <300 g/L; 2.5 lb/gal mixed  
 Reduced 10% with R7K15: <340 g/L; 2.8 lb/gal mixed  
 Reduced 9% with MEK, R6K10: <340 g/L; 2.8 lb/gal mixed  
**Mix Ratio:** 6:1 by volume, 1 gallon or 5 gallon mixes premeasured components

### Recommended Spreading Rate per coat:

	Minimum	Maximum
Wet mils (microns)	4.5 (112.5)	9.0 (225)
Dry mils (microns)	3.0 (75)	6.0 (150)
~Coverage sq ft/gal (m <sup>2</sup> /L)	175 (4.3)	346 (8.5)
Theoretical coverage sq ft/gal (m <sup>2</sup> /L) @ 1 mil / 25 microns dft	1040 (25.5)	

NOTE: Brush or roll application may require multiple coats to achieve maximum film thickness and uniformity of appearance.

### Drying Schedule @ 6.0 mils wet (150 microns):

	@ 35°F/1.7°C	@ 77°F/25°C 50% RH	@ 120°F/49°C
To touch:	4 hours	30 minutes	20 minutes
To handle:	18 hours	6 hours	4 hours
To recoat:			
minimum:	18 hours	8 hours	6 hours
maximum:	3 months	3 months	3 months
To cure:	14 days	7 days	5 days
Pot Life:	4 hours	2 hours	45 minutes
(reduced 5% with Reducer R7K15)			
Sweat-in-Time:	None		

If maximum recoat time is exceeded, abrade surface before recoating.  
 Drying time is temperature, humidity, and film thickness dependent.  
 Paint temperature must be at least 40°F (4.5°C) minimum.

**Shelf Life\*:** Part A - 36 months, unopened  
 Part B - 24 months, unopened  
 Store indoors at 40°F (4.5°C) to 100°F (38°C).  
 \*Aluminum (Part A, Rex # B65SW655) has a shelf life of 12 months.  
**Flash Point:** 55°F (13°C), Seta, mixed  
**Reducer/Clean Up:**  
 Spray: Reducer R7K15, MEK R6K10, or R7K111  
 Brush / Roll: Reducer #132, R7K132 or R7K111

### RECOMMENDED USES

Specifically formulated for in-shop applications. For use over prepared metal and masonry surfaces in industrial environments such as:

- Structural steel
- Rail cars and locomotives
- Conveyors
- Bridges
- Wind Towers - onshore and offshore
- Offshore platforms - exploration and production
- Suitable for use in USDA inspected facilities
- Conforms to AWWA D102 Outside Coating Systems #4 (OCS-4), #5 (OCS-5) & #6 (OCS-6)
- Acceptable for use in high performance architectural applications
- A component of INFINITANK

### PERFORMANCE CHARACTERISTICS

**Substrate\*:** Steel  
**Surface Preparation\*:** SSPC-SP10/NACE 2  
**System Tested\*:**  
 1 ct. Macropoxy 646 @ 6.0 mils (150 microns) dft  
 1 ct. Acrolon 218 HS Gloss @ 4.0 mils (100 microns) dft  
 \*unless otherwise noted below


Test Name	Test Method	Results
Abrasion Resistance <sup>1</sup>	ASTM D4060, CS17 wheel, 1000 cycles, 1 kg load	43 mg loss
Adhesion	ASTM D4541	975 psi
Corrosion Weathering <sup>2</sup>	ASTM D5894, 9 cycles, 3024 hours	Rating 10 per ASTM D610, for rusting; Rating 10 per ASTM D714, for blistering
Direct Impact Resistance <sup>1</sup>	ASTM D2794	50 in. lb.
Dry Heat Resistance <sup>1</sup>	ASTM D2485, Method A	200°F (93°C)
Flexibility <sup>1</sup>	ASTM D522, 180° bend, 1/8" mandrel	Passes
Humidity Resistance <sup>2</sup>	ASTM D4585, 100°F (38°C), 1500 hours	Rating 10 per ASTM D610, for rusting; Rating 10 per ASTM D714, for blistering
Pencil Hardness	ASTM D3363	3H
Salt Fog Resistance <sup>2</sup>	ASTM B117, 7000 hours	Rating 10 per ASTM D610, for rusting; Rating 9 per ASTM D714, for blistering

Meets the requirements of SSPC Paint No. 36, Level 3 for white and light colors. Dark colors may require a clear coat.

Complies with ISO 12944-5 C5I and C5M requirements.

### Footnotes:

<sup>1</sup> Finish coat only tested  
<sup>2</sup> Primer Zinc-Clad II Plus  
 Intermediate Macropoxy 646  
 Finish Acrolon 218 HS

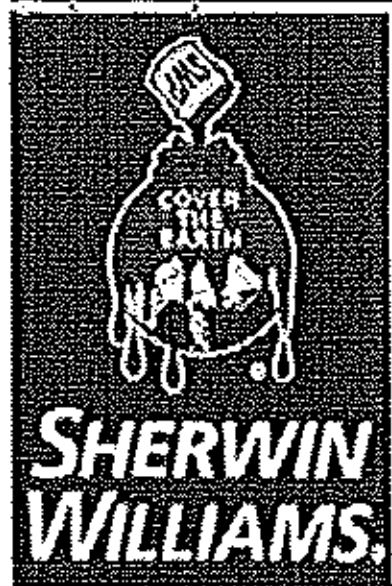

**Protective  
&  
Marine  
Coatings**

# ACROLON™ 218 HS ACRYLIC POLYURETHANE

PART A B65-600 GLOSS SERIES  
 PART A B65-650 SEMI-GLOSS SERIES  
 PART B B65V600 HARDENER

## PRODUCT INFORMATION

5.22

### RECOMMENDED SYSTEMS

	Dry Film Thickness / ct.	
	Mils	(Microns)
<b>Steel:</b>		
1 ct. Macropoxy 646	5.0-10.0	(125-250)
1-2 cts. Acrolon 218 HS Polyurethane	3.0-6.0	(75-150)
<b>Steel:</b>		
1 ct. Zinc Clad II Plus	3.0-5.0	(75-125)
1 ct. Macropoxy 646	5.0-10.0	(125-250)
1-2 cts. Acrolon 218 HS Polyurethane	3.0-6.0	(75-150)
<b>Steel:</b>		
1 ct. Zinc Clad IV	3.0-5.0	(75-125)
1-2 cts. Acrolon 218 HS Polyurethane	3.0-6.0	(75-150)
<b>Steel:</b>		
1 ct. Corothane I-GalvaPac Zinc Primer	3.0-4.0	(75-100)
1-2 cts. Acrolon 218 HS Polyurethane	3.0-6.0	(75-150)
<b>Steel:</b>		
1 ct. Epoxy Mastic Aluminum II	6.0	(150)
1-2 cts. Acrolon 218 HS Polyurethane	3.0-6.0	(75-150)
<b>Steel:</b>		
1 ct. Recoatable Epoxy Primer	4.0-6.0	(100-150)
1-2 cts. Acrolon 218 HS Polyurethane	3.0-6.0	(75-150)
<b>Concrete/Masonry:</b>		
1 ct. Kem Cati-Coat HS Epoxy Filler/Sealer	10.0-20.0	(250-500)
1-2 cts. Acrolon 218 HS Polyurethane	3.0-6.0	(75-150)
<b>Aluminum/Galvanizing:</b>		
1 ct. DTM Wash Primer	0.7-1.3	(18-32)
1-2 cts. Acrolon 218 HS Polyurethane	3.0-6.0	(75-150)
<b>ISO 12944 C5M System:</b>		
1 ct. Zinc Clad III HS	3.0-5.0	(75-125)
1 ct. Tower Guard Epoxy	5.0-11.5	(125-287.5)
1 ct. Acrolon 218 HS	3.0-6.0	(75-150)

### SURFACE PREPARATION

Surface must be clean, dry, and in sound condition. Remove all oil, dust, grease, dirt, loose rust, and other foreign material to ensure adequate adhesion.

Refer to product Application Bulletin for detailed surface preparation information.

Minimum recommended surface preparation:

- \* Iron & Steel: SSPC-SP6/NACE 3, 1-2 mil (25-50 micron) profile
- \* Galvanizing: SSPC-SP1
- \* Concrete & Masonry: SSPC-SP13/NACE 6, or ICRI No. 310.2, CSP 1-3

\* Primer required

#### Surface Preparation Standards

Condition of Surface	ISO 8501-1 BS7079:A1	Swedish Std. SIS055900	SSPC	NACE
White Metal	Sa 3	Sa 3	SP 5	1
Near White Metal	Sa 2.5	Sa 2.5	SP 10	2
Commercial Blast	Sa 2	Sa 2	SP 6	3
Brush-Off Blast	Sa 1	Sa 1	SP 7	4
Hand Tool Cleaning	C St 2	C St 2	SP 2	-
Pitted & Rusty	D St 2	D St 2	SP 2	-
Rusty	C St 3	C St 3	SP 3	-
Power Tool Cleaning	Pitted & Rusty	D St 3	SP 3	-

### TINTING

Tint Part A with Maxitoner Colorants.

- Extra white tints at 100% tint strength
- Ultradeep base tints at 150% tint strength

Five minutes minimum mixing on a mechanical shaker is required for complete mixing of color.

### APPLICATION CONDITIONS

Temperature: 35°F (1.7°C) minimum, 120°F (49°C) maximum (air and surface)  
 40°F (4.5°C) minimum, 120°F (49°C) maximum (material)  
 At least 5°F (2.8°C) above dew point

Relative humidity: 85% maximum

Refer to product Application Bulletin for detailed application information.

### ORDERING INFORMATION

Packaging: 1 gallon (3.78L) mix; 5 gallon (18.9L) mix;  
 Part A: .86 gal (3.25L) 4.29 gal (16.2L)  
 Part B: .14 gal (0.53L) 0.71 gal (2.7L)  
 (premeasured components)

Weight: 11.2 ± 0.2 lb/gal ; 1.3 Kg/L  
 mixed, may vary with color

### SAFETY PRECAUTIONS

Refer to the MSDS sheet before use.

Published technical data and instructions are subject to change without notice. Contact your Sherwin-Williams representative for additional technical data and instructions.

### WARRANTY

The Sherwin-Williams Company warrants our products to be free of manufacturing defects in accord with applicable Sherwin-Williams quality control procedures. Liability for products proven defective, if any, is limited to replacement of the defective product or the refund of the purchase price paid for the defective product as determined by Sherwin-Williams. NO OTHER WARRANTY OR GUARANTEE OF ANY KIND IS MADE BY SHERWIN-WILLIAMS, EXPRESSED OR IMPLIED, STATUTORY, BY OPERATION OF LAW OR OTHERWISE, INCLUDING MERCHANTABILITY AND FITNESS FOR A PARTICULAR PURPOSE.

### DISCLAIMER

The information and recommendations set forth in this Product Data Sheet are based upon tests conducted by or on behalf of The Sherwin-Williams Company. Such information and recommendations set forth herein are subject to change and pertain to the product offered at the time of publication. Consult your Sherwin-Williams representative to obtain the most recent Product Data Information and Application Bulletin.

The systems listed above are representative of the product's use, other systems may be appropriate.



**Protective  
&  
Marine  
Coatings**

# ACROLON™ 218 HS ACRYLIC POLYURETHANE

PART A	B65-600	GLOSS SERIES
PART A	B65-650	SEMI-GLOSS SERIES
PART B	B65V600	HARDENER

Revised 4/12

## APPLICATION BULLETIN

5.22

### SURFACE PREPARATIONS

Surface must be clean, dry, and in sound condition. Remove all oil, dust, grease, dirt, loose rust, and other foreign material to ensure adequate adhesion.

#### Iron & Steel

Remove all oil and grease from surface by Solvent Cleaning per SSPC-SP1. Minimum surface preparation is Commercial Blast Cleaning per SSPC-SP6/NACE 3. For better performance, use Near White Metal Blast Cleaning per SSPC-SP10/NACE 2. Blast clean all surfaces using a sharp, angular abrasive for optimum surface profile (1-2 mils / 25-50 microns). Prime any bare steel the same day as it is cleaned or before flash rusting occurs.

#### Aluminum

Remove all oil, grease, dirt, oxide and other foreign material by Solvent Cleaning per SSPC-SP1. Primer required.

#### Galvanized Steel

Allow to weather a minimum of six months prior to coating. Solvent Clean per SSPC-SP1. When weathering is not possible, or the surface has been treated with chromates or silicates, first Solvent Clean per SSPC-SP1 and apply a test patch. Allow paint to dry at least one week before testing adhesion. If adhesion is poor, brush blasting per SSPC-SP7 is necessary to remove these treatments. Rusty galvanizing requires a minimum of Hand Tool Cleaning per SSPC-SP2, prime the area the same day as cleaned or before flash rusting occurs. Primer required.

#### Concrete and Masonry

For surface preparation, refer to SSPC-SP13/NACE 6, or ICRI No. 310.2, CSP 1-3. Surfaces should be thoroughly clean and dry. Concrete and mortar must be cured at least 28 days @ 75°F (24°C). Remove all loose mortar and foreign material. Surface must be free of laitance, concrete dust, dirt, form release agents, moisture curing membranes, loose cement and hardeners. Fill bug holes, air pockets and other voids with Steel-Seam FT910. Primer required.

#### Follow the standard methods listed below when applicable:

ASTM D4258 Standard Practice for Cleaning Concrete.  
ASTM D4259 Standard Practice for Abrading Concrete.  
ASTM D4260 Standard Practice for Etching Concrete.  
ASTM F1869 Standard Test Method for Measuring Moisture Vapor Emission Rate of Concrete.  
SSPC-SP 13/Nace 6 Surface Preparation of Concrete.  
ICRI No. 310.2 Concrete Surface Preparation.

#### Surface Preparation Standards

Condition of Surface	ISO 8501-1 BS7079:A1	Swedish Std. SIS055900	SSPC	NACE
White Metal	Sa 3	Sa 3	SP 5	1
Near White Metal	Sa 2.5	Sa 2.5	SP 10	2
Commercial Blast	Sa 2	Sa 2	SP 6	3
Brush-Off Blast	Sa 1	Sa 1	SP 7	4
Hand Tool Cleaning	C St 2	C St 2	SP 2	-
Pitted & Rusted	D St 2	D St 2	SP 2	-
Rusted	C St 3	C St 3	SP 3	-
Power Tool Cleaning	Pitted & Rusted	D St 3	SP 3	-

### APPLICATION CONDITIONS

Temperature: 35°F (1.7°C) minimum, 120°F (49°C) maximum (air and surface)  
40°F (4.5°C) minimum, 120°F (49°C) maximum (material)  
At least 5°F (2.8°C) above dew point

Relative humidity: 85% maximum

### APPLICATION EQUIPMENT

The following is a guide. Changes in pressures and tip sizes may be needed for proper spray characteristics. Always purge spray equipment before use with listed reducer. Any reduction must be compliant with existing VOC regulations and compatible with the existing environmental and application conditions.

#### Reducer/Clean Up:

Spray.....Reducer R7K15, MEK R6K10, or R7K111  
Brush/Roll .....Reducer #132, R7K132, or R7K111  
If reducer is used, reduce at time of catalyzation.

#### Airless Spray

Pressure.....2500 - 2800 psi  
Hose.....3/8" ID  
Tip......013" - .017"  
Filter.....60 mesh  
Reduction.....As needed up to 10% by volume with R7K15 or R7K111, or up to 9% with MEK, R6K10\*

#### Conventional Spray

Gun .....Binks 95  
Cap .....63P  
Atomization Pressure.....50 - 70 psi  
Fluid Pressure.....20 - 25 psi  
Reduction.....As needed up to 10% by volume with R7K15 or R7K111, or up to 9% with MEK, R6K10\*

#### Brush

Brush.....Natural Bristle  
Reduction.....As needed up to 10% by volume\*

#### Roller

Cover .....3/8" woven with solvent resistant core  
Reduction.....As needed up to 10% by volume\*

If specific application equipment is not listed above, equivalent equipment may be substituted.

\* Note: Reducing more than maximum recommended level will result in VOC exceeding 340g/L



**Protective  
&  
Marine  
Coatings**

**ACROLON™ 218 HS  
ACRYLIC POLYURETHANE**

PART A B65-600 GLOSS SERIES  
 PART A B65-650 SEMI-GLOSS SERIES  
 PART B B65V600 HARDENER

**APPLICATION BULLETIN**

5.22

**APPLICATION PROCEDURES**

Surface preparation must be completed as indicated.

Mix contents of each component thoroughly with low speed power agitation. Make certain no pigment remains on the bottom of the can. Then combine six parts by volume of Part A with one part by volume of Part B (premeasured components). Thoroughly agitate the mixture with power agitation. Re-stir before using.

If reducer is used, add only after both components have been thoroughly mixed.

Apply paint at the recommended film thickness and spreading rate as indicated below:

**Recommended Spreading Rate per coat:**

	Minimum	Maximum
Wet mils (microns)	4.5 (112.5)	9.0 (225)
Dry mils (microns)	3.0 (75)	6.0 (150)
~Coverage sq ft/gal (m <sup>2</sup> /L)	175 (4.3)	346 (8.5)
Theoretical coverage sq ft/gal (m <sup>2</sup> /L) @ 1 mil / 25 microns dft	1040 (25.5)	

NOTE: Brush or roll application may require multiple coats to achieve maximum film thickness and uniformity of appearance.

**Drying Schedule @ 6.0 mils wet (150 microns):**

	@ 35°F/1.7°C	@ 77°F/25°C 50% RH	@ 120°F/49°C
To touch:	4 hours	30 minutes	20 minutes
To handle:	18 hours	6 hours	4 hours
To recoat:			
minimum:	18 hours	8 hours	6 hours
maximum:	3 months	3 months	3 months
To cure:	14 days	7 days	5 days
Pot Life:	4 hours	2 hours	45 minutes
(reduced 5% with Reducer R7K15)			
Sweat-in-Time:	None		

If maximum recoat time is exceeded, abrade surface before recoating. Drying time is temperature, humidity, and film thickness dependent. Paint temperature must be at least 40°F (4.5°C) minimum.

Application of coating above maximum or below minimum recommended spreading rate may adversely affect coating performance.

**CLEAN UP INSTRUCTIONS**

Clean spills and spatters immediately with Reducer #132, R7K132. Clean tools immediately after use with Reducer #132, R7K132. Follow manufacturer's safety recommendations when using any solvent.

**DISCLAIMER**

The information and recommendations set forth in this Product Data Sheet are based upon tests conducted by or on behalf of The Sherwin-Williams Company. Such information and recommendations set forth herein are subject to change and pertain to the product offered at the time of publication. Consult your Sherwin-Williams representative to obtain the most recent Product Data Information and Application Bulletin.

**PERFORMANCE TIPS**

Stripe coat all crevices, welds, and sharp angles to prevent early failure in these areas.

When using spray application, use a 50% overlap with each pass of the gun to avoid holidays, bare areas, and pinholes. If necessary, cross spray at a right angle.

Spreading rates are calculated on volume solids and do not include an application loss factor due to surface profile, roughness or porosity of the surface, skill and technique of the applicator, method of application, various surface irregularities, material lost during mixing, spillage, overthinning, climatic conditions, and excessive film build.

Excessive reduction of material can affect film build, appearance, and adhesion.

Do not apply the material beyond recommended pot life.

Do not mix previously catalyzed material with new.

In order to avoid blockage of spray equipment, clean equipment before use or before periods of extended downtime with Reducer #15, R7K15 or MEK, R6K10.

Mixed coating is sensitive to water. Use water traps in all air lines. Moisture contact can reduce pot life and affect gloss and color.

Quick-Thane Urethane Accelerator is acceptable for use. See data page 5.97 for details.

E-Z Roll Urethane Defoamer is acceptable for use. See data page 5.99 for details.

Refer to Product Information sheet for additional performance characteristics and properties.


**SAFETY PRECAUTIONS**

Refer to the MSDS sheet before use.


Published technical data and instructions are subject to change without notice. Contact your Sherwin-Williams representative for additional technical data and instructions.

**WARRANTY**

The Sherwin-Williams Company warrants our products to be free of manufacturing defects in accord with applicable Sherwin-Williams quality control procedures. Liability for products proven defective, if any, is limited to replacement of the defective product or the refund of the purchase price paid for the defective product as determined by Sherwin-Williams. NO OTHER WARRANTY OR GUARANTEE OF ANY KIND IS MADE BY SHERWIN-WILLIAMS, EXPRESSED OR IMPLIED, STATUTORY, BY OPERATION OF LAW OR OTHERWISE, INCLUDING MERCHANTABILITY AND FITNESS FOR A PARTICULAR PURPOSE.

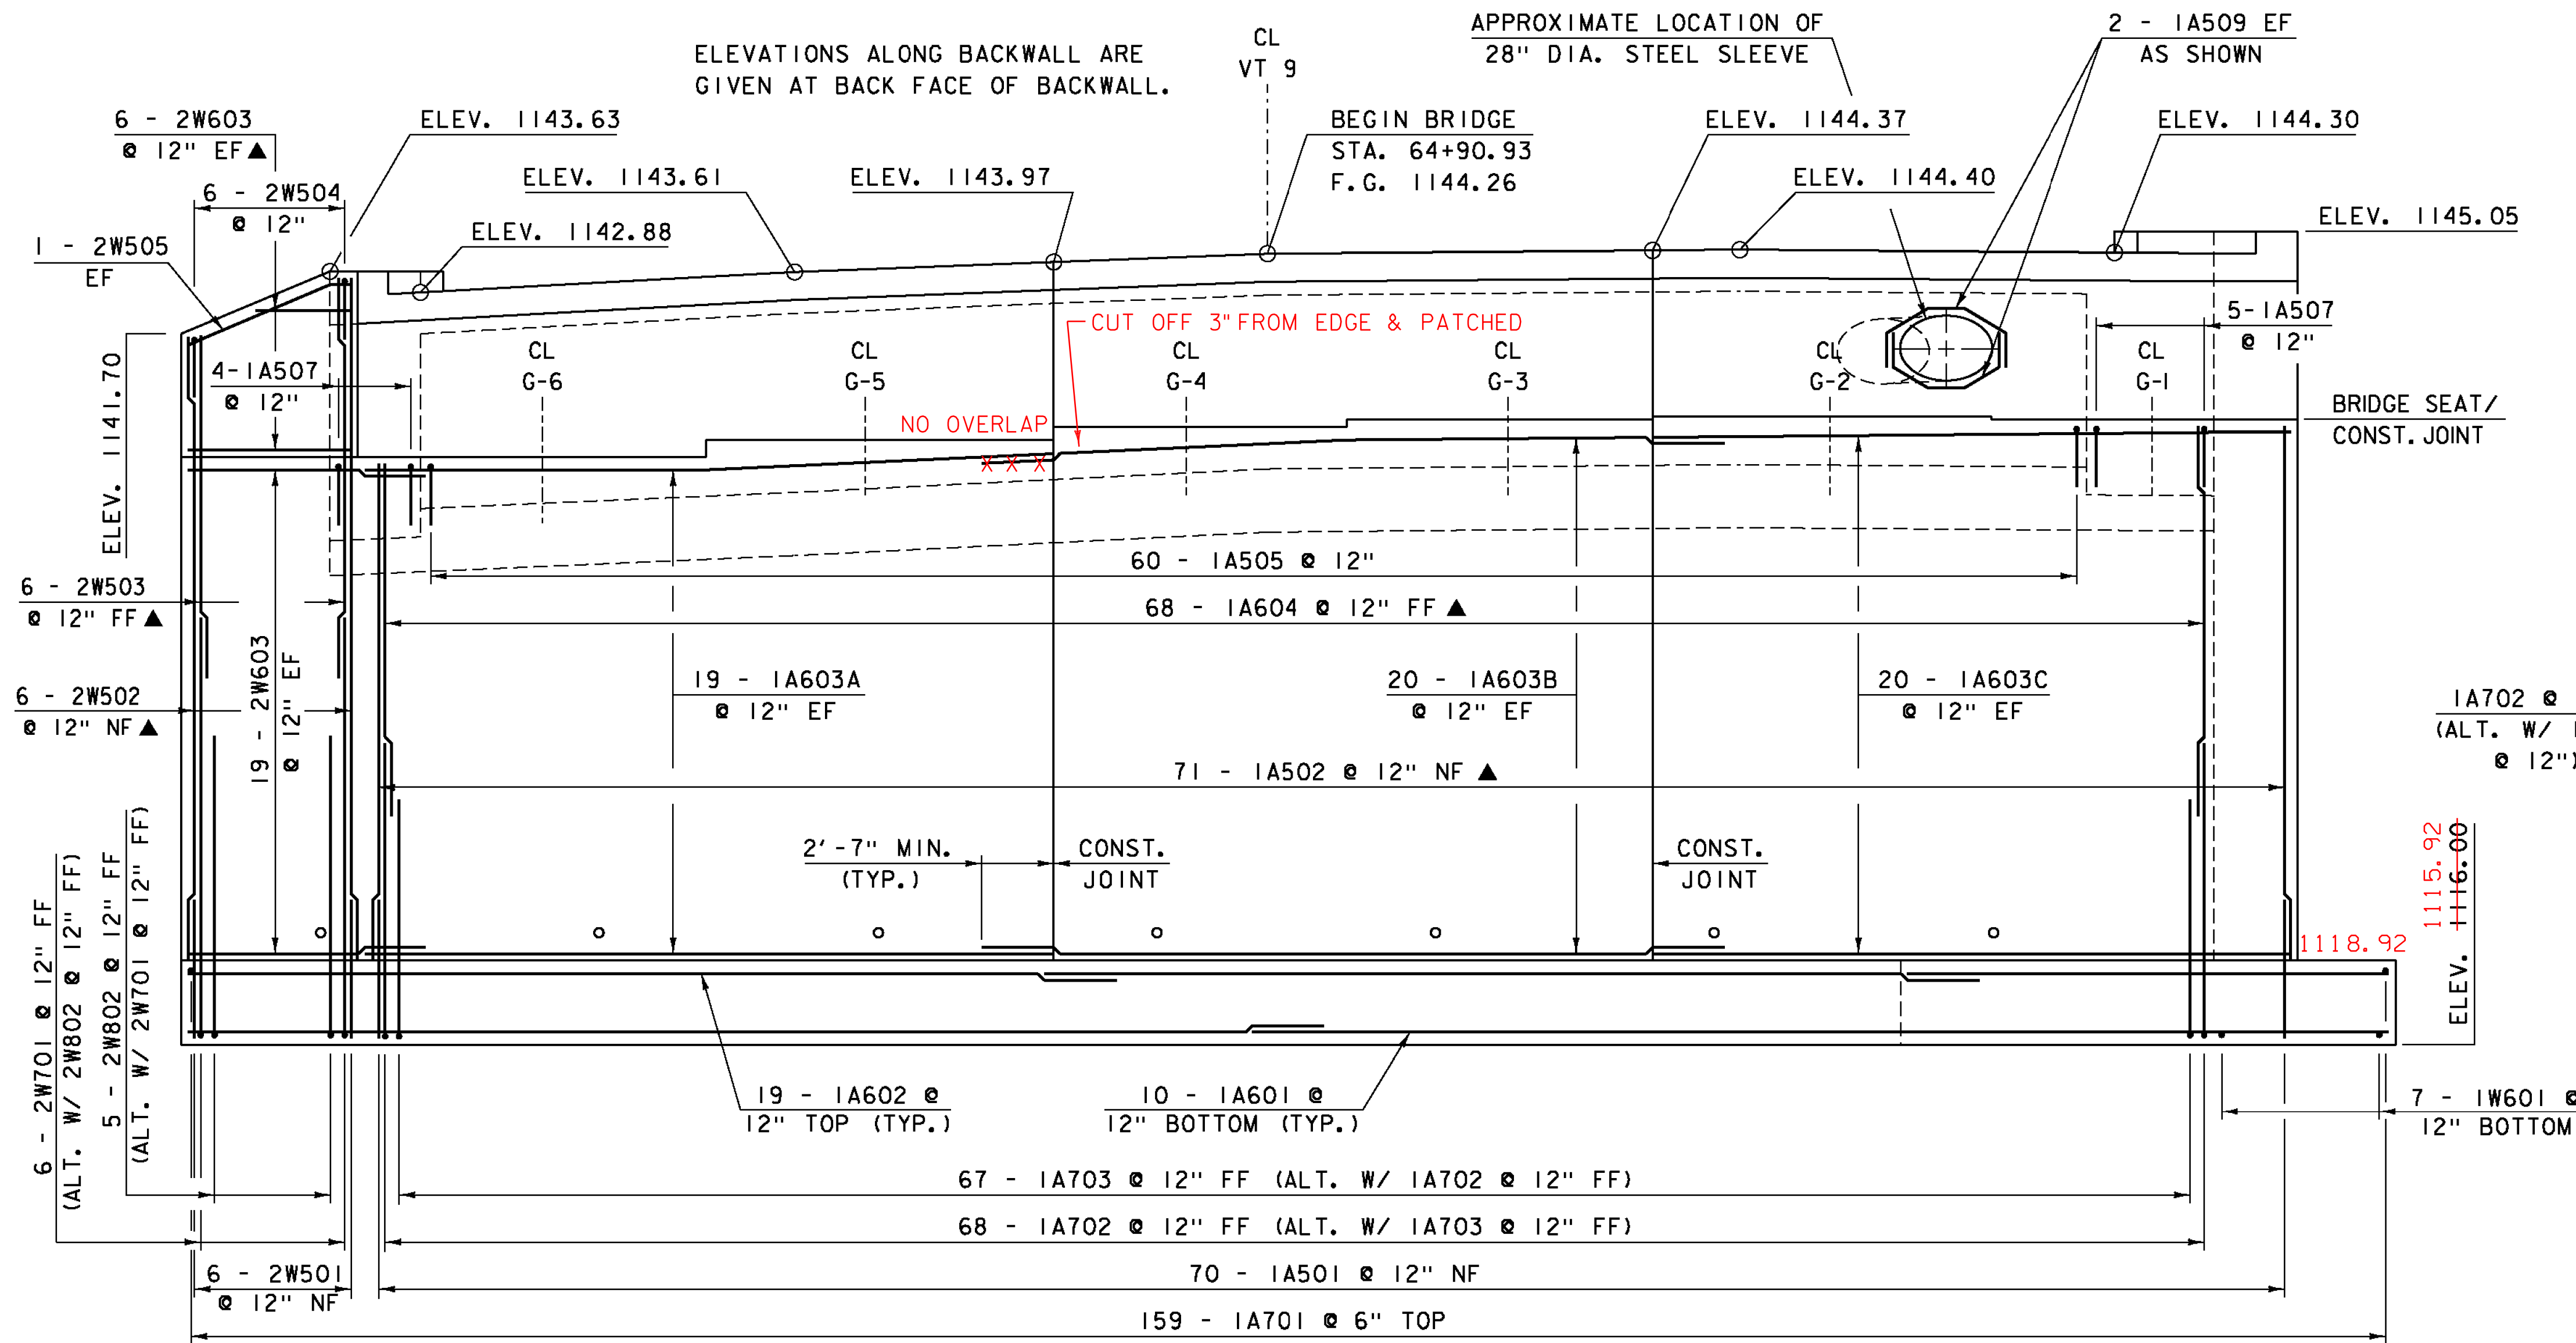


**ABUTMENT I ELEVATION**  
SCALE 1/4" = 1'-0"

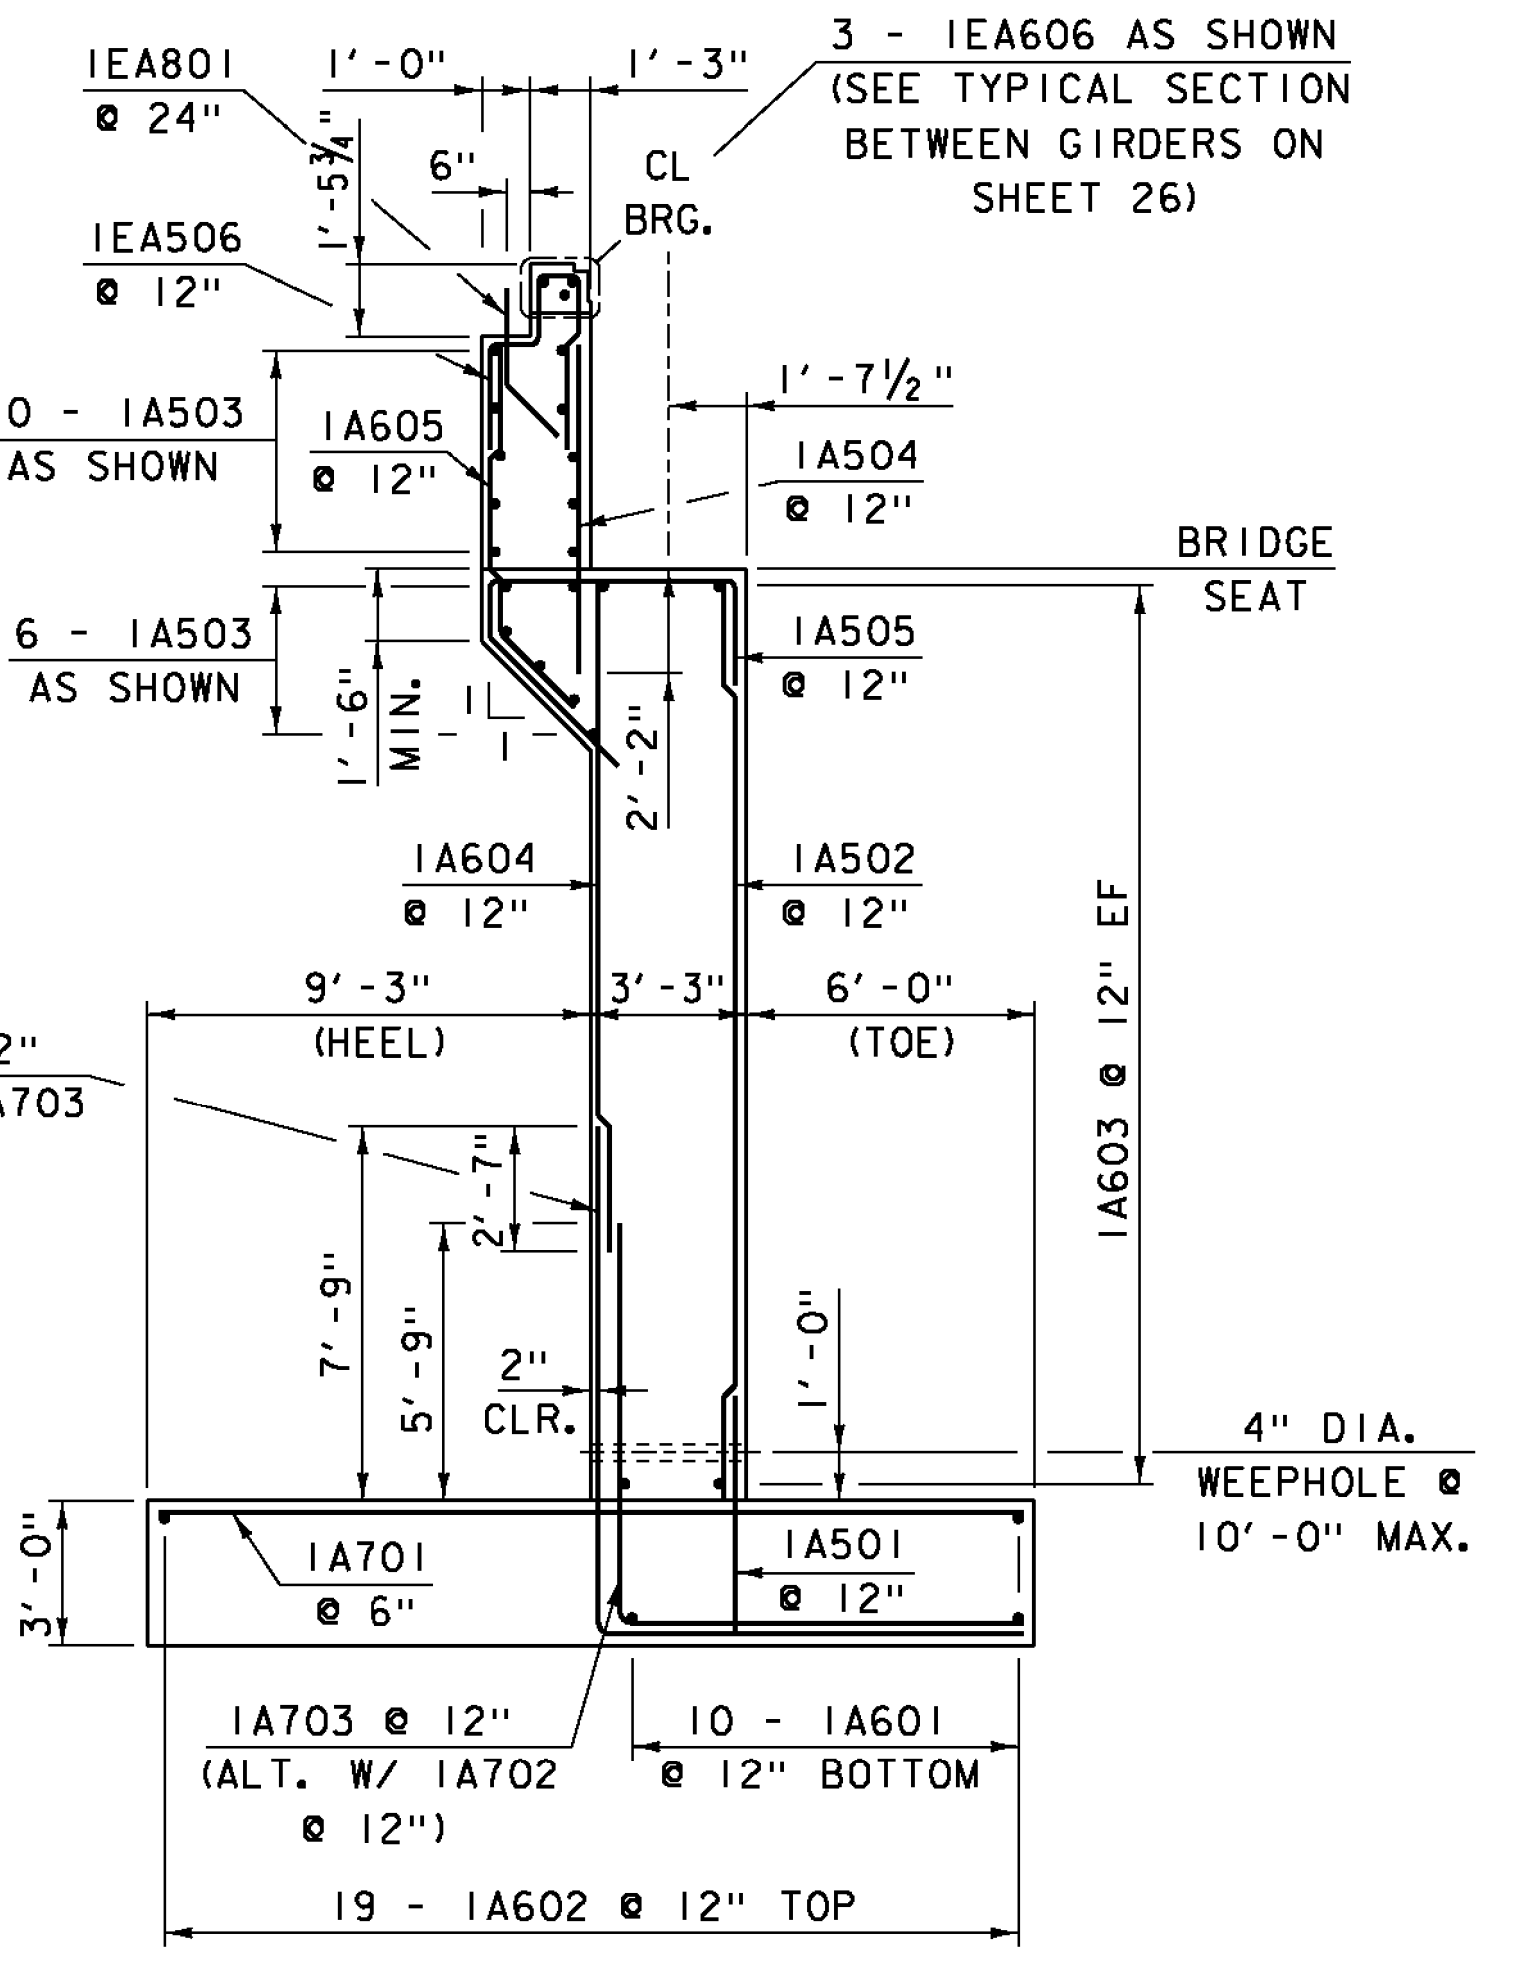

**ABUTMENT I TYPICAL SECTION**  
SCALE 1/4" = 1'-0"





BRIDGE SEAT	ELEVATION
SEAT 1	1138.33
SEAT 2	1138.42
SEAT 3	1138.33
SEAT 4	1138.06
SEAT 5	1137.61
SEAT 6	1136.99

**NOTE:**  
 NF = NEAR FACE  
 FF = FAR FACE  
 EF = EACH FACE  
 ▲ = CUT TO FIT IN FIELD  
 3" CLEAR, UNLESS OTHERWISE SPECIFIED ON THE PLANS.  
 2'-2" BAR LAP UNLESS OTHERWISE SPECIFIED ON THE PLANS.

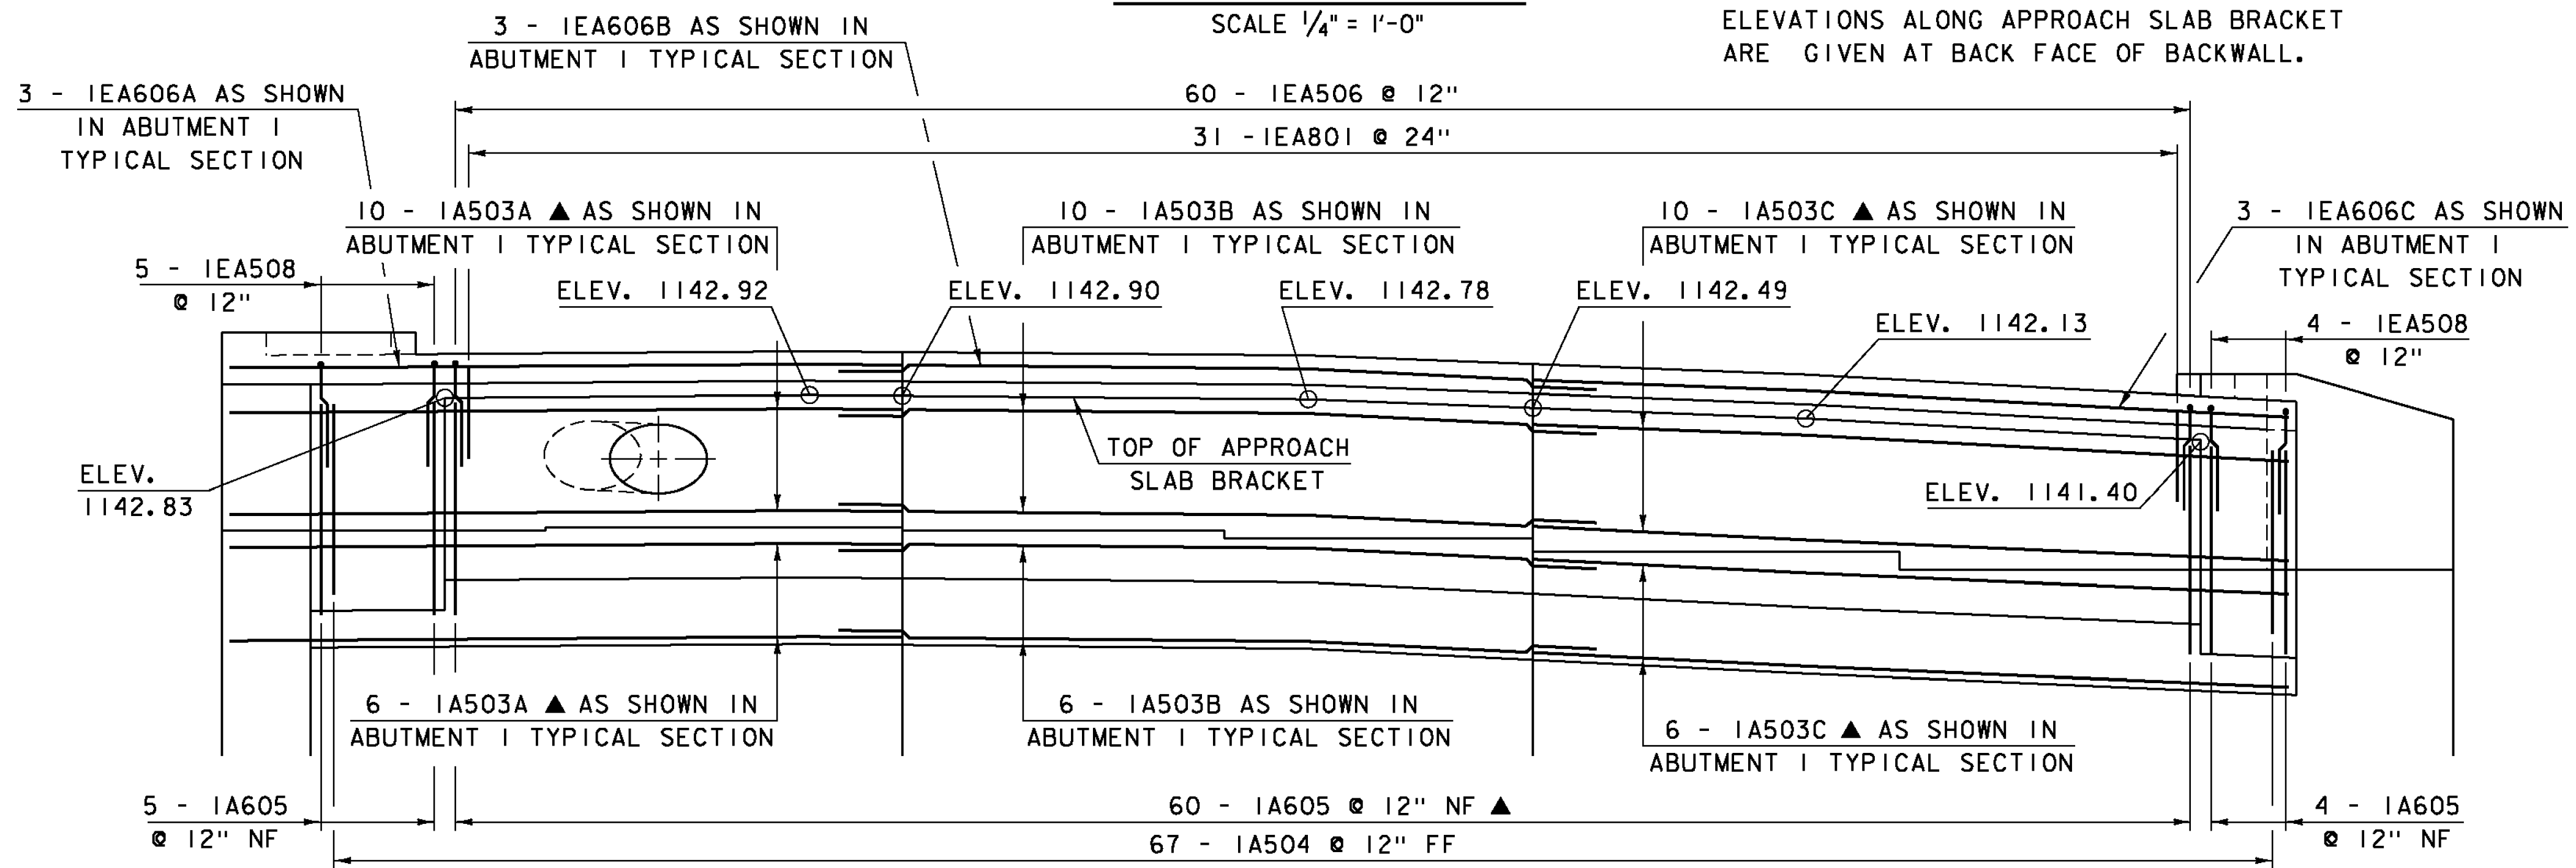

**ABUTMENT I ELEVATION (LOOKING AT BACK OF ABUTMENT)**  
SCALE 1/4" = 1'-0"

PROJECT NAME: WOODFORD  
 PROJECT NUMBER: ER BHF 010-(144)  
 FILE NAME: slb214sub.dgn PLOT DATE: 23-MAR-2012  
 PROJECT LEADER: C. CARLSON DRAWN BY: G. ROY  
 DESIGNED BY: M. EVANS-MONGEON CHECKED BY: M. EVANS-MONGEON  
 ABUTMENT I ELEVATION SHEET 32 OF 58

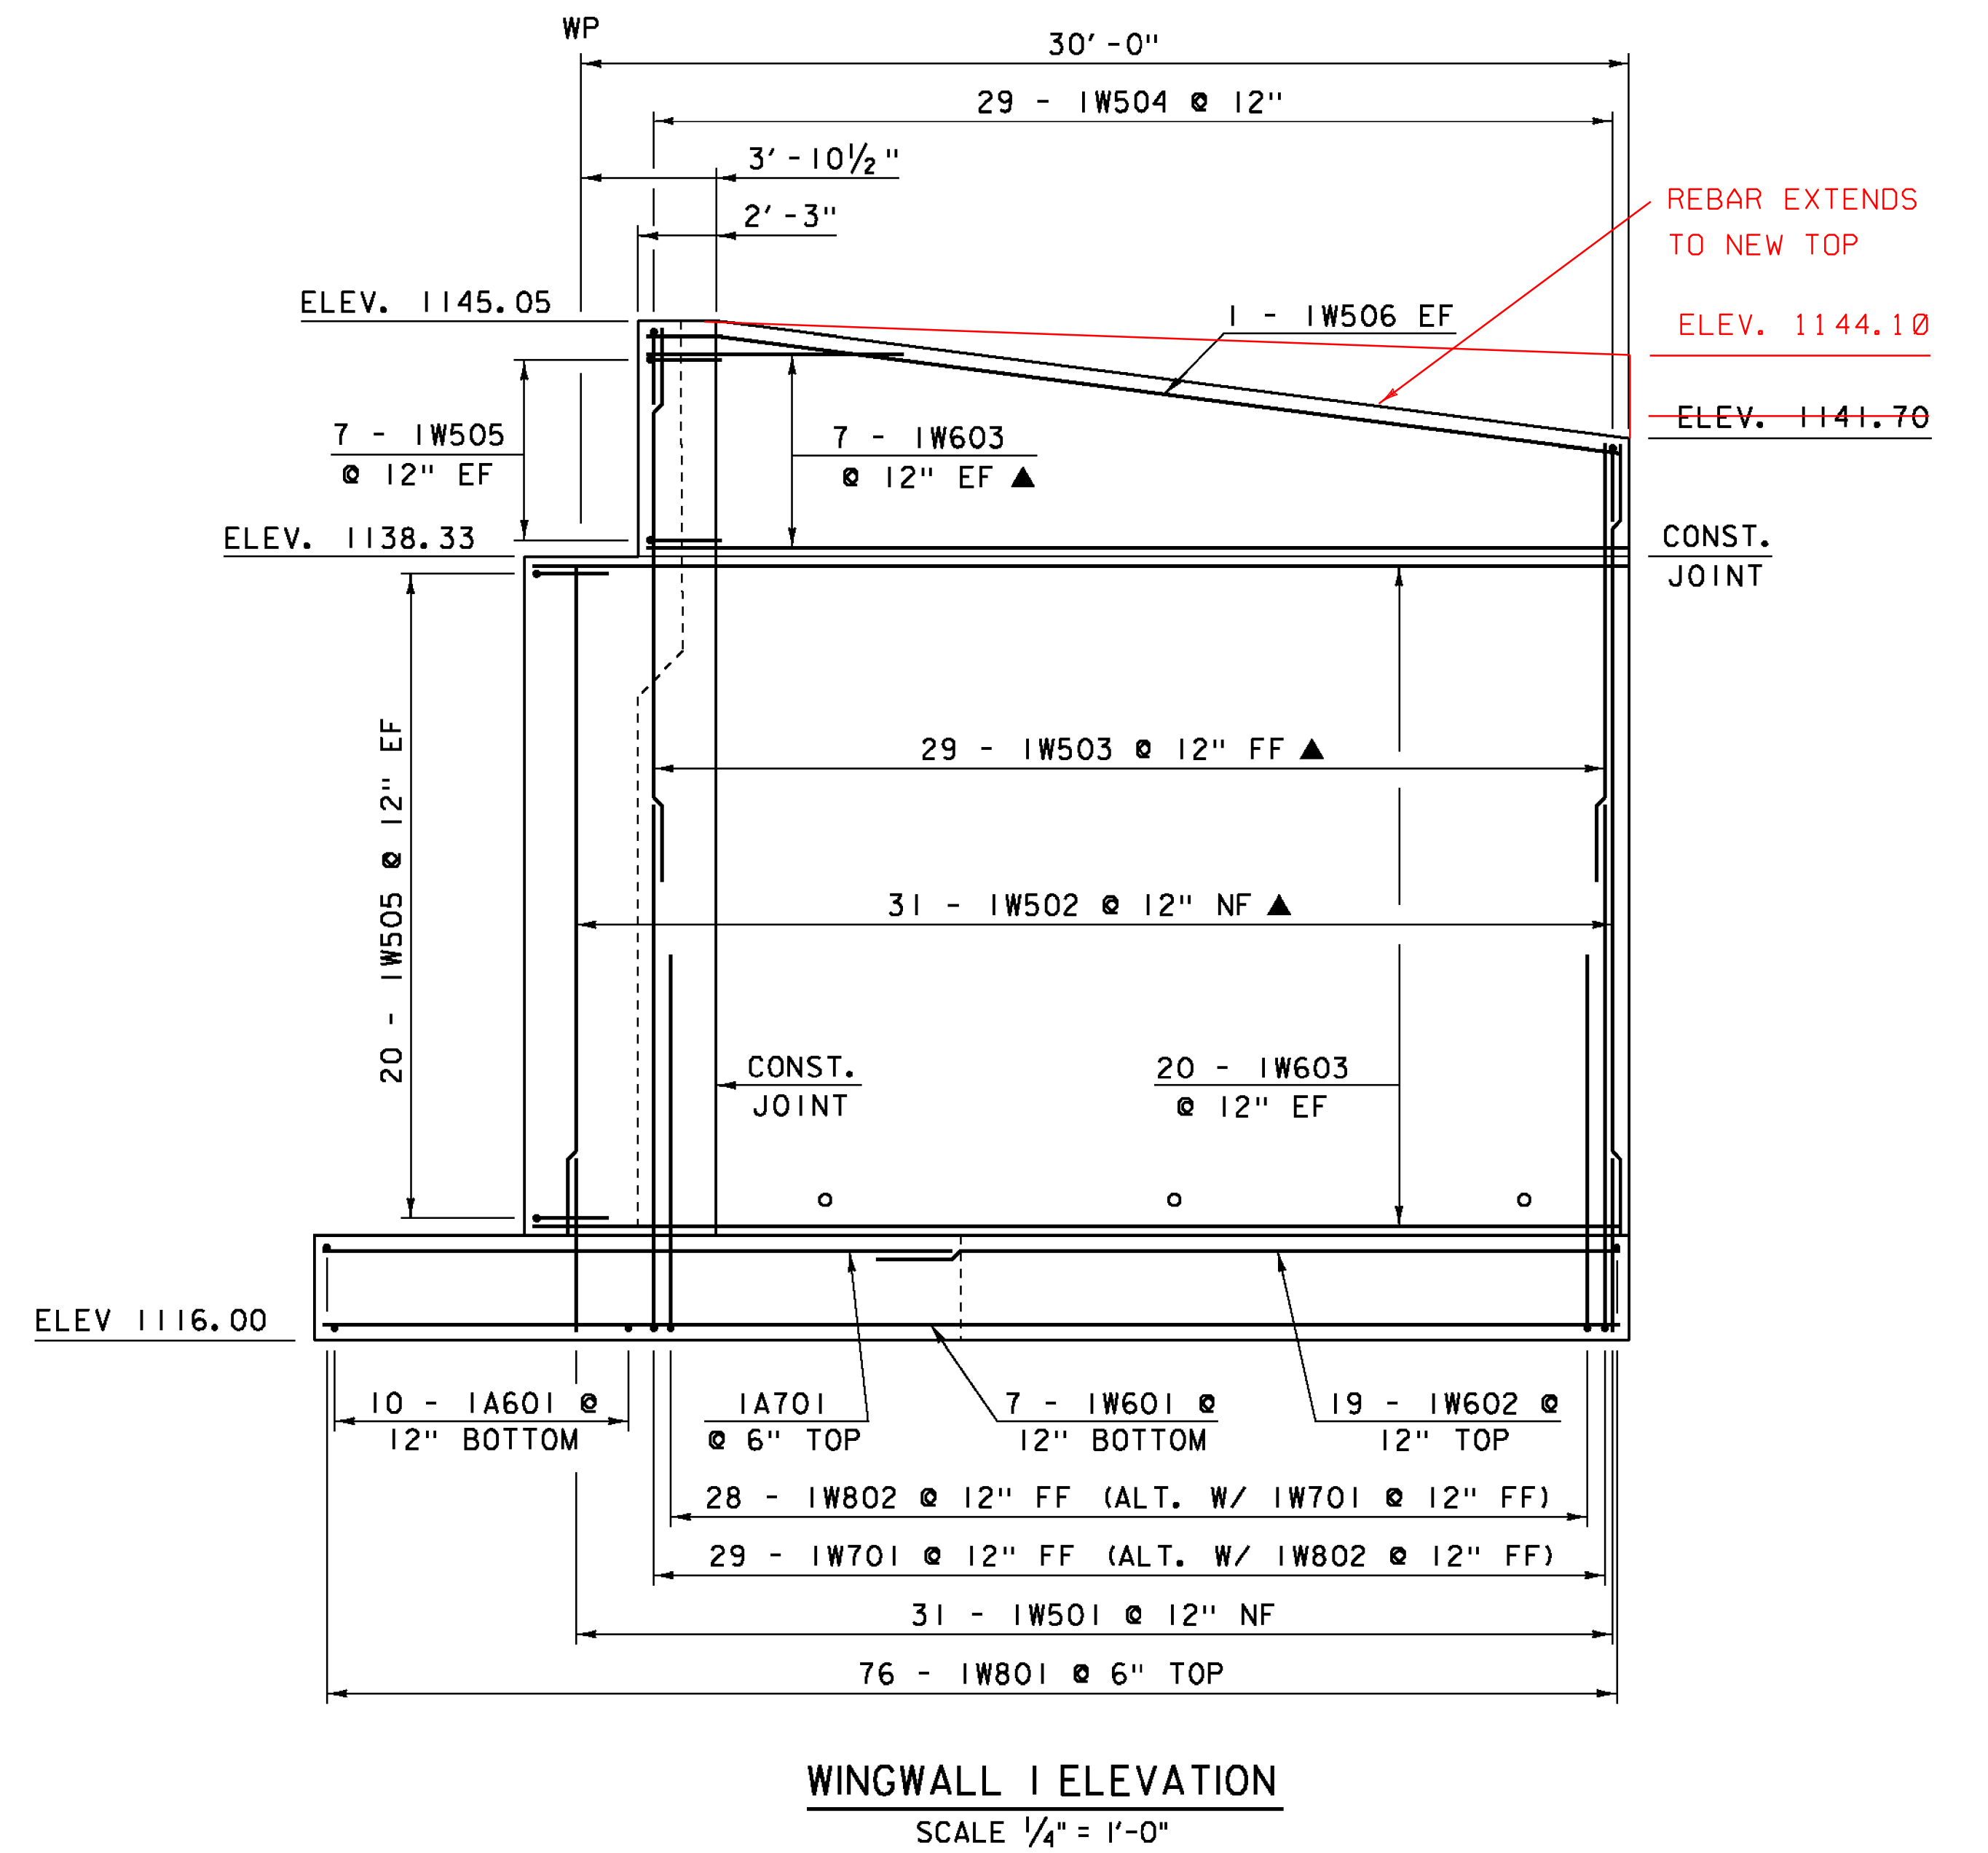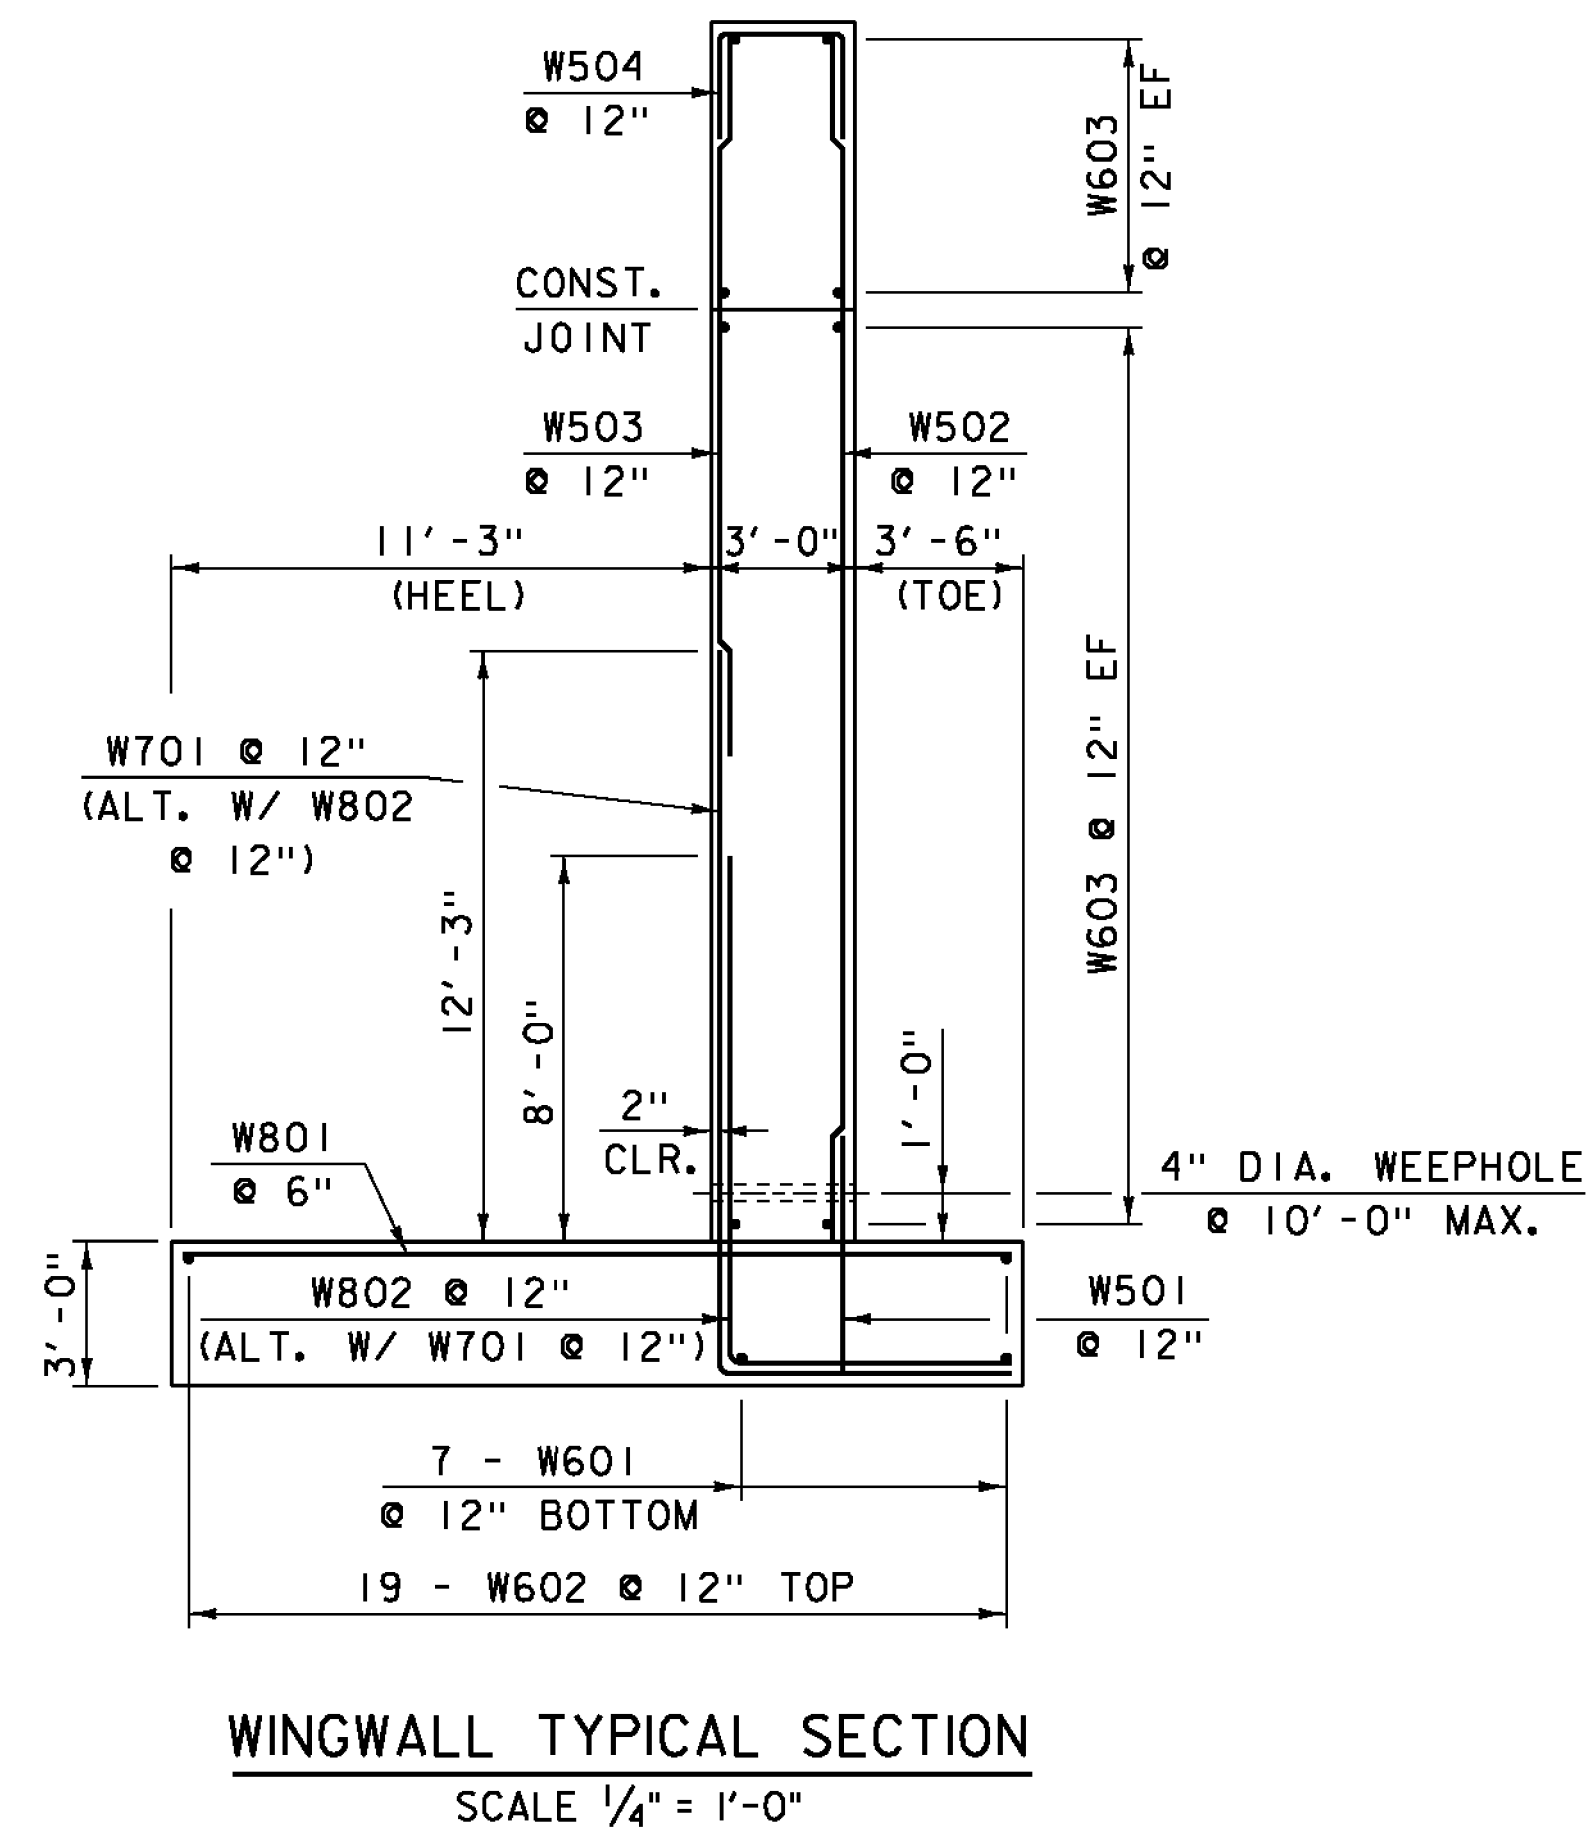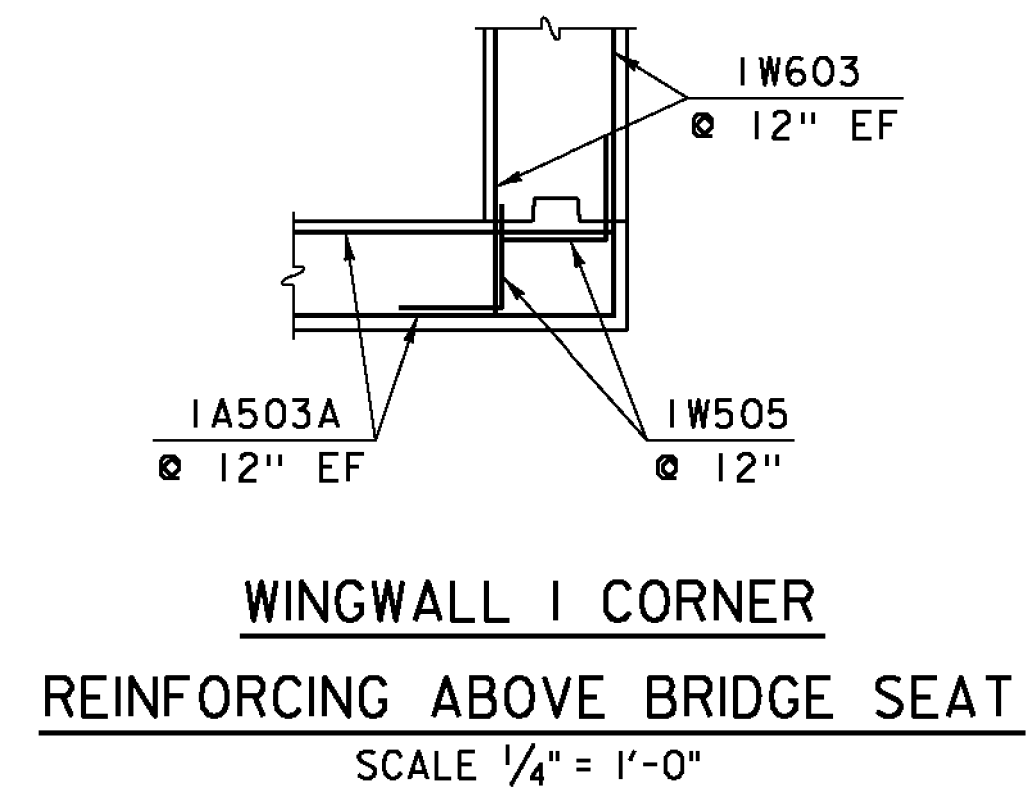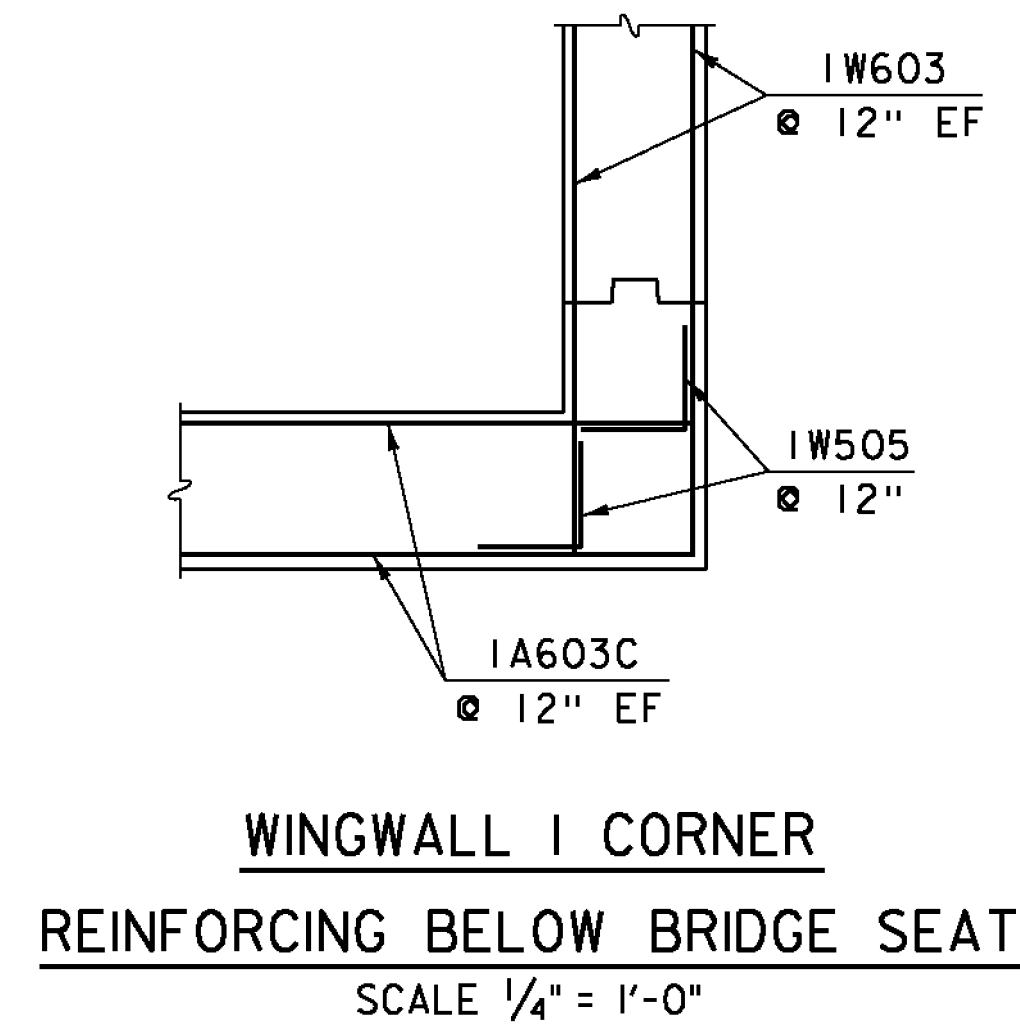

**NOTE:**

NF = NEAR FACE  
FF = FAR FACE  
EF = EACH FACE  
▲ = CUT TO FIT IN FIELD  
3" CLEAR, UNLESS OTHERWISE SPECIFIED ON THE PLANS.  
2'-2" BAR LAP UNLESS OTHERWISE SPECIFIED ON THE PLANS.

PROJECT NAME: WOODFORD	
PROJECT NUMBER: ER BHF 010-(44)	
FILE NAME: slb214sub.dgn	PLOT DATE: 23-MAR-2012
PROJECT LEADER: C. CARLSON	DRAWN BY: G. ROY
DESIGNED BY: M. EVANS-MONGEON	CHECKED BY: M. EVANS-MONGEON
WINGWALL DETAILS	SHEET 34 OF 58