



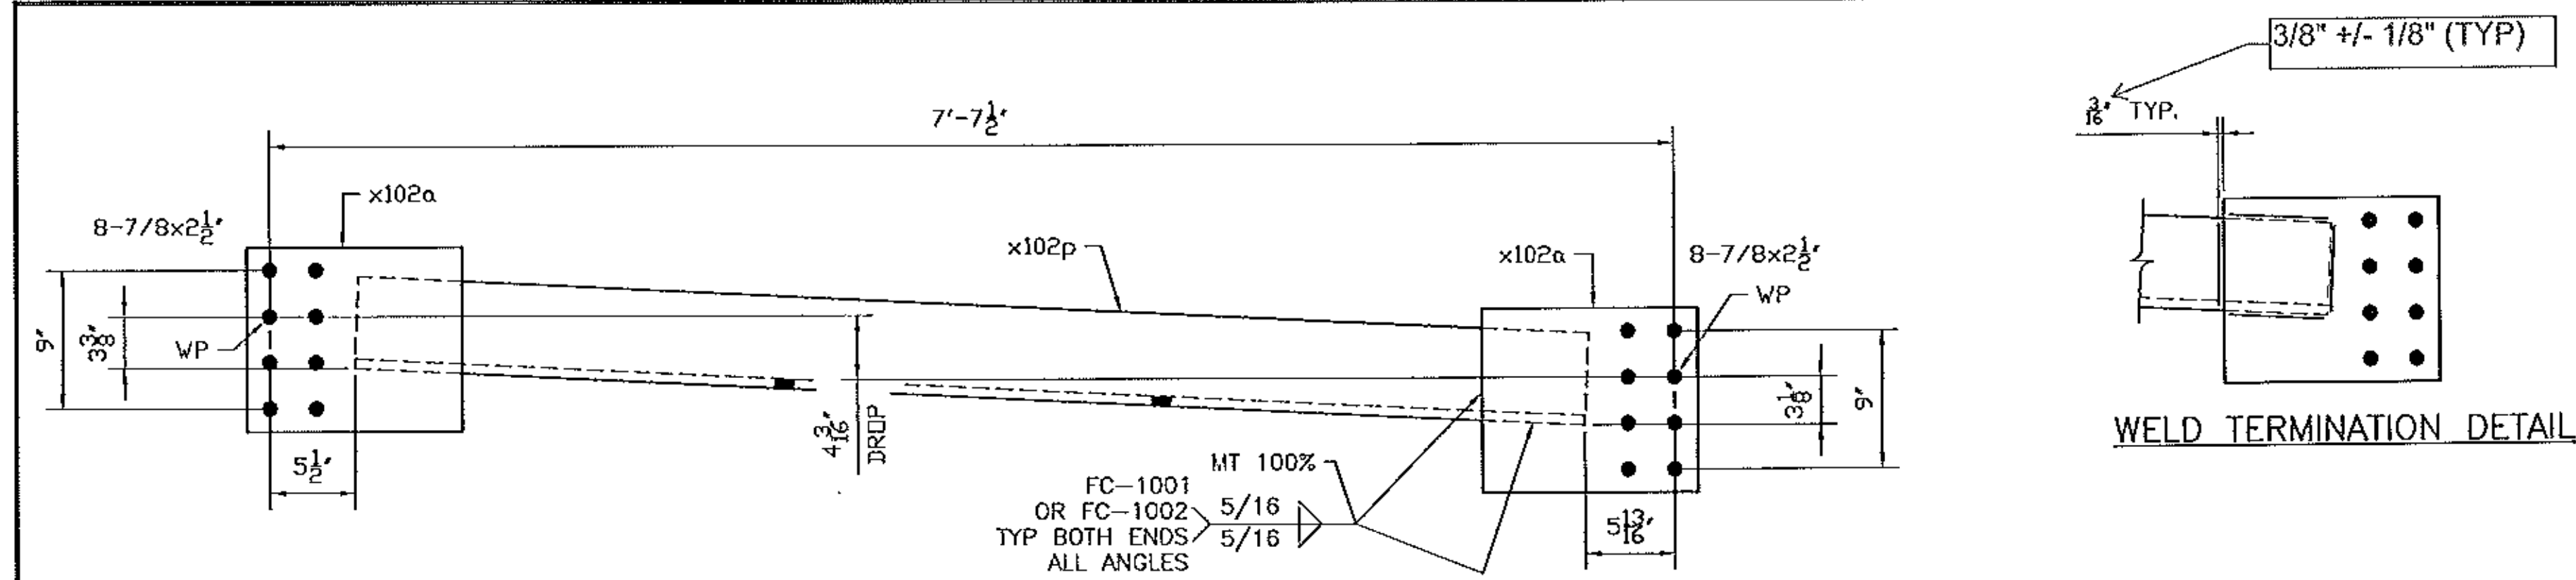

5 - INTERMEDIATE SUPPORT 111CF1

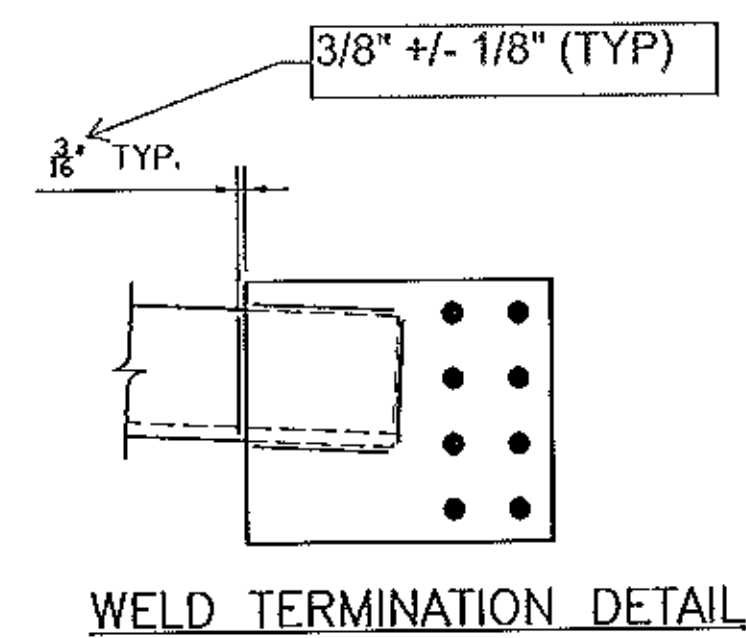

GENERAL NOTES: SEE GN100
 HOLES: 15/16 (U.N.)
 CLEANING AND PAINTING: SEE SHEET P100 AND P101

FOR APPROVAL	07/06/12	BR	EG
REVISION	DATE	PAR	VER.

See standard specification 506.24(a)(9), no payment will be made for bolts, nuts, washers, they are considered to be incidental

NOTE: BOLT 1 WASHER: 1 WASHER UNDER NUT U.N.
 BOLT 2 WASHER: 1 WASHER UNDER HEAD U.N.
 1 WASHER UNDER HEAD U.N.



PROJECT: VT RT 9, BRIDGE NO. 11
 TOWN OF WOODFORD, VT
 OVER WALDOOMSAC RIVER

TITLE: INTERMEDIATE SUPPORT AT WATERLINE

REFERENCE: PROJECT NO. ER BHF 010-1 (44)

BR	JULY 2012	UN04260
GG	JULY 2012	111 A

BILL OF MATERIAL

Mark	Qty.	Description	SU	Length	Remark	ABM	Total Weight	Seq	Qty /Seq
111CF1	5	INTERMEDIATE SUPPORT	Grd			1048	1112	5	
111CF1	5	INTERMEDIATE SUPPORT		7-10 1/2					
x102a	10	PL1/2x12	A70950W	1-2		107-2	238		
x102p	5	L6x6x5/8	A70950W	6-8 5/16		107-1	810		
FB		FIELD BOLTS							
78F212	80	.7/8 Dia A325 TYP3		2 1/2	1FL WASH				

Vermont Agency of Transportation

RECEIVED

CK'D BY M.E.M. OK'D BY C.W.M.

July 09, 2012

RESUBMIT APPROVED AS NOTED
 BY C. CARLSON DATE 07-27-2012