
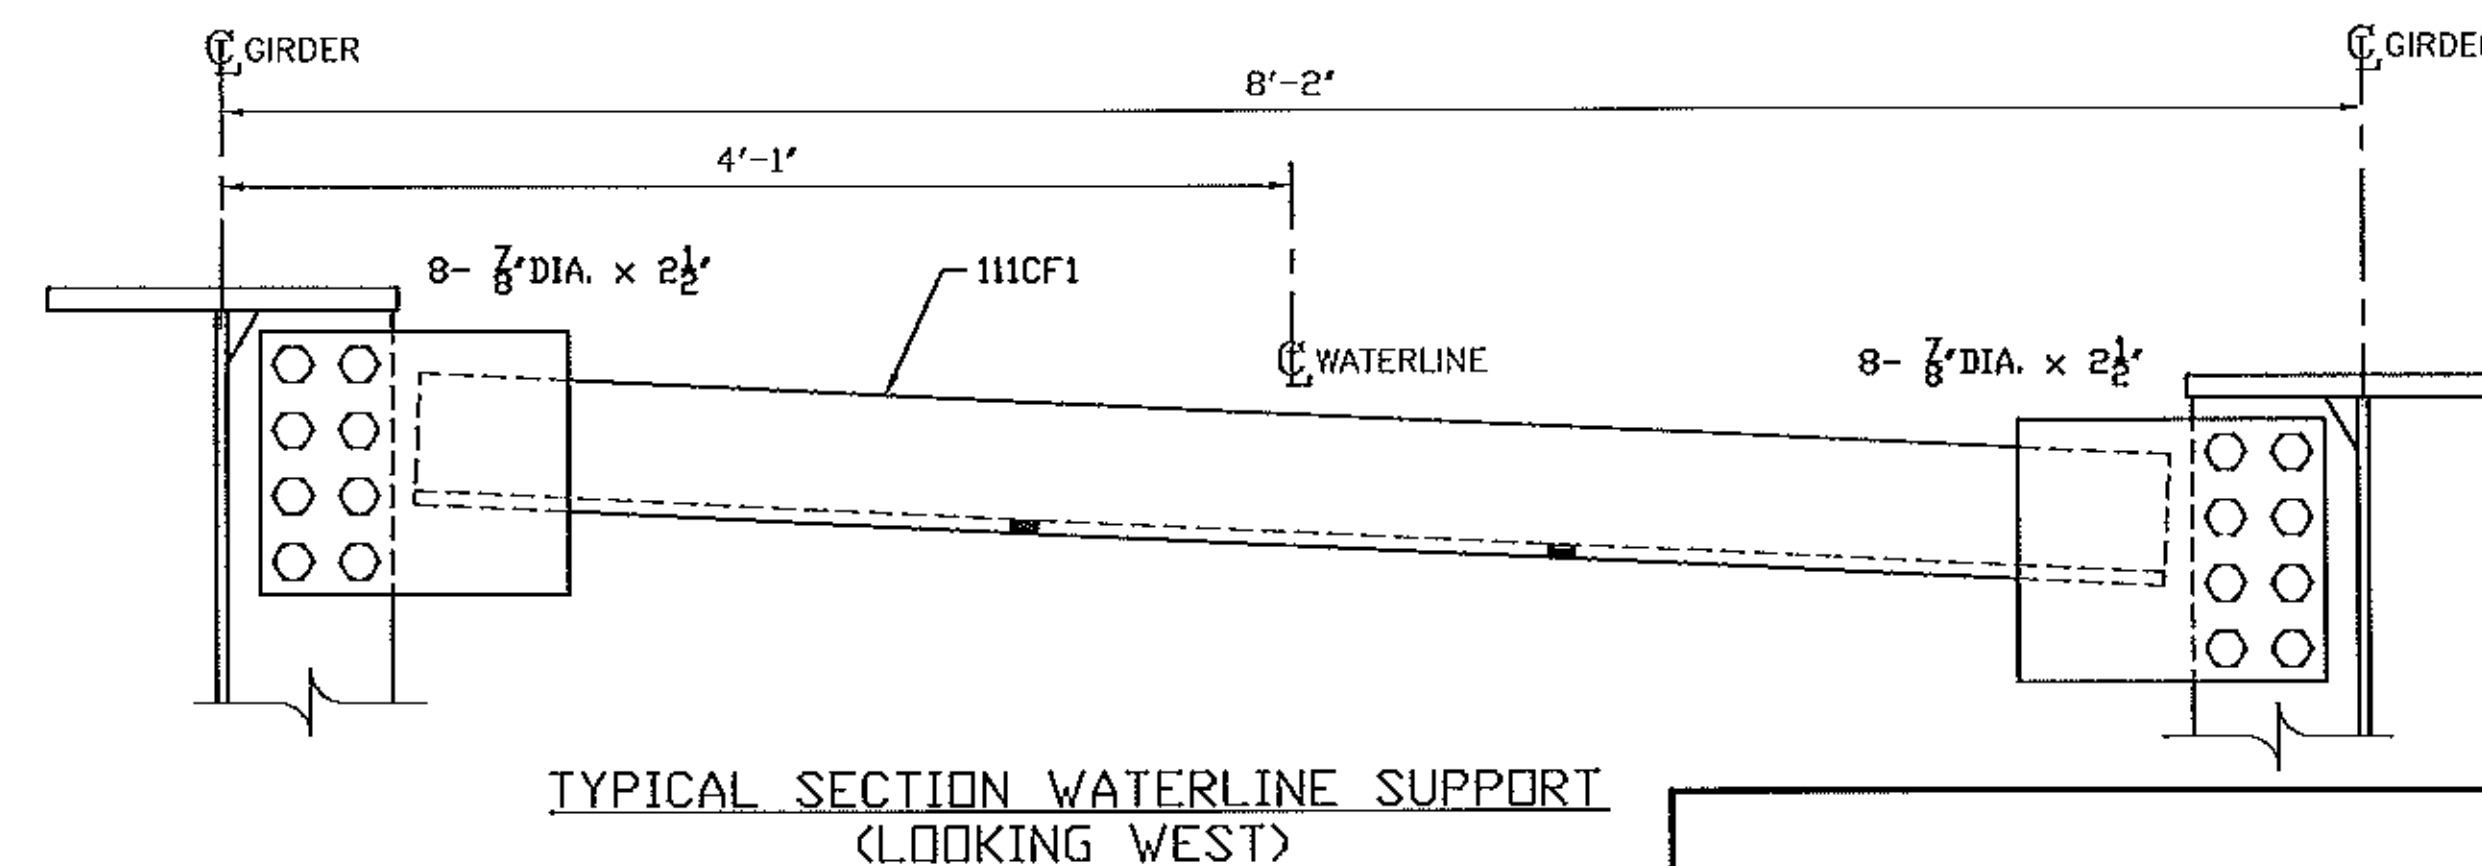


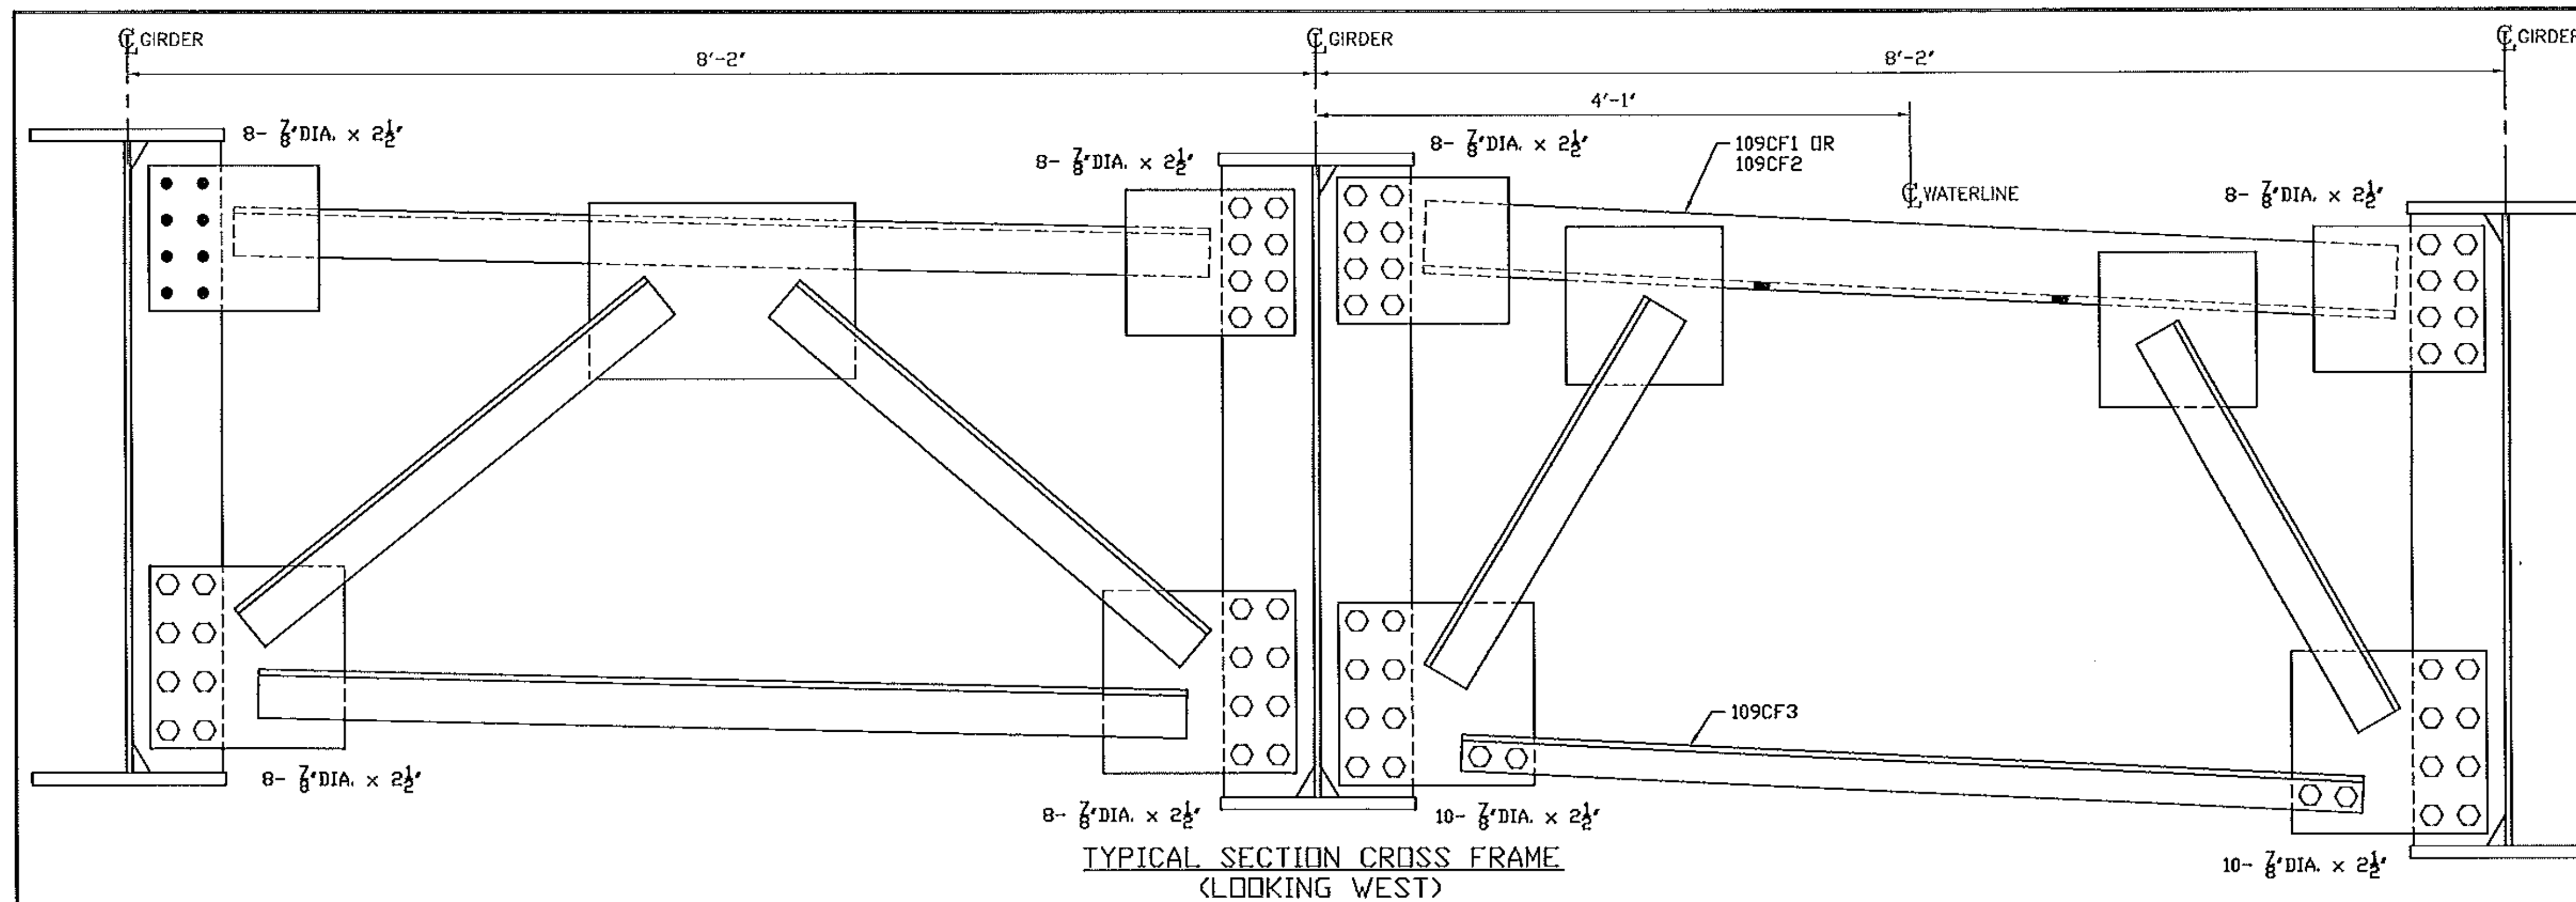

*** THIS DRAWING IS TO BE USED FOR MARKS AND BOLTS ONLY AND MUST BE READ IN CONJUNCTION WITH THE CONTRACT DRAWINGS SPECIFICATIONS AND SPECIAL PROVISIONS. THIS DRAWING IS NOT TO BE USED FOR CONSTRUCTION SEQUENCING OR AS AN ERECTION PROCEDURE.

Vermont Agency of Transportation
RECEIVED
 CK'D BY M.E.M. OK'D BY C.W.M.
 July 09, 2012
 RESUBMIT APPROVED ✓
 BY C. CARLSON DATE 07-27-2012

FOR APPROVAL	07/06/12	BR	EG
REVISION	DATE	PAR	VER.

NOTE: BOLT 1 WASHER: 1 WASHER UNDER NUT U.N.
 BOLT 2 WASHER: 1 WASHER UNDER HEAD U.N.
 1 WASHER UNDER HEAD U.N.



PROJECT: VT RT 9, BRIDGE NO. 11
 TOWN OF WOODFORD, VT
 OVER WALDOOMSAC RIVER

TITLE: ERECTION PLAN CROSS FRAME

REFERENCE: PROJECT NO. ER BHF 010-1 (44)

DATE	BR	DATE	JULY 2012	CONTRACT NO.	UN04260
CHECKED BY	GG	DATE	JULY 2012	REVISION	E102 A