


(BS)

COATING SYSTEM SEE P100 AND P101

|              |                |                          |
|--------------|----------------|--------------------------|
| <b>NOTE:</b> | BOLT 1 WASHER: | 1 WASHER UNDER NUT U.N.  |
|              | BOLT 2 WASHER: | 1 WASHER UNDER HEAD U.N. |
|              |                | 1 WASHER UNDER HEAD U.N. |

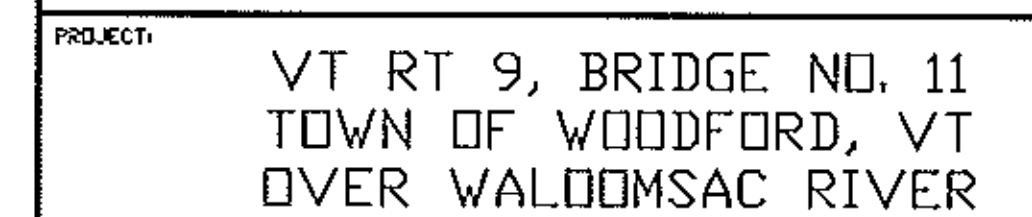

|       |             |
|-------|-------------|
| TITLE | PAINT NOTES |
|-------|-------------|

REFERENCE PROJECT NO. ER BHF 010-1 (44)

|            |    |      |           |             |                                                                                            |
|------------|----|------|-----------|-------------|--------------------------------------------------------------------------------------------|
| ISSUE IS   | EG | DATE | JULY 2012 | CONTRACT NO | UN04260                                                                                    |
| CHECKED IS | GG | DATE | JULY 2012 | ISSUING NO  | P100  |

-TOP COAT COLOR: FEDERAL STANDARD 595 COLOR NO. 20059 BROWN.

RESUBMIT APPROVED ☒  
BY C. CARLSON DATE 07-27-2012