
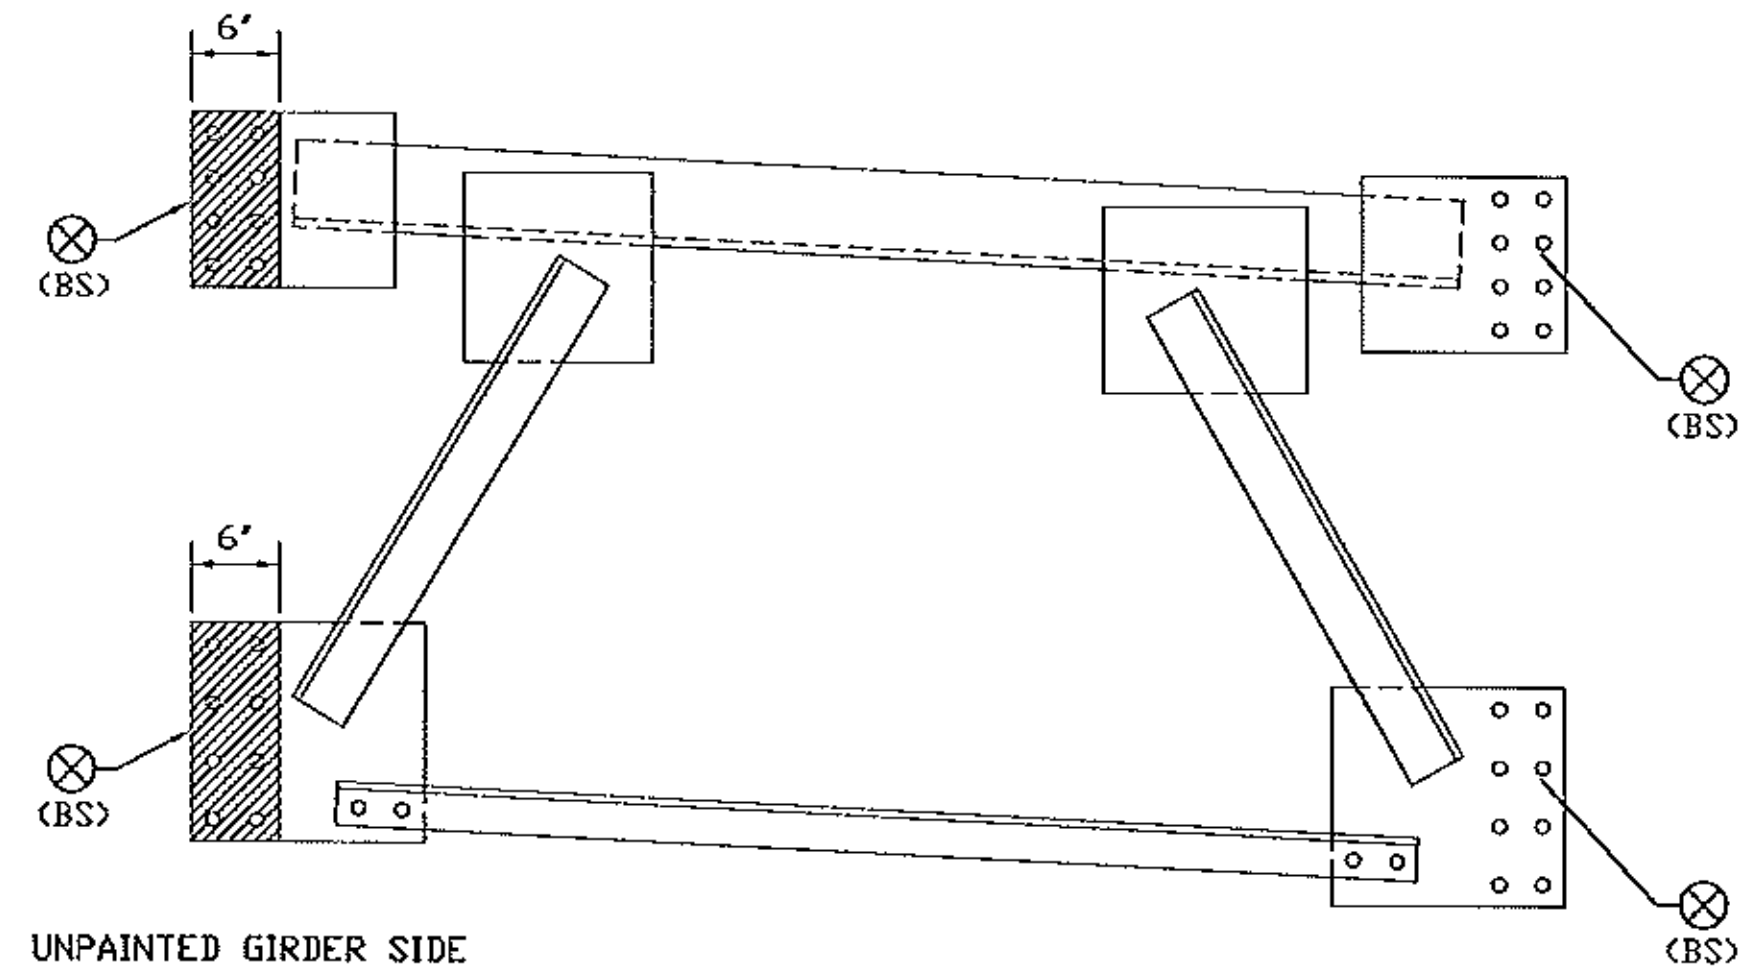
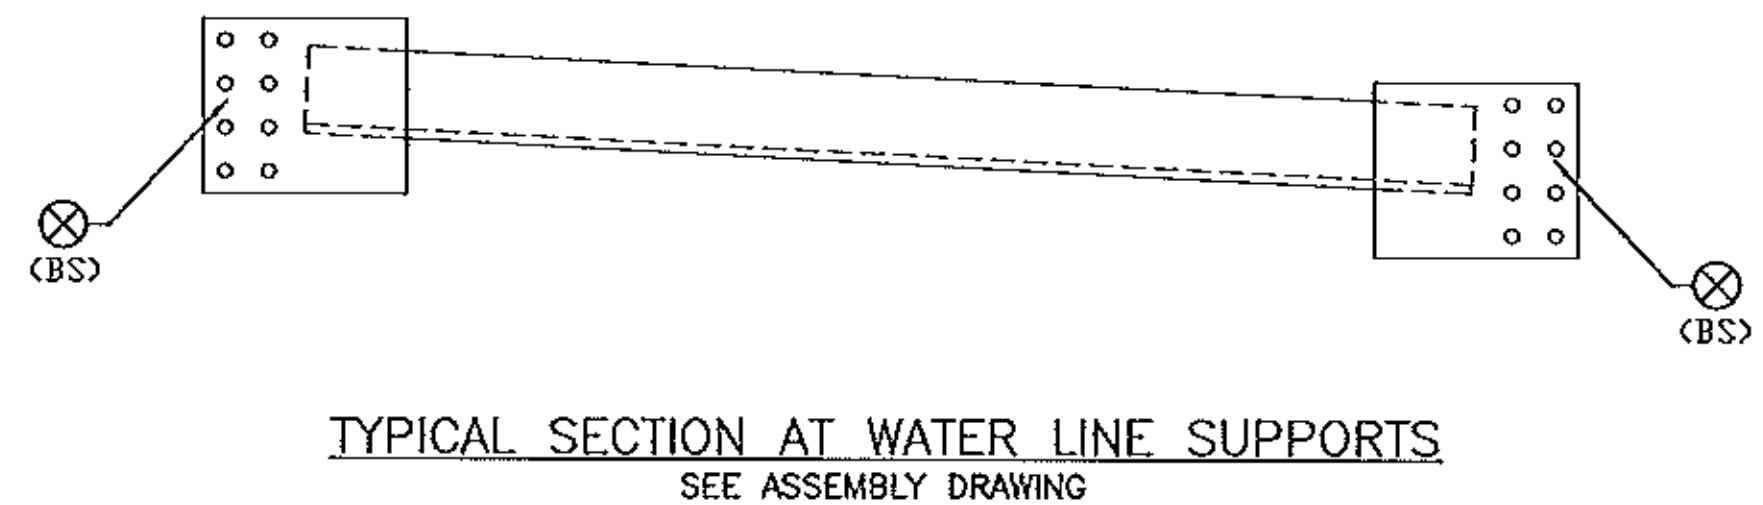
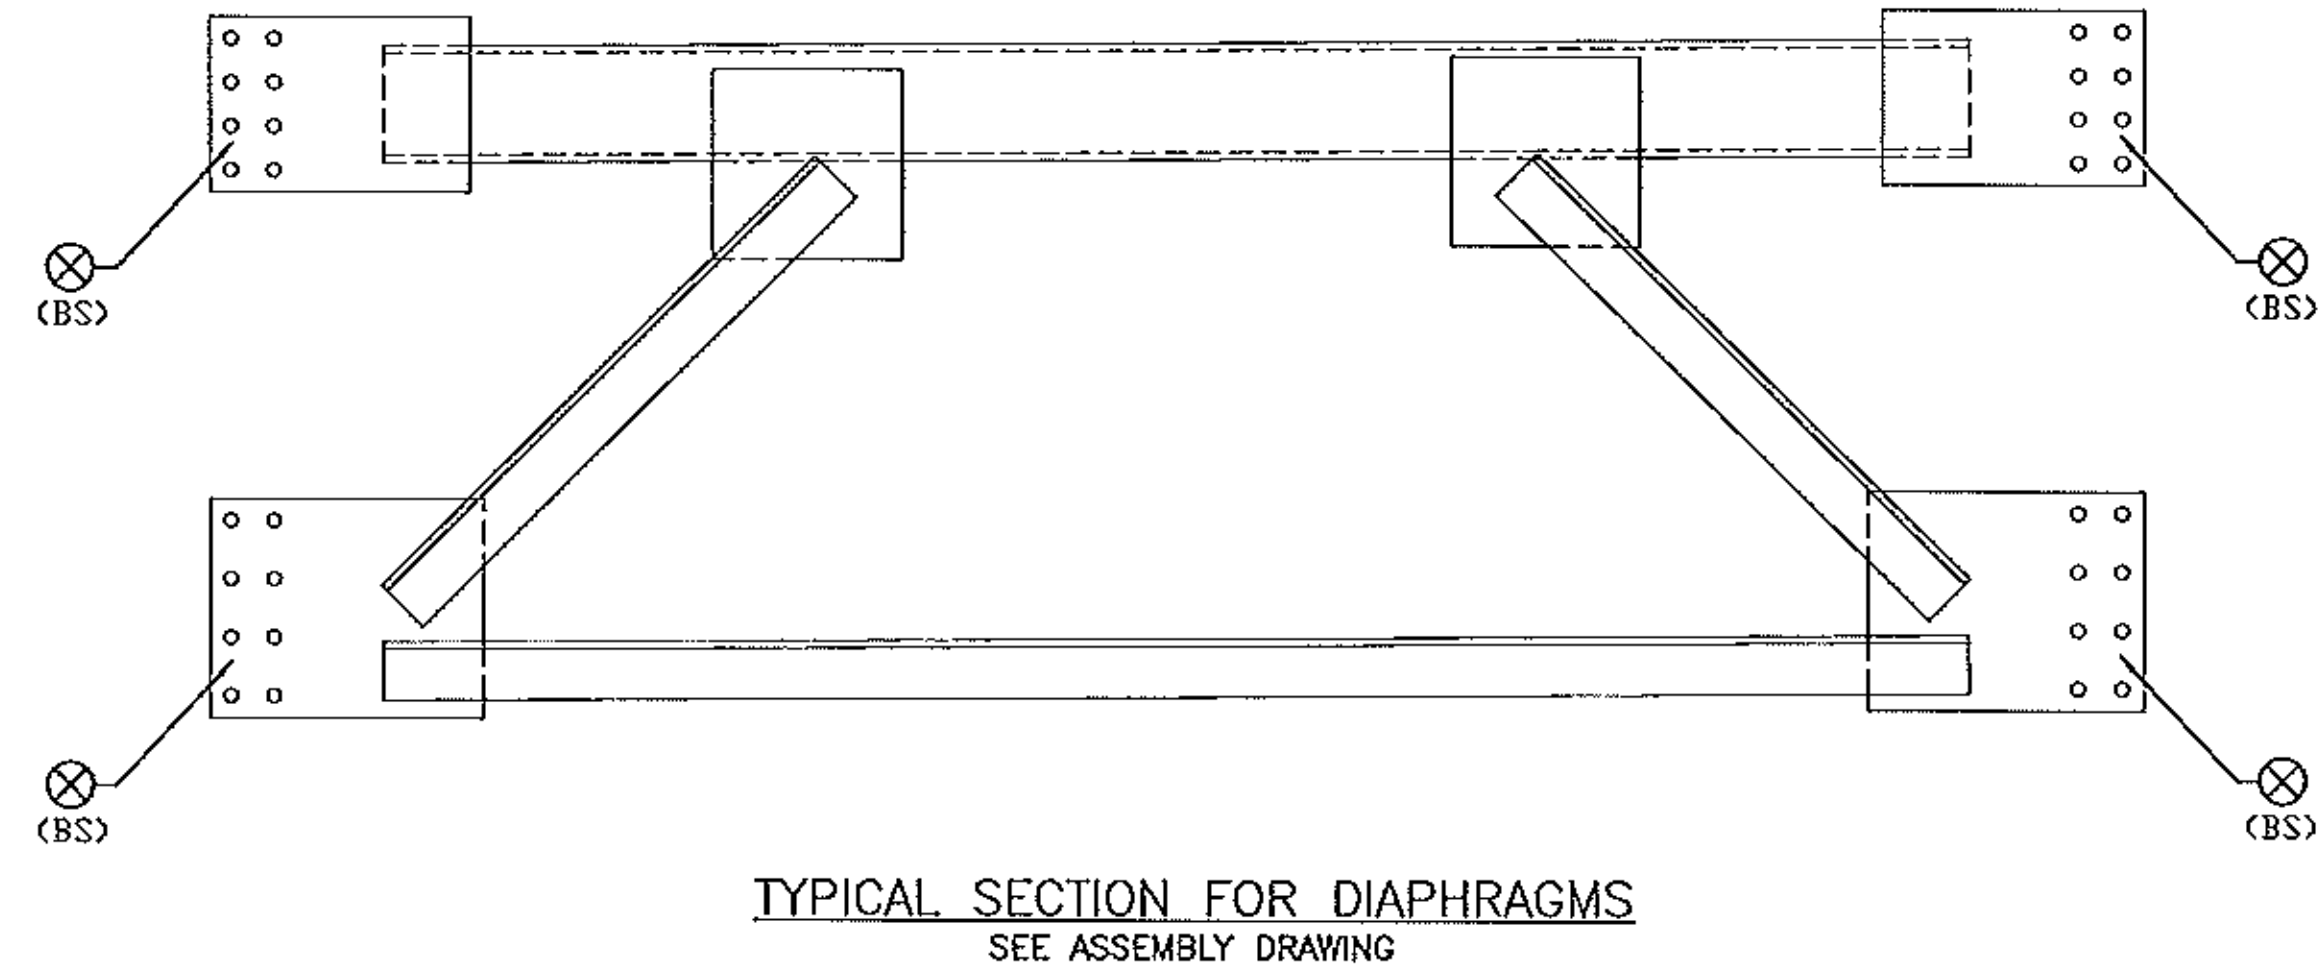


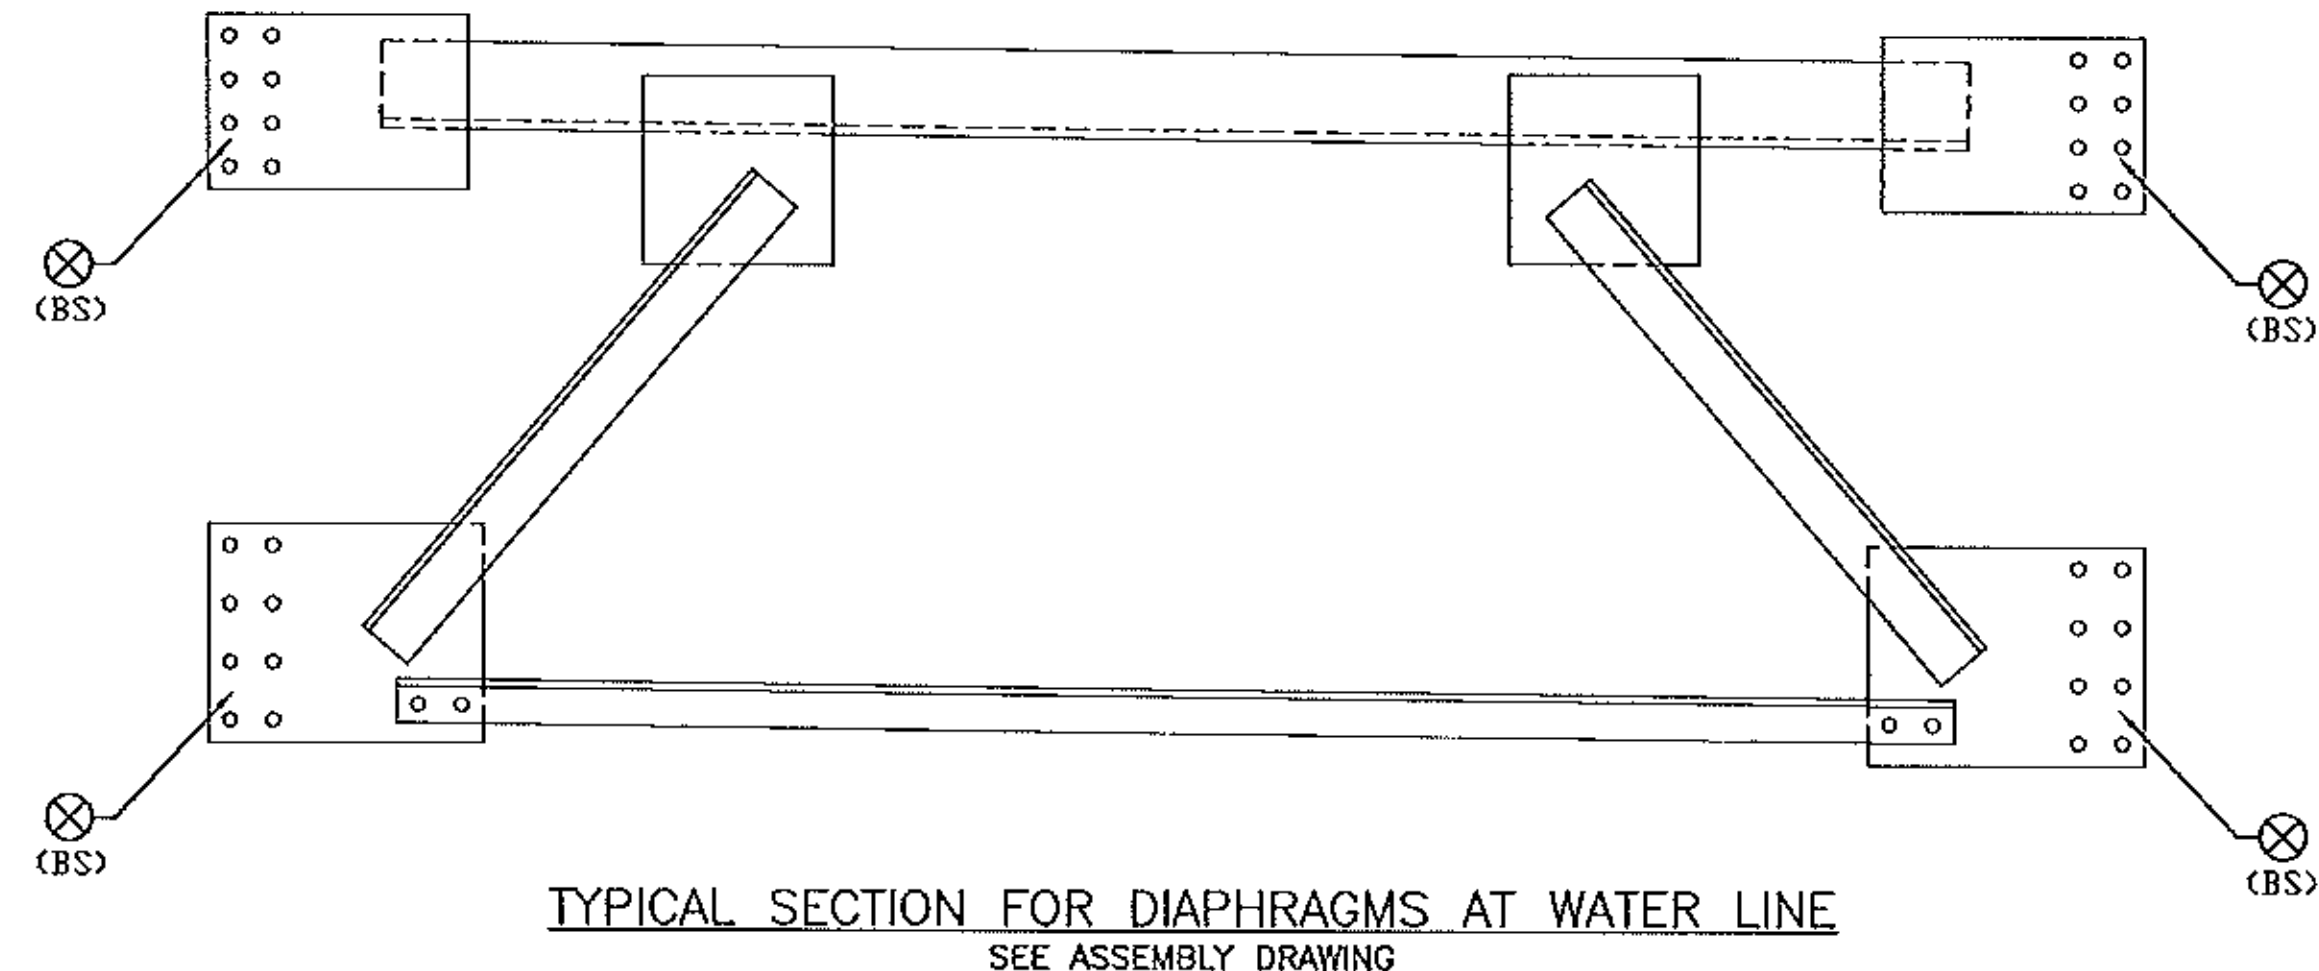

GENERAL NOTES: SEE GN100
 HOLES: 15/16 (U.N.)
 COATING SYSTEM: SEE P100 AND P101

PRIMER ONLY, NO PAINT
 BOTH SIDES 75 mm DIA AROUND HOLE
 WHERE NOTED WITH THIS SYMBOL

Vermont Agency of Transportation
RECEIVED
 CK'D BY M.E.M. OK'D BY C.W.M.
 July 09, 2012
 RESUBMIT APPROVED ✓
 BY C. CARLSON DATE 07-27-2012

FOR APPROVAL	07/06/12	BR	EG
REVISION	DATE	PAR	VER.

NOTE: BOLT 1 WASHER: 1 WASHER UNDER NUT U.N.
 BOLT 2 WASHER: 1 WASHER UNDER HEAD U.N.
 1 WASHER UNDER HEAD U.N.

STRUCTAL
 Bridges
 386 River Road, Claremont,
 NH 03743
 Tel: (603) 542-5202 Fax: (603) 542-5312
 a division of **CANAM**

PROJECT: VT RT 9, BRIDGE NO. 11
 TOWN OF WOODFORD, VT
 OVER WALDOOMSAC RIVER

TITLE: PAINT NOTES

REFERENCE: PROJECT NO. ER BHF 010-1 (44)

NO. 10	EG	DATE	JULY 2012	CONTRACT NO.	UN04260
DESIGNED BY	GG	DATE	JULY 2012	REVISION	P101