
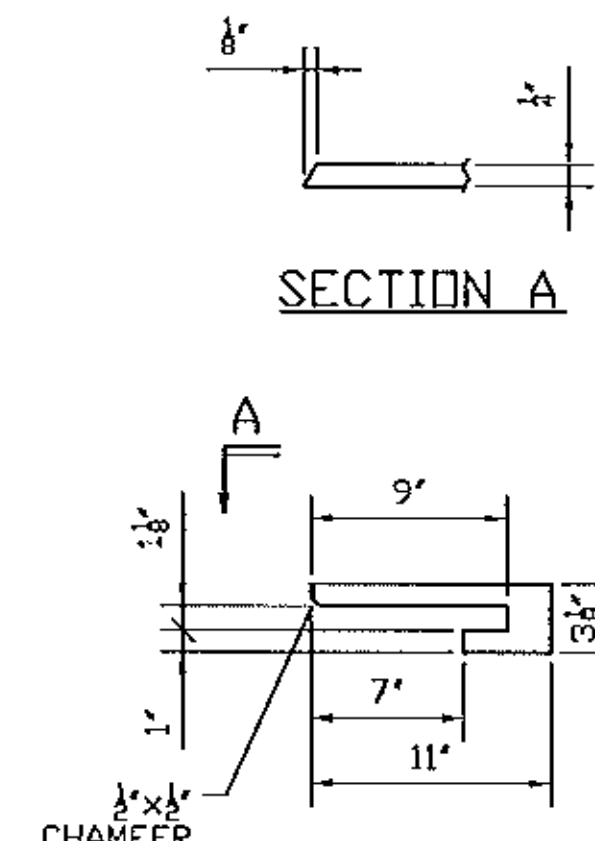
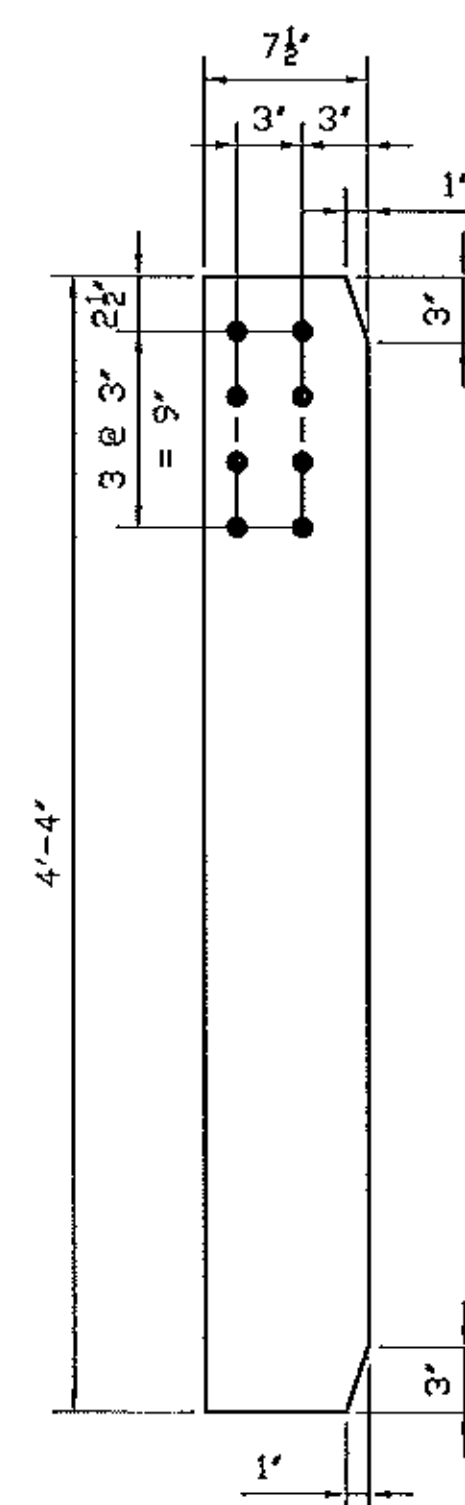
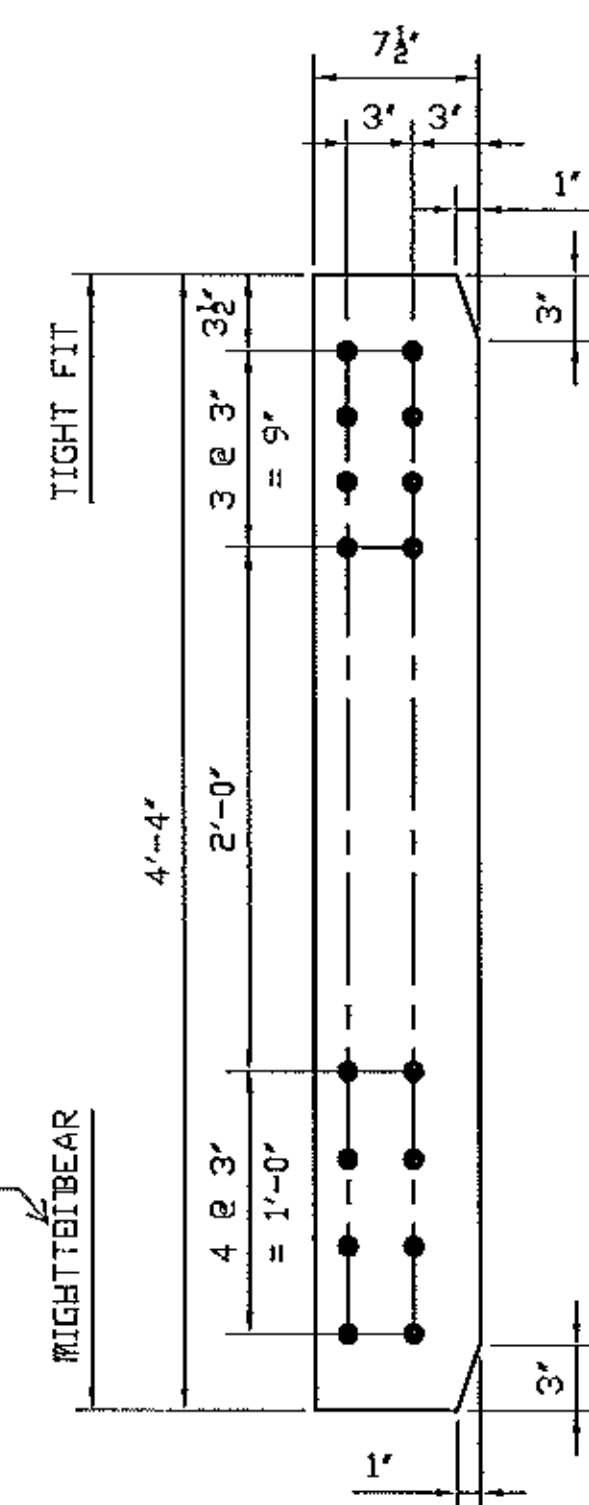
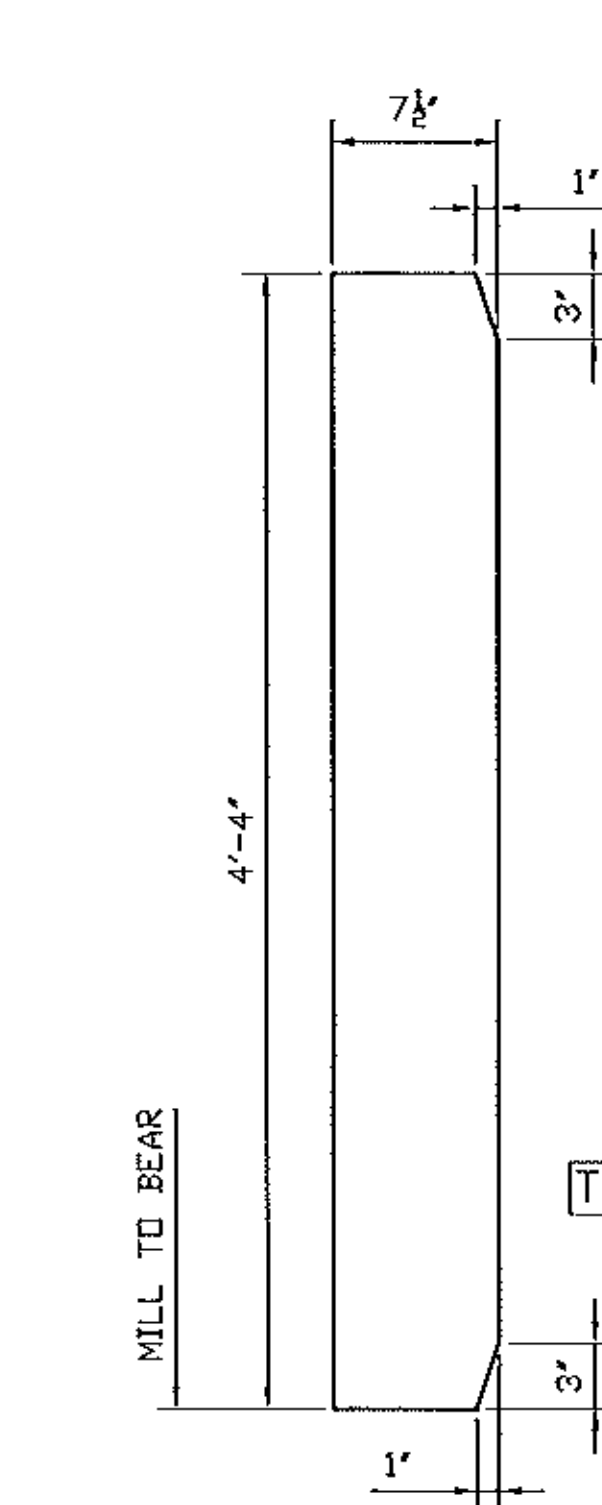


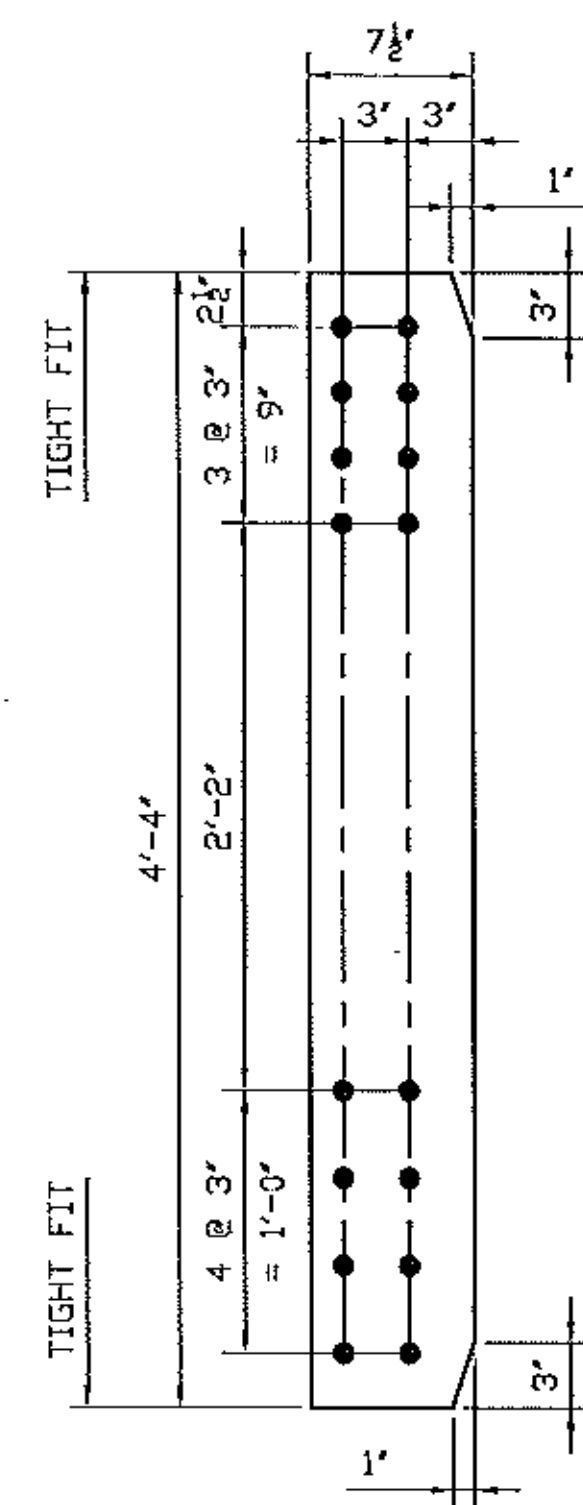


PL1/2x7 1/2x4-4 - x101a

PL7/8x7 1/2x4-4 - x101b

PL1/2x7 1/2x4-4 - x101c

PL1/2x7 1/2x4-4 - x101d

PL1/4x3 1/8x11 - x101e

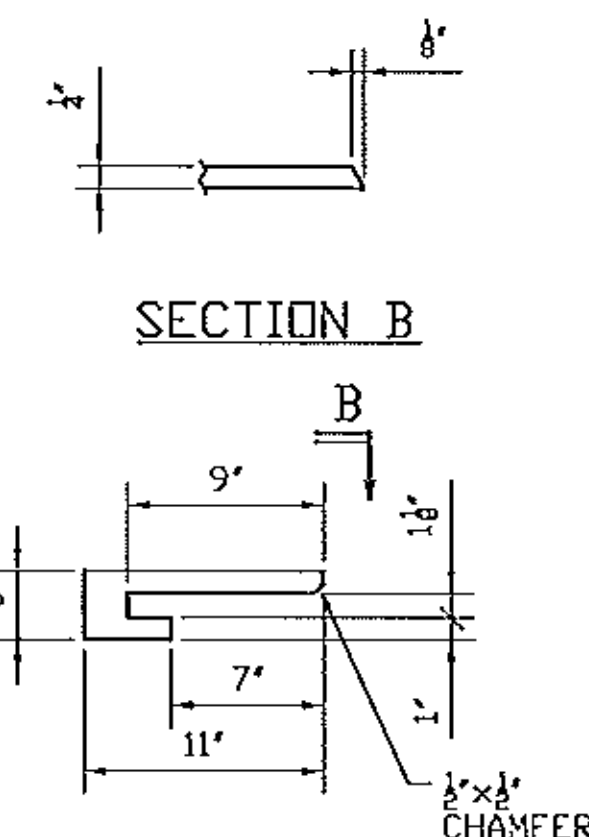

PL1/4x3 1/8x11 - x101k

GENERAL NOTES: SEE GN100
HOLES: 15/16 (U.N.)
CLEANING AND PAINTING: SEE SHEET P100 AND P101

FOR APPROVAL	07/06/12	BR	EG
REVISION	DATE	PAR	VER.

NOTE: BOLT 1 WASHER: 1 WASHER UNDER NUT U.N.
BOLT 2 WASHER: 1 WASHER UNDER HEAD U.N.
1 WASHER UNDER HEAD U.N.




PROJECT: VT RT 9, BRIDGE NO. 11
TOWN OF WOODFORD, VT
OVER WALDOMSAC RIVER

TITLE: GIRDER DETAILS


REFERENCE: PROJECT NO. ER BHF 010-1 (44)

DESIGNED BY	BR	DATE	JULY 2012	CONTRACT NO.	UN04260
CHECKED BY	GG	DATE	JULY 2012	REVISED	X101


Vermont Agency of Transportation
RECEIVED
CK'D BY M.E.M. OK'D BY C.W.M.
July 09, 2012
RESUBMIT APPROVED AS NOTED
BY C. CARLSON DATE 07-27-2012

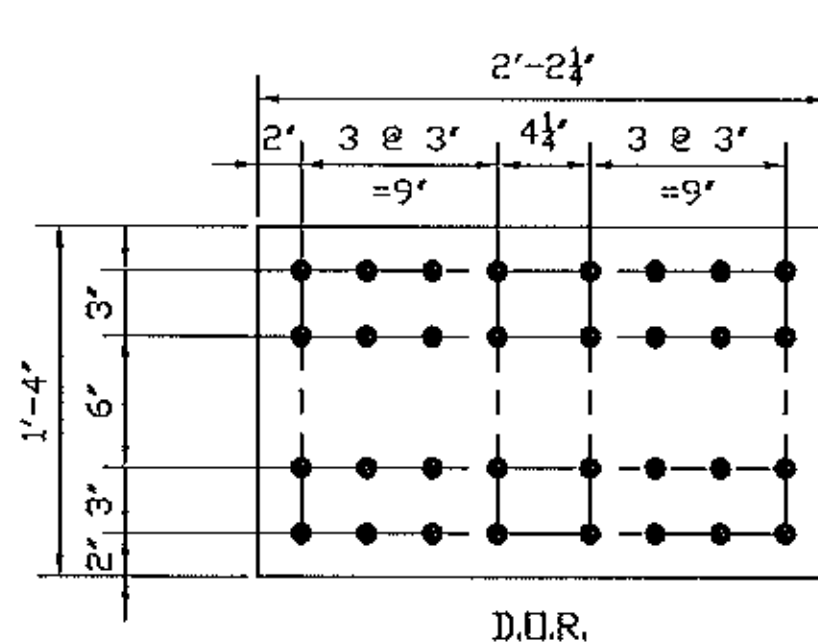


PL1/2x16x2-2 1/4 - x101spa

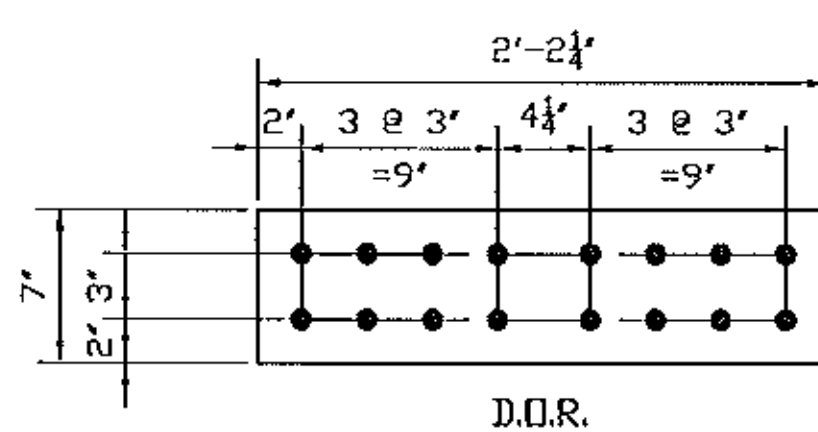


PL1/2x7x2-2 1/4 - x101spb

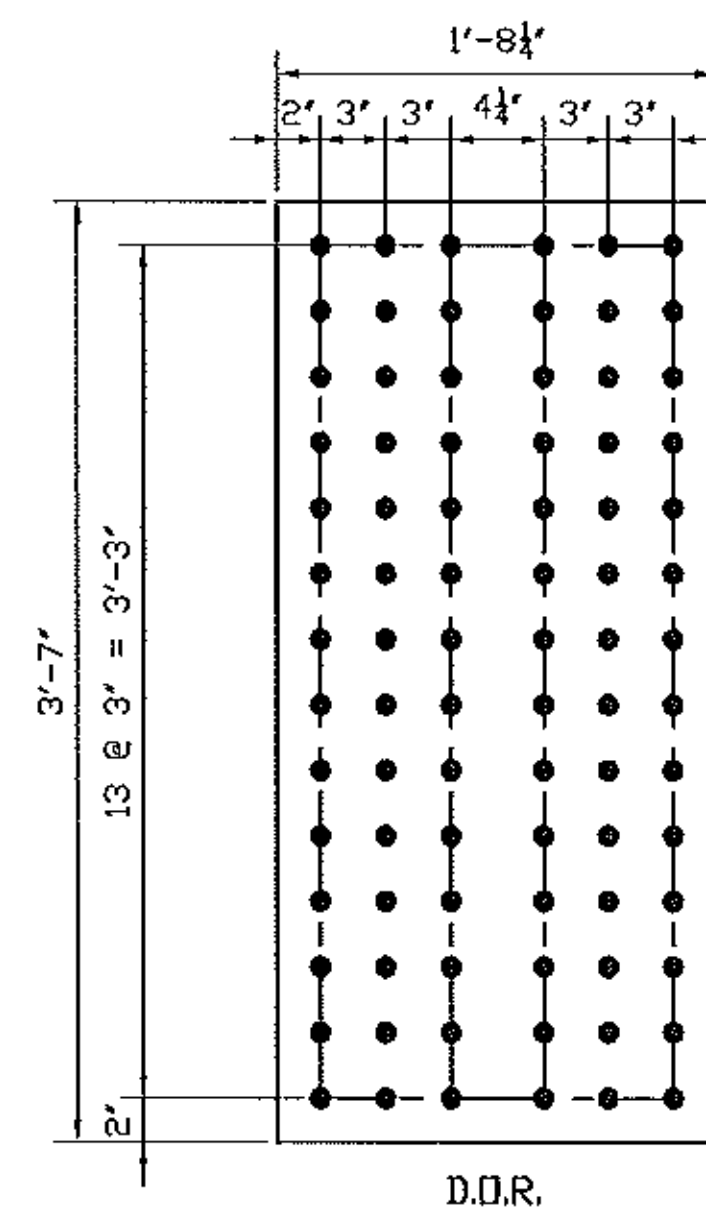

PL1/2x43x1-8 1/4 - x101spc

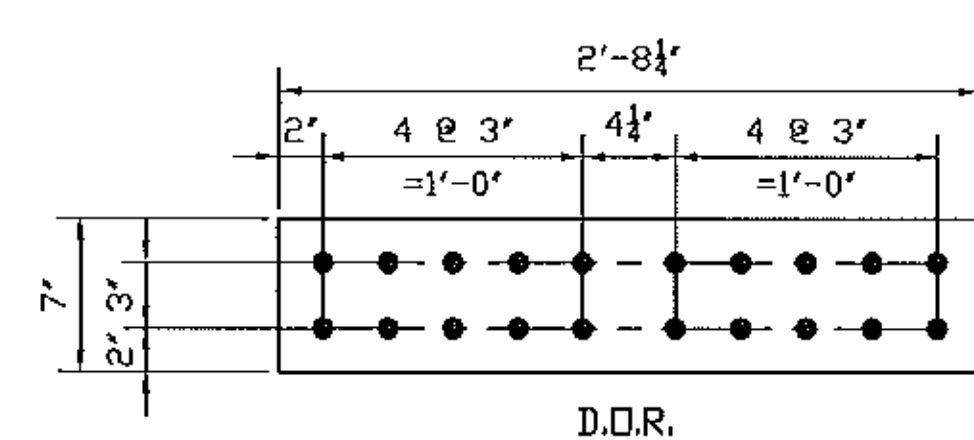

PL1/2x7x2-8 1/4 - x101spd

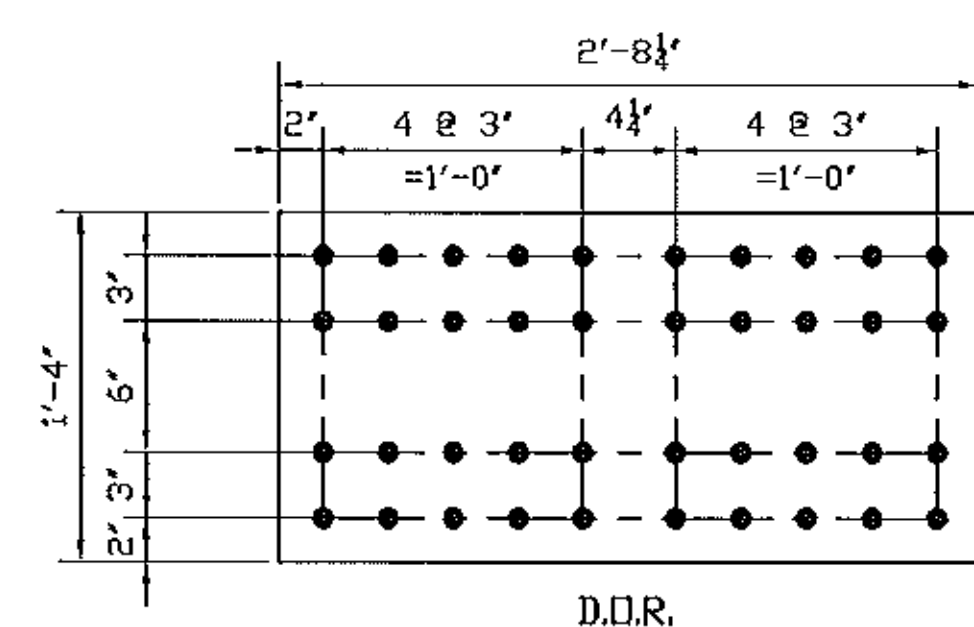

PL1/2x16x2-8 1/4 - x101spe