




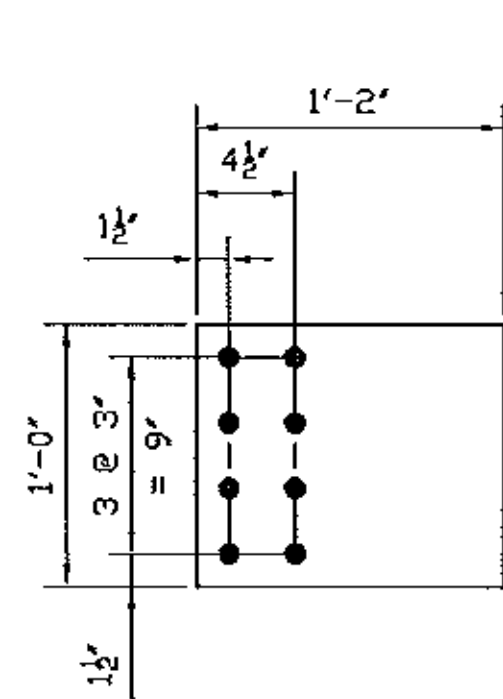


PL1/2x12x1-2 - x102a

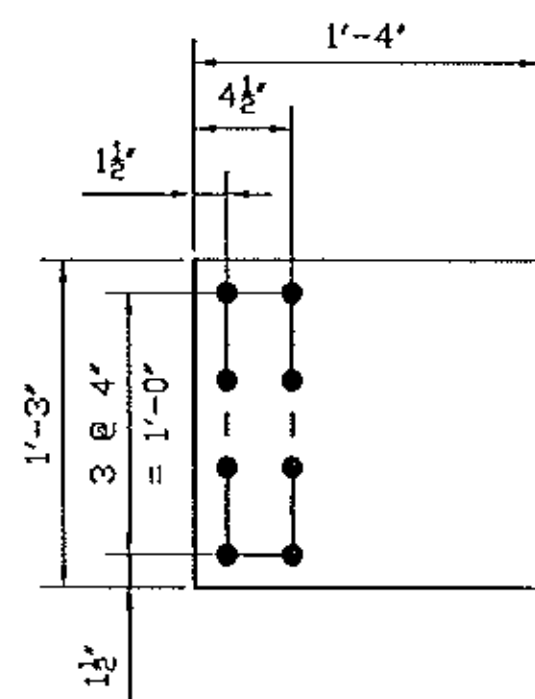


PL1/2x15x1-4 - x102b

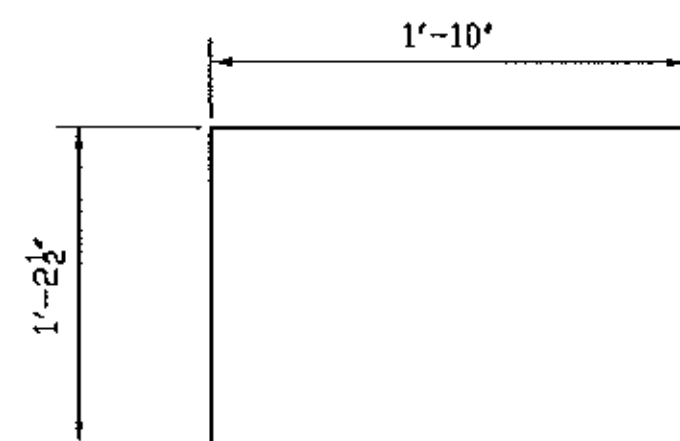


PL1/2x14 1/2x1-10 - x102c

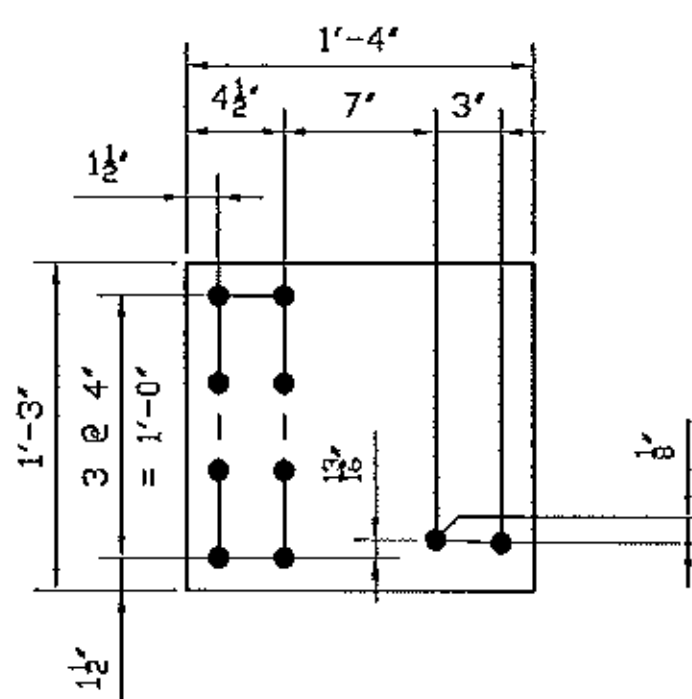


PL1/2x15x1-4 - x102d

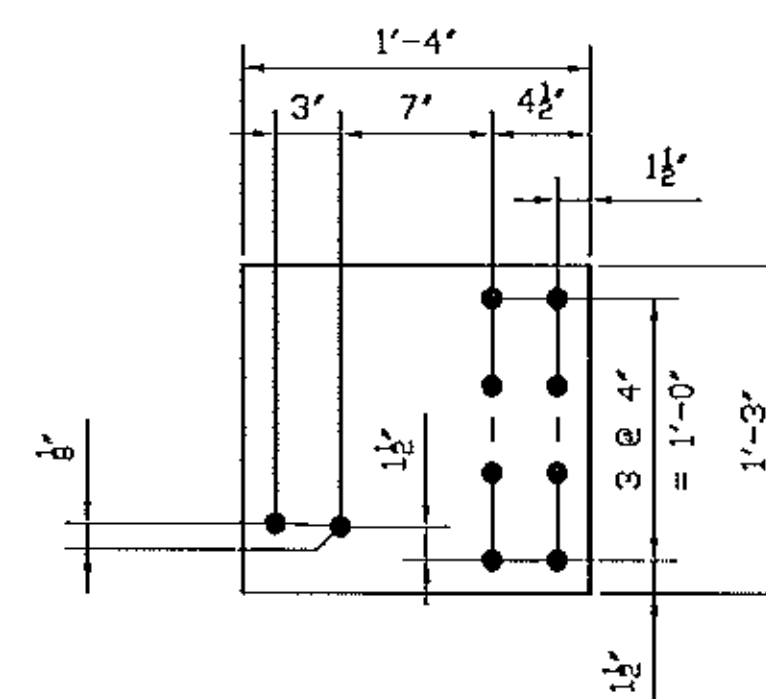

PL1/2x15x1-4 - x102e

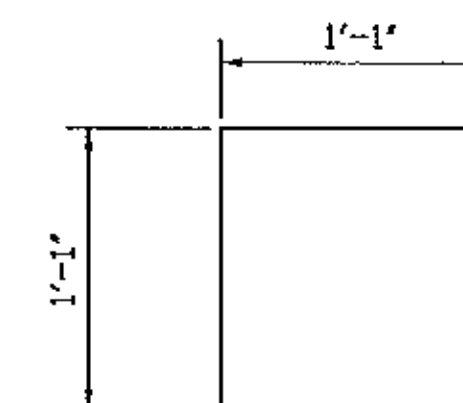


PL1/2x13x1-1 - x102g

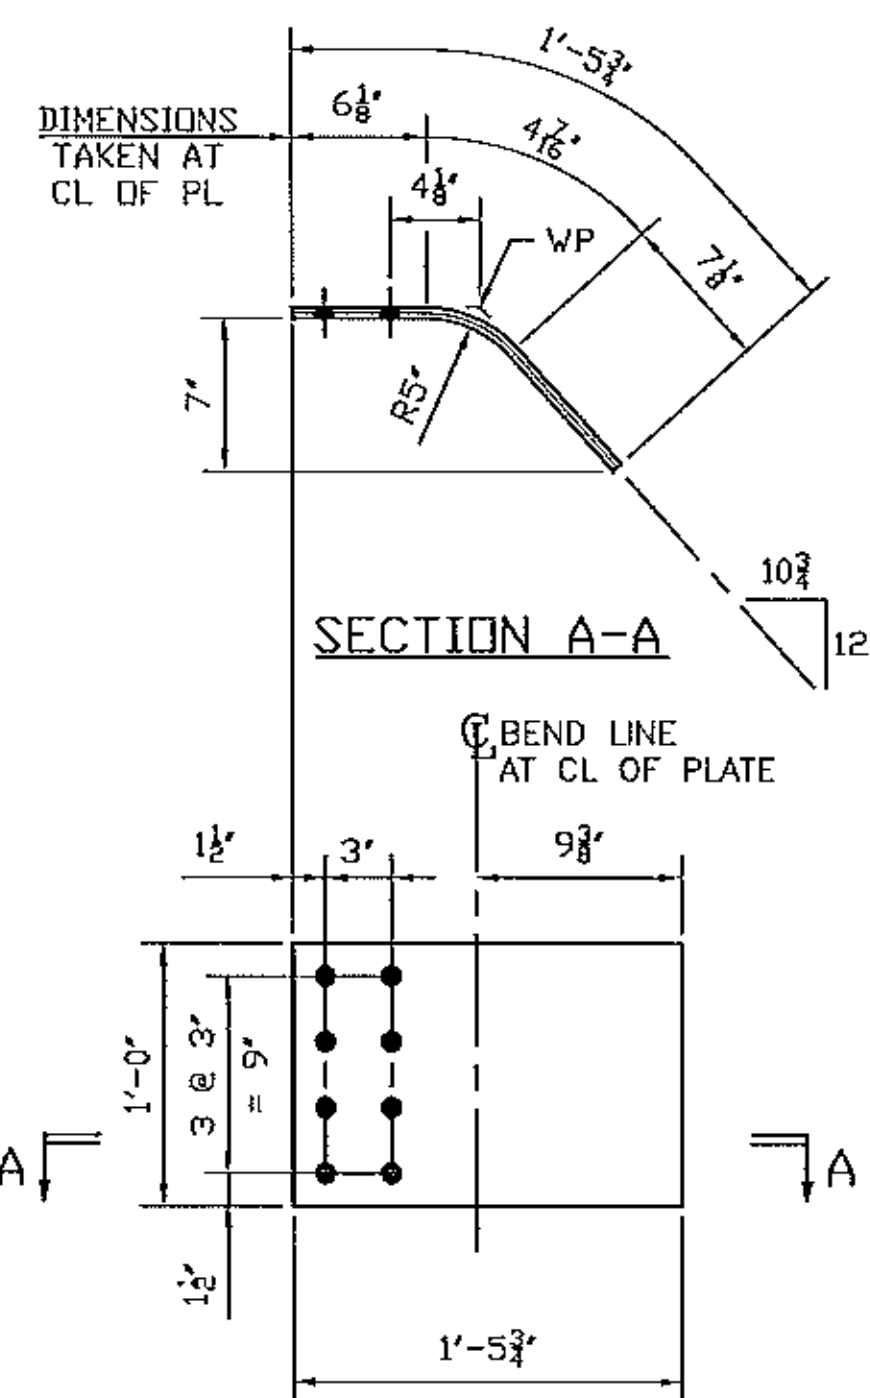


PL1/2x12x1-5 3/4 - x102h
(DEVELOPED)

D.O.R.

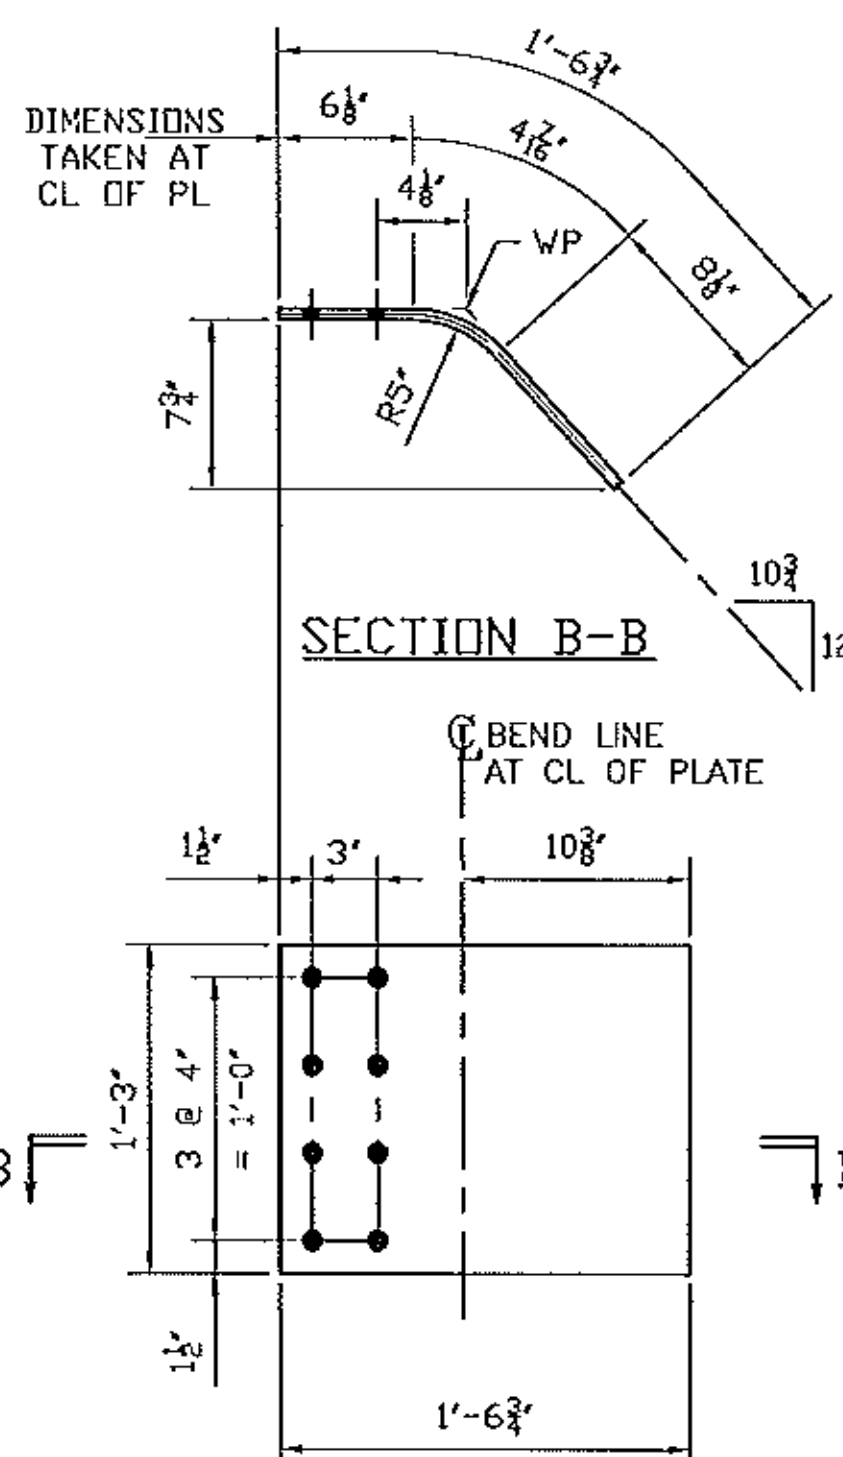


PL1/2x15x1-6 3/4 - x102k
(DEVELOPED)

D.O.R.

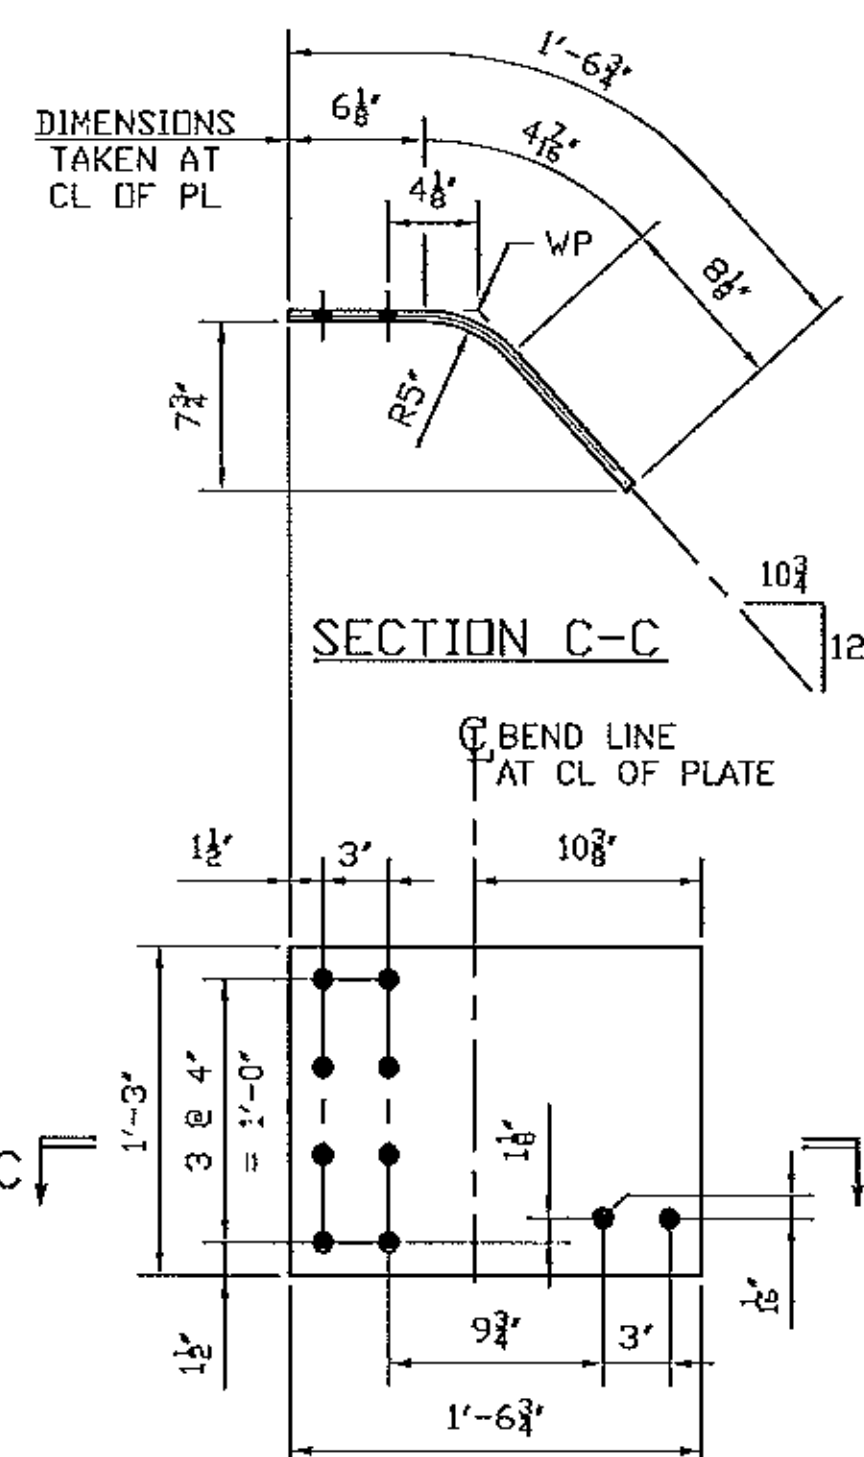

PL1/2x15x1-6 3/4 - x102m
(DEVELOPED)

D.O.R.

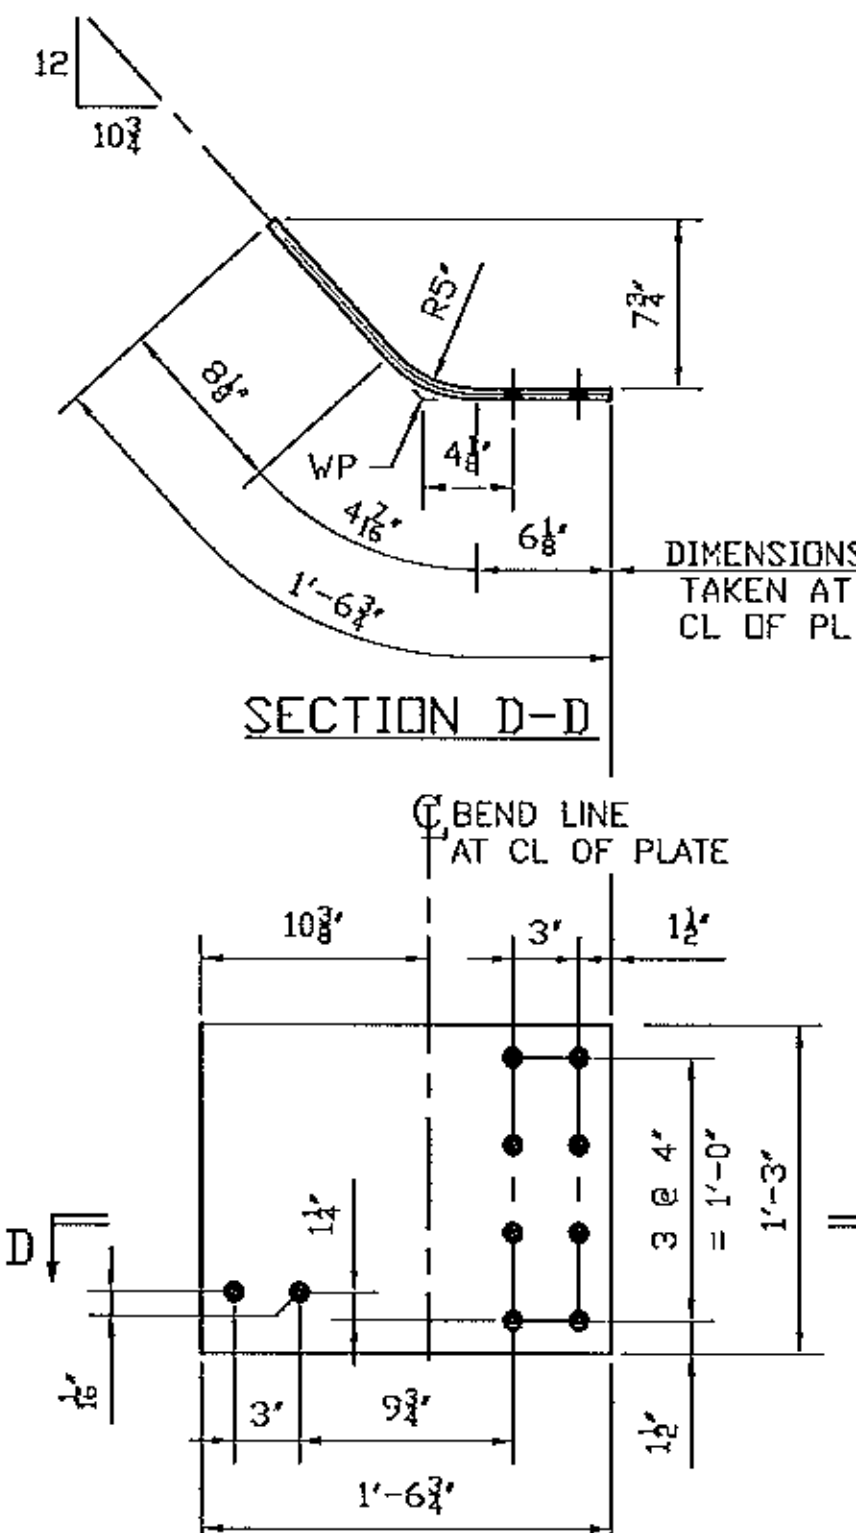

PL1/2x15x1-6 3/4 - x102n
(DEVELOPED)

D.O.R.

GENERAL NOTES: SEE GN100

HOLES: 15/16 (U.N.)

CLEANING
AND PAINTING: SEE SHEET P100
AND P101

No	FOR APPROVAL	DATE	BR	EG
	REVISION		PAR	VER.

NOTE: BOLT 1 WASHER: 1 WASHER UNDER NUT U.N.
BOLT 2 WASHER: 1 WASHER UNDER HEAD U.N.
1 WASHER UNDER HEAD U.N.



PROJECT: VT RT 9, BRIDGE NO. 11
TOWN OF WOODFORD, VT
OVER WALDOOMSAC RIVER

TITLE: CROSSFRAME DETAILS

REFERENCE: PROJECT NO. ER BHF 010-1 (44)

DESIGN BY	BR	DATE	JULY 2012	PROJECT NO.	UN04260
CHECKED BY	GG	DATE	JULY 2012	REVISED BY	X102/A

Vermont Agency of Transportation

RECEIVED

CK'D BY M.E.M. OK'D BY C.W.M.

July 09, 2012

RESUBMIT APPROVED
BY C. CARLSON DATE 07-27-2012