




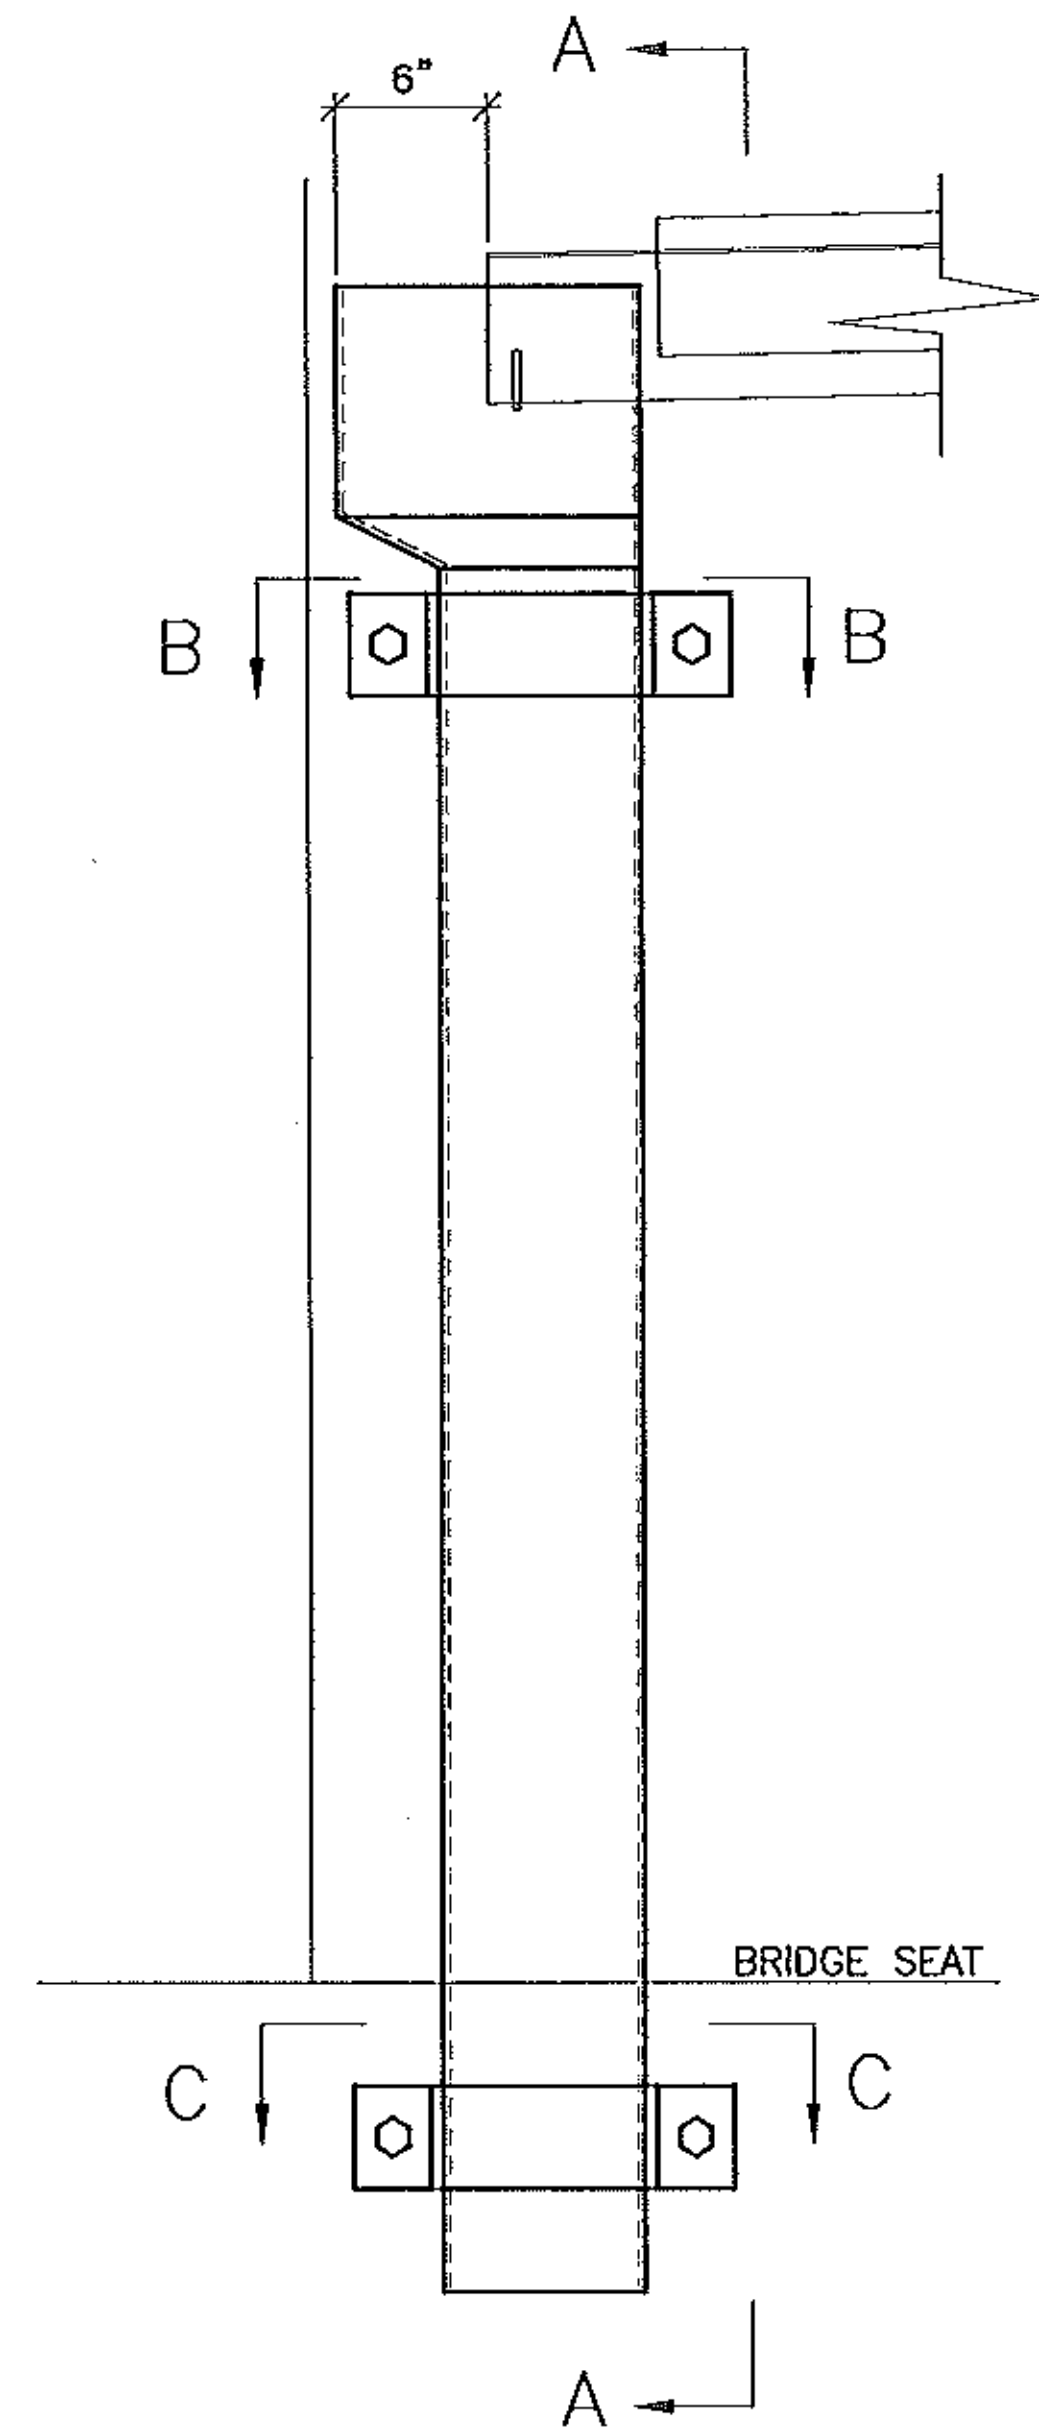


DOWNSPOUT SIDE ELEVATION
(ONE LOCATION AS SHOWN, ONE LOCATION OPP. HAND)

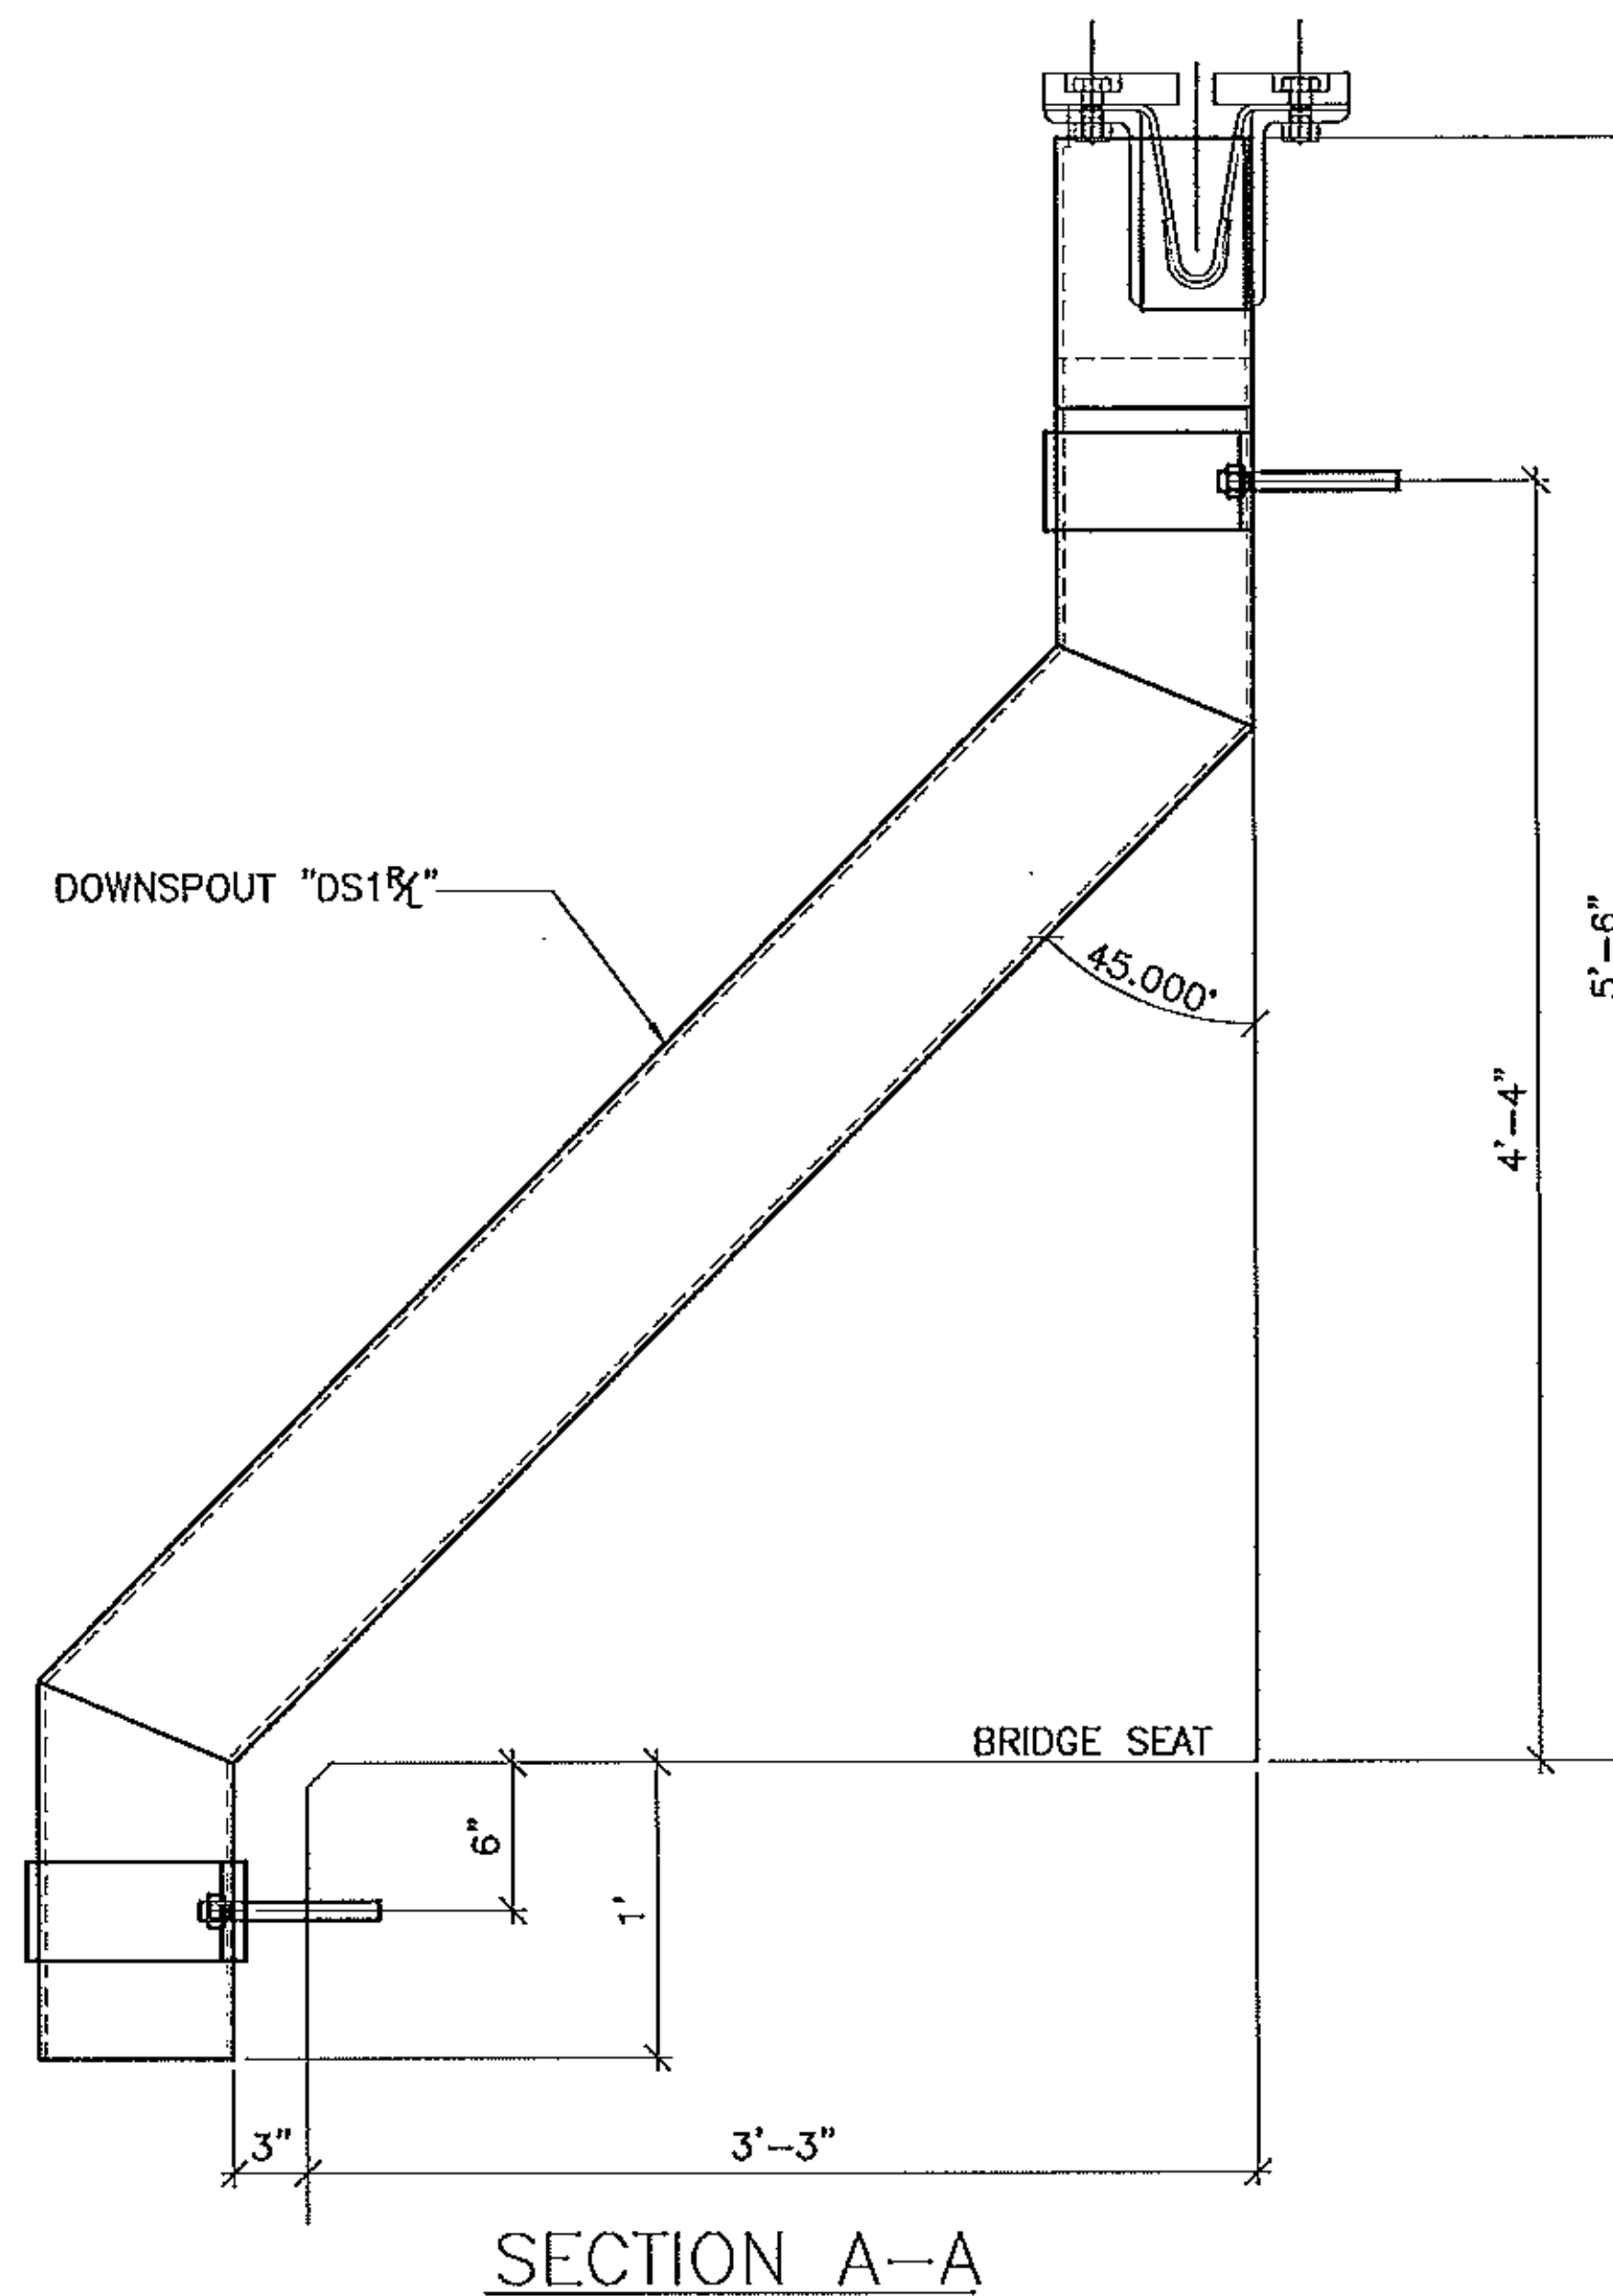

SECTION A-A

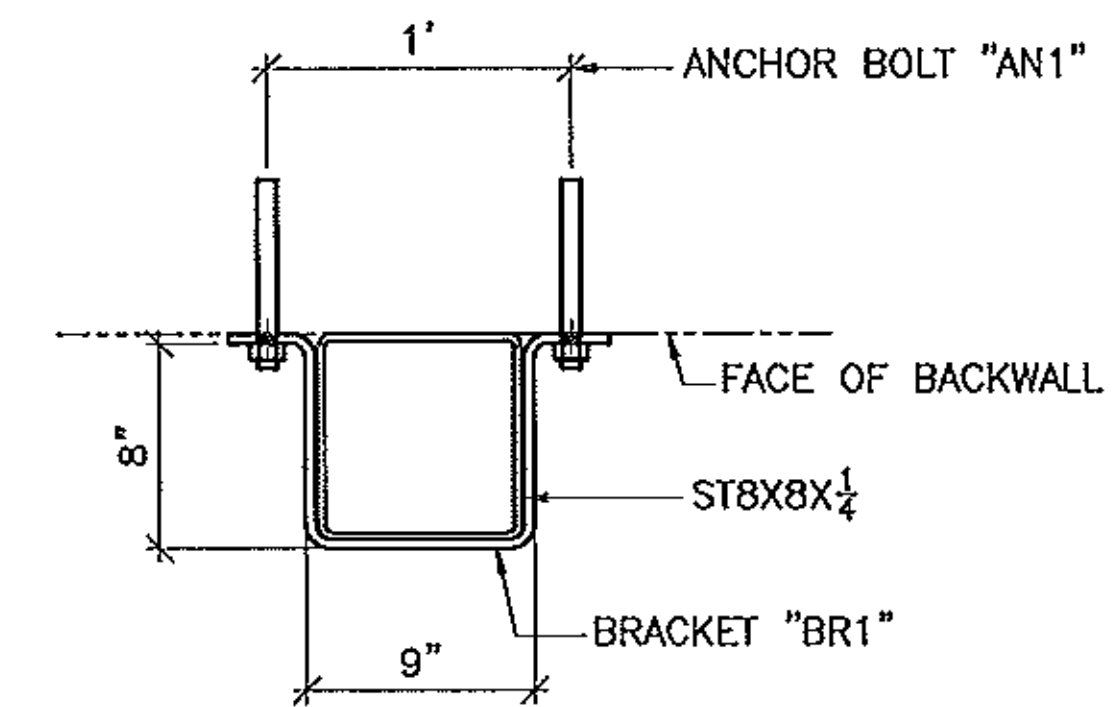

SECTION B-B

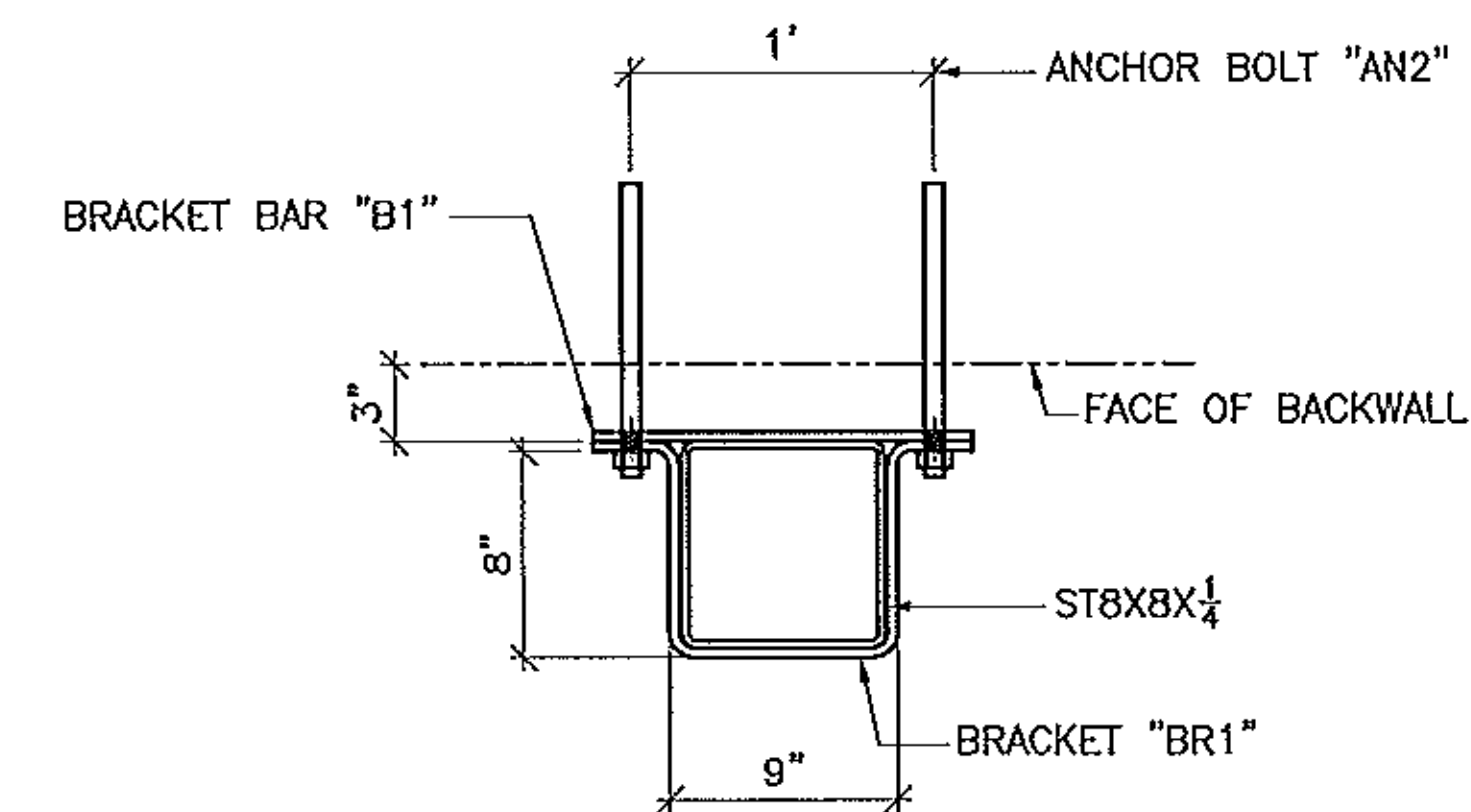

SECTION C-C

SEE DWG. 2 FOR DETAILS & B.O.M.

Vermont Agency of Transportation

RECEIVED

CK'D BY MEM OK'D BY GER

08/21/2012

RESUBMIT
BY C. CARLSON

APPROVED X
DATE 08/29/2012

FINISH	HOT DIPPED GALVANIZED				
MATERIAL	AASHTO M270 GR. 36/ASTM A500 GR.B				
HOLES	AS NOTED				
ELECTRODES	PER W.P.S.				
WELDS	AS NOTED				
SURFACE PREP	SSPC-SP8				
		NO	DATE	DESCRIPTION	BY
REVISIONS					
		ADVANCED RESOURCES & CONST. ENTERPRISES, INCORPORATED P.O. BOX 120 KINGFIELD, ME. 04947 PHONE: (207) 265-2646 - FAX: (207) 265-4064			
DRAFTER	JAC	DOWNSPOUT ERECTION DETAILS			PROJECT NO.
DATE	7/28/12	VERMONT AGENCY OF TRANSPORTATION, TOWN OF WOODFORD			OR BIF 010-1(4)
CHECKED	WTD	ABUTMENT #1 VI JOINT			DWG. NO.
JOB	12-324	G.C. T BUCK CONSTRUCTION, INC.			1