
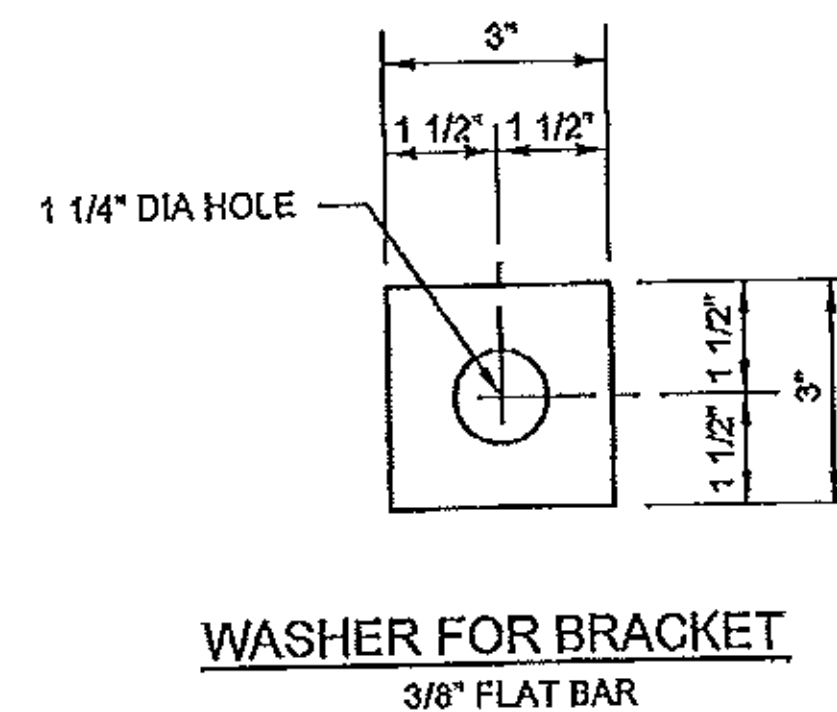
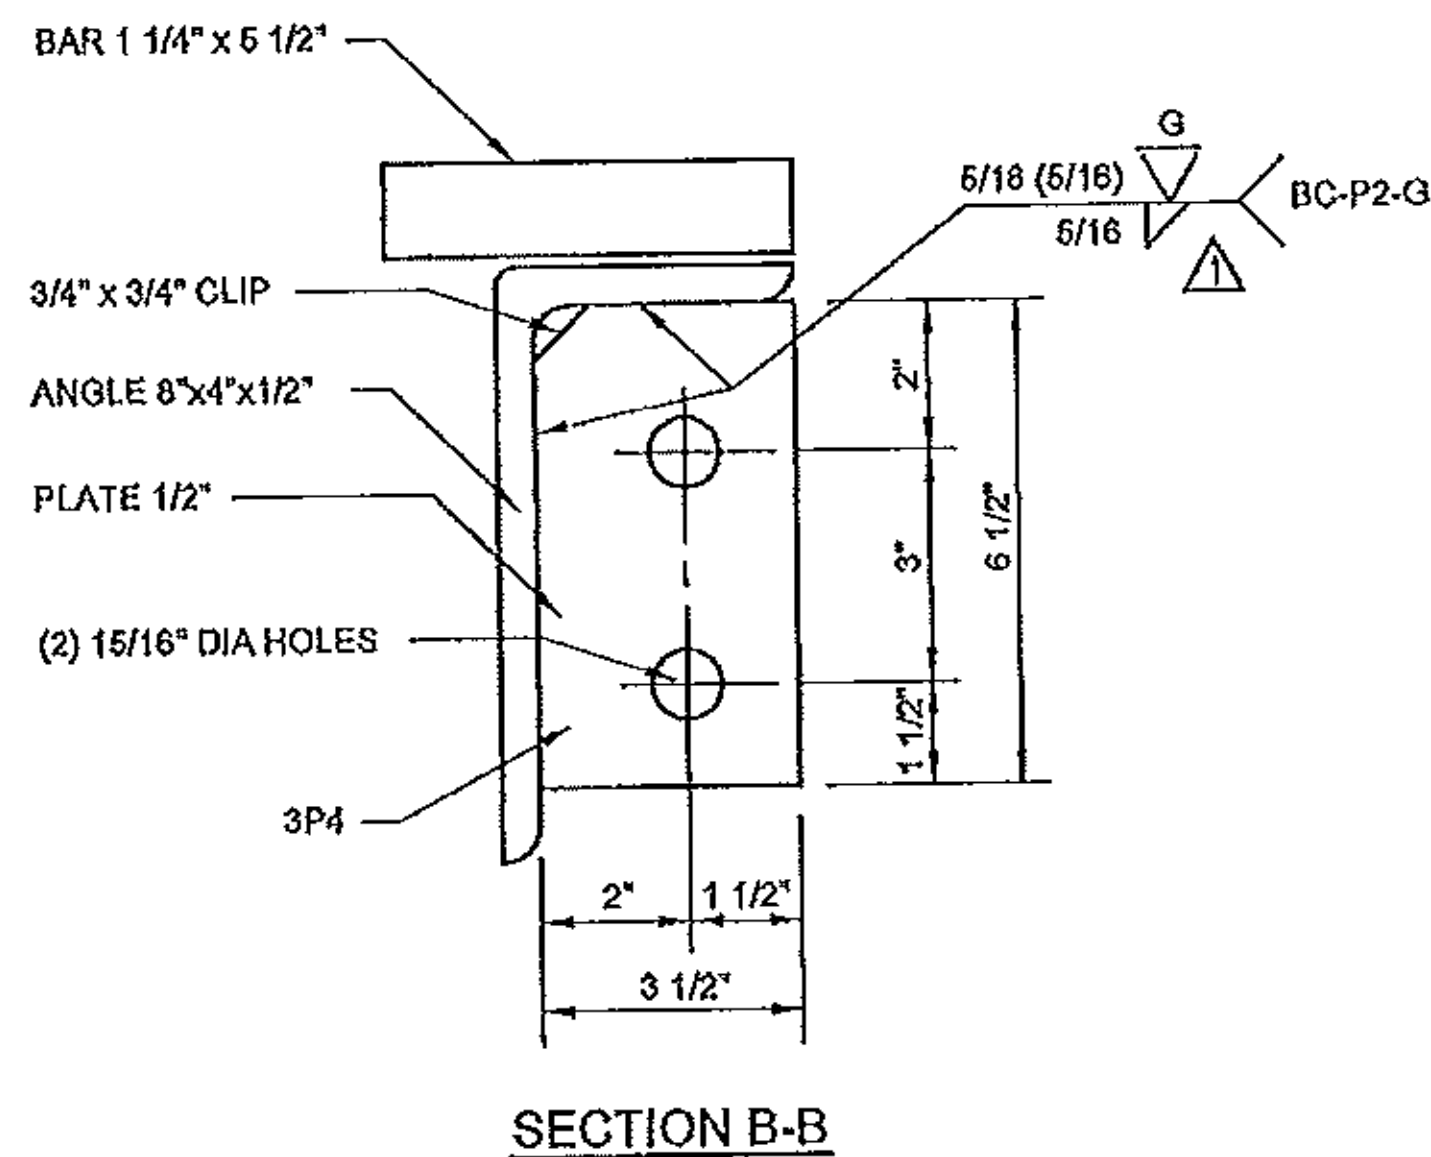
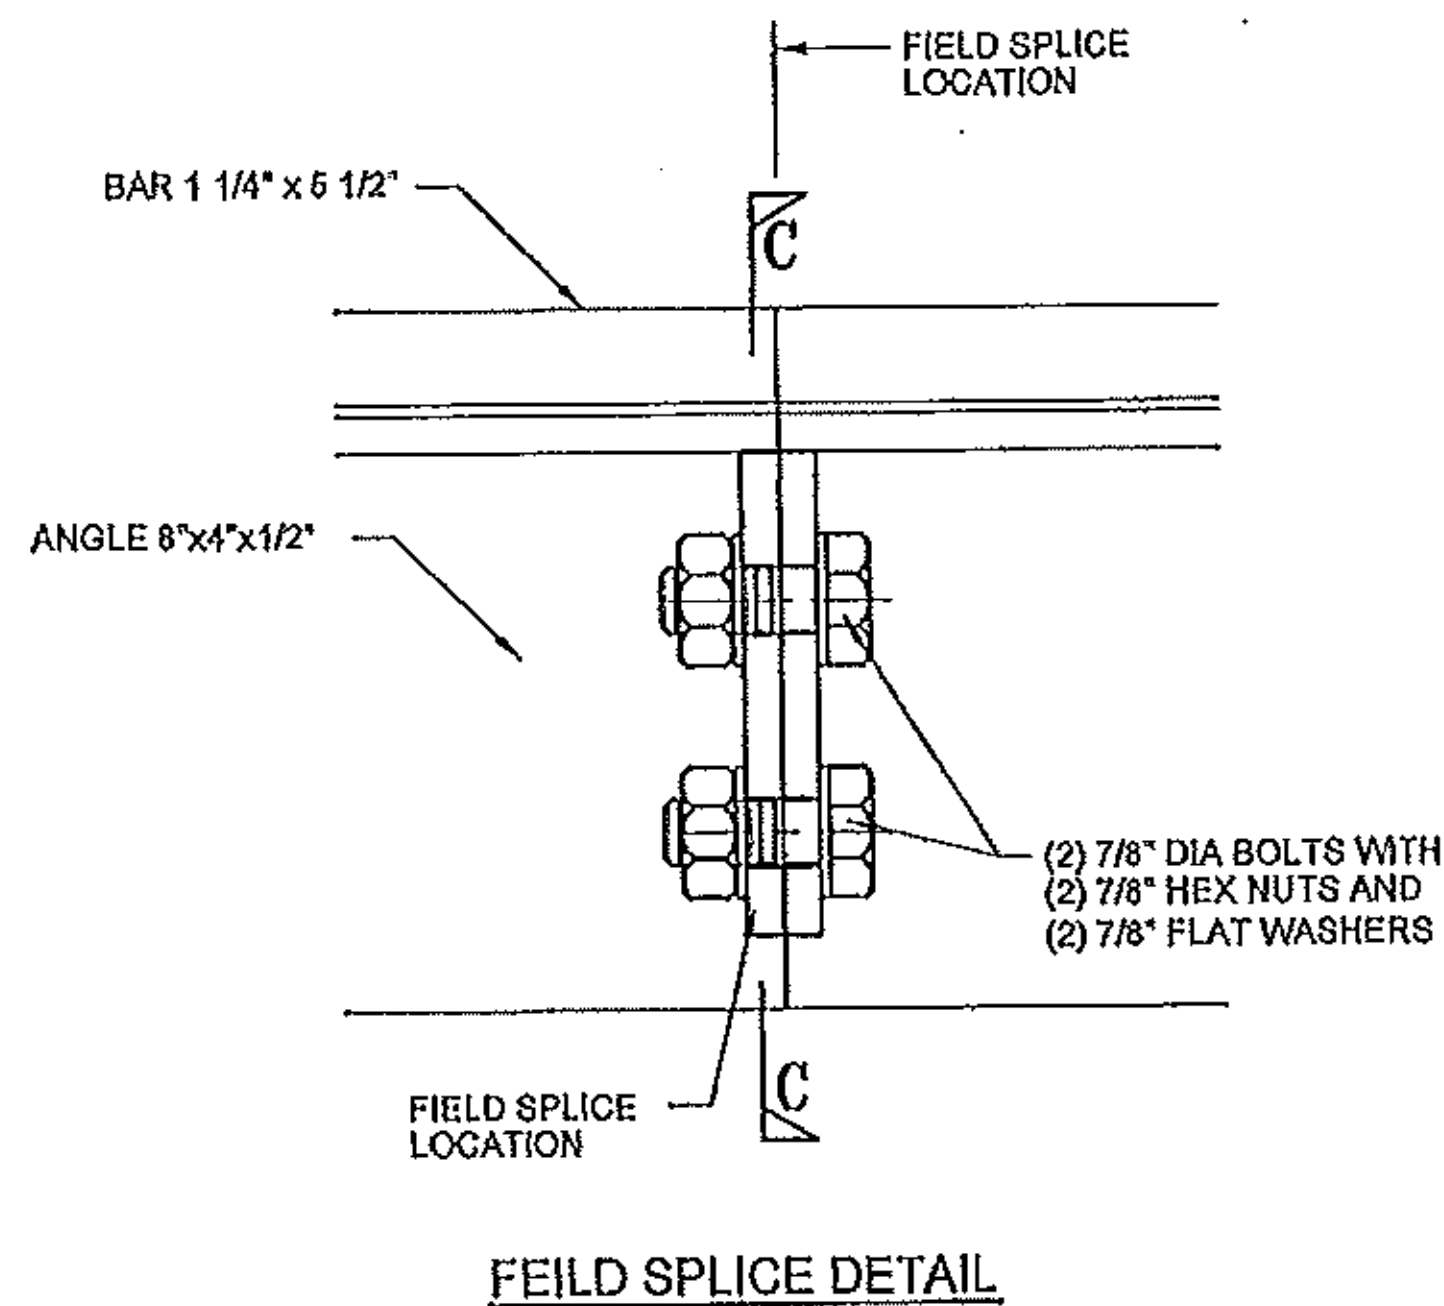
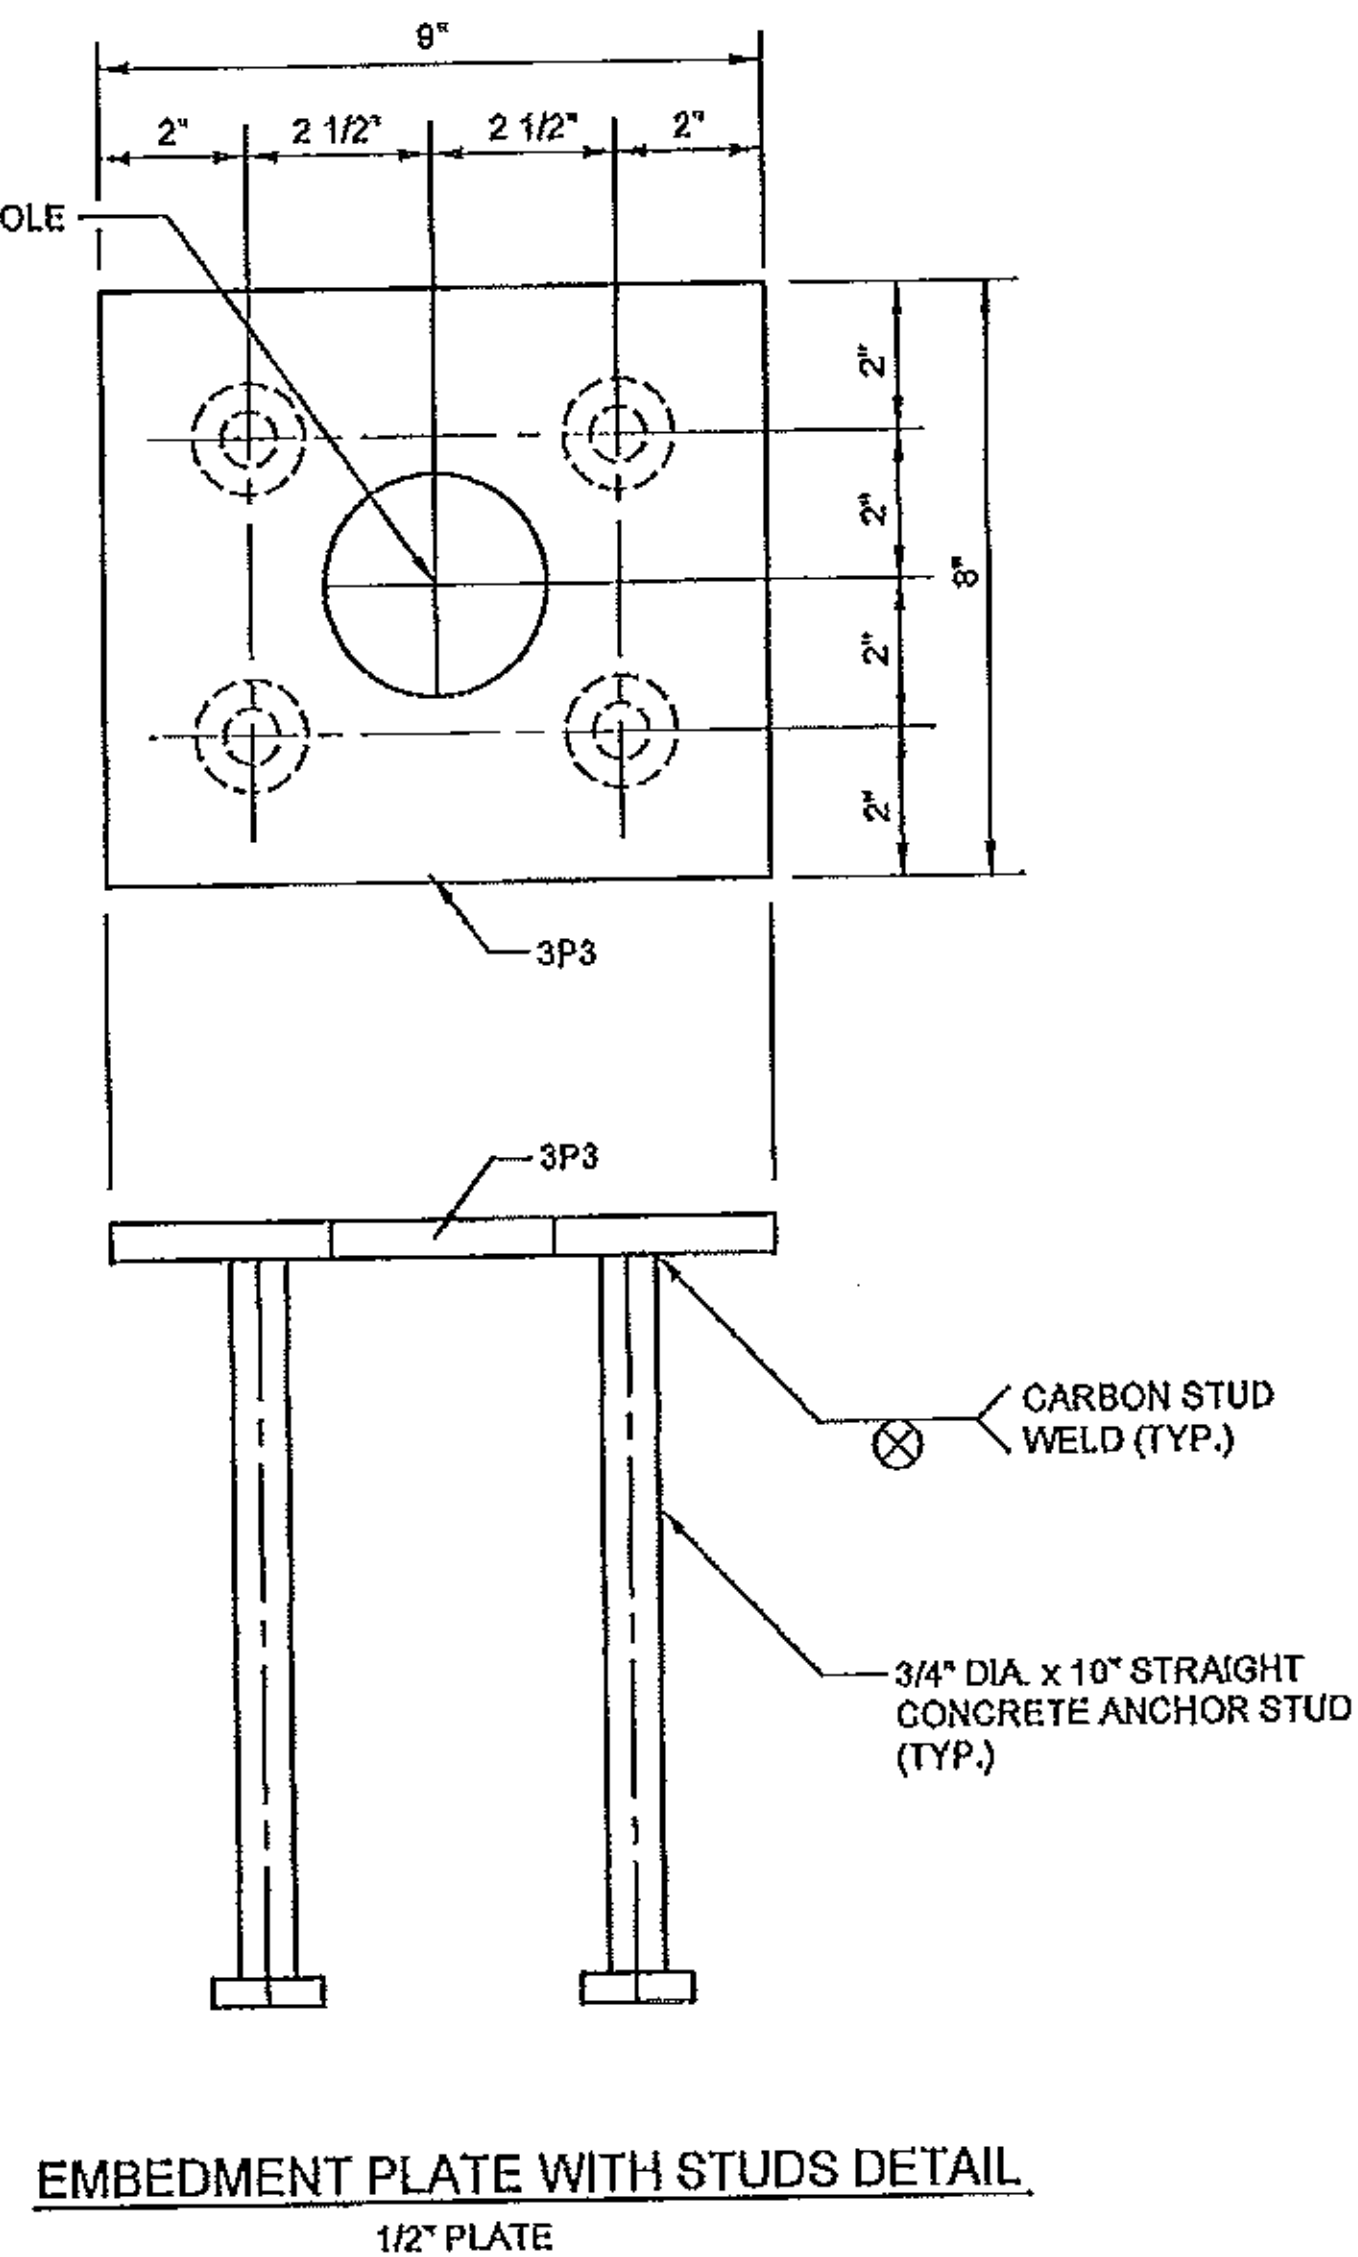
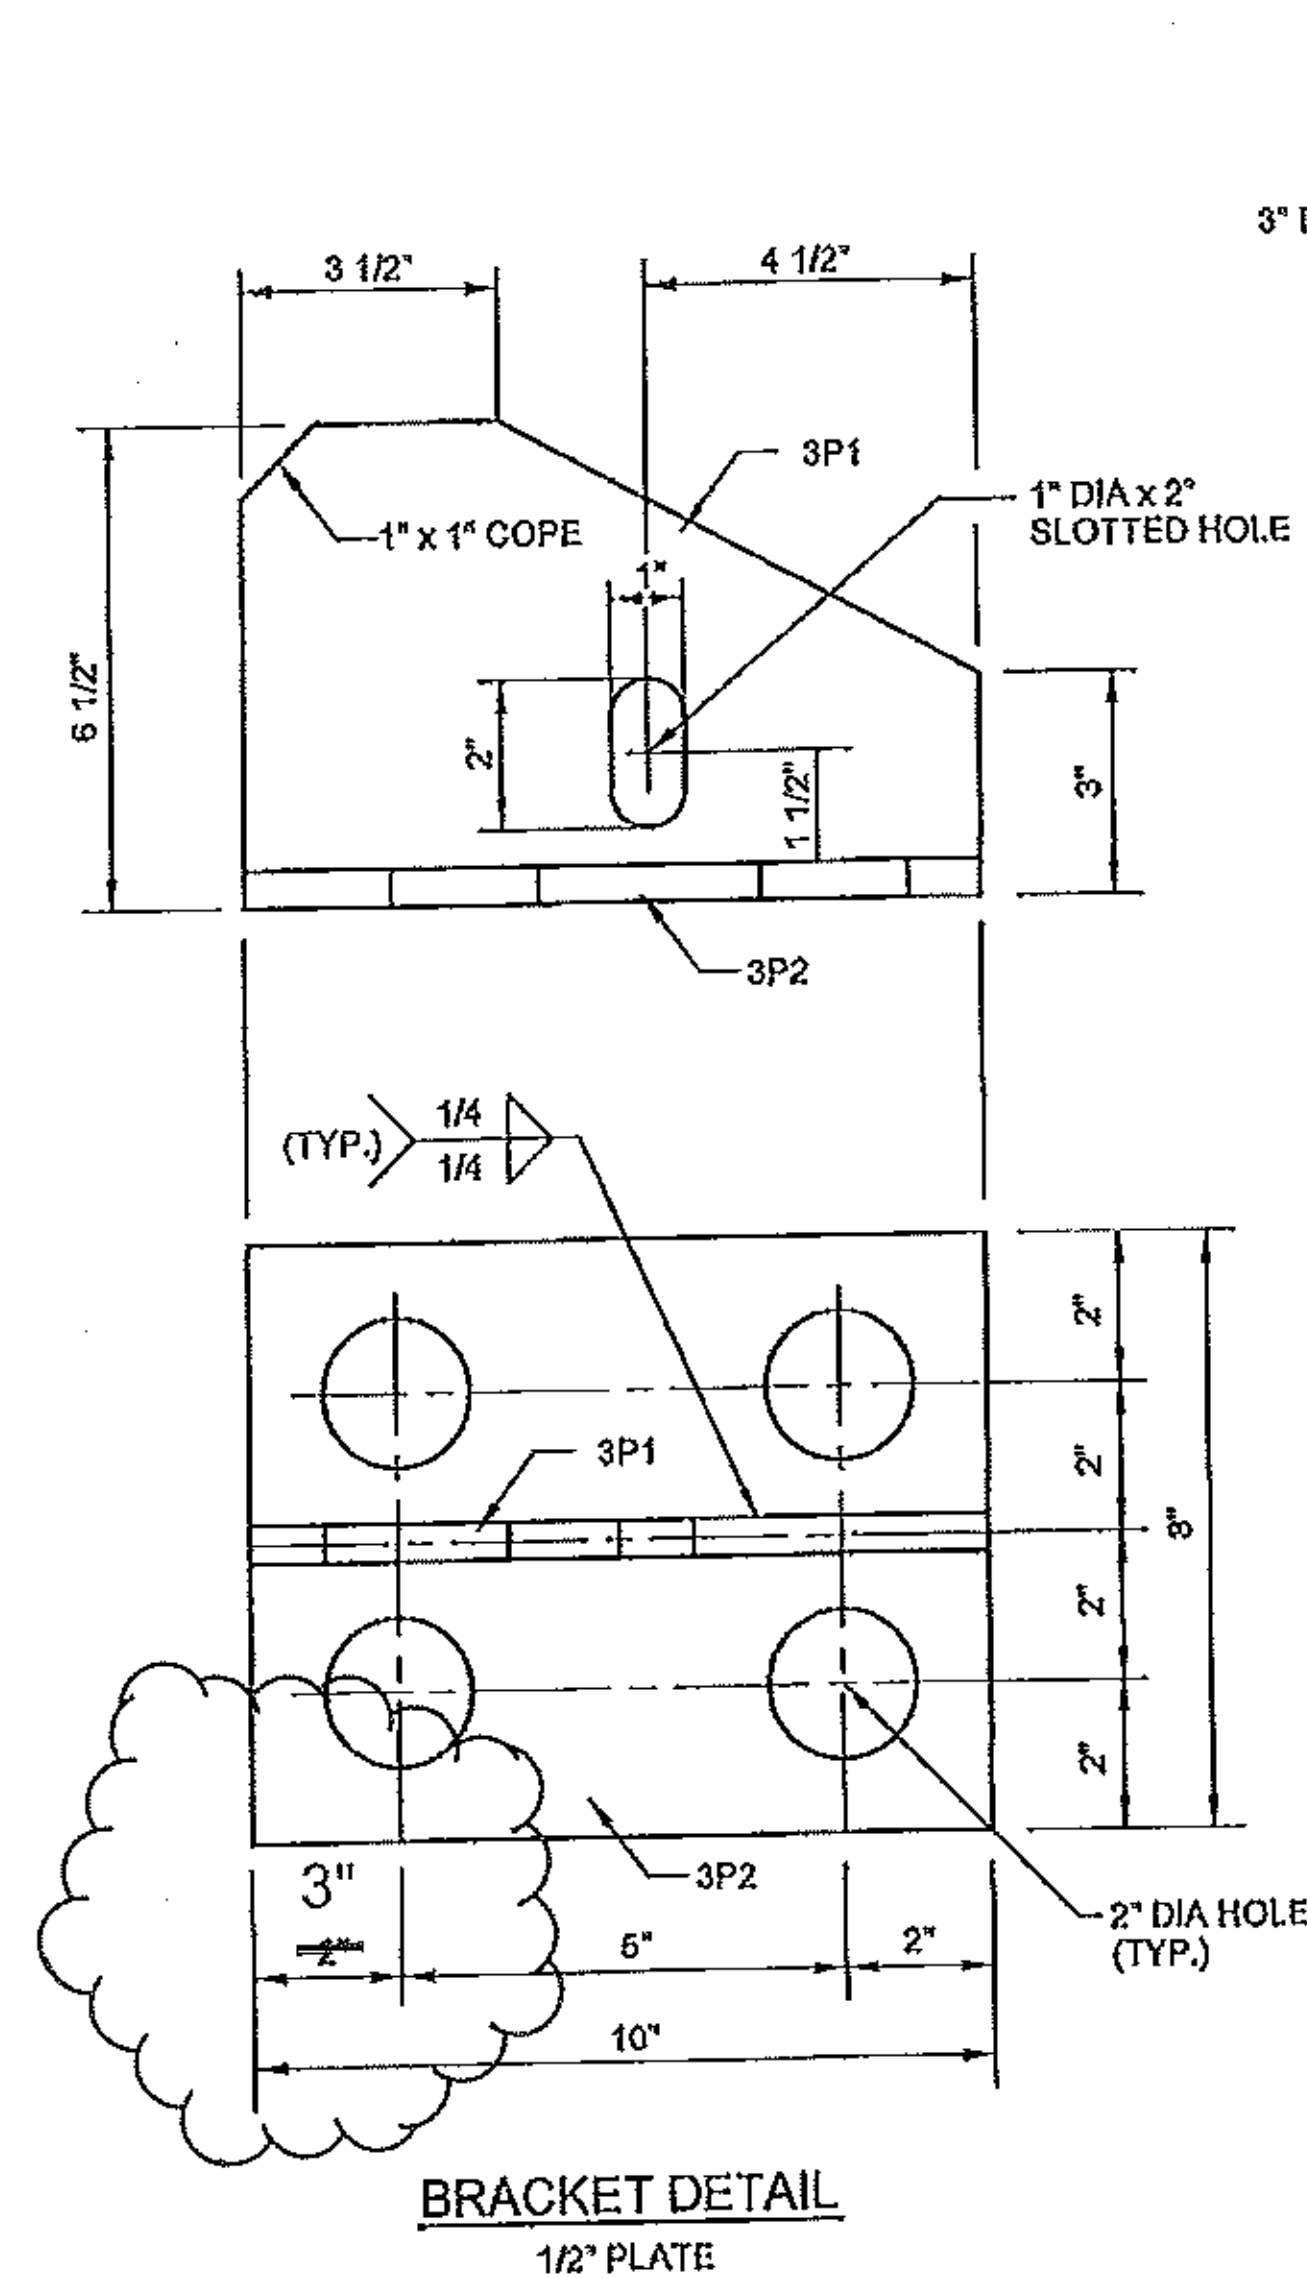


G:\Engineer\WBA Projects\143833-T Buck-Woodford ER BHF 050-Drawings\BSC08503.dwg, 8/21/2012 11:11:09 AM

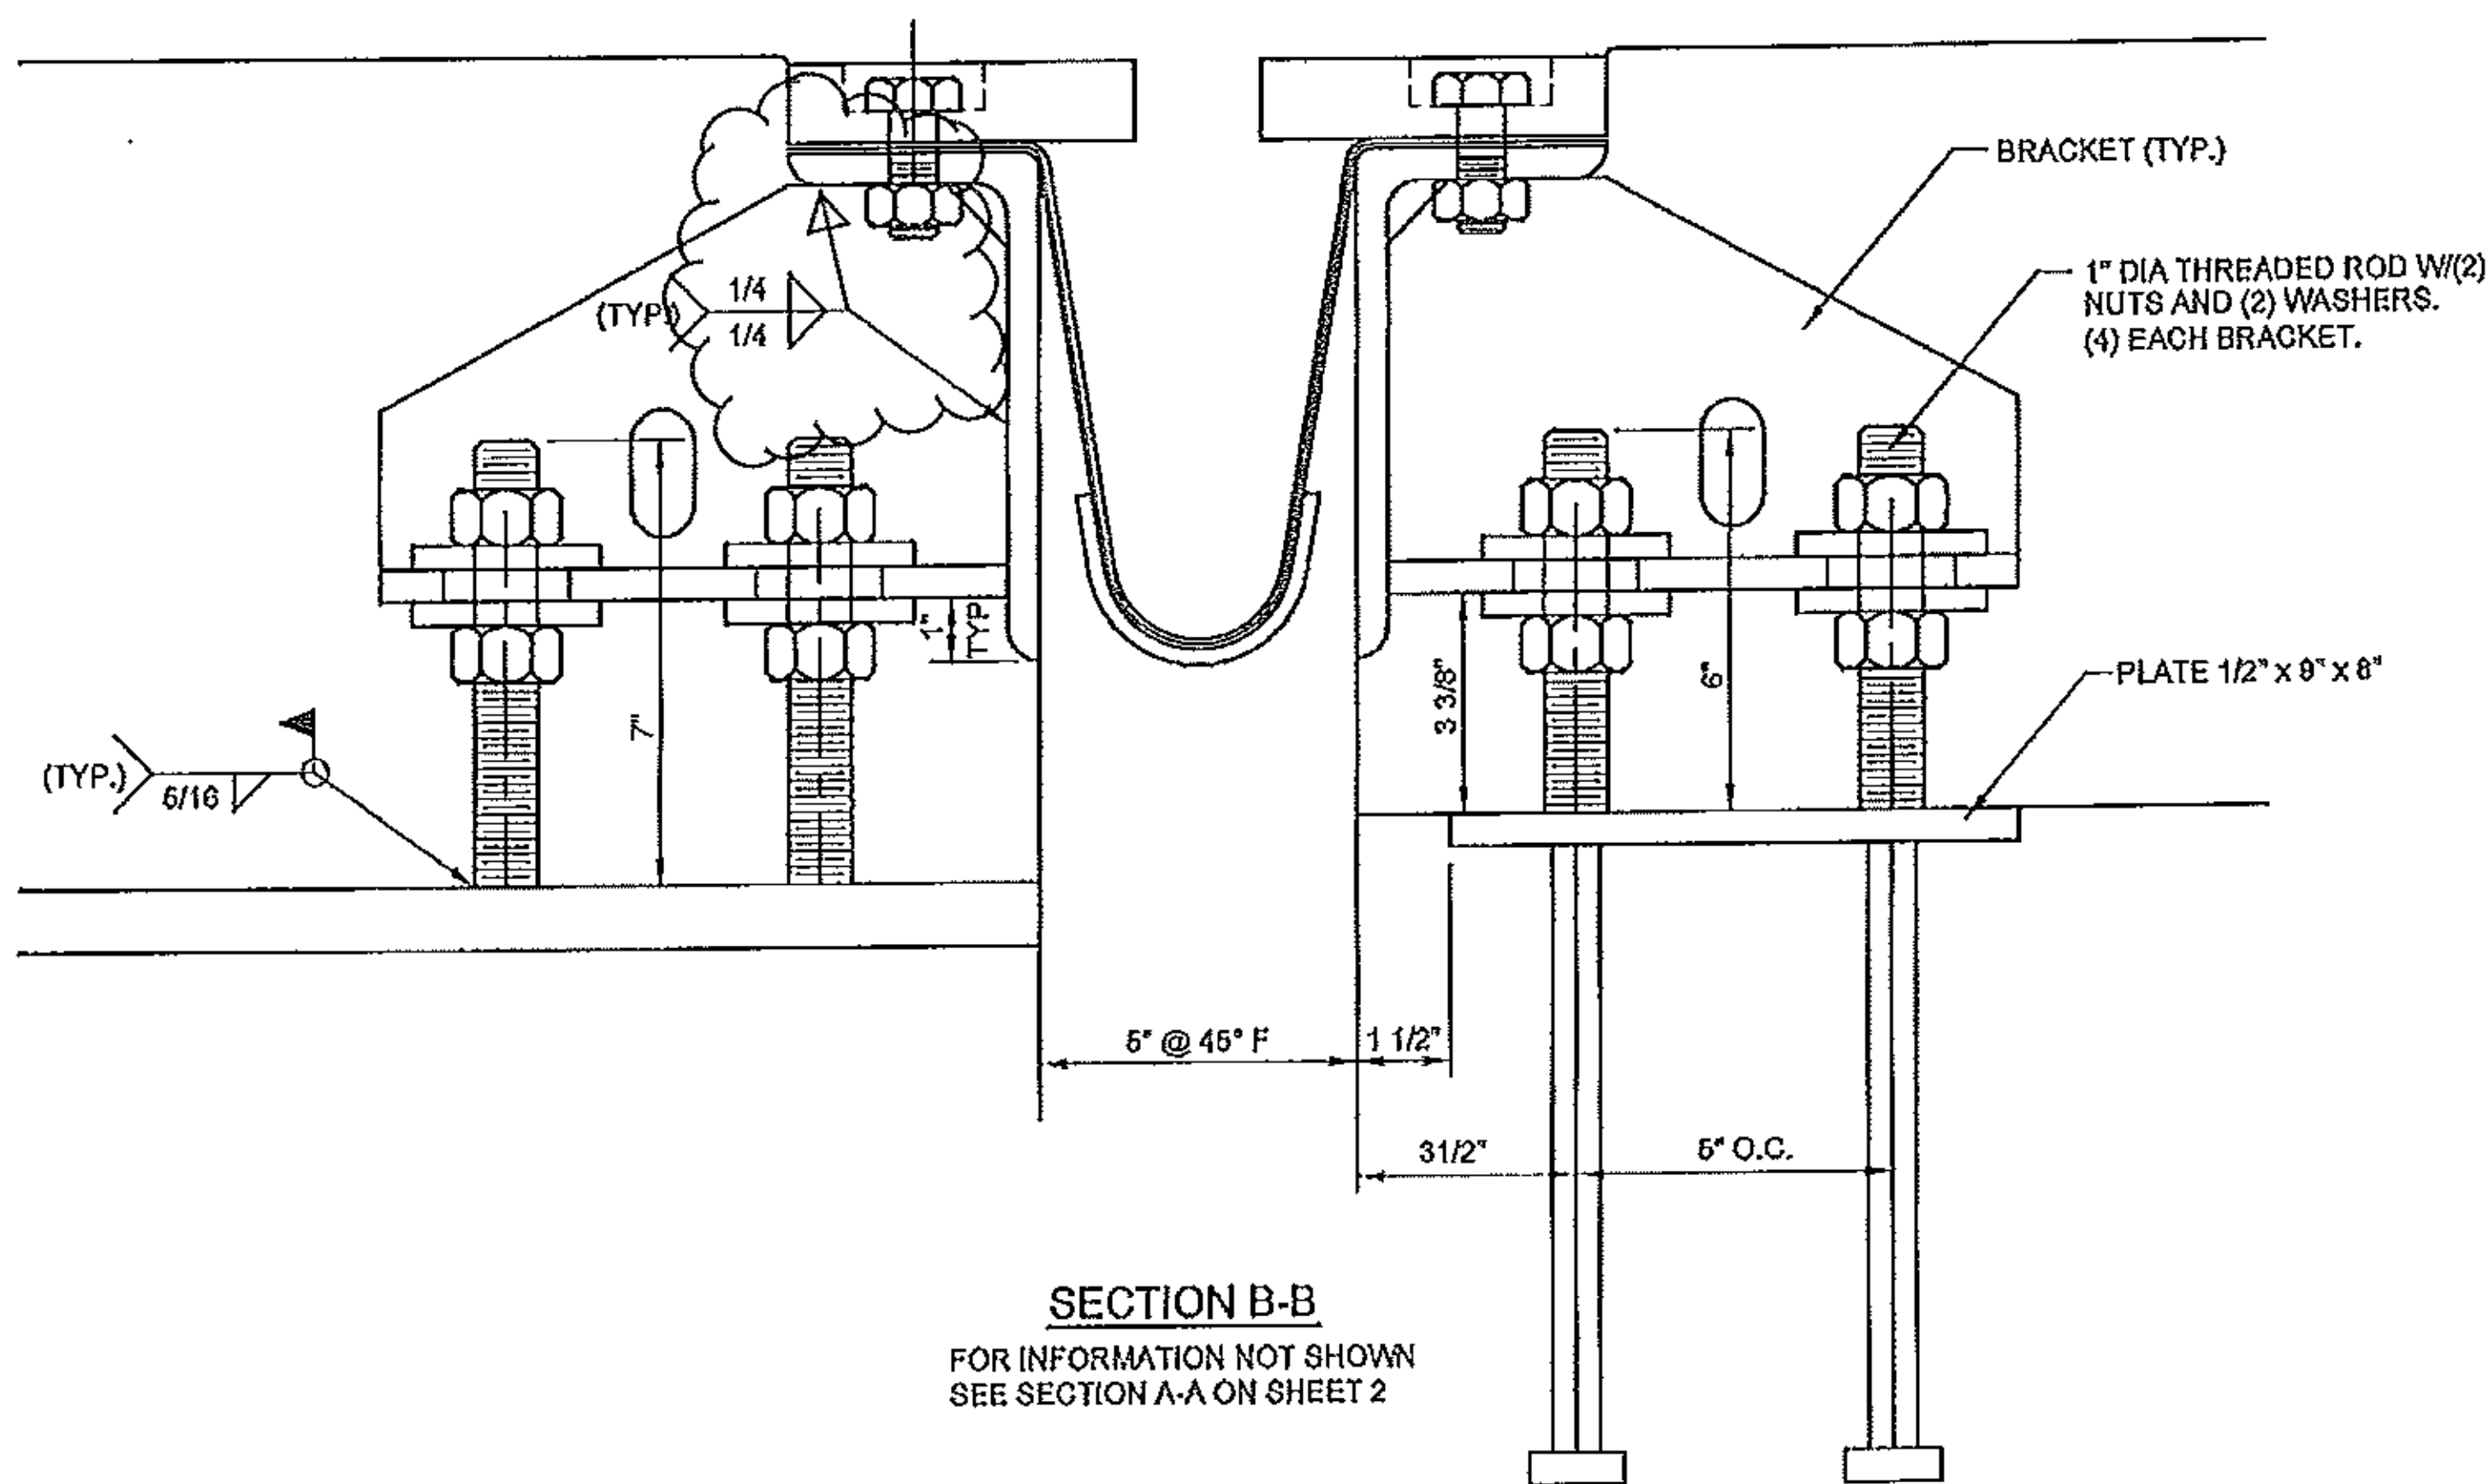

Vermont Agency of Transportation
RECEIVED

CK'D BY M.E.M. OK'D BY C.W.M.

Aug. 21, 2012

RESUBMIT APPROVED AS NOTED
BY C. CARLSON DATE 09-05-2012

STATE: VERMONT
COUNTY: BENNINGTON
PROJECT NO.: ER BHF 010-1(44)
REFERENCE NO.: XXXXXXXXXX
DISTRICT: XXX ROUTE: XXX
WBA PRODUCT NO.: EMB143833AA

MARK SYSTEM
2e1

DRAWING ACTION:

NO.	REVISION	DATE	BY	CHKD
1	REVISED WELD DETAIL	8/21/2012	JFW	
Information provided herein, including but not limited to, any drawing, design, photograph, graphic, or statement(s) ("Materials") are the property of Watson Bowman Acme Corporation ("Company"). Reproduction, translation, or reduction to any electronic medium or machine readable form, in whole or part, is strictly prohibited, except for the express purpose for which it has been furnished, without prior written consent of Company. All Materials are provided by Company for information purposes only. Company reserves the right to amend or withdraw any information contained in the Materials without notice. All technical or other advice by Company, whether verbal or written, concerning products, or the use of products in specific situations ("Advice") is given by Company and is used at the User's own risk.				



WATSON BOWMAN ACME CORPORATION
65 PREVIEW DRIVE, ALBANY, N.Y. 12208 TEL: (518) 511-7343 FAX: (518) 511-9339

PROJECT: WOODFORD
VT RT 9 BRIDGE NO. 11 OVER ROARING
BRANCH OF THE WALLOOMSAC RIVER
WABO PLATE JOINT W/NEOPRENE TROUGH DETAILS

DESIGNED BY	JFW	DATE	8-14-12
CHECKED BY	KF	DATE	8-14-12
SCALE	NTS	WBA JOB NO.	143833
SHEET NO.	3 OF 5	DISTRICT NO.	B-30085