



**62+25.00  
BEGIN APPROACH  
MATCH EXISTING**

**62+50**

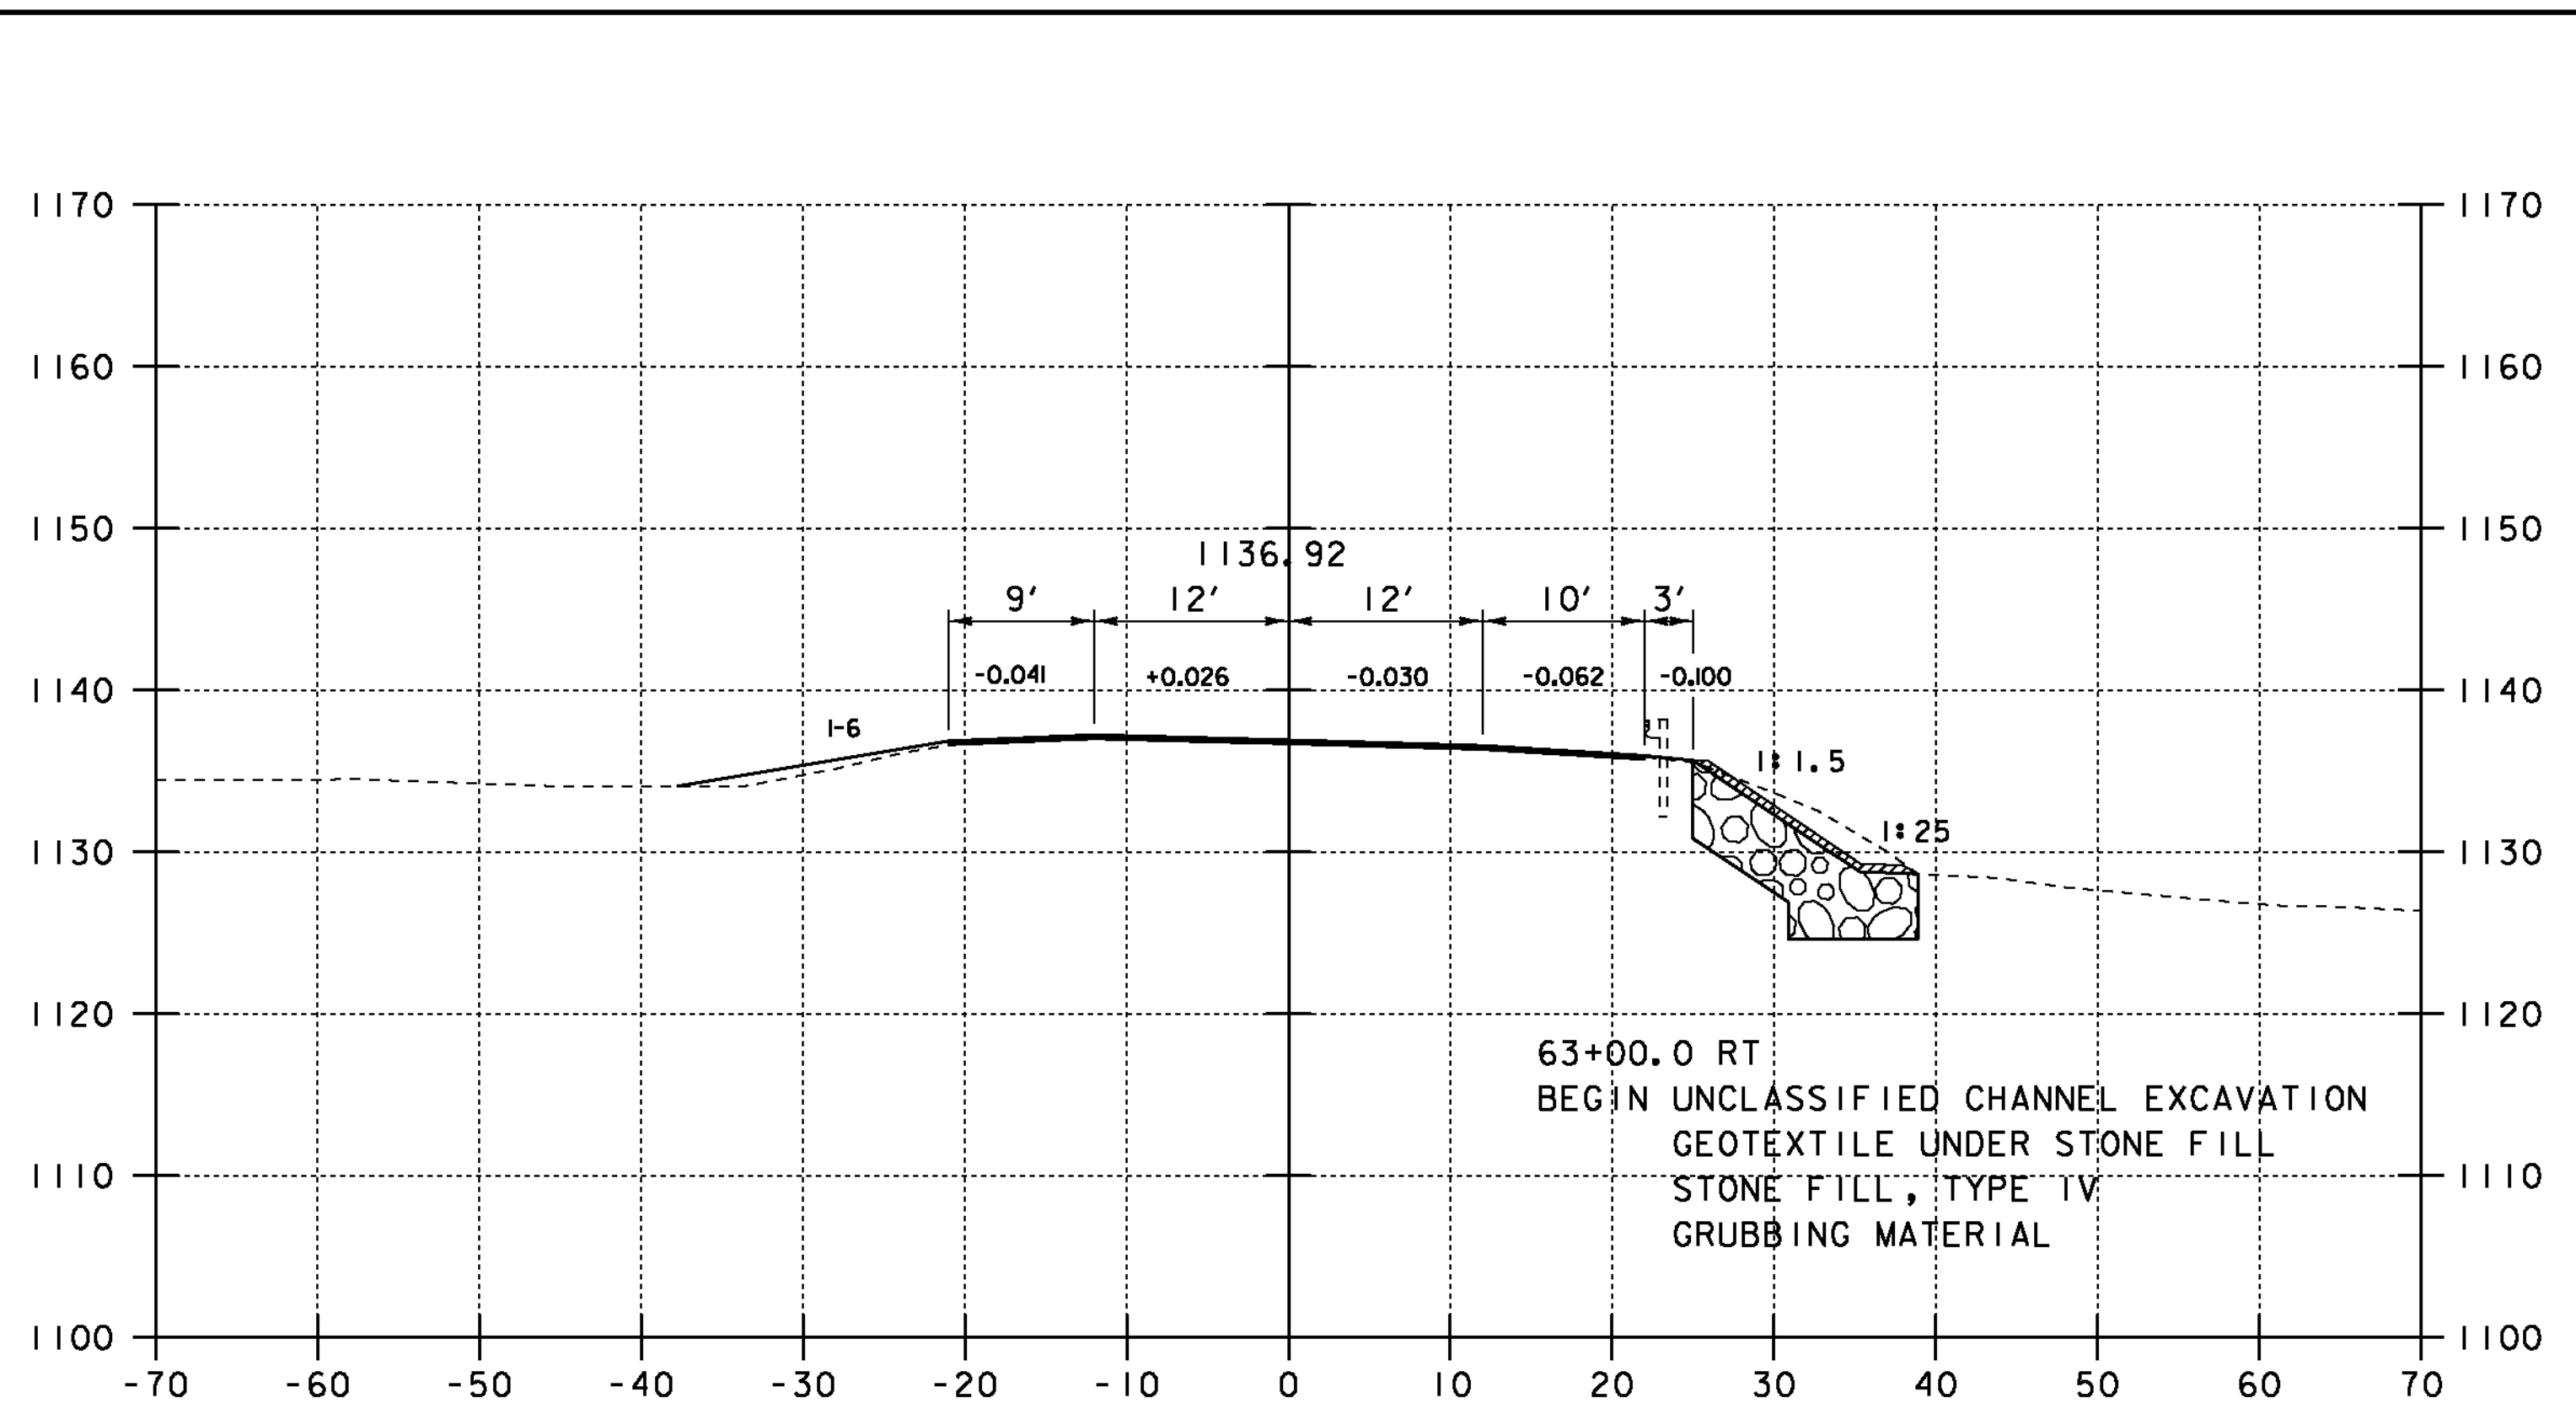


**63+00**

63+00.0 RT  
BEGIN UNCLASSIFIED CHANNEL EXCAVATION  
GEOTEXTILE UNDER STONE FILL  
STONE FILL, TYPE IV  
GRUBBING MATERIAL

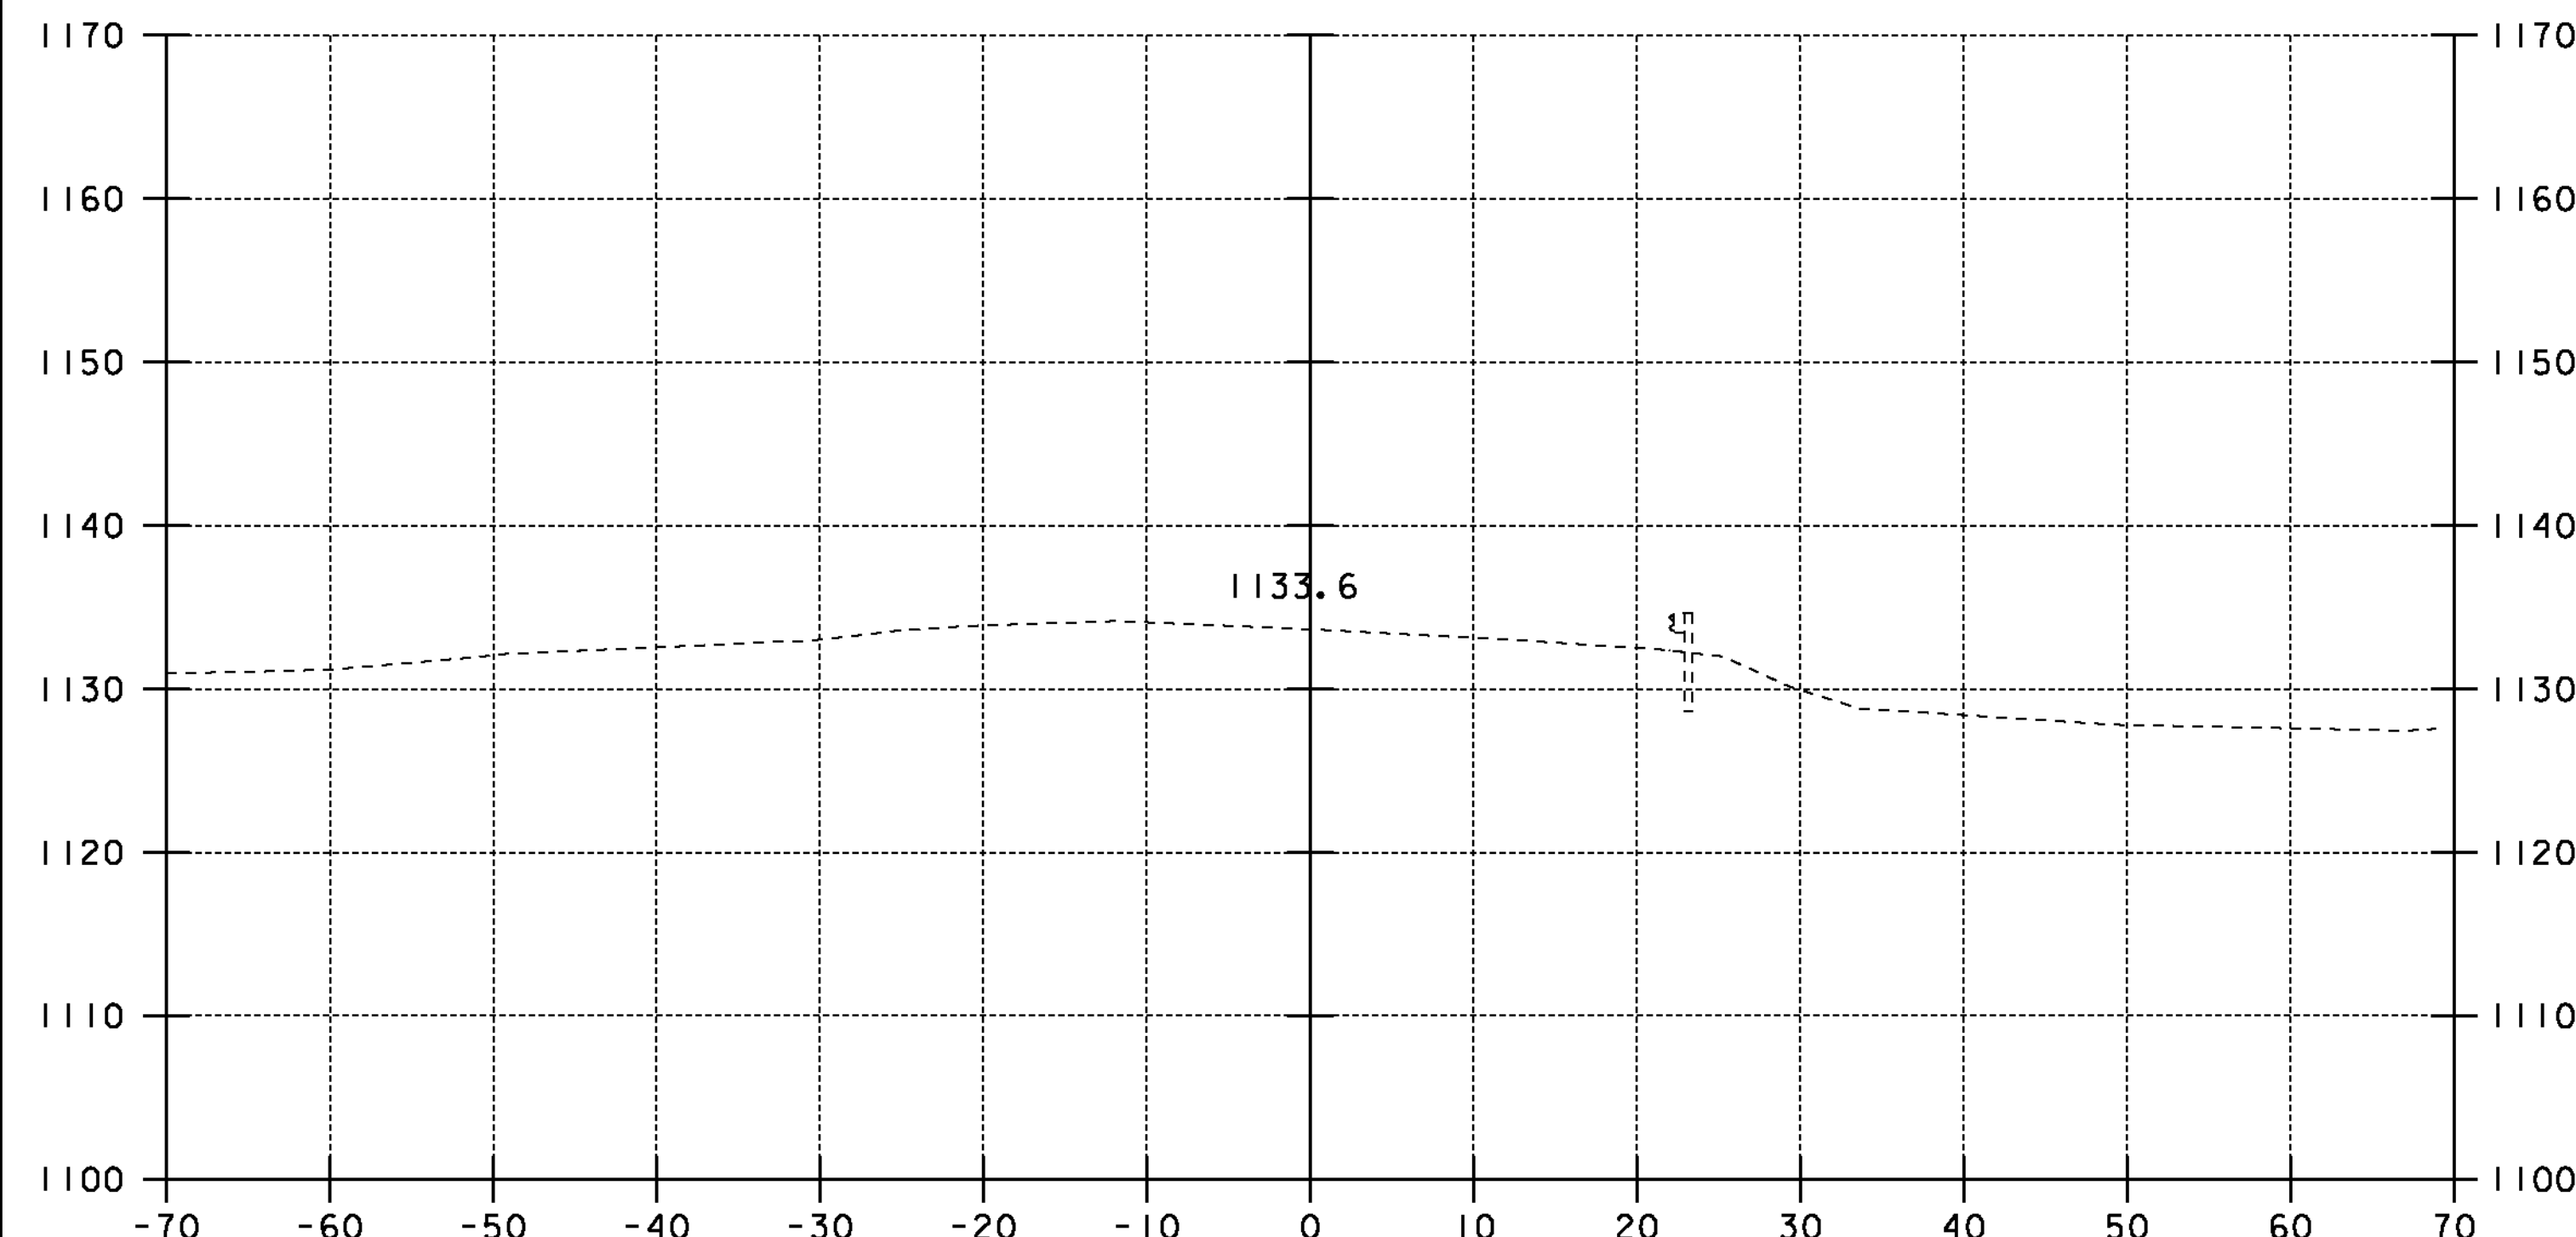

**62+19**

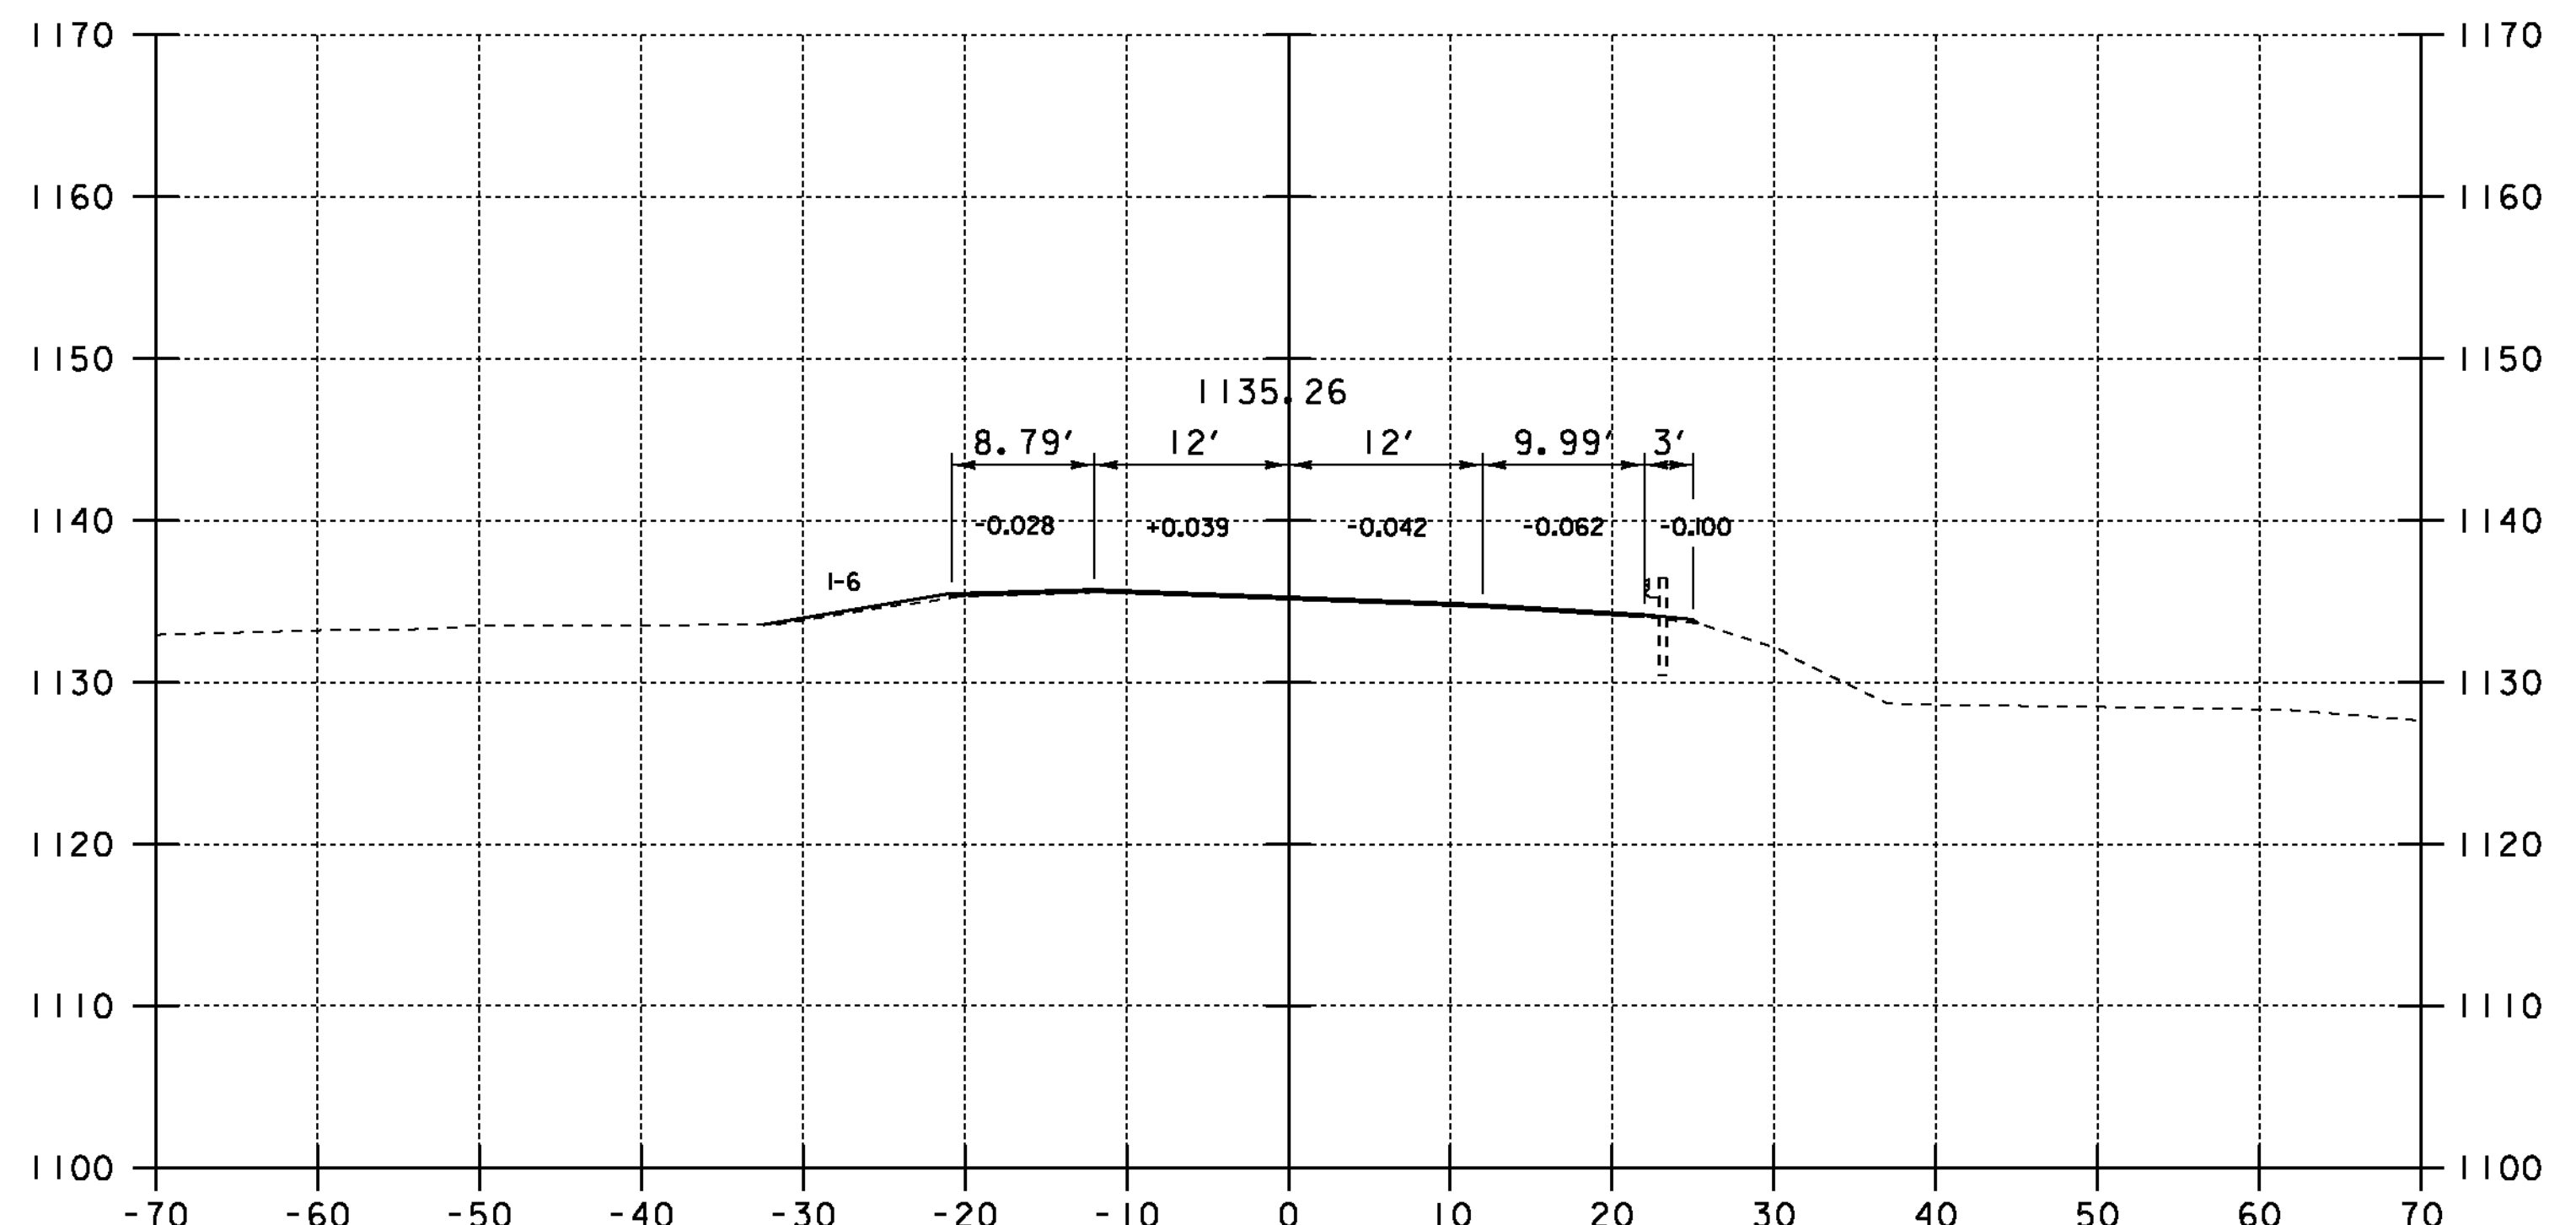

**62+59**

PROJECT NAME:	WOODFORD
PROJECT NUMBER:	ER BHF 010-1(44)
FILE NAME:	slb214xs.dgn
PROJECT LEADER:	C. CARLSON
DESIGNED BY:	M. EVANS-MONGEON
ROADWAY CROSS SECTIONS SHEET (1)	
PLOT DATE:	23-MAR-2012
DRAWN BY:	EVANS-MONGEON
CHECKED BY:	
SHEET	36 OF 58