


STA. 69+00

MATCH LINE B-B

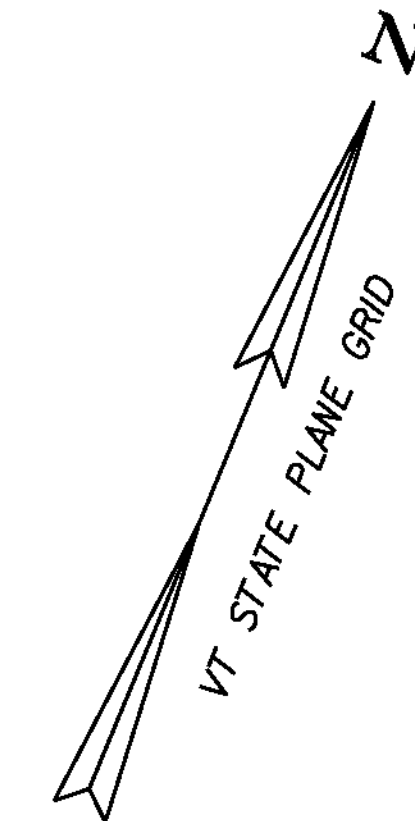

SOIL INFORMATION
 COLTON GRAVELLY LOAMY SAND
 HYDRO GROUP A
 WELL DRAINED
 POTENTIALLY HIGHLY ERODIBLE

SOIL INFORMATION
 BERKSHIRE FINE LOAMY SAND
 HYDRO GROUP B
 HIGHLY ERODIBLE

SCALE 1" = 20'-0"

----- SOIL BOUNDARY

PROJECT NAME: WOODFORD
 PROJECT NUMBER: ER BHF 010-1(44)

FILE NAME: s11b214EPSC bdr.dgn PLOT DATE: 23-MAR-2012
 PROJECT LEADER: CAROLYN CARLSON DRAWN BY: EVANS-MONGEON
 DESIGNED BY: M.EVANS-MONGEON CHECKED BY: G. ROY
 EPSC EXISTING CONDITION (3) SHEET 50 OF 58

