


STA. 63+00

STA. 69+00


MATCH LINE A-A

MATCH LINE B-B

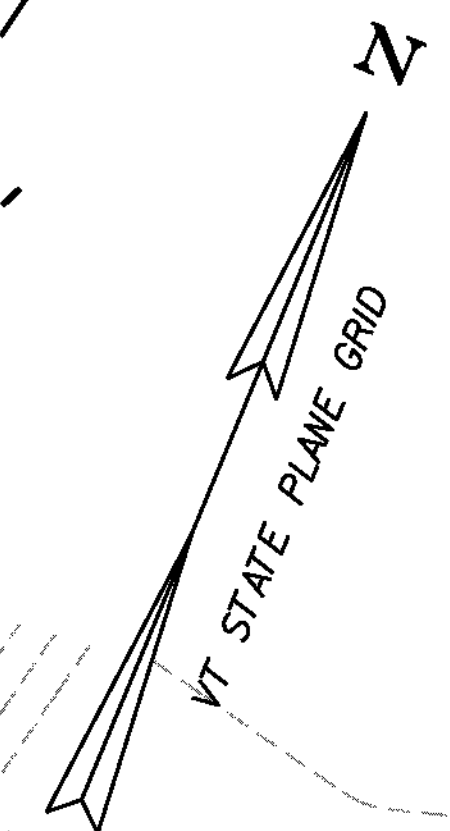

LEGEND

EROSION MATTING	
PROJECT DEMARCATION FENCE	PDF — PDF —
BARRIER FENCE	BF — BF — BF —
RIPARIAN BUFFER
WOVEN WIRE REINFORCED SILT FENCE	-----
SILT FENCE	-----
FILTER CURTAIN	ONNOONNOONNOONNOONNOONNO

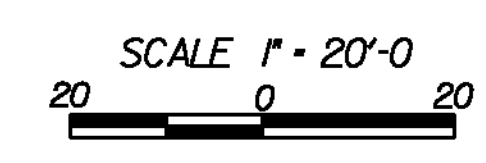

PROJECT NAME:	WOODFORD
PROJECT NUMBER:	ER BHF 010-1(44)
FILE NAME:	slb214EPSC bdr.dgn
PROJECT LEADER:	C. CARLSON
DESIGNED BY:	M. EVANS-MONGEON
EPSC CONSTRUCTION CONDITION (2)	
PLOT DATE:	23-MAR-2012
DRAWN BY:	EVANS-MONGEON
CHECKED BY:	G. ROY
SHEET	52 OF 58