

NOTE:  
SHRUBS SHALL BE MULCHED ONLY  
ON FLAT GROUND OR DISCRETION  
OF ENGINEER.

2" BARK MULCH AS SPECIFIED.  
TAPER AT BASE AS SHOWN.

FORM SAUCER WITH 3" HIGH BY 3"  
WIDE CONTINUOUS RIM.

EXISTING GRADE

FINISHED GRADE

BACK FILL MIX CONSISTS OF 1/2  
TOPSOIL, 1/4 COMPOST, AND 1/4  
NATIVE MATERIAL AS APPROVED BY  
THE ENGINEER. TAMP TO REMOVE  
AIR POCKETS AND WATER  
THOROUGHLY AT TIME OF PLANTING.

PLACE SHRUB IN THE HOLE SUCH  
THAT BARE ROOT BALL RESTS ON  
UNDISTURBED GROUND. AVOID  
PLANTING TOO DEEP. TOP OF  
ROOTBALL SHOULD BE AT FINISHED  
GRADE.

PLANTING HOLE SHALL BE AT  
LEAST 3 X THE WIDTH OF  
THE ROOT BALL.

SHRUB AND SEEDLING TREE PLANTING DETAIL

2" BARK MULCH AS SPECIFIED.  
TAPER AT BASE AS SHOWN.

MAINTAIN MINIMUM 3" HIGH BY 3" WIDE  
CONTINUOUS RIM ON LOWER SIDES OF  
PLANTING TO RETAIN WATER.

ORIGINAL GROUND


BIODEGRADABLE  
JUTE MESH

BACK FILL MIX CONSISTS OF 1/2 TOPSOIL,  
1/4 COMPOST, AND 1/4 NATIVE MATERIAL AS  
APPROVED BY THE ENGINEER. TAMP TO  
REMOVE AIR POCKETS AND WATER THOROUGHLY  
AT TIME OF PLANTING.

PLACE SHRUB IN THE HOLE SUCH THAT BARE  
ROOT BALL RESTS ON UNDISTURBED GROUND.  
AVOID PLANTING TOO DEEP. TOP OF ROOTBALL  
SHOULD BE AT FINISHED GRADE.

PLANTING HOLE SHALL BE AT  
LEAST 2 X THE WIDTH OF  
THE ROOT BALL.

SHRUB AND SEEDLING TREE PLANTING ON SLOPES DETAIL

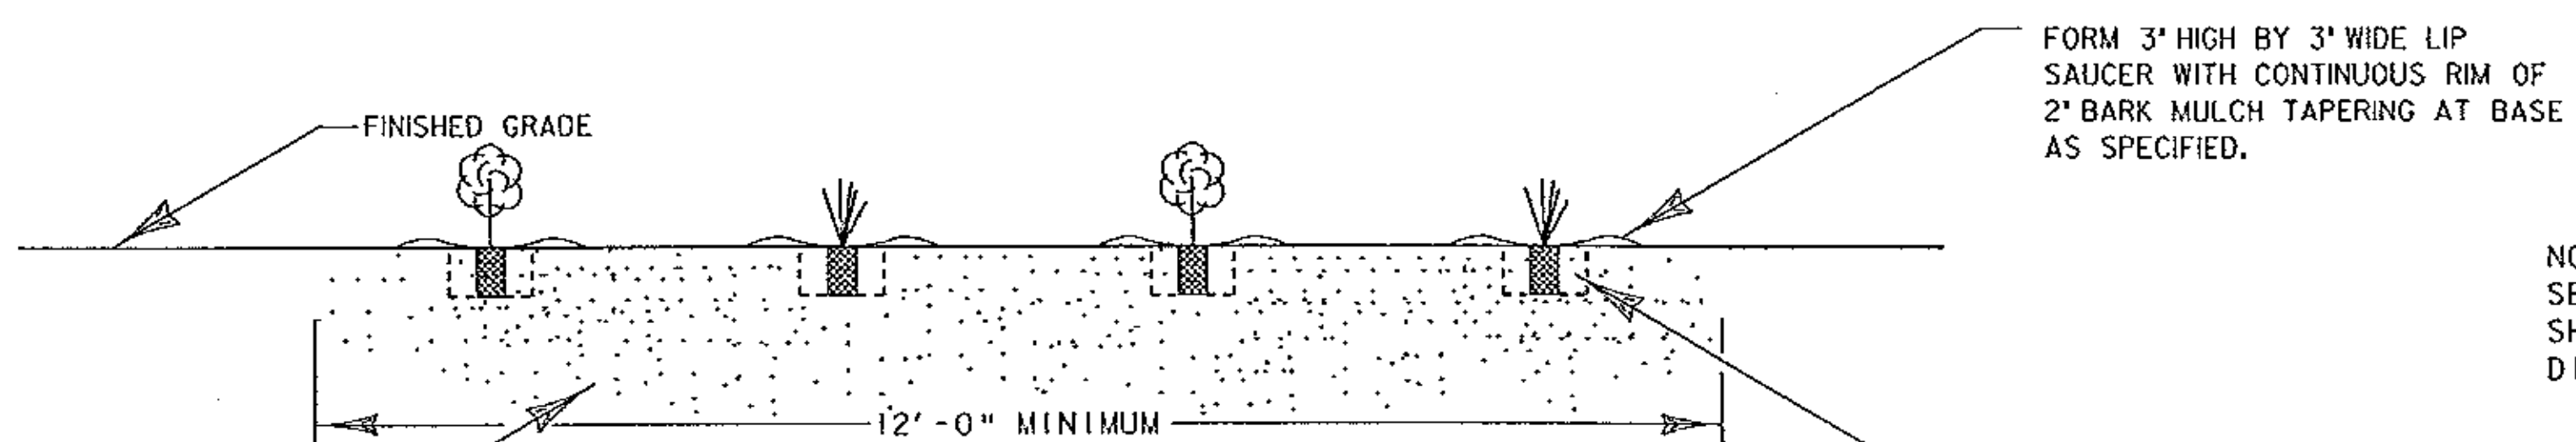

SHRUBS AND SEEDLING TREE GROUPINGS CROSS SECTION  
(FOR FLAT GROUND)

FORM 3" HIGH BY 3" WIDE LIP  
SAUCER WITH CONTINUOUS RIM OF  
2" BARK MULCH TAPERING AT BASE  
AS SPECIFIED.

NOTE:  
SEE SHRUB AND SEEDLING TREE PLANTING DETAIL.  
SHRUBS SHALL BE MULCHED ON FLAT GROUND ONLY OR AT  
DISCRETION OF ENGINEER.

BACK FILL MIX CONSISTS OF 1/2  
TOPSOIL, 1/4 COMPOST, AND 1/4  
NATIVE MATERIAL AS APPROVED BY  
THE ENGINEER.

TAMP TO REMOVE AIR POCKETS AND  
WATER THOROUGHLY AT TIME OF  
PLANTING.

LANDSCAPE GROUP AND SHRUB CROSS-SECTION

PROJECT NAME:	WOODFORD	PLOT DATE:	03-OCT-2005
PROJECT NUMBER:	BHF 010-1(29)	DRAWN BY:	L GOLDSTEIN
FILE NAME:	84e039/structures/84e039erobdr.dgn	DESIGNED BY:	J BROWN
PROJECT LEADER:	M EVANS-MONGEON	CHECKED BY:	
IPARM:	epsclspdet3.l	SHEET	39 OF 106

NOT TO SCALE