


RAIL PLACEMENT  
(WINGWALL # 3)

SCALE 3/4" = 1'-0"

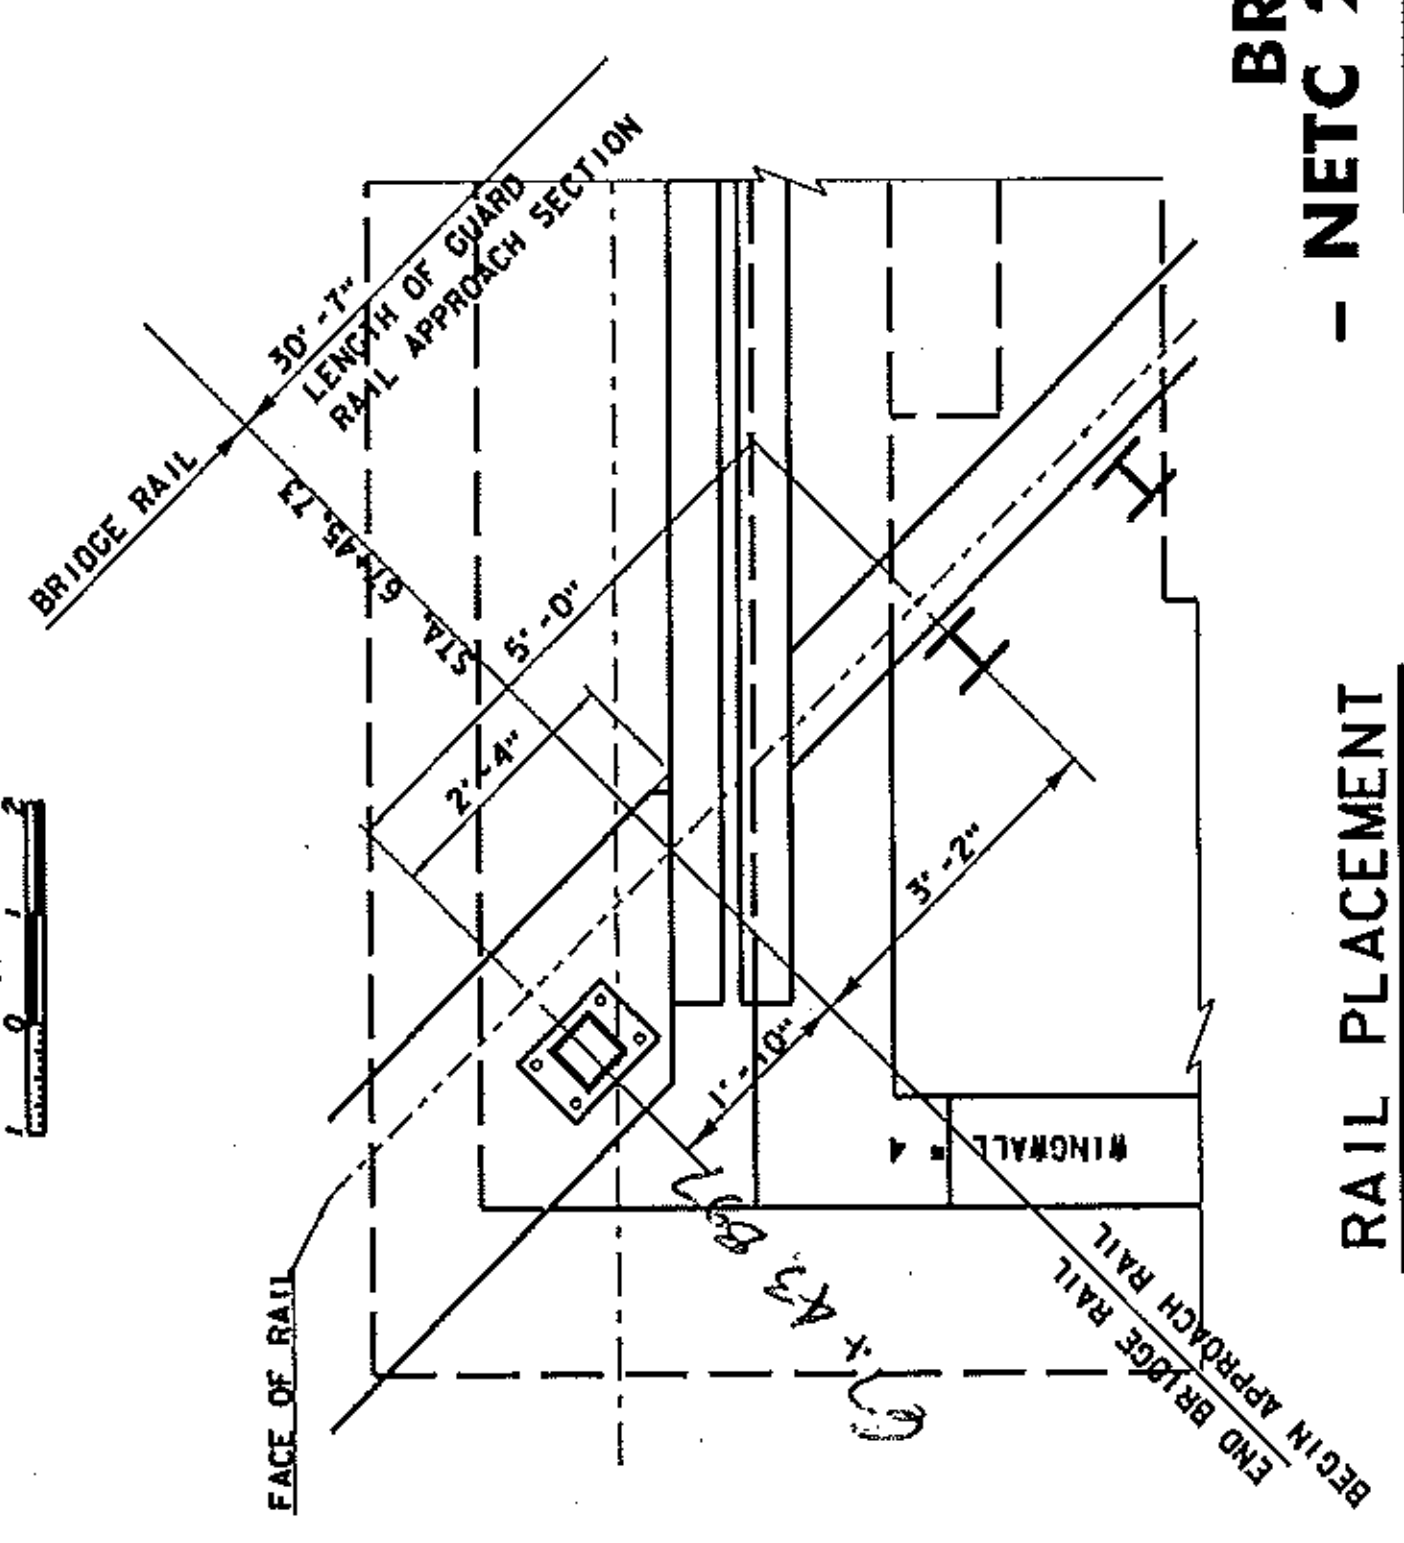


RAIL PLACEMENT  
(WINGWALL # 4)

SCALE 3/4" = 1'-0"




BRIDGE  
- NETC 2 R  
PROJECT NAME: W  
PROJECT NUMBER: B1  
FILE NAME: /B40037.w  
PROJECT LEADER: A. PI  
DESIGNED BY: MEY

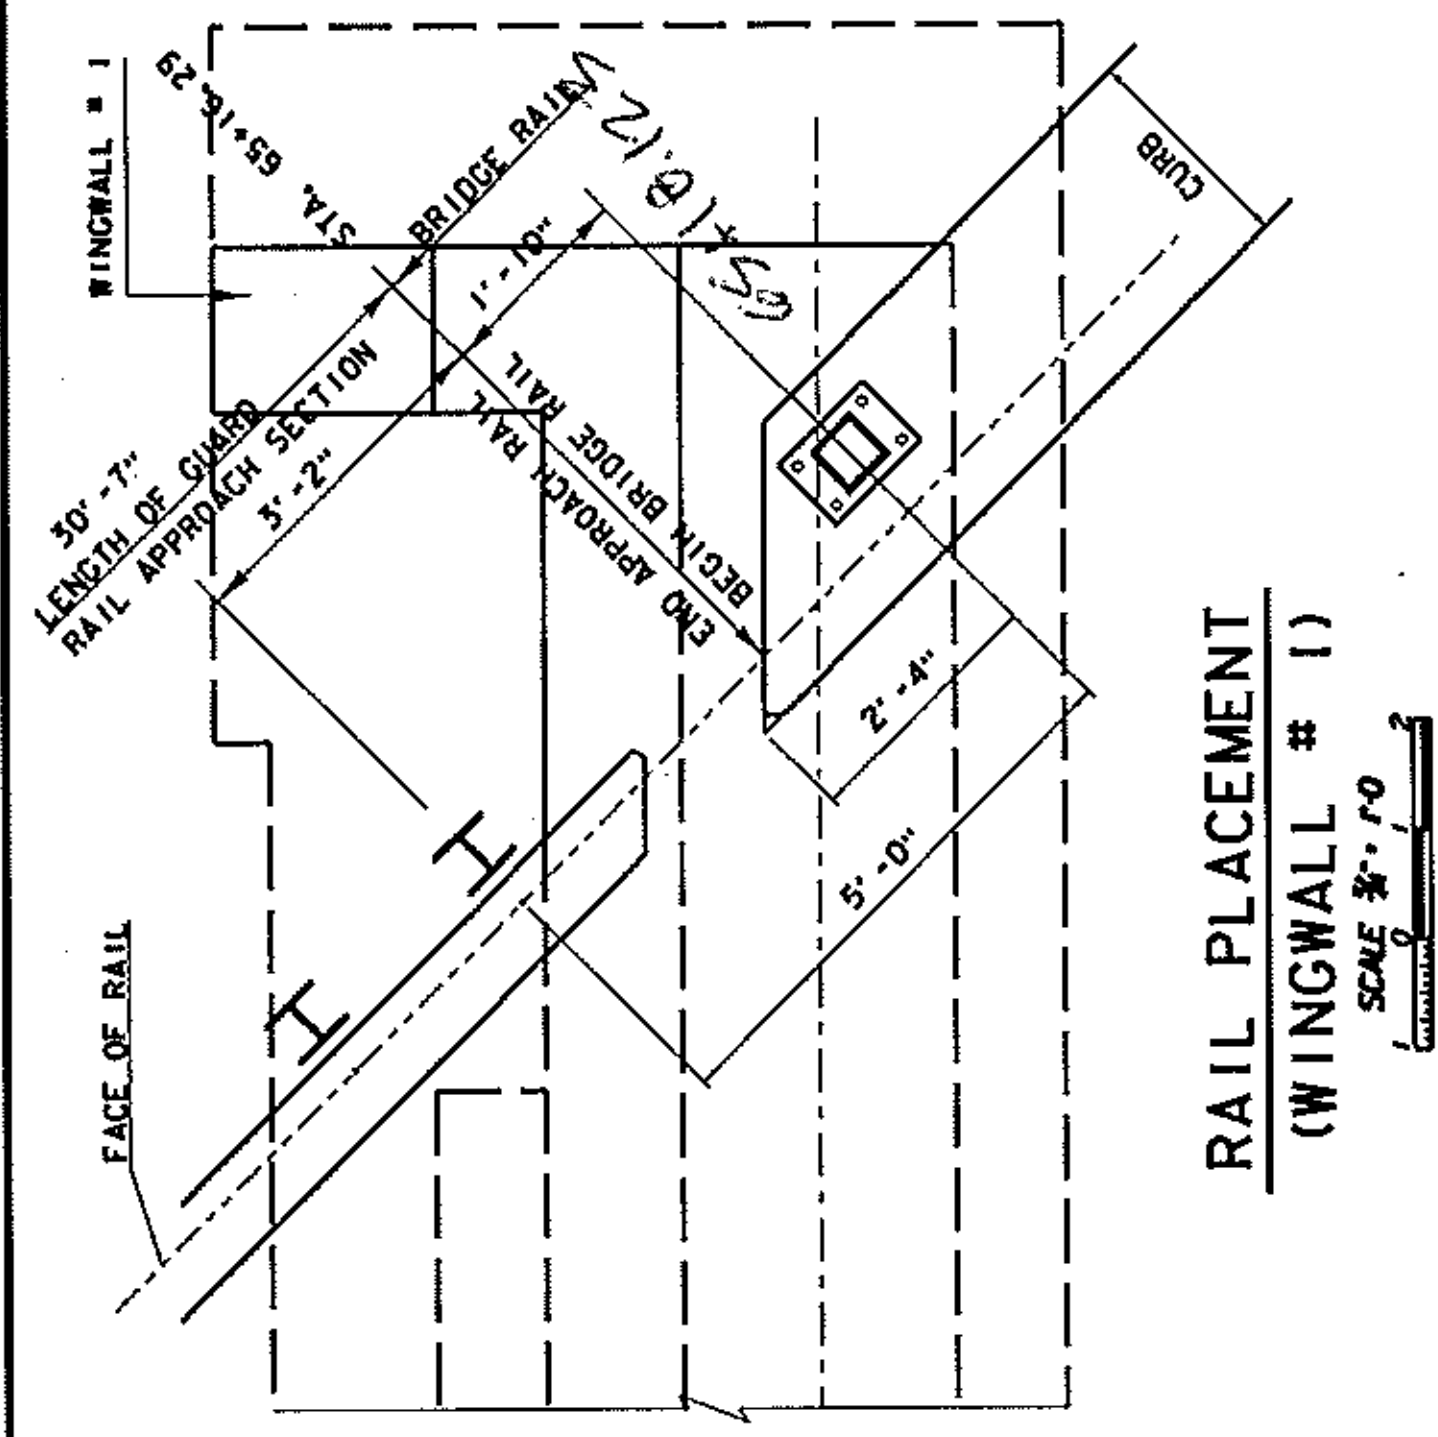

RAIL PLACEMENT  
(WINGWALL # 1)

SCALE 3/4" = 1'-0"

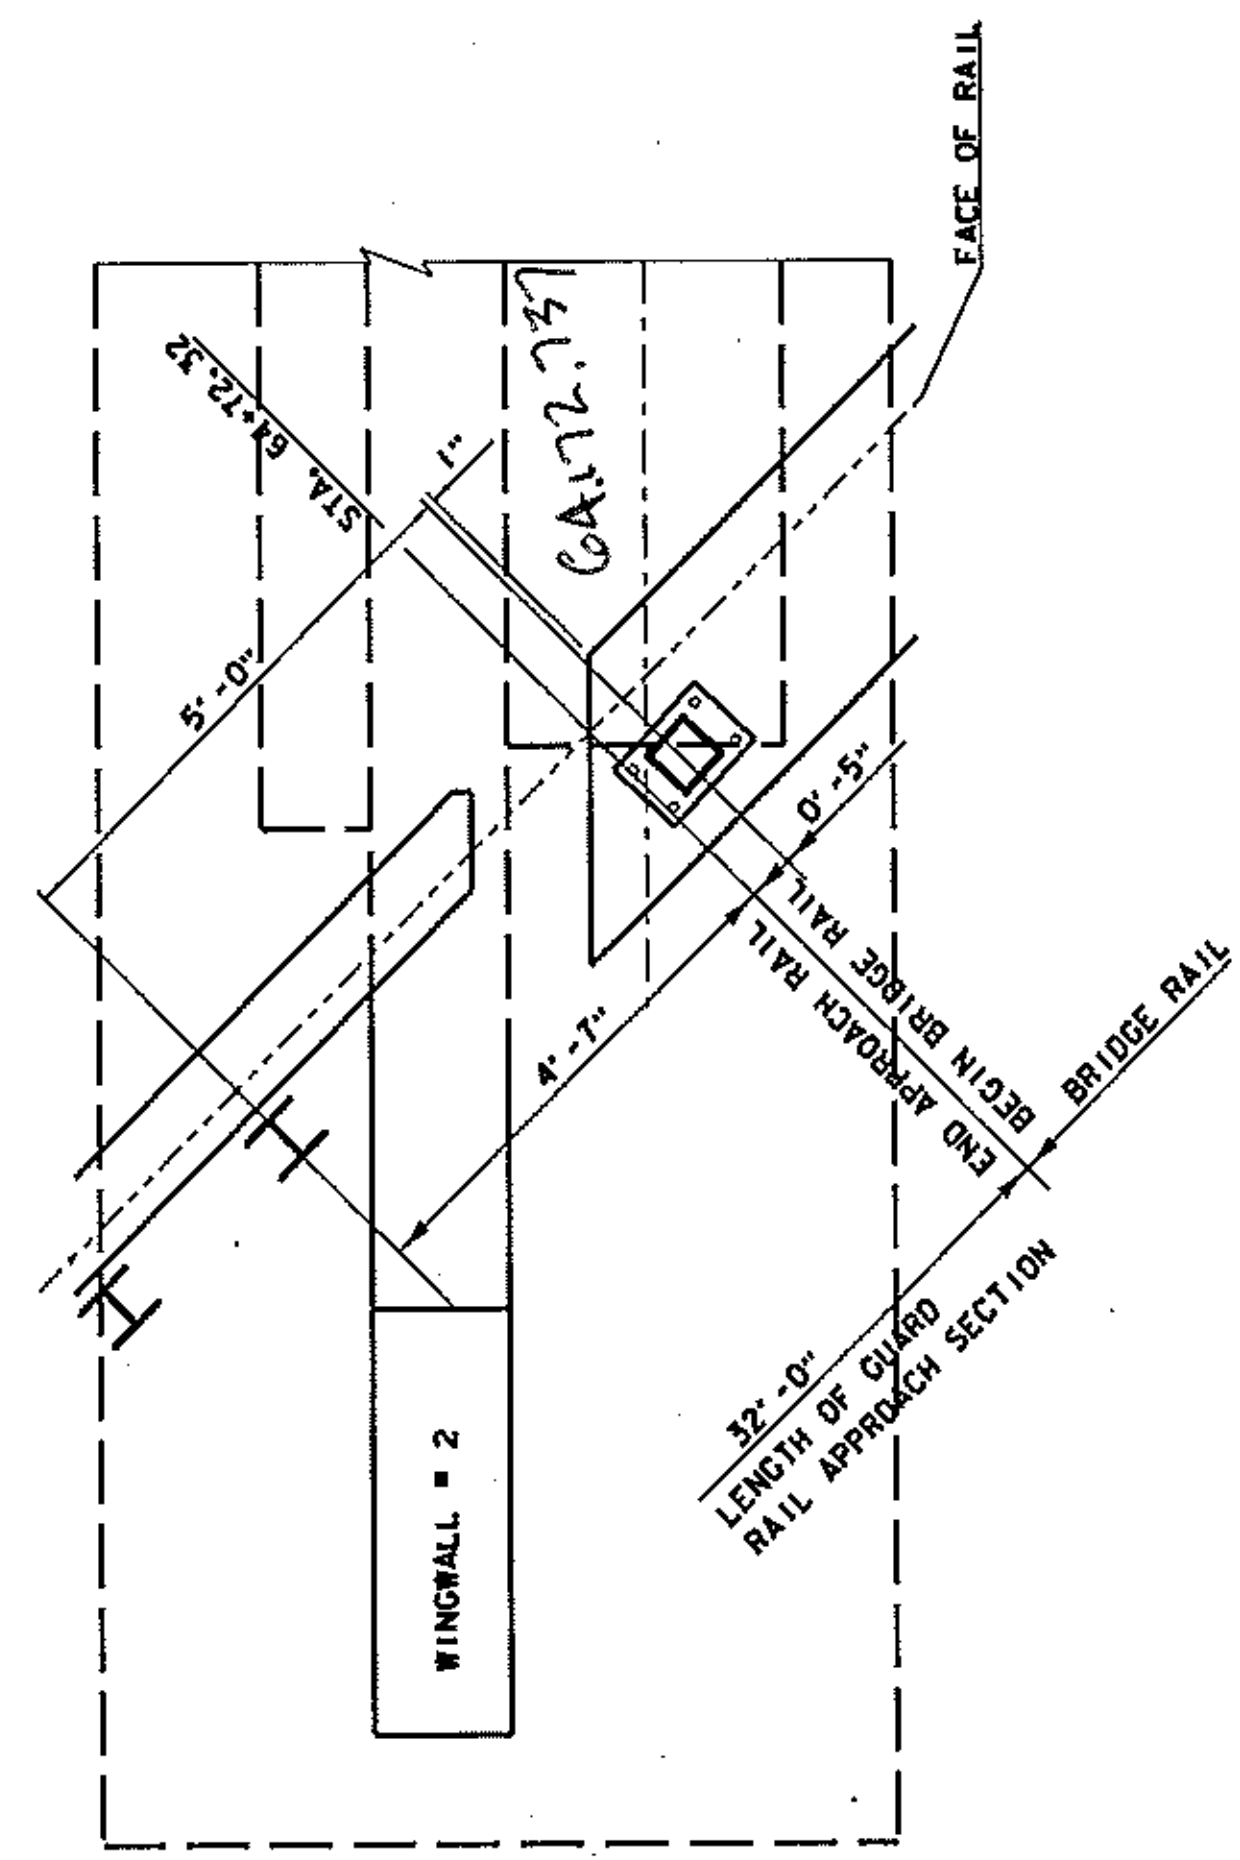

RAIL PLACEMENT  
(WINGWALL # 2)

SCALE 3/4" = 1'-0"



27.1.14

27.1.14

2006