
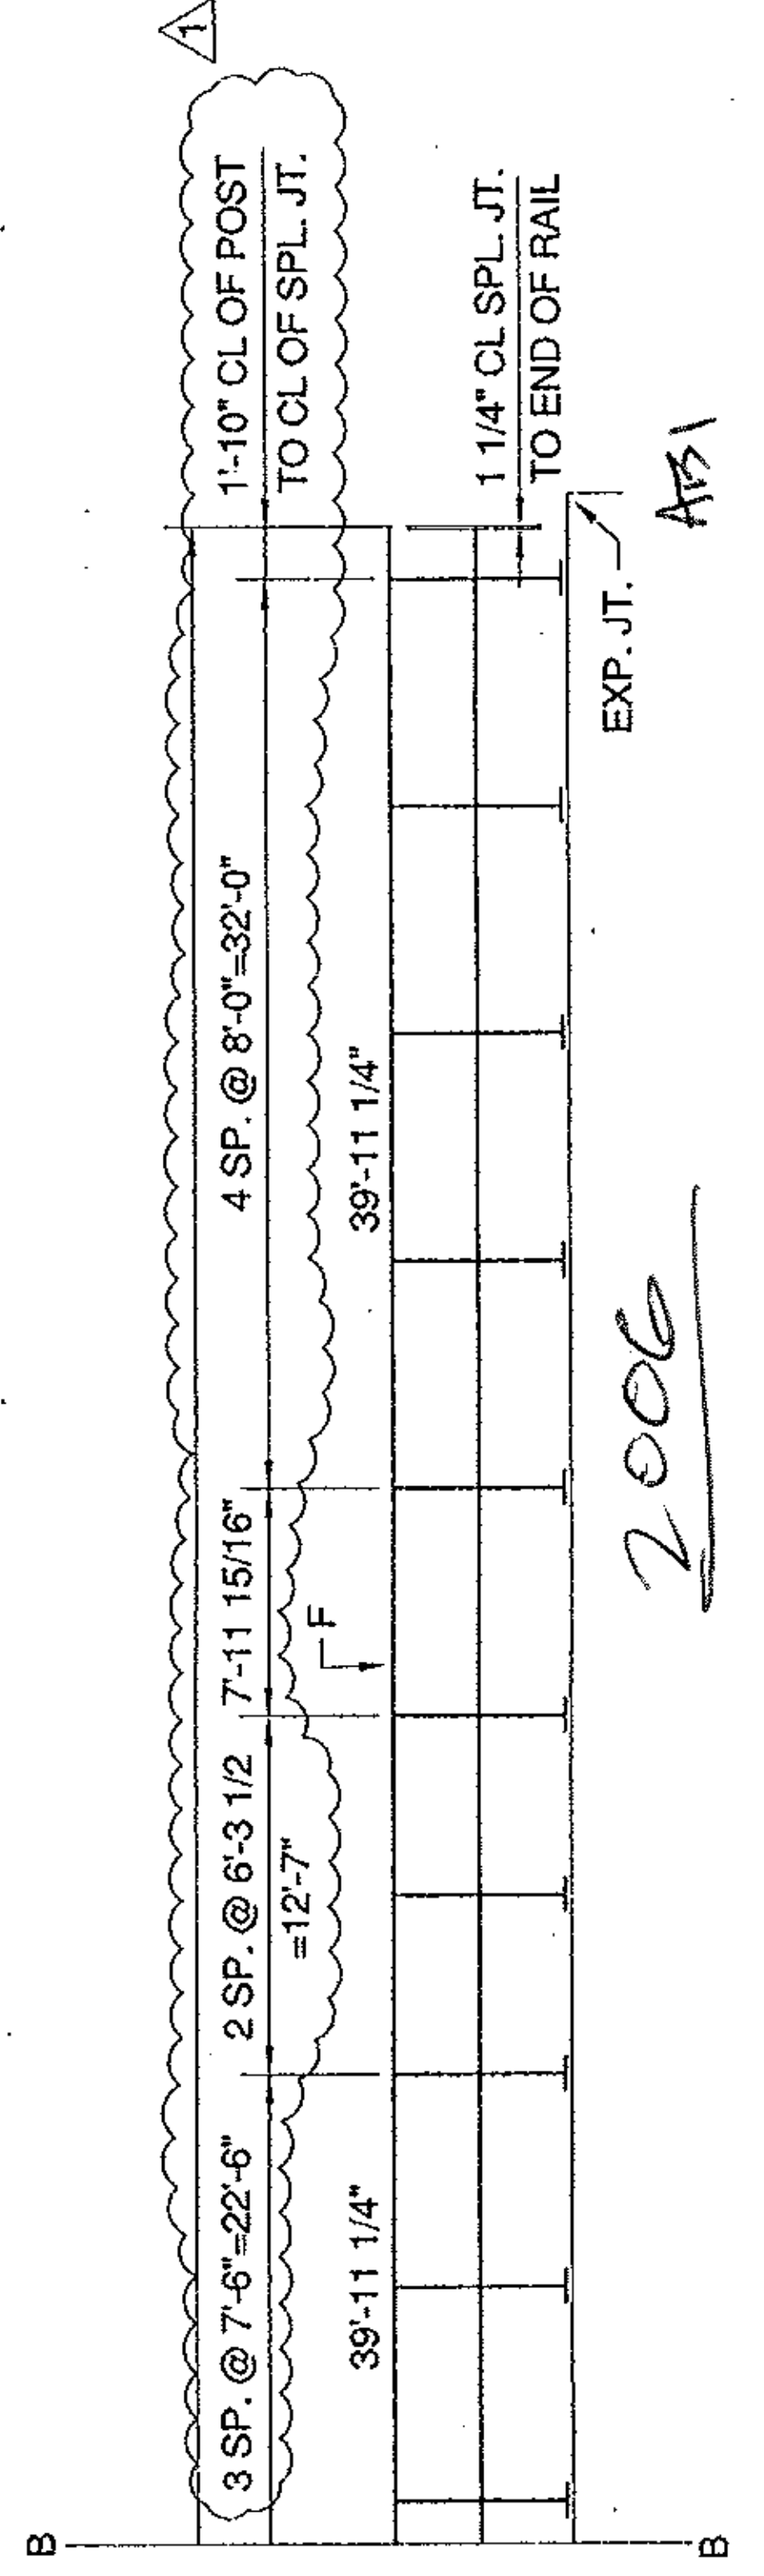


PAY LIMIT ITEM 525.33-274'-9 15/16"

**SOUTH LOOKING SOUTH ELEVATION VIEW
(2 RAIL POSTS W/ANCHORAGE)**

AS2

KEY
F=3/4" FXD. SPL. JT.
E=2 1/2" EXP. SPL. JT.

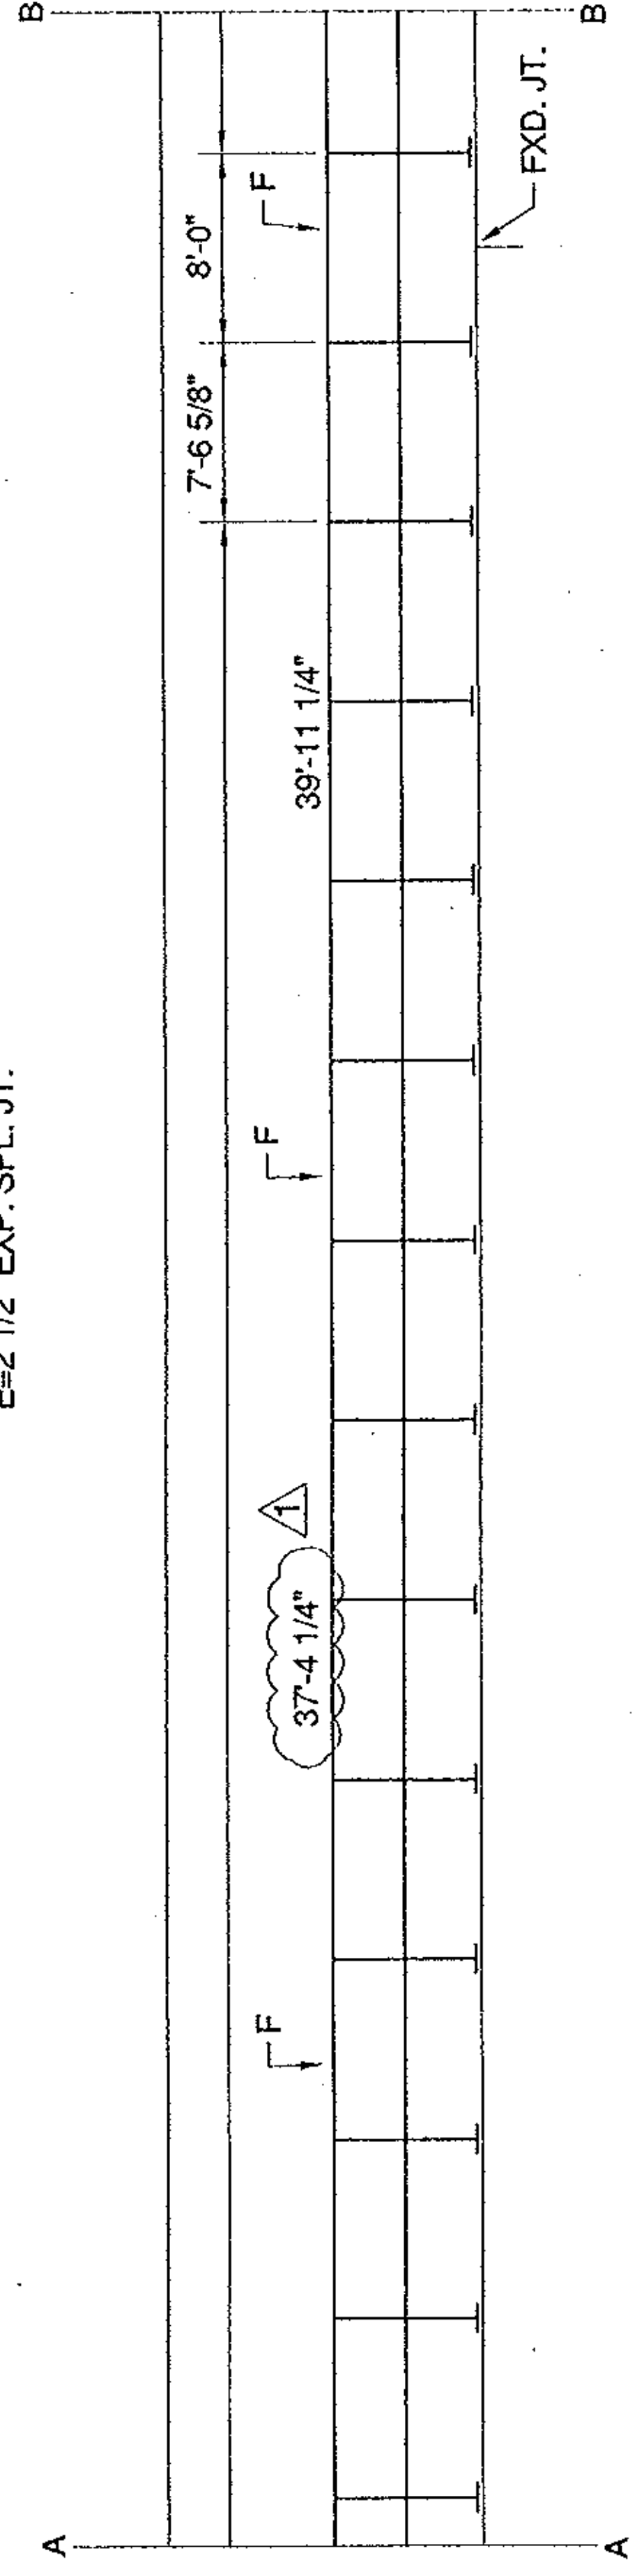

2006