
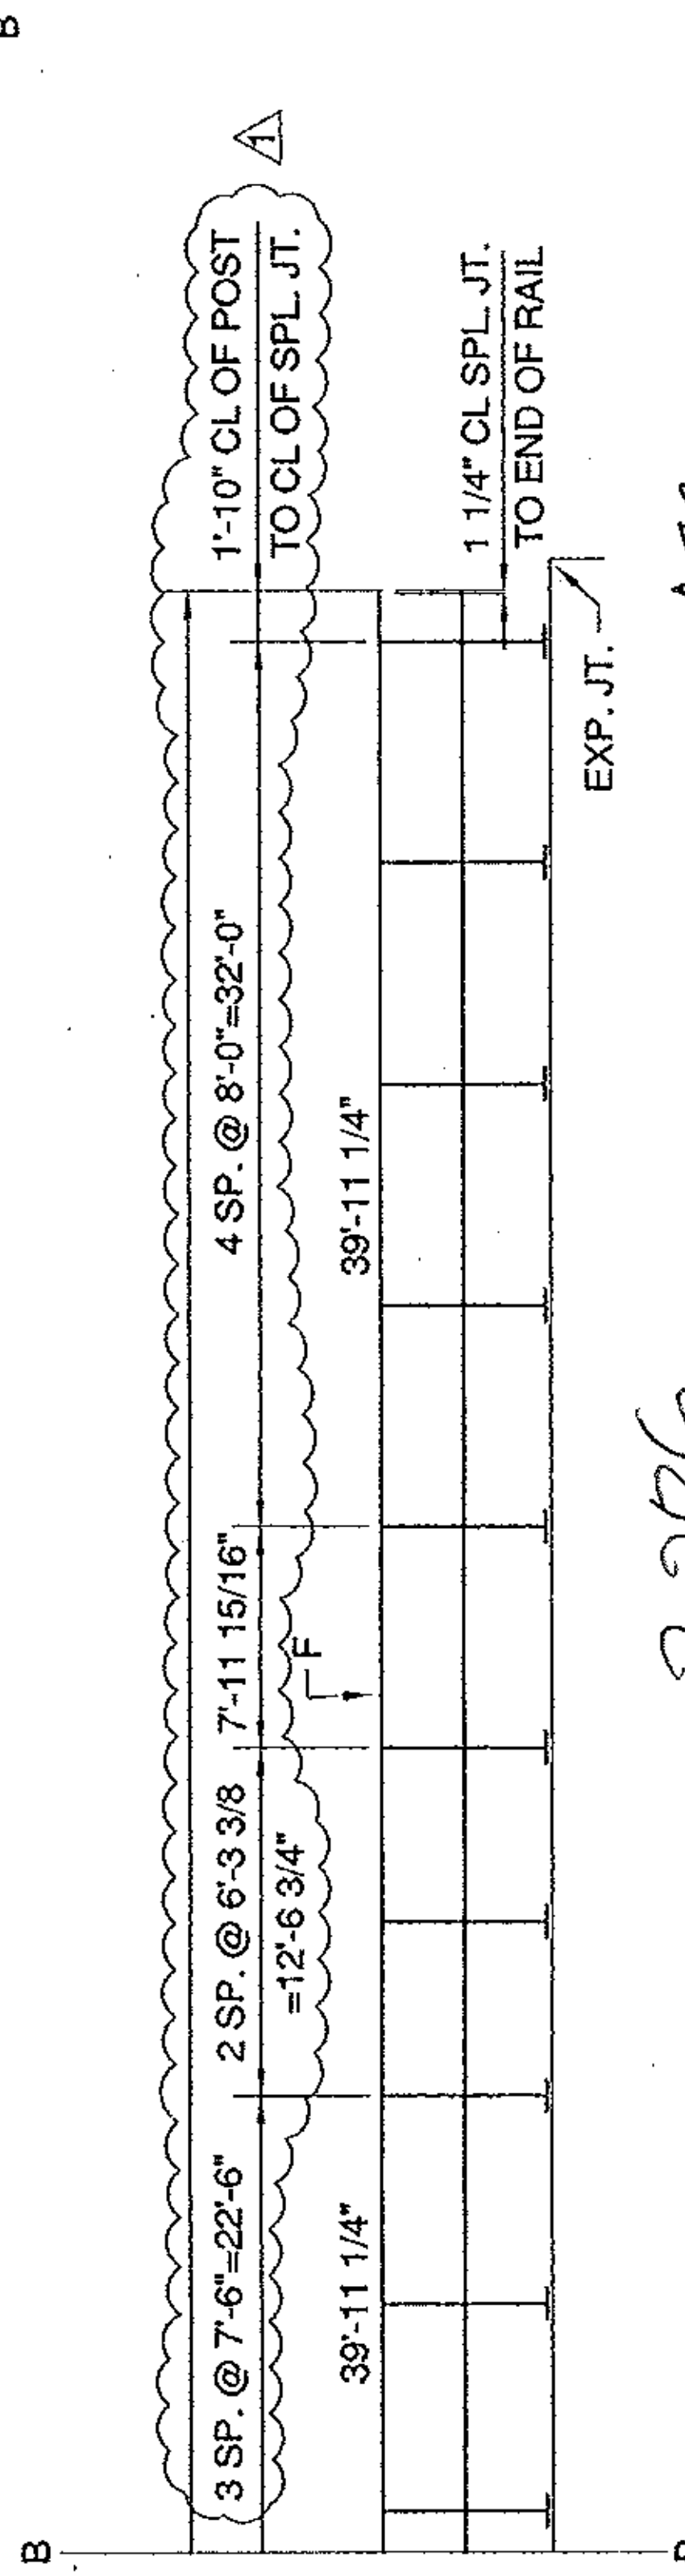


**NORTH LOOKING NORTH ELEVATION VIEW
(2 RAIL POSTS W/ANCHORAGE)**

AB1

KEY
 F=3/4" FXD. SPL. JT.
 E=2 1/2" EXP. SPL. JT.

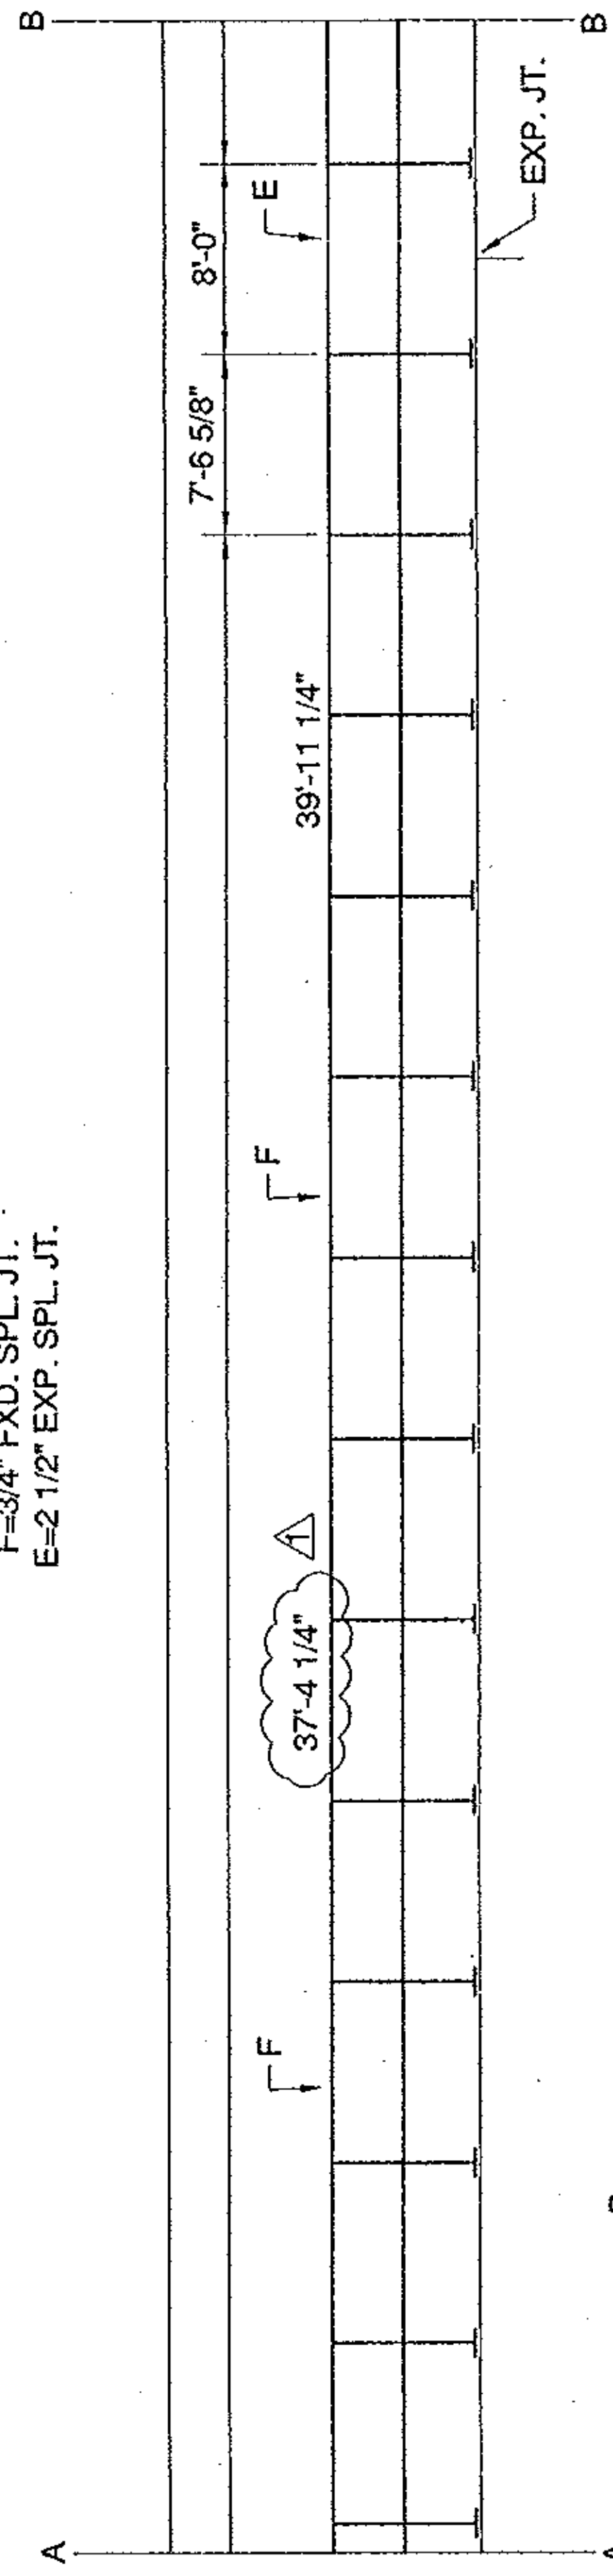

2006

AB2