


ONE WEB PLATE W103
W103 = PL 1/2"

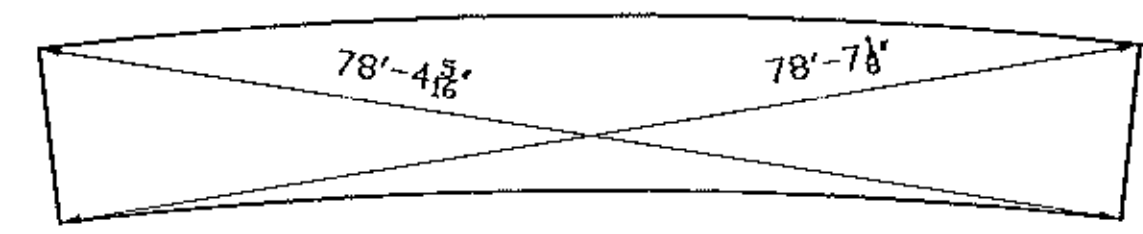

GENERAL NOTES: SEE GN100

No.	REVISION	DATE	PAR	VER.
1	FOR APPROVAL	07/06/12	BR	EG

NOTE: BOLT 1 WASHER: 1 WASHER UNDER NUT U.N.
BOLT 2 WASHER: 1 WASHER UNDER HEAD U.N.



PROJECT: VT RT 9, BRIDGE NO. 11
TOWN OF WOODFORD, VT
OVER WALDOMSAC RIVER

TITLE: GIRDER 103G1

REFERENCE: PROJECT NO. ER BHF 010-1 (44)

REVISED BY	DATE	REVISION NO.	DESCRIPTION
BR	JULY 2012		
GG	JULY 2012		

Vermont Agency of Transportation
RECEIVED
CK'D BY M.E.M. OK'D BY C.W.M.
July 09, 2012
RESUBMIT APPROVED ✓
BY C. CARLSON DATE 07-27-2012