


ONE WEB PLATE W105
W105 = PL 1/2"

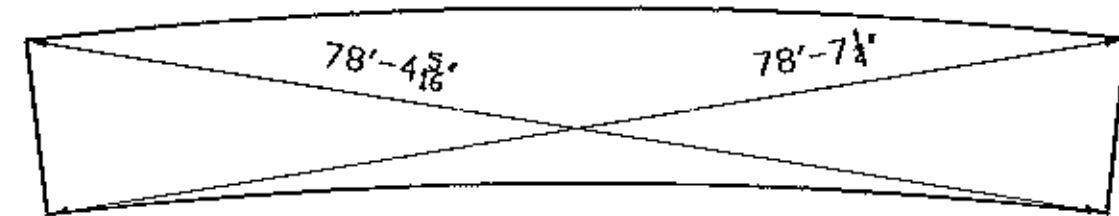

GENERAL NOTES: SEE GN100

No.	REVISION	DATE	PAR	VER.
A	FOR APPROVAL	07/06/12	BR	EG

NOTE: BOLT 1 WASHER: 1 WASHER UNDER NUT U.N.
BOLT 2 WASHER: 1 WASHER UNDER HEAD U.N.
1 WASHER UNDER HEAD U.N.

STRUCTAL
Bridges
386 River Road, Claremont,
NH, 03743
Tel: (603) 542-5202 Fax: (603) 542-5312
A Division of **CANAM**
1207 INC.

PROJECT: VT RT 9, BRIDGE NO. 11
TOWN OF WOODFORD, VT
OVER WALDOOMSAC RIVER

TITLE: GIRDER 105G1

REFERENCE: PROJECT NO. ER BHF 010-1 (44)

REV. NO.	DATE	BY	APP'D.	CONTRACT NO.
BR	JULY 2012			UN04260
GG	JULY 2012			105-1/A

Vermont Agency of Transportation
RECEIVED
CK'D BY M.E.M. OK'D BY C.W.M.
July 09, 2012
RESUBMIT APPROVED ✓
BY C. CARLSON DATE 07-27-2012