




BEGIN APPROACH
31+75

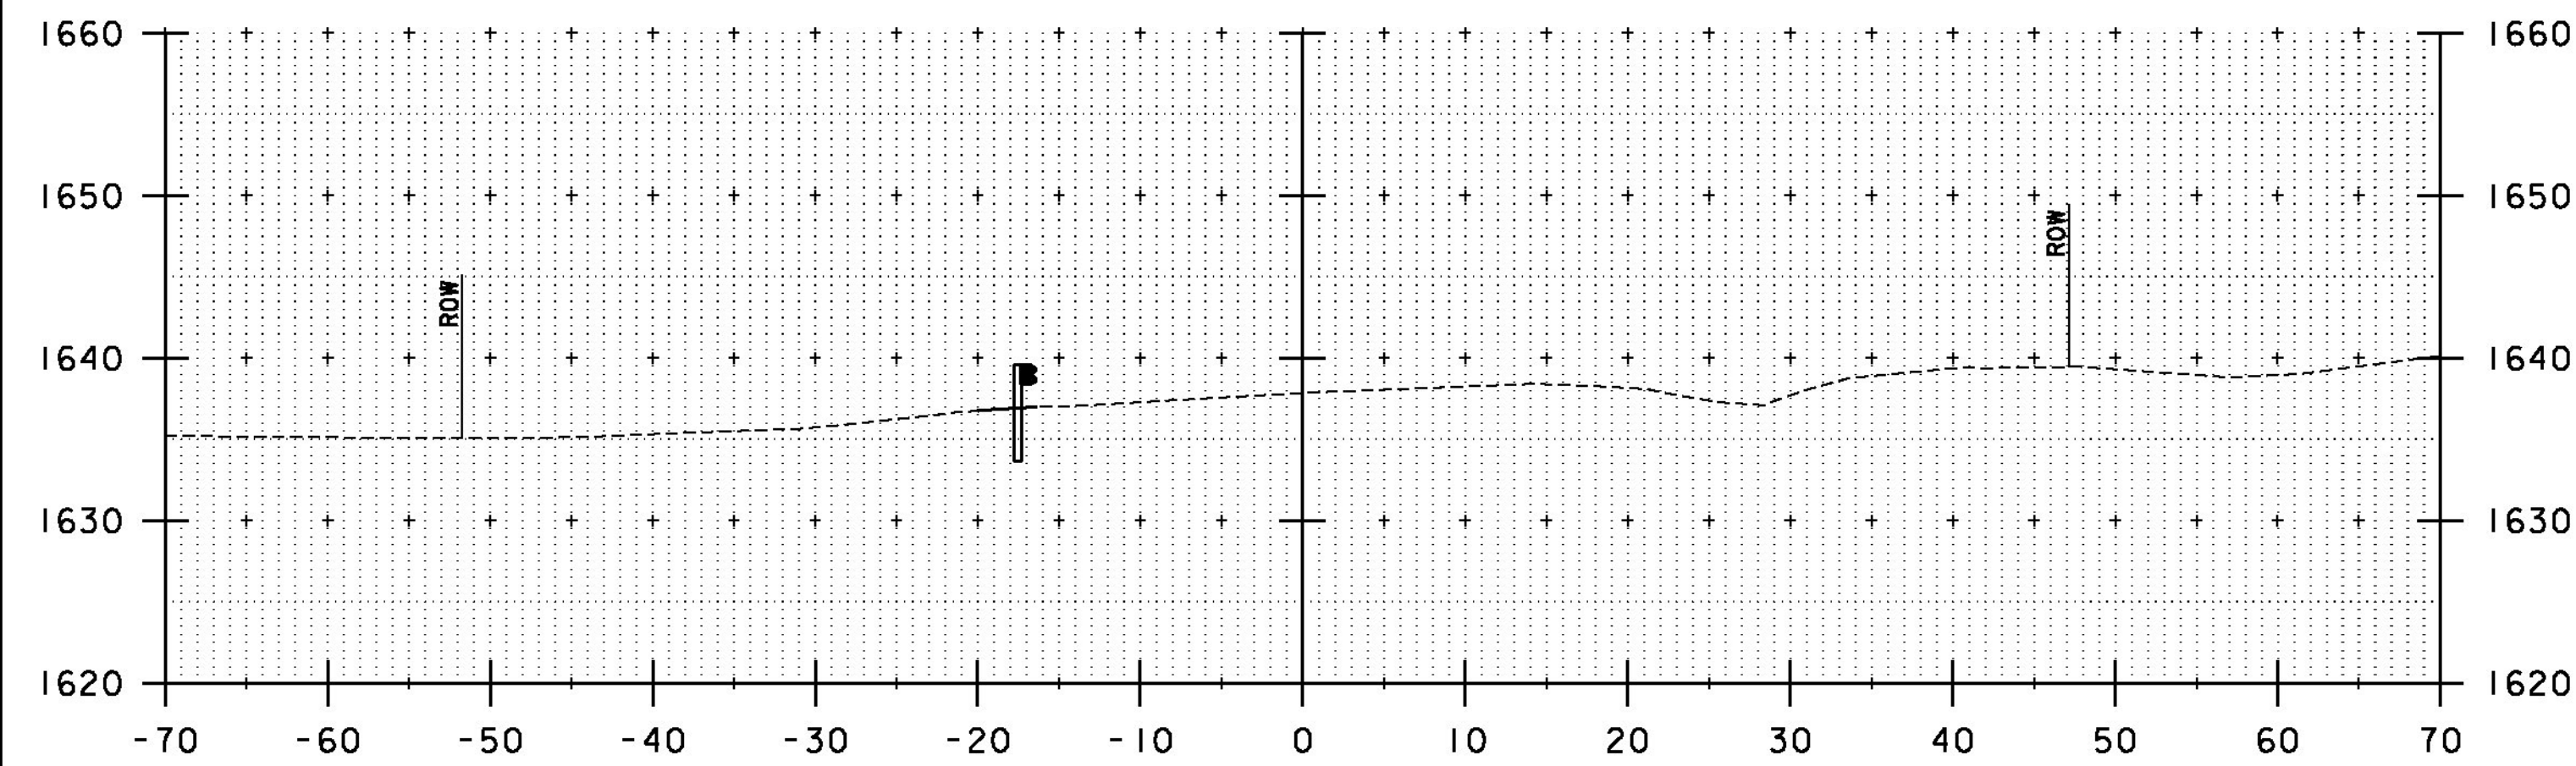

31+50

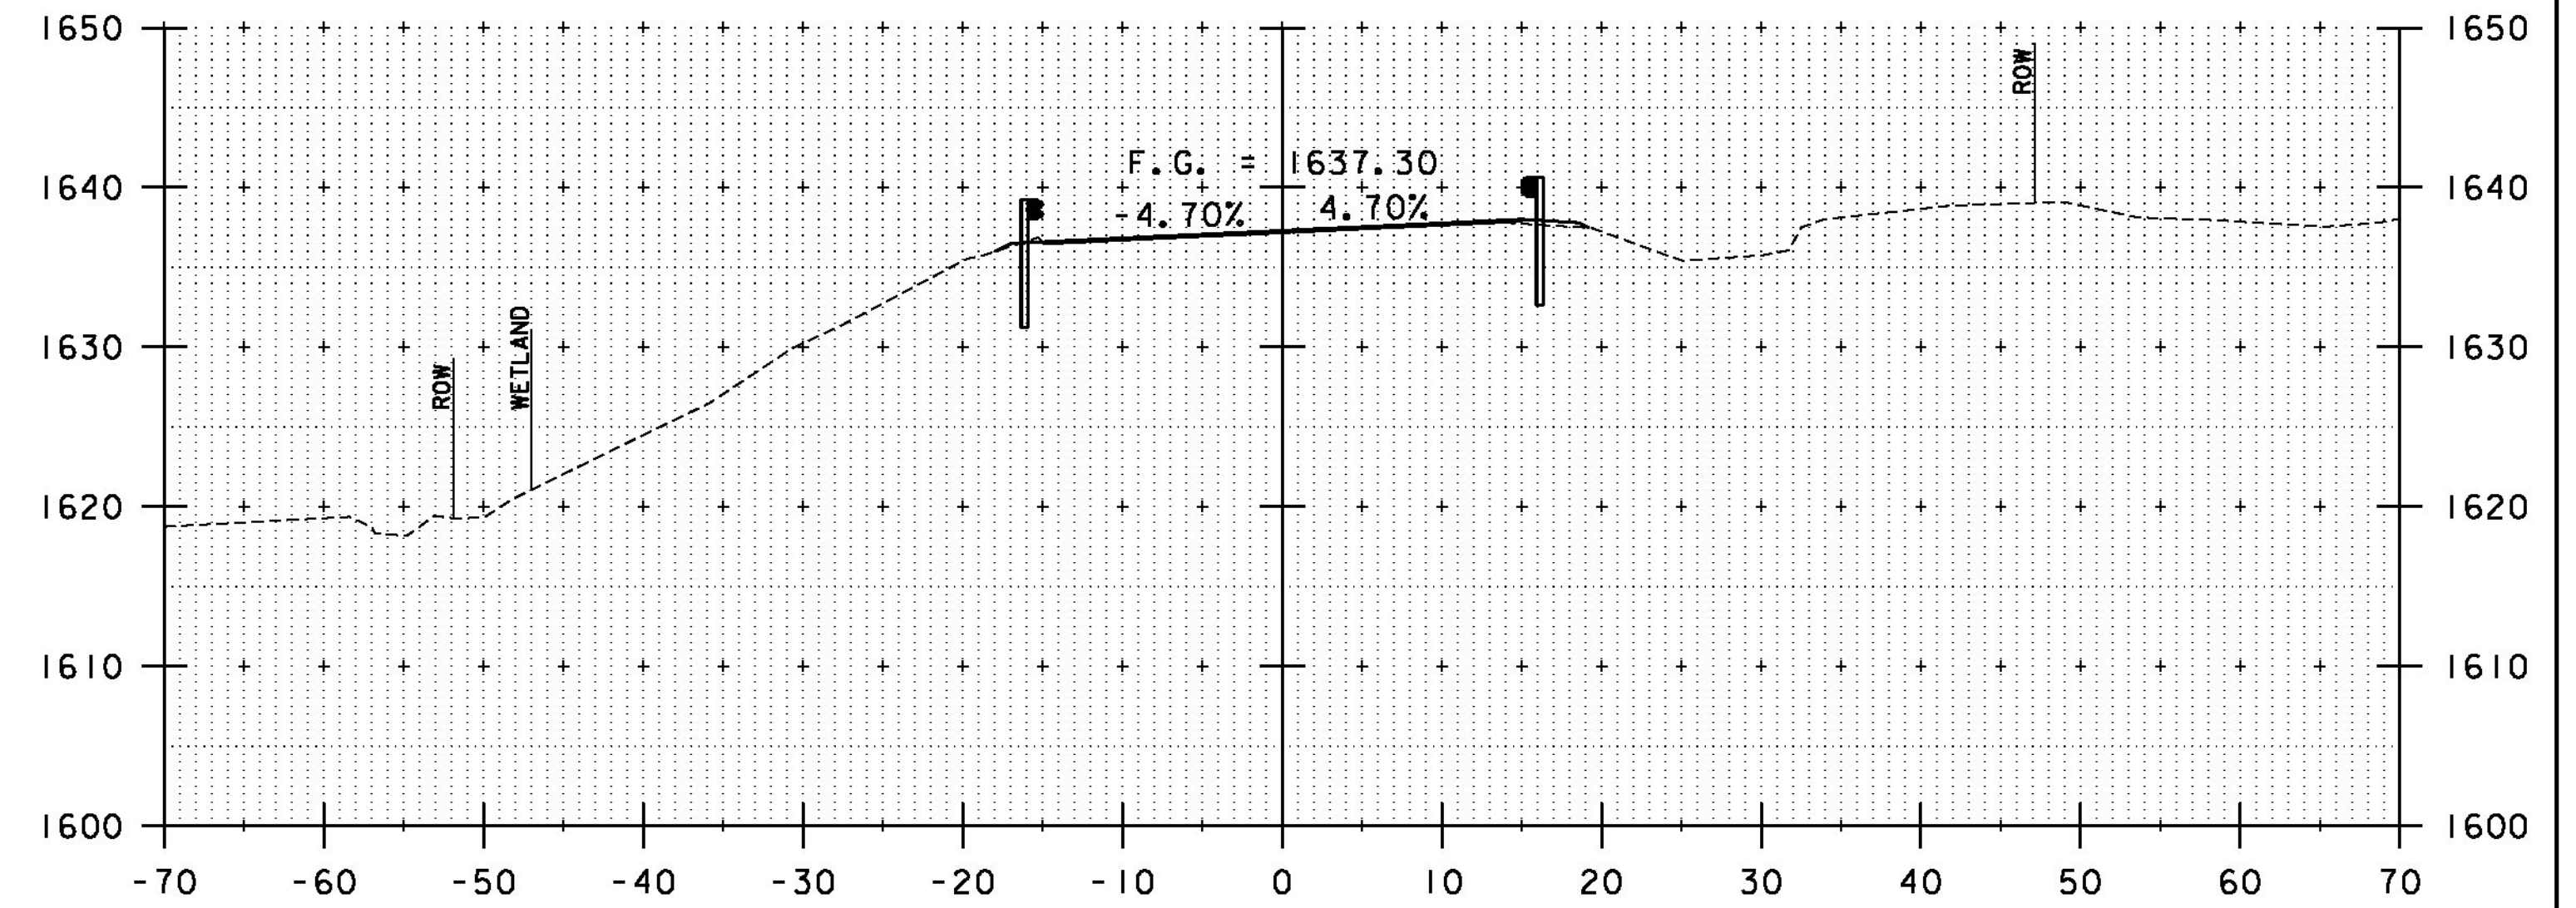

32+25

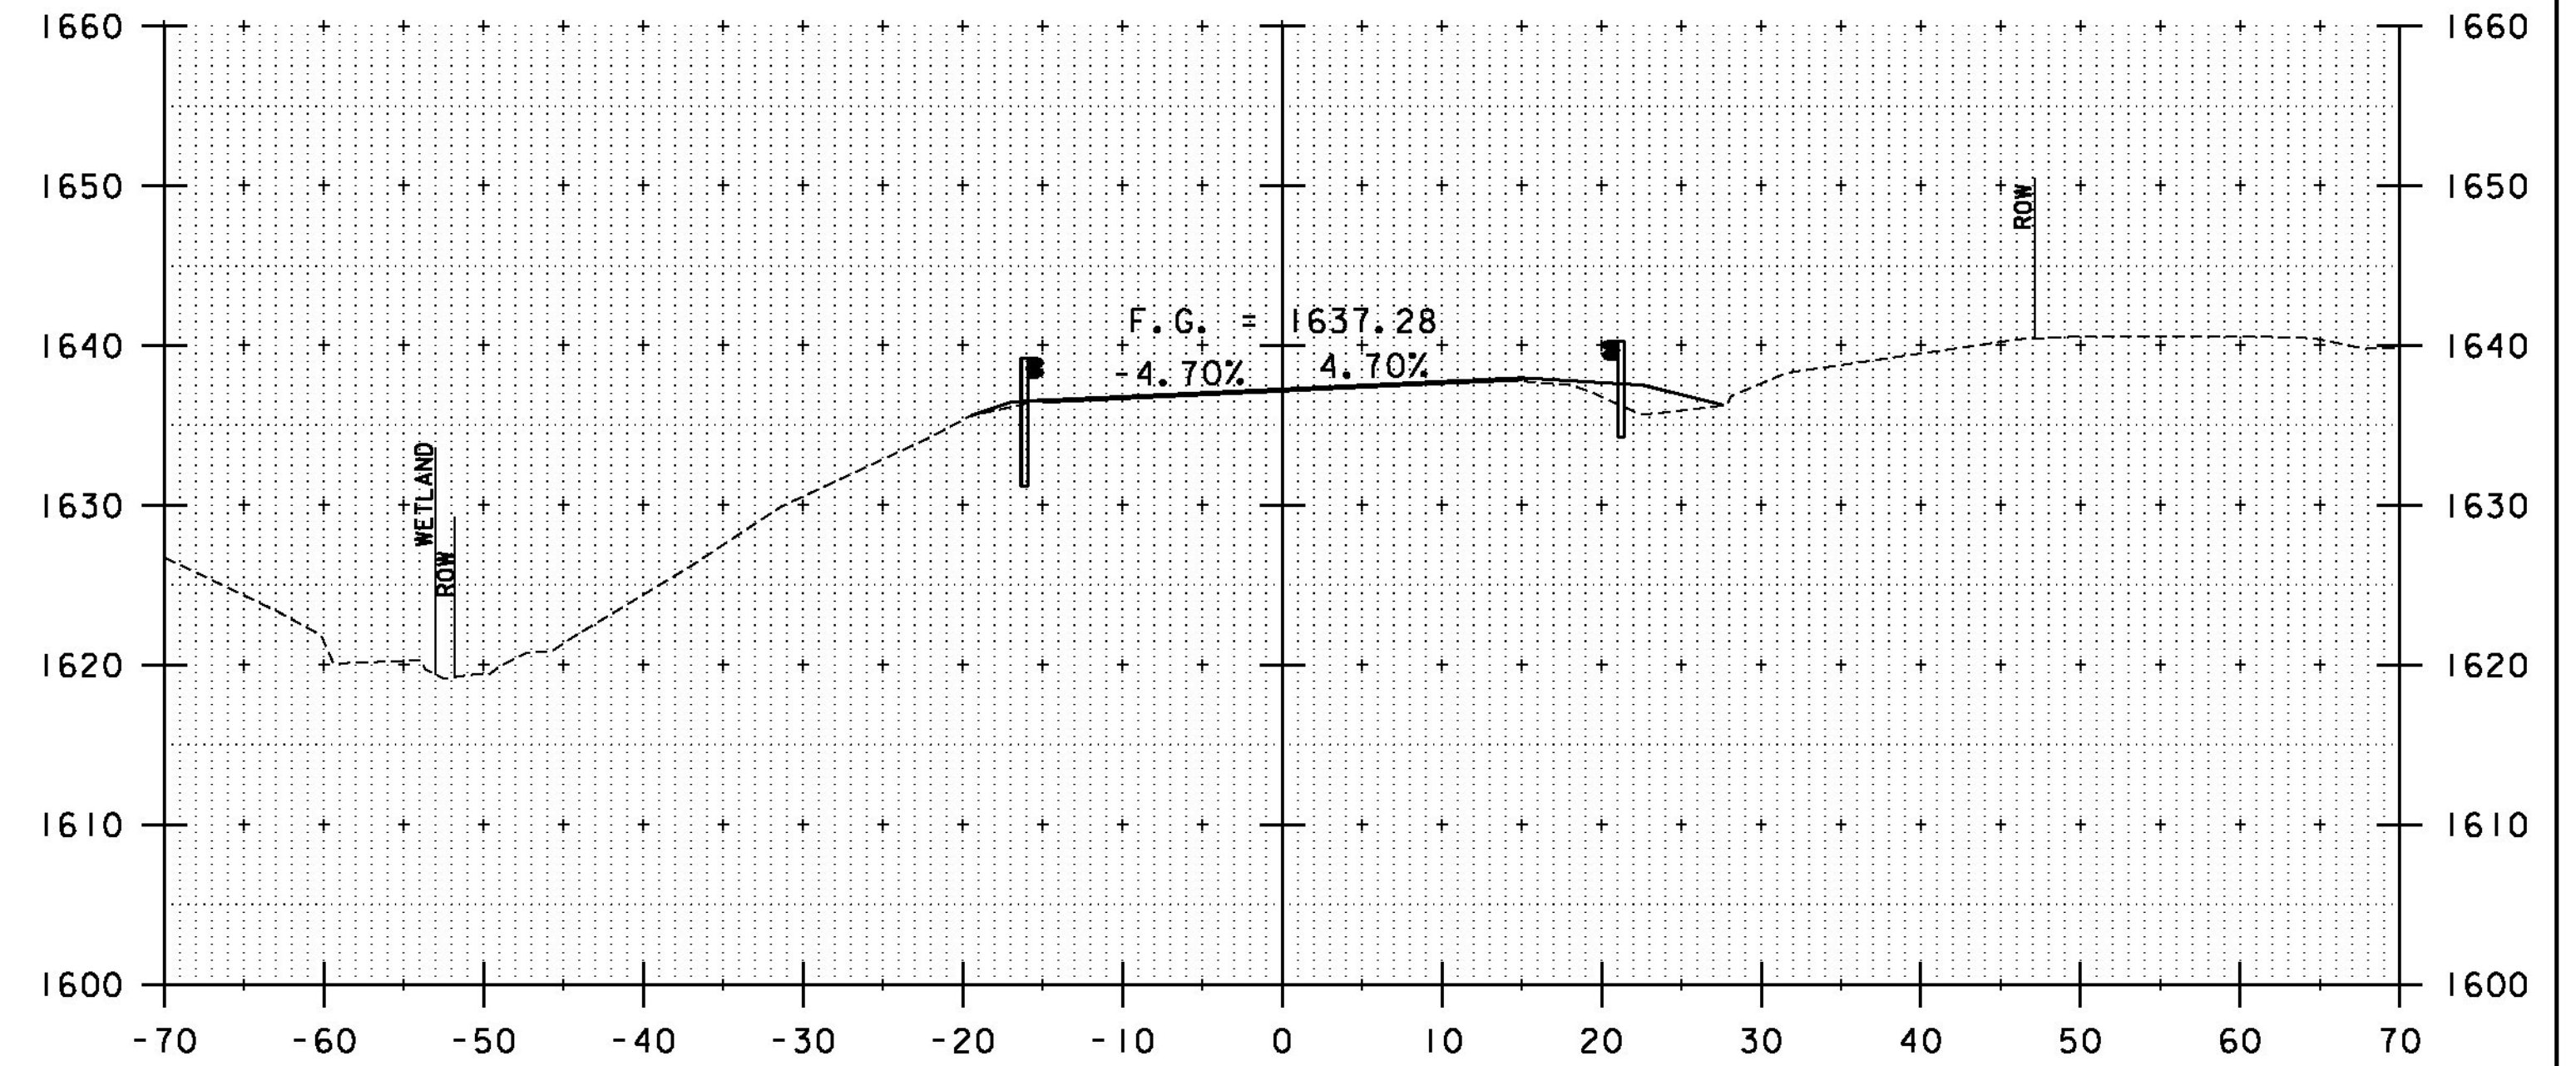

32+00

STA. 31+50 TO STA. 32+25

PROJECT NAME: WINHALL
PROJECT NUMBER: STP CULV(3I)

FILE NAME: z1lb268xs_br47.dgn
PROJECT LEADER: M. CHENETTE
DESIGNED BY: J. HUNGERFORD
ROADWAY CROSS SECTIONS - RXSI - BR47

PLOT DATE: 9/25/2014
DRAWN BY: L. BUXTON
CHECKED BY: M. CHENETTE
SHEET 22 OF 60

