




33+75

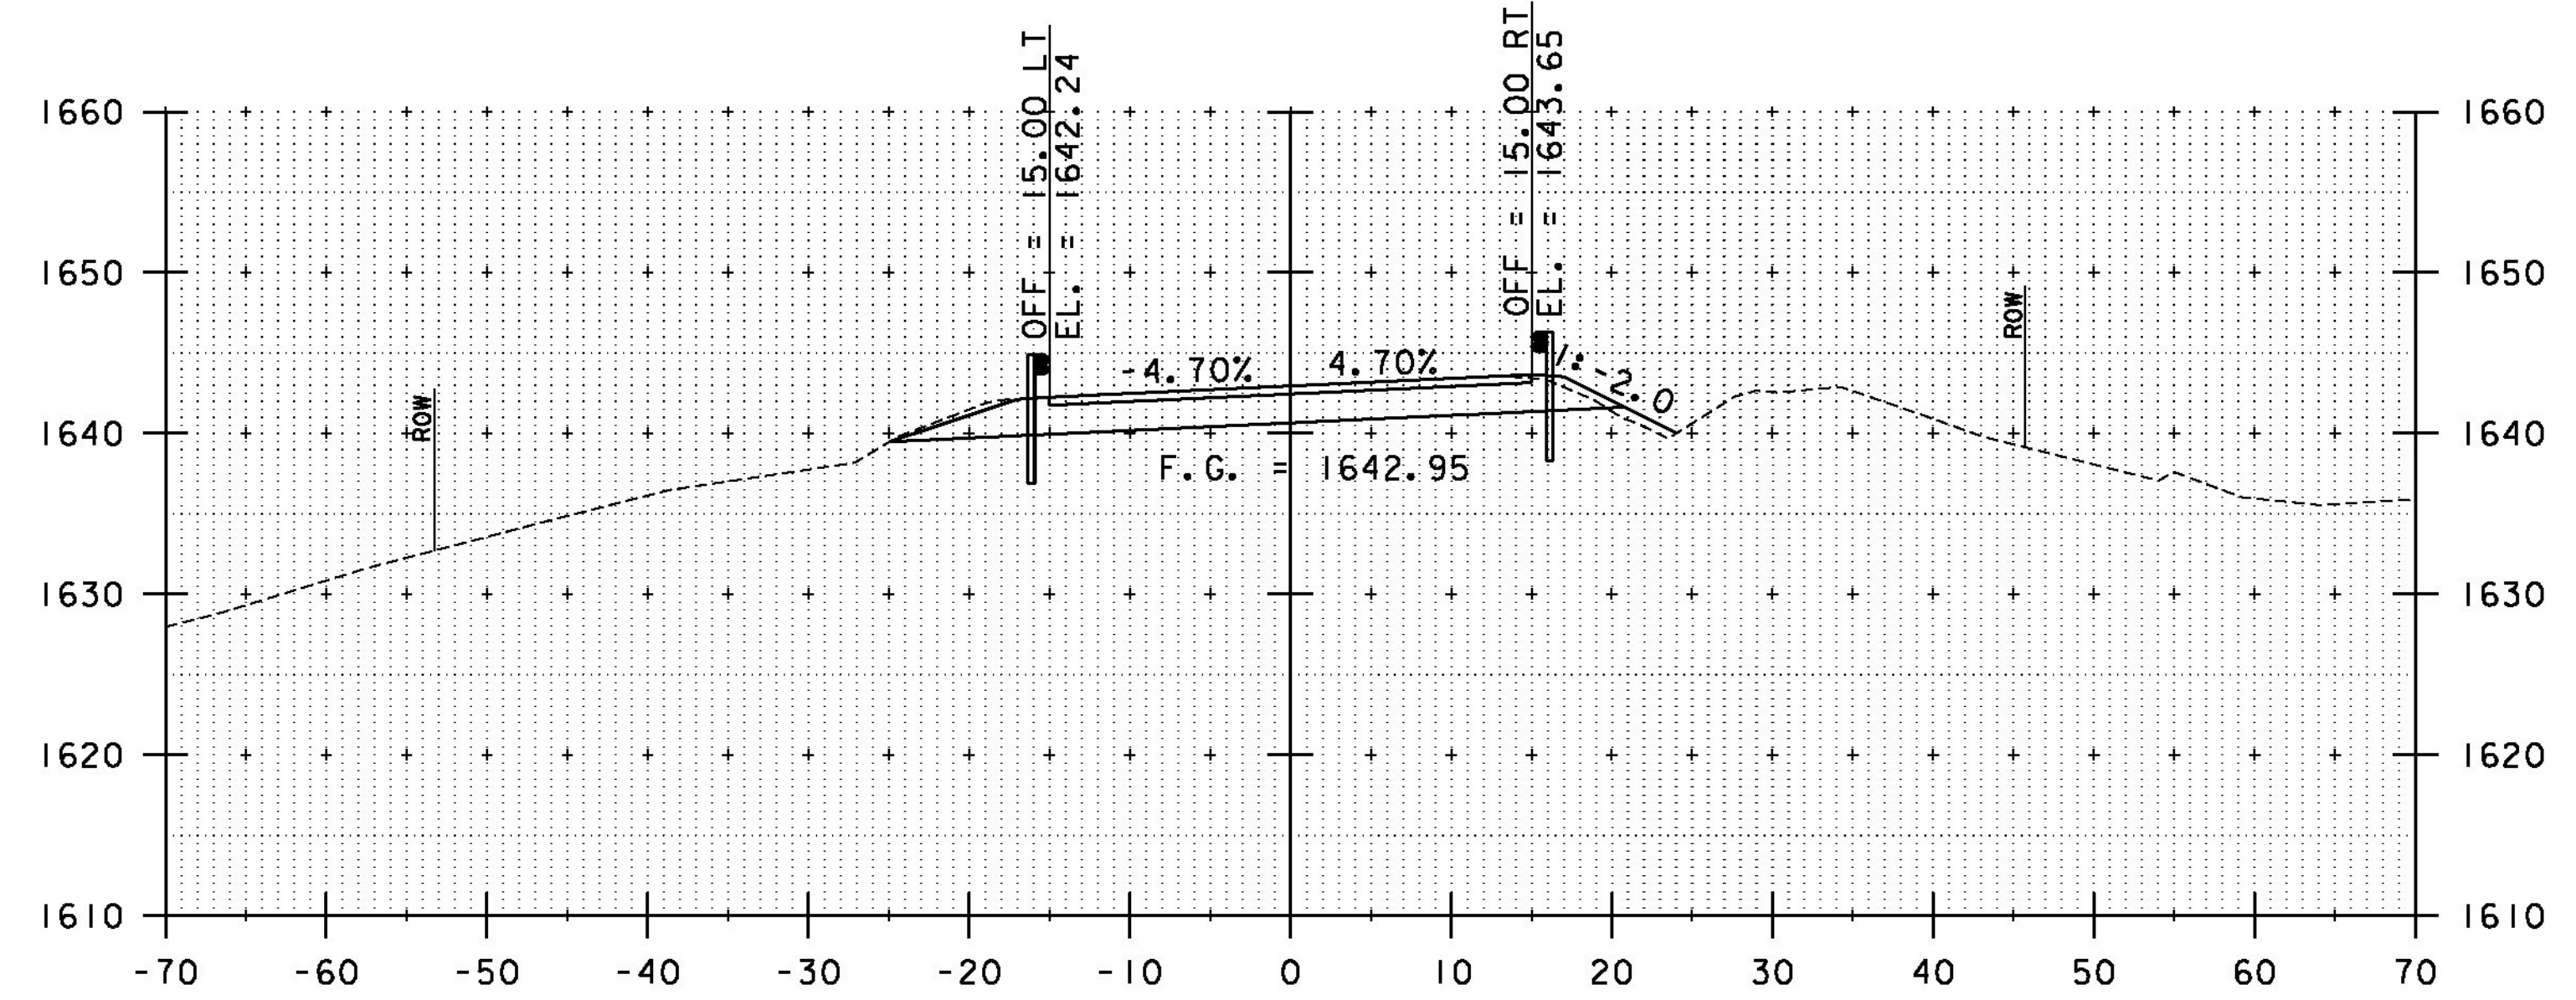

34+25

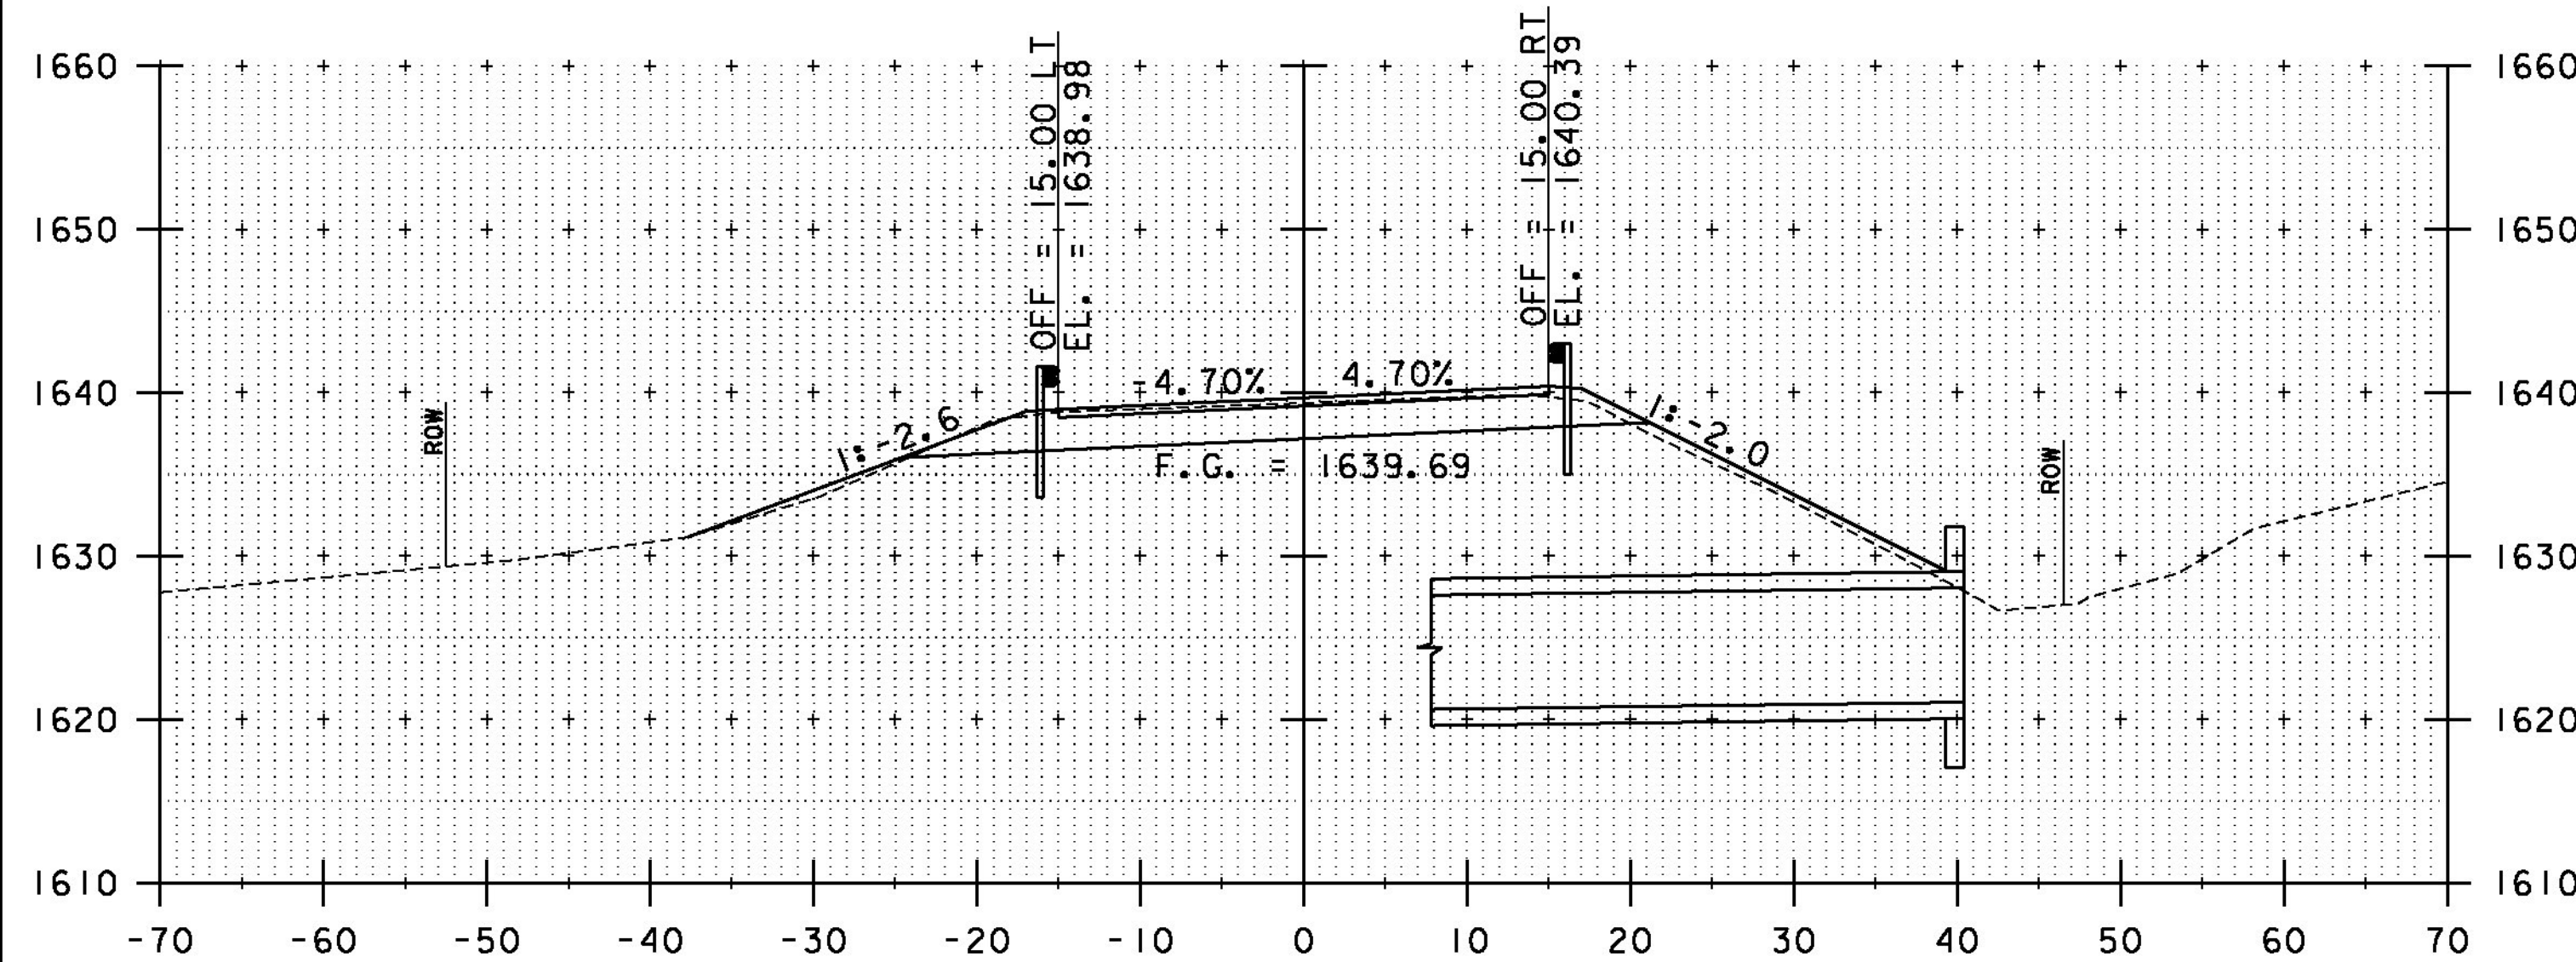

33+50

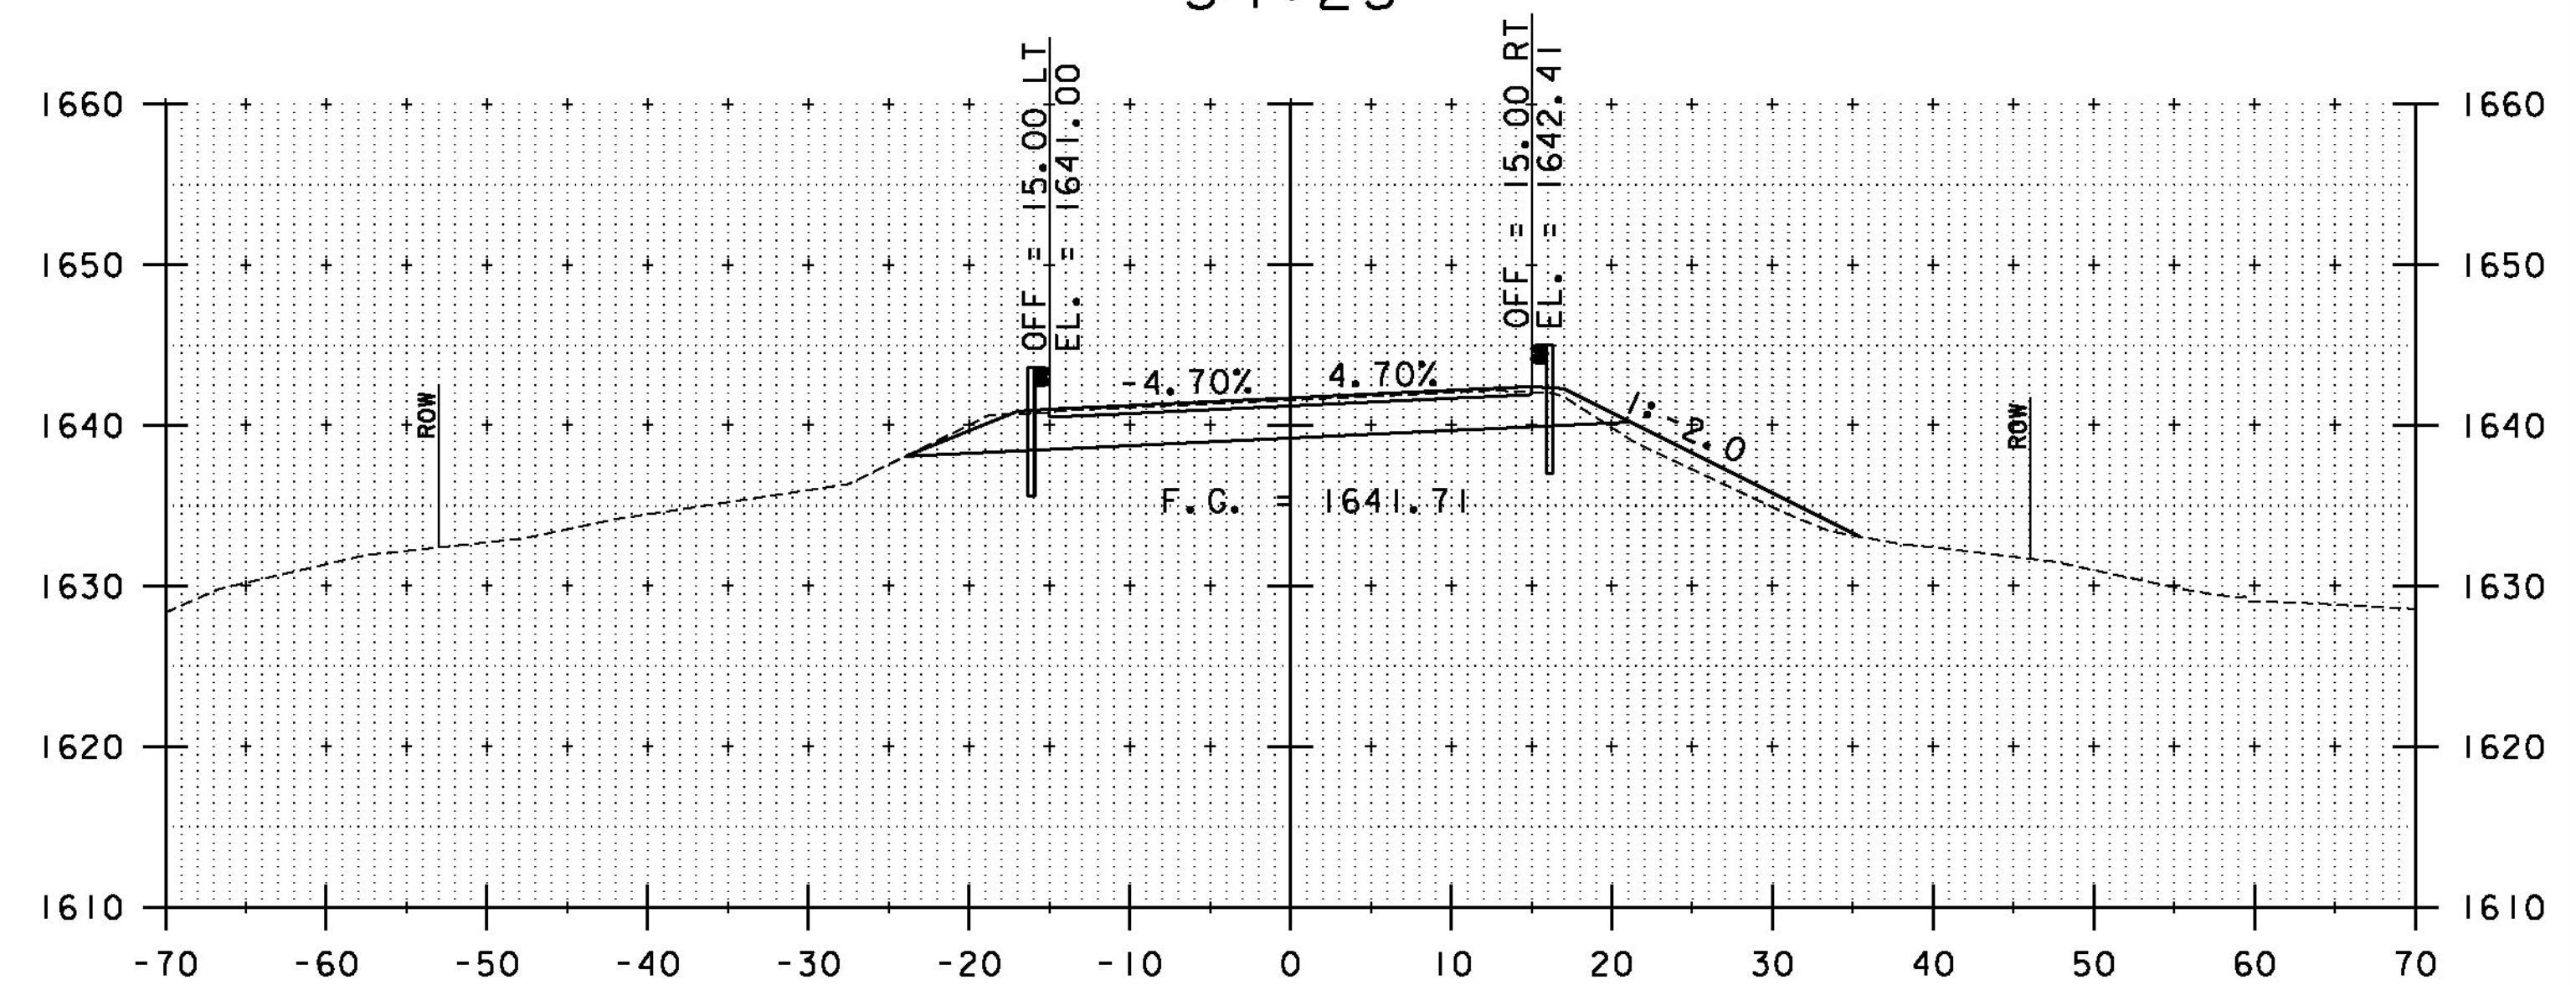

34+05
END PROJECT
34+00

STA. 33+50 TO STA. 34+25

PROJECT NAME: WINHALL
PROJECT NUMBER: STP CULV(3I)

FILE NAME: z1lb268xs_br47.dgn
PROJECT LEADER: M. CHENETTE
DESIGNED BY: J. HUNGERFORD
ROADWAY CROSS SECTIONS - RXS3 - BR47

PLOT DATE: 9/25/2014
DRAWN BY: L. BUXTON
CHECKED BY: M. CHENETTE
SHEET 24 OF 60

