




11+00

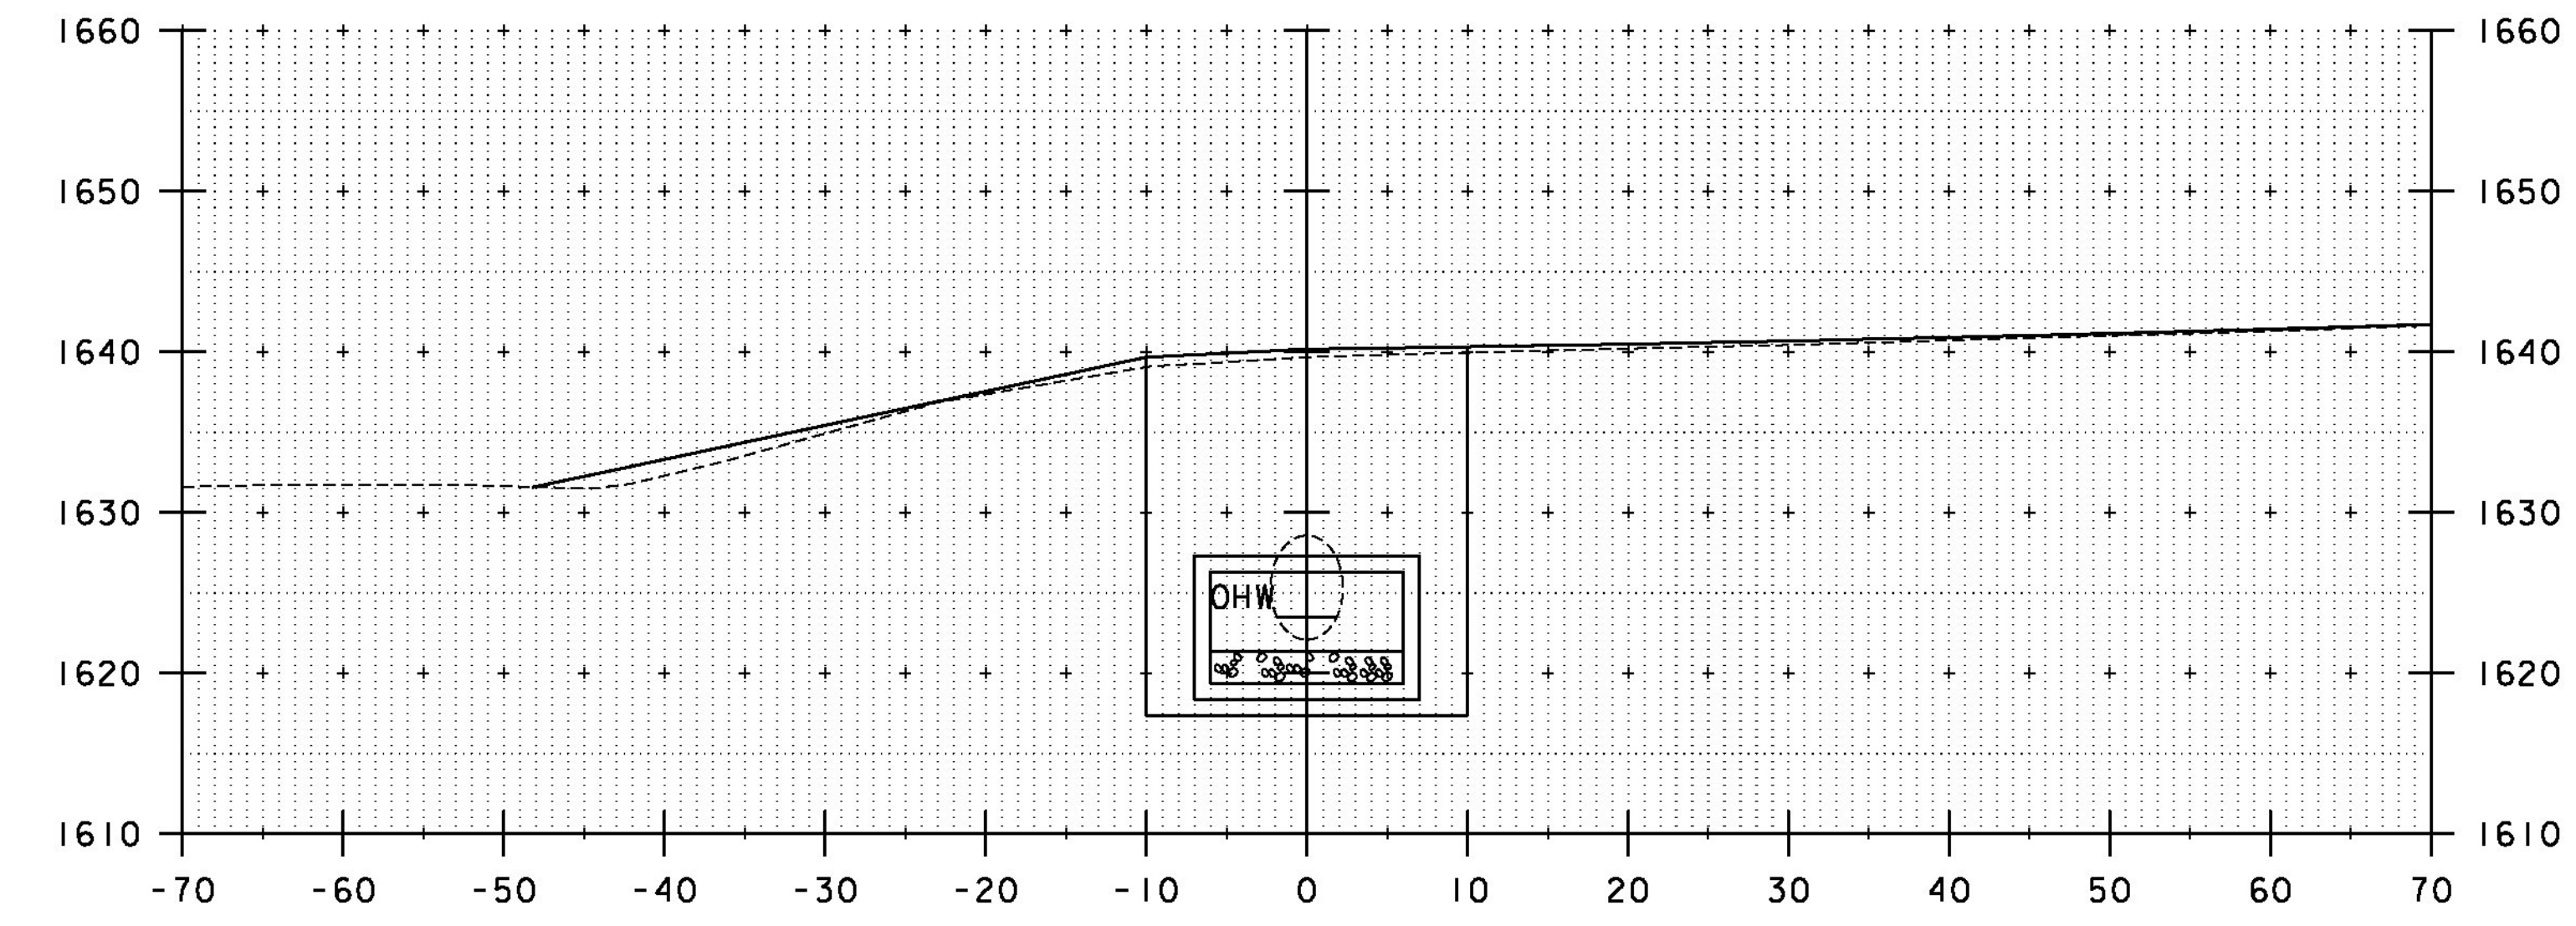

11+20

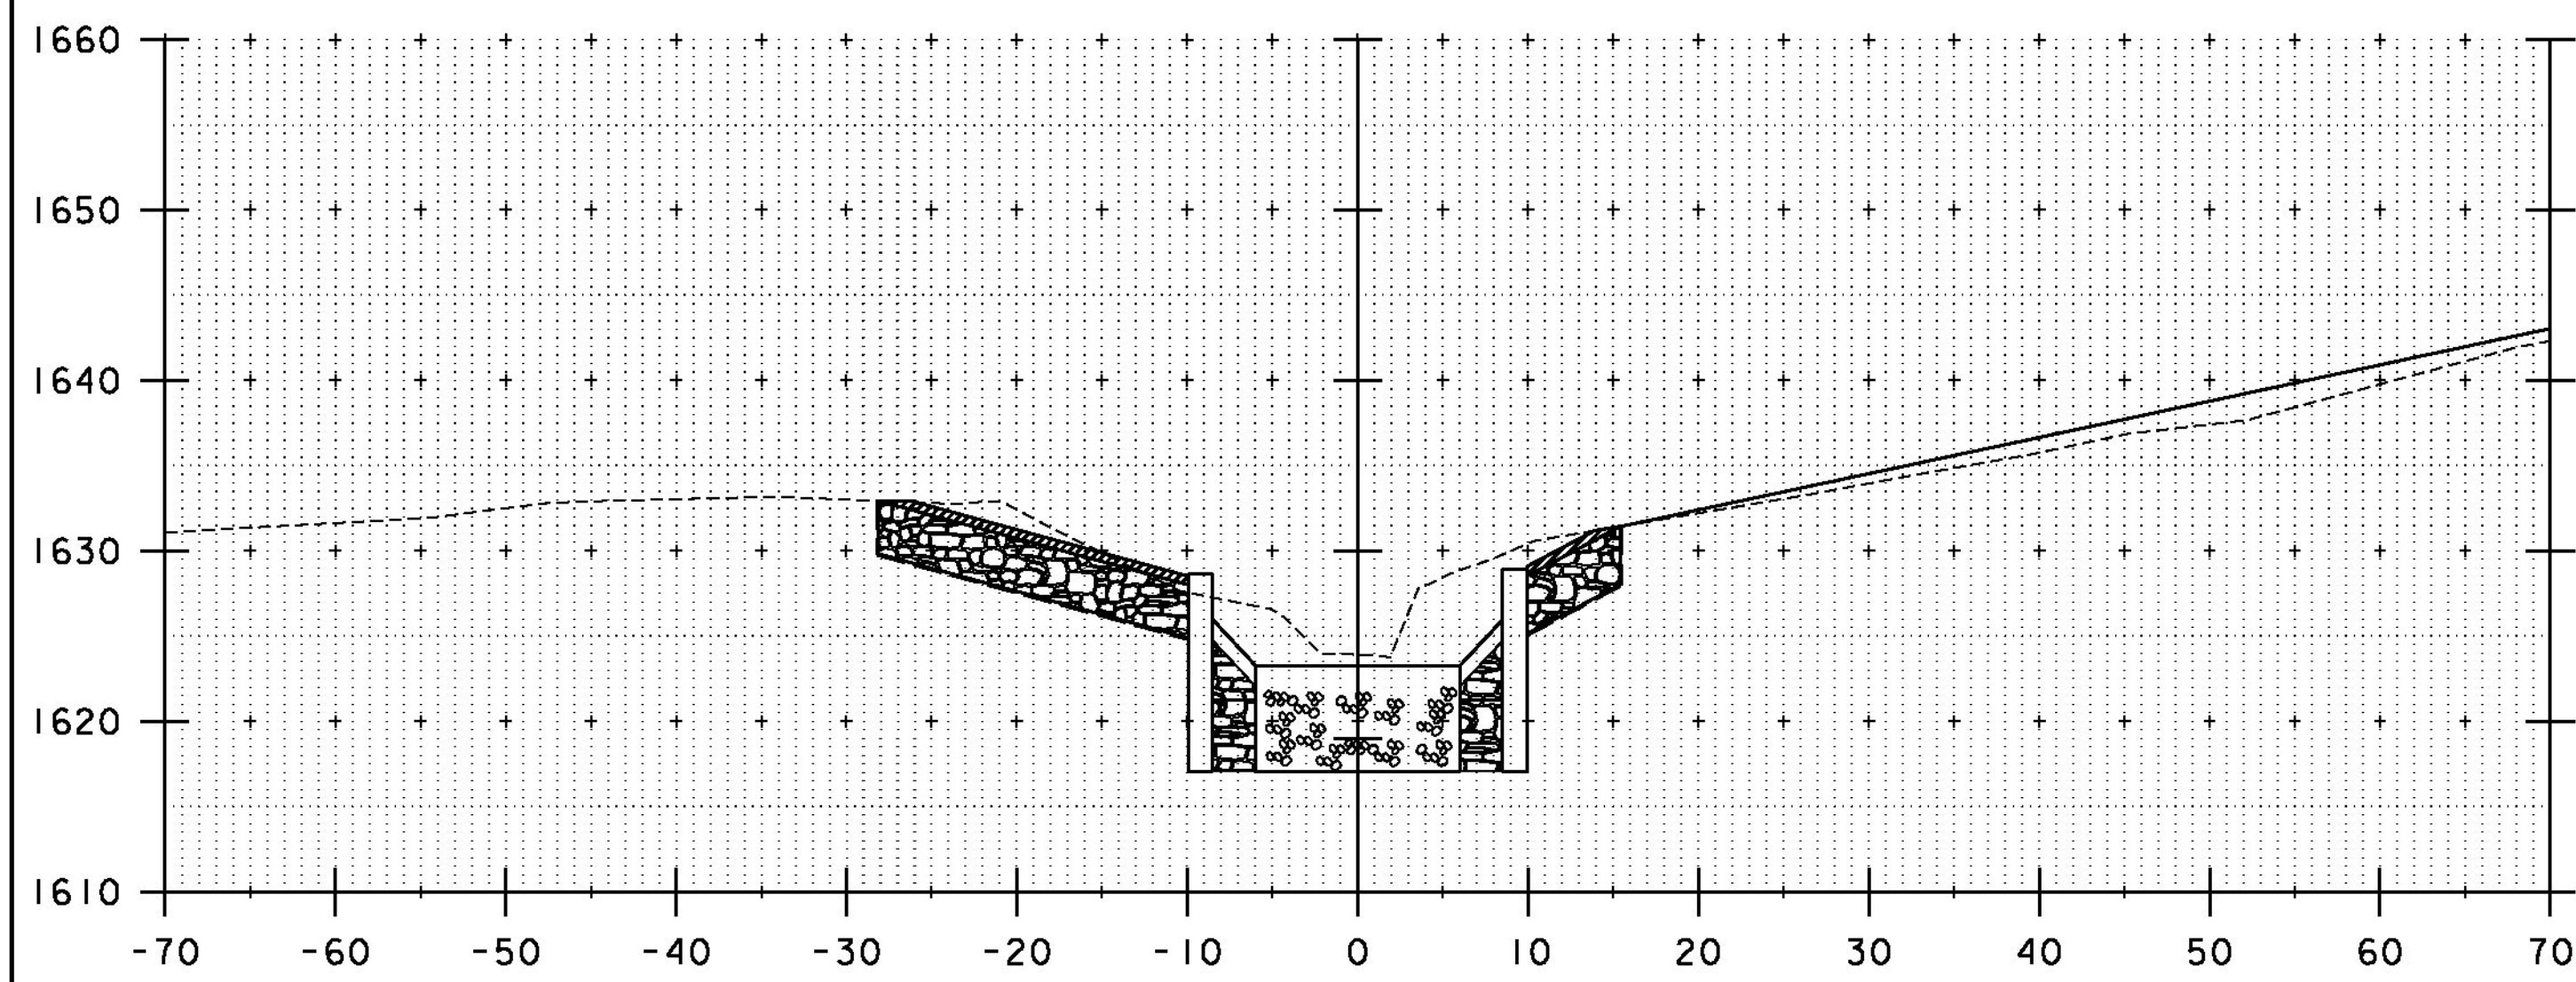

10+90

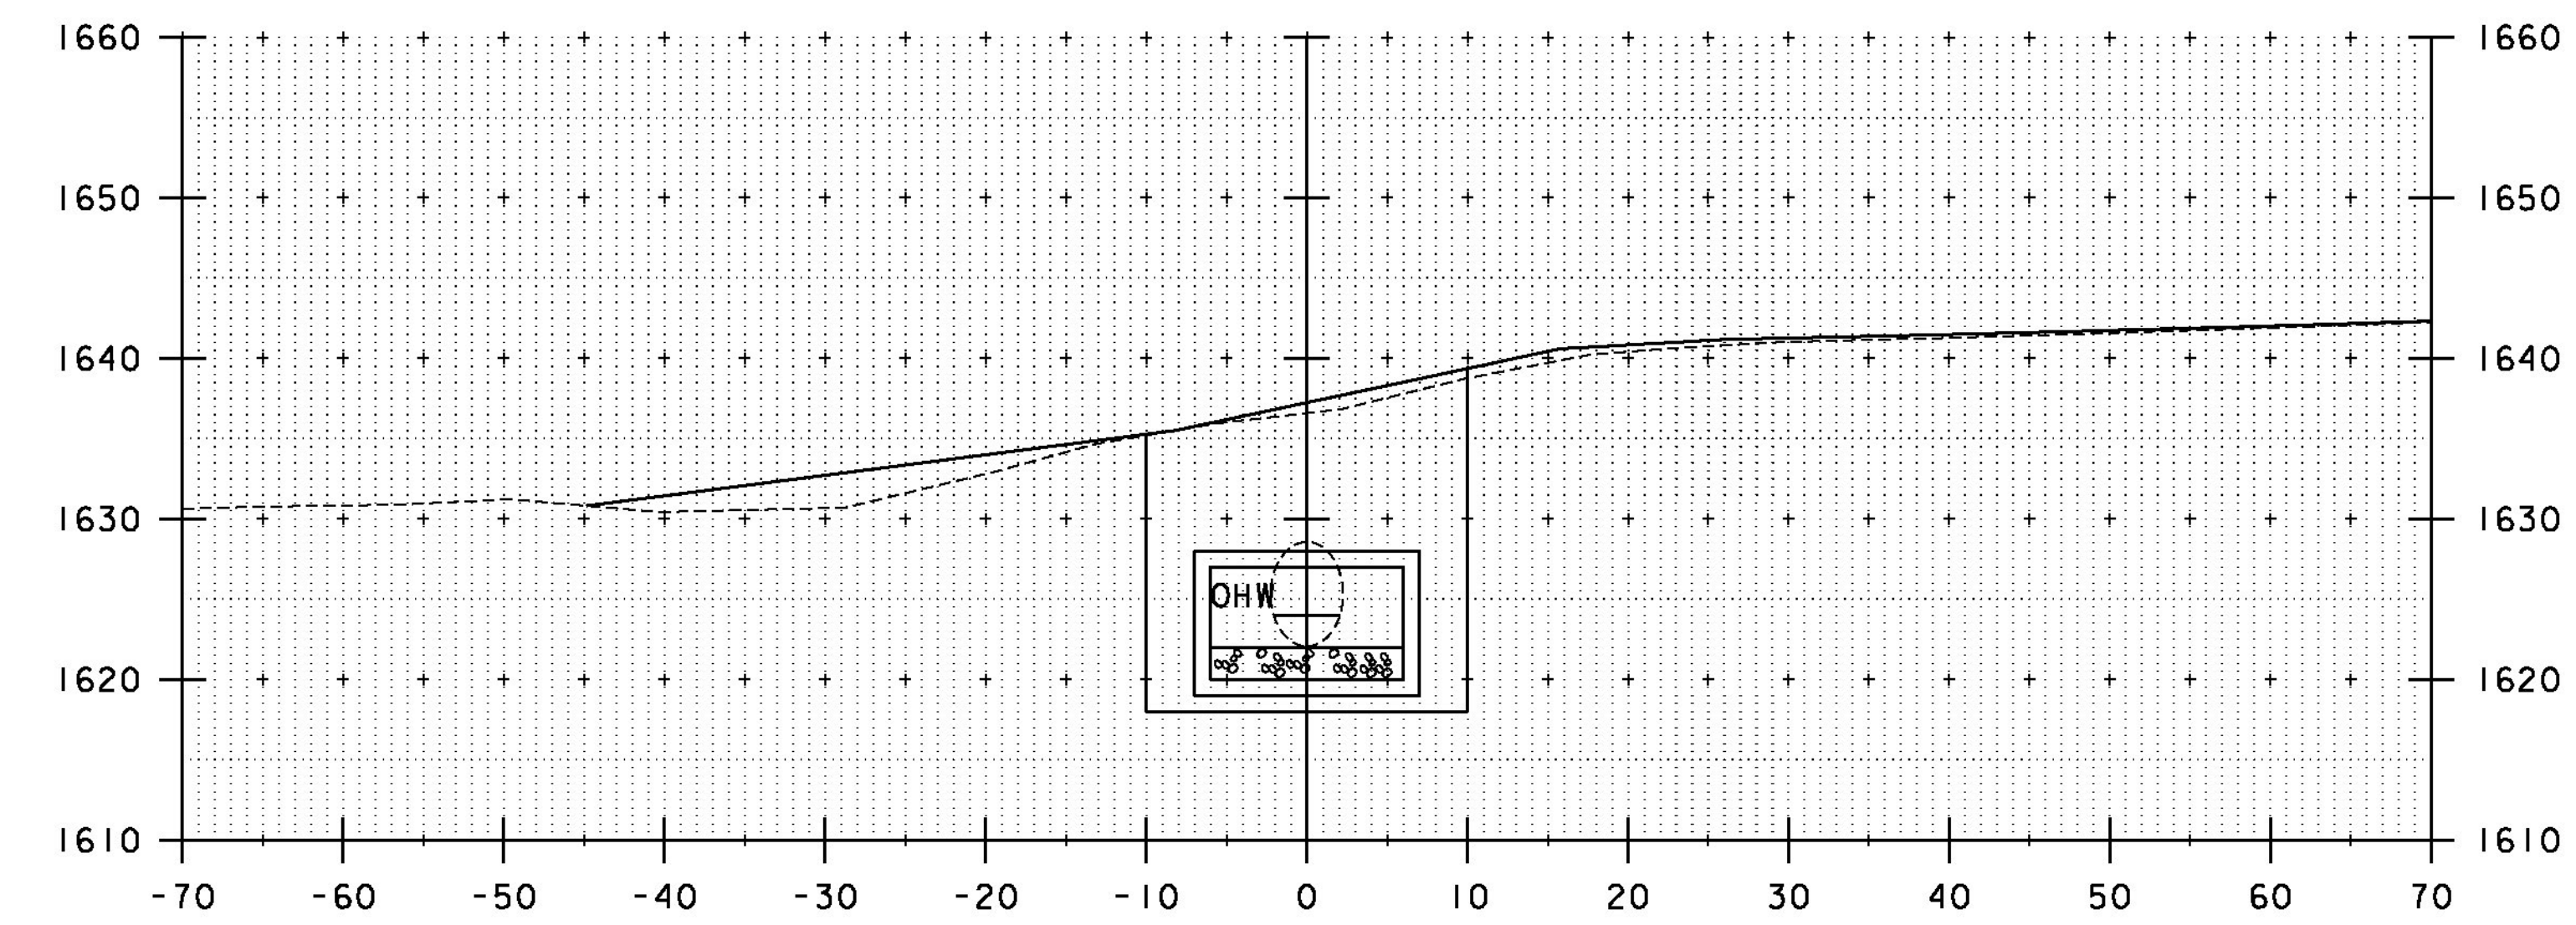

11+10

STA. 10+94 LT
 STOP UNCLASSIFIED CHANNEL EXCAVATION
 GEOTEXTILE UNDER STONE FILL
 STONE FILL, TYPE III
 GRUBBING MATERIAL

STA. 10+94 RT
 STOP UNCLASSIFIED CHANNEL EXCAVATION
 GEOTEXTILE UNDER STONE FILL
 STONE FILL, TYPE III
 GRUBBING MATERIAL

STA. 10+90 TO STA. 11+20

PROJECT NAME: WINHALL	PLOT DATE: 10/9/2014
PROJECT NUMBER: STP CULV(3I)	DRAWN BY: L. BUXTON
FILE NAME: zllb268xs_br47.dgn	CHECKED BY: M. CHENETTE
PROJECT LEADER: M. CHENETTE	SHEET 27 OF 60
DESIGNED BY: J. HUNGERFORD	
CHANNEL CROSS SECTIONS - CXS2 - BR47	

