


TRAFFIC SIGN SUMMARY

STATION	SIGN LEGEND	SIGN DIMENSIONS		NEW SIGNS		NO. OF POSTS	NEW SIGN POSTS			REMARKS	STD. SHEET NUMBER		
		E A	WIDTH (in)	HEIGHT (in)	"A"		"B"	SQUARE STEEL (in)					
								1.75	2.0			2.5	
							lb/ft						
							1.88	2.42	3.35	ANCHOR	SPALL		
41+68, RT		I	6	8	0.33	I	X			X		VR-701 T-42	
42+17, LT		I	6	8	0.33	I	X			X		VR-701 T-42	
TOTALS				SF	SF			FT					
				0.66				30					


FINAL POST LENGTHS ARE TO BE DETERMINED IN THE FIELD. POST SIZES ARE COMPUTED BASED ON INFORMATION FURNISHED ON THE STANDARD SHEETS AND THE VTRANS "SIGN POST DESIGN GUIDELINE."

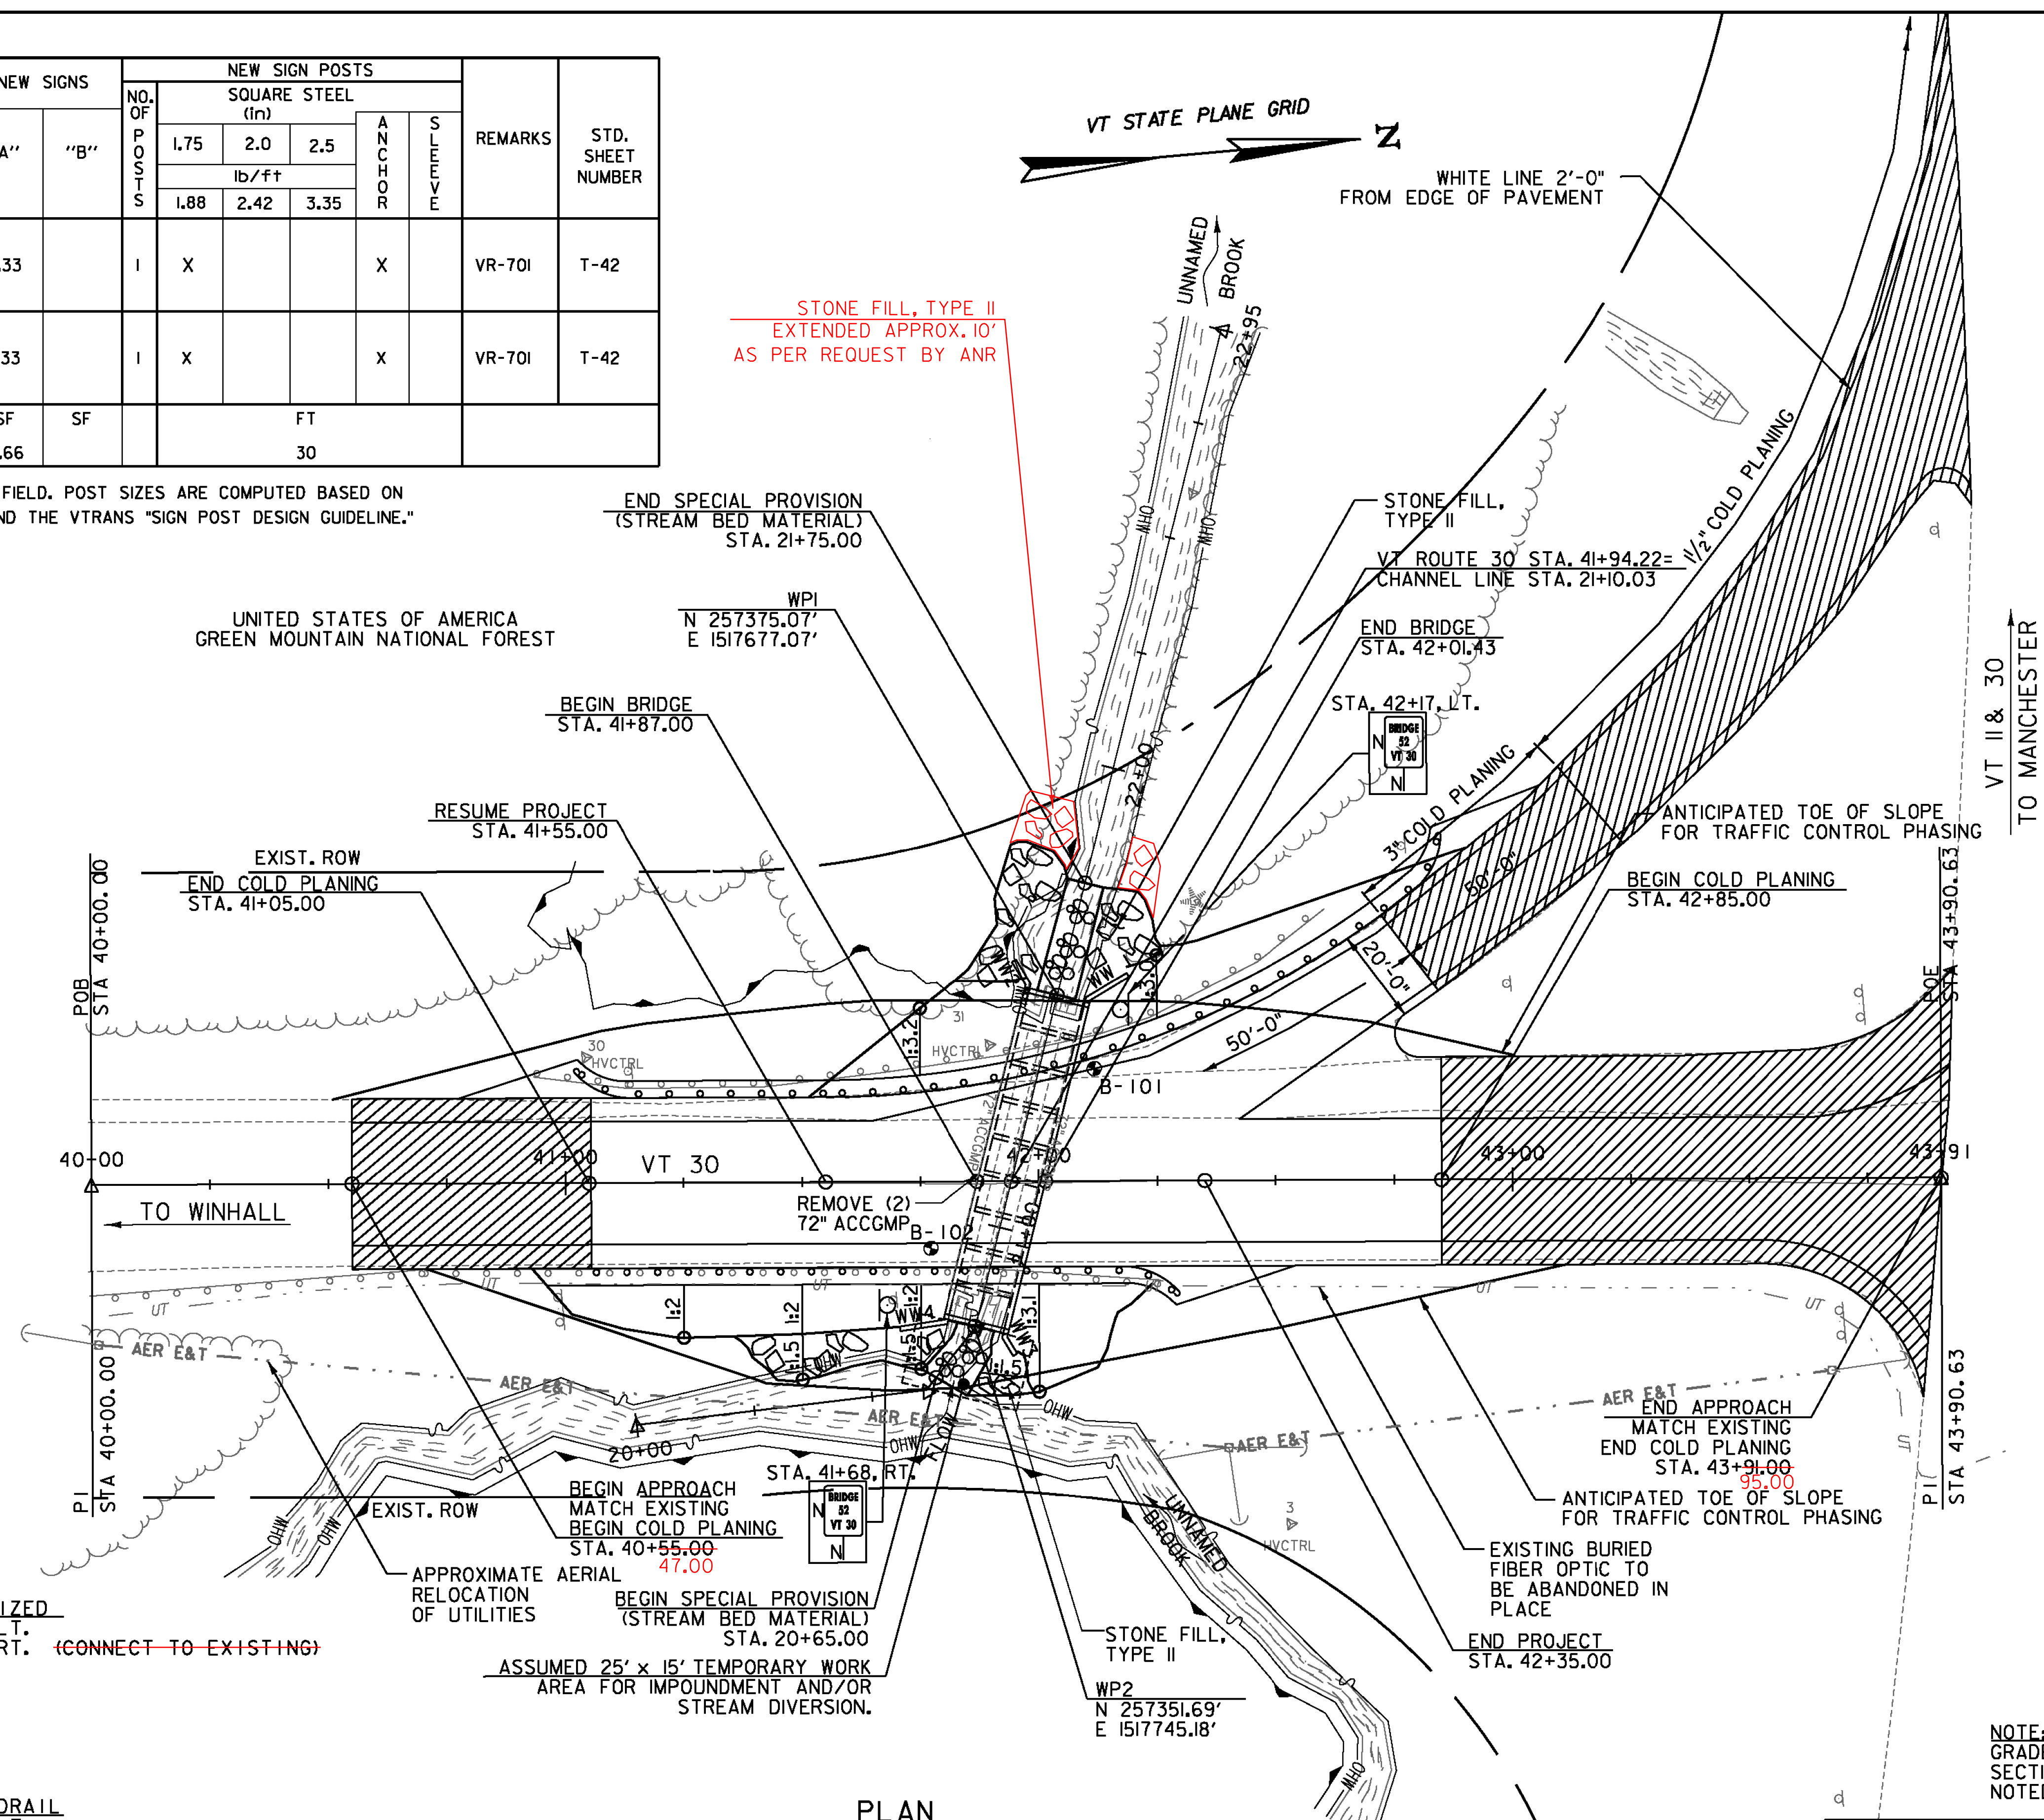

GUARDRAIL REMOVAL & NEW GUARDRAIL EXTENDED BACK TO STA. 40+05 RT. EXISTING RAIL WAS DAMAGED.

STONE FILL, TYPE II EXTENDED APPROX. 10' AS PER REQUEST BY ANR

- 621.20 - STEEL BEAM GUARDRAIL, GALVANIZED
STA. 41+02.00, LT. TO STA. 42+85.00, LT.
STA. 41+05.00, RT. TO STA. 42+30.00, RT. (CONNECT TO EXISTING)
40+05.00
- 621.60 - ANCHOR FOR STEEL BEAM RAIL
STA. 41+08.00, LT.
STA. 41+11.00, RT. STA. 40+11.00, RT.
STA. 42+24.00, RT.
STA. 42+79.00, LT.
- 621.80 - REMOVAL AND DISPOSAL OF GUARDRAIL
STA. 40+93.32, LT. TO STA. 42+60.44, LT.
STA. 41+05.00, RT. TO STA. 42+25.66, RT.
40+05.00
- 646.400 - DURABLE 4 INCH WHITE LINE
STA. 40+55.00, RT. TO STA. 43+91.00, RT.
STA. 40+55.00, LT. TO STA. 43+91.00, LT.
- 646.410 - DURABLE 4 INCH YELLOW LINE
STA. 40+55.00, CL. TO STA. 43+91.00, CL. (DYCL)

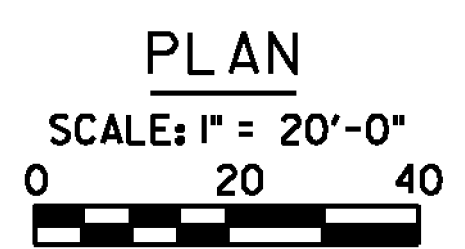

LEGEND

	STONE FILL, TYPE II
	SPECIAL PROVISION (STONE FILL, CULVERT LINING)

NOTE: GRADE IN ACCORDANCE WITH TYPICAL ROADWAY SECTION AND ROADWAY CROSS SECTIONS UNLESS NOTED OTHERWISE.

PROJECT NAME:	WINHALL	FILE NAME:	zlib268bdr_br52.dgn	PLOT DATE:	10/9/2014
PROJECT NUMBER:	STP CULV(31)	PROJECT LEADER:	M. CHENETTE	DRAWN BY:	L. BUXTON
		DESIGNED BY:	J. HUNGERFORD	CHECKED BY:	M. CHENETTE
		PLAN LAYOUT SHEET - BR52		SHEET	39 OF 60

