




42+50

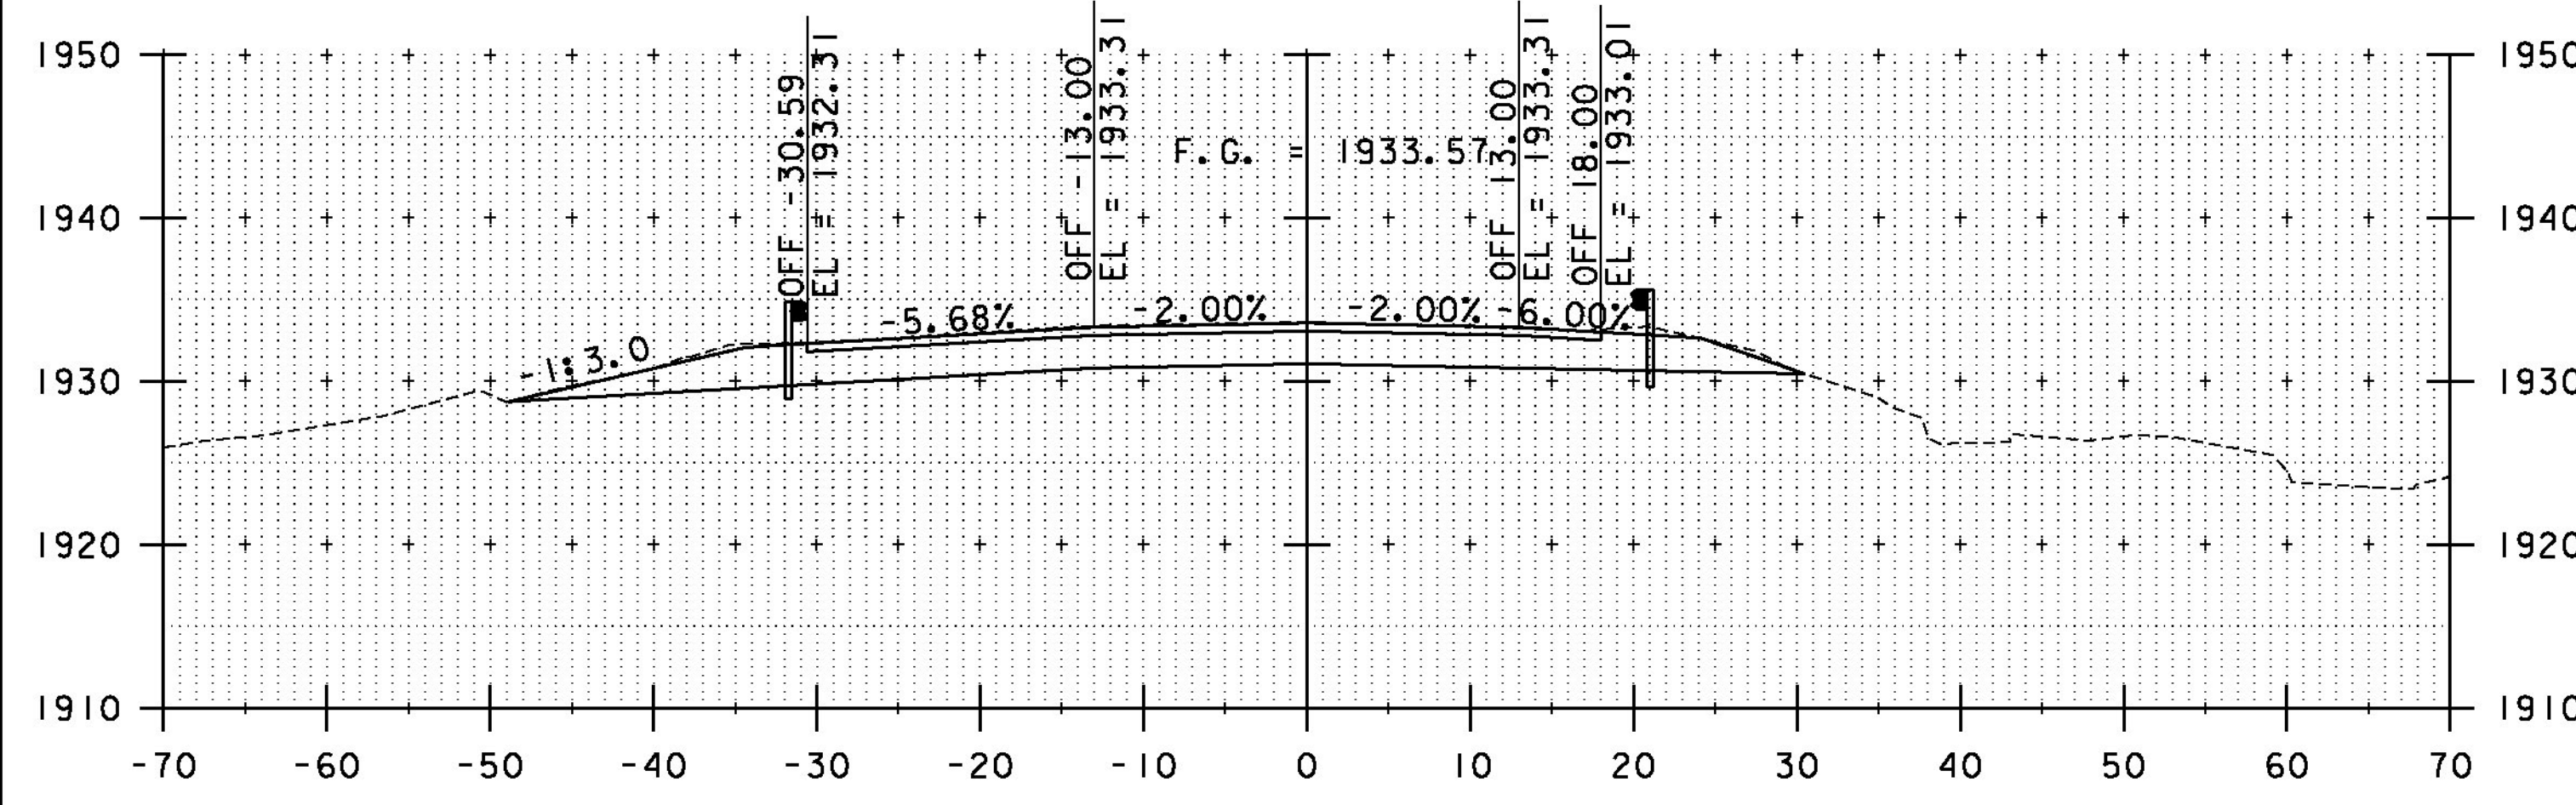


END PROJECT
42+35
42+25

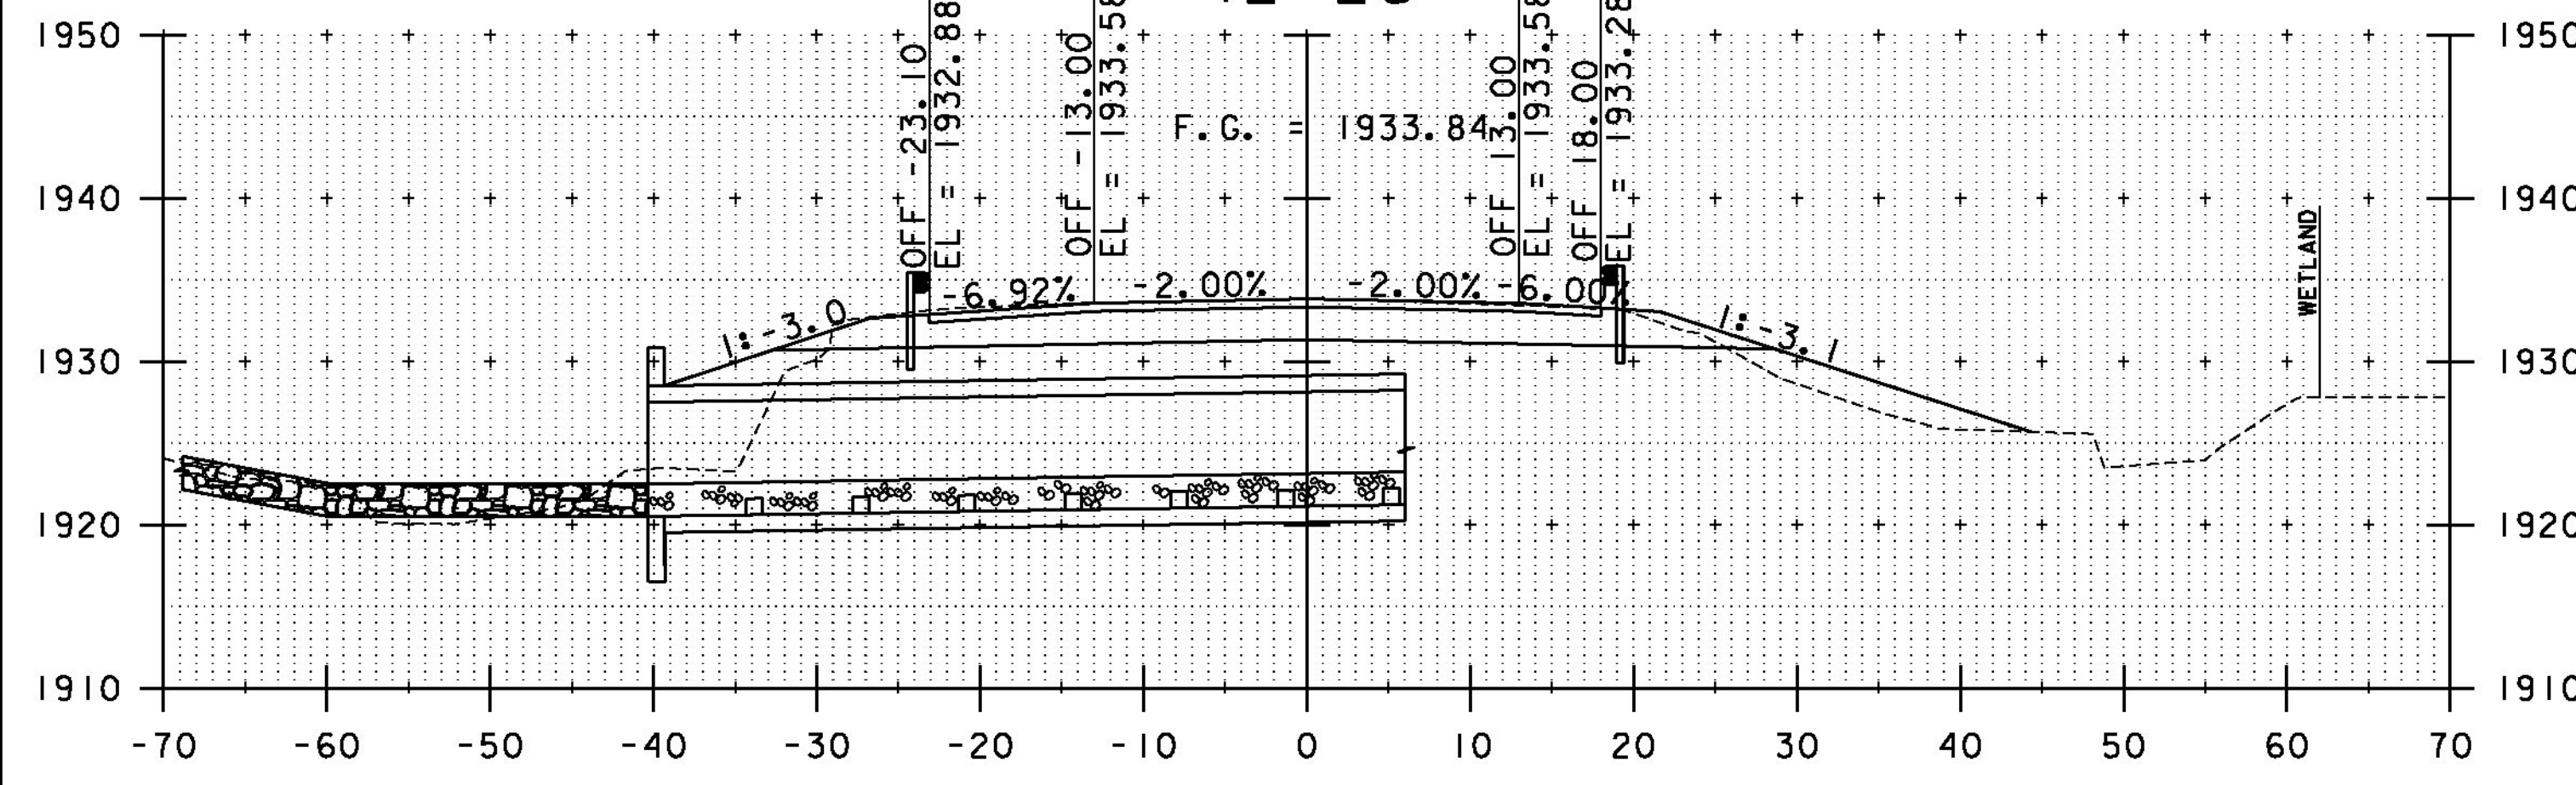


END BRIDGE
42+01.43
42+00

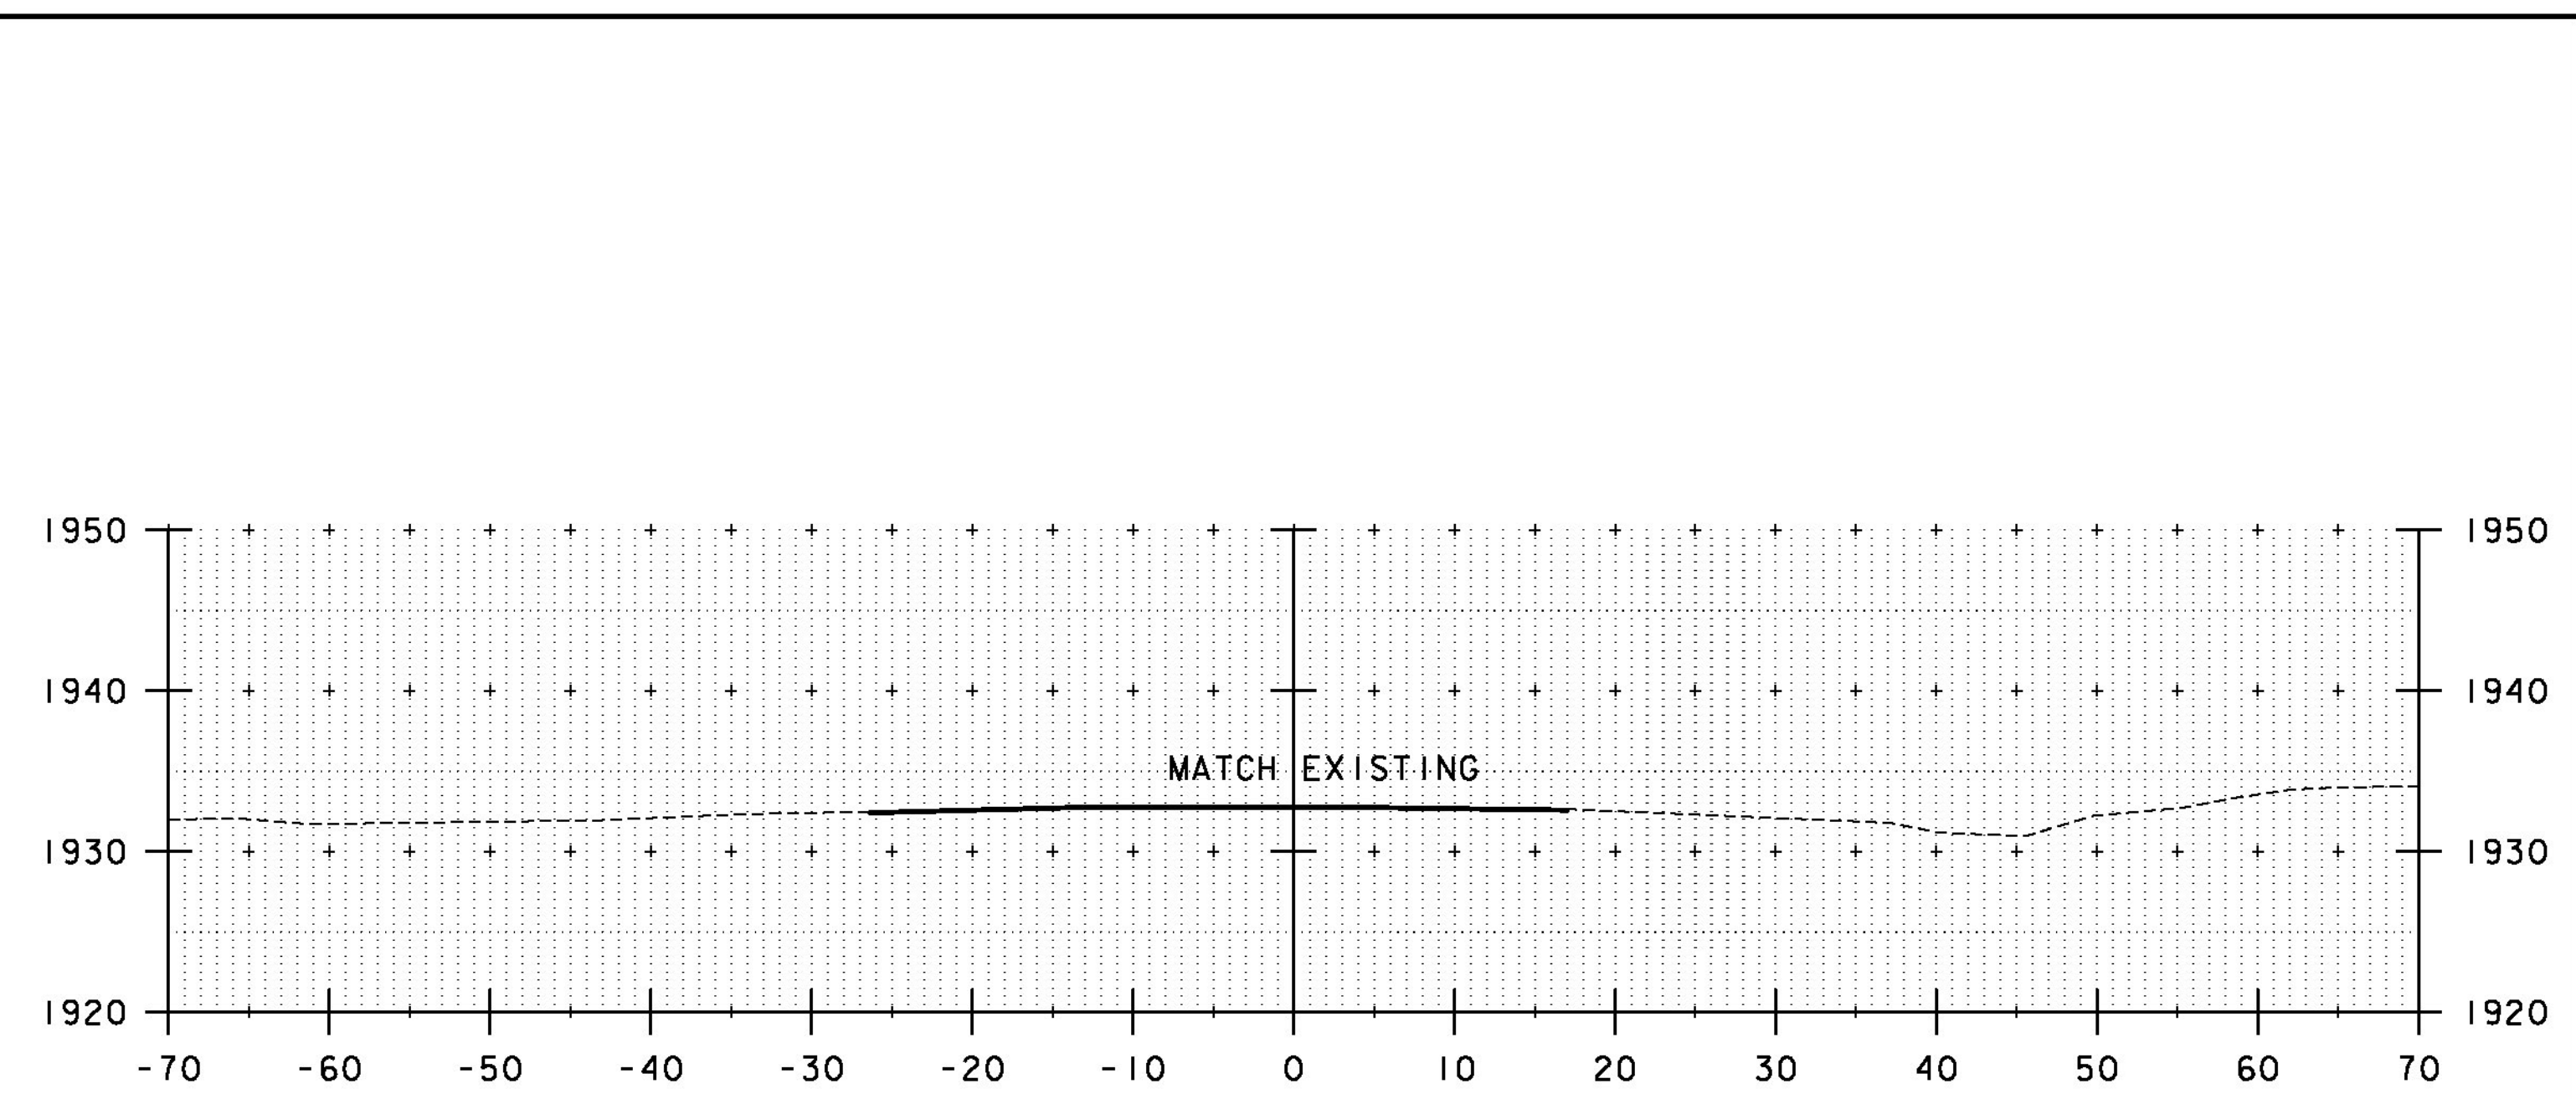

END APPROACH
43+91

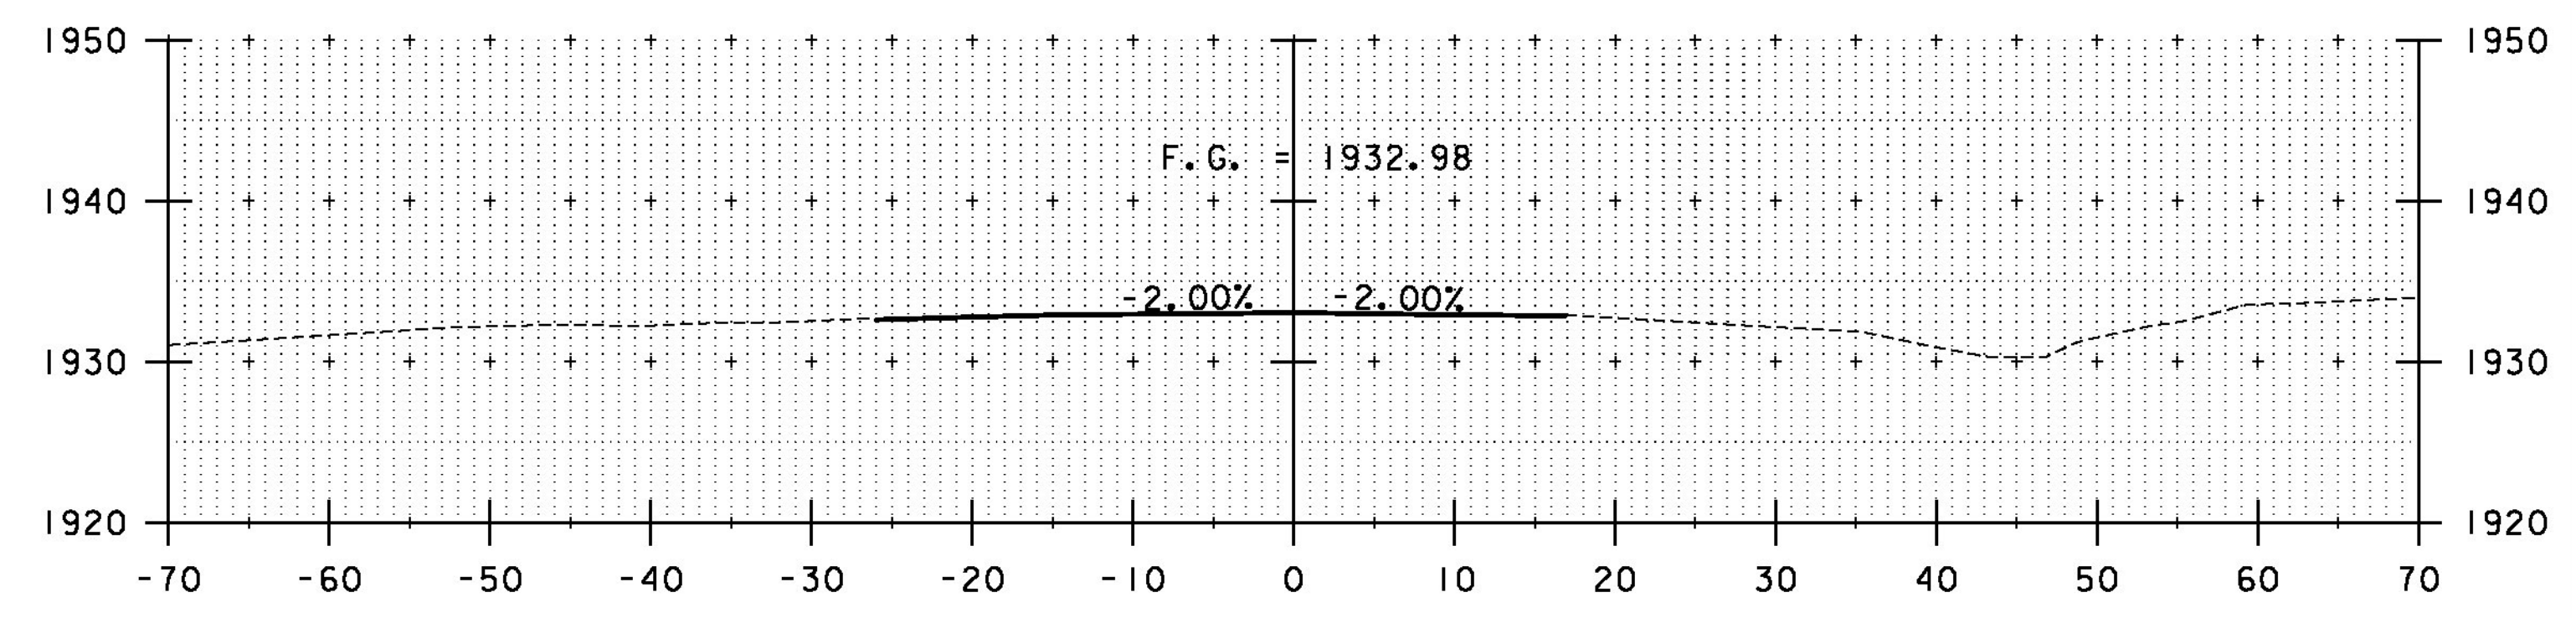

43+00

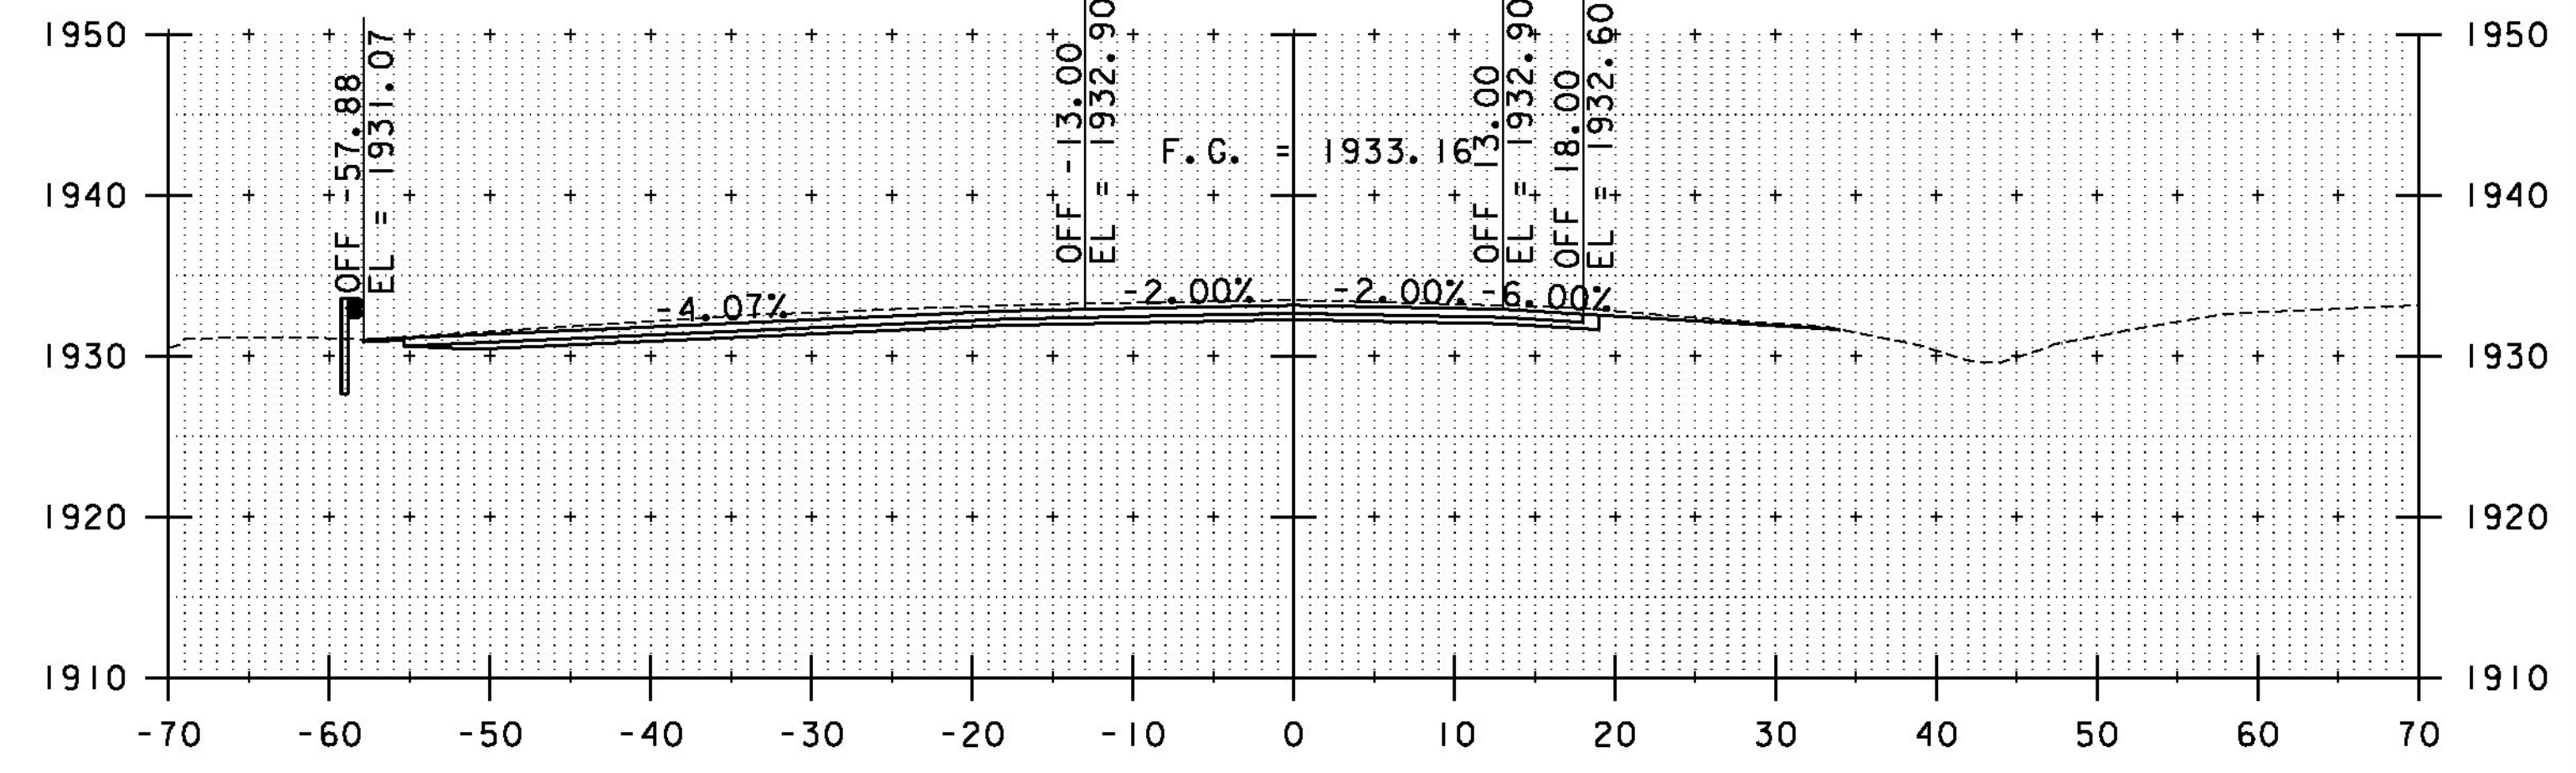

42+75

STA. 42+00 TO STA. 43+91

PROJECT NAME: WINHALL	PLOT DATE: 9/25/2014
PROJECT NUMBER: STP CULV(31)	DRAWN BY: L. BUXTON
FILE NAME: z1lb268xs_br52.dgn	CHECKED BY: M. CHENETTE
PROJECT LEADER: M. CHENETTE	SHEET 48 OF 60
DESIGNED BY: J. HUNGERFORD	
ROADWAY CROSS SECTIONS - RXS2 - BR52	

