
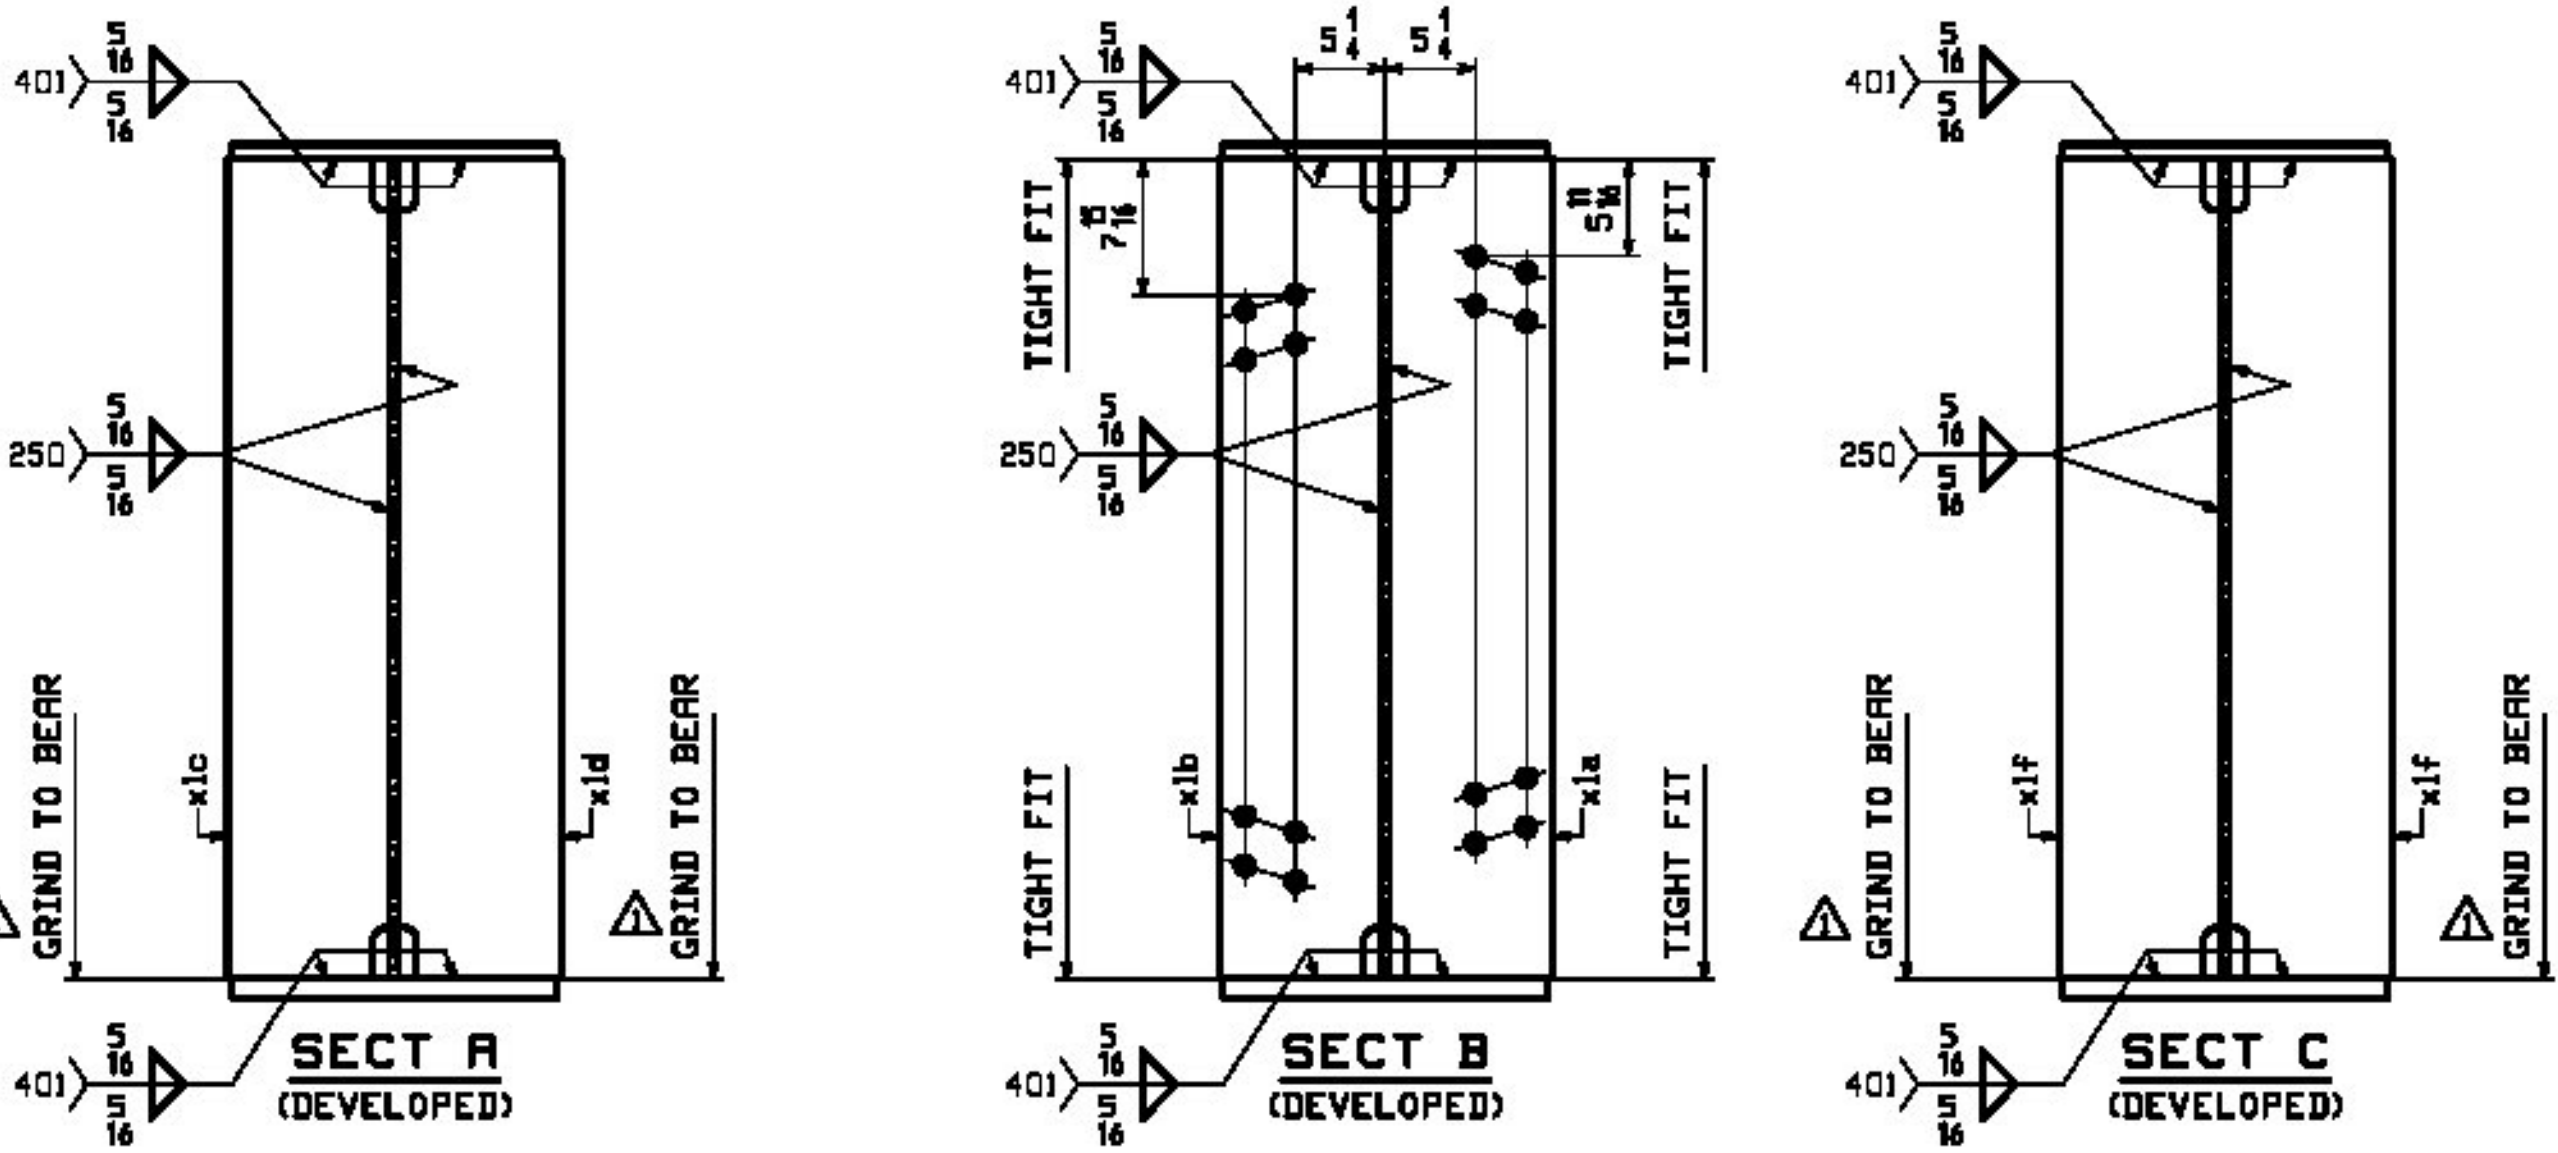
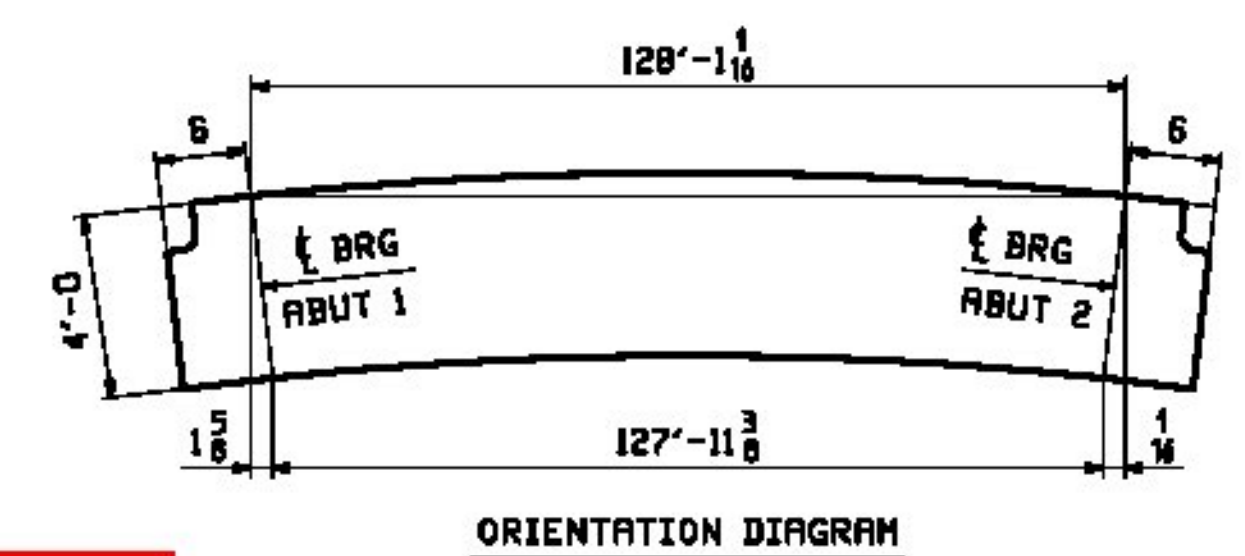


JOB NO.		DRAWING NO.		REV.		
303		2		Δ		
ROW INFO	QTY	UNIT	DESCRIPTION	REMARKS	MT	PROCUREMENT NOTES
2G2	1		GIRDER		31869	
1 E	1	wt	PL 3/16x48	79 7/8	M270-S0M72	7317
1 G	1	wb	PL 3/16x48	49 5/16	M270-S0M72	4546
1 L	1	tw	PL 3/16x19	46 11/16		2768
1 J	1	tb	PL 3/16x19	79 5/8		4457
1 C	1	ba	PL 1/2x19	31 5/8	M270-S0M72	2291
1 H	1	bb	PL 1/2x19	66 0	M270-S0M72	5934
1 C	1	bc	PL 1/2x19	31 5/8	M270-S0M72	2297
2 C	6	x1a	PL 1/2x9 1/2	4 0		65
2 C	6	x1b	PL 1/2x9 1/2	4 0		65
2 B	1	x1c	PL 1/2x9 1/2	4 0 1/2	OND	113
2 B	1	x1d	PL 1/2x9 1/2	4 0 1/2	OND	113
2 B	2	x1f	PL 1/2x9 1/2	4 0	OND	113

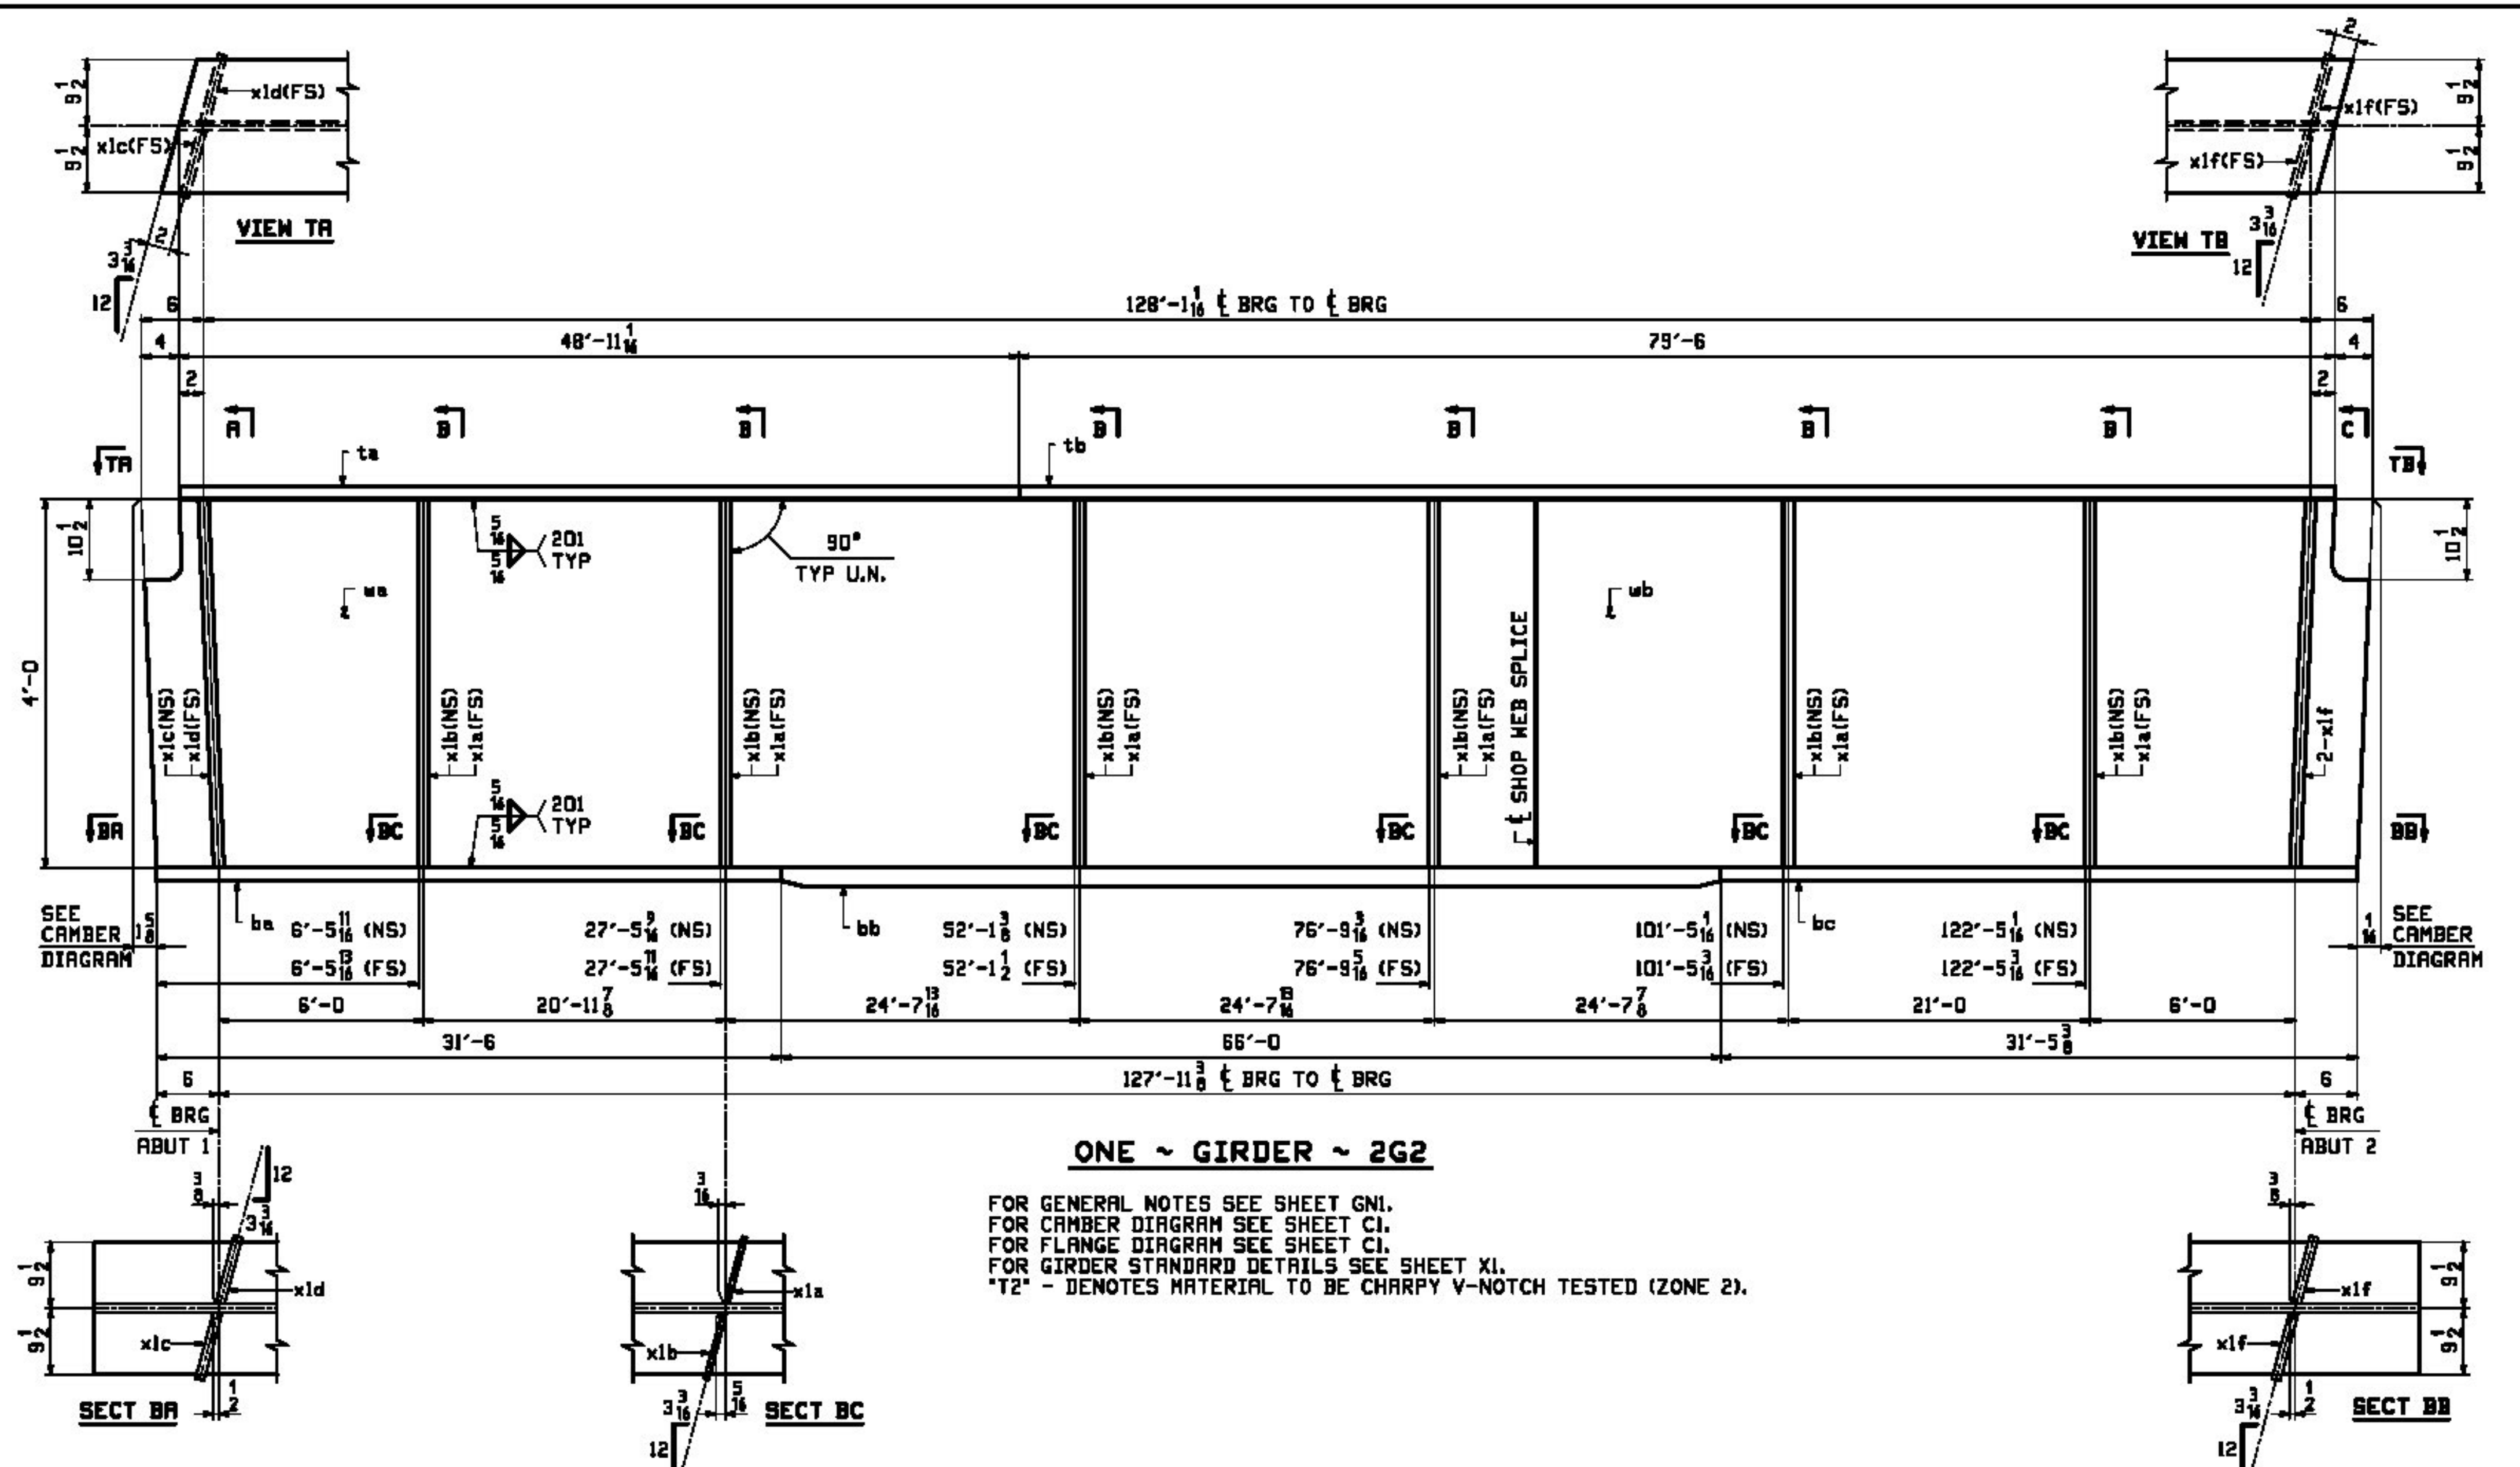

T.Y. LIN INTERNATIONAL

THE STAMPED DOCUMENTS ARE HEREBY:

APPROVED
 APPROVED AS NOTED
 REVISE AND RESUBMIT

SEE TRANSMITTAL FOR ADDITIONAL INFORMATION AS APPLICABLE.

THIS REVIEW IS FOR GENERAL CONFORMANCE WITH DESIGN CONCEPT ONLY. ANY DEVIATION FROM THE PLANS OR SPECIFICATIONS NOT CLEARLY NOTED BY THE CONTRACTOR HAS NOT BEEN REVIEWED. REVIEW BY THE ENGINEER SHALL NOT RELIEVE THE CONTRACTOR OF THE CONTRACTUAL RESPONSIBILITY FOR ANY ERRORS OR DEVIATION FROM THE CONTRACT REQUIREMENTS.

RICK HEBERT
 REVIEWER

4/25/2014
 DATE

Δ	4/7/14	GRIND TO BEAR PER APPROVAL COMMENT	HL			
□						
REV.	DATE	REMARKS	DWN	CHK	APVL	SHOP
MATERIAL:		SURFACE PREP. & PAINT:		HOLES:		SHOP BOLTS:
M270-50M (UN)		SEE GNI		5/16"		NONE
DESCRIPTION: GIRDER~2G2						
			CASCO BAY STEEL STRUCTURES, INC. 1 WALLACE AVE. PHONE (207) 780-6722 SOUTH PORTLAND, ME 04106 FAX: (207) 780-6725			
STRUCTURE: VT RTE 15 OVER CENTERVILLE BRIDGE #42 HYDE PARK LAMOILLE COUNTY			DRWN: JAS	DATE: 02/28		
			CHKD: JH	DATE: 3/6/14		
LOCATION: HYDE PARK, VT			JOB NO. 565		DWG NO. 2	
PROJ NO. STP CULV (26)					REV. Δ	
CUSTOMER: VDOT						