


JOB NO.		DRAWING NO.		REV.		
303		4		Δ		
ROW INFO	QTY	UNIT	DESCRIPTION	REMARKS	MT	PROCUREMENT NOTES
4G4	1		GIRDER		31859	
1 E	1	wt	PL 3/8x48	79 7/8	M270-50M2	7317
1 G	1	wb	PL 3/8x48	49 5/8	M270-50M2	4545
1 L	1	tw	PL 3/8x19	48 11/16		2768
1 J	1	tb	PL 3/8x19	79 5/8		4457
1 C	1	ba	PL 1/2x19	31 5/8	M270-50M2	2291
1 H	1	bb	PL 1/2x19	66 0	M270-50M2	5934
1 C	1	bc	PL 1/2x19	31 5/8	M270-50M2	2287
2 C	6	x1a	PL 2x9 1/2	4 0		65
2 C	6	x1b	PL 2x9 1/2	4 0		65
2 B	1	x1c	PL 2x9 1/2	4 0 1/2	OND	113
2 B	1	x1d	PL 2x9 1/2	4 0 1/2	OND	113
2 B	2	x1f	PL 2x9 1/2	4 0	OND	113

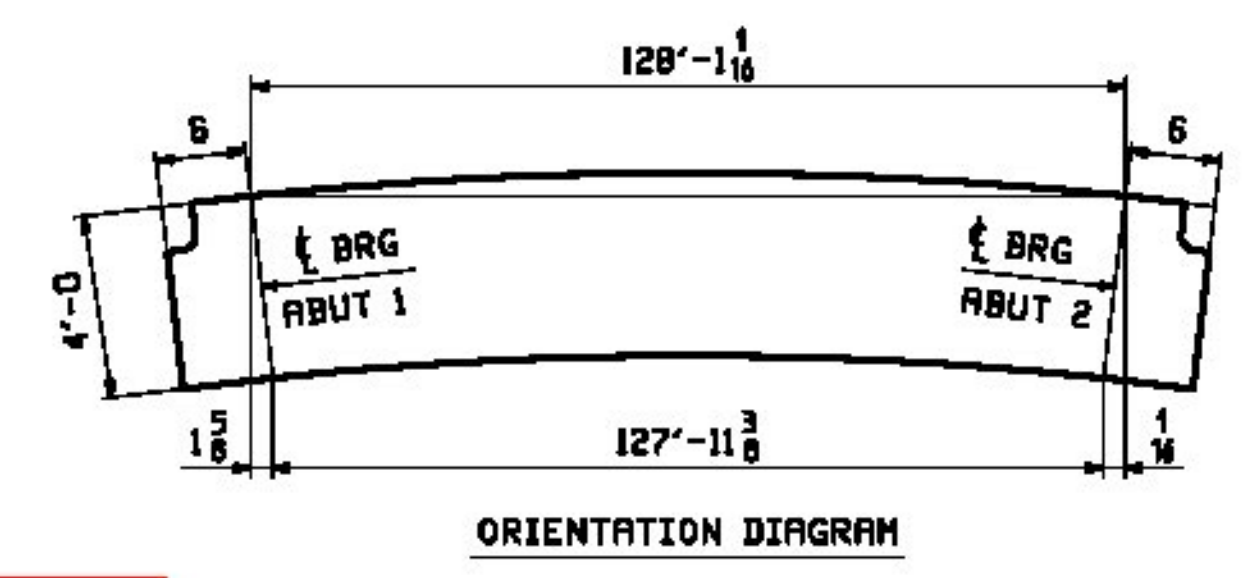

T.Y. LIN INTERNATIONAL

THE STAMPED DOCUMENTS ARE HEREBY:

APPROVED
 APPROVED AS NOTED
 REVISE AND RESUBMIT

SEE TRANSMITTAL FOR ADDITIONAL INFORMATION AS APPLICABLE.

THIS REVIEW IS FOR GENERAL CONFORMANCE WITH DESIGN CONCEPT ONLY. ANY DEVIATION FROM THE PLANS OR SPECIFICATIONS NOT CLEARLY NOTED BY THE CONTRACTOR HAS NOT BEEN REVIEWED. REVIEW BY THE ENGINEER SHALL NOT RELIEVE THE CONTRACTOR OF THE CONTRACTUAL RESPONSIBILITY FOR ANY ERRORS OR DEVIATION FROM THE CONTRACT REQUIREMENTS.

RICK HEBERT
 REVIEWER

4/25/2014
 DATE

Δ	4/7/14	GRIND TO BEAR PER APPROVAL COMMENT	ML			
□						
REV.	DATE	REMARKS	DWN	CHK	APVL	SHOP
MATERIAL:		SURFACE PREP. & PAINT:		HOLES:		SHOP BOLTS:
M270-50M (UN)		SEE GNI		5/8" Ø		NONE
DESCRIPTION: GIRDER-4G4						
CASCO BAY STEEL STRUCTURES, INC. 1 WALLACE AVE. PHONE (207) 780-6722 SOUTH PORTLAND, ME 04105 FAX: (207) 780-6725			TENSAR 2014			
STRUCTURE: VT RTE 15 OVER CENTERVILLE BRIDGE #42 HYDE PARK LAMOILLE COUNTY				DRAWN:	JAS	DATE: 02/28
				CHKD:	DD	DATE: 3/6/14
LOCATION: HYDE PARK, VT				JOB NO. 565		DWG NO. 4
PROJ NO. STP CULV (26)						REV. Δ
CUSTOMER: VDOT						