



JOB NO.		DRAWING NO.		REV.	
565		5		Δ	
REV.	DATE	BY	CHK	APVL	SHOP
1	4/7/14				
2					
3					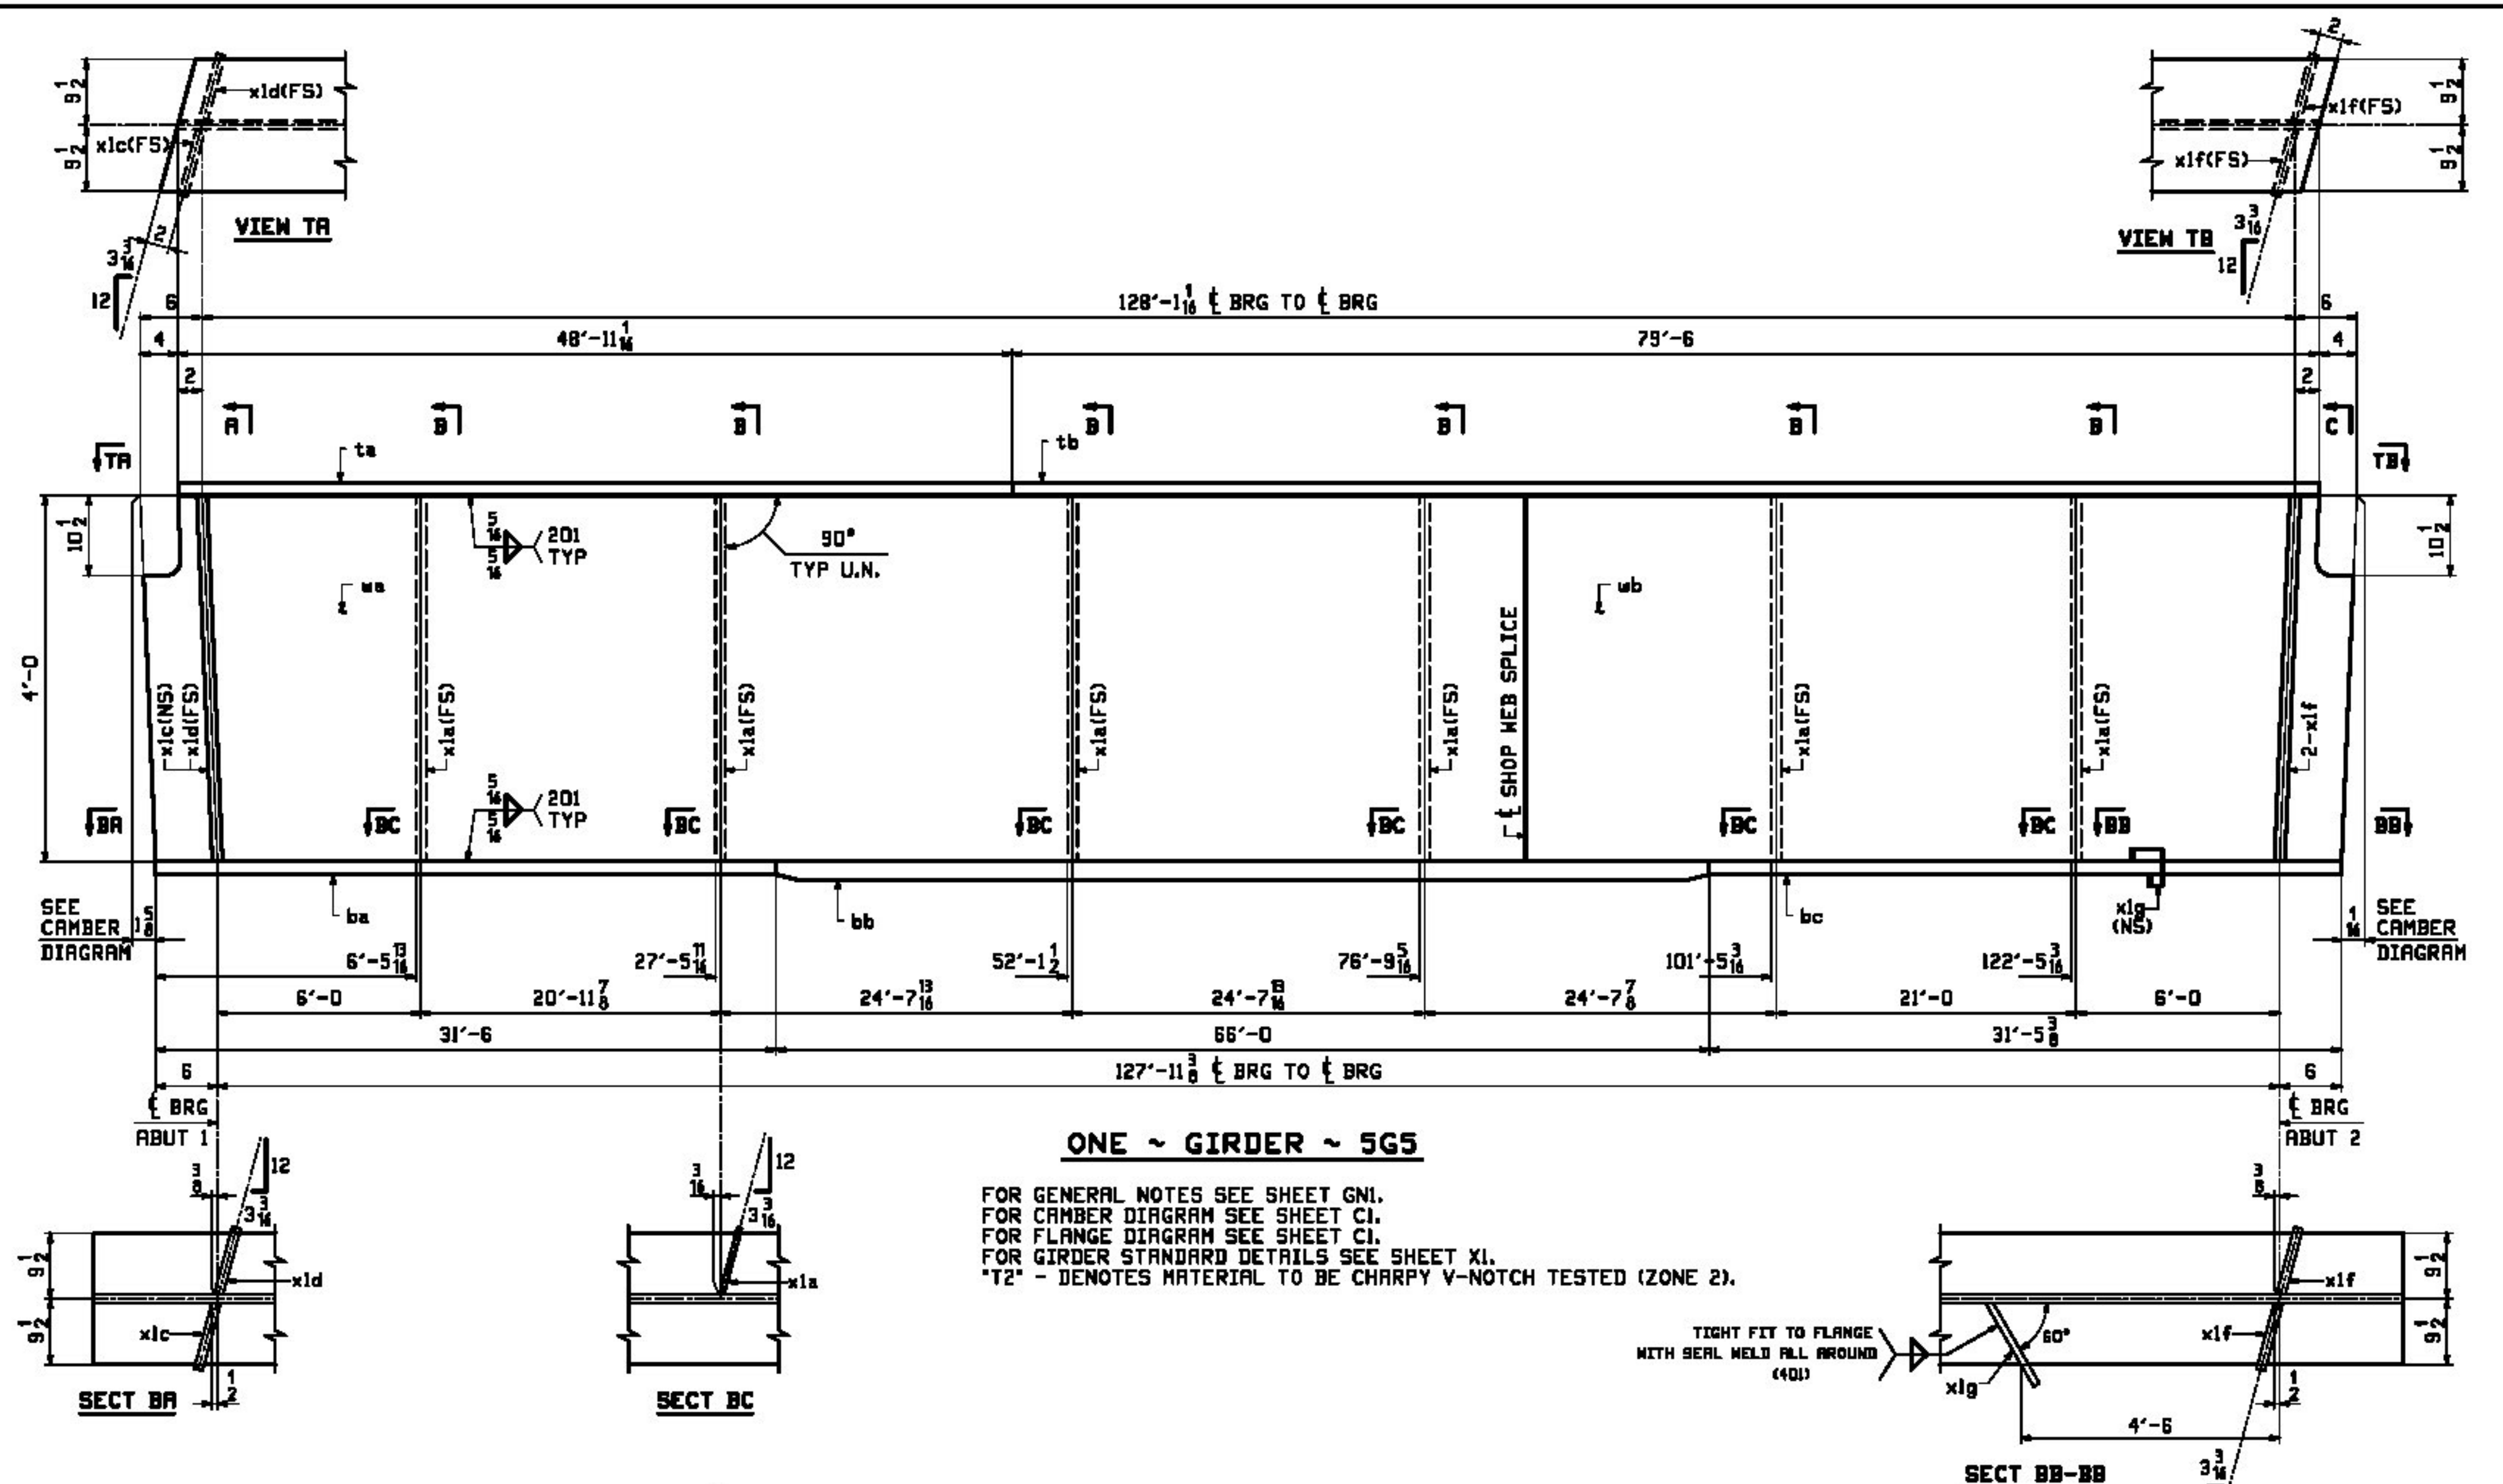
ONE ~ GIRDER ~ 5G5

FOR GENERAL NOTES SEE SHEET GNI.
 FOR CAMBER DIAGRAM SEE SHEET CI.
 FOR FLANGE DIAGRAM SEE SHEET CI.
 FOR GIRDER STANDARD DETAILS SEE SHEET XI.
 T2 - DENOTES MATERIAL TO BE CHARPY V-NOTCH TESTED (ZONE 2).

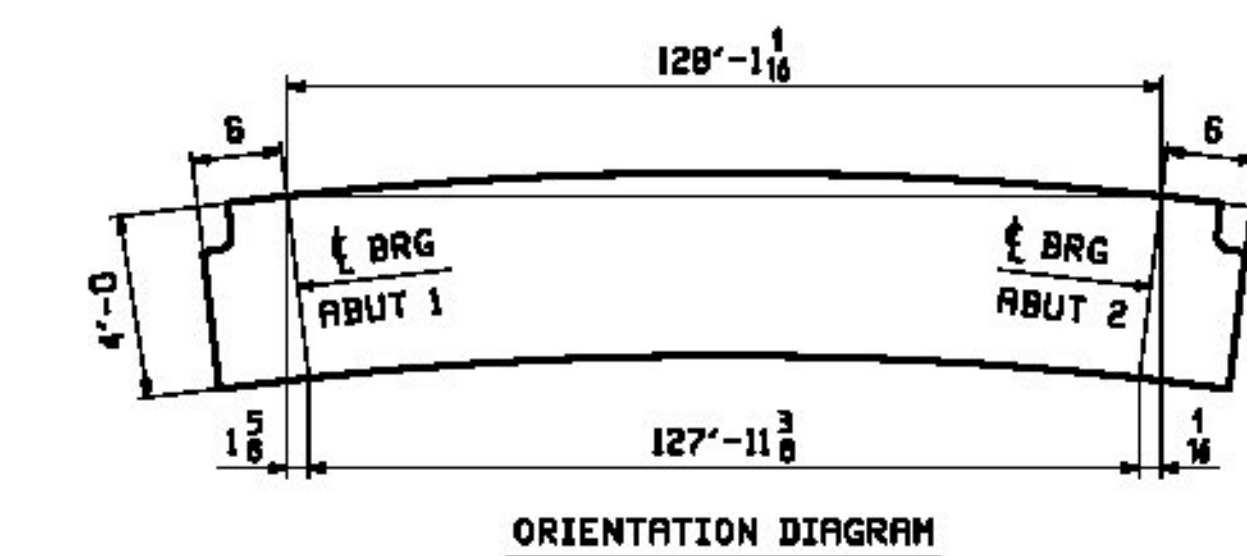

T.Y. LIN INTERNATIONAL

THE STAMPED DOCUMENTS ARE HEREBY:

APPROVED
 APPROVED AS NOTED
 REVISE AND RESUBMIT

SEE TRANSMITTAL FOR ADDITIONAL INFORMATION AS APPLICABLE.

THIS REVIEW IS FOR GENERAL CONFORMANCE WITH DESIGN CONCEPT ONLY. ANY DEVIATION FROM THE PLANS OR SPECIFICATIONS NOT CLEARLY NOTED BY THE CONTRACTOR HAS NOT BEEN REVIEWED. REVIEW BY THE ENGINEER SHALL NOT RELIEVE THE CONTRACTOR OF THE CONTRACTUAL RESPONSIBILITY FOR ANY ERRORS OR DEVIATION FROM THE CONTRACT REQUIREMENTS.

RICK HEBERT
 REVIEWER

4/25/2014
 DATE

1/7/14	GRIND TO BEAR PER APPROVAL COMMENT	HL				
REV.	DATE	REMARKS	DWN	CHK	APVL	SHOP
MATERIAL:	SURFACE PREP. & PAINT:		HOLES:		SHOP BOLTS:	
M270-50M (UN)	SEE GNI		5/8" Ø		NONE	
DESCRIPTION: GIRDER-5G5						
			CASCO BAY STEEL STRUCTURES, INC. 1 WALLACE AVE. PHONE (207) 780-6722 SOUTH PORTLAND, ME 04106 FAX: (207) 780-6725			
STRUCTURE: VT RTE 15 OVER CENTERVILLE BRIDGE #42 HYDE PARK LAMOILLE COUNTY			DRAWN:	DATE:		
			JAS	02/28		
			CHKD:	DATE:		
			DD	3/6/14		
LOCATION: HYDE PARK, VT			JOB NO.		DWG NO.	
PROJ NO. STP CULV (26)			565		5	
CUSTOMER: VDOT					REV. Δ	