


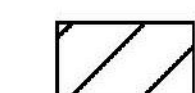

TEMPORARY ROADWAY B PROFILE
 STATIONING AND ELEVATIONS ARE IN FEET

-  - PHASE 2 CUT WALL SHORING
-  - PHASE 2 FILL WALL SHORING
-  - TEMPORARY SHEETING FOR FLOW DIVERSION

NOTE:
 FOR ADDITIONAL INFORMATION SEE MAINTENANCE
 OF TRAFFIC PLANS AND SECTIONS.

TYL INTERNATIONAL	PROJECT NAME: HYDE PARK	FILE NAME: zllb292bdr_mot_PR.dgn	PLOT DATE: 11/6/2013
	PROJECT NUMBER: STP CULV(26)	PROJECT LEADER: R. HEBERT	DRAWN BY: T. KELLEY
		DESIGNED BY: T. KELLEY	CHECKED BY: D. BRYANT
		MAINTENANCE OF TRAFFIC PROFILE	SHEET 17 OF 60