




ABUTMENT NO 1 REINFORCEMENT ELEVATION
SCALE: 3/8" = 1'-0"

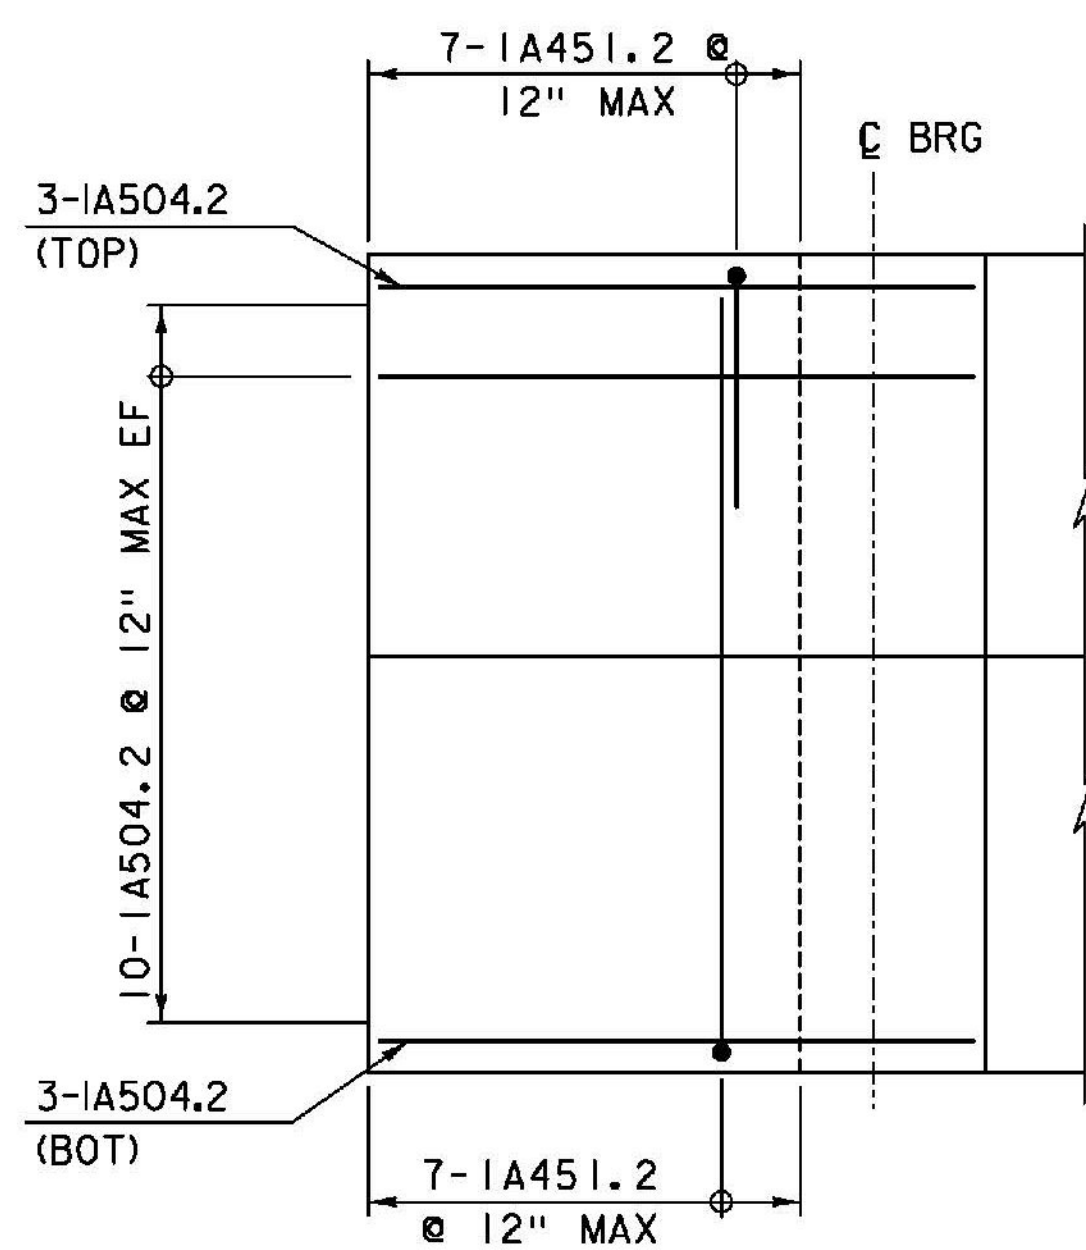

WINGWALL 1 - REINFORCEMENT ELEVATION
SCALE: 3/8" = 1'-0"

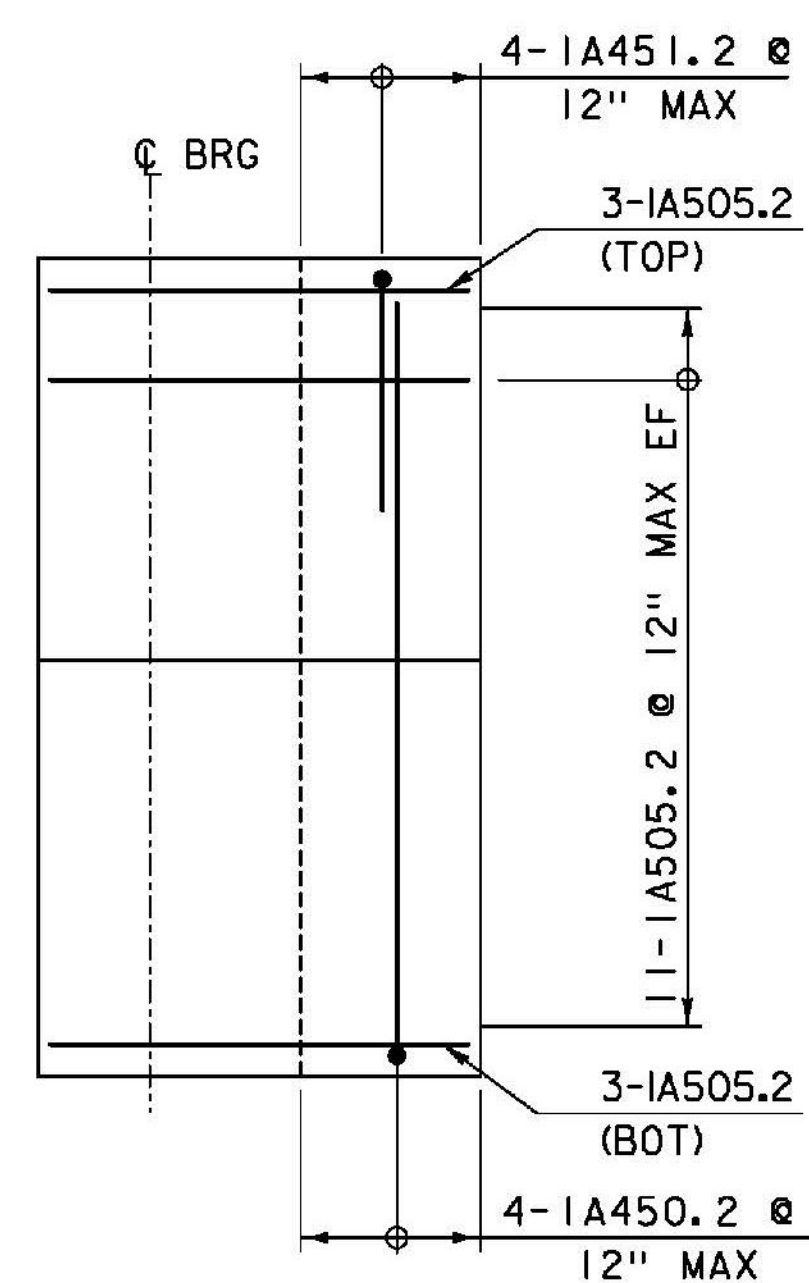

WINGWALL 2 - REINFORCEMENT ELEVATION
SCALE: 3/8" = 1'-0"

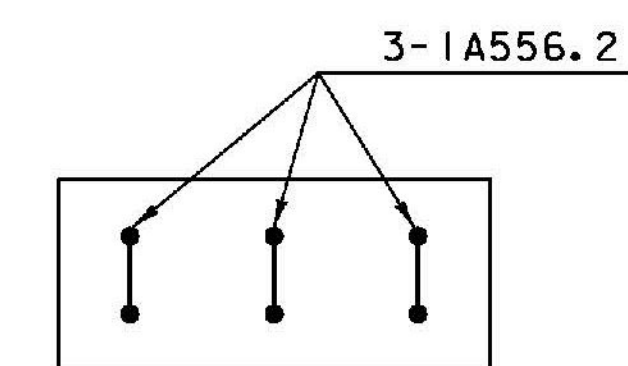

TYPICAL PEDESTAL REINFORCEMENT PLAN
SCALE: 1/2" = 1'-0"

TYLININTERNATIONAL

PROJECT NAME: HYDE PARK
PROJECT NUMBER: STP CULV(26)

FILE NAME: zllb292bdrabutr.dgn
PROJECT LEADER: R. HEBERT
DESIGNED BY: D. MYERS
ABUTMENT 1 - REINFORCEMENT

PLOT DATE: 11/6/2013
DRAWN BY: S. MORGAN
CHECKED BY: D. MYERS
SHEET 35 OF 60