



ABUTMENT NO. 2 PLAN

SCALE: 3/8" = 1'-0"
 NOTE: SEE ABUTMENT SECTIONS SHEET FOR SECTIONS A-A, B-B AND C-C

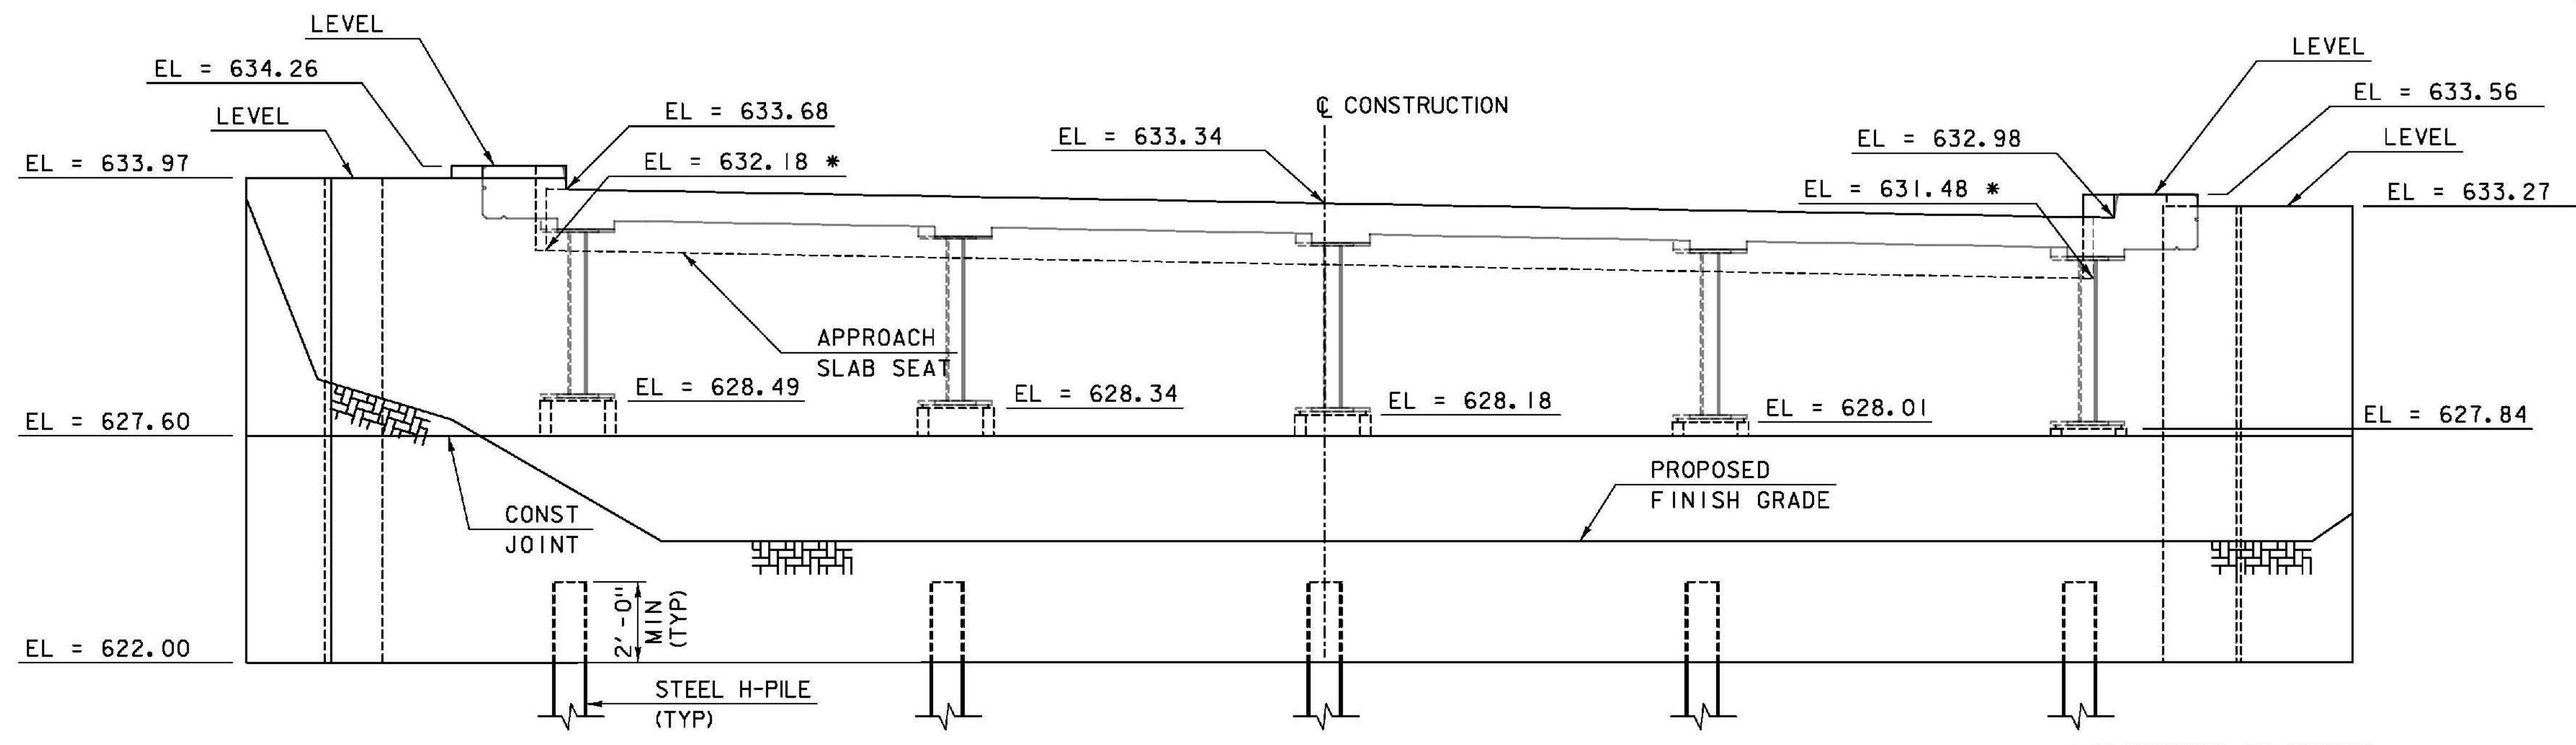

ABUTMENT NO. 2 ELEVATION

SCALE: 3/8" = 1'-0"
 NOTE: ELEVATIONS AT FRONT FACE OF ABUTMENT UNLESS OTHERWISE NOTED

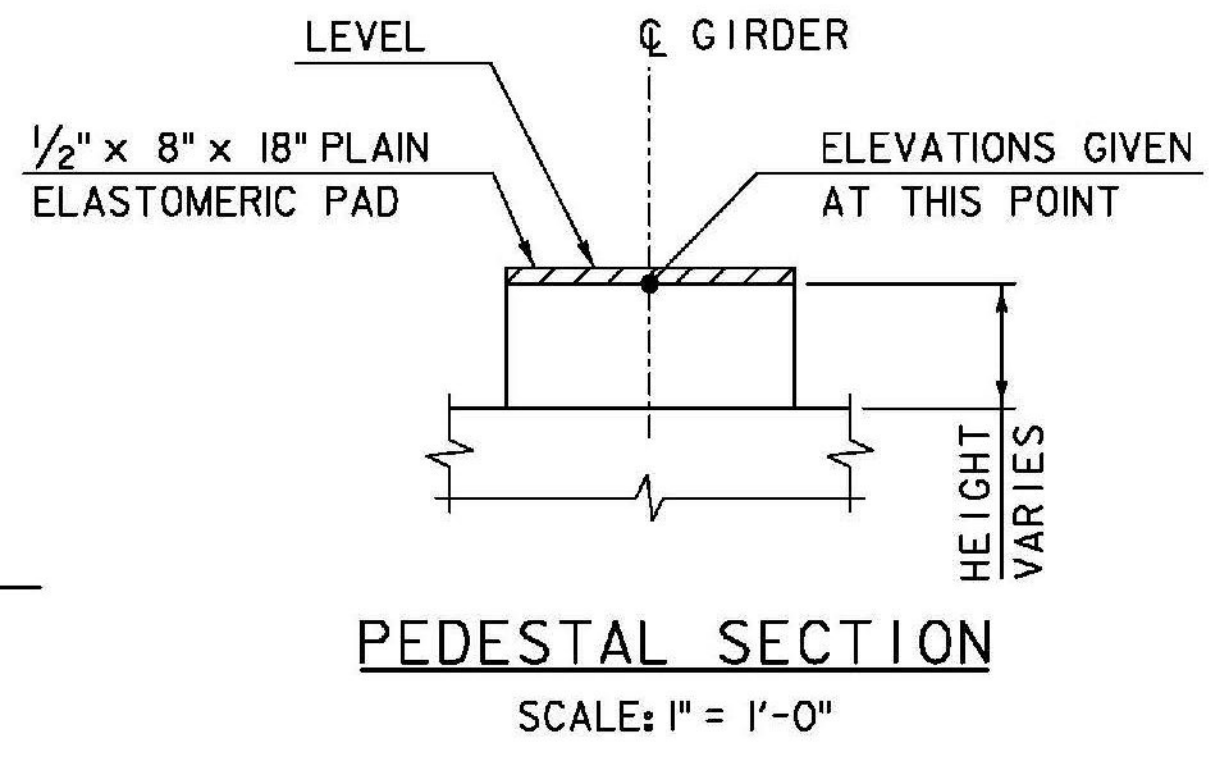

PEDESTAL SECTION

SCALE: 1" = 1'-0"

TYLIN INTERNATIONAL

PROJECT NAME: HYDE PARK	FILE NAME: zllb292bdrabut2.dgn	PLOT DATE: 11/6/2013
PROJECT NUMBER: STP CULV(26)	PROJECT LEADER: R. HEBERT	DRAWN BY: T. KELLEY
	DESIGNED BY: D. MYERS	CHECKED BY: J. OLUND
	ABUTMENT 2 PLAN AND ELEVATION	SHEET 36 OF 60