



SECTION A-A
 ABUTMENT - APPROACH SLAB
 SCALE: 1" = 1'-0"

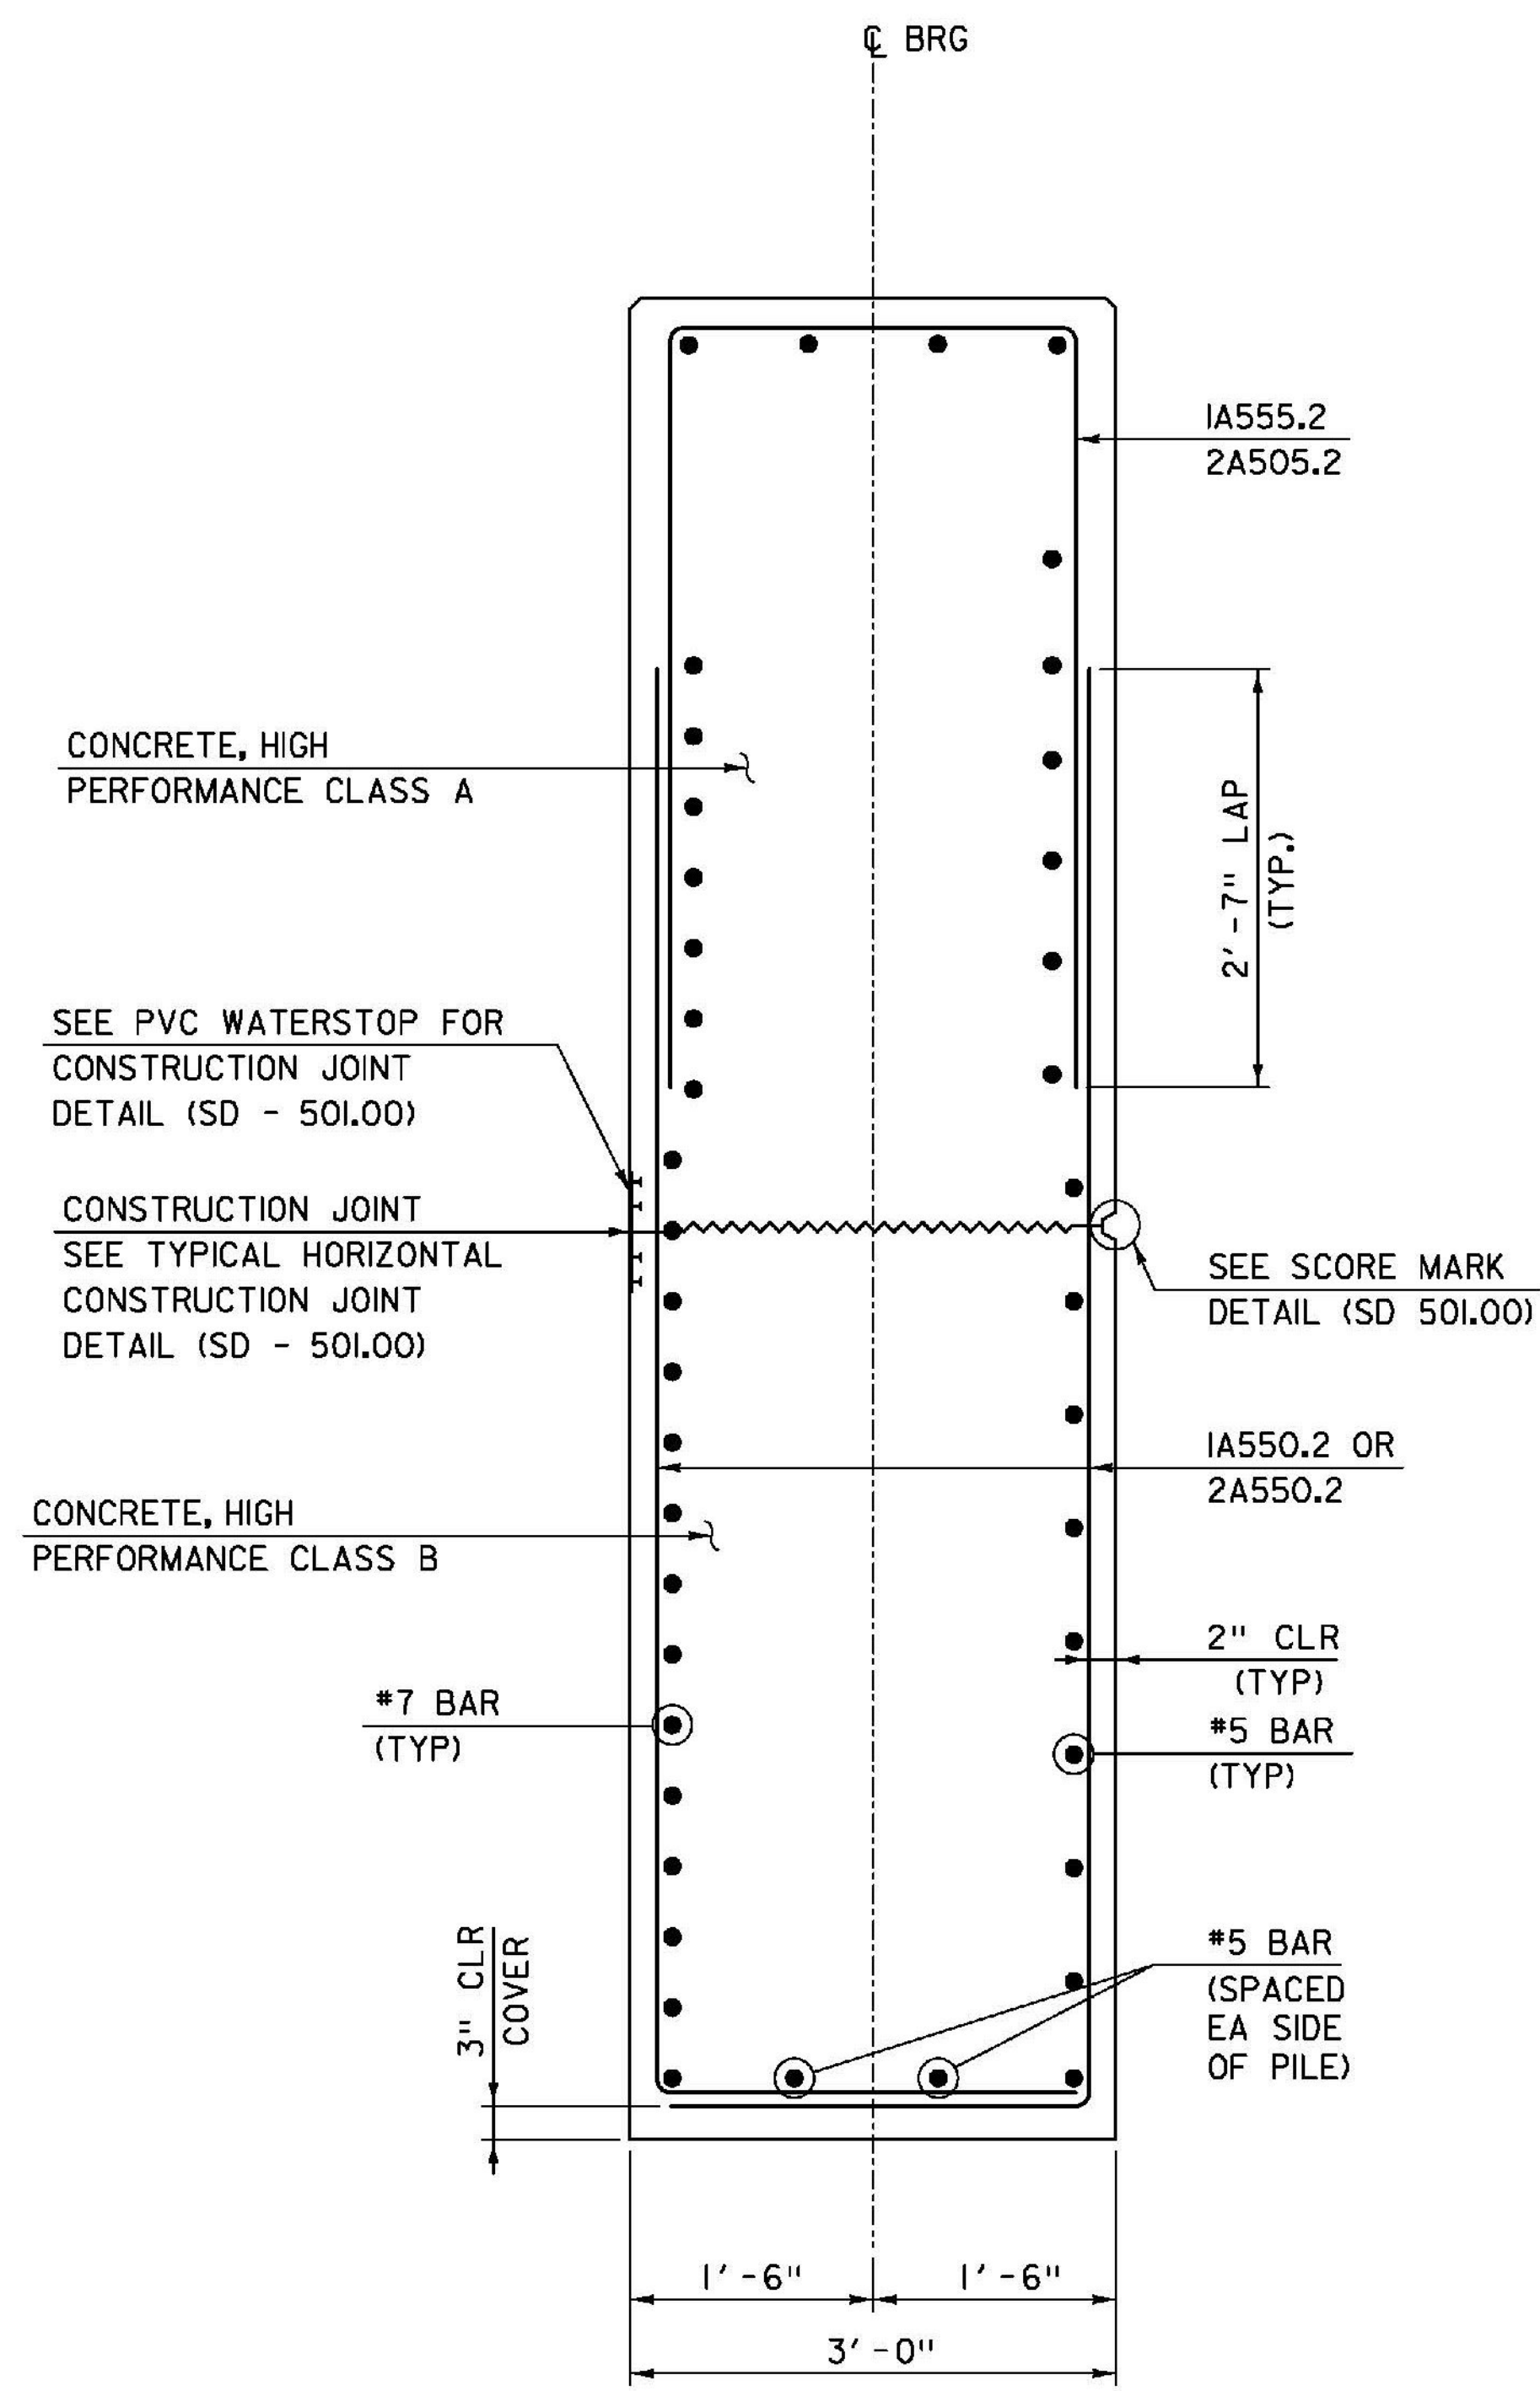

SECTION B-B
 ABUTMENT - BACKWALL
 SCALE: 1" = 1'-0"

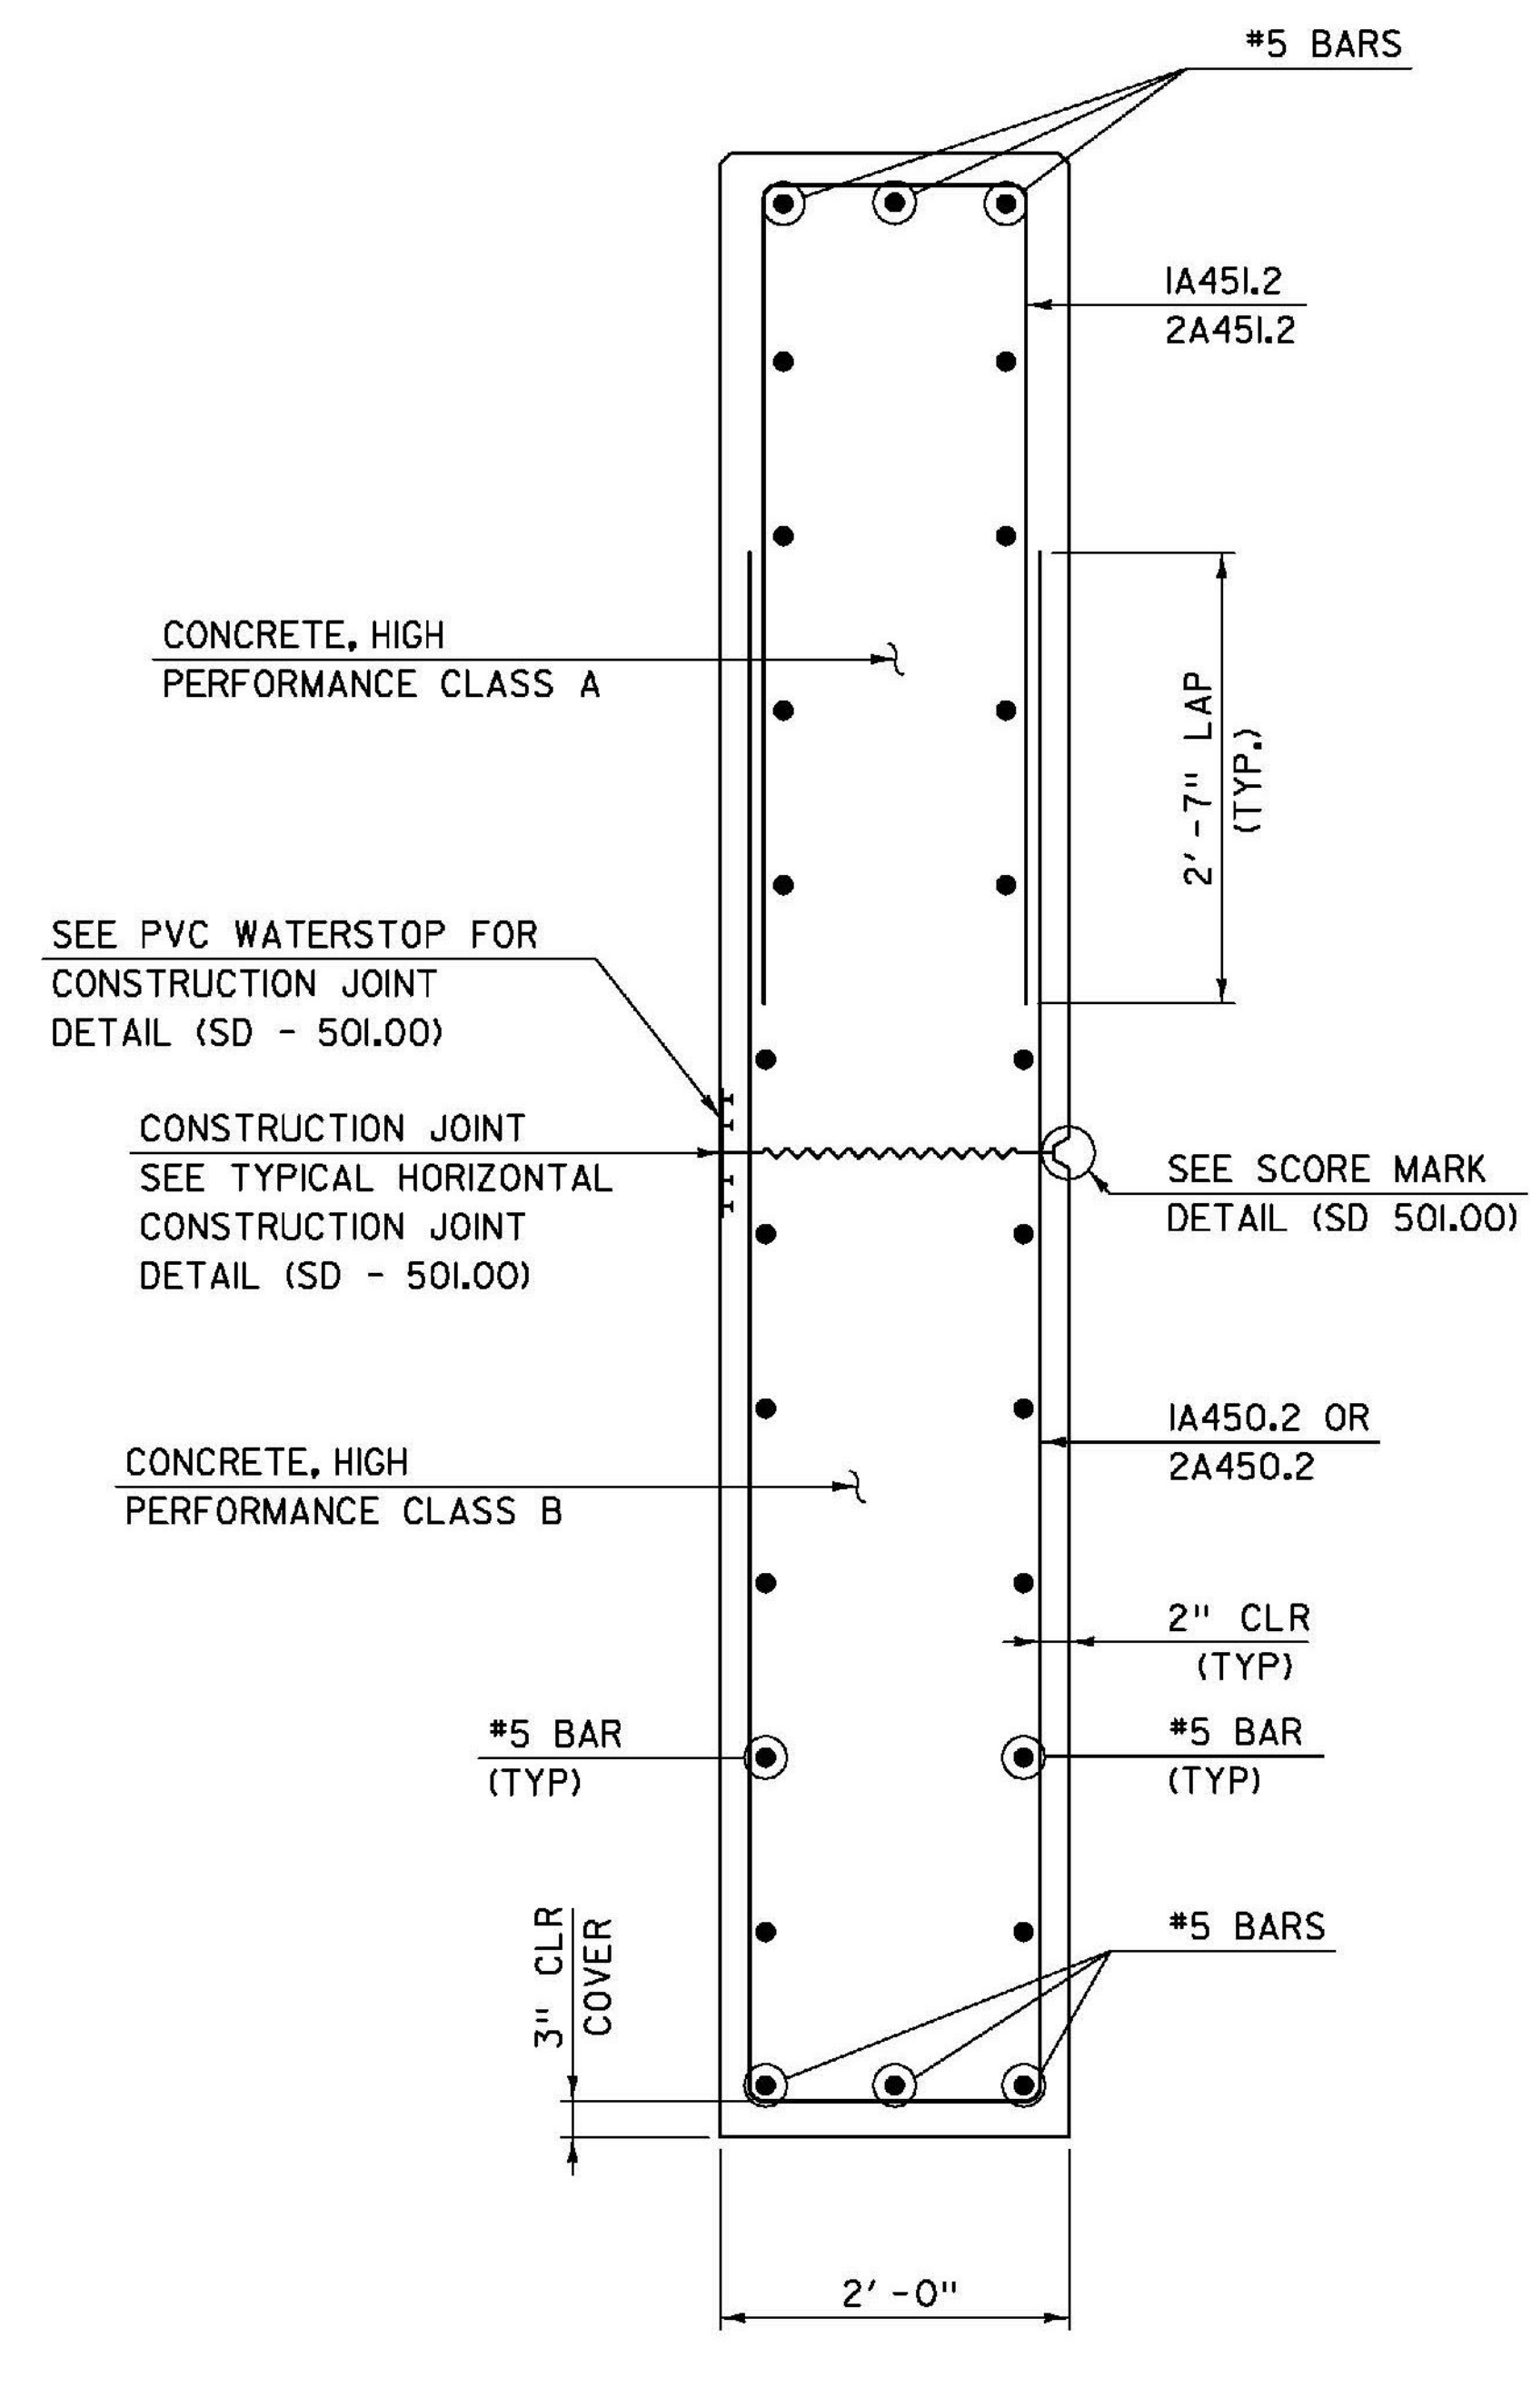

SECTION C-C
 WINGWALL TYPICAL
 SCALE: 1" = 1'-0"

TYLIN INTERNATIONAL

PROJECT NAME:	HYDE PARK	
PROJECT NUMBER:	STP CULV(26)	
FILE NAME:	zlib292bdrabutsect.dgn	PLOT DATE: 11/6/2013
PROJECT LEADER:	R. HEBERT	DRAWN BY: T. KELLEY
DESIGNED BY:	D. MYERS	CHECKED BY: D. MYERS
ABUTMENT SECTIONS		SHEET 38 OF 60