




1+00

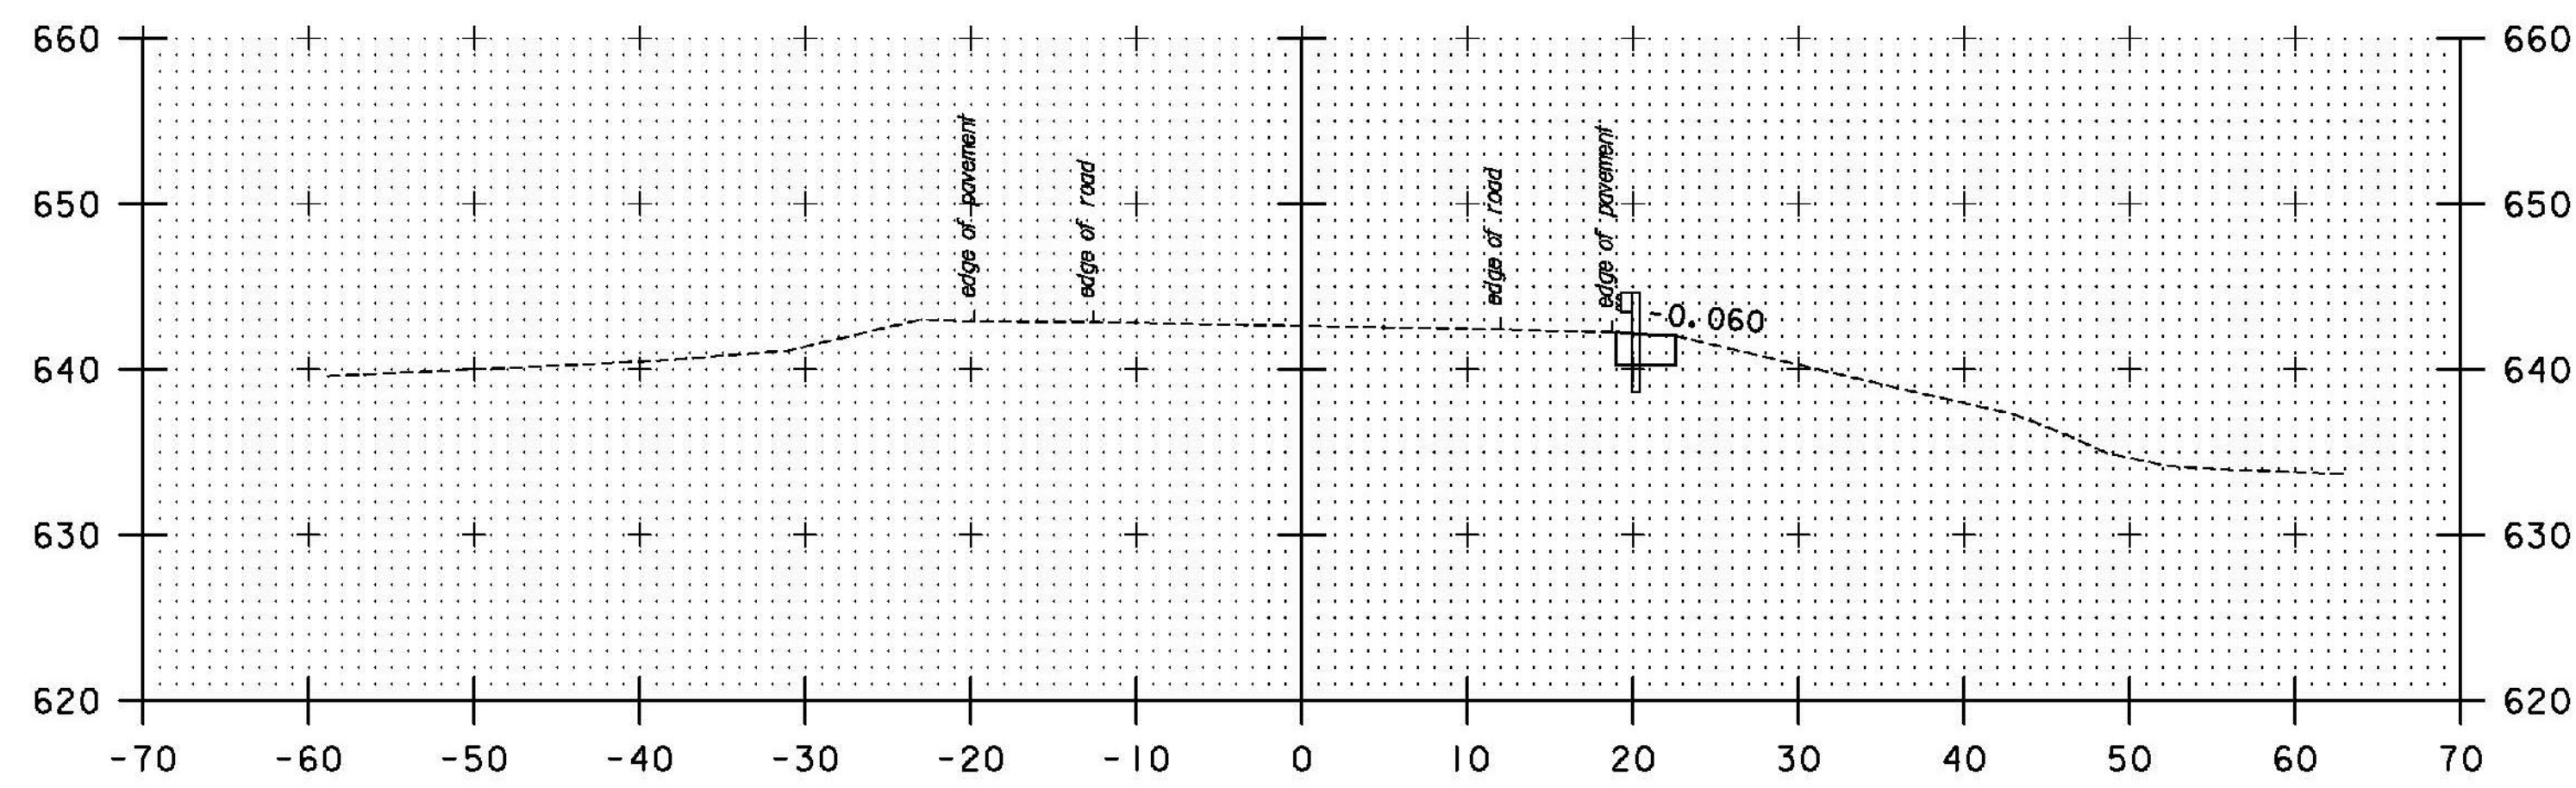

0+50

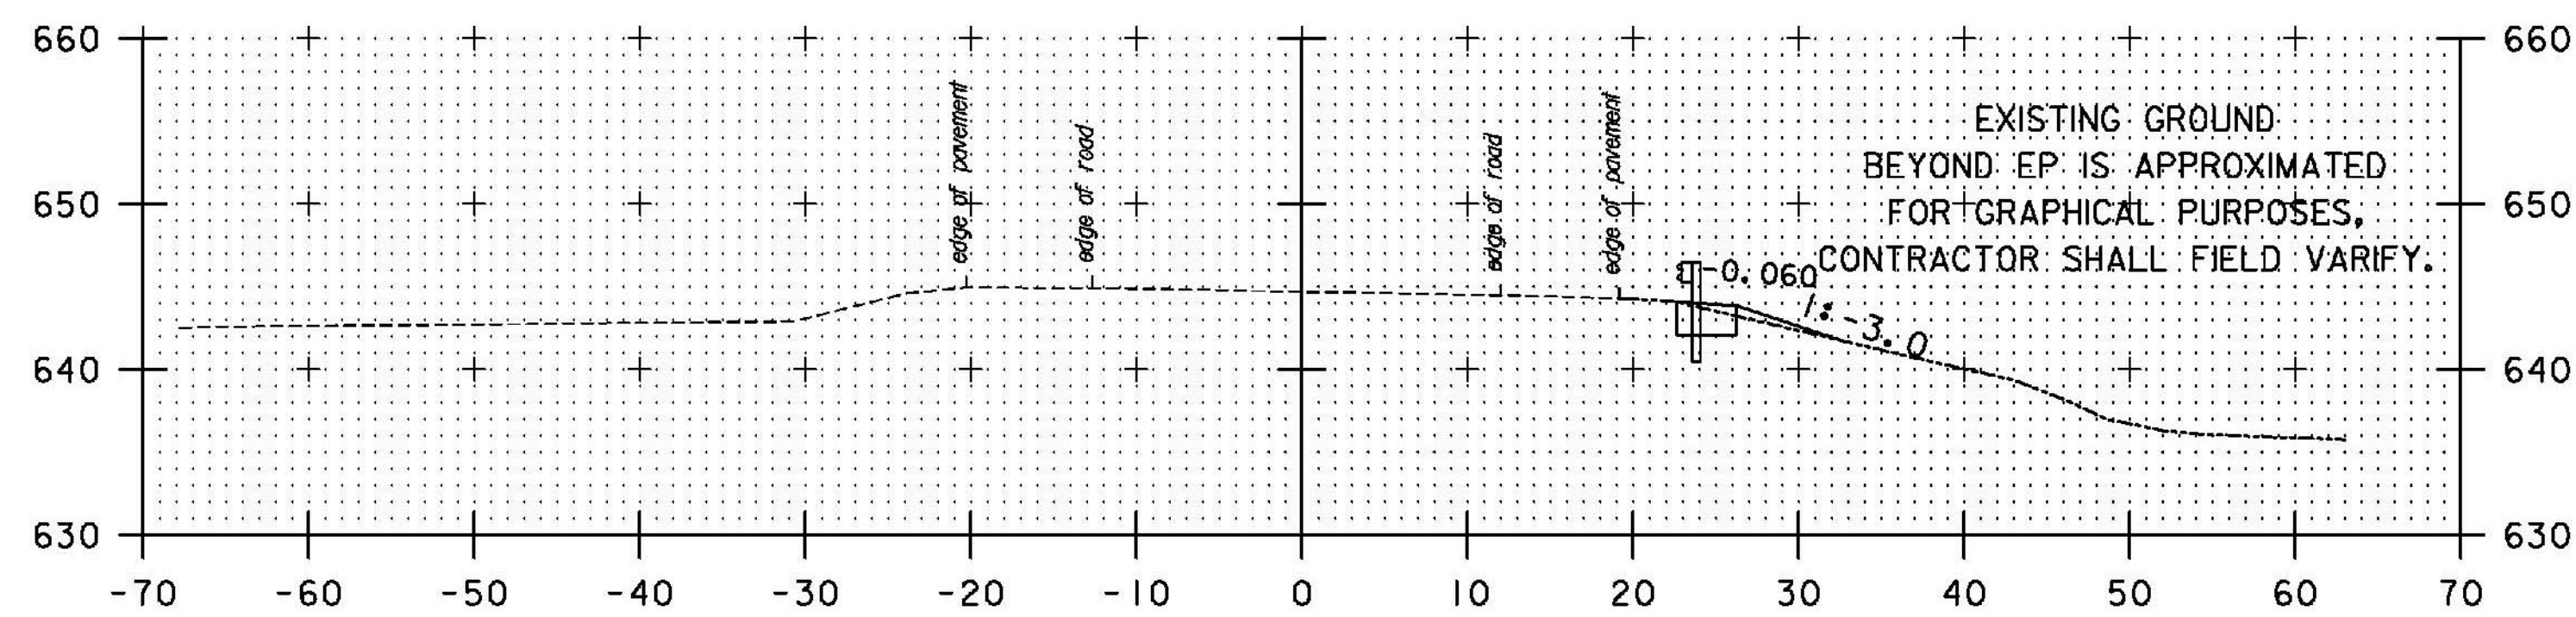


0+00

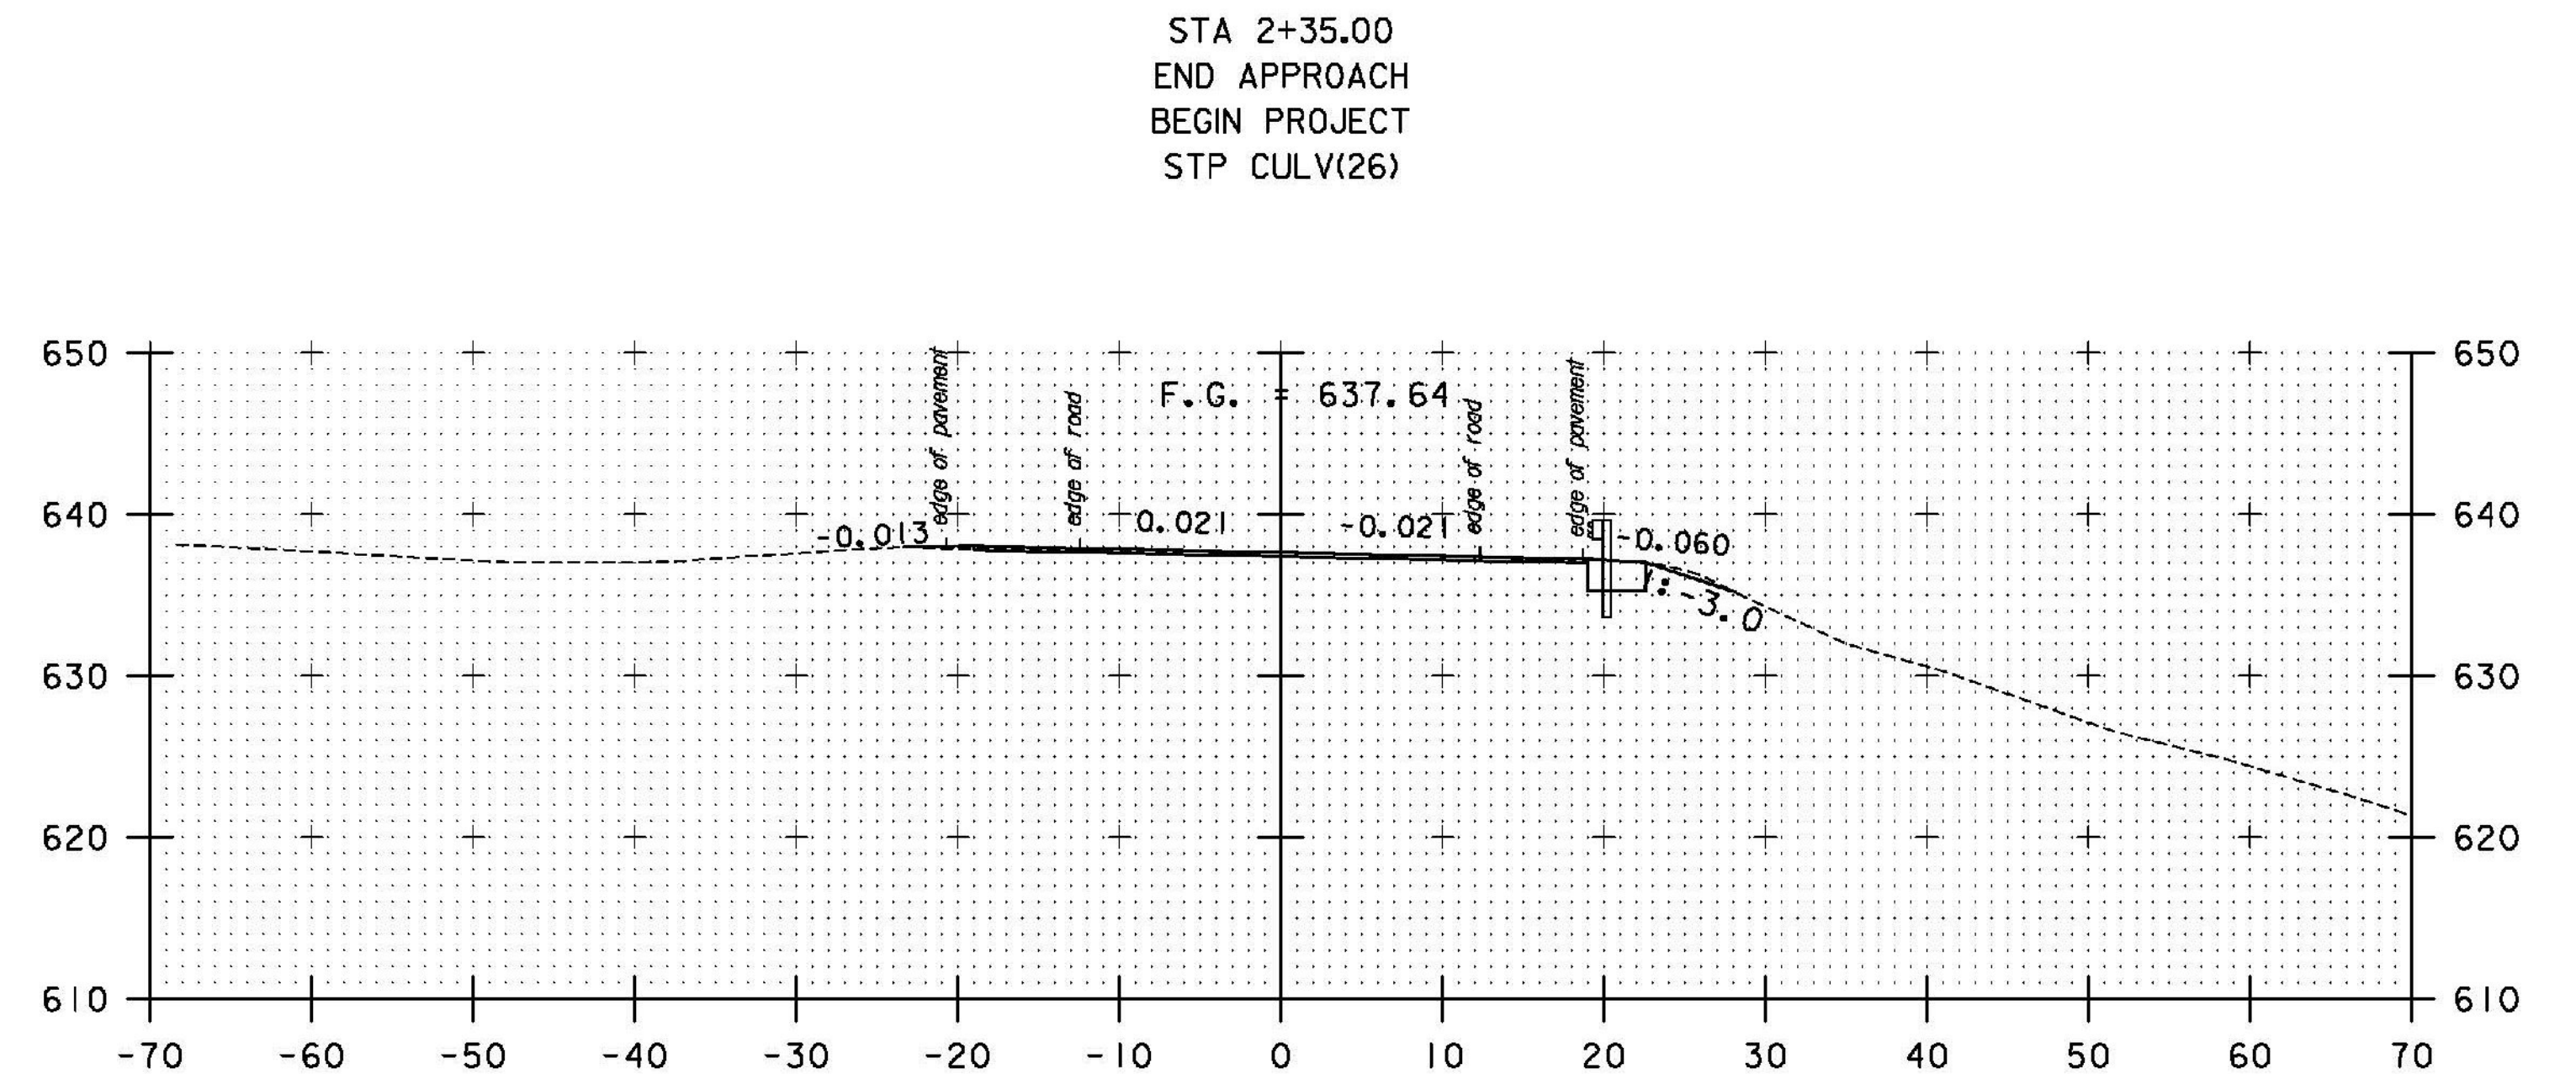

STA 2+35.00
END APPROACH
BEGIN PROJECT
STP CULV(26)

2+00
DRIVE LEFT

VT 15
STA 1+85.00
BEGIN APPROACH
MATCH EXISTING PAVEMENT

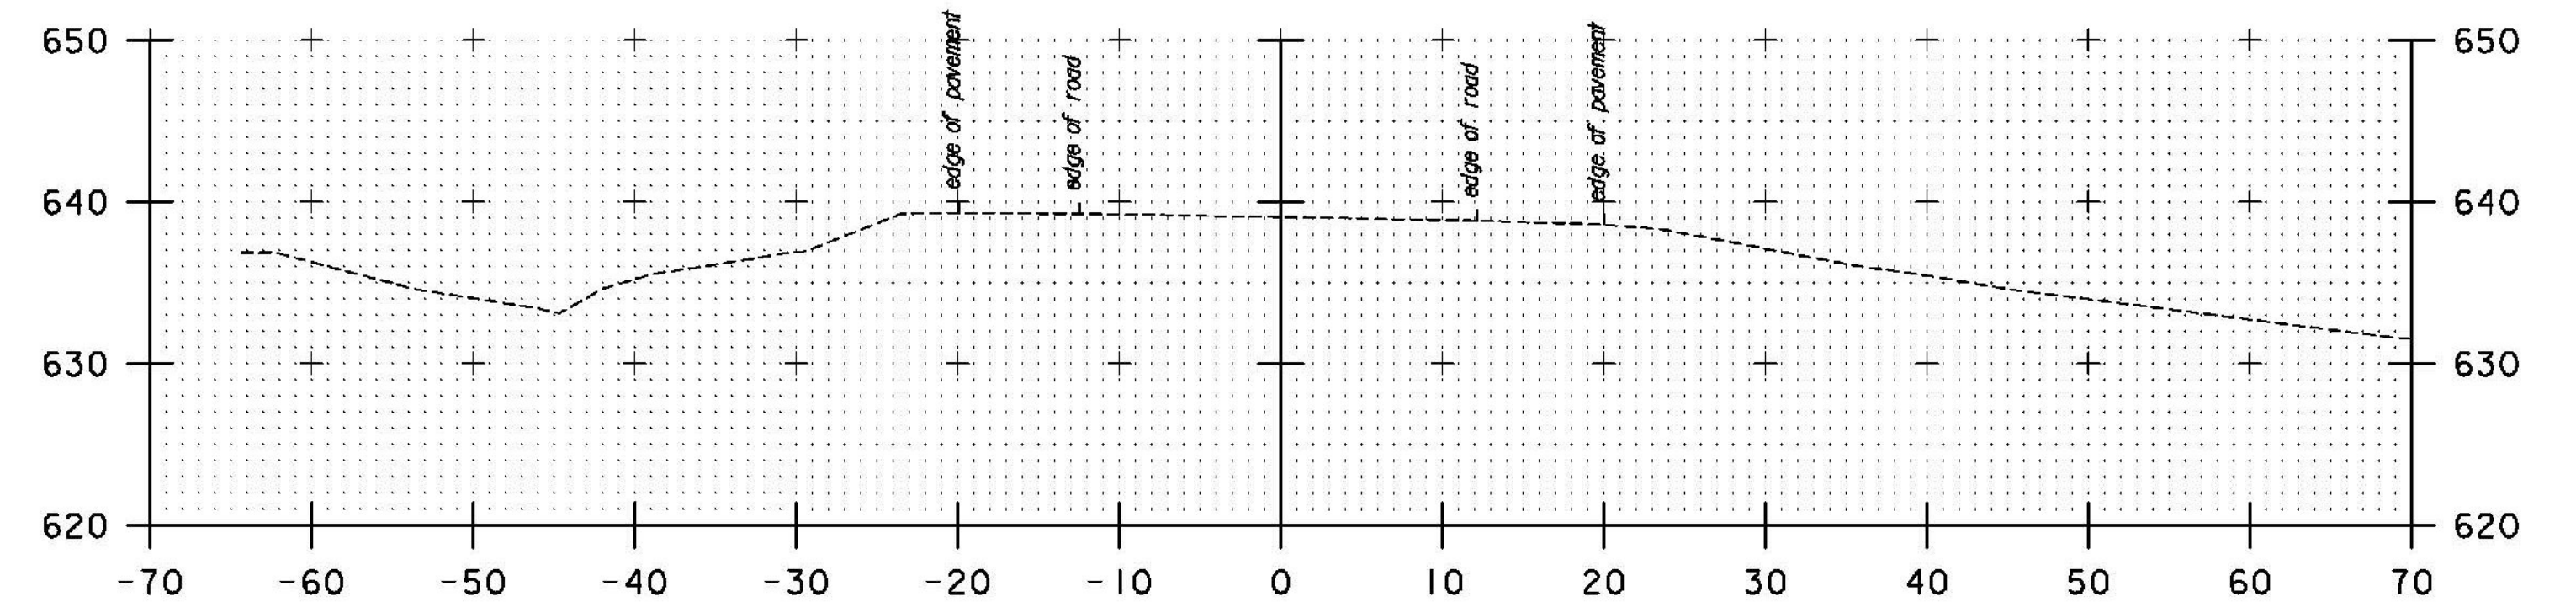

1+50
DRIVE RIGHT

STA. 0+00 TO STA. 2+00

SCALE 1" = 10' - 0"
10 0 10

TYLINTERNATIONAL

PROJECT NAME: HYDE PARK
PROJECT NUMBER: STP CULV(26)

FILE NAME: zllb292bdr_xs.dgn
PROJECT LEADER: R. HEBERT
DESIGNED BY: T. KELLEY
ROADWAY CROSS SECTIONS I

PLOT DATE: 11/6/2013
DRAWN BY: T. KELLEY
CHECKED BY: D. BRYANT
SHEET 41 OF 60