



4+50
 STA 4+17.52
 END BRIDGE
 RESUME ROADWAY

STA 2+88.48
 STOP ROADWAY
 BEGIN BRIDGE

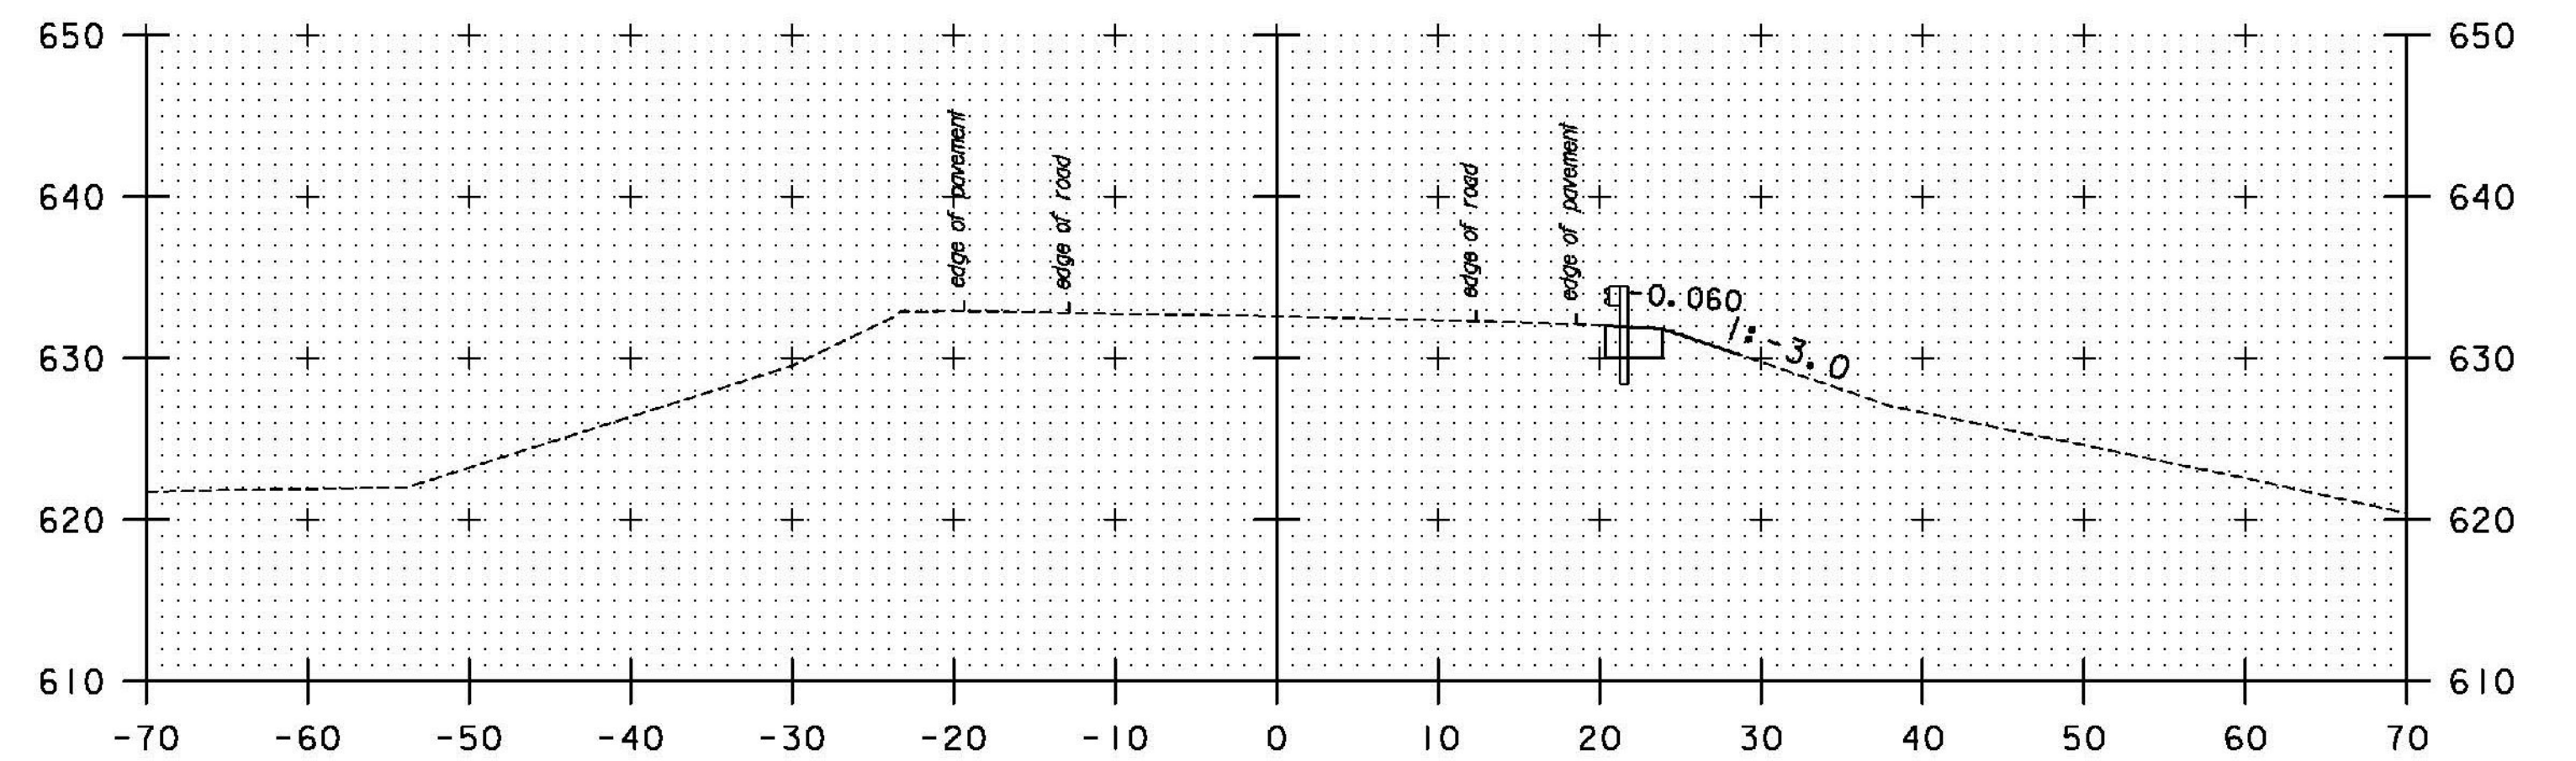


5+50

VT 15
 STA 5+20.00
 END APPROACH
 MATCH EXISTING PAVEMENT

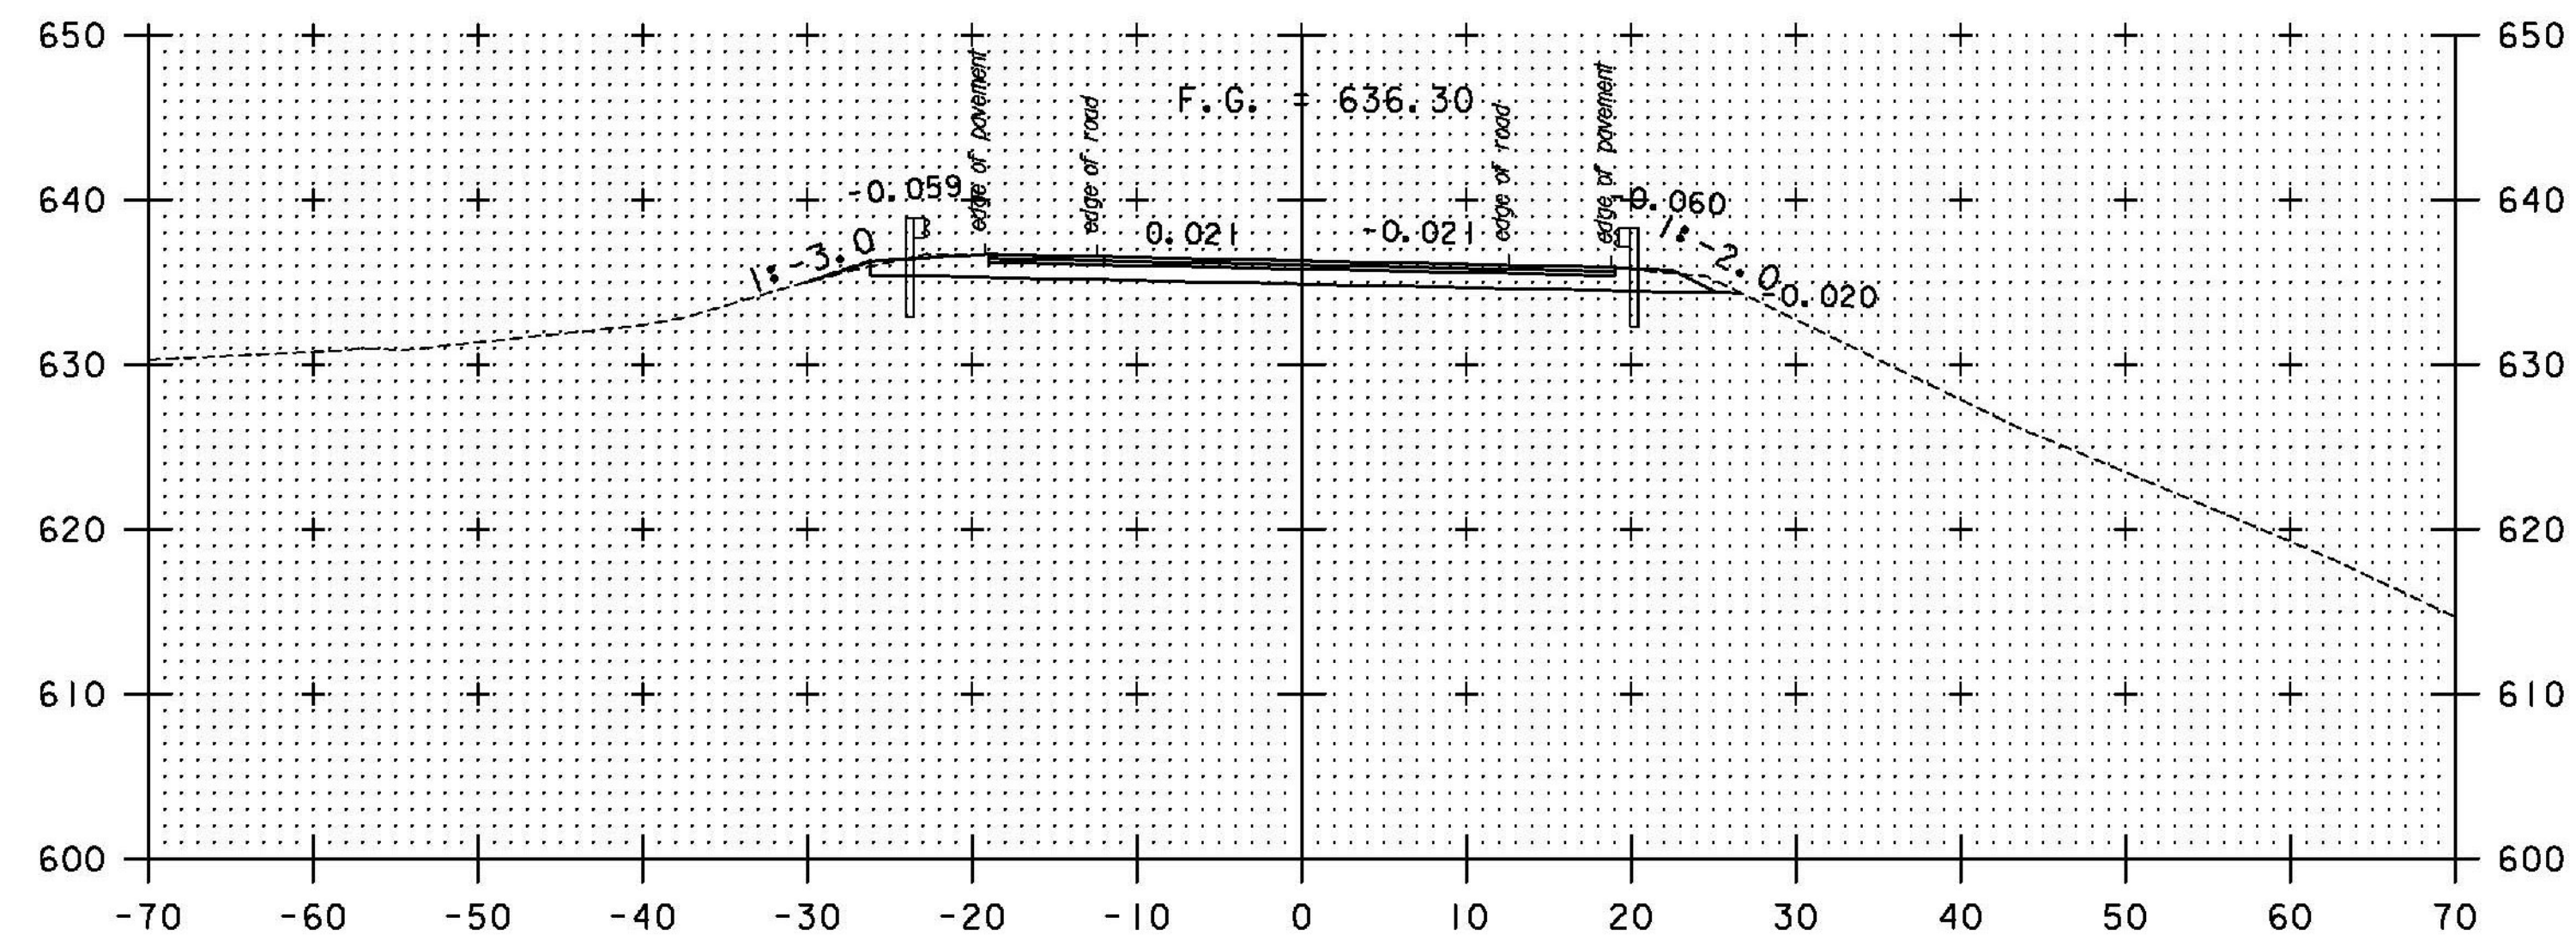

2+50

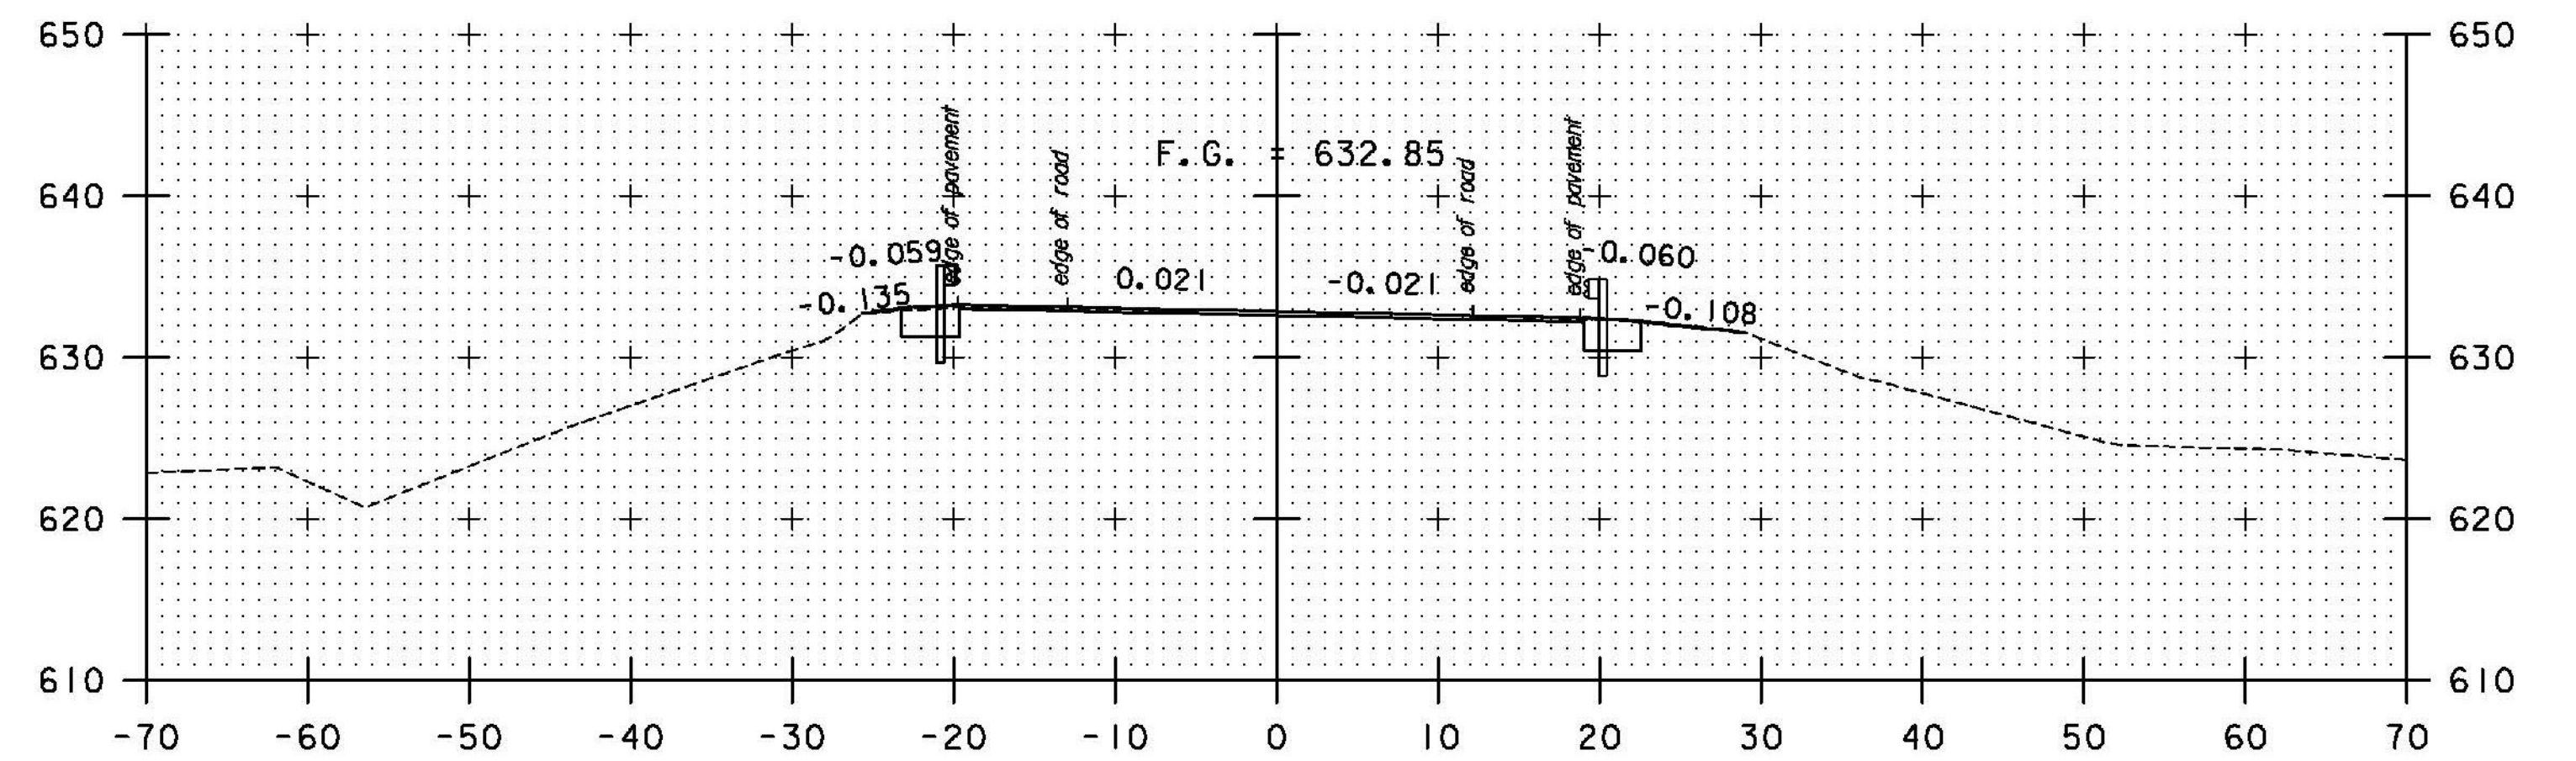

5+00

STA 4+70.00
 END PROJECT
 STP CULV(26)
 BEGIN APPROACH

+52.72
 35.33' RT
 3" LOCUST (REMOVE)
 +64.81
 34.85' RT
 3" LOCUST (REMOVE)

STA. 2+50 TO STA. 5+50

SCALE 1" = 10'-0"
 10 0 10

TYLIN INTERNATIONAL

PROJECT NAME: HYDE PARK
 PROJECT NUMBER: STP CULV(26)

FILE NAME: zllb292bdr_xs.dgn
 PROJECT LEADER: R. HEBERT
 DESIGNED BY: T. KELLEY
 ROADWAY CROSS SECTIONS 2

PLOT DATE: 11/6/2013
 DRAWN BY: T. KELLEY
 CHECKED BY: D. BRYANT
 SHEET 42 OF 60