


51+25

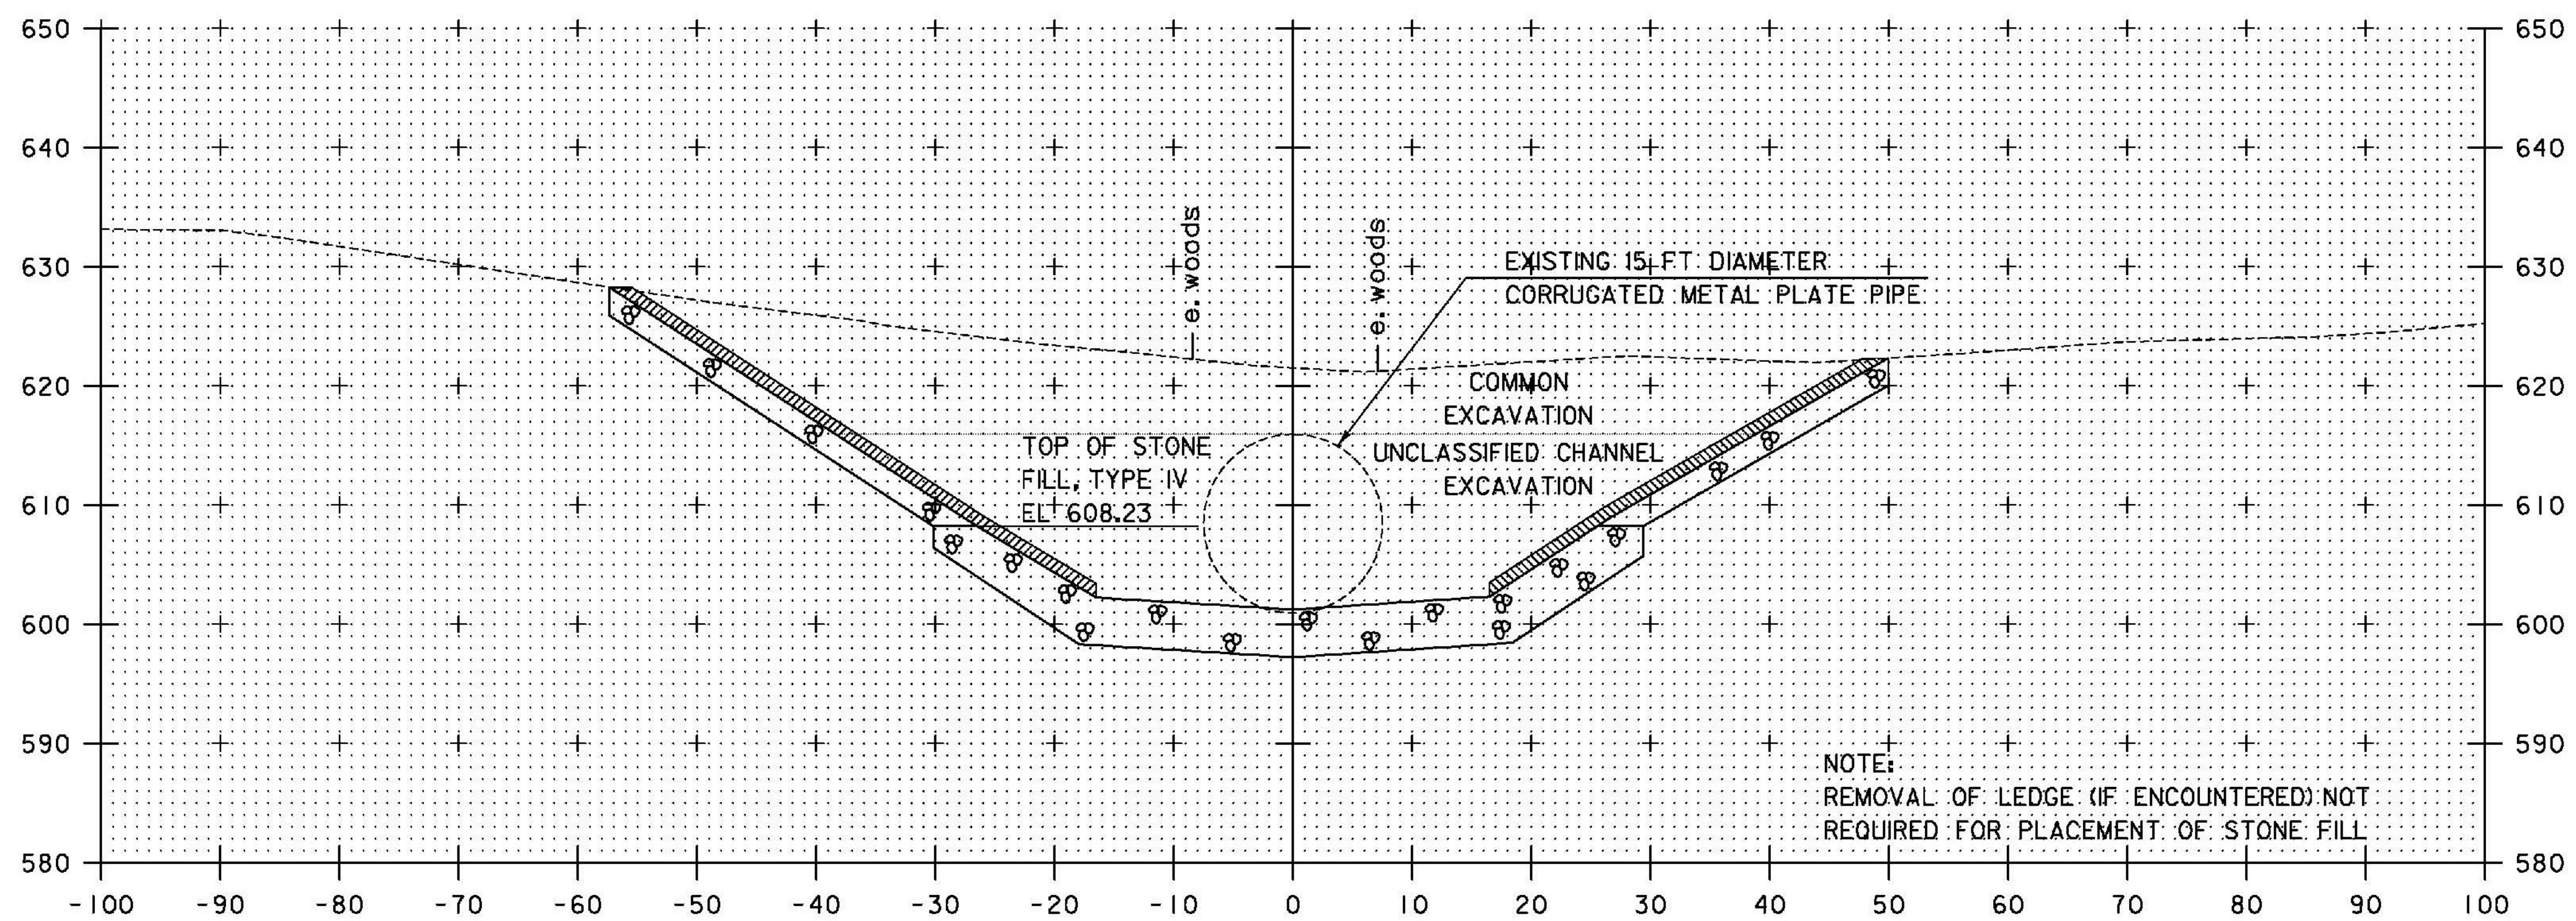

STATION 50+80
BEGIN COMMON EXCAVATION 51+00

STA. 51+00 TO STA. 51+25

TYLINTERNATIONAL

PROJECT NAME: HYDE PARK
PROJECT NUMBER: STP CULV(26)

FILE NAME: z1lb292bdrxschan.dgn
PROJECT LEADER: R. HEBERT
DESIGNED BY: J. OLUND
CHANNEL CROSS SECTIONS - 2

PLOT DATE: 11/6/2013
DRAWN BY: S. MORGAN
CHECKED BY: J. OLUND
SHEET 44 OF 60