


51+75

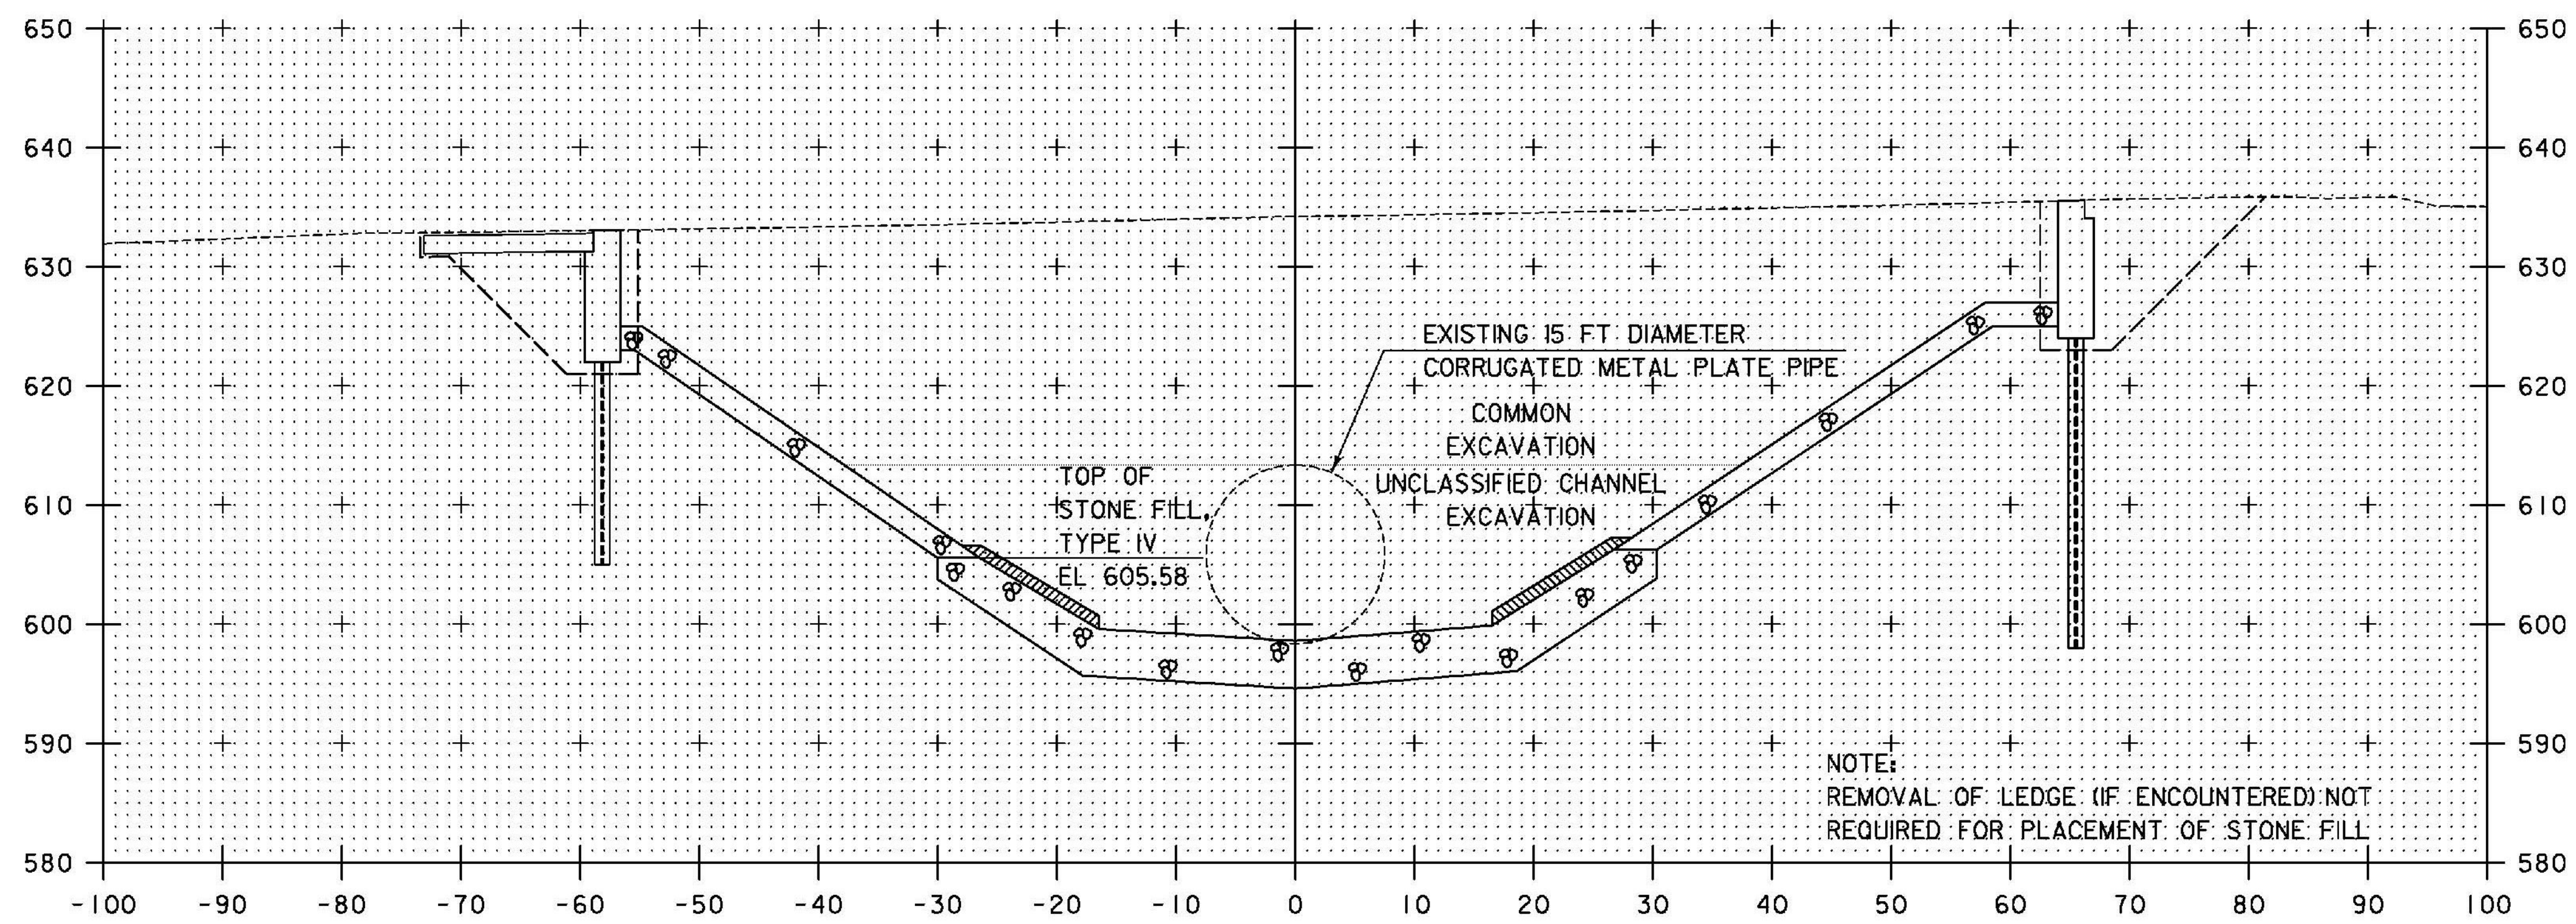

51+50
(CENTER OF BRIDGE)

STA. 51+50 TO STA. 51+75

TYLINTINTERNATIONAL

PROJECT NAME: HYDE PARK
PROJECT NUMBER: STP CULV(26)

FILE NAME: zlb292bdrxschan.dgn
PROJECT LEADER: R. HEBERT
DESIGNED BY: J. OLUND
CHANNEL CROSS SECTIONS - 3

PLOT DATE: 11/6/2013
DRAWN BY: S. MORGAN
CHECKED BY: J. OLUND
SHEET 45 OF 60