


52+25

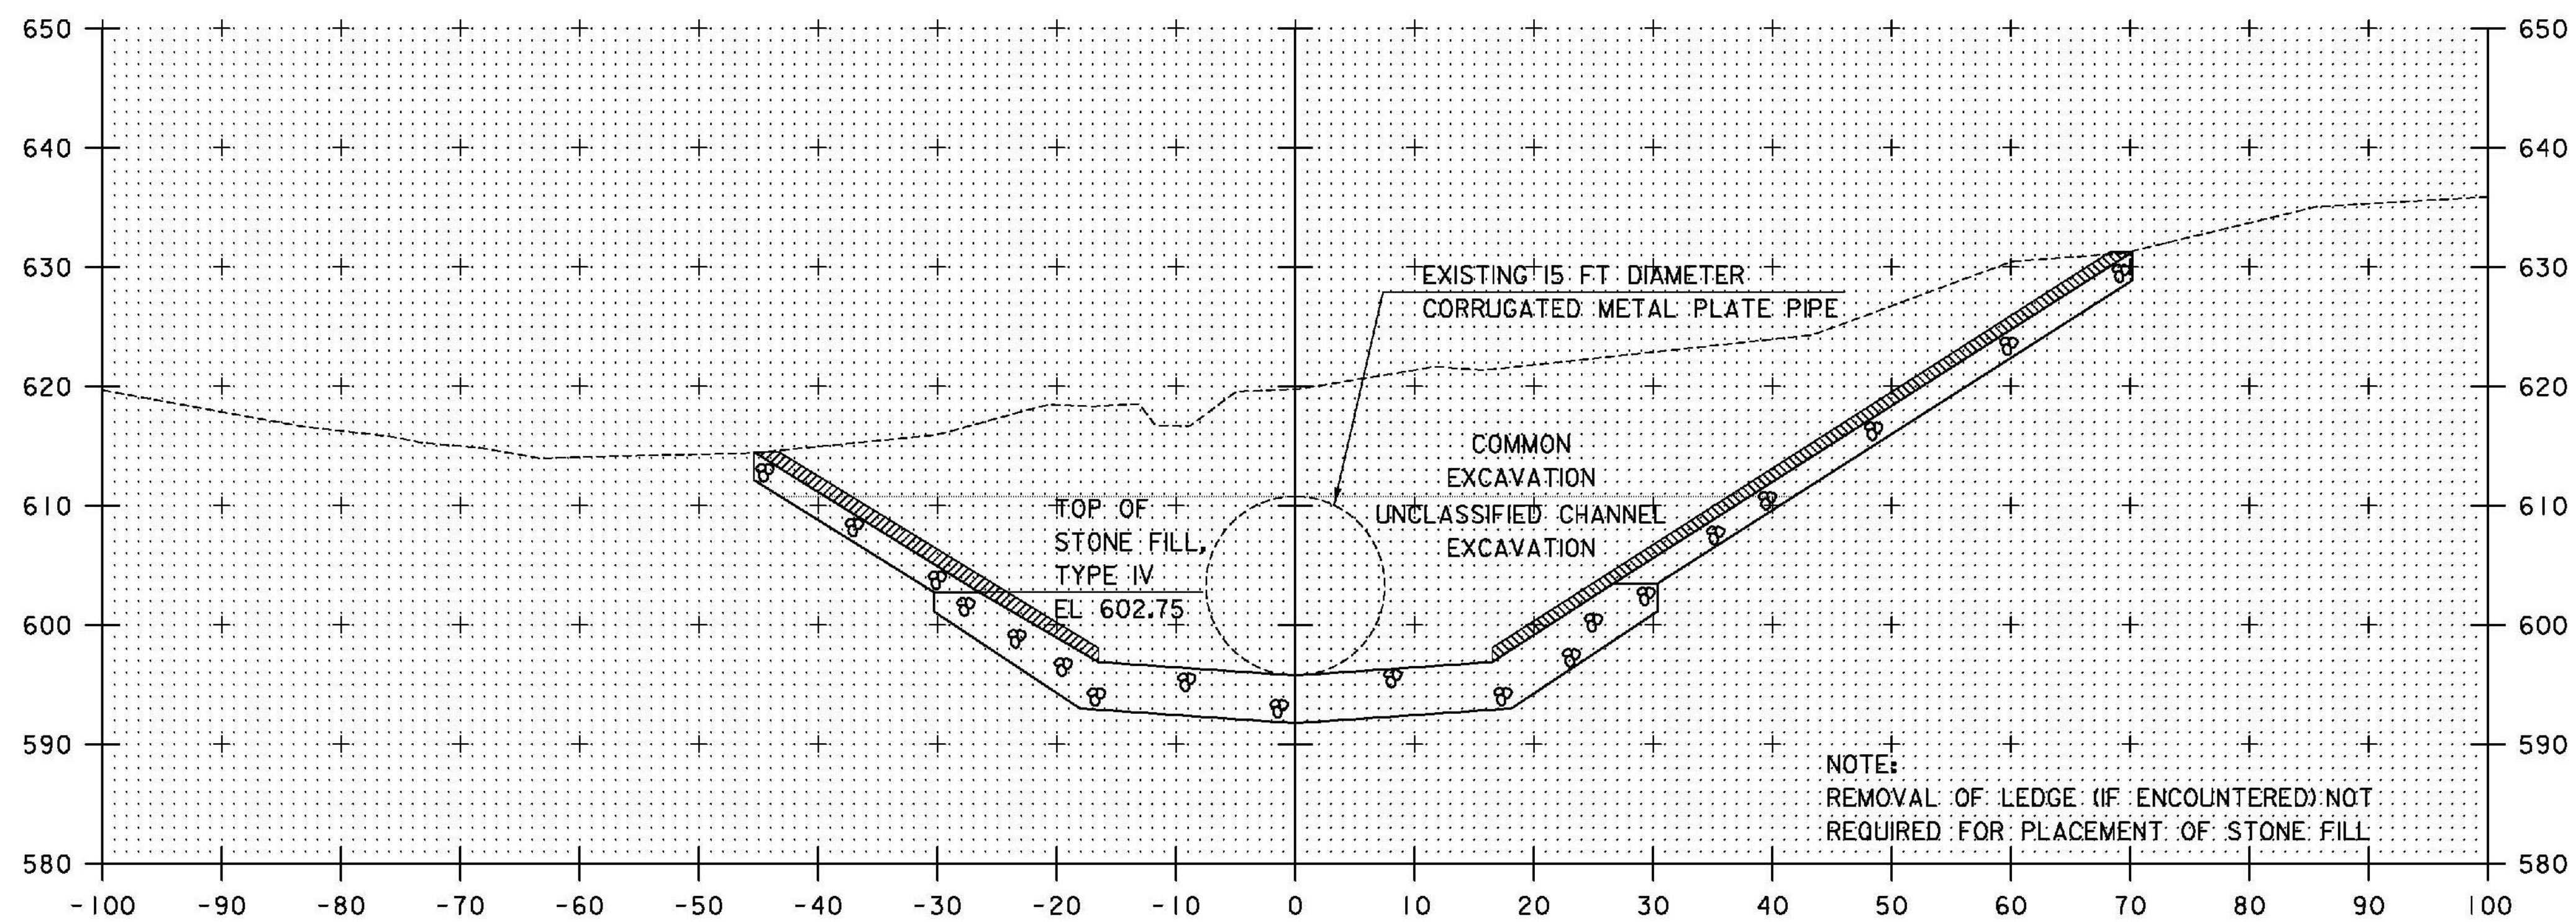

52+00

STA. 52+00 TO STA. 52+25

TYLIN INTERNATIONAL

PROJECT NAME: HYDE PARK
PROJECT NUMBER: STP CULV(26)

FILE NAME: zlb292bdrxschan.dgn
PROJECT LEADER: R. HEBERT
DESIGNED BY: J. OLUND
CHANNEL CROSS SECTIONS - 4

PLOT DATE: 11/6/2013
DRAWN BY: S. MORGAN
CHECKED BY: J. OLUND
SHEET 46 OF 60