


MATCH LINE STA. 4+50.00

LEGEND:
 ARCH ——— ARCHAEOLOGICAL RESOURCE LIMIT
 [Hatched Box] CLASS II WETLAND

NOTES:
 1. ORDINARY HIGH WATER ELEVATION = VARIES
 2. COUNTOURS REFLECT EXISTING CONDITIONS.

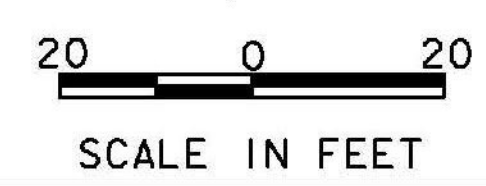

TYLININTERNATIONAL

PROJECT NAME: HYDE PARK	PLOT DATE: 11/6/2013
PROJECT NUMBER: STP CULV(26)	DRAWN BY: D. BRYANT
FILE NAME: zllb292bdr_ero.dgn	CHECKED BY: D. BURHANS
PROJECT LEADER: R. HEBERT	SHEET 51 OF 60
DESIGNED BY: D. BRYANT	
EPSC EXISTING CONDITIONS SITE PLAN I	