


LEGEND:
 ARCH ——— ARCHAEOLOGICAL RESOURCE LIMIT
 CLASS II WETLAND

NOTES:
 I. COUNTOURS REFLECT EXISTING CONDITIONS.

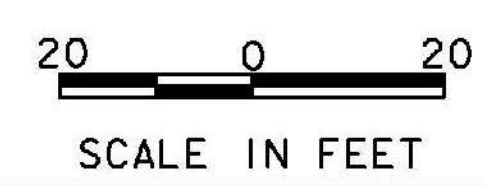

TYLININTERNATIONAL

PROJECT NAME: HYDE PARK	FILE NAME: zllb292bdr_ero.dgn	PLOT DATE: 11/6/2013
PROJECT NUMBER: STP CULV(26)	PROJECT LEADER: R. HEBERT	DRAWN BY: D. BRYANT
	DESIGNED BY: D. BRYANT	CHECKED BY: D. BURHANS
	EPSC EXISTING CONDITIONS SITE PLAN 2	SHEET 52 OF 60