

GEOTEXTILE FOR SILT FENCE,
WOVEN WIRE REINFORCED

46+90.75 LT - 46+90.92 LT = 17.4 SF
47+04.31 LT - 47+17.93 LT = 43.8 SF

GEOTEXTILE FOR SILT FENCE

4+50.00 RT - 5+48.39 RT = 258.9 SF
5+47.15 RT - 5+90.67 RT = 115.5 SF
5+90.65 RT - 7+27.62 RT = 363.3 SF
47+17.93 LT - 47+41.84 LT = 68.1 SF
47+45.42 LT - 47+70.77 LT = 91.1 SF
47+80.84 LT - 48+27.16 LT = 134.6 SF
48+34.25 LT - 48+79.24 LT = 116.1 SF
48+81.75 LT - 49+15.94 LT = 86.4 SF
49+16.27 LT - 49+39.45 LT = 78.2 SF

PROJECT DEMARCATION FENCE

47+18.35 LT - 49+85.58 LT = 316.35 LF
4+50.00 RT - 7+27.62 RT = 299.38 LF

TEMPORARY STONE CHECK DAMS, TYPE I



46+67 RT - 49+09 RT
46+75 LT - 49+09 LT

BARRIER FENCE


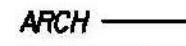






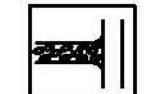

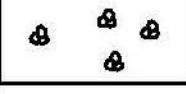
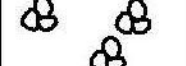
46+66.34 LT - 47.18.35 LT = 56.84 LF

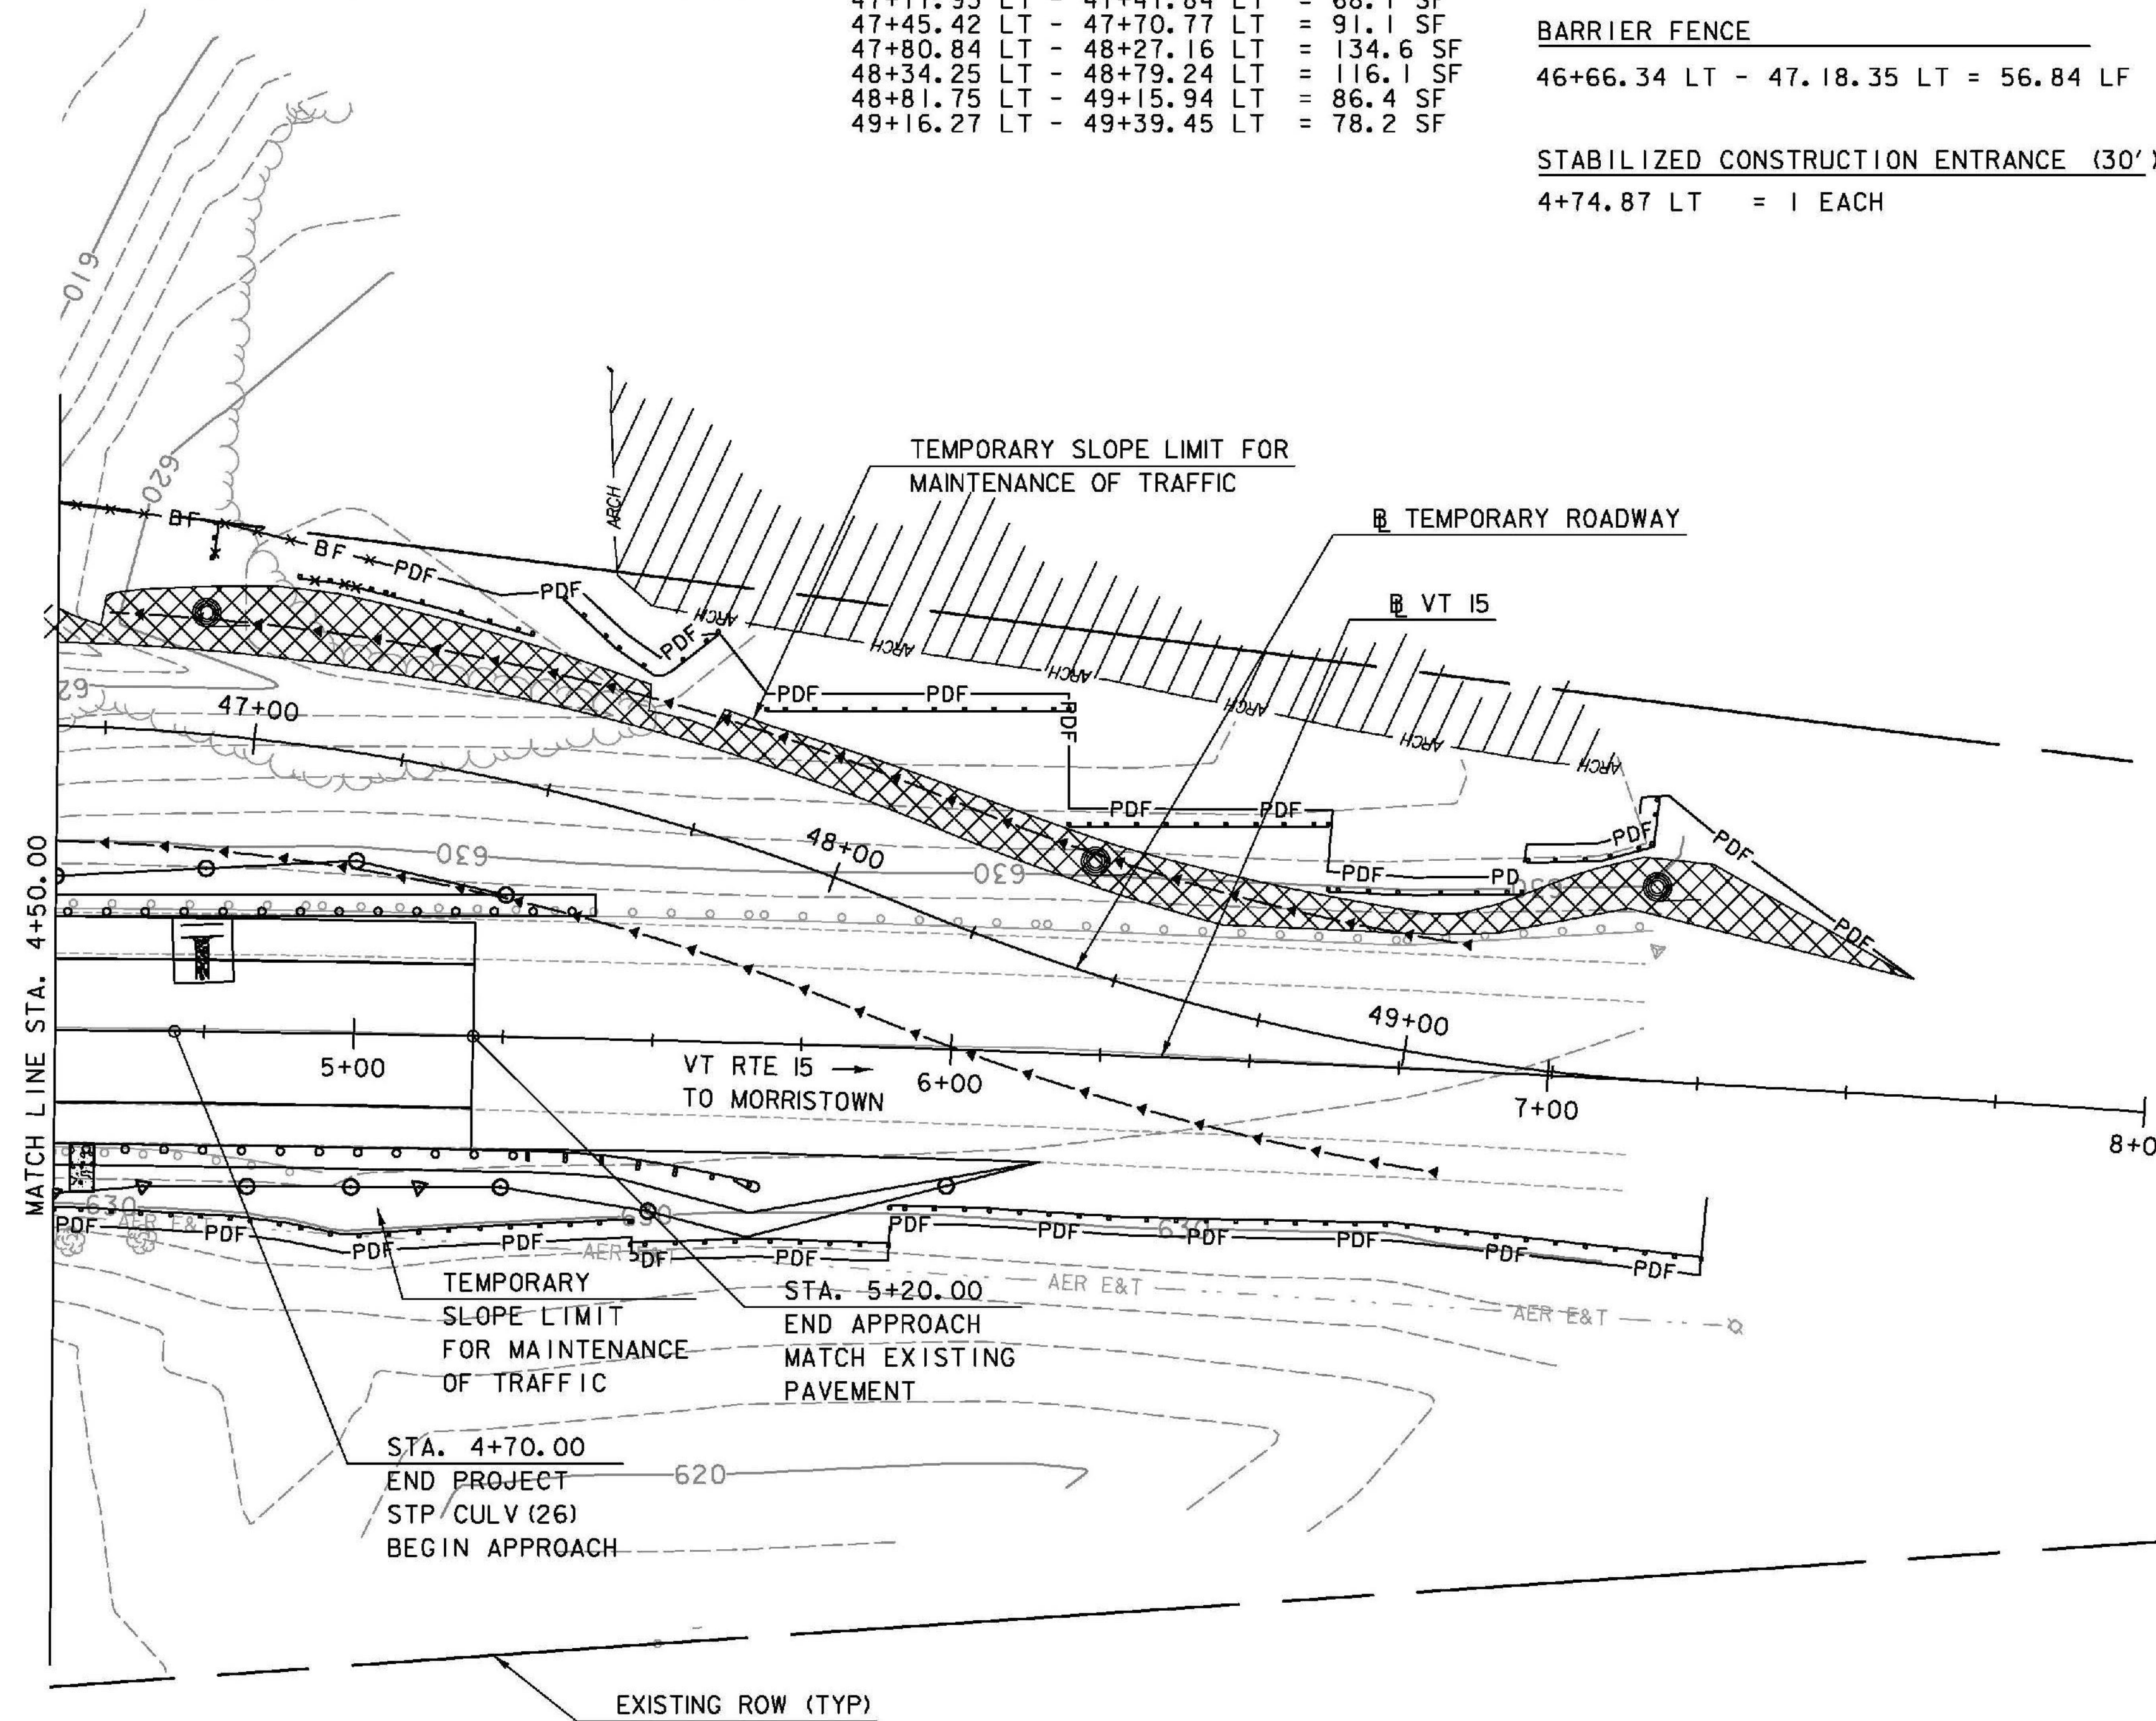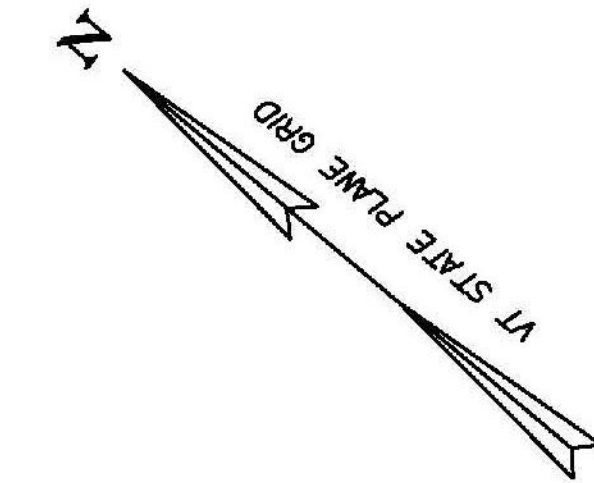STABILIZED CONSTRUCTION ENTRANCE (30')

4+74.87 LT = 1 EACH

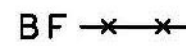


LEGEND:

-  FILTER BAG
-  ARCH ——— ARCHAEOLOGICAL RESOURCE LIMIT
-  CLASS II WETLAND
-  PDF ——— PROJECT DEMARCATION FENCE
-  BF ——— BARRIER FENCE
-  ——— SILT FENCE
-  ——— SILT FENCE, WOVEN WIRE
-  ——— CHECK DAMS
-  STABILIZED CONSTRUCTION ENTRANCE (USED IN PHASE I ONLY)
-  TEMPORARY EROSION MATTING (SEE NOTES ON EPSC NARRATIVE)
-  STONE FILL, TYPE II
-  STONE FILL, TYPE IV

NOTES:

1. TEMPORARY EROSION MATTING TO BE USED ON SLOPES STEEPER THAN 3:1.
2. CONTOURS REFLECT EXISTING CONDITIONS. SEE CROSS SECTIONS FOR FINAL GRADES.
3. ORDINARY HIGH WATER ELEVATION = 606.9

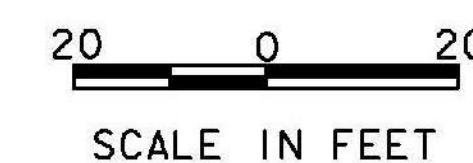

TYLININTERNATIONAL

PROJECT NAME: HYDE PARK
PROJECT NUMBER: STP CULV(26)

FILE NAME: zllb292bdr_ero.dgn
PROJECT LEADER: R. HEBERT
DESIGNED BY: D. BRYANT
EPSC CONSTRUCTION SITE PLAN 2

PLOT DATE: 11/6/2013
DRAWN BY: D. BRYANT
CHECKED BY: D. BURHANS
SHEET 54 OF 60