


UTILITY RELOCATION PLAN

LEGEND:
 - - - - - AER E&T - - - - - ELECTRIC/TELEPHONE
 // - - - - - AER E&T - - - - - ELECTRIC/TELEPHONE TO BE RELOCATED

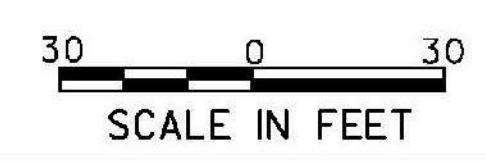

TYLIN INTERNATIONAL

PROJECT NAME: HYDE PARK	PLOT DATE: 11/6/2013
PROJECT NUMBER: STP CULV(26)	DRAWN BY: T. KELLEY
FILE NAME: zllb292bdr_Utl.dgn	CHECKED BY: D. BRYANT
PROJECT LEADER: R. HEBERT	SHEET 60 OF 60
DESIGNED BY: T. KELLEY	
UTILITY RELOCATION PLAN	