


CLD 12-006 MODEL: Sheet01

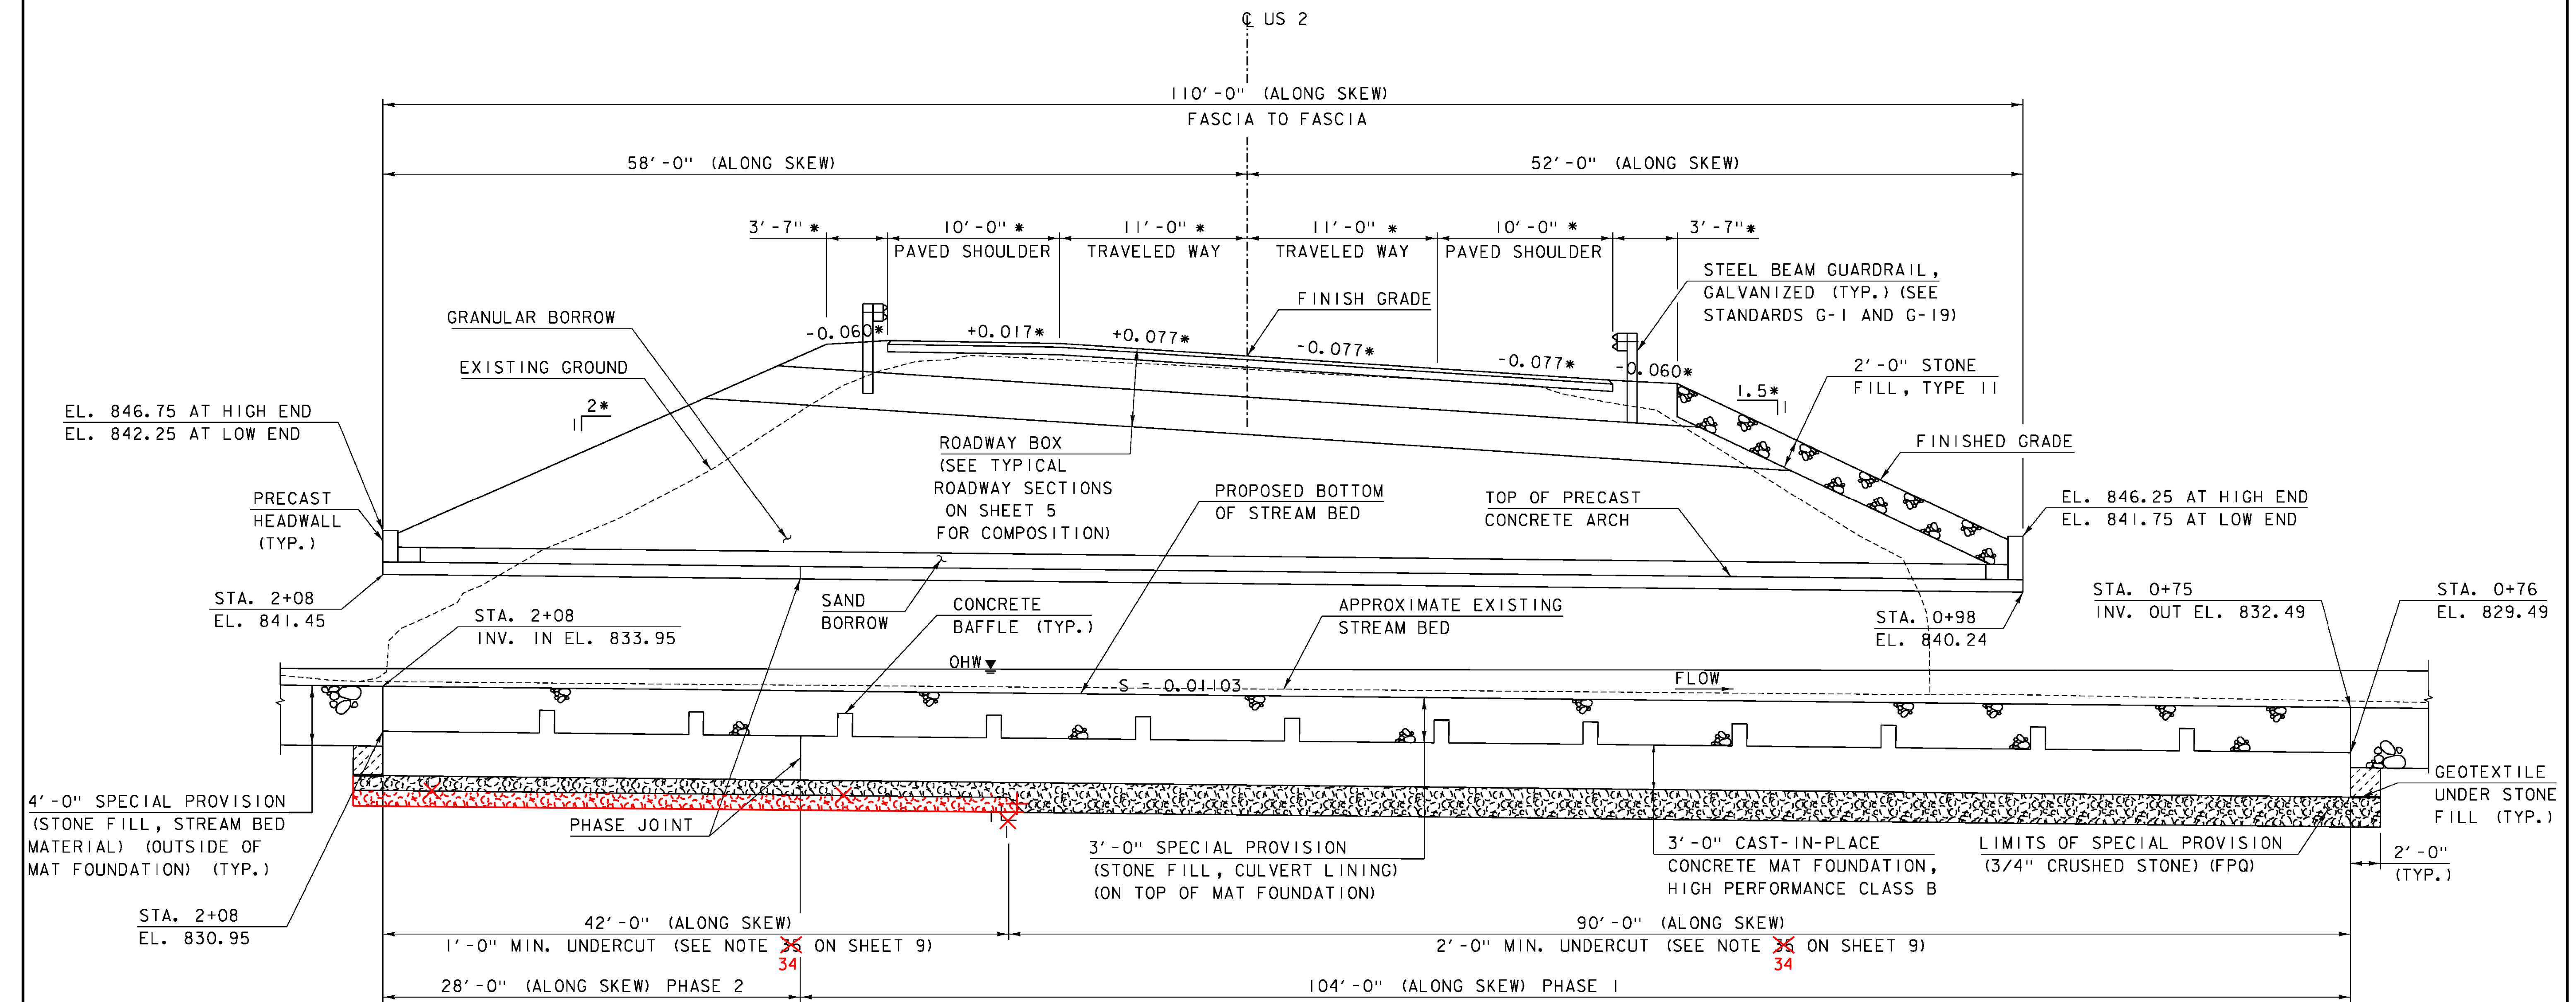

TYPICAL LONGITUDINAL BRIDGE SECTION
(SHOWN ALONG C OF ARCH)
SCALE: 3/16" = 1'-0"

NOTES:

* DIMENSIONS AND SLOPES GIVEN PERPENDICULAR TO ROADWAY C

PROJECT NAME:	LUNENBURG	FILE NAME:	11b294/cos/z11b294sub.dgn	PLOT DATE:	8/6/2015
PROJECT NUMBER:	NH CULV(27)	PROJECT LEADER:	J. BYATT	DRAWN BY:	M. SMITH
		DESIGNED BY:	S. BEAUMONT	CHECKED BY:	J. BYATT
		TYPICAL BRIDGE SECTION SHEET 1			SHEET 3 OF 74

