

NOTE

REMOVAL OF EXISTING PAVEMENT MARKINGS AND APPLICATION OF TEMPORARY PAVEMENT MARKINGS, GUARDRAIL, ANCHORS, DELINEATORS AND DRIVE CONSTRUCTION AS NOTED ON THIS SHEET WILL BE INCLUDED UNDER PAY ITEM 900.645, "SPECIAL PROVISION (TEMPORARY ROADWAY)". NOTES ARE PROVIDED FOR INFORMATIONAL PURPOSES ONLY.

TEMPORARY 4 INCH WHITE LINE, PAINT
425+50 TO 429+75 LT & RT

TEMPORARY 4 INCH YELLOW LINE, PAINT
425+50 TO 426+85 LT & RT

TEMPORARY 24 INCH STOP BAR, PAINT
426+85 RT

ENERGY ABSORPTION ATTENUATOR

427+75 RT
427+85 LT

TEMPORARY TRAFFIC BARRIER

427+75 TO 429+75 RT
427+85 TO 429+75 LT

CONSTRUCT DRIVES WITH 4 FOOT PAVED APRON
102+38 LT (18.4 FT WIDE, GRAVEL, RES.)

STA 424+25.00
BEGIN APPROACH

STA 424+50.00
END APPROACH
BEGIN PROJECT

DETOUR STA 100+00.00=
US 2 STA 425+00.00

STA 100+50 TO 102+00 LT
SEE PHASE I FOR PAVEMENT LAYOUT


STA 429+26.33
BEGIN BRIDGE

STA 100+50.00
BEGIN DETOUR

STA 429+51.35
END BRIDGE

LEGEND


- N/C NEW SIGN/CONSTRUCTION ONLY
- B/W BLACK/WHITE
- ☒ TYPE III BARRICADE
- ☒ TYPE III BARRICADE (MOD.)
- ▬ TEMPORARY TRAFFIC BARRIER
- ⊗ ENERGY ABSORPTION ATTENUATOR

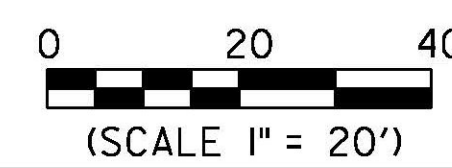

PROJECT NAME: LUNENBURG
PROJECT NUMBER: NH CULV(27)

FILE NAME: llb294/cos/2llb294bdr+cpp2.dgn PLOT DATE: 8/24/2015
PROJECT LEADER: J. BYATT DRAWN BY: M. HALEY
DESIGNED BY: M. HALEY CHECKED BY: P. SHEDD
PHASE 2 TRAFFIC CONTROL SHEET 1 SHEET 24 OF 74

CLD_12-0106 MODEL: L01

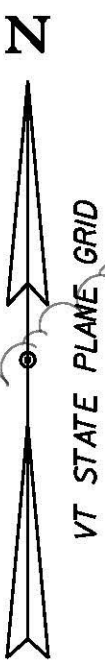

MATCH LINE SEE NEXT SHEET

