

- LEGEND**
- N/C NEW SIGN/CONSTRUCTION ONLY
 - B/W BLACK/WHITE
 - ☒ TYPE III BARRICADE
 - ☒ TYPE III BARRICADE (MOD.)
 - ▬ TEMPORARY TRAFFIC BARRIER
 - ⊗ ENERGY ABSORPTION ATTENUATOR

NOTE

REMOVAL OF EXISTING PAVEMENT MARKINGS AND APPLICATION OF TEMPORARY PAVEMENT MARKINGS, GUARDRAIL, ANCHORS, DELINEATORS AND DRIVE CONSTRUCTION AS NOTED BELOW WILL BE INCLUDED UNDER PAY ITEM 900.645, "SPECIAL PROVISION (TEMPORARY ROADWAY)". NOTES ARE PROVIDED FOR INFORMATIONAL PURPOSES ONLY.

TEMPORARY 4 INCH WHITE LINE, PAINT
429+75 TO 432+90 LT & RT

TEMPORARY 24 INCH STOP BAR, PAINT
432+90 LT


ENERGY ABSORPTION ATTENUATOR

431+12 LT
431+16 RT

TEMPORARY TRAFFIC BARRIER

429+75 TO 431+15 LT
429+75 TO 431+16 RT

CONSTRUCT DRIVES WITH 4 FOOT PAVED APRON
107+33.1 LT (18.0 FT WIDE, GRAVEL, FIELD)

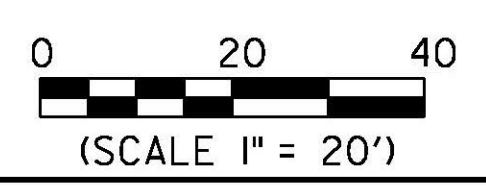

PROJECT NAME:	LUNENBURG
PROJECT NUMBER:	NH CULV(27)
FILE NAME:	11b294/cos/211b294bdr+cpp2.dgn
PLOT DATE:	8/24/2015
PROJECT LEADER:	J. BYATT
DRAWN BY:	M. HALEY
DESIGNED BY:	M. HALEY
CHECKED BY:	P. SHEDD
PHASE 2 TRAFFIC CONTROL SHEET 2	SHEET 25 OF 74

CLD_12-0106 MODEL: L02