



PEDESTAL WALL MASONRY PLAN - WEST

SCALE: 3/16" = 1'-0"

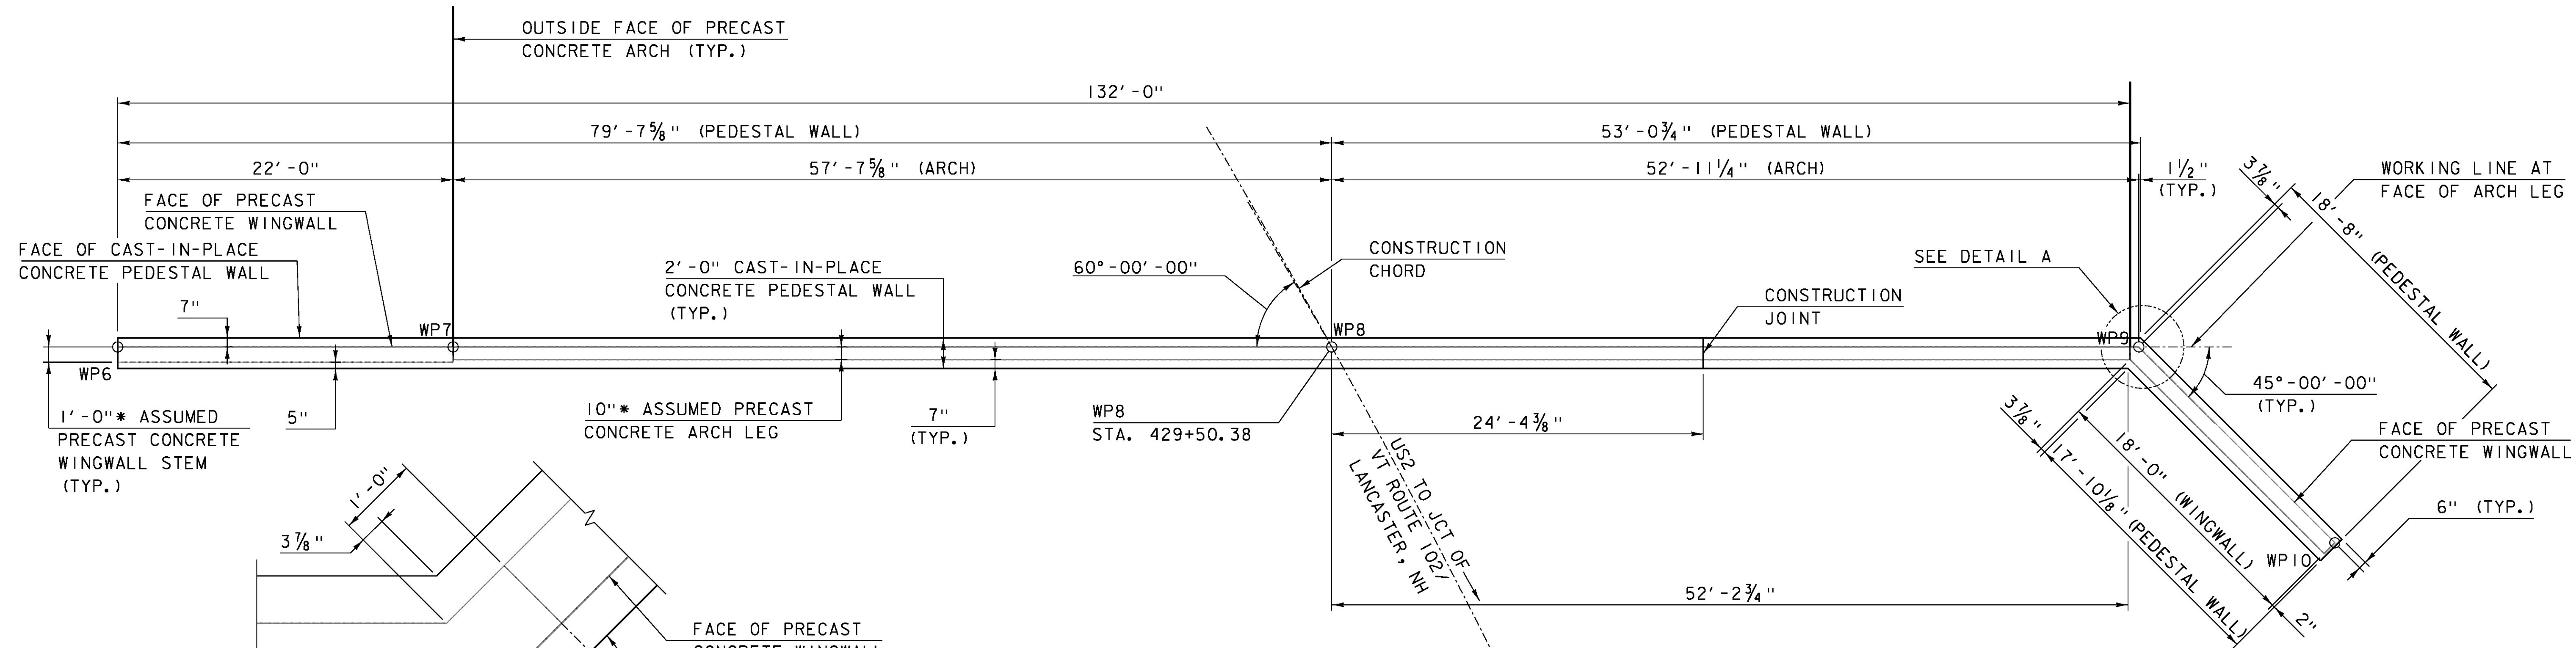

PEDESTAL WALL MASONRY PLAN - EAST

SCALE: 3/16" = 1'-0"

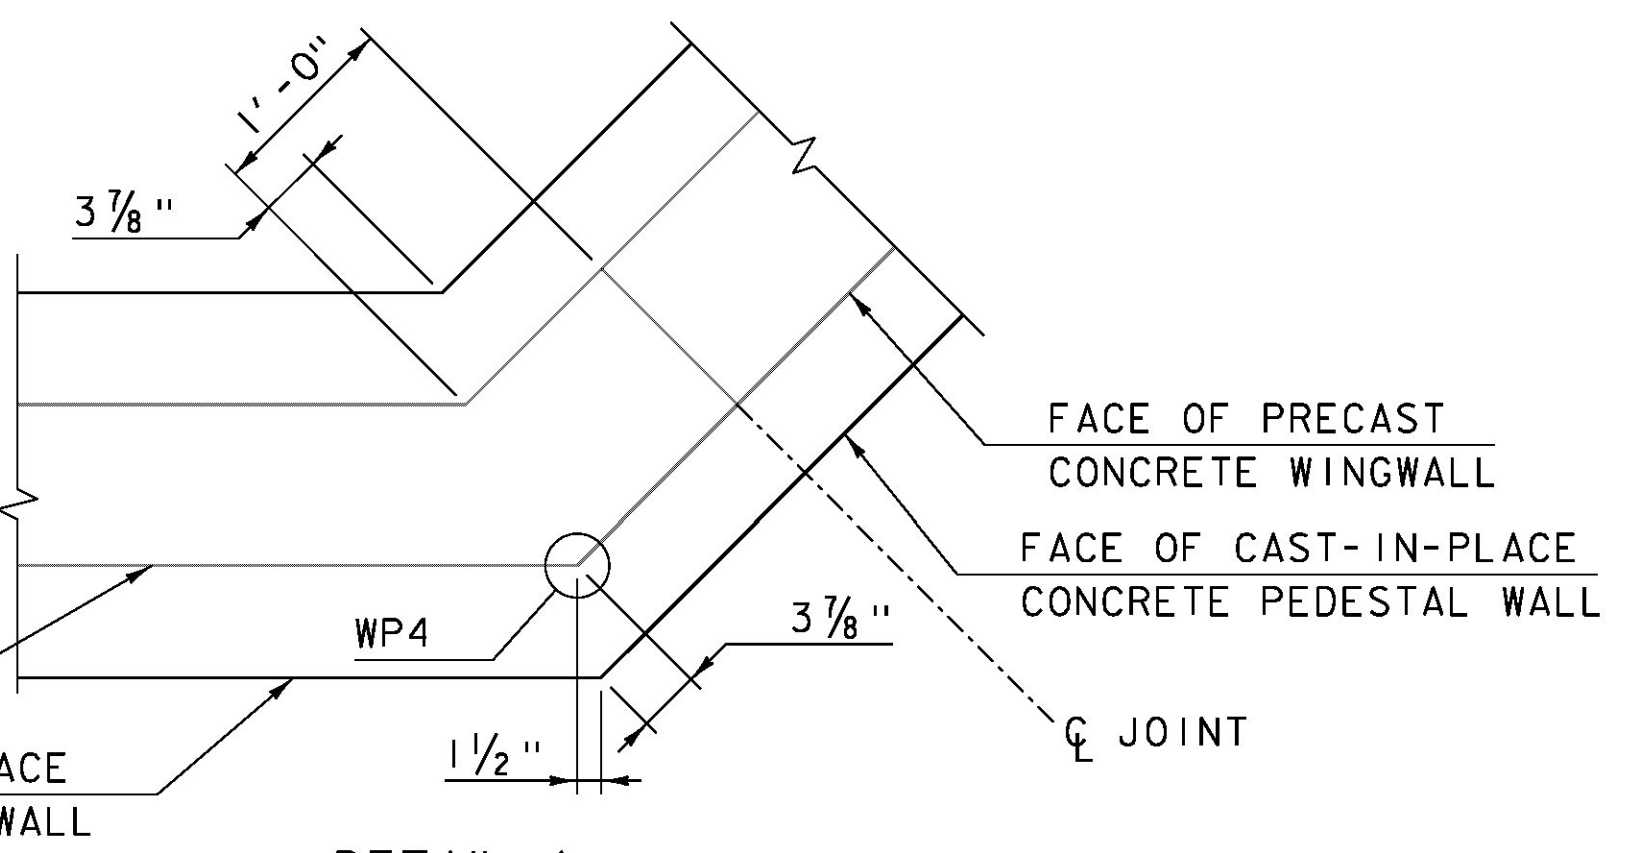

DETAIL A

(NORTHWEST WINGWALL SHOWN, OTHER WINGWALLS SIMILAR)  
SCALE: 1" = 1'-0"

NOTES:

\* SEE PRECAST CONCRETE ARCH NOTES ON SHEET 10.



PROJECT NAME:	LUNENBURG	PLOT DATE:	8/6/2015
PROJECT NUMBER:	NH CULV(27)	DRAWN BY:	M. SMITH
FILE NAME:	lib294/cos/zlib294sub.dgn	DESIGNED BY:	S. BEAUMONT
PROJECT LEADER:	J. BYATT	CHECKED BY:	N. CARON
SUBSTRUCTURE DETAILS SHEET 1			SHEET 45 OF 74

CLD\_12-0106 MODEL: Sheet07