




429+00

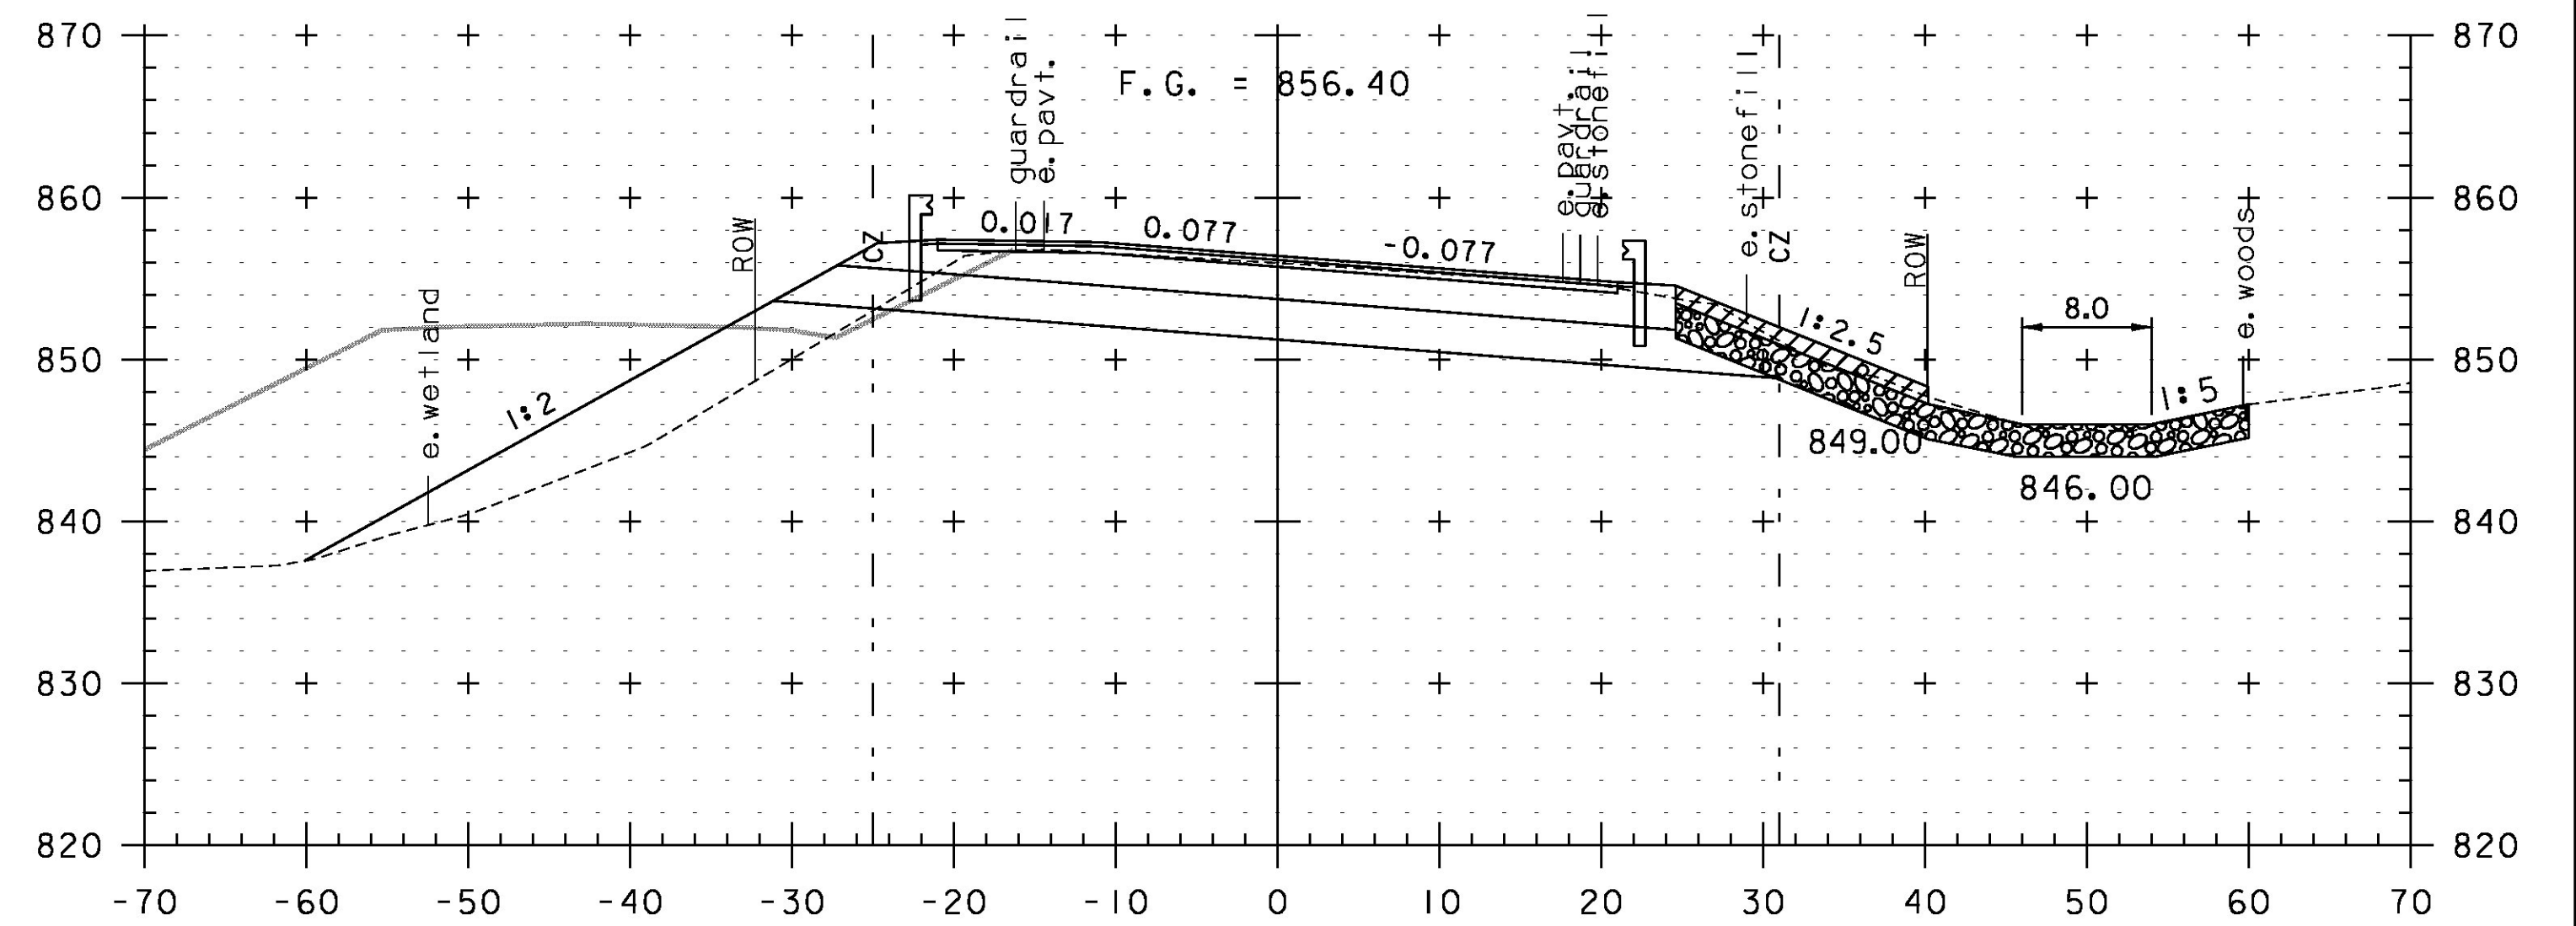

430+00

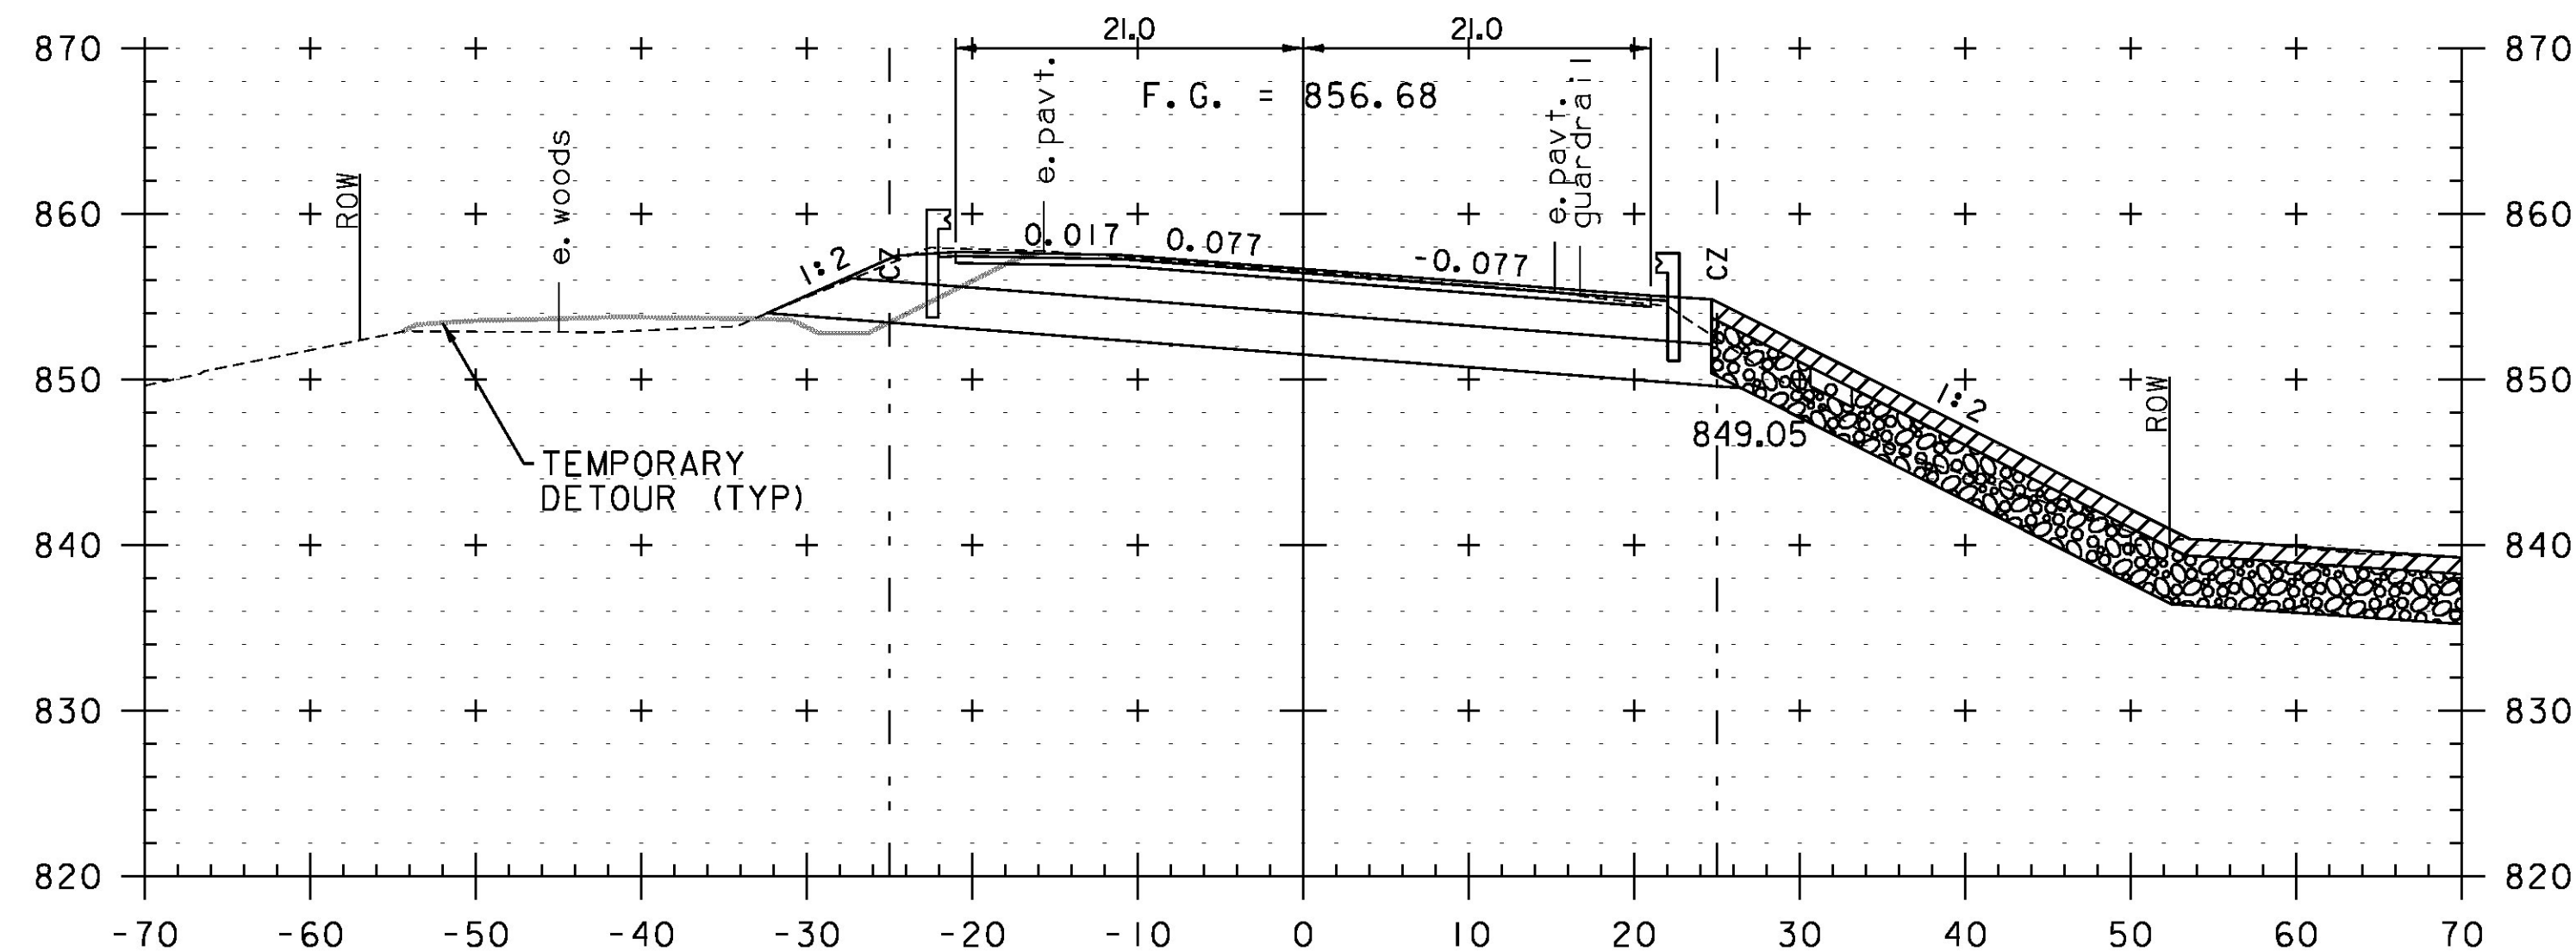

428+50

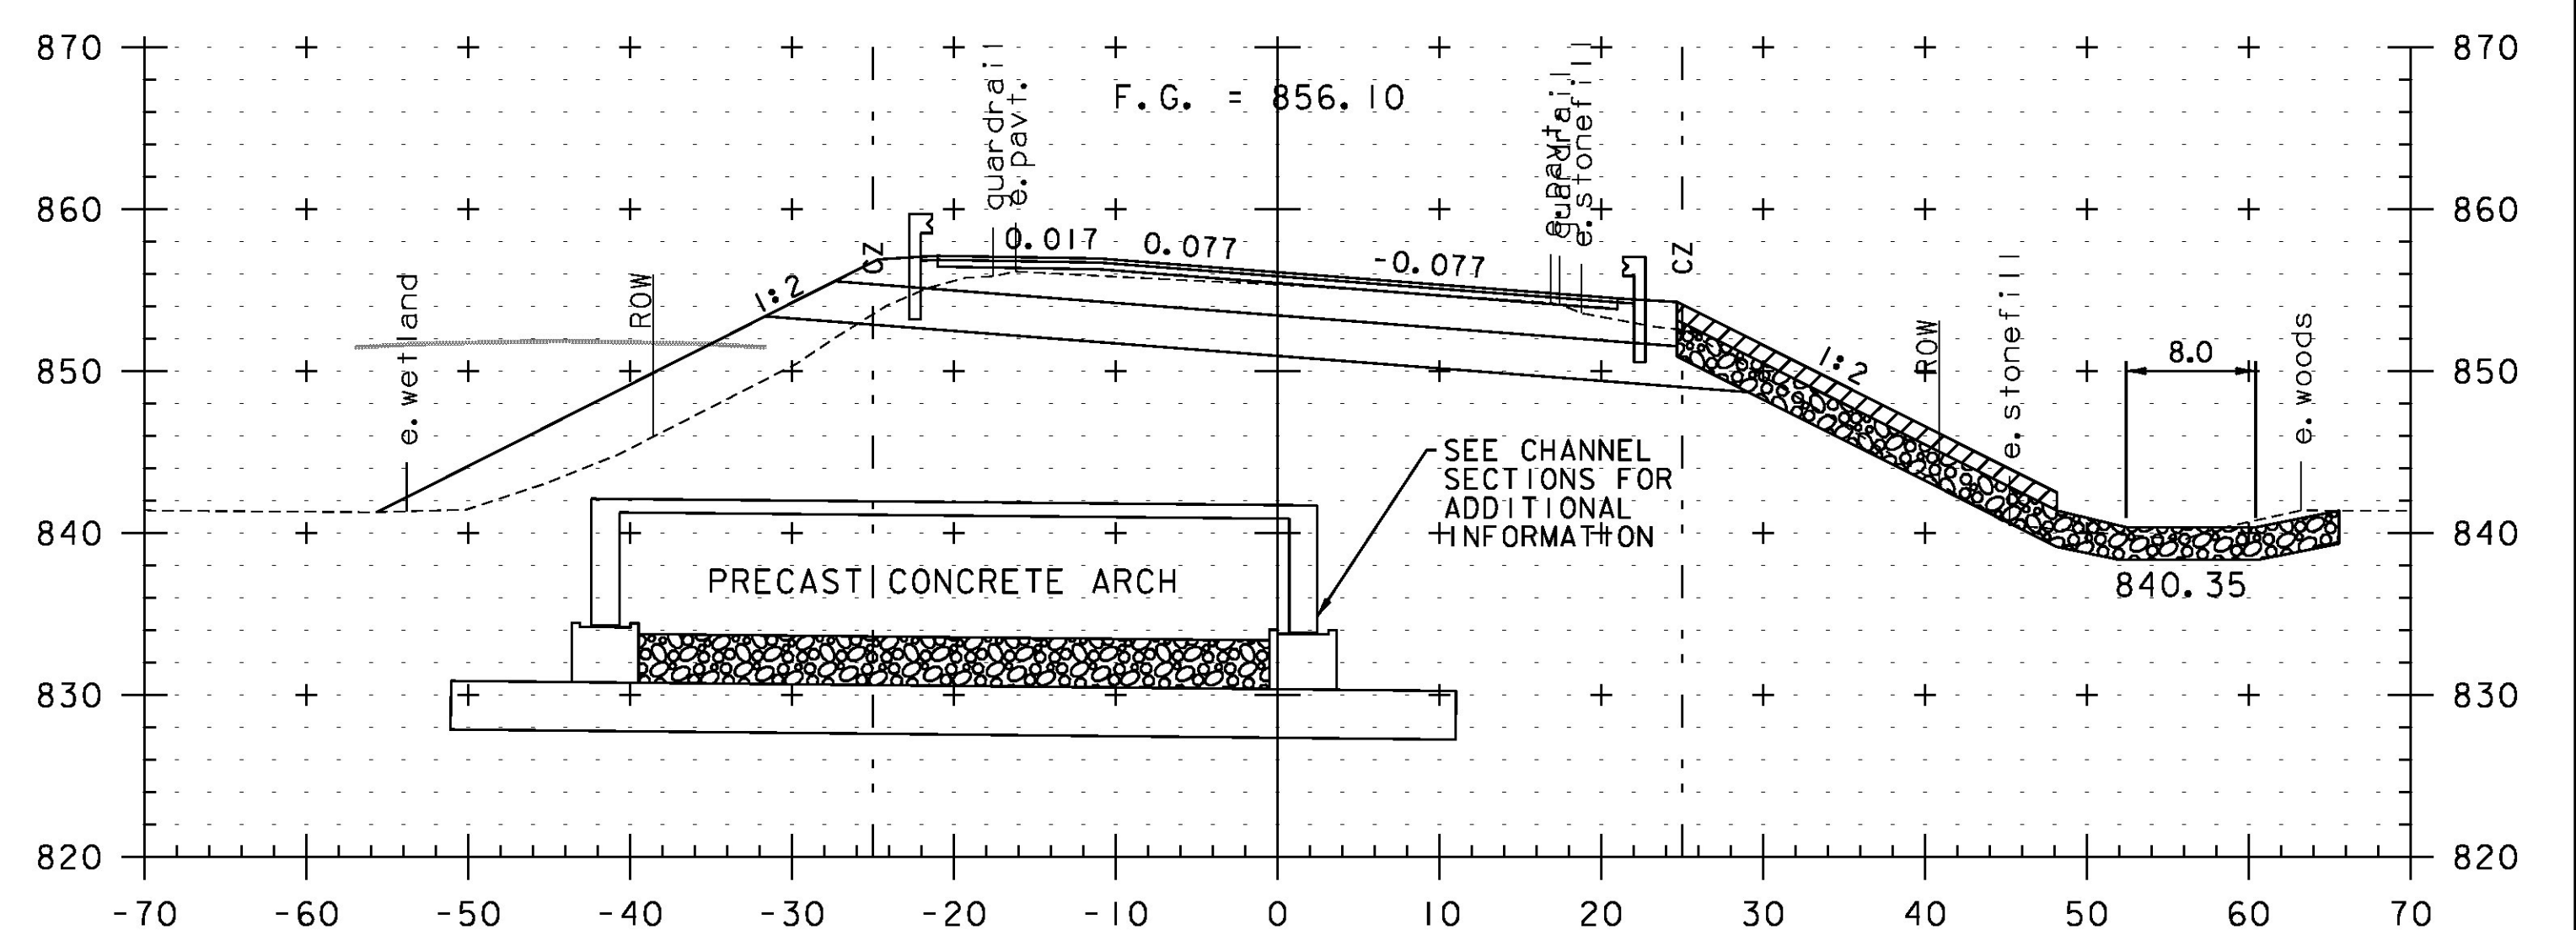

429+50

STA. 428+50 TO STA. 430+00

PROJECT NAME: LUNENBURG
PROJECT NUMBER: NH CULV(27)

FILE NAME: IIB294/cos/zlib294xsl.dgn
PROJECT LEADER: J. BYATT
DESIGNED BY: M. HALEY
ROADWAY CROSS SECTIONS 3

PLOT DATE: 8/6/2015
DRAWN BY: M. HALEY
CHECKED BY: P. SHEDD
SHEET 52 OF 74

