




431+50

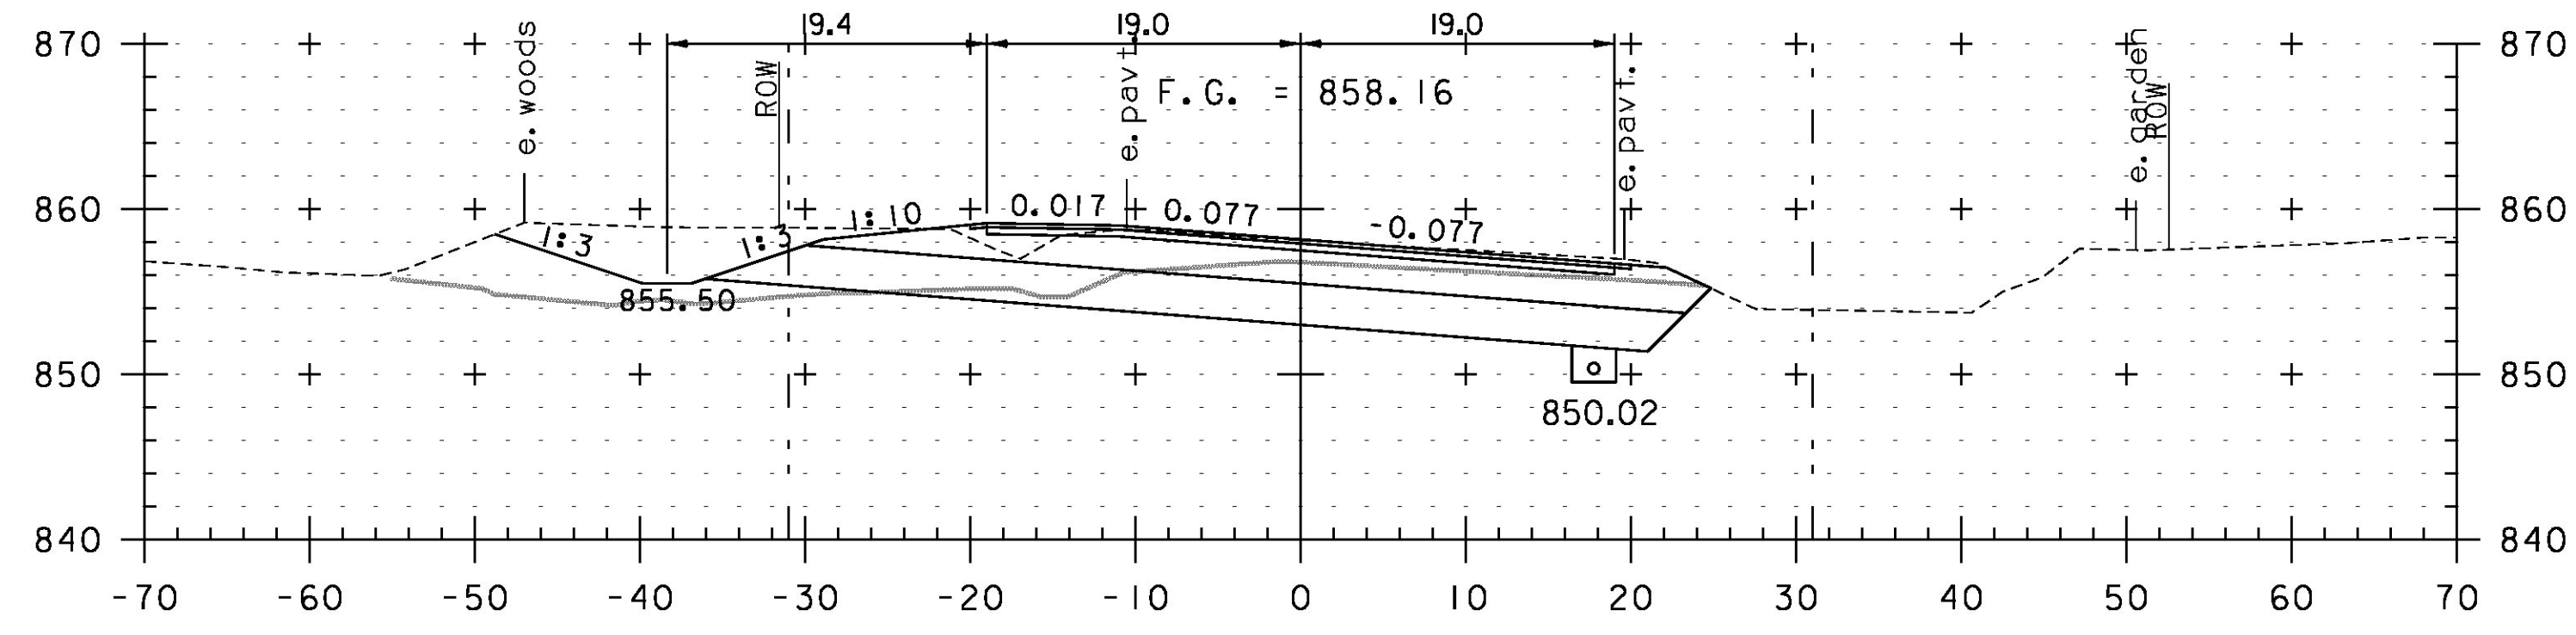


431+00

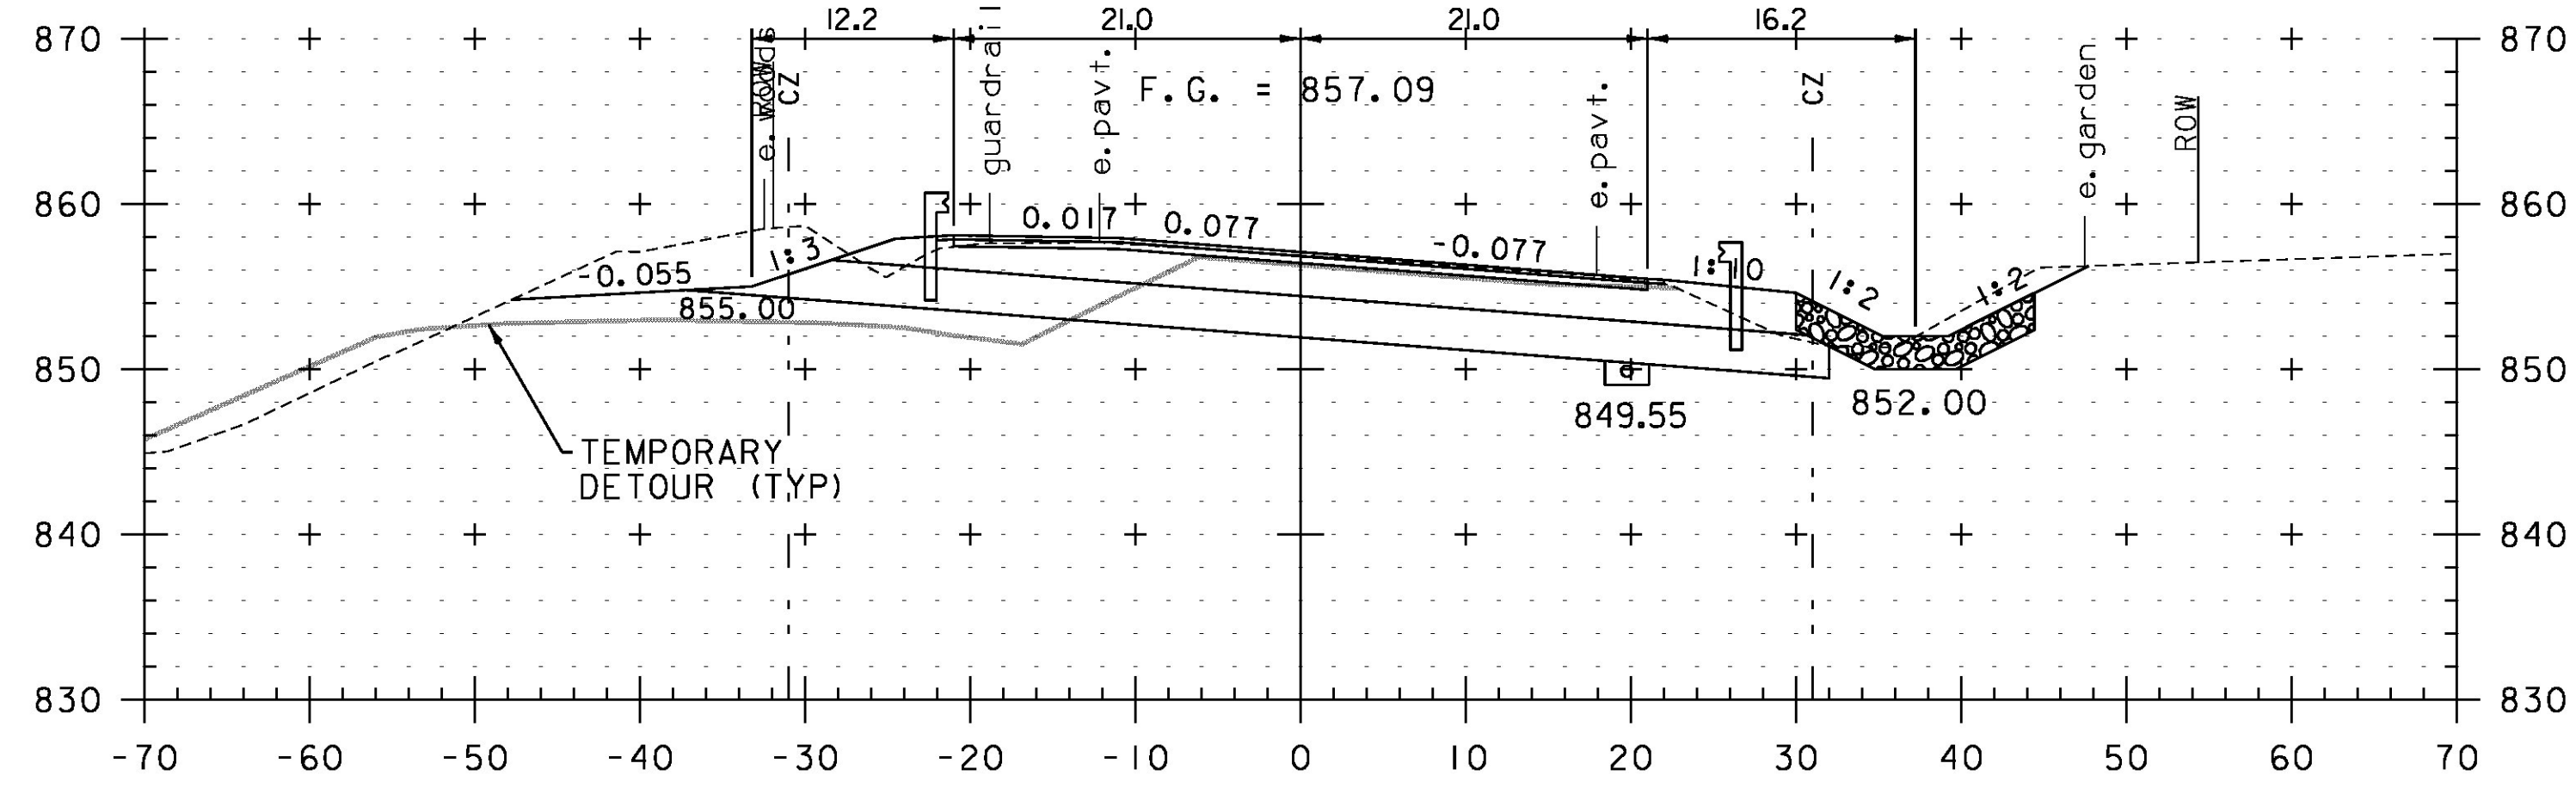


430+50

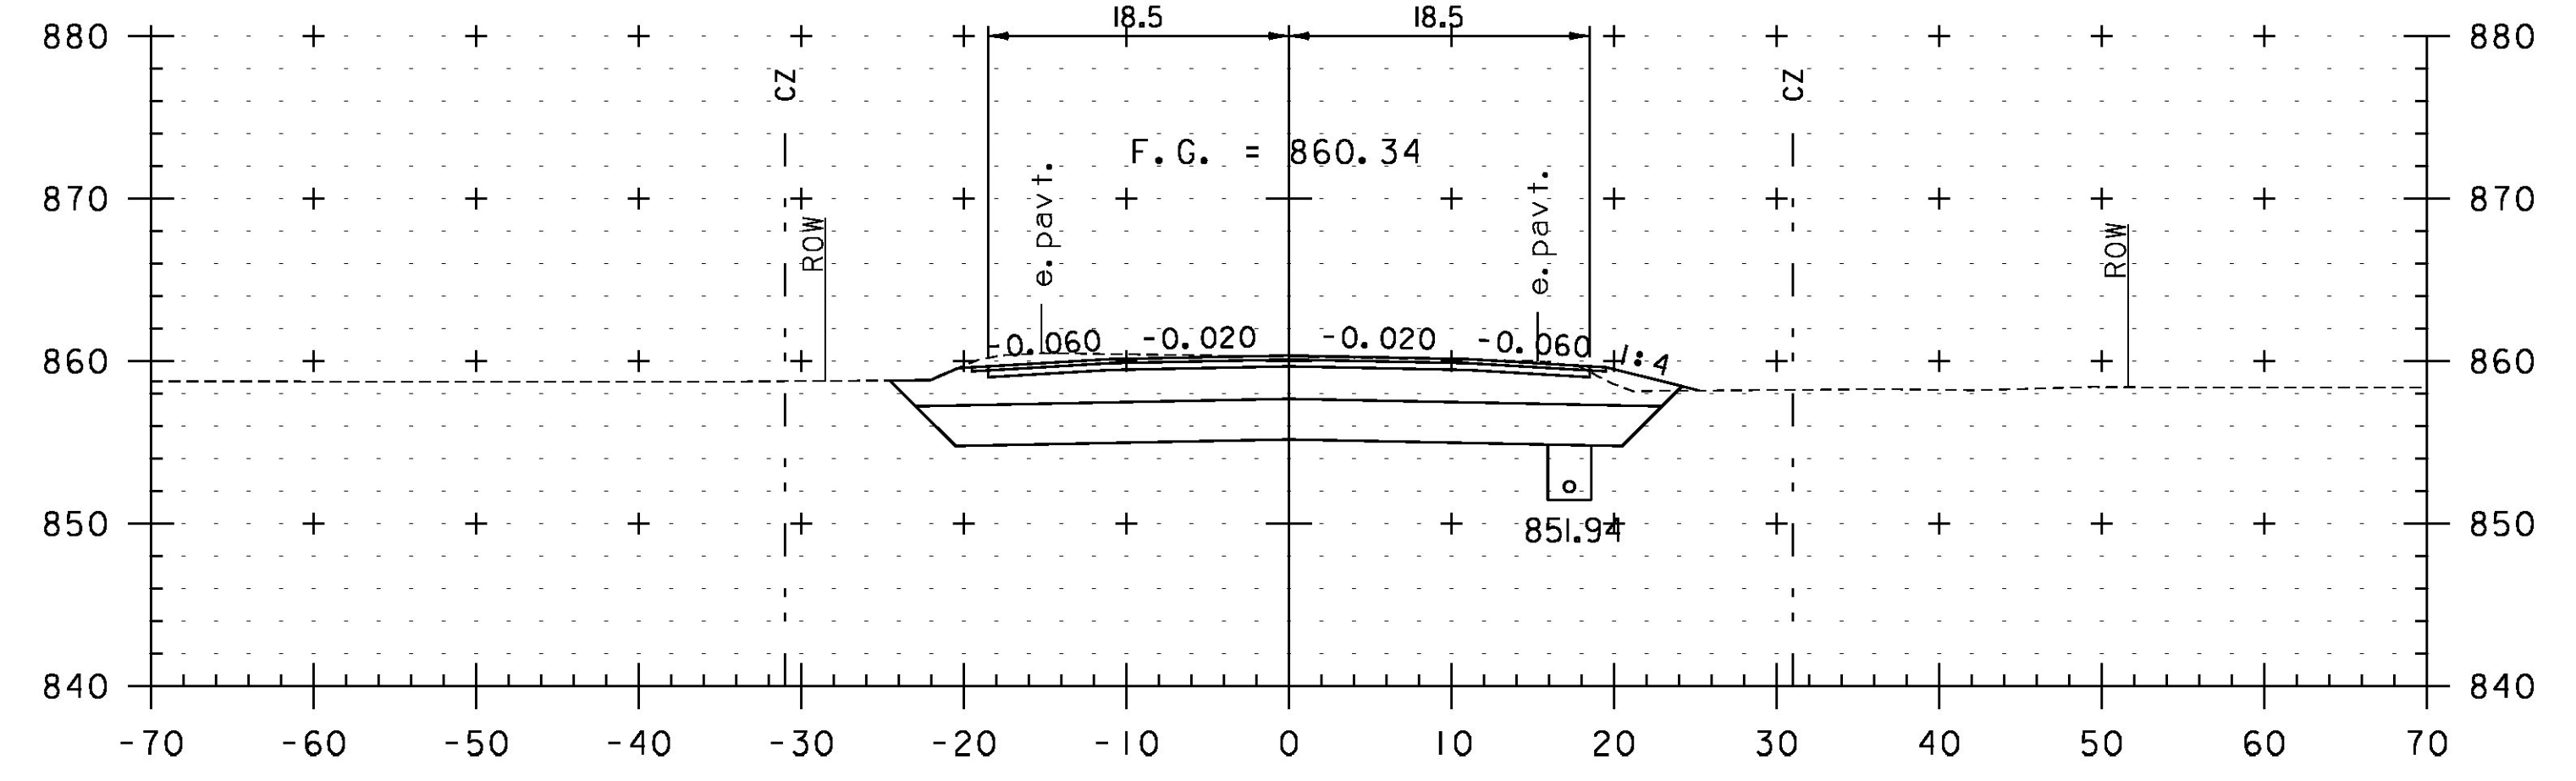

433+00

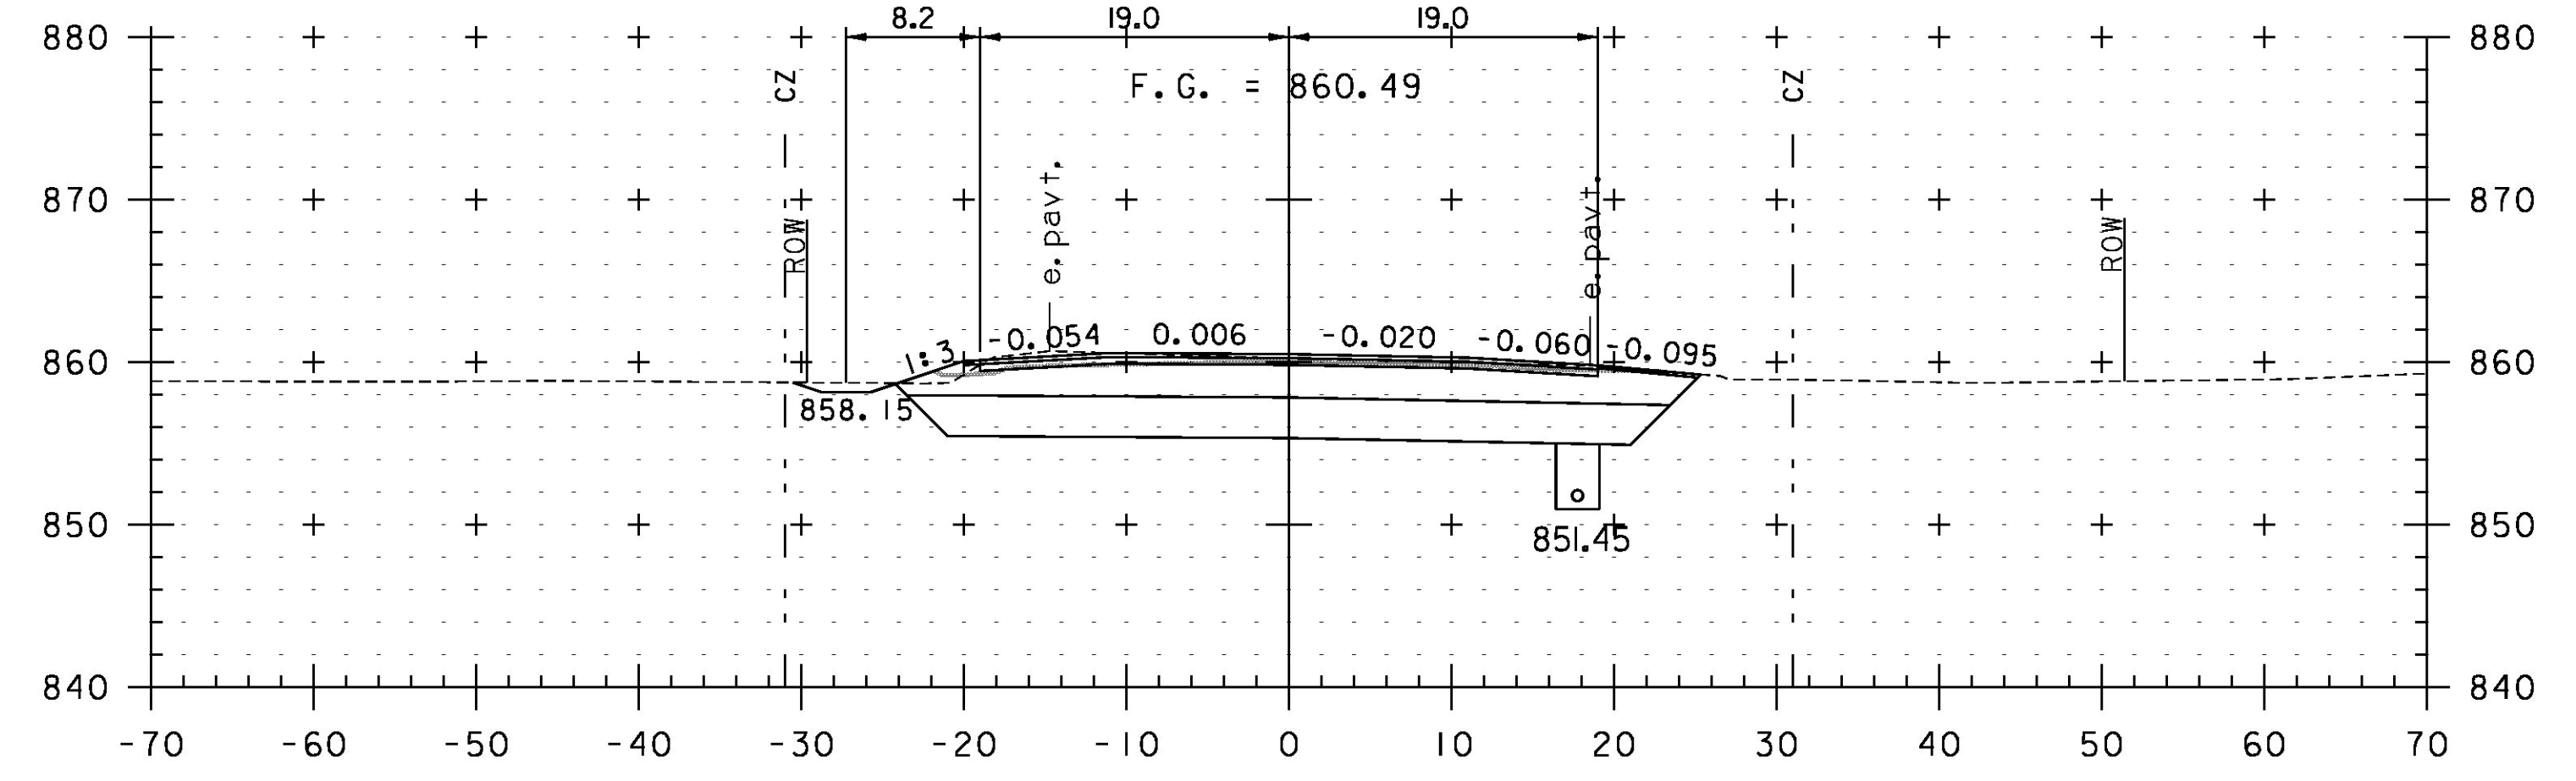


432+50
DRIVE RT

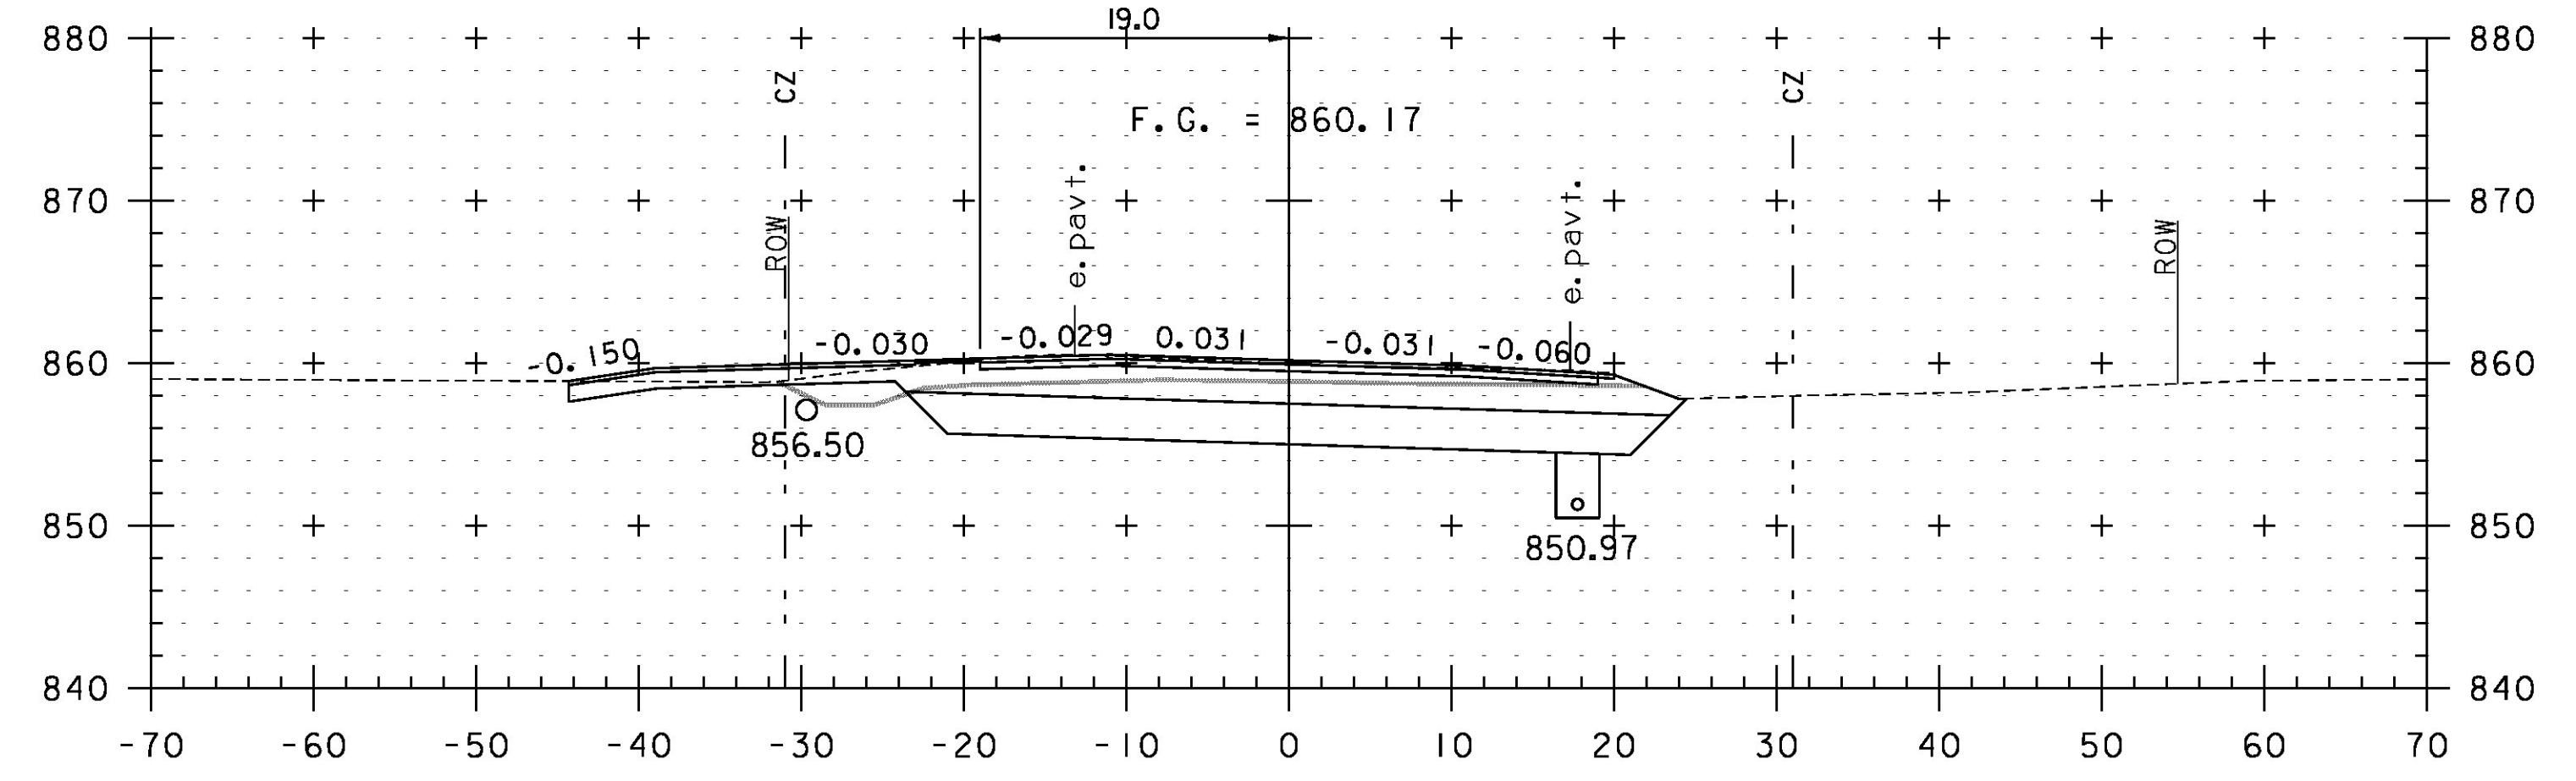

432+00
DRIVE LT

STA. 430+50 TO STA. 433+00

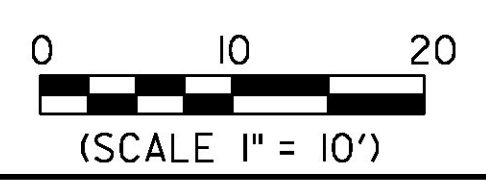

PROJECT NAME:	LUNENBURG	PLOT DATE:	8/6/2015
PROJECT NUMBER:	NH CULV(27)	DRAWN BY:	M. HALEY
FILE NAME:	IIB294/cos/zlib294xsl.dgn	CHECKED BY:	P. SHEDD
PROJECT LEADER:	J. BYATT	ROADWAY CROSS SECTIONS 4	SHEET 53 OF 74
DESIGNED BY:	M. HALEY		

CLD_12-0106 MODEL: XS04